



**GRADELINE DIAGRAM**

No Scale  
412' - CIP P/T Box Girder

HYDRAULIC DATA		
	DESIGN FLOOD	BASE FLOOD
DISCHARGE (cfs)	120,000	130,000
FREQUENCY (yrs)	50	100
H.W. ELEVATION AT UPSTREAM FACE OF BRIDGE	25.75	27.39
BACKWATER (ft.)	0.01	0.01

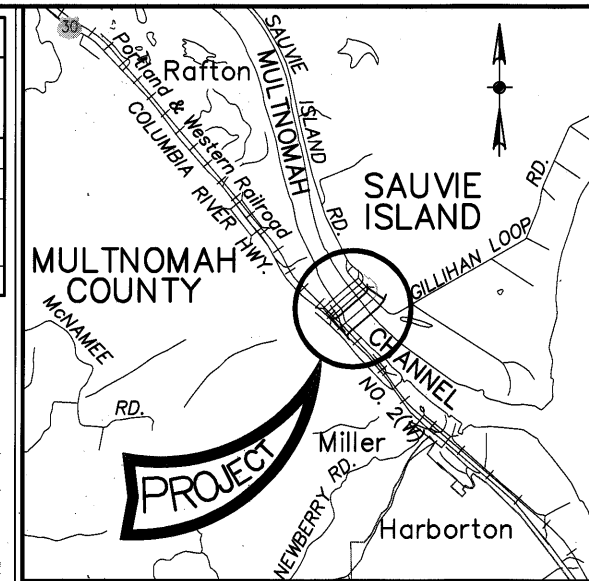

SEC. 28, T. 2 N., R. 1 W., W.M.  
**LOCATION MAP**  
No Scale

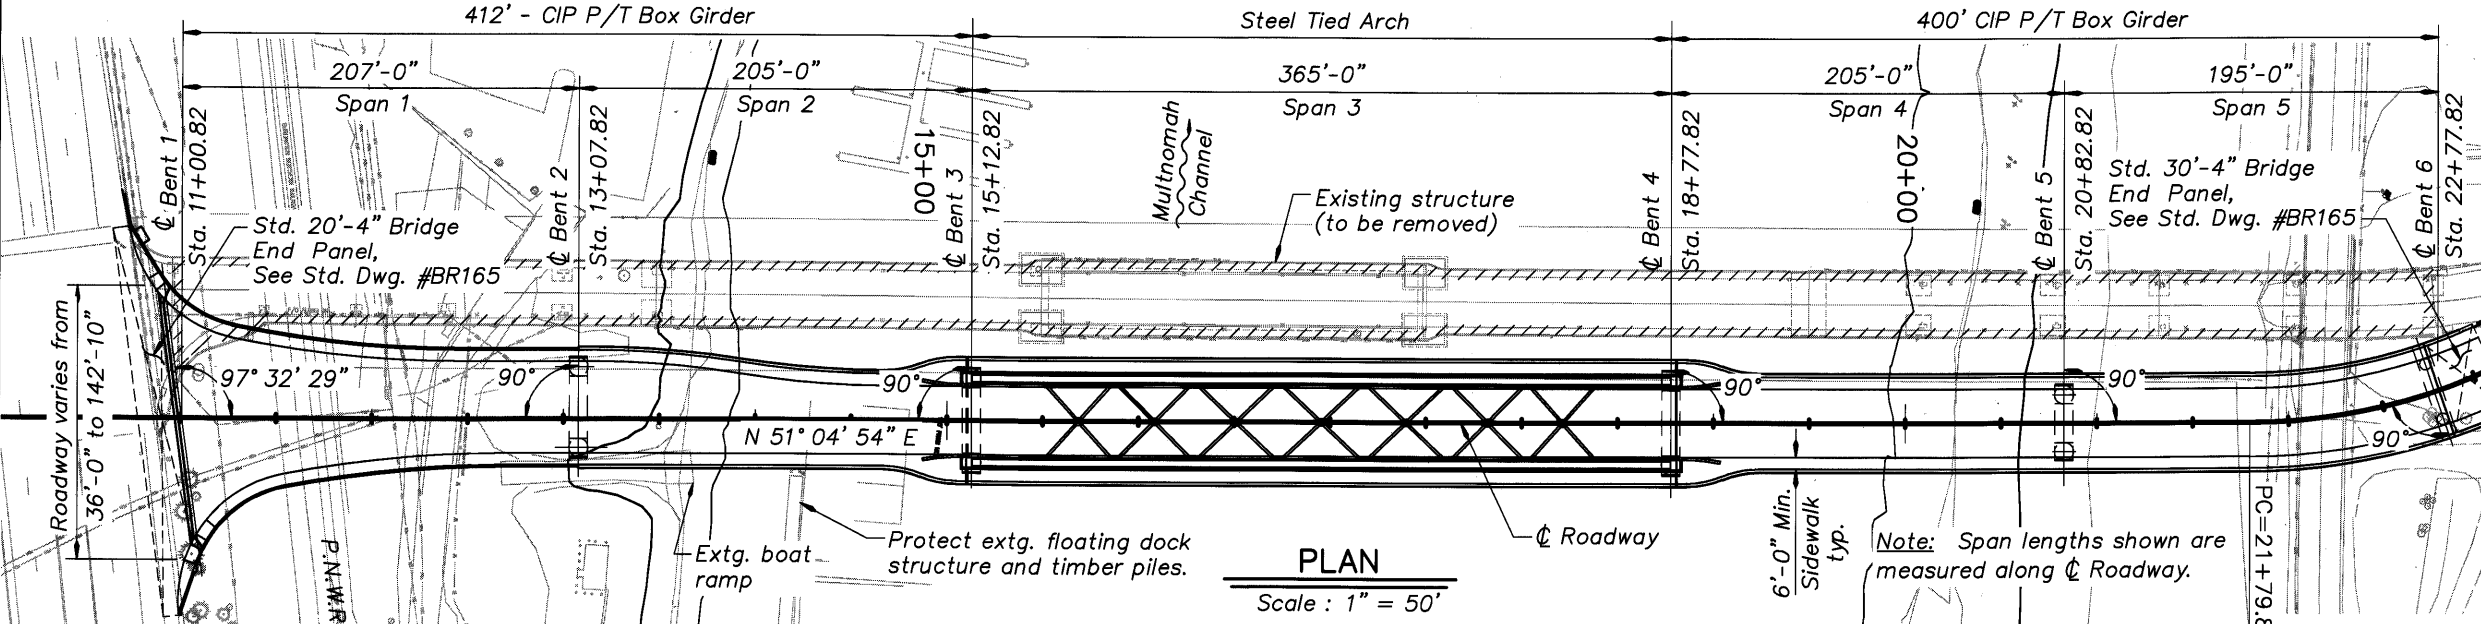


**PLAN**

Scale: 1" = 50'

**CURVE DATA**

R 300'  
Δ 96°22'14"  
L 504.60'

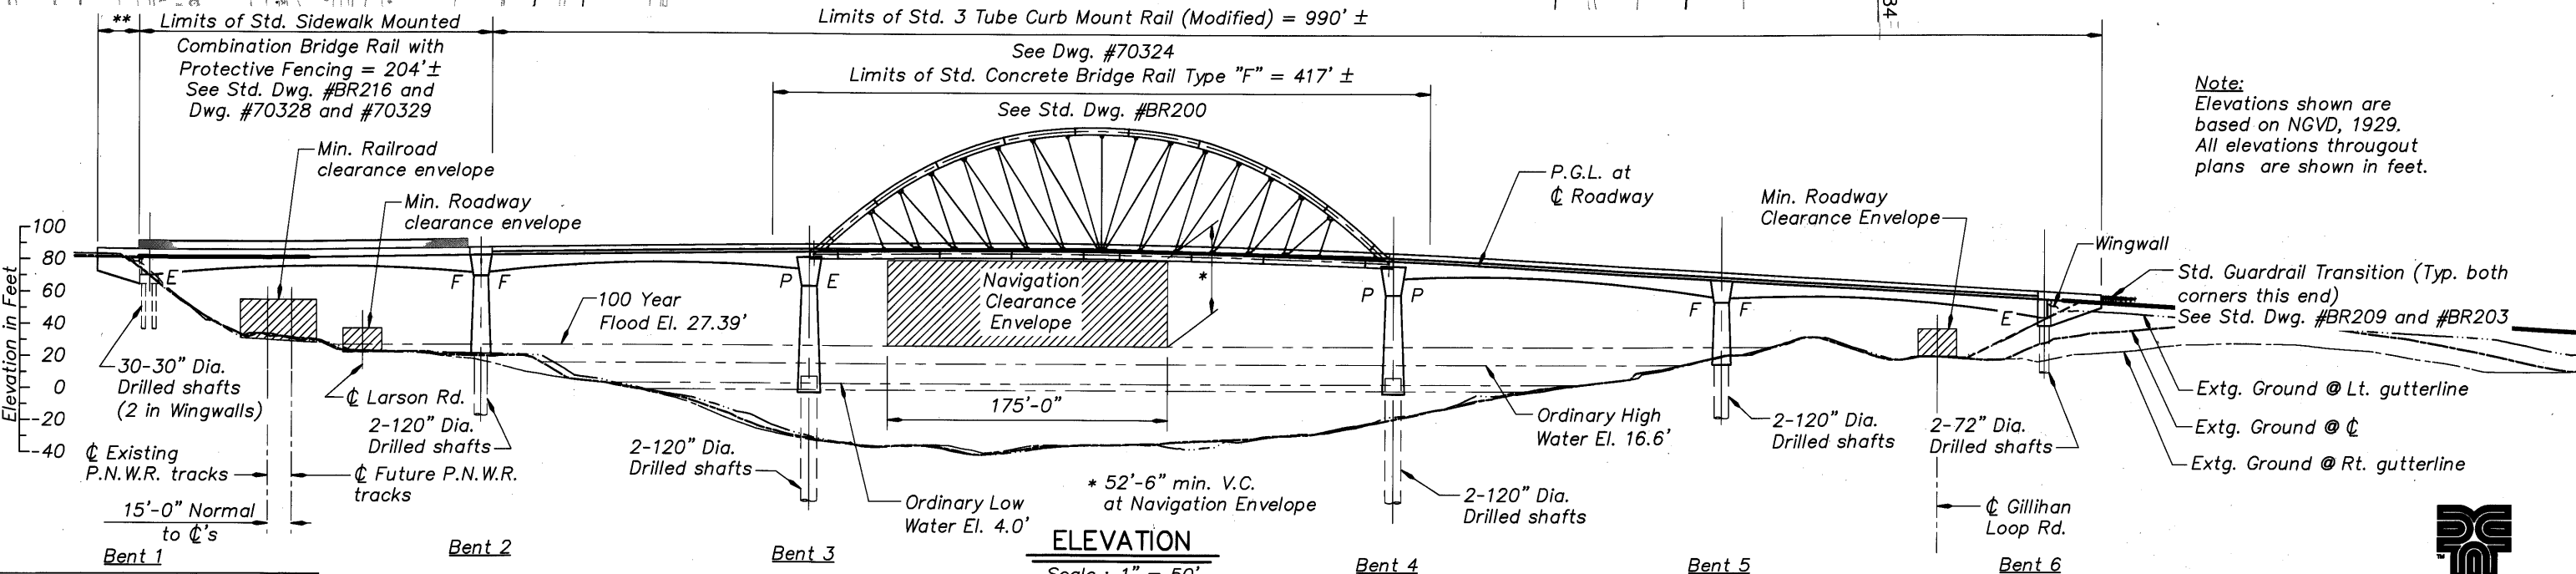

**ELEVATION**

Scale: 1" = 50'

DO NOT SCALE THIS DRAWING. FOLLOW DIMENSIONS. INDICATED SCALES CORRECT ONLY FOR FULL SIZE SHEET (22"x34").

\*\* Limits of Std. Flush Mounted Combination Bridge Rail = 43' ± See Std. Dwg. #BR220

CONNECTING COMMERCE AND COMMUNITY  
**MULTNOMAH COUNTY BRIDGES** TRANSPORTATION DIVISION  
Existing Co. Br. No. 2641

**DAVID EVANS AND ASSOCIATES INC.**  
530 Center Street N.E., Suite 605  
Salem Oregon 97301  
Phone: 503.361.8635

DATE	REVISION	BY
08/05	Revised Columns	KWC
03/09	As-Constructed	TDF

**J. Patton**  
DRAFTED:  
**Shonn Mills**  
CHECKED:  
**Clifford Coulter**  
REVIEWED:

**DESIGNER**  
REGISTERED PROFESSIONAL ENGINEER  
No. 74548 PE  
OREGON  
MARCH 09, 2004  
WENT WILLIAM CORDELL  
EXPIRES: 12/31/05

**OREGON DEPARTMENT OF TRANSPORTATION**  
BRIDGE ENGINEERING SECTION  
ACCOMPANIED BY DWGS. BR120, BR135, BR136, BR145, BR150, BR165, BR200, BR203, BR208, BR209, BR216, BR220, BR223 & BR246

**BRIDGE NO. 20136**  
**DATE** Sept. 2005  
**CALC. BOOK**  
MULTNOMAH CHANNEL & PNWR ETC., SAUVIE ISLAND RD.  
MULTNOMAH CHANNEL (SAUVIE ISLAND RD.) (BR. #02641)  
SAUVIE ISLAND BRIDGE REPLACEMENT  
MULTNOMAH COUNTY  
**GENERAL PLAN AND ELEVATION**  
REGION 1 OREGON DIVISION PROJECT NUMBER  
**SHEET 1 OF 173**  
**DRAWING NO. 70188**

**INDEX of DRAWINGS**

**DRAWING NUMBER**

**TITLE**

**DRAWING NUMBER**

**TITLE**

**DRAWING NUMBER**






**TITLE**

70188 General Plan And Elevation  
 70189 Index Of Bridge Drawings  
 70190 Clearance And Superelevation Diagrams  
 70191 General Notes (1 Of 2)  
 70192 General Notes (2 Of 2)  
 70193 Foundation Data (1 Of 2)  
 70194 Foundation Data (2 Of 2)  
 70195 Construction Sequence (1 Of 2)  
 70196 Construction Sequence (2 Of 2)  
 70197 Arch Erection Schemes (1 Of 3)  
 70198 Arch Erection Schemes (2 Of 3)  
 70199 Arch Erection Schemes (3 Of 3)  
 70200 Box Girder Concrete Placement - Spans 1 And 2  
 70201 Box Girder Concrete Placement - Spans 4 And 5  
 70202 Conceptual Demolition Scheme  
 70203 Temporary Work Bridge Plan  
 70204 Footing Plan (1 Of 2)  
 70205 Footing Plan (2 Of 2)  
 70206 Deck Plan Reference Notes  
 70207 Deck Plan - Span 1 Right Side  
 70208 Deck Plan - Span 1 Left Side  
 70209 Deck Plan - Span 2  
 70210 Deck Plan - Span 3 (1 Of 2)  
 70211 Deck Plan - Span 3 (2 Of 2)  
 70212 Deck Plan - Span 4  
 70213 Deck Plan - Span 5  
 70214 Typical Section - Span 3  
 70215 Arch Elevation And Geometry (1 Of 3)  
 70216 Arch Elevation And Geometry (2 Of 3)  
 70217 Arch Elevation And Geometry (3 Of 3)  
 70218 Arch And Tie-girder Deformed Geometries  
 70219 Member Typical Sections (1 Of 2)  
 70220 Member Typical Sections (2 Of 2)  
 70221 Arch Rib Member Forces (1 Of 2)  
 70222 Arch Rib Member Forces (2 Of 2)  
 70223 Tie-girder Member Forces (1 Of 2)  
 70224 Tie-girder Member Forces (2 Of 2)  
 70225 Arch Rib Details (1 Of 5)  
 70226 Arch Rib Details (2 Of 5)  
 70227 Arch Rib Details (3 Of 5)  
 70228 Arch Rib Details (4 Of 5)  
 70229 Arch Rib Details (5 Of 5)  
 70230 Arch Rib Bracing Plan  
 70231 Arch Rib Bracing Details  
 70232 Tie-girder Details  
 70233 Tie-girder Splice Details  
 70234 Tie-girder Hanger Details (1 Of 3)  
 70235 Tie-girder Hanger Details (2 Of 3)  
 70236 Tie-girder Hanger Details (3 Of 3)  
 70237 Knuckle Details (1 Of 2)  
 70238 Knuckle Details (2 Of 2)  
 70239 Knuckle Splice Details (1 Of 3)  
 70240 Knuckle Splice Details (2 Of 3)  
 70241 Knuckle Splice Details (3 Of 3)  
 70242 Hanger Cable Details (1 Of 2)  
 70243 Hanger Cable Details (2 Of 2)  
 70244 Deck Framing Plan - Arch Floor System (1 Of 2)  
 70245 Deck Framing Plan - Arch Floor System (2 Of 2)  
 70246 Typical Floorbeam Details  
 70247 End Floorbeam Details


70248 Stringer And Floorbeam Details  
 70249 Sidewalk Stringer And Floorbeam Details  
 70250 Floorbeam Attachment Bracket Details  
 70251 Roadway Stringer Details  
 70252 Sidewalk Stringer Details  
 70253 Arch And Tie-girder Access Details  
 70254 Access Details (1 Of 2)  
 70255 Access Details (2 Of 2)  
 70256 Traveler Rail Details  
 70257 Miscellaneous Steel Details  
 70258 Longitudinal Beam Layout - Span 1 Right Side  
 70259 Longitudinal Beam Layout - Span 1 Left Side  
 70260 Longitudinal Beam Layout - Span 2 (1 Of 2)  
 70261 Longitudinal Beam Layout - Span 2 (2 Of 2)  
 70262 Typical Sections - Span 1 (1 Of 2)  
 70263 Typical Sections - Span 1 (2 Of 2)  
 70264 Typical Sections - Span 2  
 70265 Box Girder Reinforcement - Spans 1 And 2 (1 Of 3)  
 70266 Box Girder Reinforcement - Spans 1 And 2 (2 Of 3)  
 70267 Box Girder Reinforcement - Spans 1 And 2 (3 Of 3)  
 70268 Deck Reinforcement - Spans 1 And 2 (1 Of 2)  
 70269 Deck Reinforcement - Spans 1 And 2 (2 Of 2)  
 70270 Bent 1 - End Beam Details  
 70271 Part Layout - Span 1  
 70272 Diaphragm Details  
 70273 Typical Diaphragm Details  
 70274 Bent 2 - Integral X-beam Plan And Elevation  
 70275 Bent 2 - Integral X-beam Details (1 Of 3)  
 70276 Bent 2 - Integral X-beam Details (2 Of 3)  
 70277 Bent 2 - Integral X-beam Details (3 Of 3)  
 70278 Bent 3 - End Beam Details (1 Of 2)  
 70279 Bent 3 - End Beam Details (2 Of 2)  
 70280 Camber Diagram - Spans 1 And 2  
 70281 Longitudinal Beam Layout - Span 4  
 70282 Longitudinal Beam Layout - Span 5  
 70283 Typical Sections - Spans 4 And 5  
 70284 Box Girder Reinforcement - Spans 4 And 5  
 70285 Bent 4 - End Beam Details (1 Of 2)  
 70286 Bent 4 - End Beam Details (2 Of 2)  
 70287 Bent 5 - Integral X-beam Plan And Elevation  
 70288 Bent 5 - Integral X-beam Details (1 Of 2)  
 70289 Bent 5 - Integral X-beam Details (2 Of 2)  
 70290 Bent 6 - End Beam Details (1 Of 2)  
 70291 Bent 6 - End Beam Details (2 Of 2)  
 70292 Camber Diagram - Spans 4 And 5  
 70293 General Details - Post-tensioning  
 70294 Post-tensioning Details And Notes  
 70295 Curved Beam Details  
 70296 Bent 1 - Plan And Elevation  
 70297 Bent 1 - Left Sidewalk Details  
 70298 Bent 1 - Right Sidewalk Details  
 70299 Bent 1 - Sidewalk And Rail Details  
 70300 Bent 1 - Footing Plan  
 70301 Bent 1 - Typical Section And Details  
 70302 Bent 1 - Left Wingwall Plan And Elevation  
 70303 Bent 1 - Right Wingwall Plan And Elevation  
 70304 Bent 1 - Miscellaneous Details  
 70305 Bent 2 - Column And Drilled Shaft  
 70306 Bent 3 - X-beam Plan And Elevation  
 70307 Bent 3 - Column And Drilled Shaft

70308 Bent 3 And 4 - X-beam Details (1 Of 4)  
 70309 Bent 3 And 4 - X-beam Details (2 Of 4)  
 70310 Bent 3 - X-beam Details (3 Of 4)  
 70311 Bent 3 - X-beam Details (4 Of 4)  
 70312 Bent 4 - X-beam Plan And Elevation  
 70313 Bent 4 - Column And Drilled Shaft  
 70314 Bent 5 - Column And Drilled Shaft  
 70315 Column And Drilled Shaft Staging Details  
 70316 Column And Drilled Shaft Details (1 Of 3)  
 70317 Column And Drilled Shaft Details (2 Of 3)  
 70318 Column And Drilled Shaft Details (3 Of 3)  
 70319 Bent 6 - Plan And Elevation  
 70320 Bent 6 - Footing Plan  
 70321 Bent 6 - Typical Section And Details  
 70322 Bent 6 - Right Wingwall Plan And Elevation  
 70323 Bent 6 - Left Wingwall Plan And Elevation  
 70324 Railing Details (1 Of 4)  
 70325 Railing Details (2 Of 4)  
 70326 Railing Details (3 Of 4)  
 70327 Railing Details (4 Of 4)  
 70328 Protective Fencing Details (1 Of 2)  
 70329 Protective Fencing Details (2 Of 2)  
 70330 Bearing Details - Bents 1 And 6 (1 Of 2)  
 70331 Bearing Details - Bents 1 And 6 (2 Of 2)  
 70332 Bearing Details - Bent 3 (1 Of 2)  
 70333 Bearing Details - Bent 3 (2 Of 2)  
 70334 Bearing Details - Bent 4 (1 Of 2)  
 70335 Bearing Details - Bent 4 (2 Of 2)  
 70336 Deck Drainage (1 Of 2)  
 70337 Deck Drainage (2 Of 2)  
 70338 Span 3 Sidewalk Drainage  
 70339 Expansion Joint Details (1 Of 4)  
 70340 Expansion Joint Details (2 Of 4)  
 70341 Expansion Joint Details (3 Of 4)  
 70342 Expansion Joint Details (4 Of 4)  
 70343 Lighting Layout - Span 1 Right Side  
 70344 Lighting Layout - Span 1 Left Side  
 70345 Lighting Layout - Span 2  
 70346 Lighting Layout - Span 3 Right Side - 1  
 70347 Lighting Layout - Span 3 Right Side - 2  
 70348 Lighting Layout - Span 3 Left Side - 1  
 70349 Lighting Layout - Span 3 Left Side - 2  
 70350 Lighting Layout - Span 4  
 70351 Lighting Layout - Span 5  
 70352 Lighting Details - 1  
 70353 Lighting Details - 2  
 70354 Lighting Details - 3  
 70355 Navigation Lights  
 70356 Lighting Circuit Schedule  
 70357 Seismic Restrainer Details (1 Of 2)  
 70358 Seismic Restrainer Details (2 Of 2)  
 70359 Ground Improvement Details  
 70360 Miscellaneous Details (1 Of 2)  
 70361 Miscellaneous Details (2 Of 2)


xref: Odotbr.dwg 0000460 INDEX.dwg

	DATE	REVISION	BY	J. Patton DRAFTED:	 DESIGNER <b>DAVID EVANS AND ASSOCIATES INC.</b> 530 Center Street N.E., Suite 605 Salem Oregon 97301 Phone: 503.361.8635 EXPIRES: 12-31-05	 CONNECTING COMMERCE AND COMMUNITY <b>MULTNOMAH COUNTY BRIDGES</b> TRANSPORTATION DIVISION  <b>OREGON DEPARTMENT OF TRANSPORTATION BRIDGE ENGINEERING SECTION</b>	BRIDGE NO.	MULTNOMAH CHANNEL & PNWR ETC., SAUVIE ISLAND RD.	SHEET
	08/05	Added Dwg. #70315	KWC				20136		2 OF 173
	03/09	As-Constructed	TDF	Shonn Mills CHECKED:			DATE		DRAWING NO.
				Joel Tubbs REVIEWED:			Sept. 2005		70189
							CALC. BOOK	INDEX OF BRIDGE DRAWINGS	


\* - 25'-0" Preferred. Less than 25'-0" requires flagging.

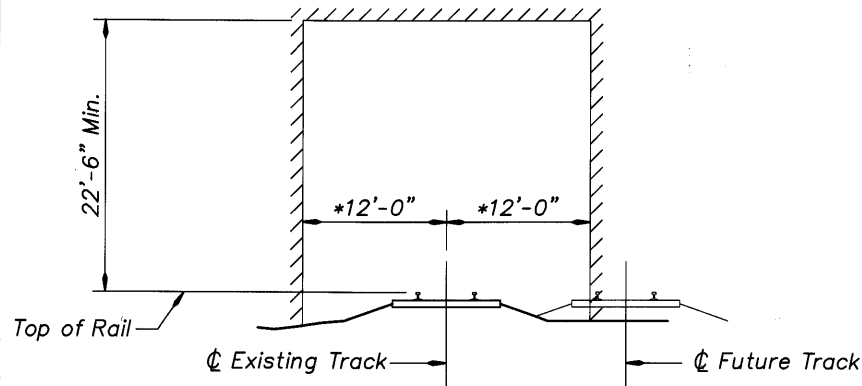

**RAILROAD TEMPORARY CONSTRUCTION CLEARANCE**

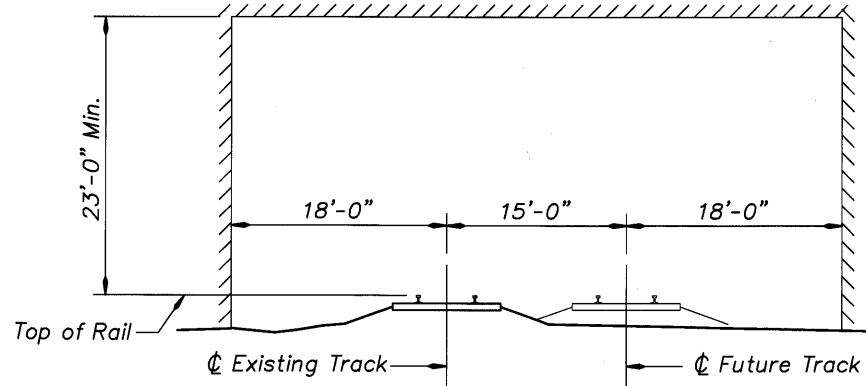


**RAILROAD PERMANENT CLEARANCE**

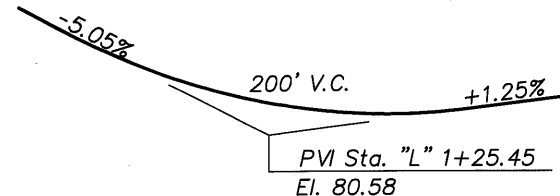


**"L" LINE PROFILE**

No Scale  
 Left Curb Sta. "L" 2+24.87 PT = 30.00' left, Sta. 12+47.36  $\phi$  Roadway  
 See also Dwg. #70208.

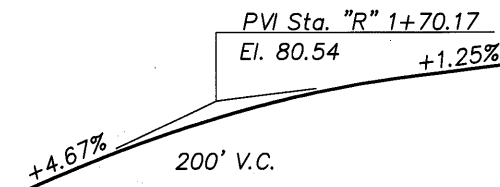


**"R" LINE PROFILE**

No Scale  
 Right Curb Sta. "R" 3+12.73 PT = 18.00' right, Sta. 12+68.09  $\phi$  Roadway  
 See also Dwg. #70207.

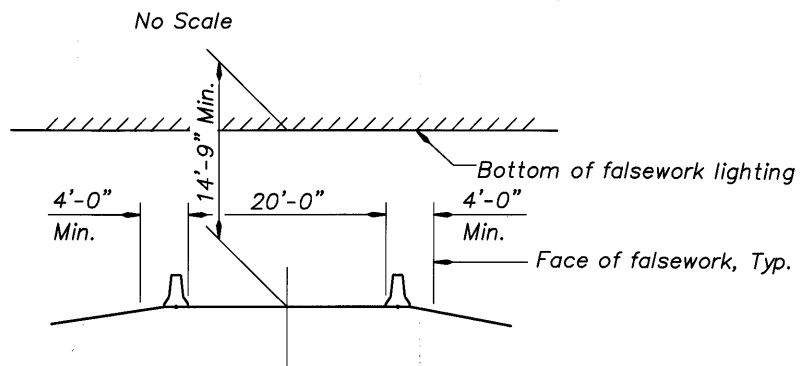


**LARSON ROAD TEMPORARY CONSTRUCTION CLEARANCE**

\*\*Note: Field verify existing roadway width.

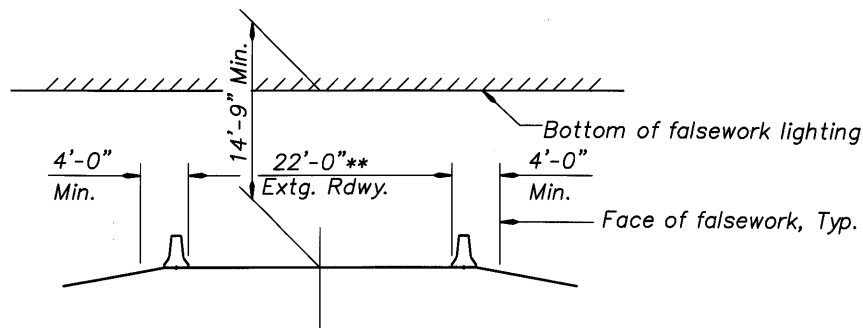

**GILLIHAN LOOP ROAD TEMPORARY CONSTRUCTION CLEARANCE**

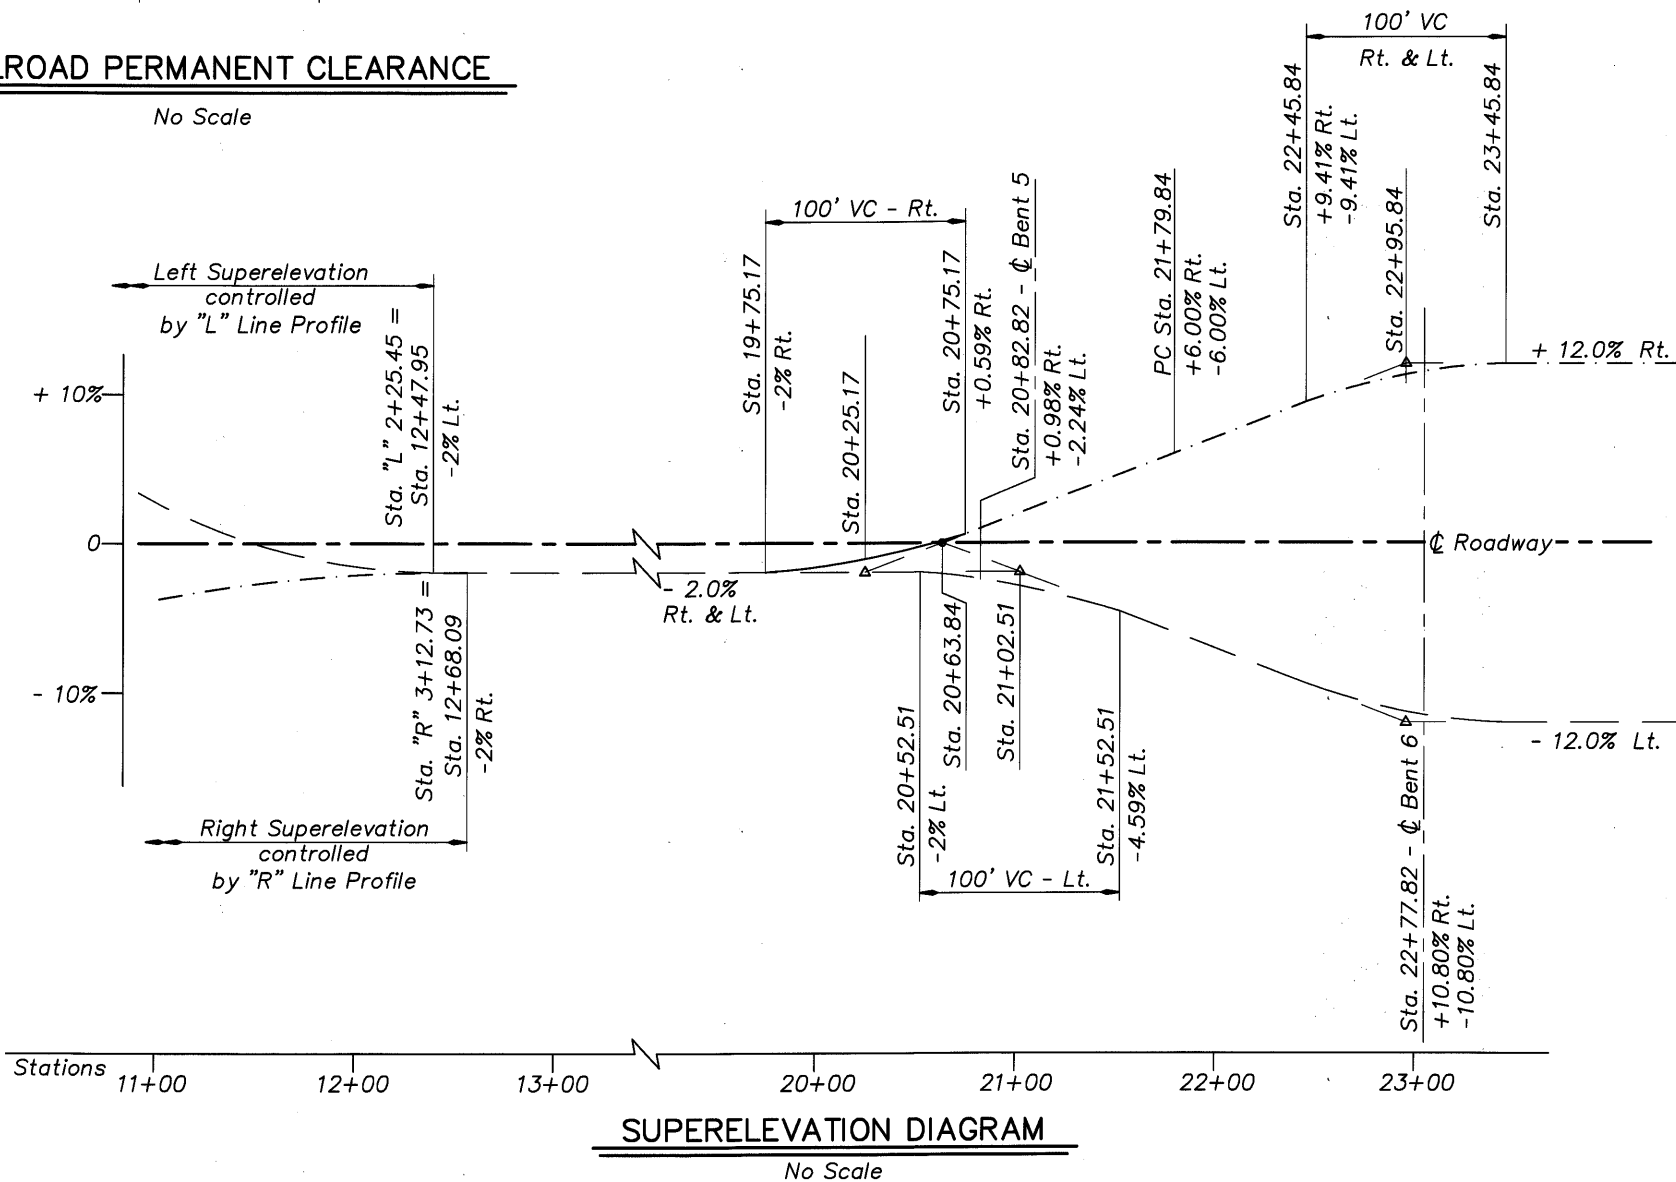

**SUPERELEVATION DIAGRAM**

DO NOT SCALE THIS DRAWING. FOLLOW DIMENSIONS. INDICATED SCALES CORRECT ONLY FOR FULL SIZE SHEET (22"x34").

DATE	REVISION	BY
08/05	Revised Larson Rd. clearance	JBT
03/09	As-Constructed	TDF

DESIGNED BY: J. Patton
CHECKED BY: Shonn Mills
REVIEWED BY: Joel Tubbs

**DESIGNER**

REGISTERED PROFESSIONAL ENGINEER  
 74548 PE  
 OREGON  
 EXPIRES: 12-31-05

**DAVID EVANS AND ASSOCIATES INC.**  
 530 Center Street N.E., Suite 605  
 Salem Oregon 97301  
 Phone: 503.361.8635

CONNECTING COMMERCE AND COMMUNITY

**MULTNOMAH COUNTY BRIDGES**

TRANSPORTATION DIVISION

**OREGON DEPARTMENT OF TRANSPORTATION BRIDGE ENGINEERING SECTION**

BRIDGE NO.	20136
DATE	Sept. 2005
CALC. BOOK	

MULTNOMAH CHANNEL & PNWR ETC., SAUVIE ISLAND RD.

**CLEARANCE AND SUPERELEVATION DIAGRAMS**

SHEET 3 OF 173

DRAWING NO. 70190





**GENERAL NOTES CONT'D:**

**DESIGN CODES and PERFORMANCE CRITERIA:**

Bridge is designed in accordance with the AASHTO LRFD Design Specifications (Third Edition, 2004). Project specific loads are clarified under Design Loads.

The Span 3 Tied Arch structure is designed to meet a maximum live load deflection of 3.60" (L/1200).

The Span 3 Tied Arch structure is designed to be globally redundant to prevent structure collapse from fracture of any single plate or rolled shape, through use of stitch-bolted built-up tension tie-girders and knuckles. The tension tie-girder has been designed for the loss of any single web or flange plate, in accordance with the following special Extreme Event III:

$\eta, \gamma_p$  per AASHTO LRFD Design Specifications, (Third Edition, 2004)

$\gamma_{LL} = 1.30$  for HL-93 Loads

$\gamma_{LL} = 1.10$  for Permit Loads in governing lane and HL-93 Loads in other applicable lanes

Bridge hanger cable assemblies are designed with a minimum factor of safety of 4.0 for breaking strength versus calculated unfactored DL+LL+IM loads. Bridge hanger cable assemblies are also designed for the loss of any one cable with a minimum factor of safety of 3.0 for breaking strength versus calculated DL+LL+IM loads for the remaining cables.

**DESIGN LOADS:**

Bridge is designed for dead loading from self-weight, utility weight of 200 lbs per lineal foot of bridge, and future wearing surface weight of 25 psf of roadway.

Bridge is designed for vehicular live load as follows:

Design lanes consist of an AASHTO HL-93 load (design truck or tandem + lane) or an ODOT Permit 1 Vehicle or an ODOT Permit 2 Vehicle for all AASHTO described limit states except Strength II and Fatigue. The Strength II design lane shall consist of an ODOT Permit 3 Vehicle or ODOT Permit 4 Vehicle or the Multnomah County Permit Vehicle plus one additional design lane as described for all other limit states. The Fatigue limit state shall utilize the code prescribed design live load. The application and number of design lanes follow the criteria described in AASHTO LRFD Design Specifications (Third Edition, 2004).

See schematics of the permit loads below.

Bridge is designed for pedestrian live loading of 75 psf for all but the local design of the cantilevered sidewalk support system in Span 3 which is designed for 85 psf.

Bridge is designed for inspection and maintenance traveler loading of 36 kips (maximum gross weight). The design loading is applied to the pedestrian walk supports in arch portion of the bridge as a moving load. Traveler loading is not applied concurrently with the pedestrian live loading.

Bridge is designed for the following thermal loading:

a) Assumed erection temperature is 52 degrees F.

b) Assumed seasonal temperature variance:


Concrete portions:  
12 degrees F to 82 degrees F

Steel portions:  
-10 degrees F to 120 degrees F

c) Assume +/- 25 degrees F temperature differential between steel members above and below top of tie-girder.

Bridge is designed for vessel collision in accordance with Method I of AASHTO "Guide Specification and Commentary for Vessel Collision Design of Highway Bridges, Volume I: Final Report," February 1991.

Seismic design is by multi-mode elastic analysis in accordance with AASHTO LRFD Design Specifications (Third Edition, 2004). The response modification factors used are R = 5.0 for column moments, R = 3.0 for drilled shaft moments, R = 0.8 for abutment connections, and R = 1.0 for other components. The 1000-year return period response spectra are as follows:

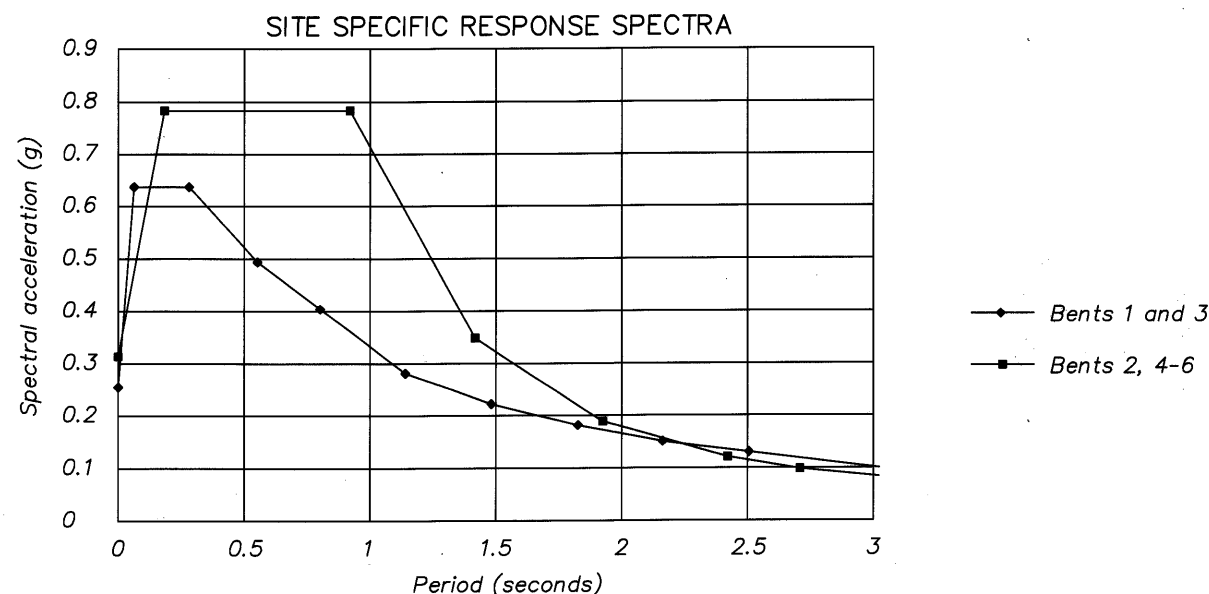


**LIST OF ABBREVIATIONS**


- AWS American Welding Society
- BC Begin curve
- BH Borehole
- Cont'd. Continued
- CSL Crosshole Sonic Logging
- DL Dead Load
- EC End Curve
- Eq. Equal
- FL Flowline
- LOL Layout Line
- LRFD Load and Resistance Factor Design
- OHW Ordinary High Water
- PGL Profile Grade Line
- P.N.W.R. Portland & Western Railroad
- SS Stainless Steel
- sq. square
- U.N.O. Unless noted otherwise
- W.P. Working Point

**PERMIT LOADINGS: (kips)**


**PERMIT 1**

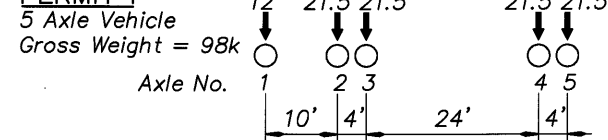


**PERMIT 2**

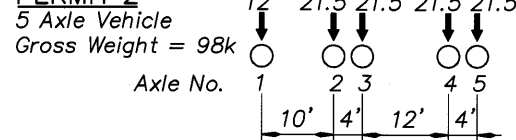


**PERMIT 3**

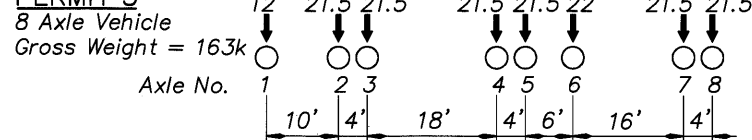


**PERMIT 4**

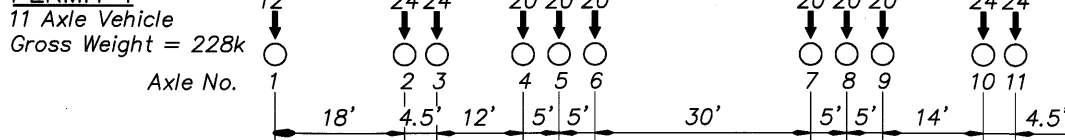

**MULTNOMAH COUNTY PERMIT**


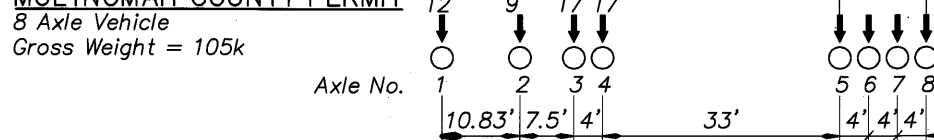


	DATE	REVISION	BY	J. Patton			TRANSPORTATION DIVISION OREGON DEPARTMENT OF TRANSPORTATION BRIDGE ENGINEERING SECTION	BRIDGE NO.	20136	MULTNOMAH CHANNEL & PNWR ETC., SAUVIE ISLAND RD.	SHEET	5
	03/09	As-Constructed	TDF	Shonn Mills				DATE	Sept. 2005		OF	173
				Clifford Coulter				CALC. BOOK			DRAWING NO.	70192
								GENERAL NOTES (2 of 2)				

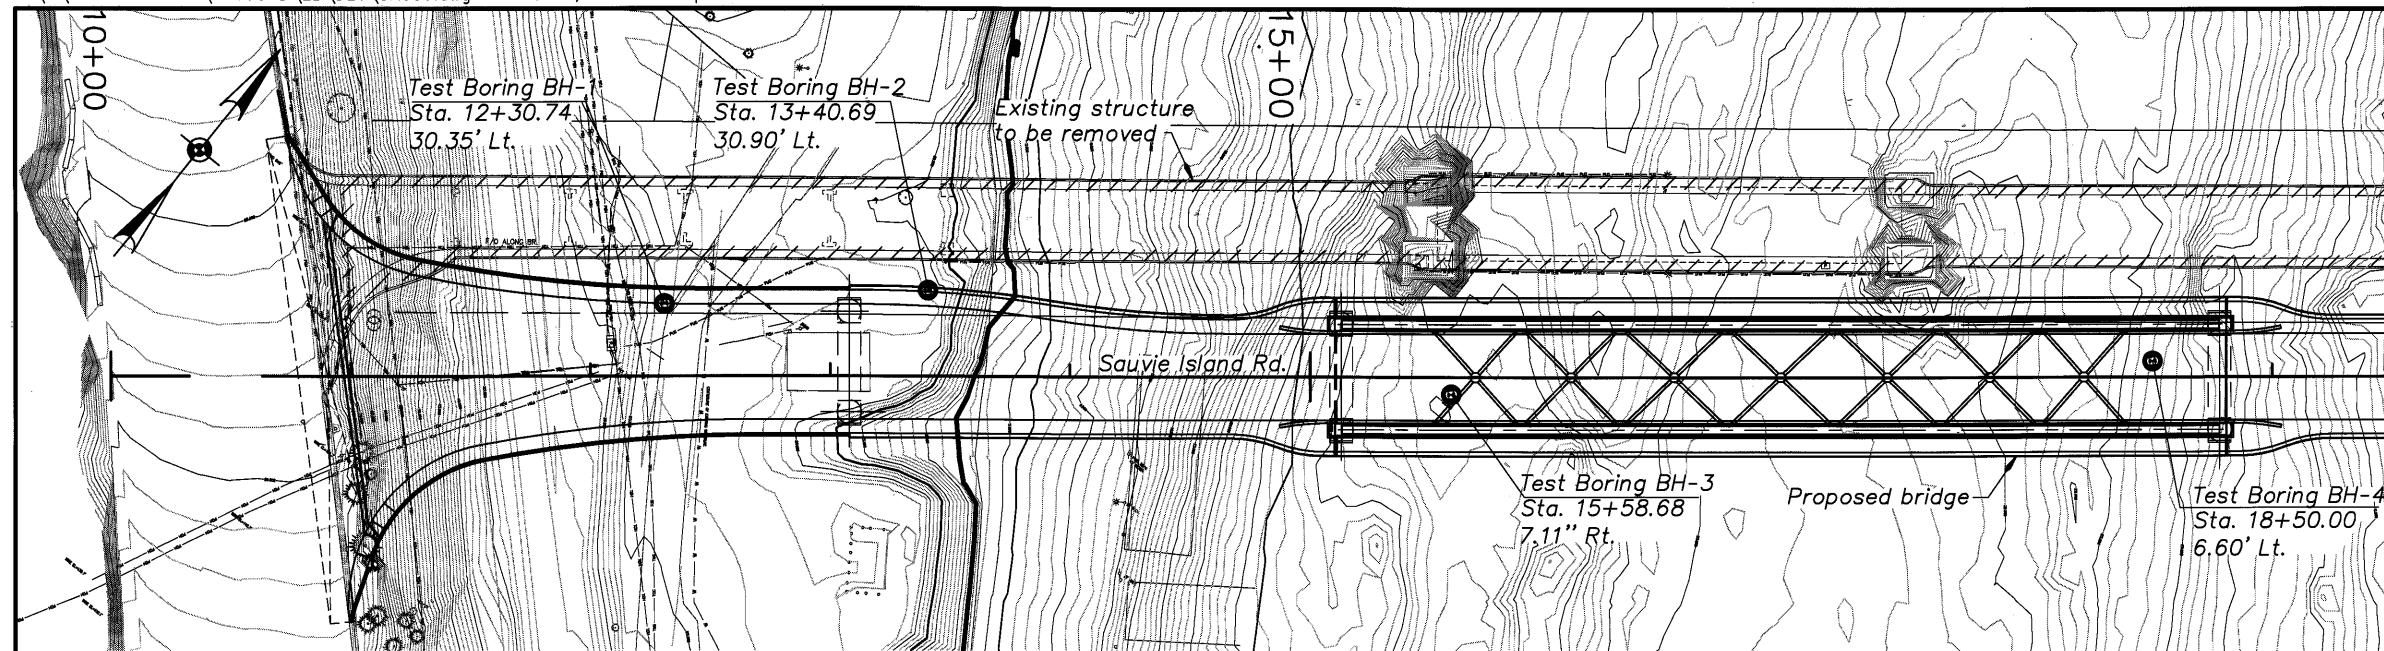

PLAN  
Scale: 1" = 40'

LEGEND OF MATERIALS

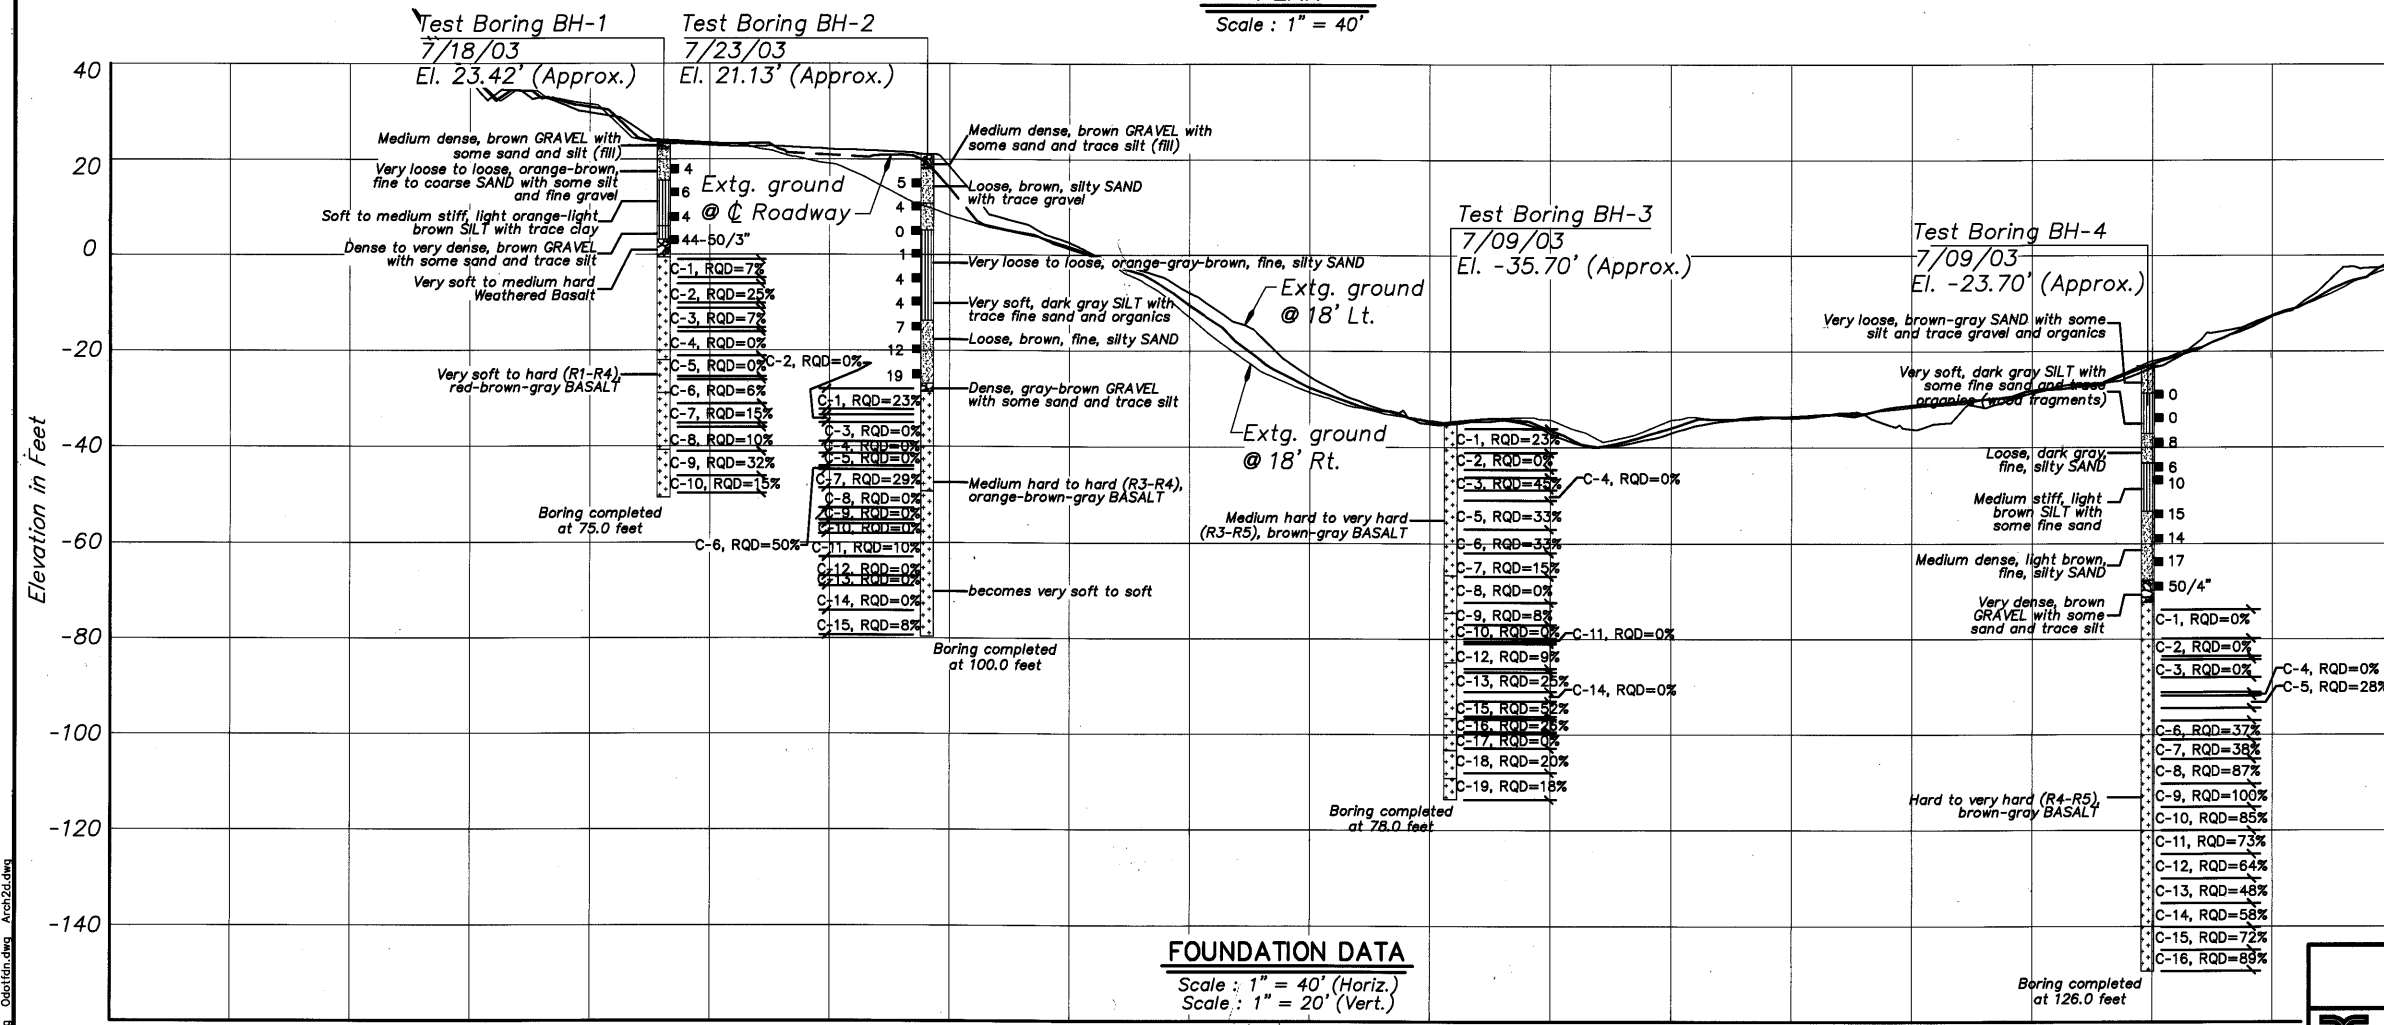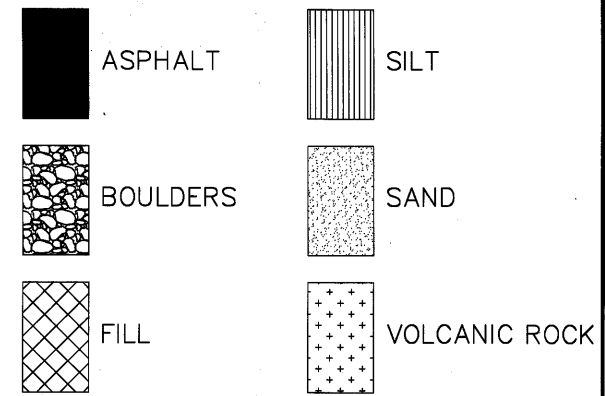

FOUNDATION DATA  
Scale: 1" = 40' (Horiz.)  
Scale: 1" = 20' (Vert.)

24 Standard Penetration Test.  
N value.  
C = Core Sample.  
P = Undisturbed Sample  
RQD = Rock Quality Designation.  
∇ = Elevation Groundwater Encountered

03/09 As-Constructed TDF  
DO NOT SCALE THIS DRAWING.  
FOLLOW DIMENSIONS. INDICATED  
SCALES CORRECT ONLY FOR  
FULL SIZE SHEET (22"x34").

NOTE:  
TEST HOLE LOCATIONS AND ELEVATIONS  
ARE APPROXIMATE.  
FOUNDATION DATA SHOWN ON THIS DRAWING IS A  
CONSOLIDATION OF INFORMATION AND/OR REVISION  
IN TERMINOLOGY FROM THE BORING LOGS. THESE  
LOGS WERE USED IN COMPILING THIS DRAWING AND  
ARE INCLUDED IN THE GEOTECHNICAL REPORT,

DRAFTED: R. Stone  
DESIGNED: Allison Pynch  
REVIEWED: Scott Mills


CHECKED:  
REGISTERED PROFESSIONAL ENGINEER  
50801  
OREGON  
EXPIRES 12/31/05

CONNECTING COMMERCE AND COMMUNITY  
MULTNOMAH COUNTY BRIDGES  
TRANSPORTATION DIVISION  
OREGON DEPARTMENT OF TRANSPORTATION  
BRIDGE ENGINEERING SECTION



BRIDGE NO. 20136  
DATE Sept. 2005

GEOD  
DAVID EVANS AND ASSOCIATES, INC.  
530 Center Street N.E., Suite 605  
Salem Oregon 97301  
Phone: 503.361.8635

MULTNOMAH CHANNEL & PNWR ETC., SAUVIE ISLAND RD.  
FOUNDATION DATA (1 OF 2)  
SHEET 6 OF 173  
DRAWING NO. 70193

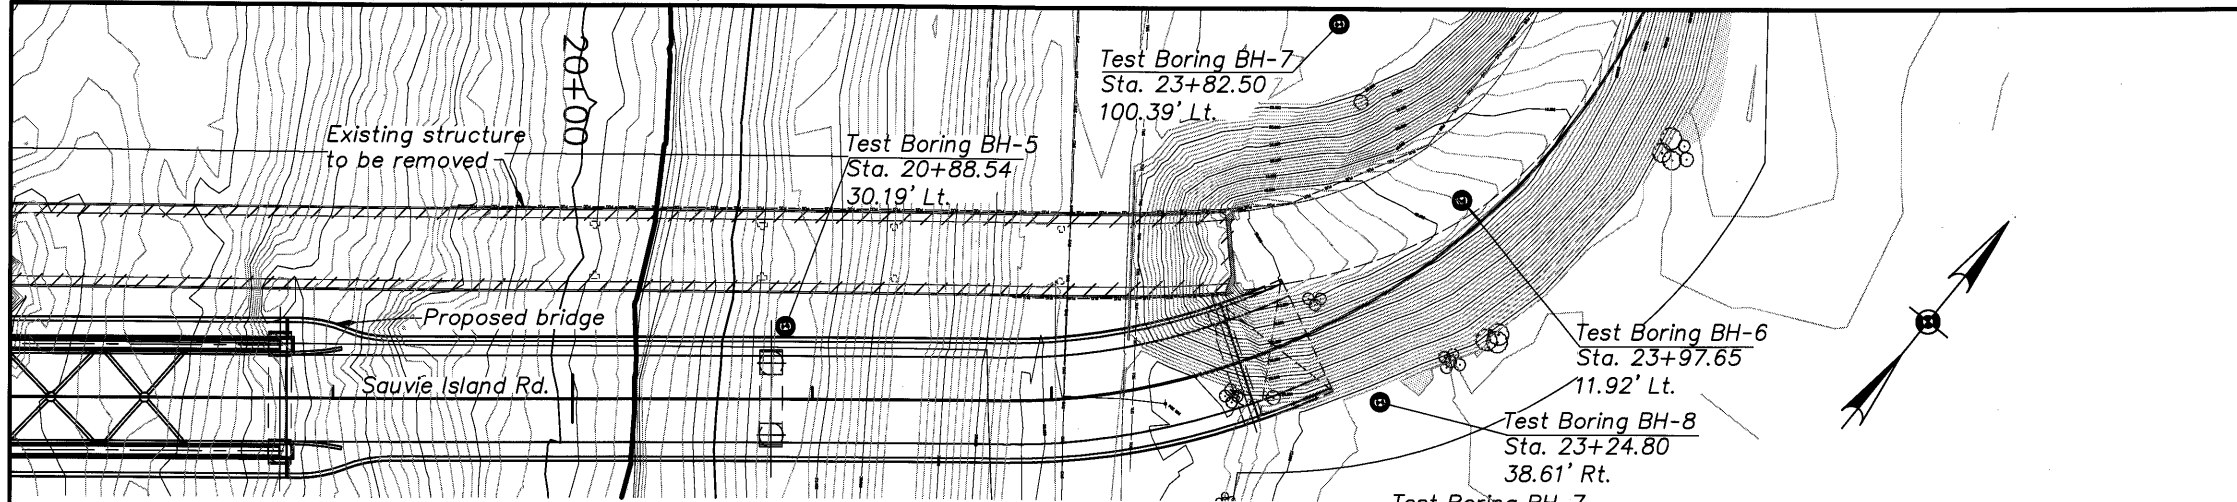

**LEGEND OF MATERIALS**

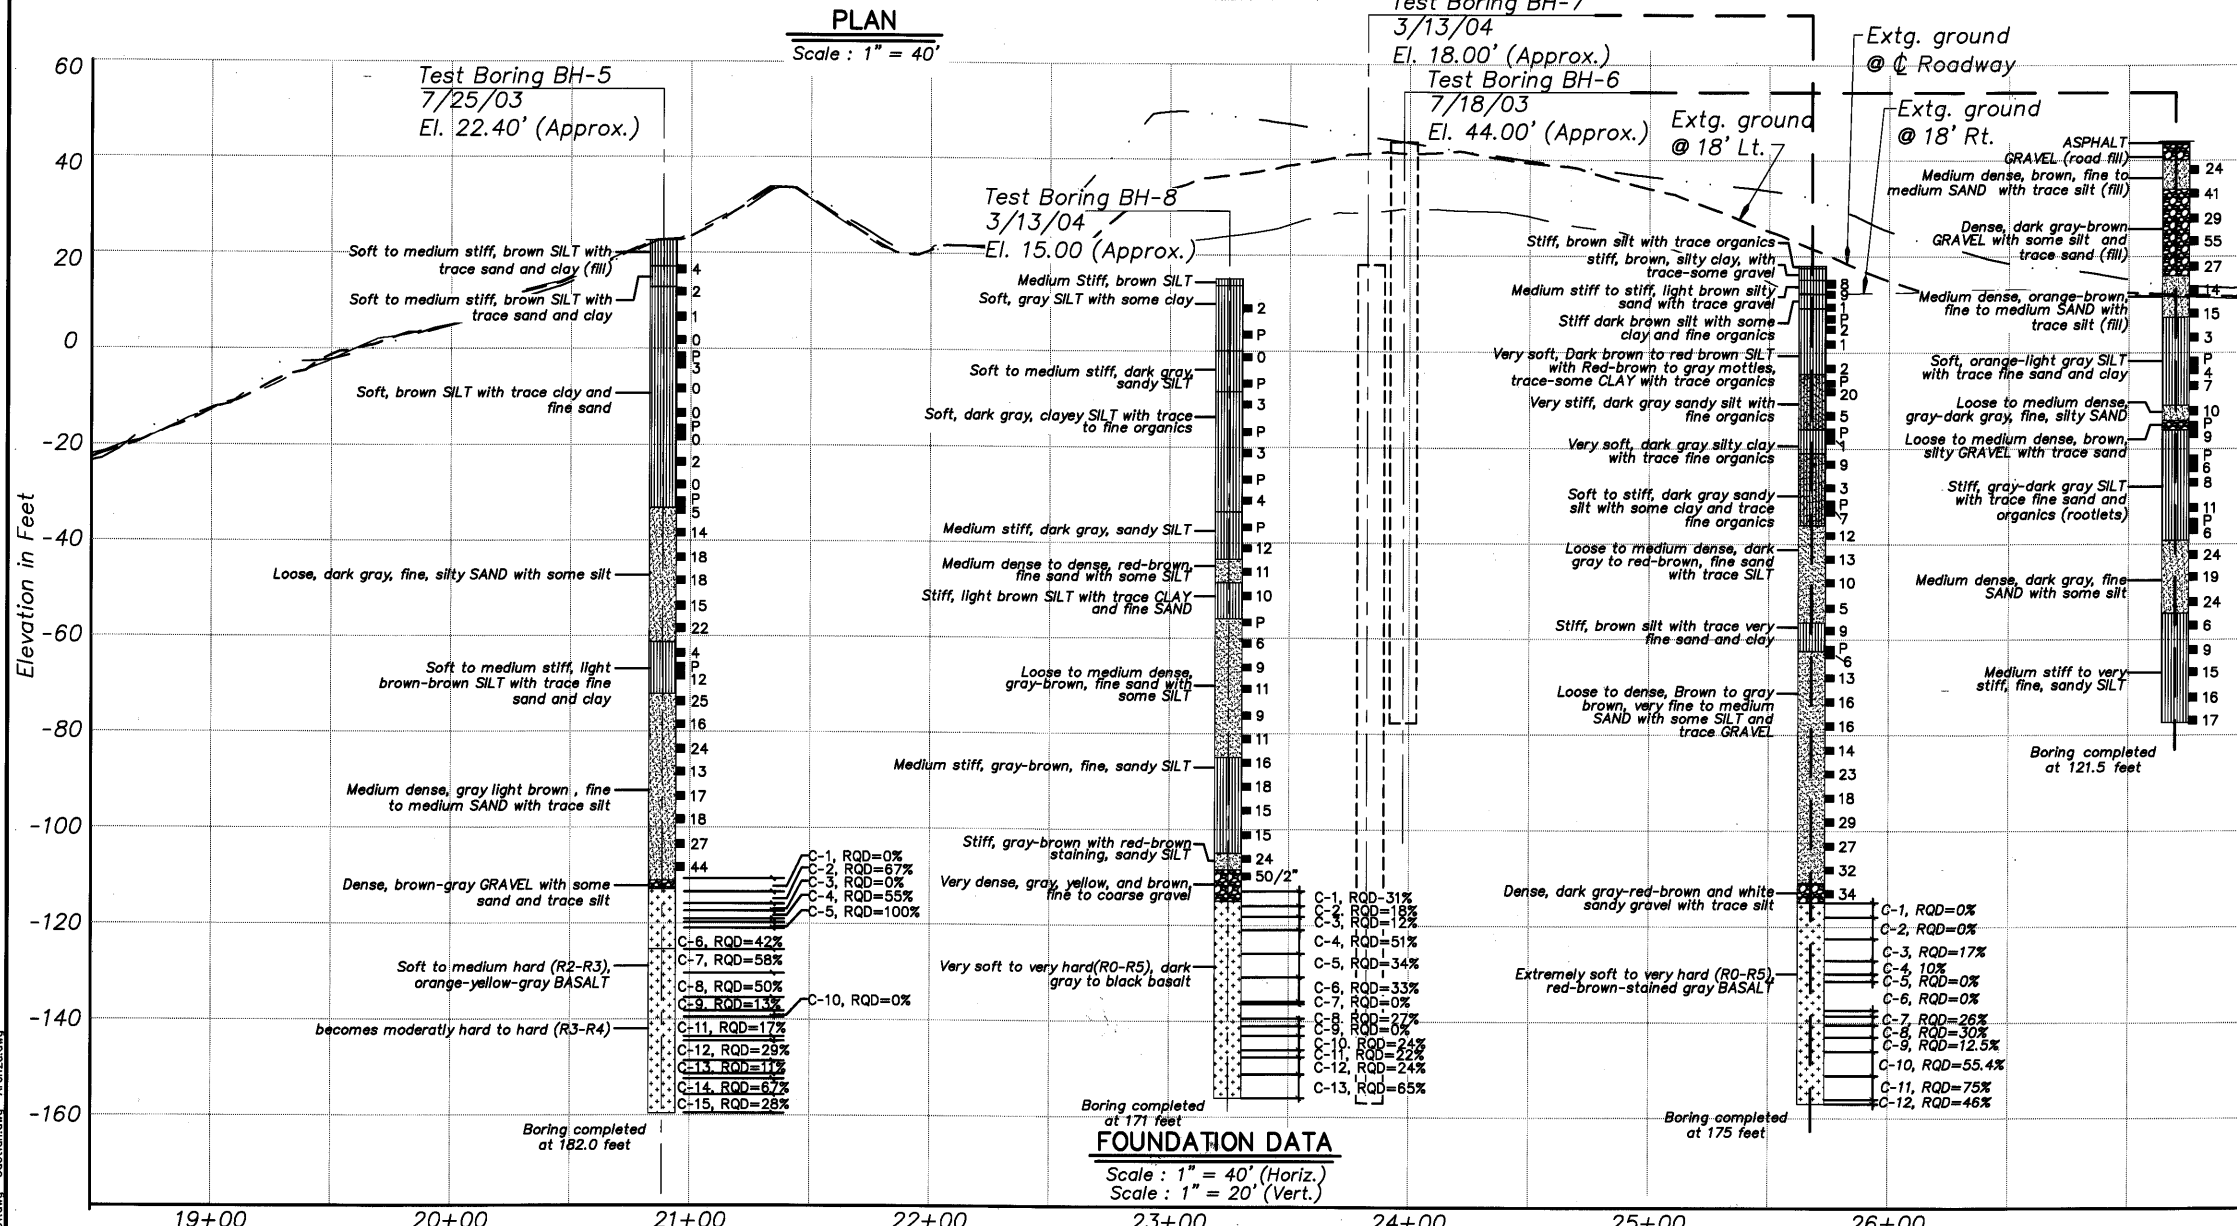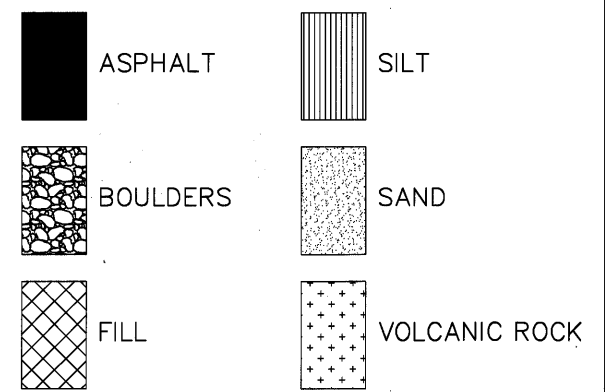

24 Standard Penetration Test.  
N value.

C = Core Sample.  
P = Undisturbed Sample  
RQD = Rock Quality Designation.  
∇ = Elevation Groundwater Encountered

03/09 As-Constructed TDF

**DO NOT SCALE THIS DRAWING.**  
FOLLOW DIMENSIONS. INDICATED  
SCALES CORRECT ONLY FOR  
FULL SIZE SHEET (22"x34").

**GEODESIGN**  
DAVID EVANS AND ASSOCIATES, INC. 530 Center Street N.E., Suite 605  
Salem Oregon 97301  
Phone: 503.361.8635

**NOTE:**  
TEST HOLE LOCATIONS AND ELEVATIONS  
ARE APPROXIMATE.

FOUNDATION DATA SHOWN ON THIS DRAWING IS A  
CONSOLIDATION OF INFORMATION AND/OR REVISION  
IN TERMINOLOGY FROM THE BORING LOGS. THESE  
LOGS WERE USED IN COMPILING THIS DRAWING AND  
ARE INCLUDED IN THE GEOTECHNICAL REPORT,

DRAFTED: R. Stone  
DESIGNED: Allison Pyrch  
REVIEWED: Scott Mills


CHECKED: [Professional Engineer Seal]  
EXPRES 125M05

CONNECTING COMMERCE AND COMMUNITY  
**MULTNOMAH COUNTY**  
BRIDGES  
TRANSPORTATION DIVISION  
**OREGON DEPARTMENT OF TRANSPORTATION**  
BRIDGE ENGINEERING SECTION


BRIDGE NO.  
20136  
DATE  
Sept. 2005

MULTNOMAH CHANNEL & PNWR ETC., SAUVIE ISLAND RD.  
FOUNDATION DATA (2 OF 2)

SHEET  
7  
OF  
173  
DRAWING NO.  
70194

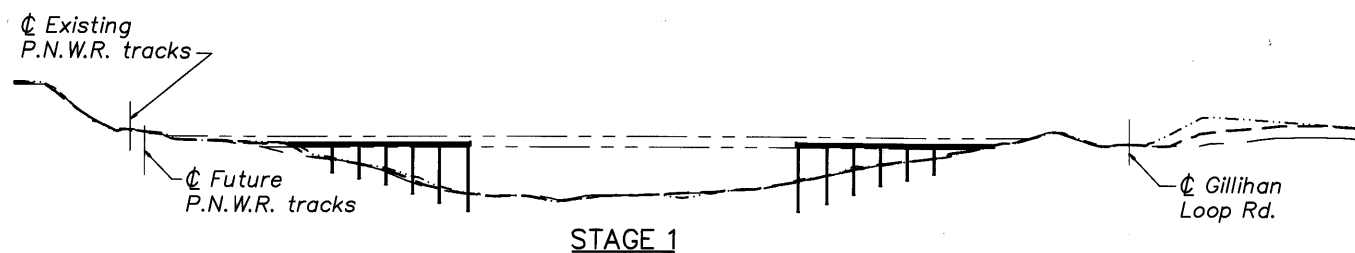


**Stage 1: (In-Water Work)**  
 Construct temporary work bridges to Bents 3 and 4.  
 See Temporary Work Bridge Plan Dwg. #70203.

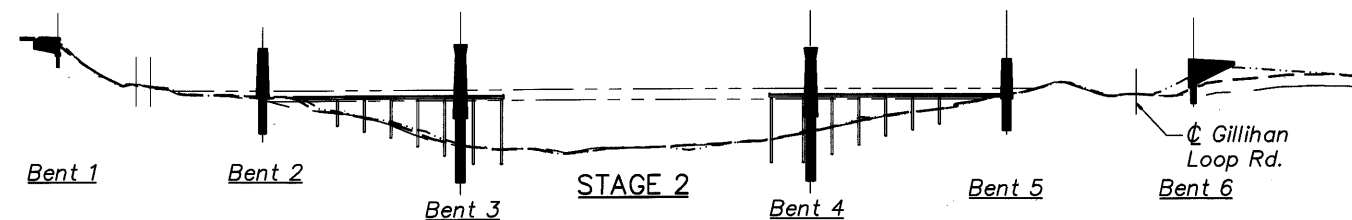


**Stage 2: (A portion is In-Water Work)**  
 Install grout tubes at existing Bents 3-4.  
 Stabilize existing bridge substructure at existing Bents 7-11. See Dwg. #70202 for bent locations.  
 Construct stone columns.  
 Remove existing bridge deck overhang and sidewalk (portion) as required for construction of temporary trestle, temporary roadway barrier required.  
 Construct temporary trestle and shift traffic.  
 Remove portion of existing Bent 1 and spans 1 and 2. See Dwg. #70202 for limits.  
 Temporary roadway barrier required.  
 Construct drilled shafts at Bent 1 (portion) and Bents 2-6.

**Stage 2: (cont'd.)**  
 Construct Bent 1 (portion).  
 Construct columns at Bents 2 and 5.  
 Construct columns and crossbeams at Bents 3 and 4.  
 Construct Bent 6 (portion).

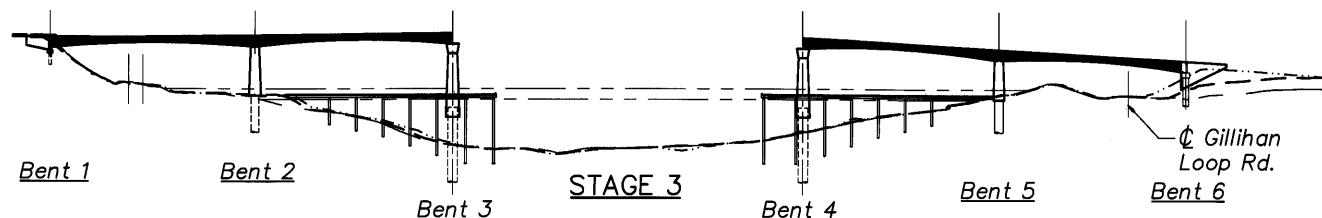

**Stage 3: (A portion is In-Water Work)**  
 Erect falsework, span 1 (portion\*), span 2, span 4, and span 5.  
 Construct span 1 (portion\*), span 2, span 4, and span 5.  
 Construct Bent 1 end panel (portion).

\* Longitudinal beams 1-8 and 8a.

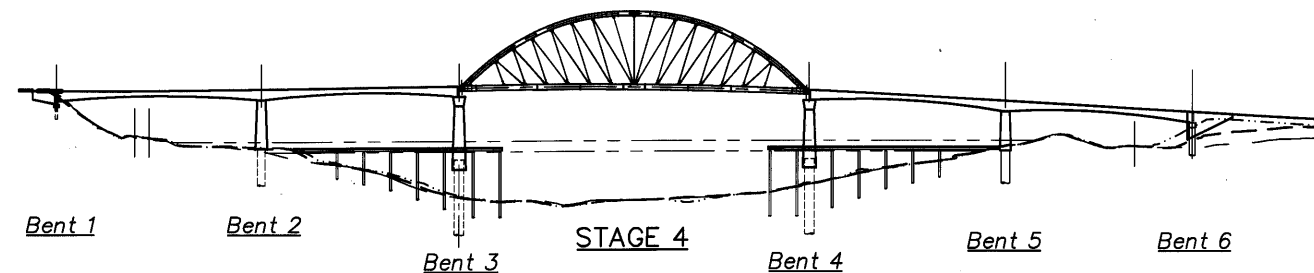

**Stage 4:**  
 Construct arch span. See Arch Erection drawings, Dwg. #70197-#70199.  
 Route traffic onto new bridge. Temporary roadway barrier required.  
 Remove temporary trestle.  
 Remove existing spans 1-3 and Bents 1 & 2 (remaining portions)

**Notes:**

1. See Traffic Control Plan drawings for additional requirements and details.
2. See Arch Erection Schemes, Dwg. #70197-#70199, for arch erection requirements at span 3.
3. See Deck Plan - Span 1 Left Side, Dwg. #70208 for construction joint locations for staged construction.


DO NOT SCALE THIS DRAWING.  
 FOLLOW DIMENSIONS. INDICATED  
 SCALES CORRECT ONLY FOR  
 FULL SIZE SHEET (22"x34").

Xref: Odotbr.dwg, ODOT0460\_CS\_02.dwg, Sauvie\_BLDWG\_NEWSAUvie\_Arch01.dwg, Arch23.dwg


△ 08/05 Revised Columns BY: J. Patton DRAFTED: KWC 03/09 As-Constructed CHECKED: Shonn Mills TDF REVIEWED: Clifford Coulter	DESIGNER DAVID EVANS AND ASSOCIATES INC. 530 Center Street N.E., Suite 605 Salem Oregon 97301 Phone: 503.361.8635	CONNECTING COMMERCE AND COMMUNITY TRANSPORTATION DIVISION BRIDGE NO. 20136 DATE Sept. 2005 CALC. BOOK	MULTNOMAH CHANNEL & PNWR ETC., SAUVIE ISLAND RD. CONSTRUCTION SEQUENCE (1 OF 2)	SHEET 8 OF 173 DRAWING NO. 70195






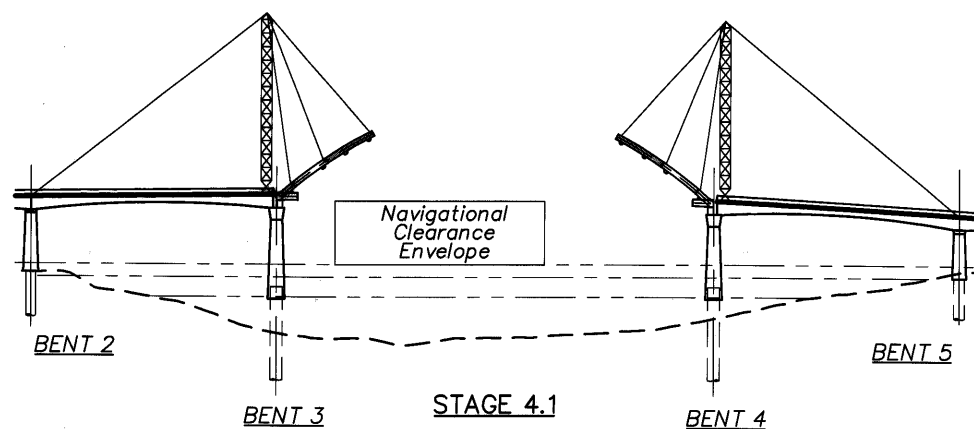


4.1a. Erect stay towers and backstay cables.  
4.1b. Erect knuckles and begin arch erection, including top lateral bracing.

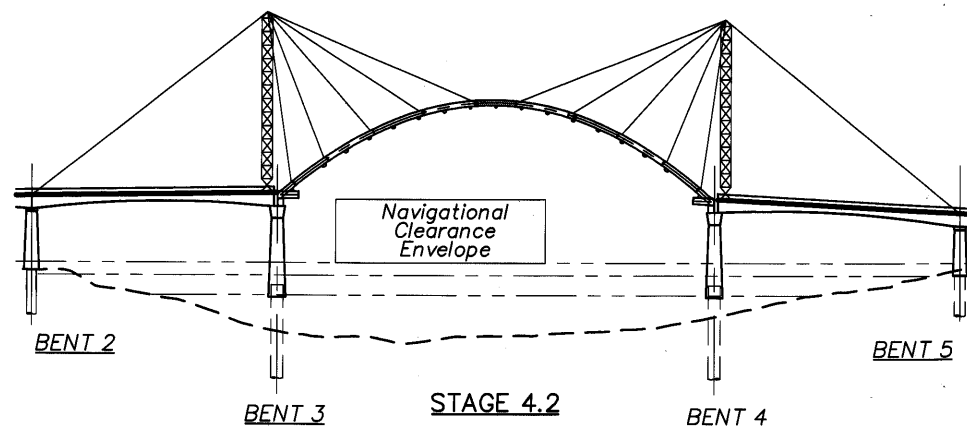


4.2a. Complete arch rib and top lateral bracing erection.

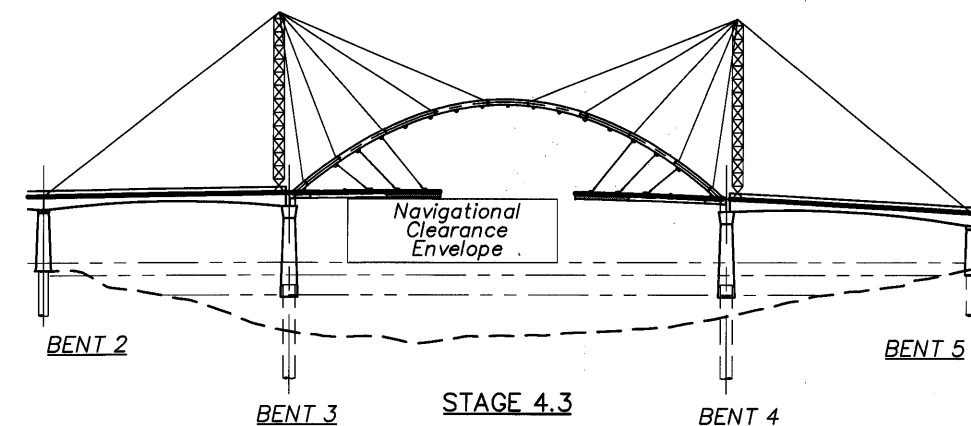


4.3a. Begin tie-girder erection, utilizing inclined cables. Include floor system.

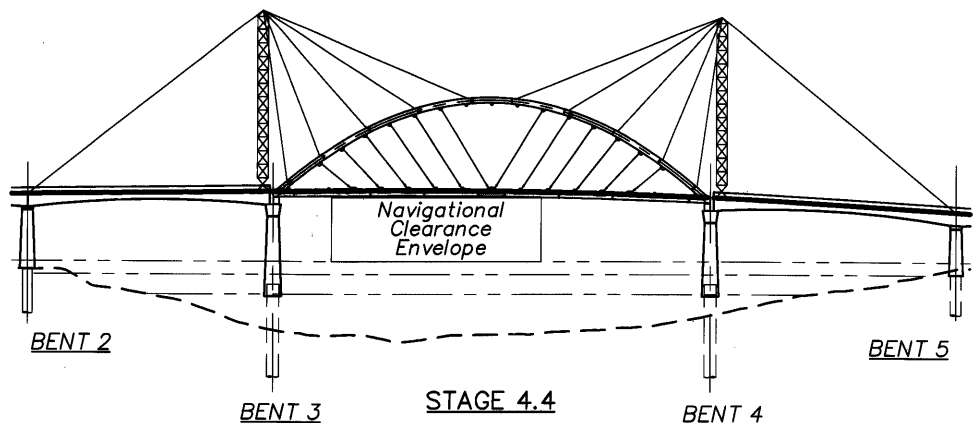

4.4a. Adjust arch geometry before closing tie-girder.  
4.4b. Complete tie-girder and floor system erection.

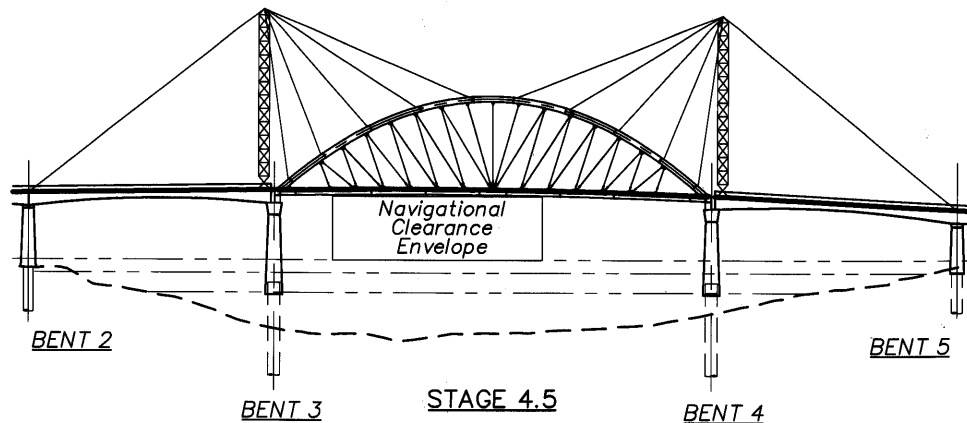

4.5a. Install remaining cables.

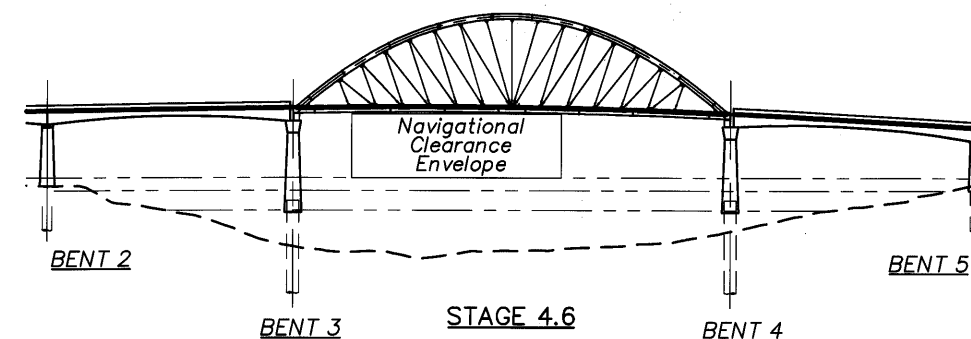

4.6a. Remove stay towers and supporting cables.  
4.6b. Adjust cable tensioning.  
4.6c. See Dwg. #70199. for remaining stages.

DO NOT SCALE THIS DRAWING.  
FOLLOW DIMENSIONS. INDICATED  
SCALES CORRECT ONLY FOR  
FULL SIZE SHEET (22"x34").

**STAYED TOWER ERECTION SCHEME**  
No Scale

DATE	REVISION	BY	J. Patton
08/05	Revised Columns	KWC	DRAFTED:
03/09	As-Constructed	TDF	CHECKED: Oliver Mueller
			DESIGNED: Gernot Komar

**REVIEWED**

REGISTERED PROFESSIONAL ENGINEER  
774548 PE  
OREGON  
MARCH 09, 2004  
WILLIAM CORRY

**DAVID EVANS AND ASSOCIATES INC.**  
530 Center Street N.E., Suite 605  
Salem Oregon 97301  
Phone: 503.361.8635

EXPIRES: 12-31-05

CONNECTING COMMERCE AND COMMUNITY


**MULTNOMAH COUNTY BRIDGES**

TRANSPORTATION DIVISION

**OREGON DEPARTMENT OF TRANSPORTATION BRIDGE ENGINEERING SECTION**


BRIDGE NO.	20136	MULTNOMAH CHANNEL & PNWR ETC., SAUVIE ISLAND RD.	SHEET 10 OF 173
DATE	Sept. 2005		
CALC. BOOK		ARCH ERECTION SCHEMES (1 OF 3)	DRAWING NO. 70197

Xref: D:\odot\460\_05\_01.dwg

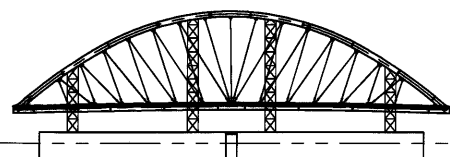


**STAGE 4.1**

- 4.1a. Fabricate tied arch structure off-site.
- 4.1b. Install temporary arch rib/tie-girder bracing.
- 4.1c. Support completed tied arch steel superstructure on low blocking on barges.
- 4.1d. All cables are installed, but remain slack.

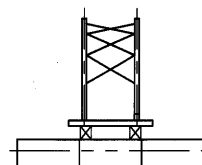


**STAGE 4.2**

- 4.2a. Prepare bridge for jacking. Add stabilizing barges as required.

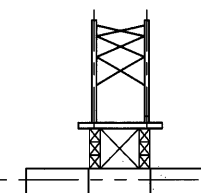


**STAGE 4.3**

- 4.3a. Initiate bridge jacking and blocking operation, maintaining stability at all times.

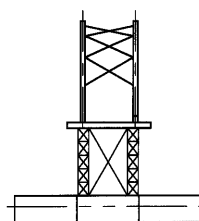


**STAGE 4.4**

- 4.4a. Raise bridge sufficiently to clear bearing seats.
- 4.4b. Maneuver barges into position adjacent to main span.

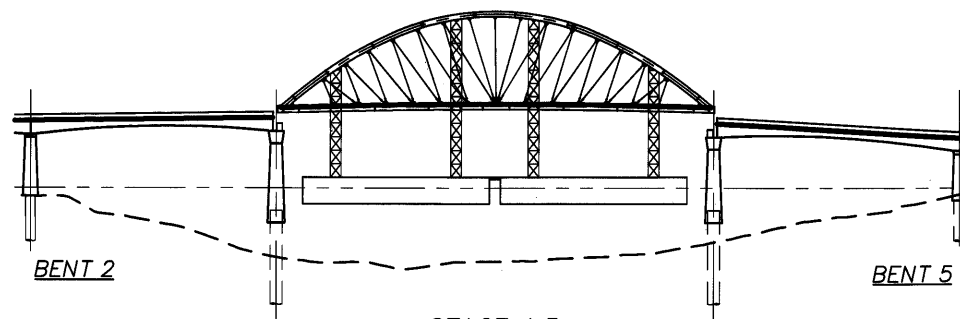

**STAGE 4.5**

- 4.5a. Maneuver bridge over bearing seats.
- 4.5b. Lower bridge onto bearings.
- 4.5c. Remove slack from cable (ZERO Tension) C2, C4, C6, C8, C10, C12, C16, C18, C20, C22, C24, and C26 (See Dwg. #70217).

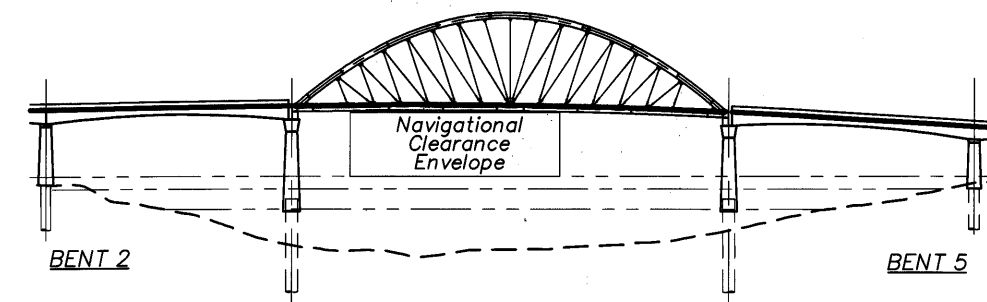

**STAGE 4.6**

- 4.6a. Remove jacks, blocking, barges and temporary arch bracing. Some cables remain slack before arch rib/tie-girder bracing is removed. (See Dwg. #70217)
- 4.6b. Adjust cable tensioning.
- 4.6c. See Dwg. #70199 for remaining stages.

**DROP-IN ERECTION SCHEME**


No Scale

DO NOT SCALE THIS DRAWING. FOLLOW DIMENSIONS. INDICATED SCALES CORRECT ONLY FOR FULL SIZE SHEET (22"x34").

REVISION DATE BY	08/05	Revised Columns	KWC	J. Patton	REVIEWED REGISTERED PROFESSIONAL ENGINEER OREGON MARCH 09, 2004 KENT WILLIAMS CORROTL	DAVID EVANS AND ASSOCIATES INC. 530 Center Street N.E., Suite 605 Salem Oregon 97301 Phone: 503.361.8635	CONNECTING COMMERCE AND COMMUNITY MULTNOMAH COUNTY BRIDGES TRANSPORTATION DIVISION	BRIDGE NO. 20136	MULTNOMAH CHANNEL & PNWR ETC., SAUVIE ISLAND RD.	SHEET 11 OF 173.
	03/09	As-Constructed	TDF	Oliver Mueller						
ARCH ERECTION SCHEMES (2 OF 3)										

### SPAN 3 TIED ARCH-ERECTION NOTES

1. Two possible methods of erecting the Span 3 steel tied arch span are shown on Dwg #70197 and #70198, as follows:
  - a) Stayed Tower Erection Scheme involves erecting the steel superstructure in final location utilizing temporary towers set over Bents 3 and 4 to suspend the arch ribs, tie-girders, and other steel elements.
  - b) Drop-In Erection Scheme involves off-site erection of the complete steel superstructure, then transporting it to the site on barges and erecting it onto the bents.
2. These two erection schemes have been shown for information only. The actual construction sequence and method of construction is the sole responsibility of the Contractor.
3. Erection of the tied arch span on falsework placed in the river channel is not permitted.
4. Develop and submit for review a complete erection scheme in advance of the beginning of steel fabrication. Do not perform the work until erection scheme has been reviewed by Engineer. Design all temporary shoring, towers, stay cables, floating barges, jacking systems, and all other temporary structures and equipment required to accomplish the proposed erection scheme. Design any required temporary bracing for the tied arch structure, and demonstrate that temporary member stresses Do Not exceed the allowable limits per the AASHTO Specifications. Obtain the endorsement seal of a Professional Engineer licensed in the State of Oregon on all drawings, calculations, and written procedures pertaining to the proposed erection scheme.
5. The erection data presented on Dwg. #70215, #70216, #70217, and #70218 pertains to the specific drop-in arch erection scheme, and is shown for information only. Develop and submit for review arch erection, cable tension, and deck elevation data for each stage of the Contractor's proposed erection scheme. Demonstrate that the Final Deformed Geometry is identical to that shown on Dwg. #70217.
6. Slack cables are not active in the structure, and are installed with an obvious sag. ZERO tension cables have sufficient initial tension to remove obvious kinks and sags, and become active in the structure. A minimum of 10 kips will be required to achieve the ZERO tension condition.
7. Major reconfiguration of designed bridge components of the steel tied arch span or the concrete approach spans to accommodate the proposed erection scheme is not permitted. Minor modifications to accommodate the proposed erection scheme may be submitted for approval by the Engineer. Do not alter the external appearance of the structure.
8. The Contractor is responsible for the stability of the structure and all temporary work during all stages of erection. The Contractor is responsible for the hydrodynamic stability of any floating erection scheme at all times, and under all anticipated weather conditions. Review of the proposed erection scheme will not relieve the Contractor of the responsibility for the safety of the methods or equipment used, or from carrying out the work in accordance with the plans and specifications.
9. Obtain copies of all project permits, and conform to all environmental, right-of-way, navigation, and other site constraints and requirements, during the erection of the bridge. Refer to the Special Provisions.

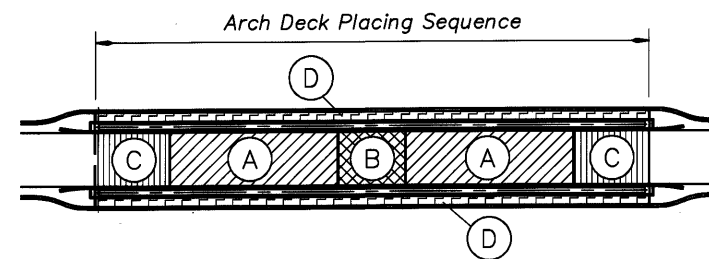


STAGE 4.7

4.7. Place concrete deck in sequence indicated:

- 4.7a. Pour concrete deck Segment (A)
- 4.7b. Pour concrete deck Segment (B)
- 4.7c. Pour concrete deck Segment (C)
- 4.7d. Pour concrete sidewalk Segment (D)

Refer to Dwg #70210 and #70211 for details and specific locations of above concrete segments.

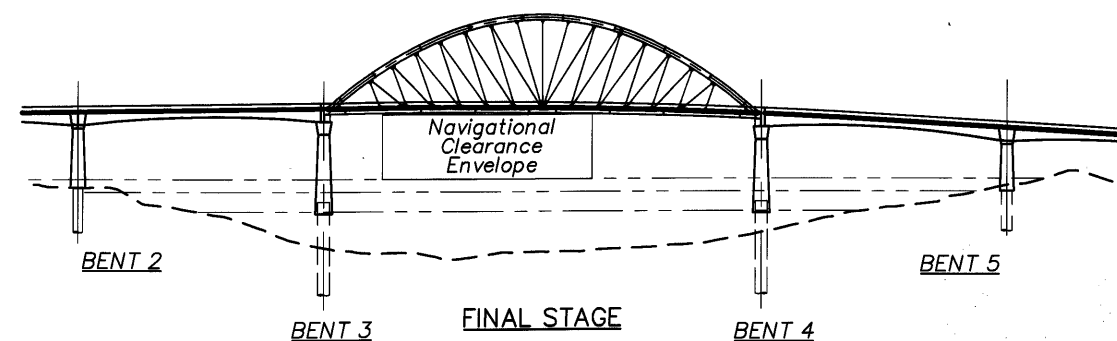


- a. Add railings.
- b. Add expansion joints.

DO NOT SCALE THIS DRAWING.  
FOLLOW DIMENSIONS. INDICATED  
SCALES CORRECT ONLY FOR  
FULL SIZE SHEET (22"x34").

Xref: Odolbr.dwg, 0000460.dwg

<table border="1"> <thead> <tr> <th>DATE</th> <th>REVISION</th> <th>BY</th> </tr> </thead> <tbody> <tr> <td>08/05</td> <td>Revised Columns</td> <td>KWC</td> </tr> <tr> <td>03/09</td> <td>As-Constructed</td> <td>TDF</td> </tr> </tbody> </table>	DATE	REVISION	BY	08/05	Revised Columns	KWC	03/09	As-Constructed	TDF	DRAFTED: J. Patton CHECKED: Oliver Mueller DESIGNED: Clifford Coulter	REVIEWED DAVID EVANS AND ASSOCIATES INC. 530 Center Street N.E., Suite 605 Salem Oregon 97301 Phone: 503.361.8635	CONNECTING COMMERCE AND COMMUNITY <b>MULTNOMAH COUNTY BRIDGES</b> TRANSPORTATION DIVISION <b>OREGON DEPARTMENT OF TRANSPORTATION BRIDGE ENGINEERING SECTION</b>	BRIDGE NO. 20136 DATE Sept. 2005 CALC. BOOK	MULTNOMAH CHANNEL & PNWR ETC., SAUVIE ISLAND RD. ARCH ERECTION SCHEMES (3 OF 3)	SHEET 12 OF 173 DRAWING NO. 70199
	DATE	REVISION	BY												
08/05	Revised Columns	KWC													
03/09	As-Constructed	TDF													

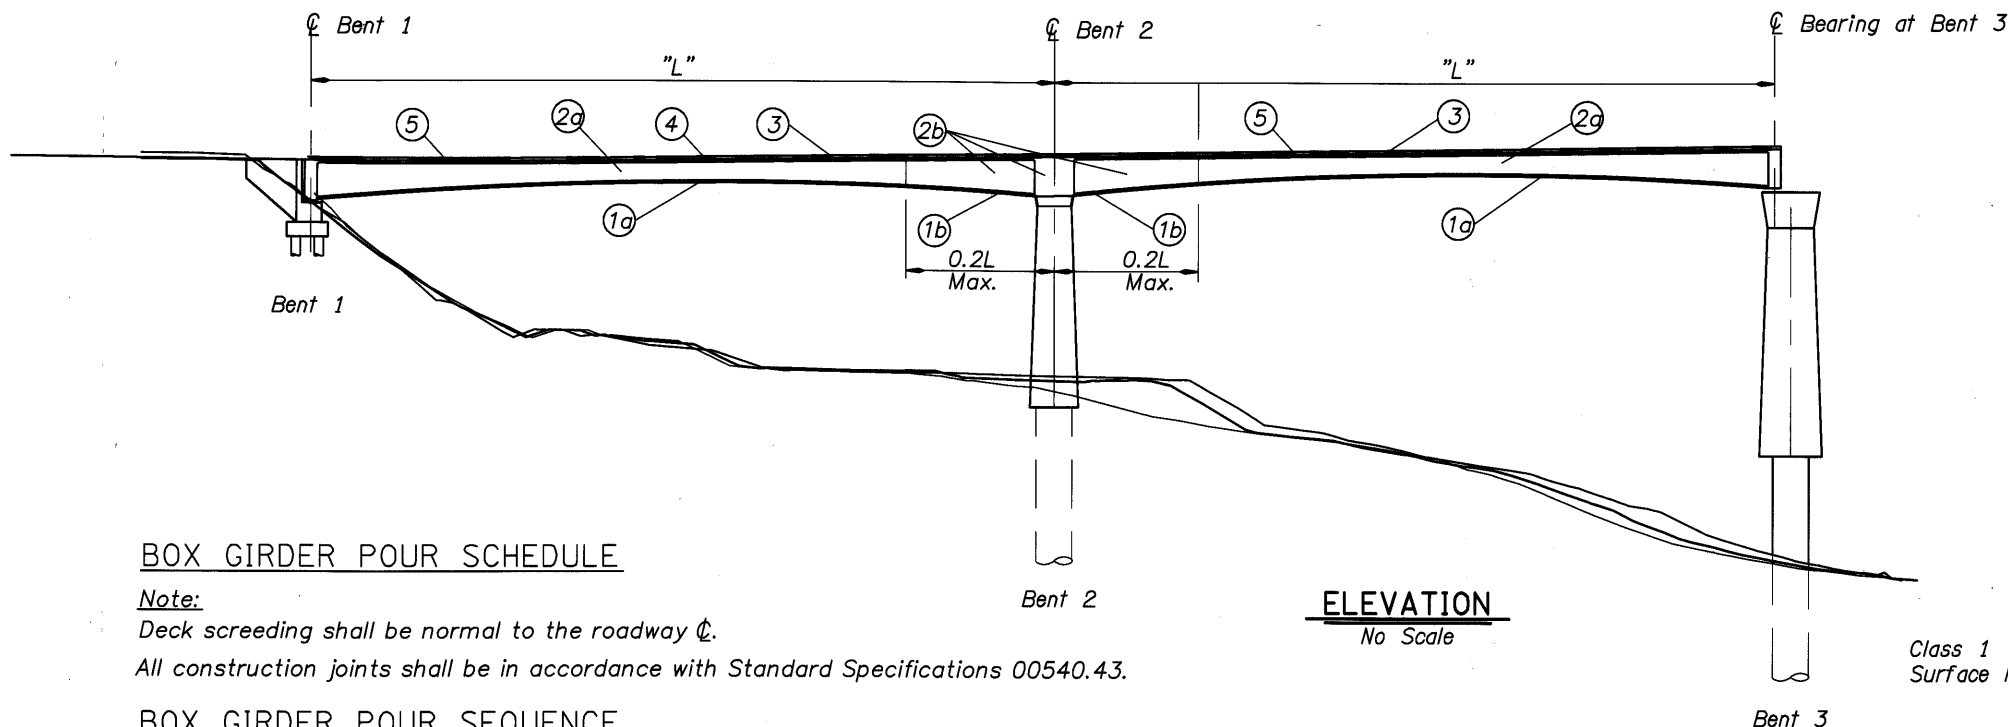

**BOX GIRDER POUR SCHEDULE**

**Note:**

Deck screeding shall be normal to the roadway  $\hat{c}$ .

All construction joints shall be in accordance with Standard Specifications 00540.43.


**BOX GIRDER POUR SEQUENCE**

1. Pours (1a) and (1b) are the bottom slab. Stop Pours (1) at falsework bent and not at a permanent bent. Delay a minimum of 3 days between adjacent Pours (1). Complete all Pours (1a) prior to starting Pours (1b). Complete all Pours (1) prior to starting Pours (2).
2. Pours (2a) and (2b) are the longitudinal and transverse beams to the bottom of the fillets. Stop (2) over a falsework bent. Delay the start of Pour (2) a minimum of 3 days after bottom slab Pours (1) are complete. Delay a minimum of 3 days between adjacent Pours (2). Complete all adjacent Pours (2a) prior to starting Pours (2b).
3. Pours (3) include the fillets and deck slab. Pours (3) to be delayed a minimum of 3 days after completion of all Pours (2). Pours (3) may be stopped over any transverse beam, with the use of a deck construction joint. Delay a minimum of 5 days between adjacent Pour (3). Bulkheads for deck pours shall not be removed until at least 3 days after completion of the pour. Deck pours may be extended over any part of a span or spans as long as they meet these requirements.
4. Pour (4) includes the deck slab closure pour between longitudinal beams 4 and 5 in span 1. Delay a minimum of 5 days after completing all pours (3).
5. Pour (5) includes the sidewalks. Delay a minimum of 5 days after completing all pours (3).
6. Box girder pour sequence is shown for longitudinal beams 1-8 and 8a. Longitudinal beam 1a is similar.

**CONSTRUCTION SEQUENCE**

See Dwg. #70195 and #70196

**ELEVATION**  
No Scale

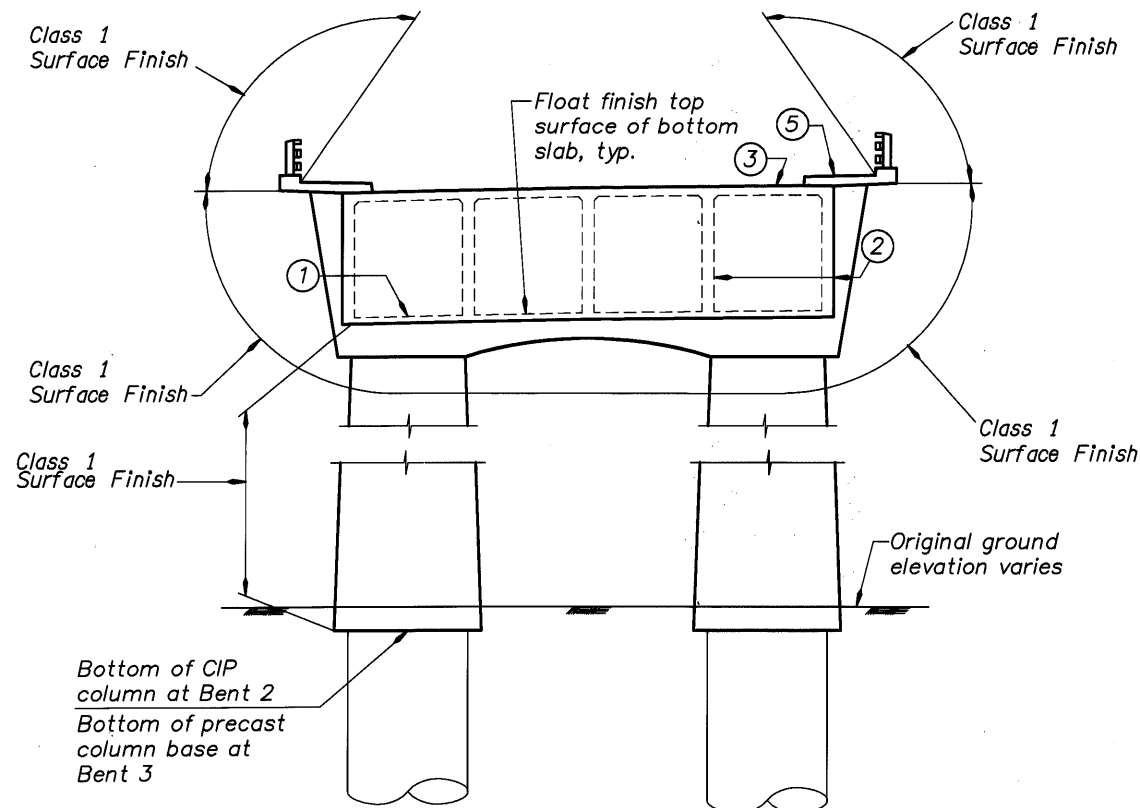


**CONCRETE FINISH DETAILS**

No Scale

DO NOT SCALE THIS DRAWING.  
FOLLOW DIMENSIONS. INDICATED  
SCALES CORRECT ONLY FOR  
FULL SIZE SHEET (22"x34").

	DATE	REVISION	BY	DRAFTED: Ken Johnson CHECKED: Josh Hewes REVIEWED: Steve Thoman			TRANSPORTATION DIVISION OREGON DEPARTMENT OF TRANSPORTATION BRIDGE ENGINEERING SECTION	BRIDGE NO.	MULTNOMAH CHANNEL & PNWR ETC., SAUVIE ISLAND RD.	SHEET 13 OF 173.
	08/05	Revised Columns	KWC					20136		
	03/09	As-Constructed	TDF		EXPIRES: 12-31-05			Sept. 2005		
								CALC. BOOK	BOX GIRDER CONCRETE PLACEMENT SPANS 1 AND 2	

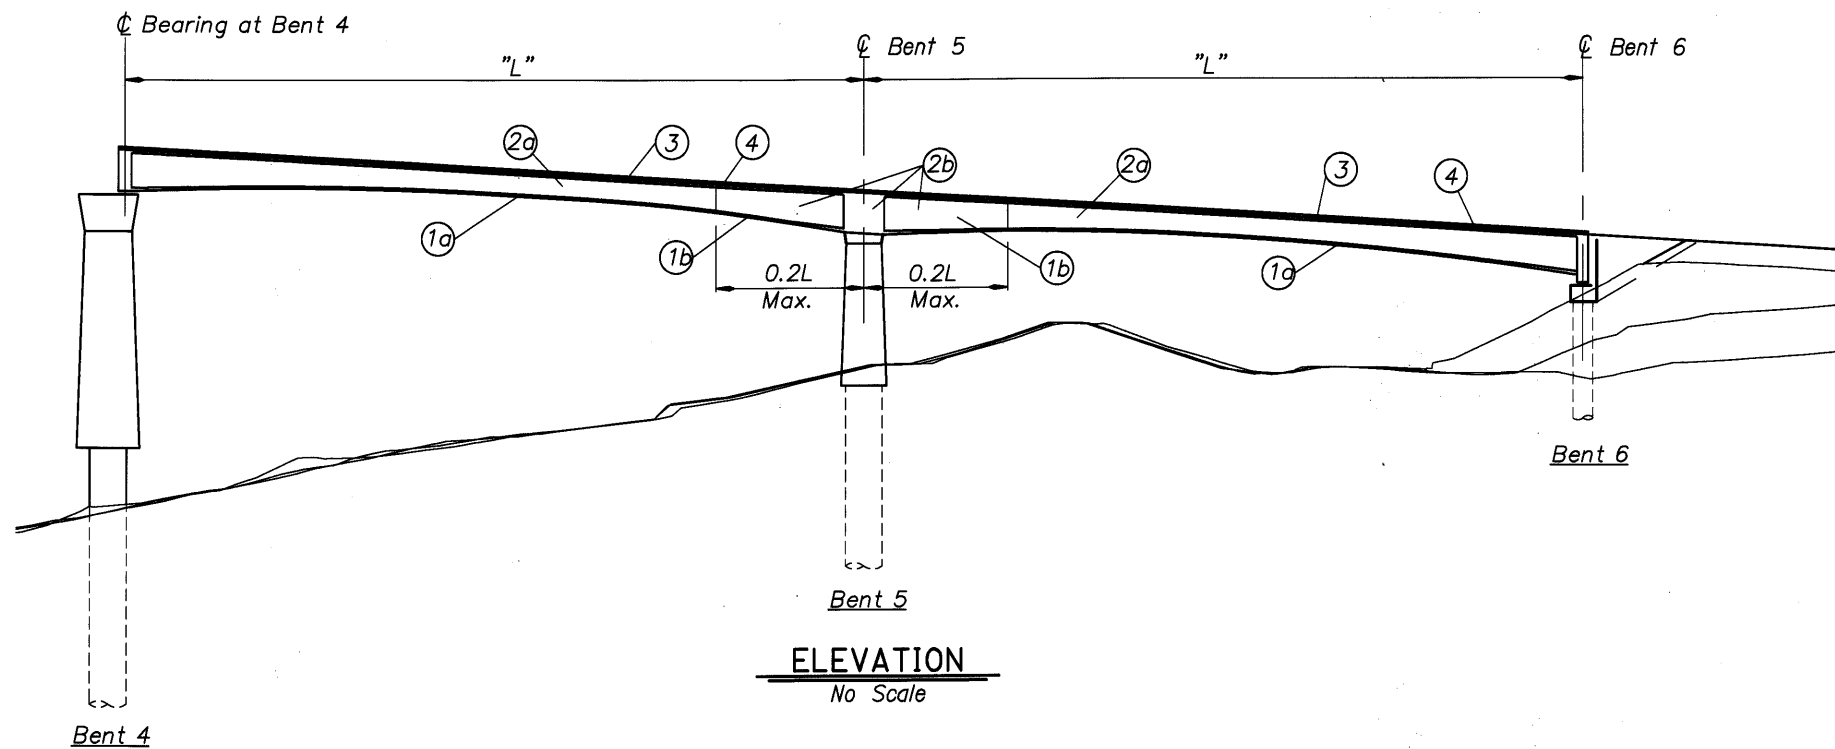

**BOX GIRDER POUR SCHEDULE**

Note:

Deck screeding shall be normal to the roadway  $\phi$ .


All construction joints shall be in accordance with Standard Specifications 00540.43.

**BOX GIRDER POUR SEQUENCE**

1. Pours ①a and ①b are the bottom slab. Stop Pours ① at falsework bent and not at a permanent bent. Delay a minimum of 3 days between adjacent Pours ①. Complete all Pours ①a prior to starting Pours ①b. Complete all Pours ① prior to starting Pours ②.
2. Pours ②a and ②b are the longitudinal and transverse beams to the bottom of the fillets. Stop ② over a falsework bent. Delay the start of Pour ② a minimum of 3 days after bottom slab Pours ① are complete. Delay a minimum of 3 days between adjacent Pours ②. Complete all adjacent Pours ②a prior to starting Pours ②b.
3. Pours ③ include the fillets and deck slab. Pours ③ to be delayed a minimum of 3 days after completion of all Pours ②. Pours ③ may be stopped over any transverse beam, with the use of a deck construction joint. Delay a minimum of 5 days between adjacent Pour ③. Bulkheads for deck pours shall not be removed until at least 3 days after completion of the pour. Deck pours may be extended over any part of a span or spans as long as they meet these requirements.
4. Pour ④ includes the sidewalks, Delay a minimum of 5 days after completing all pours ③.

**CONSTRUCTION SEQUENCE**


See Dwg. #70195 and #70196

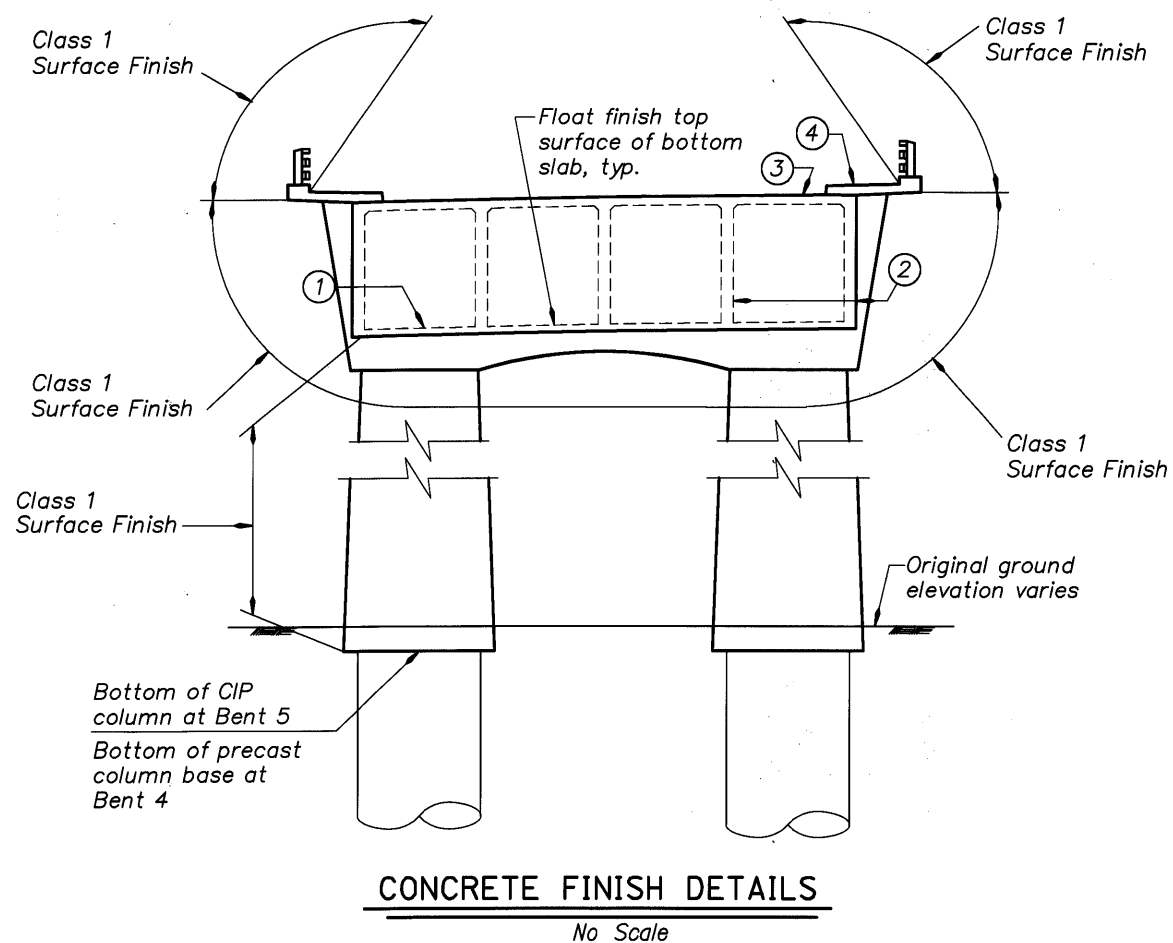

DO NOT SCALE THIS DRAWING.  
FOLLOW DIMENSIONS. INDICATED  
SCALES CORRECT ONLY FOR  
FULL SIZE SHEET (22"x34").

	DATE	REVISION	BY	DESIGNER			BRIDGE NO.	MULTNOMAH CHANNEL & PNWR ETC., SAUVIE ISLAND RD.	SHEET 14 OF 173.
	08/05	Revised Columns	KWC	Ken Johnson			20136		
	03/09	As-Constructed	TDF	Adrienne Dietrich	EXPIRES: 12-31-05	DAVID EVANS AND ASSOCIATES INC. 530 Center Street N.E., Suite 605 Salem Oregon 97301 Phone: 503.361.8635	DATE	BOX GIRDER CONCRETE PLACEMENT SPANS 4 AND 5	DRAWING NO. 70201
				Steve Thoman	OREGON DEPARTMENT OF TRANSPORTATION BRIDGE ENGINEERING SECTION	Sept. 2005			



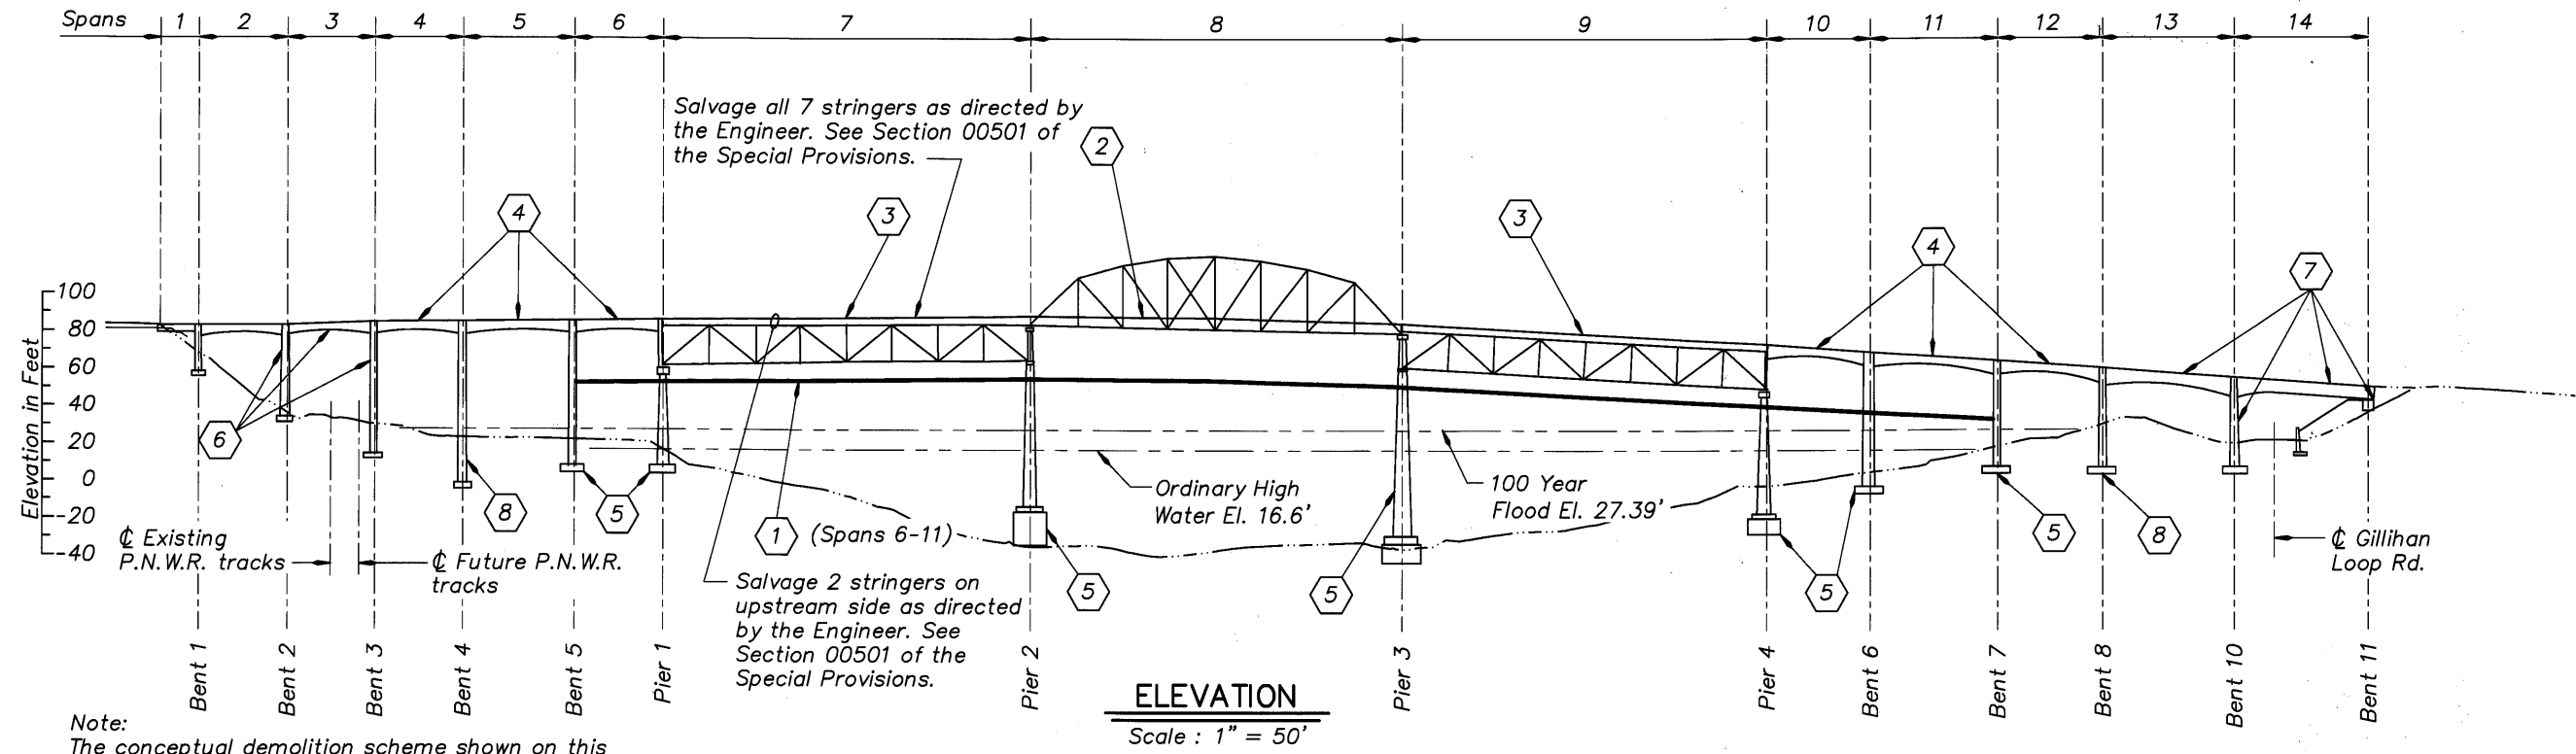


Note:  
The conceptual demolition scheme shown on this drawing has been shown for information only. The actual demolition sequence and method of demolition is the sole responsibility of the Contractor.

Remove existing structure to the limits specified in the Standard Specifications except as follows:  
Piers 2-4 and Bent 6: Remove to existing grade.  
Bent 8: Remove to 1-foot below existing grade.  
See plans for additional requirements.

**DEMOLITION SEQUENCE**

Note: Spans 1 - 3, and bents 1 and 2, to be removed during new bridge construction stages. See Demolition Plan - Existing Spans 1-3 and Dwg. #70195 and #70196.  
Coordinate construction and demolition sequences.

- Stage ①: Place debris containment system beneath spans 6 through 11.
- Stage ②: Remove concrete portions of deck, walks and rails, span 8. Remove remainder of span 8, intact, for disposal as hazardous materials.
- Stage ③: Repeat Stage 2 sequence for spans 7 and 9.
- Stage ④: Remove superstructure, spans 4 through 6, and 10 through 12.
- Stage ⑤: (A portion is In-Water Work)  
Remove bent 5, piers 1-4, and bents 6-7.
- Stage ⑥: (48 hour P.N.W.R. Closure)  
Remove remaining portions of spans 1-3 and bents 1-3.
- Stage ⑦: (24 hour Gillihan Loop Road Closure)  
Remove spans 13 and 14, and bents 10 and 11.
- Stage ⑧: Remove bents 4 and 8.


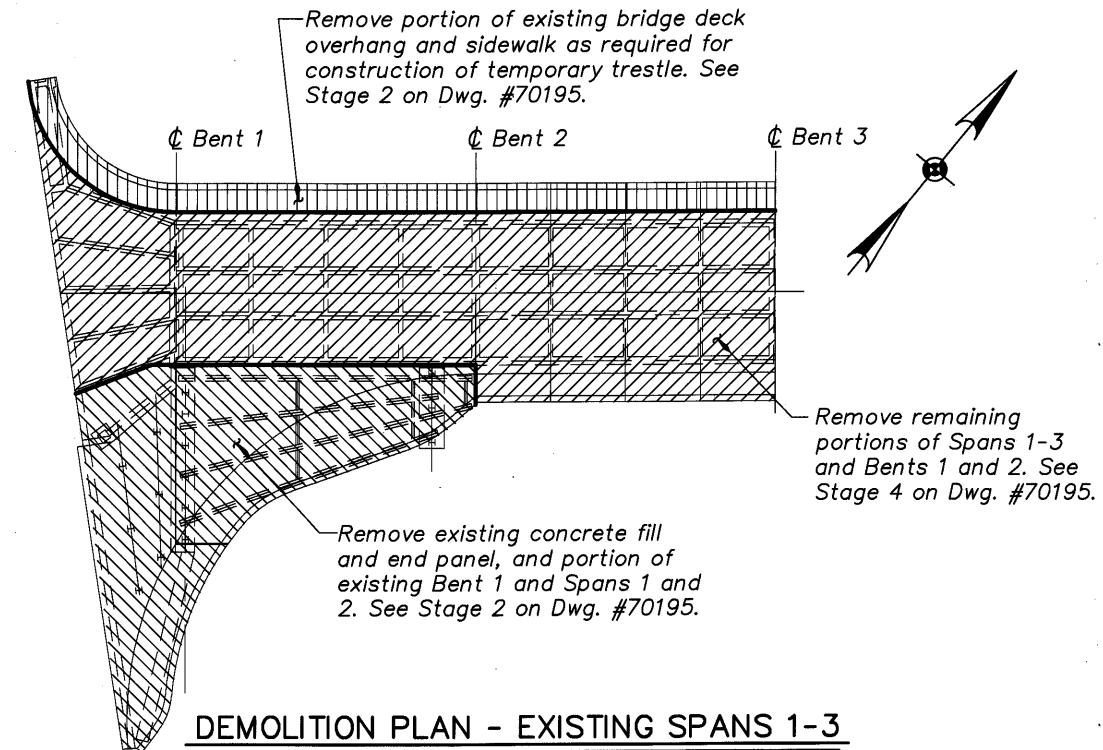


**DEMOLITION PLAN - EXISTING SPANS 1-3**  
No Scale

DO NOT SCALE THIS DRAWING. FOLLOW DIMENSIONS. INDICATED SCALES CORRECT ONLY FOR FULL SIZE SHEET (22"x34").


Xref: Sauvie\_BM.DWG multi2PROP.dwg ODOT0460\_DE.dwg C0400CAD.dwg

<table border="1"> <tr> <th>DATE</th> <th>REVISION</th> <th>BY</th> </tr> <tr> <td>08/05</td> <td>Revised salvage beam location</td> <td>JBT</td> </tr> <tr> <td>03/09</td> <td>As-Constructed</td> <td>TDF</td> </tr> </table>	DATE	REVISION	BY	08/05	Revised salvage beam location	JBT	03/09	As-Constructed	TDF	<p>DESIGNER <b>J. Patton</b></p> <p>DRAFTED: <b>Steve Thoman</b></p> <p>CHECKED: <b>Kent Cordtz</b></p> <p>REVIEWED:</p>	<p>REGISTERED PROFESSIONAL ENGINEER DAVID EVANS AND ASSOCIATES INC. 530 Center Street N.E., Suite 605 Salem Oregon 97301 Phone: 503.361.8635</p>	<p>CONNECTING COMMERCE AND COMMUNITY <b>MULTNOMAH COUNTY BRIDGES</b></p> <p>TRANSPORTATION DIVISION</p> <p><b>OREGON DEPARTMENT OF TRANSPORTATION BRIDGE ENGINEERING SECTION</b></p>	<p>BRIDGE NO. 20136</p> <p>DATE Sept. 2005</p> <p>CALC. BOOK</p>	<p>MULTNOMAH CHANNEL &amp; PNWR ETC., SAUVIE ISLAND RD.</p> <p>CONCEPTUAL DEMOLITION SCHEME</p>	<p>SHEET 15 OF 173</p> <p>DRAWING NO. 70202</p>
	DATE	REVISION	BY												
08/05	Revised salvage beam location	JBT													
03/09	As-Constructed	TDF													

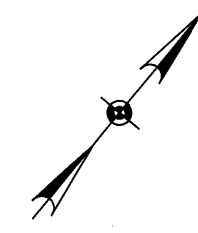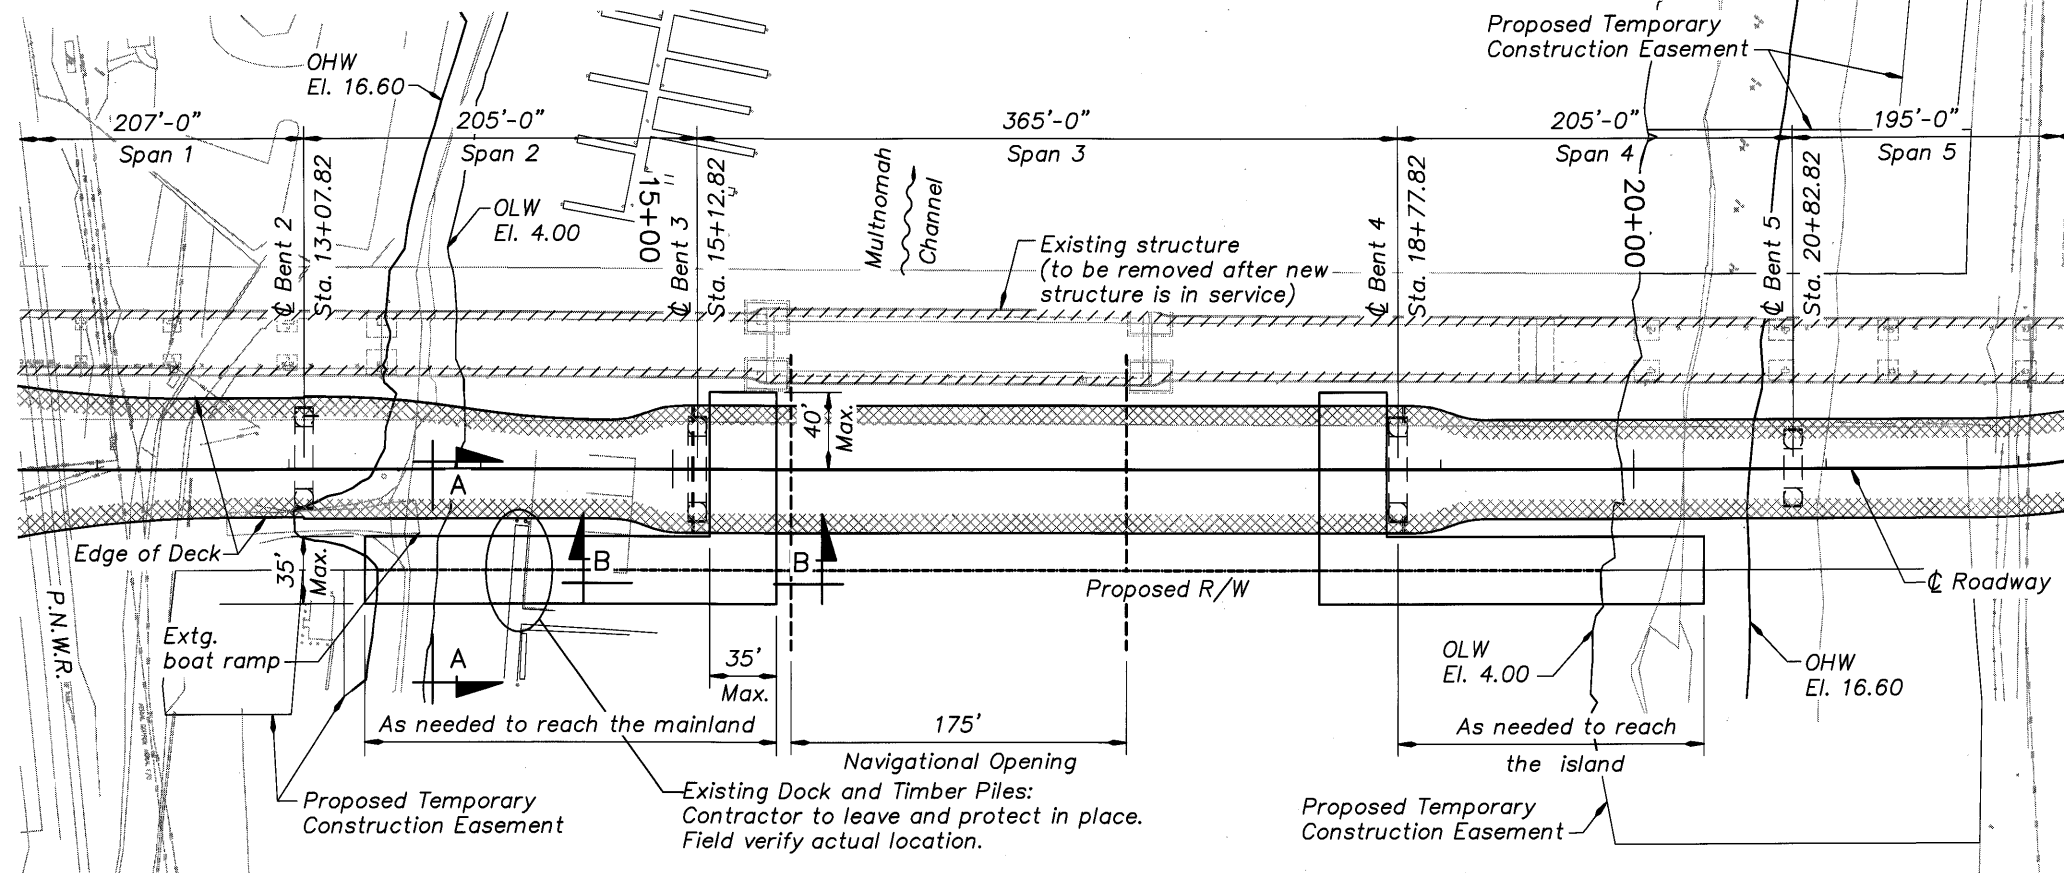


**WORK BRIDGE PLAN**

Scale : 1" = 50'

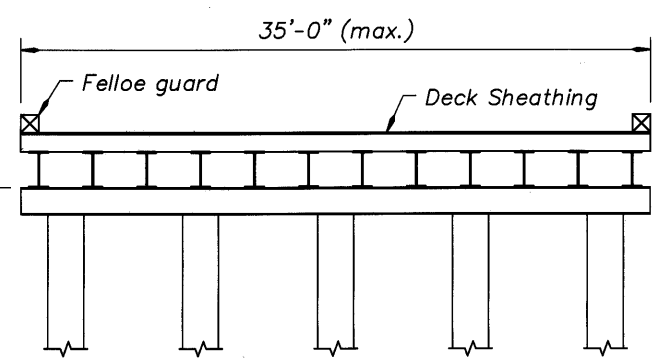

**SECTION A-A**  
Scale: 3/16" = 1'-0"

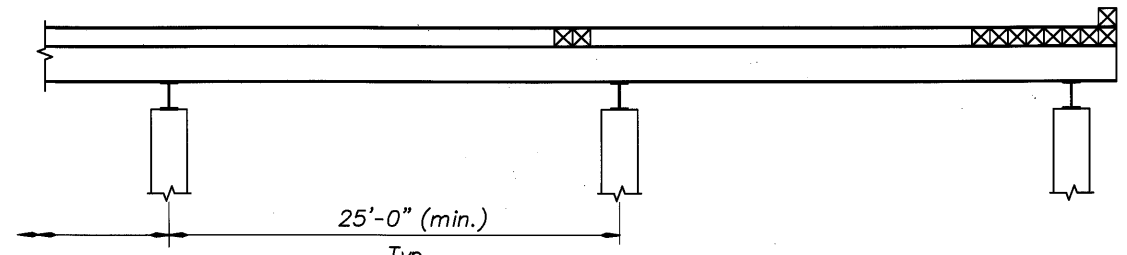

**SECTION B-B**  
Scale: 3/16" = 1'-0"


**REGULATORY AGENCY RESTRICTIONS**

Work bridge design shown is conceptual. Contractor's design must conform to the maximum and minimum dimensions shown as well as the following regulatory agency restrictions:

1. Construct and remove the work bridges during In-Water Work periods specified in Special Provisions.
2. Limit total number of piles driven for temporary work bridges within limits of OHW to 128. Number of piles per bent shown in Section A-A is conceptual.
3. Surround all piles driven within the active wetted channel with bubble curtain or approved equivalent method of noise level reduction.
4. Provide deck sheathing and continuous felloe guard to contain leakage and spills, and to prevent their entry into the waterway. Work bridges shall be removed.
5. Maintain permanent opening of at least 175 feet for existing navigational clearance.
6. Denotes minimum bottom of stringers. Provides 1.4' clear to ordinary high water. Contractor may raise this but not lower it. See Special Provisions.

DO NOT SCALE THIS DRAWING. FOLLOW DIMENSIONS. INDICATED SCALES CORRECT ONLY FOR FULL SIZE SHEET (22"x34").

	DATE	REVISION	BY	J. Patton			BRIDGE NO. 20136	MULTNOMAH CHANNEL & PNWR ETC., SAUVIE ISLAND RD.	SHEET 16 OF 173.
	03/09	As-Constructed	TDF	Steve Thoman					
				Kent Cordtz			CALC. BOOK	TEMPORARY WORK BRIDGE PLAN	

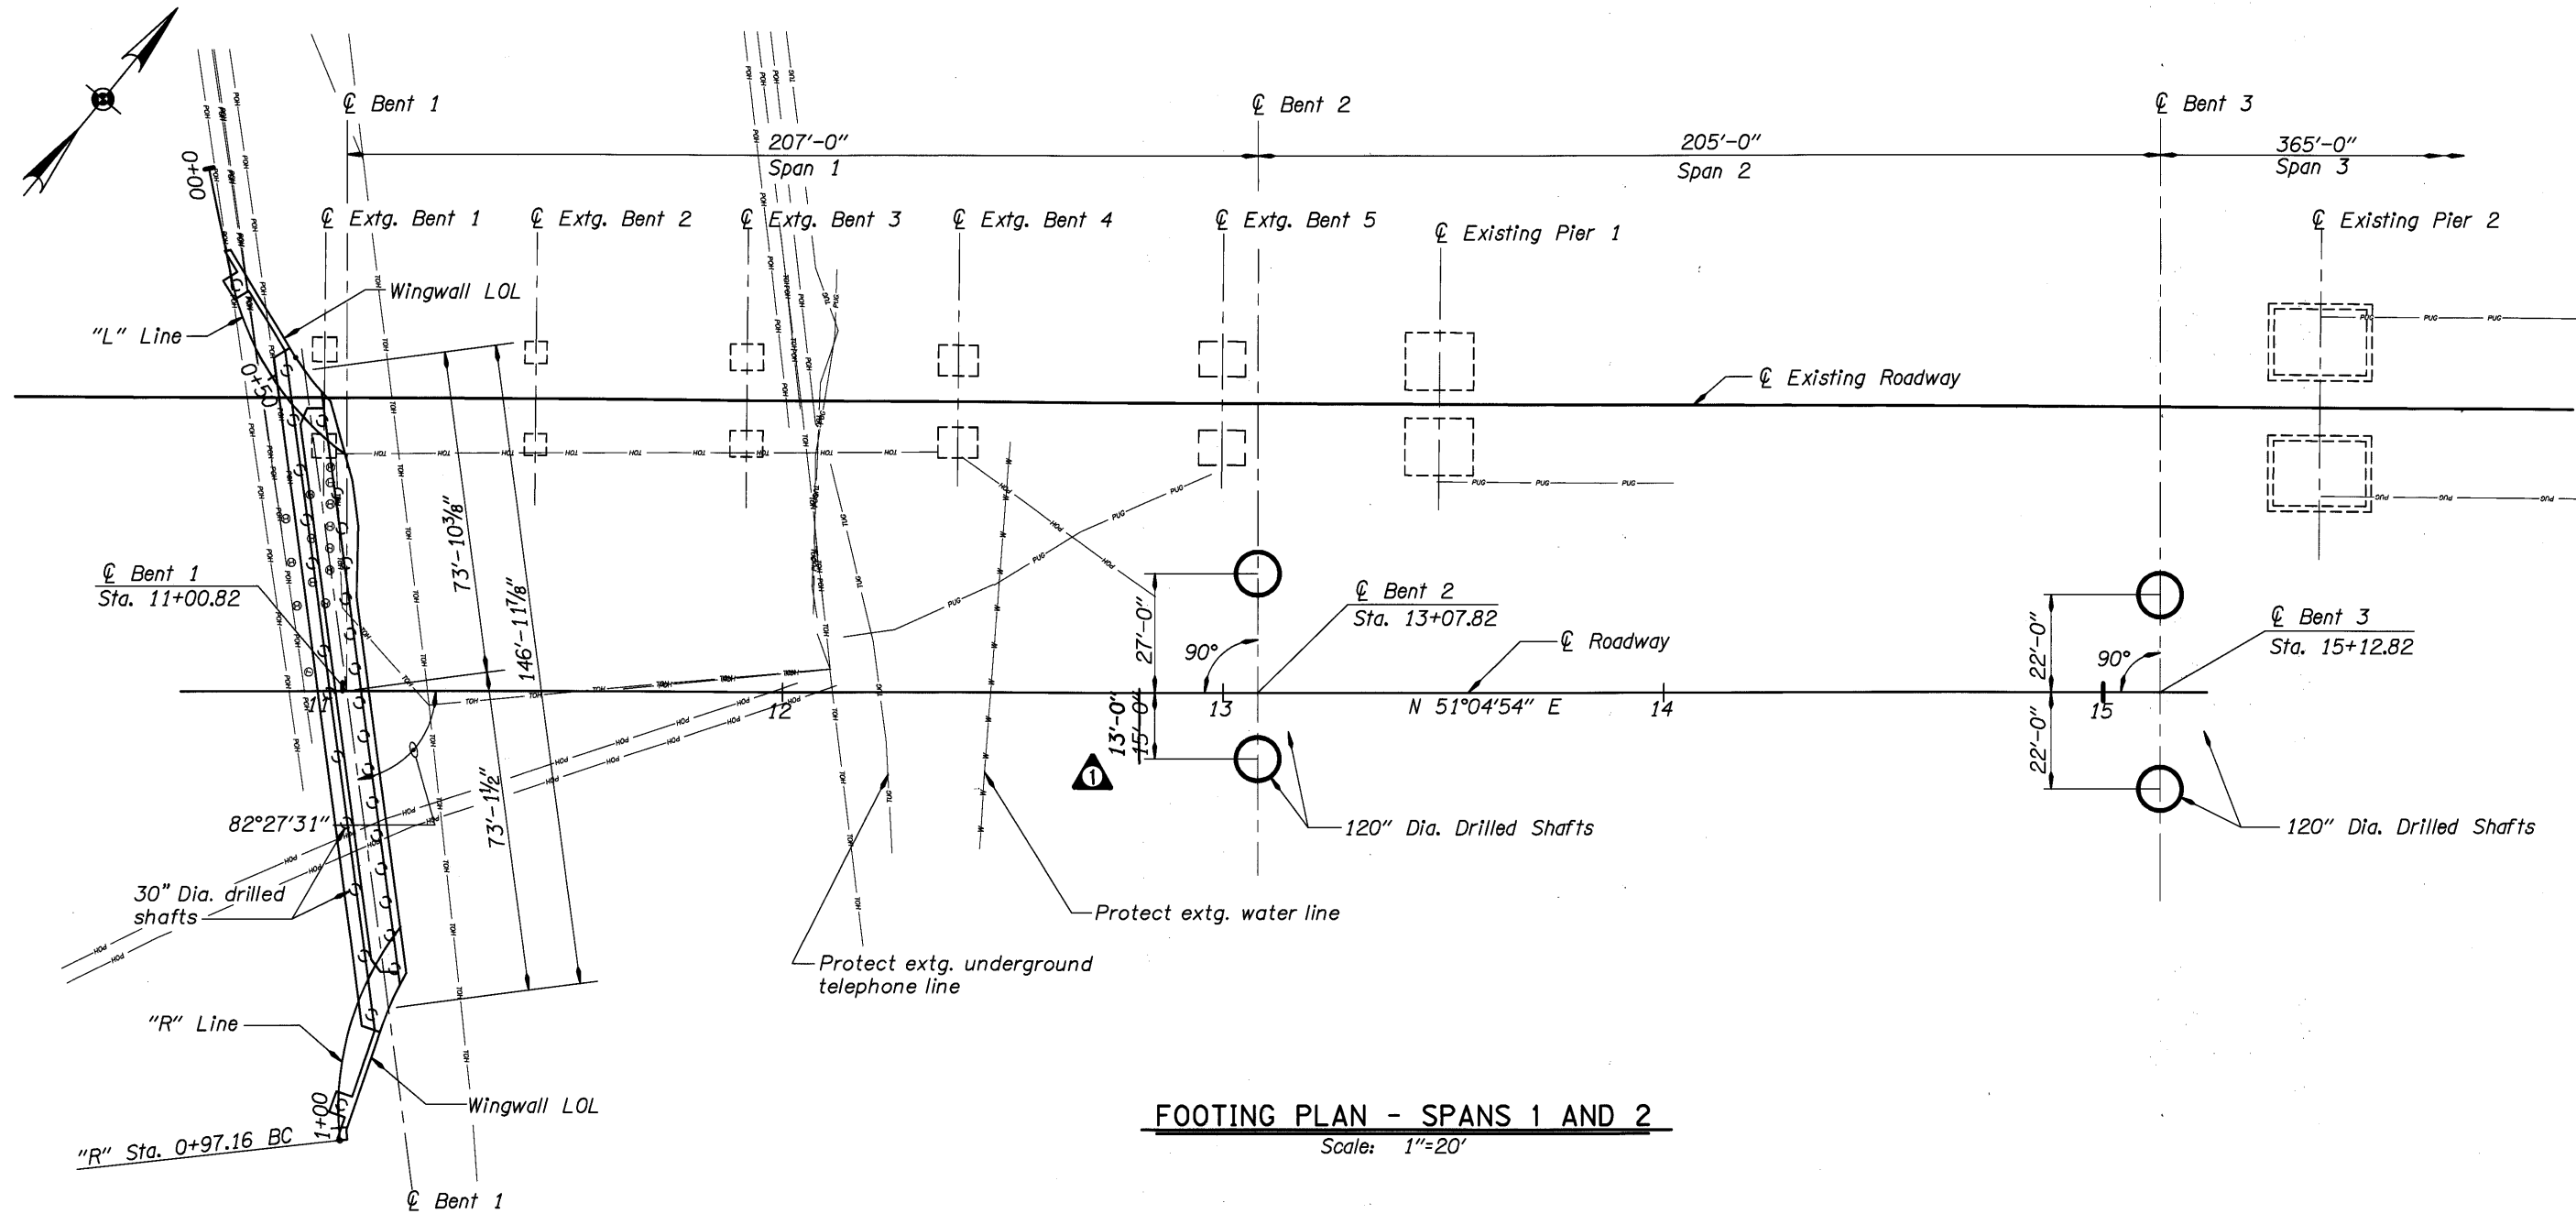


**FOOTING PLAN - SPANS 1 AND 2**  
Scale: 1"=20'

*Note:*  
See Dwg. #70300 for drilled shaft layout at Bent 1.

DO NOT SCALE THIS DRAWING.  
FOLLOW DIMENSIONS. INDICATED  
SCALES CORRECT ONLY FOR  
FULL SIZE SHEET (22"x34").

Xref: ODOTBR.dwg Savie_BM.DWG	DATE: 03/09 REVISION: As-Constructed BY: TDF	DRAFTED: Ken Johnson CHECKED: Adrienne Dietrich DESIGNED: Josh Hewes	REVIEWED: [Signature] REGISTERED PROFESSIONAL ENGINEER 74540 BC MARCH 09, 2005 KENT WILLIAM CORTEZ EXPIRES: 12-31-05	CONNECTING COMMERCE AND COMMUNITY <b>MULTNOMAH COUNTY</b> BRIDGES TRANSPORTATION DIVISION <b>OREGON DEPARTMENT OF TRANSPORTATION</b> BRIDGE ENGINEERING SECTION	BRIDGE NO.: 20136 DATE: Sept. 2005 CALC. BOOK:	MULTNOMAH CHANNEL & PNWR ETC., SAUVIE ISLAND RD. FOOTING PLAN (1 OF 2)	SHEET 17 OF 173 DRAWING NO. 70204
-------------------------------	--	--	---	--	--	---	--------------------------------------

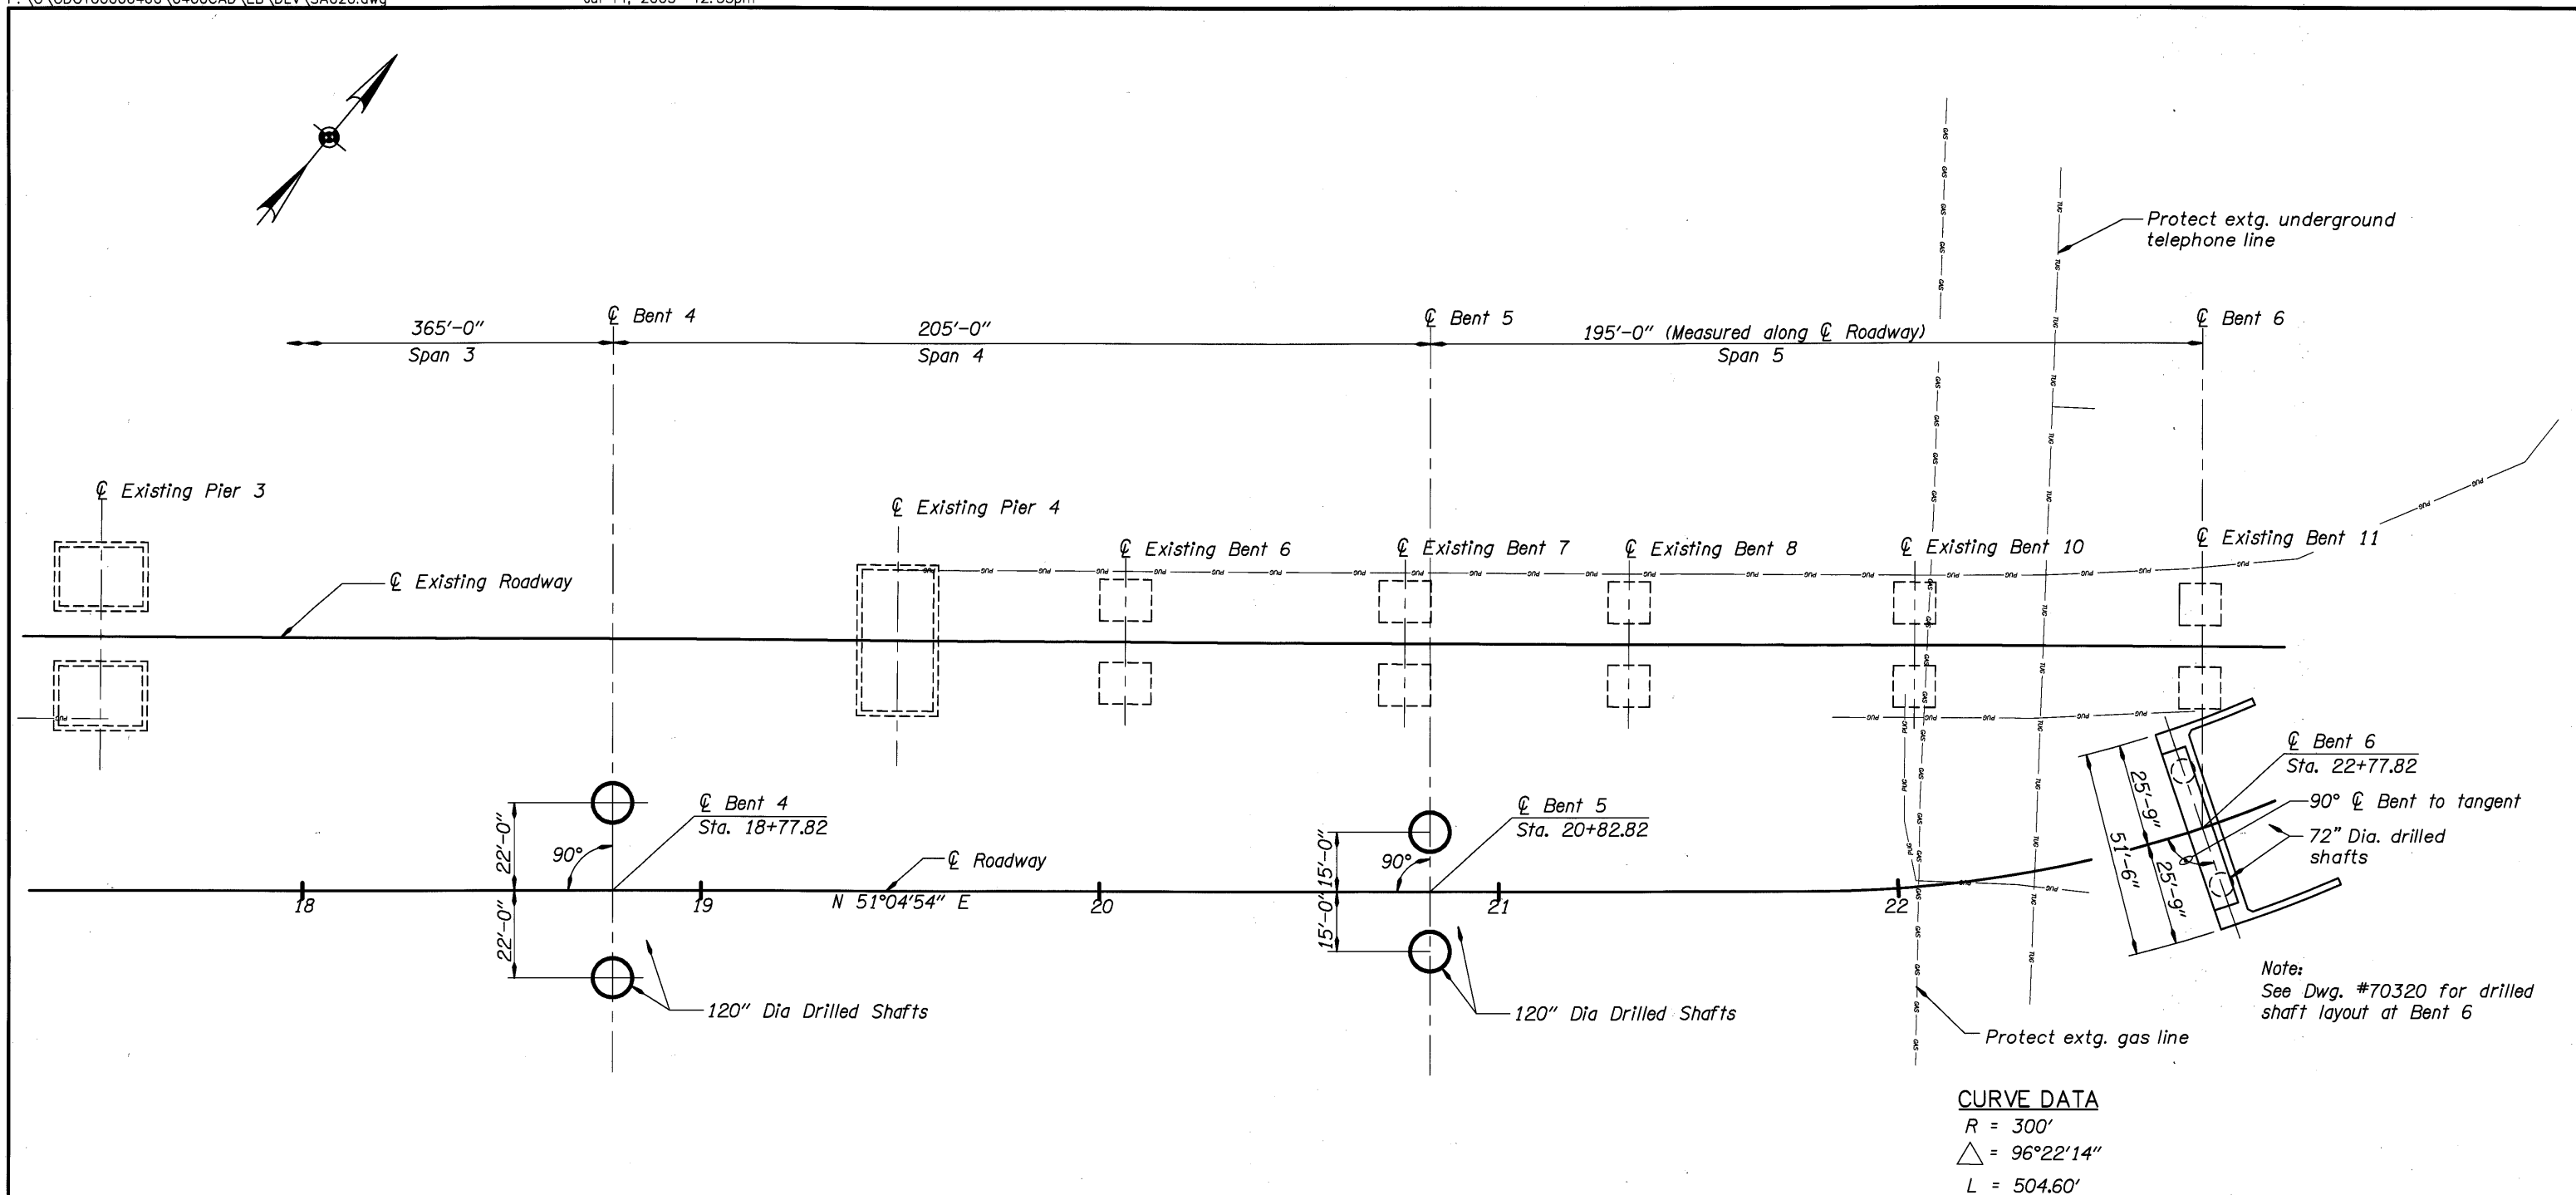

**CURVE DATA**  
 R = 300'  
 $\Delta = 96^\circ 22' 14''$   
 L = 504.60'

**FOOTING PLAN - SPANS 4 AND 5**  
 Scale: 1"=20'

DO NOT SCALE THIS DRAWING.  
 FOLLOW DIMENSIONS. INDICATED  
 SCALES CORRECT ONLY FOR  
 FULL SIZE SHEET (22"x34").

Xref: ODOTBDR.dwg SA019.dwg	DATE	REVISION	BY	REVIEWED REGISTERED PROFESSIONAL ENGINEER 74848 OR KENT WILLIAM CORROZZ EXPIRES: 12-31-05	 <b>DAVID EVANS AND ASSOCIATES INC.</b> 530 Center Street N.E., Suite 605 Salem Oregon 97301 Phone: 503.361.8635	 TRANSPORTATION DIVISION <b>OREGON DEPARTMENT OF TRANSPORTATION</b> BRIDGE ENGINEERING SECTION	BRIDGE NO.	MULTNOMAH CHANNEL & PNWR ETC., SAUVIE ISLAND RD.	SHEET 18 OF 173.	
	03/09	As-Constructed	TDF				DATE			70205
							Sept. 2005			
			DESIGNED:				CALC. BOOK	FOOTING PLAN (2 OF 2)	DRAWING NO. 70205	
			DRAFTED:							
			CHECKED:							
			Ken Johnson							
			Josh Hewes							
			Adrienne Dietrich							

DECK PLAN REFERENCE NOTES


- ① Place 4" square drain hole through diaphragm beam at low point of each cell.
- ② Place 4" diameter drain hole through bottom slab at each end of spans, each cell.
- ②0 Deck Drain, see Dwg. #70337 for details.
- ②4 Sidewalk Drain, see Dwg. #70338 for details.
- ③8 6" Dia. conduit for future utilities. See Dwg. #70360.
- ③9 4" Dia. conduit for future utilities. See Dwg. #70360.
- ④0 3" Dia. conduit for future utilities. See Dwg. #70360.
- ⑤0 Standard Concrete Bridge Rail, Type "F". See Std. Dwg. #BR200.
- ⑤2 Standard Pedestrian Rail. See Std. Dwg. #BR246.
- ⑤3 Standard 3" Tube Curb Mounted Rail (modified). See Rail Detail on Std. Dwg. #BR208.
- ⑤4 Gutterline-9" high continuous curb.
- ⑤5 Standard Sidewalk Mounted Combination Bridge Rail (Modified). See Std. Dwg. #BR216.
- ⑤6 Protective Fencing, see Dwg. #70328 and #70329.
- ⑤7 Standard 4'-6" high Flush Mounted Combination Bridge Rail, see Std. Dwg. #BR220.
- ⑤8 See Std. Dwg. #BR209 for rail connection details.
- ⑤9 Required Type "B" Joint in Std. Conc. Bridge Rail, Type "F".
- ⑥0 3 Cell Modular Expansion Joint. See joint details on dwg. #70339
- ⑥2 Standard Single Strip Seal Expansion Joint. See Std. Dwg. #BR145.
- ⑥4 Sidewalk Sliding Plate Expansion Joint. See Dwg. #70340 and #70341
- ⑦1 Standard access hole through interior stem, see Std. Dwg. #BR135 and #BR136.
- ⑦2 Standard access hole through bottom slab, see Std. Dwg. #BR135 and #BR136.
- ⑦3 Vent tubes through stems, see Std. Dwgs. #BR135 and #BR136.
- ⑧0 Standard Bridge End Panel, L=20'-4". See Std. Dwg. #BR165.
- ⑧1 Standard Bridge End Panel, L=30'-4". See Std. Dwg. #BR165.
- ⑧2 Sidewalk Ramp. See Sidewalk Details on Dwg. #70297 and #70298.
- ⑧3 Construction joint in end panel.
- ⑧4 Construction joint in deck, bottom slab, end beam, and longitudinal beam 1a.
- ⑧5 Construction joint in sidewalk.

DO NOT SCALE THIS DRAWING.  
 FOLLOW DIMENSIONS. INDICATED  
 SCALES CORRECT ONLY FOR  
 FULL SIZE SHEET (22"x34").

A	DATE	REVISION	BY	DESIGNER Ken Johnson DRAFTED: Clifford Coulter CHECKED: Oliver Mueller REVIEWED:	 DESIGNER  <b>DAVID EVANS AND ASSOCIATES INC.</b> 530 Center Street N.E., Suite 605 Salem Oregon 97301 Phone: 503.361.8635	 TRANSPORTATION DIVISION  OREGON DEPARTMENT OF TRANSPORTATION BRIDGE ENGINEERING SECTION	BRIDGE NO.	MULTNOMAH CHANNEL & PNWR ETC., SAUVIE ISLAND RD.	SHEET
	03/09	As-Constructed	TDF				20136		19
							DATE		OF
							Sept. 2005		173
							CALC. BOOK	DECK PLAN REFERENCE NOTES	DRAWING NO.
									70206

Xref: Odobdr.dwg



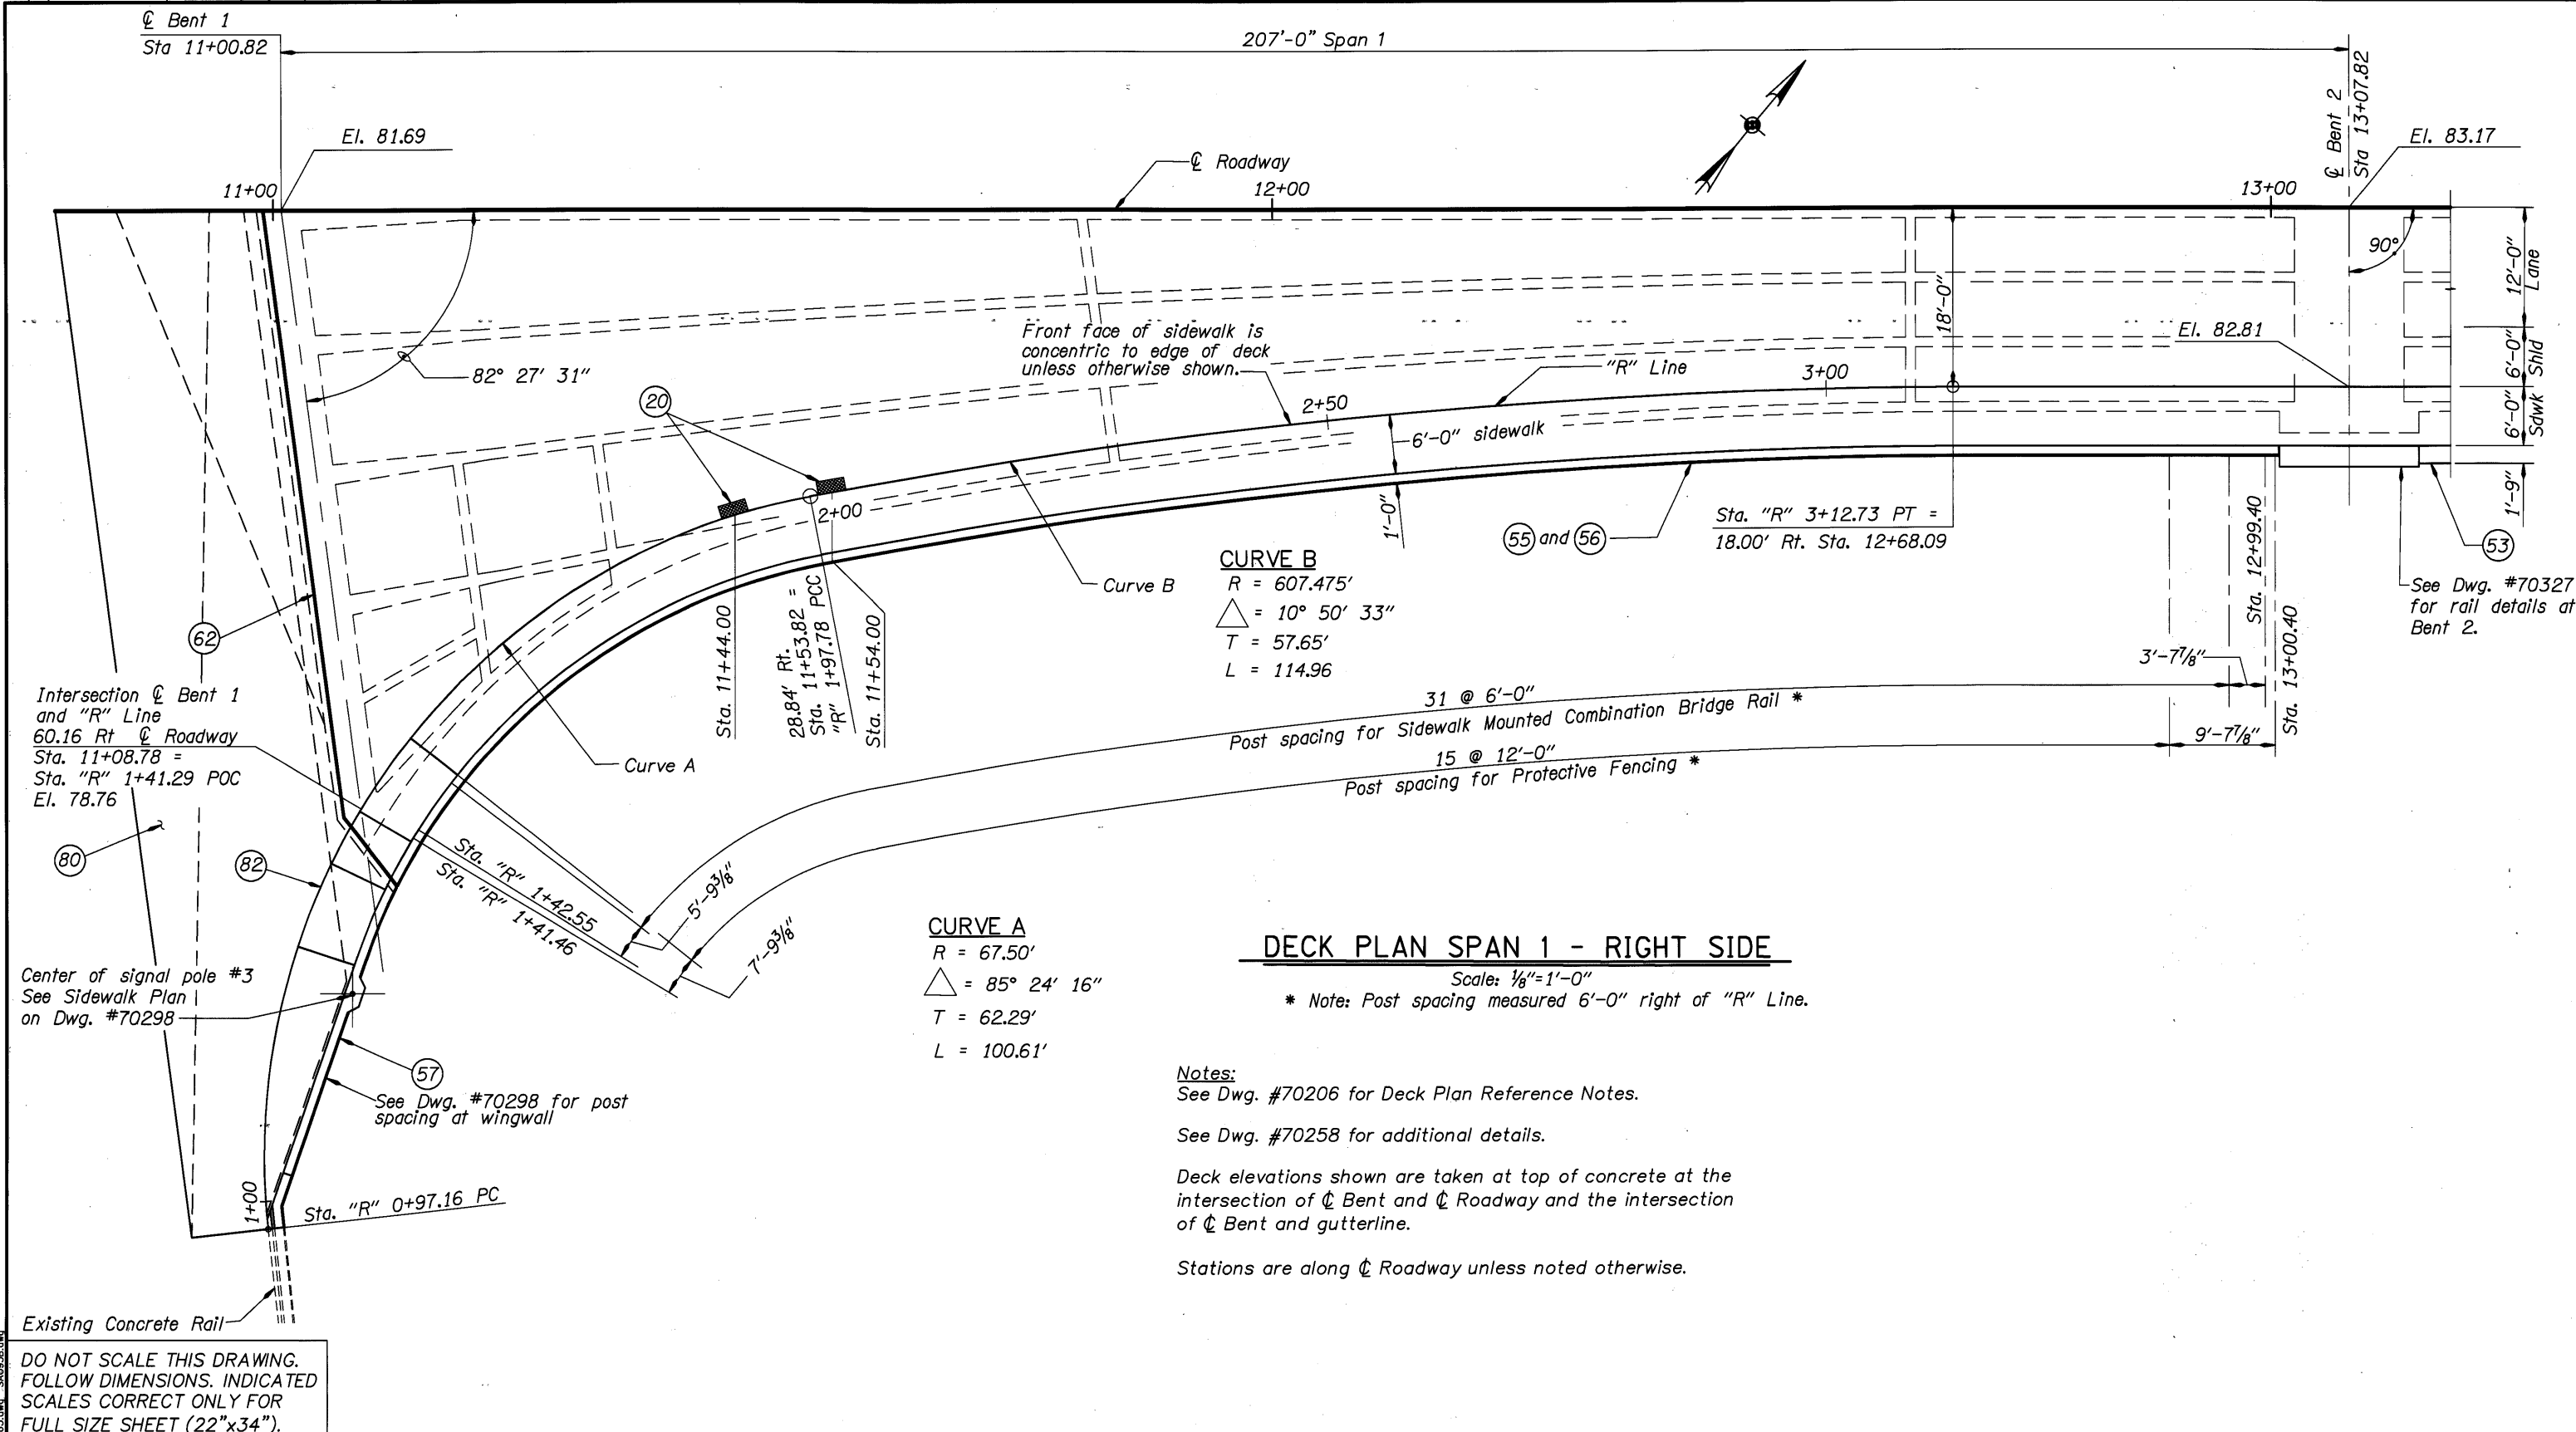

**DECK PLAN SPAN 1 - RIGHT SIDE**

Scale: 1/8"=1'-0"


\* Note: Post spacing measured 6'-0" right of "R" Line.

**Notes:**  
 See Dwg. #70206 for Deck Plan Reference Notes.  
 See Dwg. #70258 for additional details.  
 Deck elevations shown are taken at top of concrete at the intersection of  $\phi$  Bent and  $\phi$  Roadway and the intersection of  $\phi$  Bent and gutterline.  
 Stations are along  $\phi$  Roadway unless noted otherwise.

DO NOT SCALE THIS DRAWING. FOLLOW DIMENSIONS. INDICATED SCALES CORRECT ONLY FOR FULL SIZE SHEET (22"x34").

DATE	03/09	REVISION	As-Constructed	BY	Ken Johnson	REVIEWED	DAVID EVANS AND ASSOCIATES INC. 530 Center Street N.E., Suite 605 Salem Oregon 97301 Phone: 503.361.8835	BRIDGE NO.	20136	SHEET	20
					Adrienne Dietrich	KENT WILLIAM CORUTZ REGISTERED PROFESSIONAL ENGINEER OREGON MARCH 09, 2005	MULTNOMAH COUNTY BRIDGES	DATE	Sept. 2005	DRAWING NO.	70207
					Josh Hewes			OREGON DEPARTMENT OF TRANSPORTATION BRIDGE ENGINEERING SECTION	CALC. BOOK		
										MULTNOMAH CHANNEL & PNWR ETC., SAUVIE ISLAND RD.	
										DECK PLAN - SPAN 1 RIGHT SIDE	

Xref: Odobair.dwg, SauvieDwg.dwg, SA063.dwg, SA093B.dwg

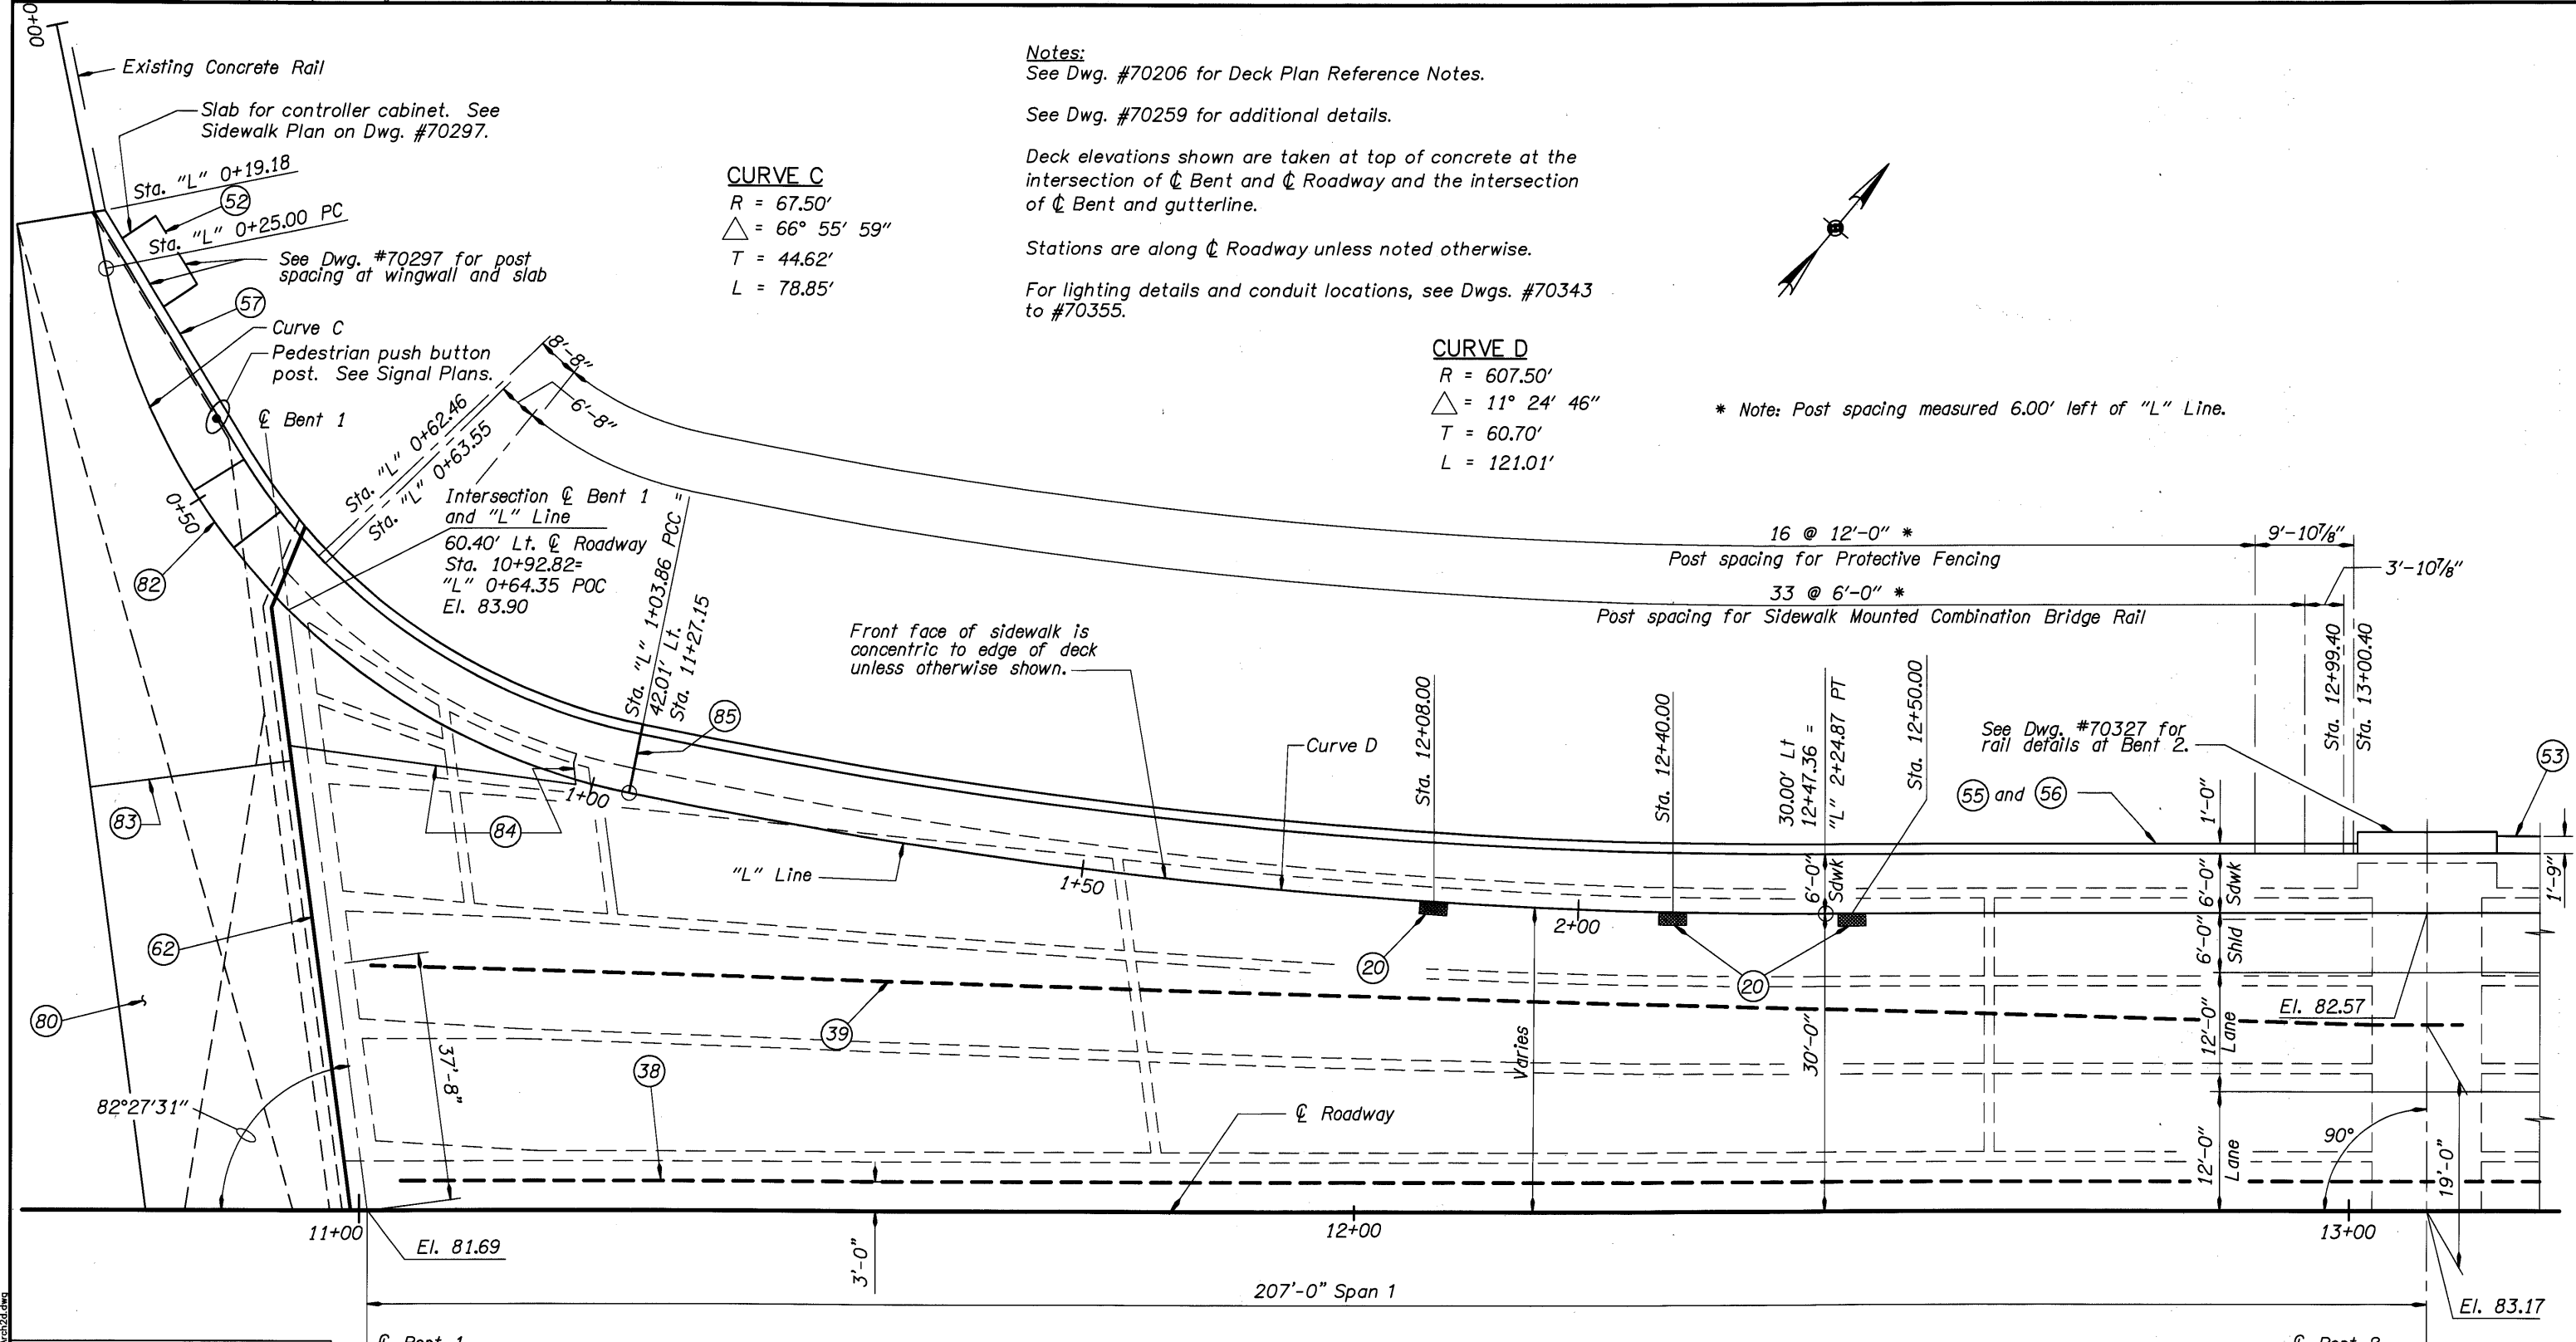


**Notes:**  
See Dwg. #70206 for Deck Plan Reference Notes.  
See Dwg. #70259 for additional details.

Deck elevations shown are taken at top of concrete at the intersection of  $\phi$  Bent and  $\phi$  Roadway and the intersection of  $\phi$  Bent and gutterline.

Stations are along  $\phi$  Roadway unless noted otherwise.

For lighting details and conduit locations, see Dwg. #70343 to #70355.

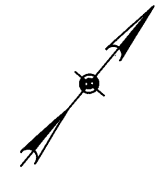


\* Note: Post spacing measured 6.00' left of "L" Line.

DO NOT SCALE THIS DRAWING. FOLLOW DIMENSIONS. INDICATED SCALES CORRECT ONLY FOR FULL SIZE SHEET (22"x34").

**DECK PLAN SPAN 1 - LEFT SIDE**  
Scale: 1/8" = 1'-0"

	DATE	REVISION	BY	Ken Johnson	<b>REVIEWED</b> 		BRIDGE NO. 20136	MULTNOMAH CHANNEL & PNWR ETC., SAUVIE ISLAND RD.	SHEET 21 OF 173.
	08/05	Added slab & ped. push button post	KWC	DRAFTED:					
	03/09	As-Constructed	TDF	ADRIANNE DIETRICH		OREGON DEPARTMENT OF TRANSPORTATION BRIDGE ENGINEERING SECTION	CALC. BOOK	DECK PLAN - SPAN 1 LEFT SIDE	
				JOSH HEWES	EXPIRES: 12-31-05				


205'-0" Span 2

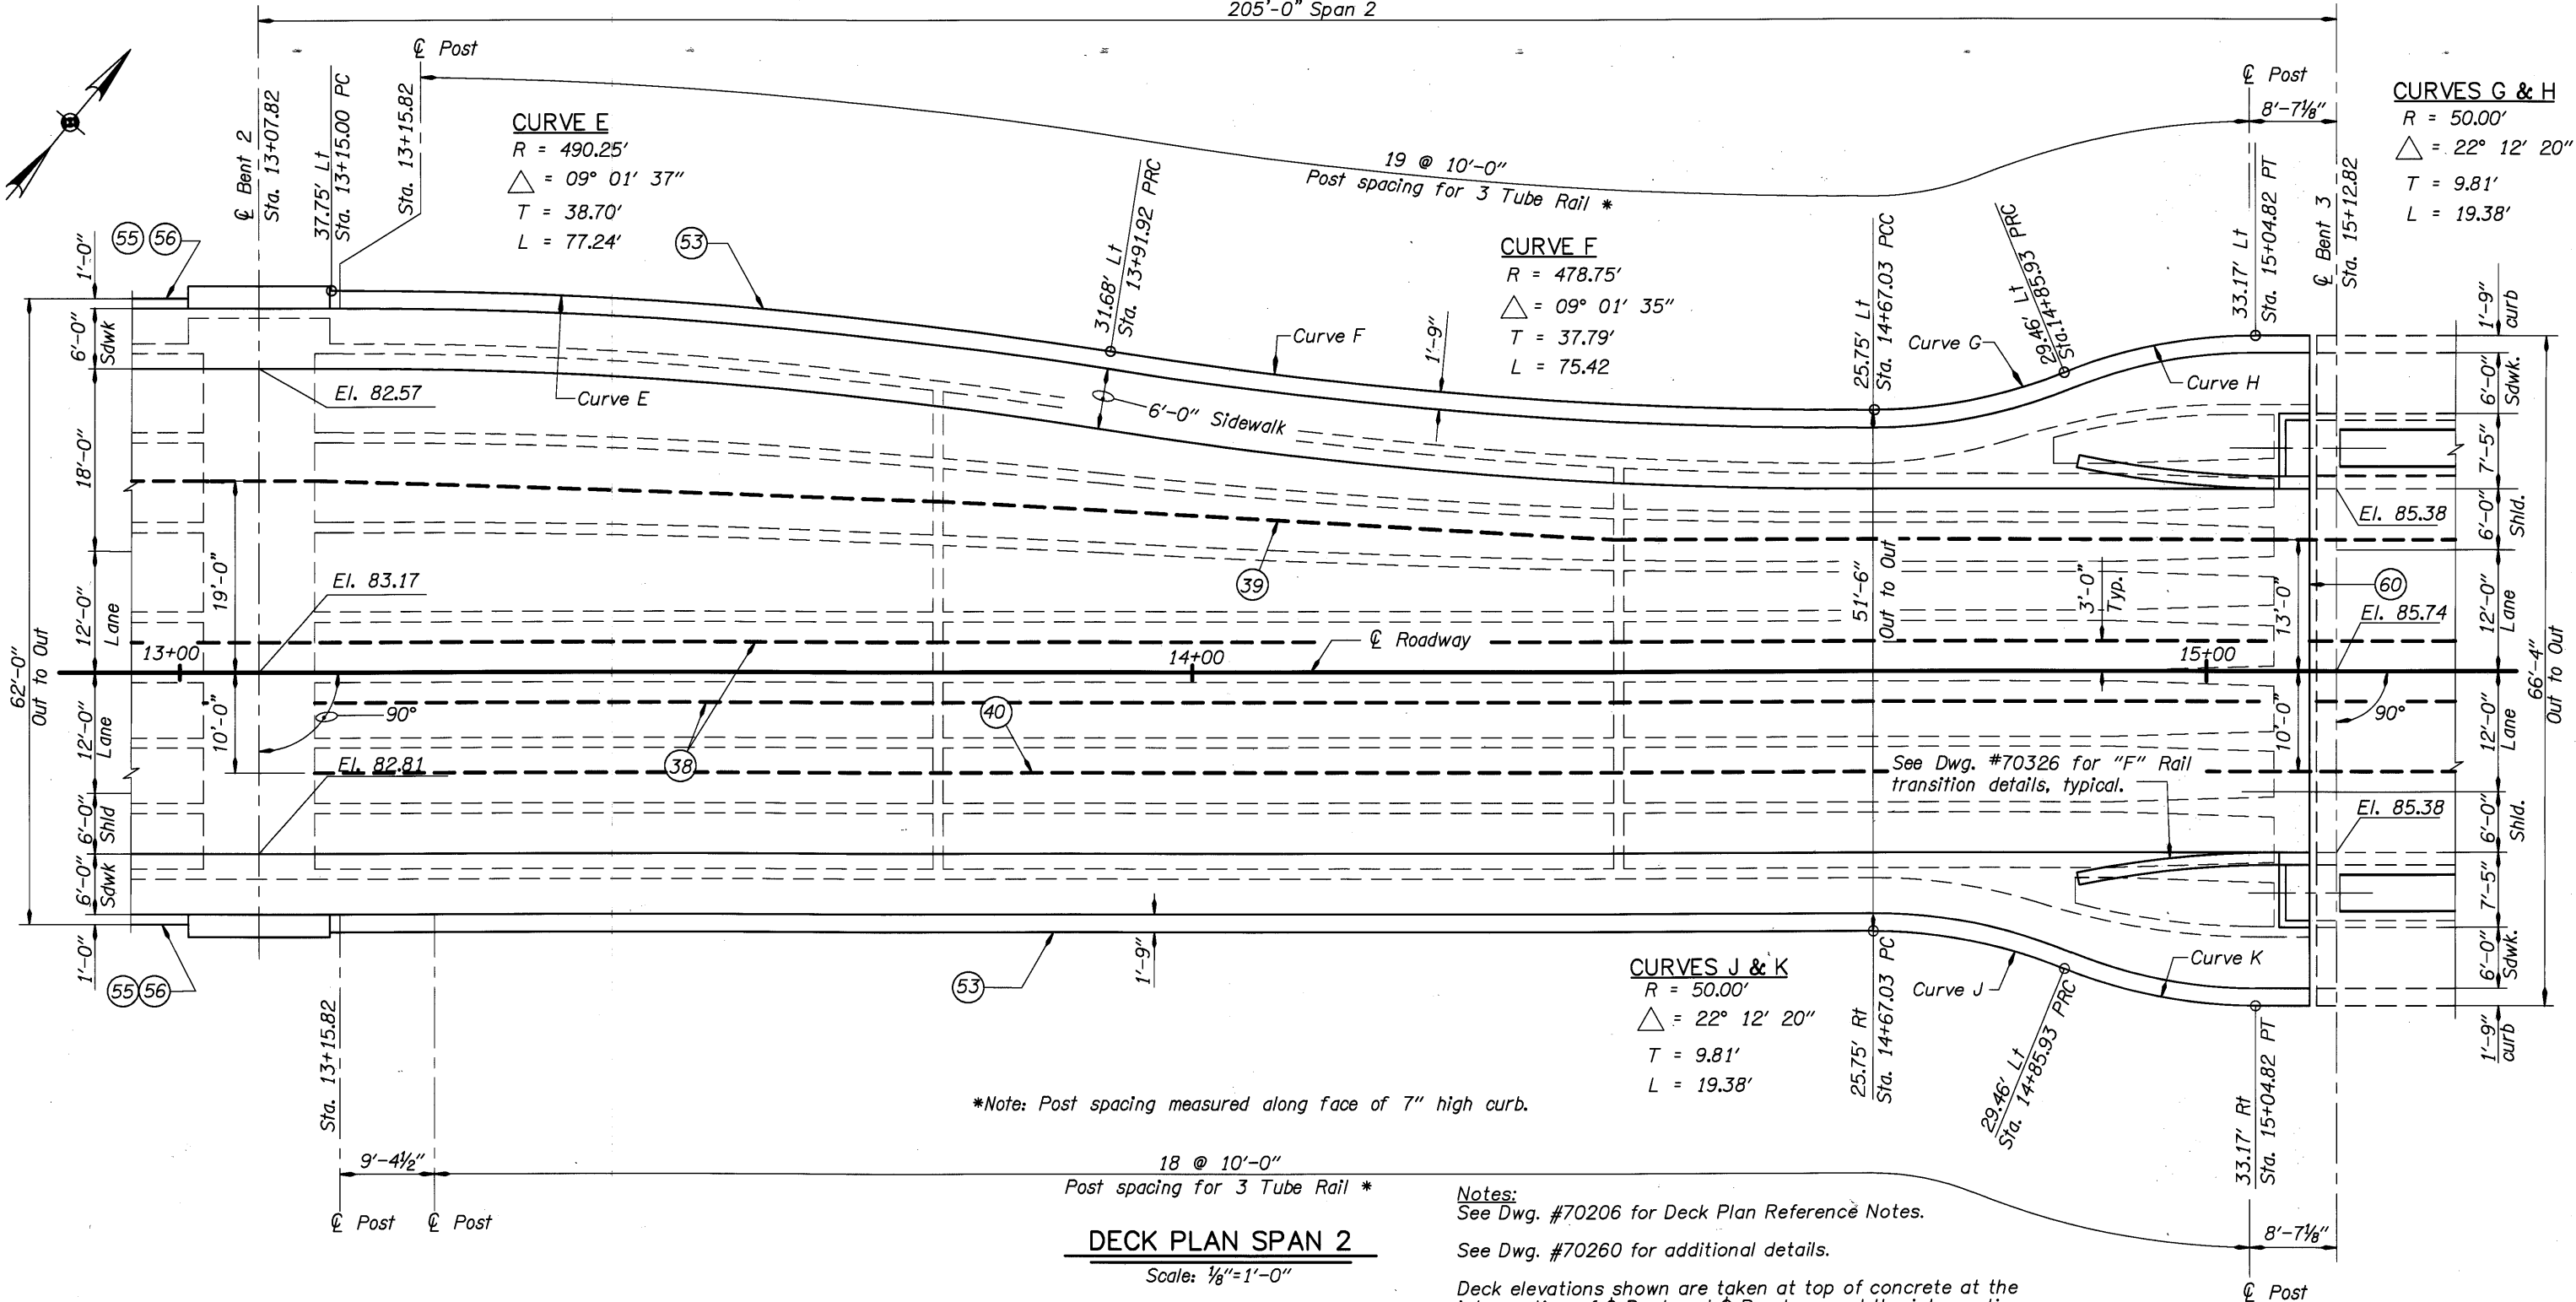

**Notes:**  
 See Dwg. #70206 for Deck Plan Reference Notes.  
 See Dwg. #70260 for additional details.  
 Deck elevations shown are taken at top of concrete at the intersection of  $\text{C Bent}$  and  $\text{C Roadway}$  and the intersection of  $\text{C Bent}$  and gutterline.  
 Stations are along  $\text{C Roadway}$  unless noted otherwise.  
 For lighting details and conduit locations, see Dwgs. #70343 to #70355.

DO NOT SCALE THIS DRAWING. FOLLOW DIMENSIONS. INDICATED SCALES CORRECT ONLY FOR FULL SIZE SHEET (22"x34").

DATE	03/09	REVISION	As-Constructed	BY	Ken Johnson	REVIEWED	DAVID EVANS AND ASSOCIATES INC. 530 Center Street N.E., Suite 605 Salem Oregon 97301 Phone: 503.361.8635	BRIDGE NO.	20136	SHEET	22
					TDF				Adrienne Dietrich		MULTNOMAH COUNTY BRIDGES TRANSPORTATION DIVISION
					Josh Hewes	OREGON DEPARTMENT OF TRANSPORTATION BRIDGE ENGINEERING SECTION	EXPIRES: 12-31-05	CALC. BOOK		DRAWING NO.	70209
										MULTNOMAH CHANNEL & PNWR ETC., SAUVIE ISLAND RD.	
										DECK PLAN SPAN 2	

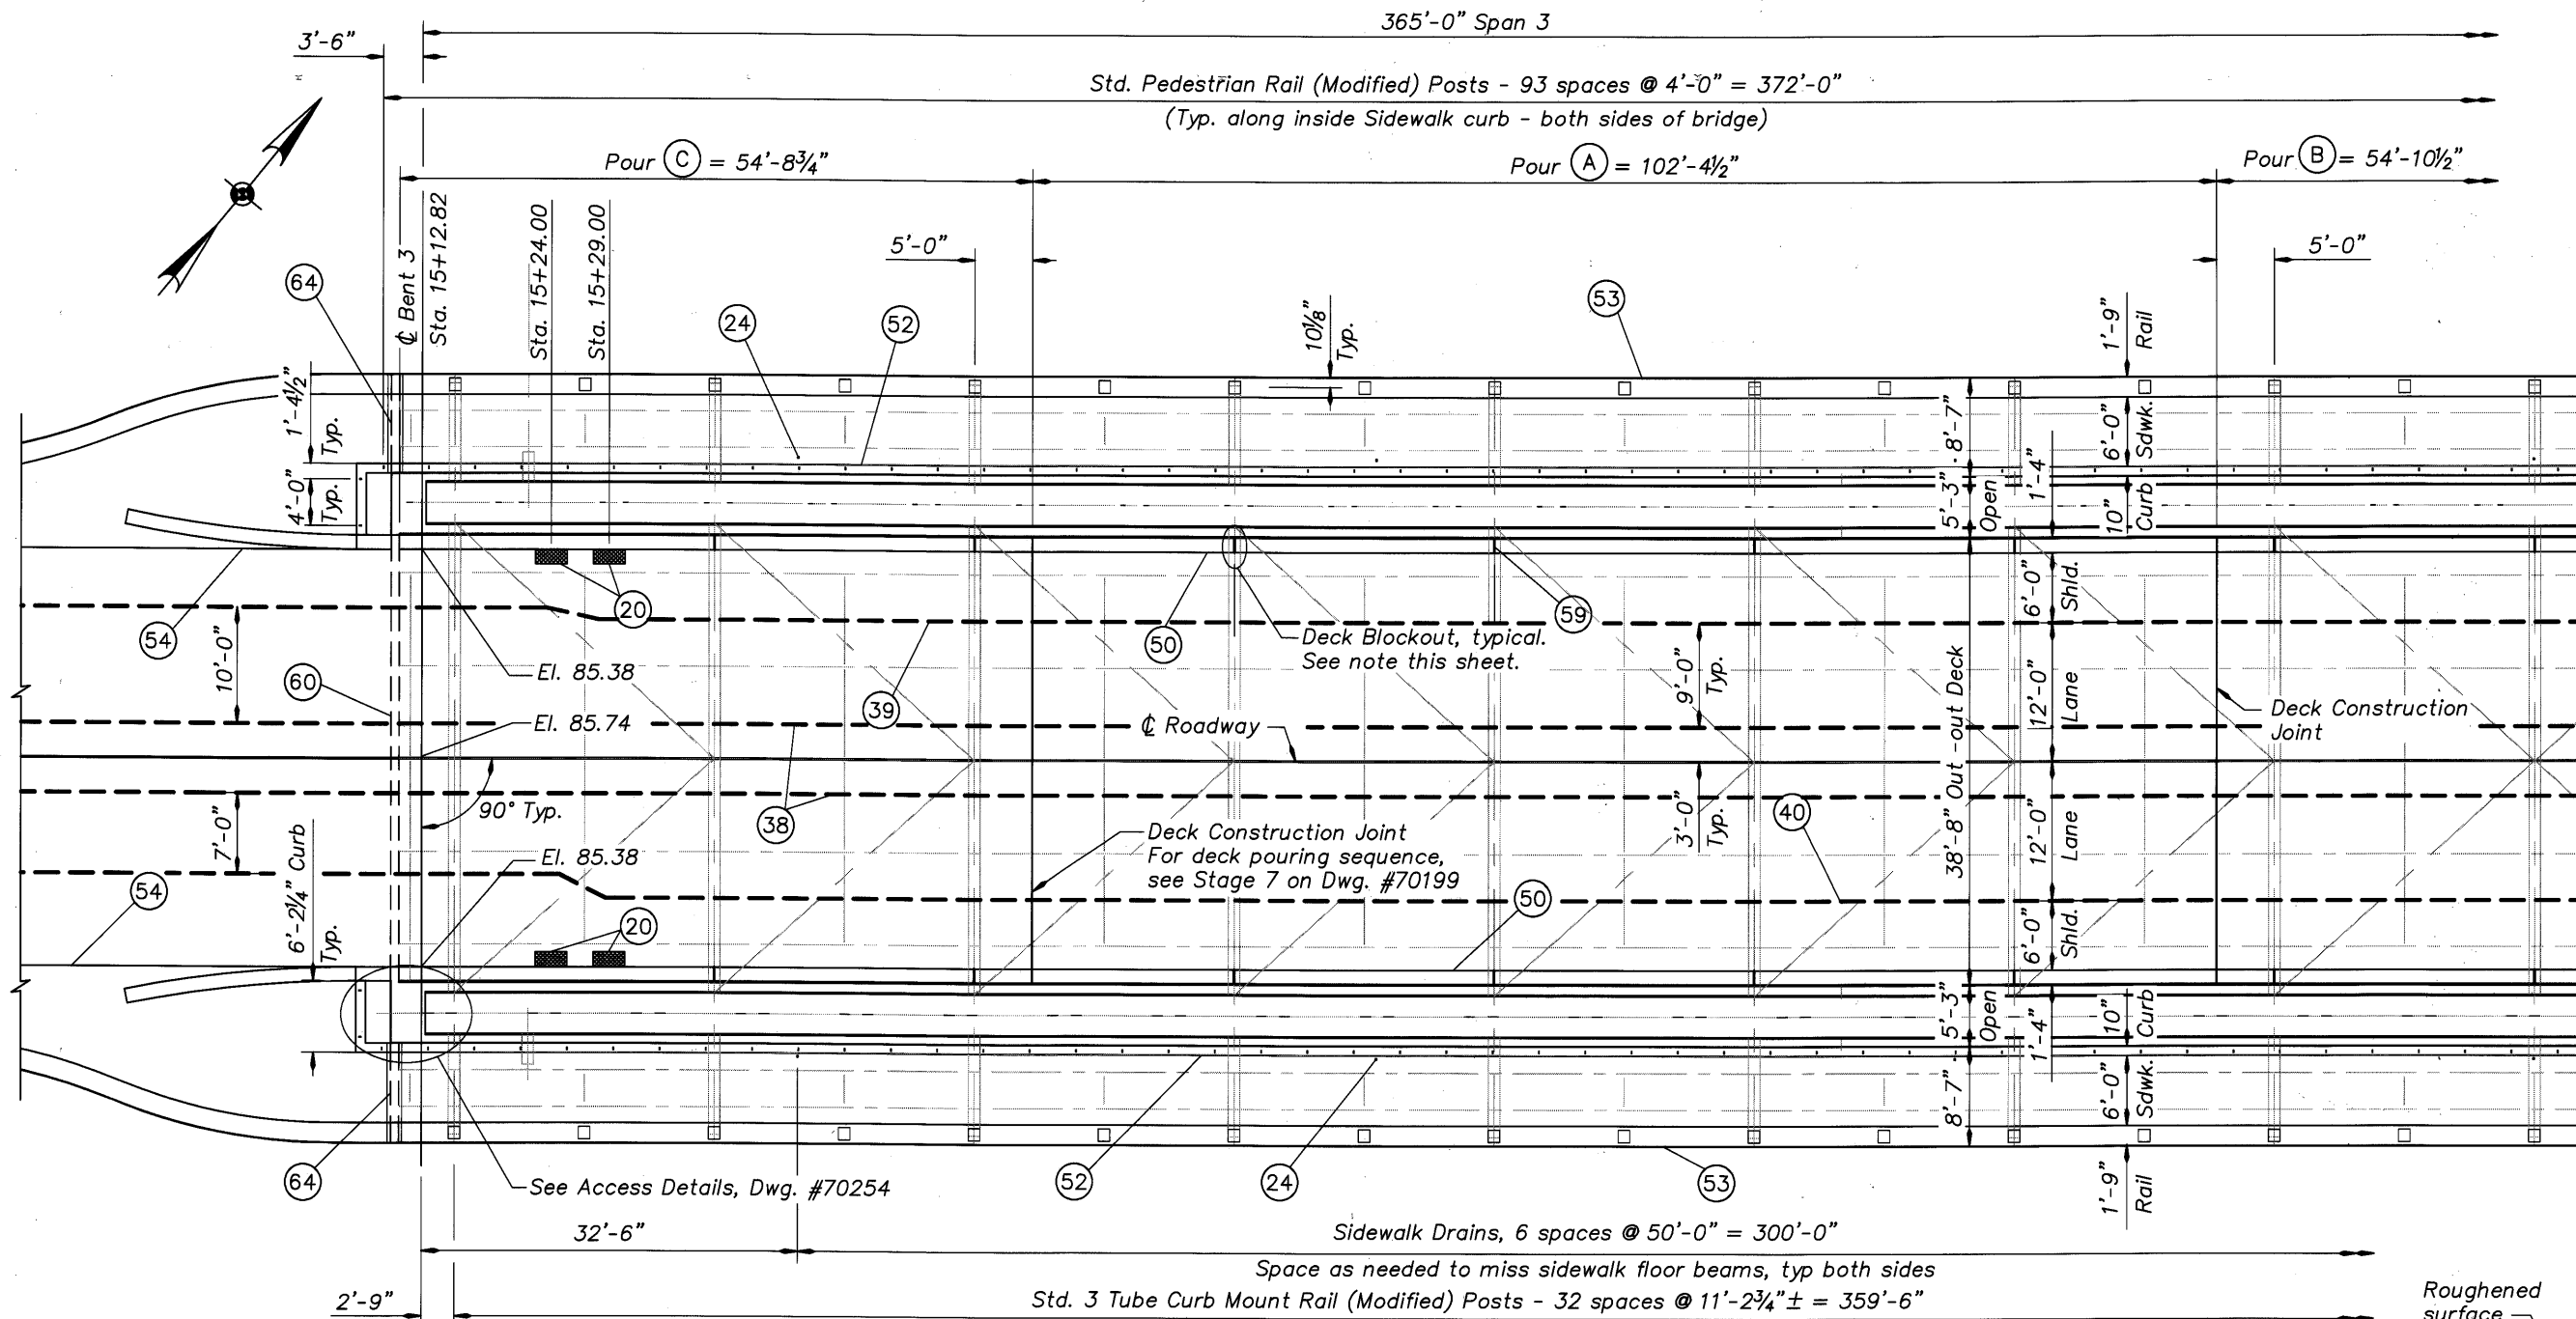

**Notes:**  
See Dwg. #70206 for Deck Plan Reference Notes.

Longitudinal reinforcing steel to extend from deck pour segments (A) to provide 1'-9" Min. lap splice with reinforcing in adjoining pours.

All sidewalk concrete to be included in Pour (D).

Provide deck blockout in edge of deck under rail joints at each end of each floorbeam. See Dwg. #70326 for details.


**DECK PLAN - PARTIAL SPAN 3**

Scale: 1/8" = 1'-0"

**Notes (Cont):**

Deck elevations shown are taken at top of concrete at the intersection of  $\phi$  Bent and  $\phi$  Roadway and the intersection of  $\phi$  Bent and gutterline.

For lighting details and conduit locations, see Dwgs. #70343 to #70355.

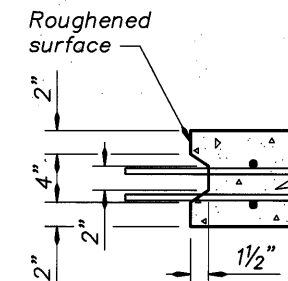

**DECK CONSTRUCTION JOINT DETAIL**

Scale: 1/2" = 1'-0"

DO NOT SCALE THIS DRAWING. FOLLOW DIMENSIONS. INDICATED SCALES CORRECT ONLY FOR FULL SIZE SHEET (22"x34").

DATE	REVISION	BY
03/09	As-Constructed	TDF

DESIGNED:	J. Patton
DRAFTED:	Oliver Mueller
CHECKED:	Clifford Coulter

REVIEWED

REGISTERED PROFESSIONAL ENGINEER  
74549 BE  
DAVID EVANS AND ASSOCIATES INC.  
530 Center Street N.E., Suite 605  
Salem Oregon 97301  
Phone: 503.361.8635

EXPIRES: 12-31-05

CONNECTING COMMERCE AND COMMUNITY

MULTNOMAH COUNTY BRIDGES

TRANSPORTATION DIVISION


OREGON DEPARTMENT OF TRANSPORTATION  
BRIDGE ENGINEERING SECTION

BRIDGE NO.	20136
DATE	Sept. 2005
CALC. BOOK	

MULTNOMAH CHANNEL & PNWR ETC., SAUVIE ISLAND RD.

DECK PLAN - SPAN 3 (1 OF 2)

SHEET	23
OF	173
DRAWING NO.	70210

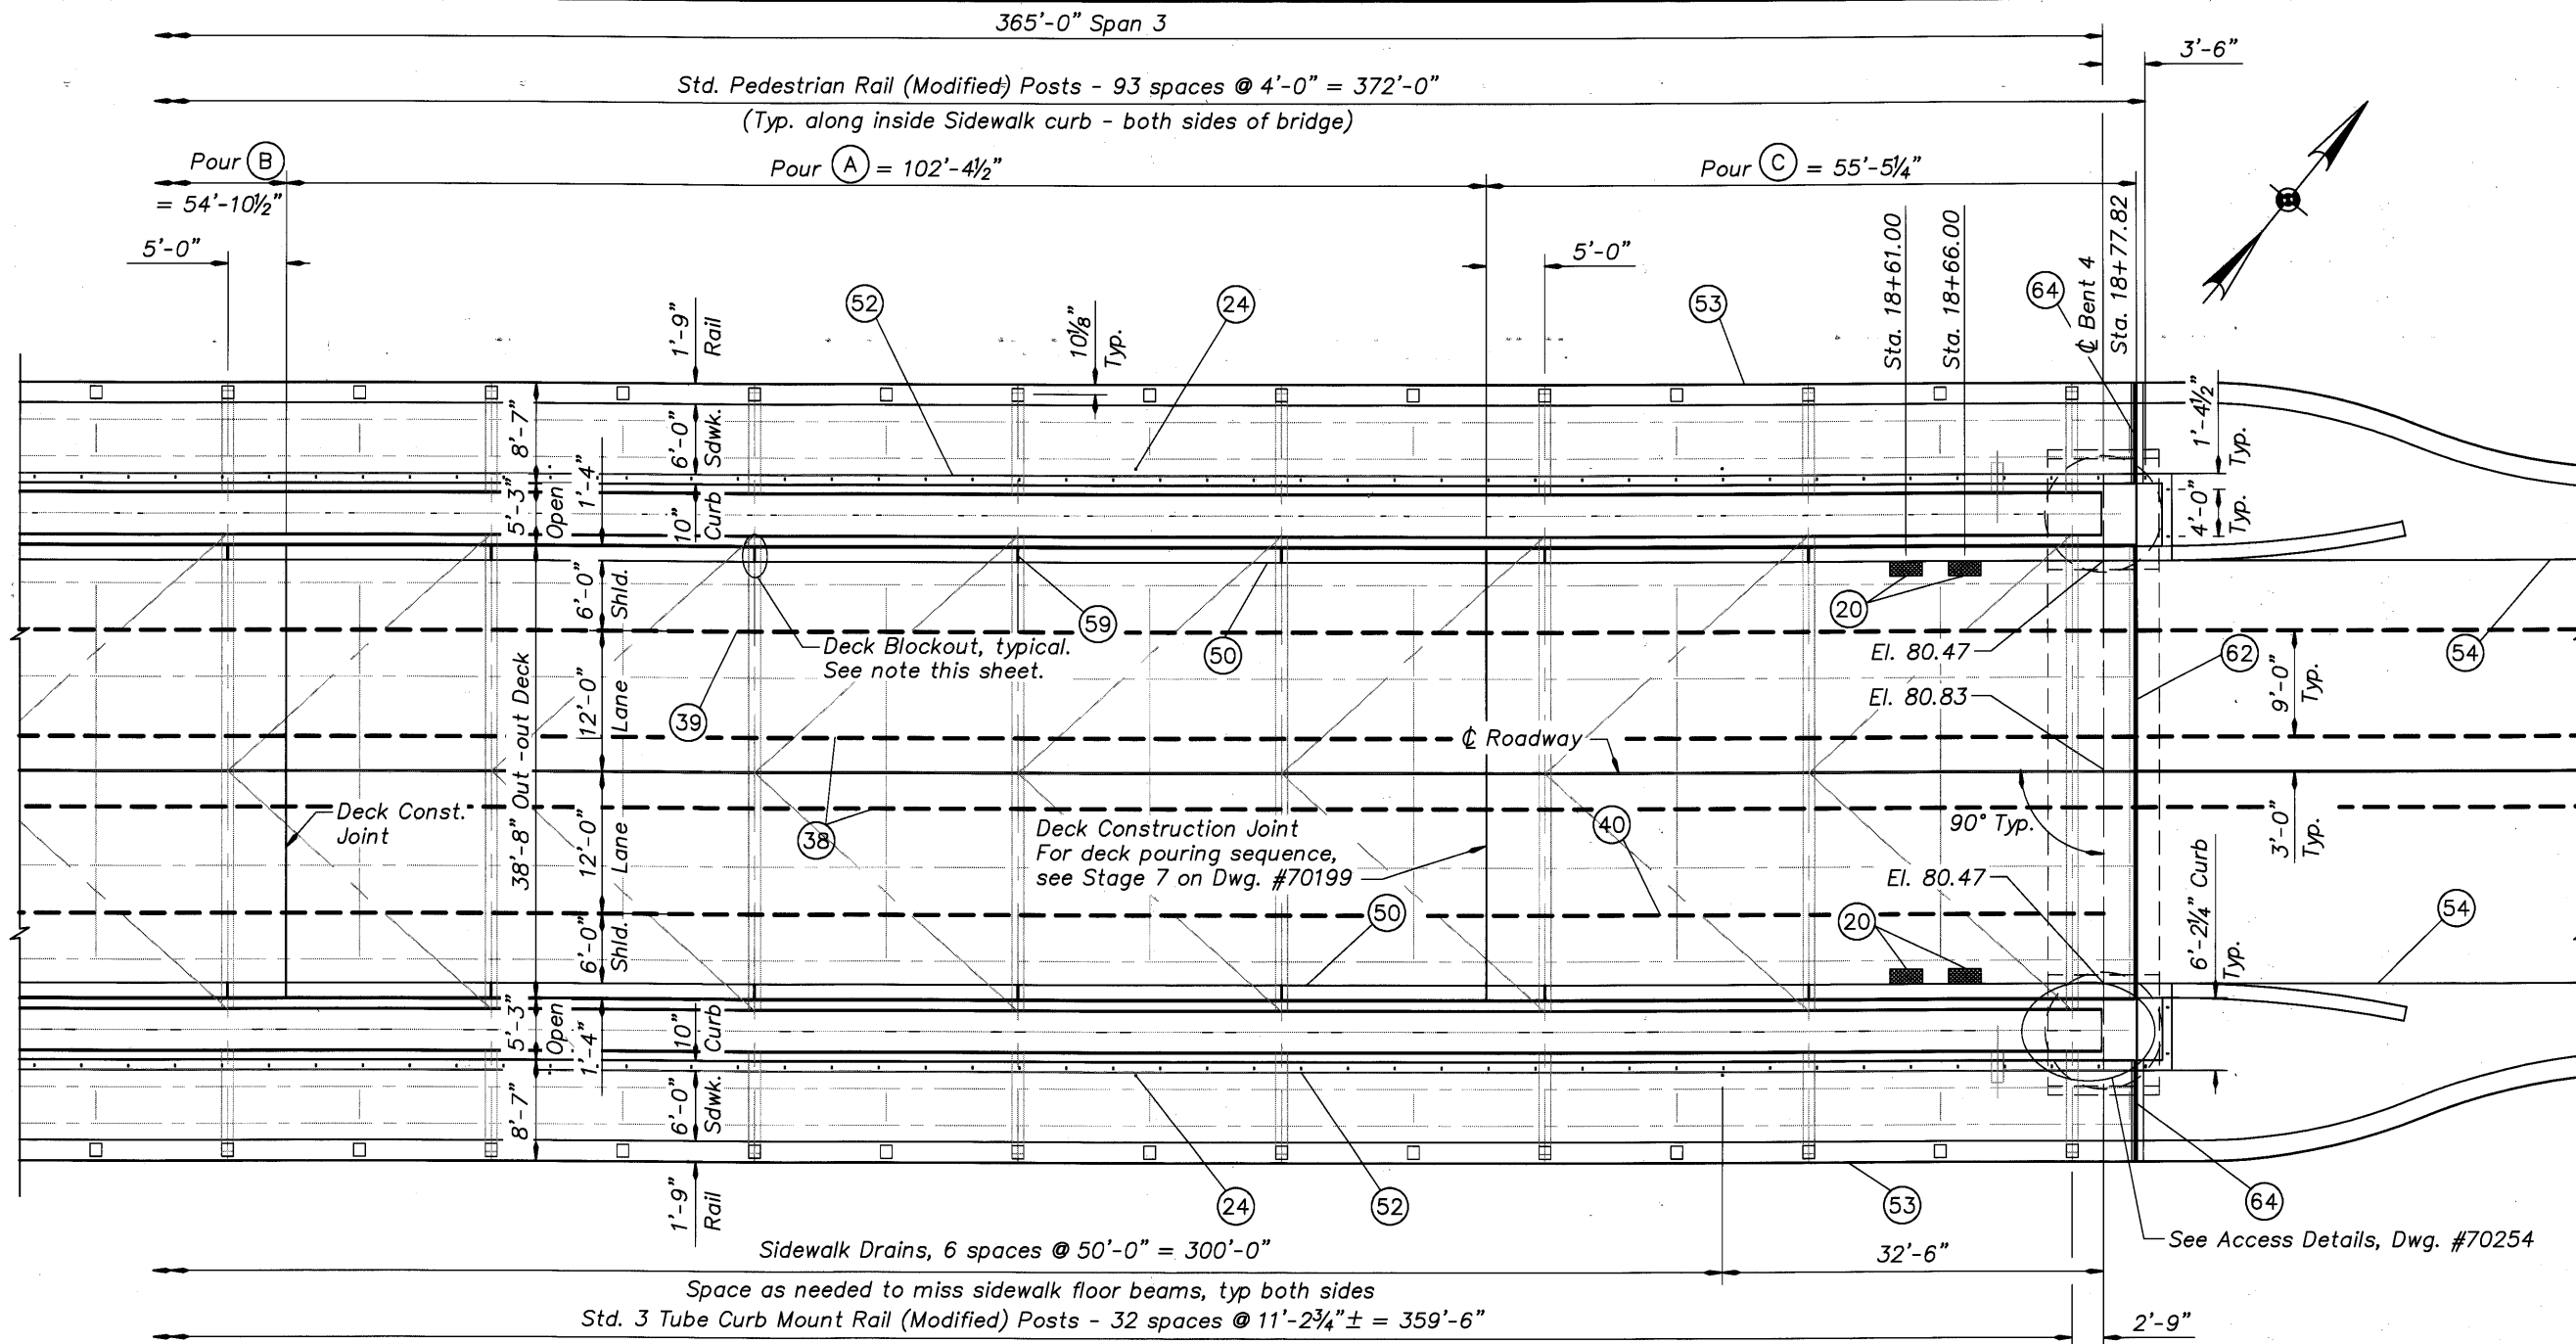

**Notes:**  
See Dwg. #70206 for Deck Plan Reference Notes.

Longitudinal reinforcing steel to extend from deck pour segments (A) to provide 1'-9" Min. lap splice with reinforcing in adjoining pours.

All sidewalk concrete to be included in Pour (D).

Provide deck blockout in edge of deck under rail joints at each end of each floorbeam. See Dwg. #70326 for details.

(Typ. along both edges of bridge)

**DECK PLAN - PARTIAL SPAN 3**

Scale : 1/8" = 1'-0"

**Notes (Cont):**

Deck elevations shown are taken at top of concrete at the intersection of  $\phi$  Bent and  $\phi$  Roadway and the intersection of  $\phi$  Bent and gutterline.

For lighting details and conduit locations, see Dwgs. #70343 to #70355.

DO NOT SCALE THIS DRAWING.  
FOLLOW DIMENSIONS. INDICATED  
SCALES CORRECT ONLY FOR  
FULL SIZE SHEET (22"x34").

DATE	REVISION	BY
03/09	As-Constructed	TDF
		J. Patton DRAFTED:
		Oliver Mueller CHECKED:
		Clifford Coulter DESIGNED:

**REVIEWED**

REGISTERED PROFESSIONAL ENGINEER  
74549 PE  
OREGON  
MARCH 09, 2005  
WILLIAM CORRY

**DAVID EVANS AND ASSOCIATES INC.**  
530 Center Street N.E., Suite 605  
Salem Oregon 97301  
Phone: 503.361.8635

EXPIRES: 12-31-05

CONNECTING COMMERCE AND COMMUNITY

**MULTNOMAH COUNTY BRIDGES**

TRANSPORTATION DIVISION

**OREGON DEPARTMENT OF TRANSPORTATION BRIDGE ENGINEERING SECTION**

<b>BRIDGE NO.</b>	20136
<b>DATE</b>	Sept. 2005
<b>CALC. BOOK</b>	


MULTNOMAH CHANNEL & PNWR ETC., SAUVIE ISLAND RD.

**DECK PLAN - SPAN 3 (2 OF 2)**

<b>SHEET</b>	24
<b>OF</b>	173
<b>DRAWING NO.</b>	70211



205'-0" Span 4

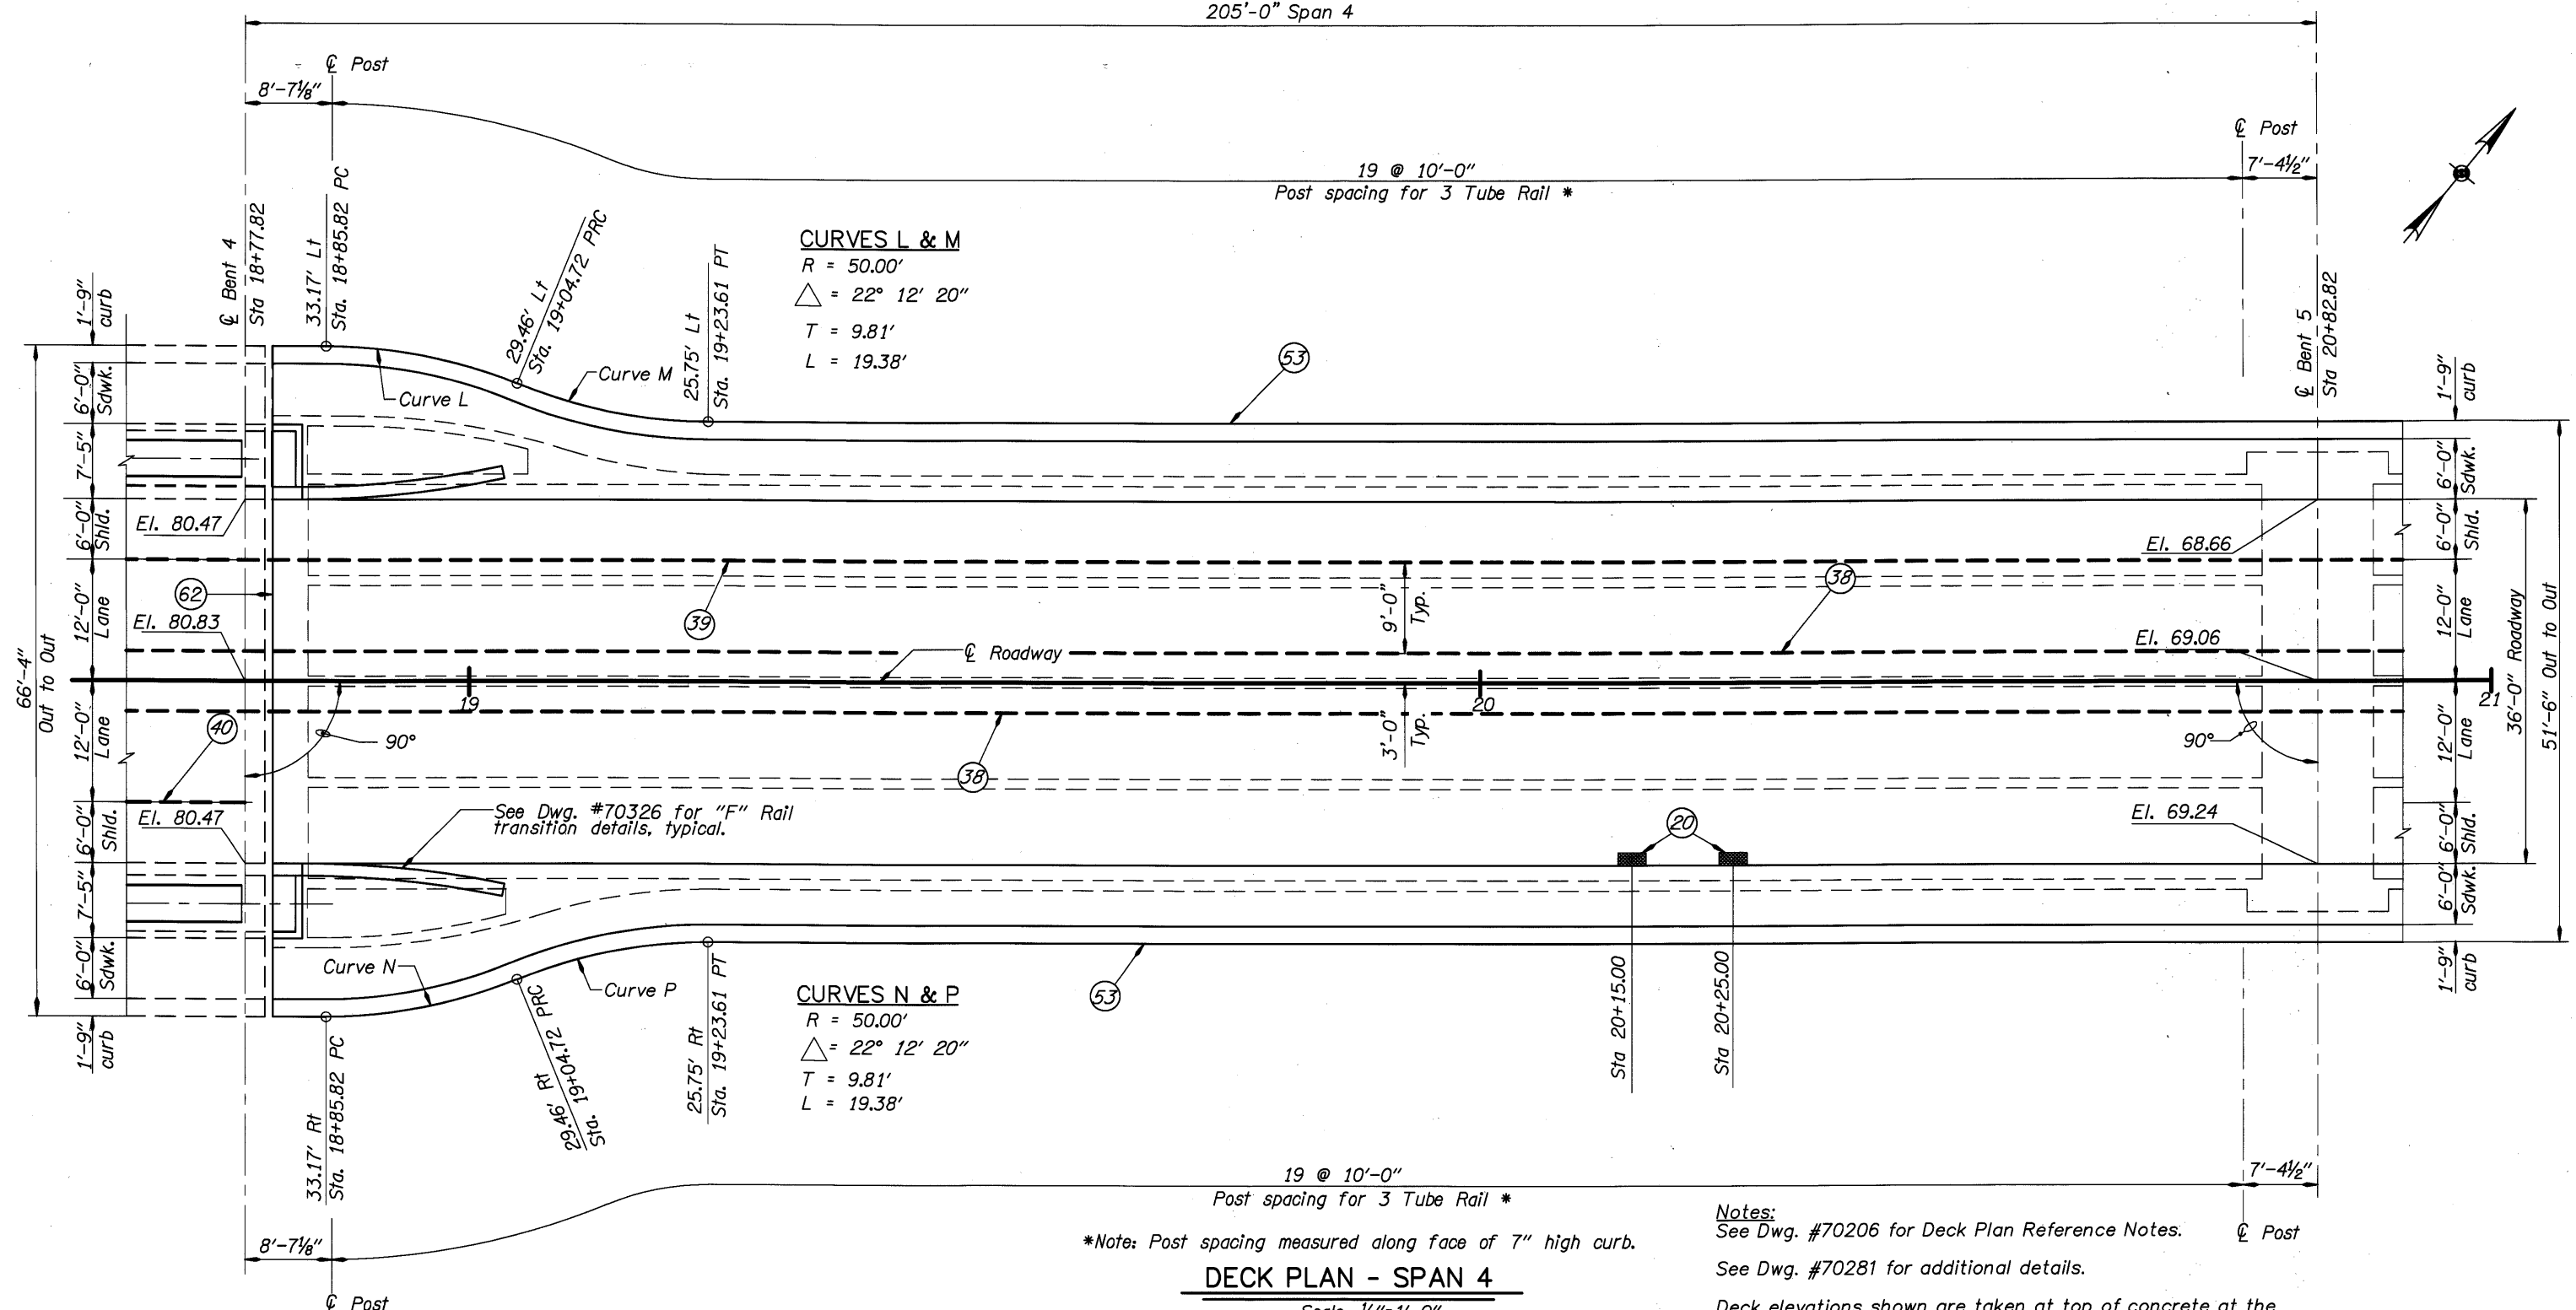

\*Note: Post spacing measured along face of 7" high curb.

**DECK PLAN - SPAN 4**

Scale: 1/8"=1'-0"

**Notes:**  
 See Dwg. #70206 for Deck Plan Reference Notes.  
 See Dwg. #70281 for additional details.  
 Deck elevations shown are taken at top of concrete at the intersection of  $\text{C}_{\text{Bent}}$  and  $\text{C}_{\text{Roadway}}$  and the intersection of  $\text{C}_{\text{Bent}}$  and gutterline.  
 Stations are along  $\text{C}_{\text{Roadway}}$  unless noted otherwise.  
 For lighting details and conduit locations, see Dwg. #70343 to #70355.


DO NOT SCALE THIS DRAWING. FOLLOW DIMENSIONS. INDICATED SCALES CORRECT ONLY FOR FULL SIZE SHEET (22"x34").

DATE	03/09	REVISION	As-Constructed	BY	Ken Johnson	REVIEWED			TRANSPORTATION DIVISION	BRIDGE NO.	20136	SHEET	25
					Josh Hewes		530 Center Street N.E., Suite 605 Salem Oregon 97301 Phone: 503.361.8635		BRIDGE ENGINEERING SECTION	DATE	Sept. 2005	DRAWING NO.	70212
					Adrienne Dietrich								

**CURVE DATA**

R = 300.00'  
 $\Delta = 96^\circ 24' 35''$   
 T = 335.59"  
 L = 504.80'

195'-0" Span 5 (measured along  $\phi$  Roadway)

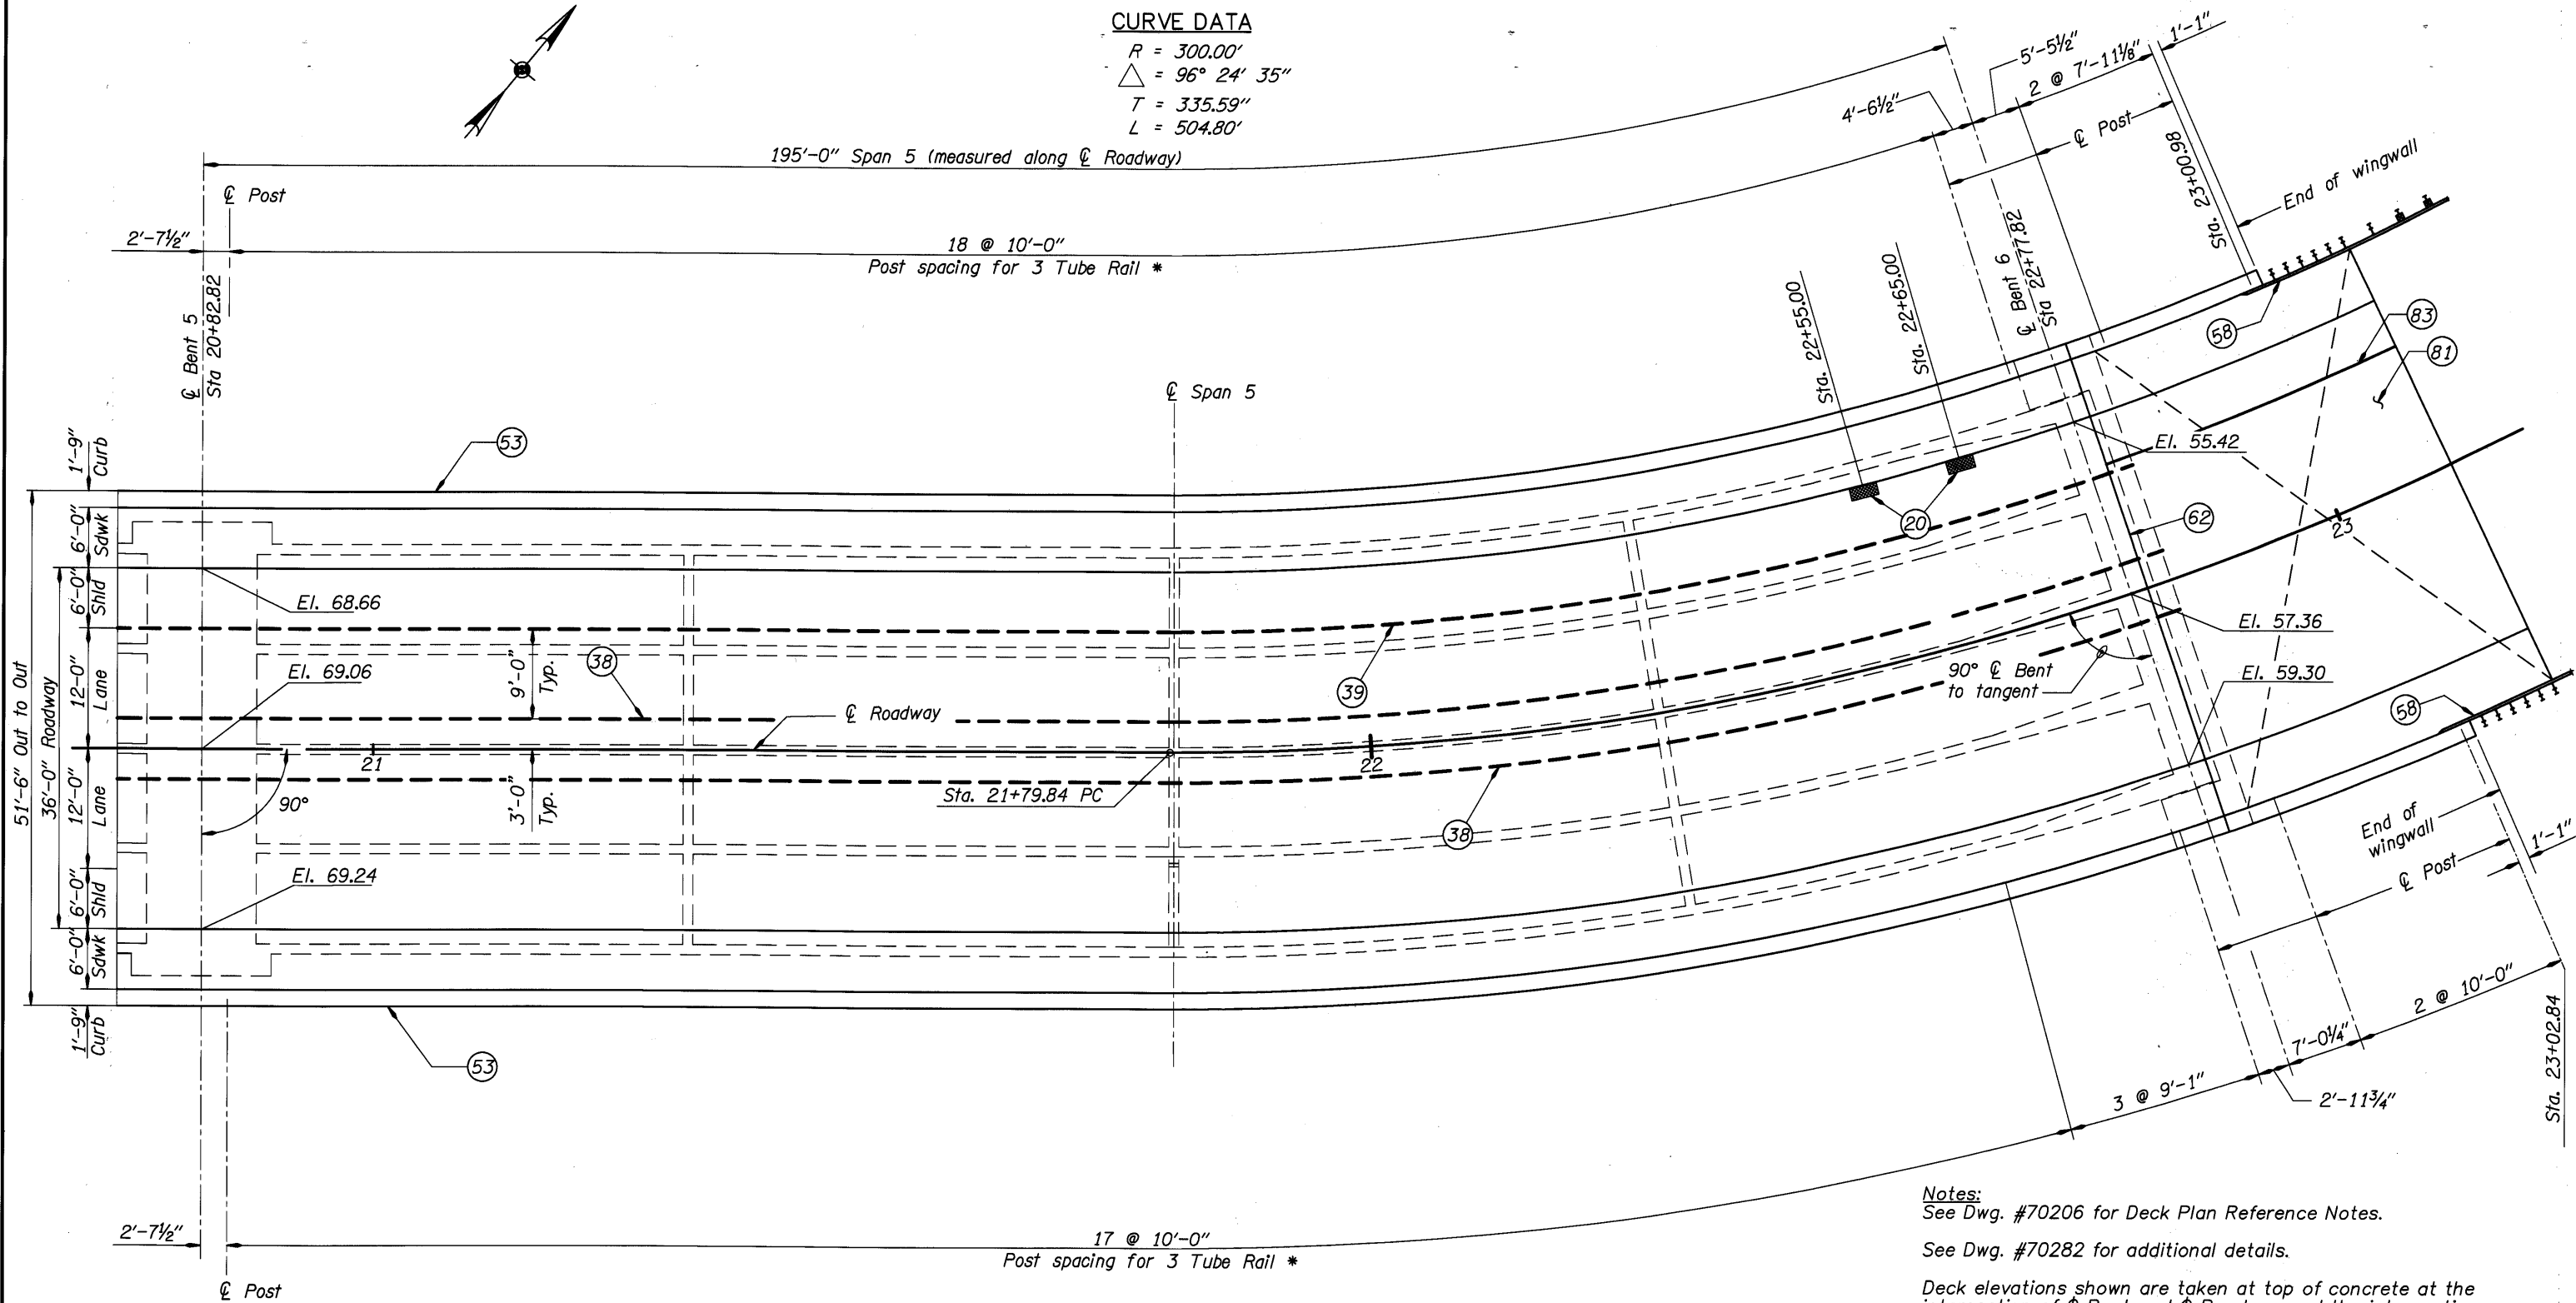

DO NOT SCALE THIS DRAWING.  
 FOLLOW DIMENSIONS. INDICATED  
 SCALES CORRECT ONLY FOR  
 FULL SIZE SHEET (22"x34").

\* Note: Post spacing measured along face of 7" high curb.

**DECK PLAN - SPAN 5**  
 Scale: 1/8" = 1'-0"

**Notes:**  
 See Dwg. #70206 for Deck Plan Reference Notes.  
 See Dwg. #70282 for additional details.  
 Deck elevations shown are taken at top of concrete at the intersection of  $\phi$  Bent and  $\phi$  Roadway and the intersection of  $\phi$  Bent and gutterline.  
 Stations are along  $\phi$  Roadway unless noted otherwise.  
 For lighting details and conduit locations, see Dwgs. #70343 to #70355.

DATE	REVISION	BY
08/05	End panel constr. joint	KWC
03/09	As-Constructed	TDF

DRAFTED: Ken Johnson  
 CHECKED: Josh Hewes  
 DESIGNED: Adrienne Dietrich

**REVIEWED**

**DAVID EVANS AND ASSOCIATES INC.**  
 530 Center Street N.E., Suite 605  
 Salem Oregon 97301  
 Phone: 503.361.8635

CONNECTING COMMERCE AND COMMUNITY

**MULTNOMAH COUNTY BRIDGES**

TRANSPORTATION DIVISION

**OREGON DEPARTMENT OF TRANSPORTATION BRIDGE ENGINEERING SECTION**

<b>BRIDGE NO.</b> 20136	<b>MULTNOMAH CHANNEL &amp; PNWR ETC., SAUVIE ISLAND RD.</b>	<b>SHEET</b> 26 OF 173
<b>DATE</b> Sept. 2005		
<b>CALC. BOOK</b>		
<b>DECK PLAN - SPAN 5</b>		<b>DRAWING NO.</b> 70213


**TYPICAL DECK STEEL**

Transverse Steel

#5 Straight bars @ 7" centers max, top and bottom of deck, typical.  
 6 additional-#5 x 10'-0" @ 7" max. ctrs. evenly spaced between typical transverse steel, top and bottom, both sides of deck at each floorbeam.  
 Place transverse bars perpendicular to  $\phi$  Roadway.

Longitudinal Steel

4-#5 x 21'-2" @ 3" max. ctrs., top and bottom of deck, btwn. deck block-outs, each edge of deck.  
 5-#5 bars x cont. @ 3" max. ctrs. top and bottom of deck, btwn. deck block-out and closest roadway stringer, both sides of deck.  
 70-#5 bars x cont. @ 6" max. ctrs., top and bottom of deck, typical.  
 Place longitudinal bars parallel to  $\phi$  Roadway.

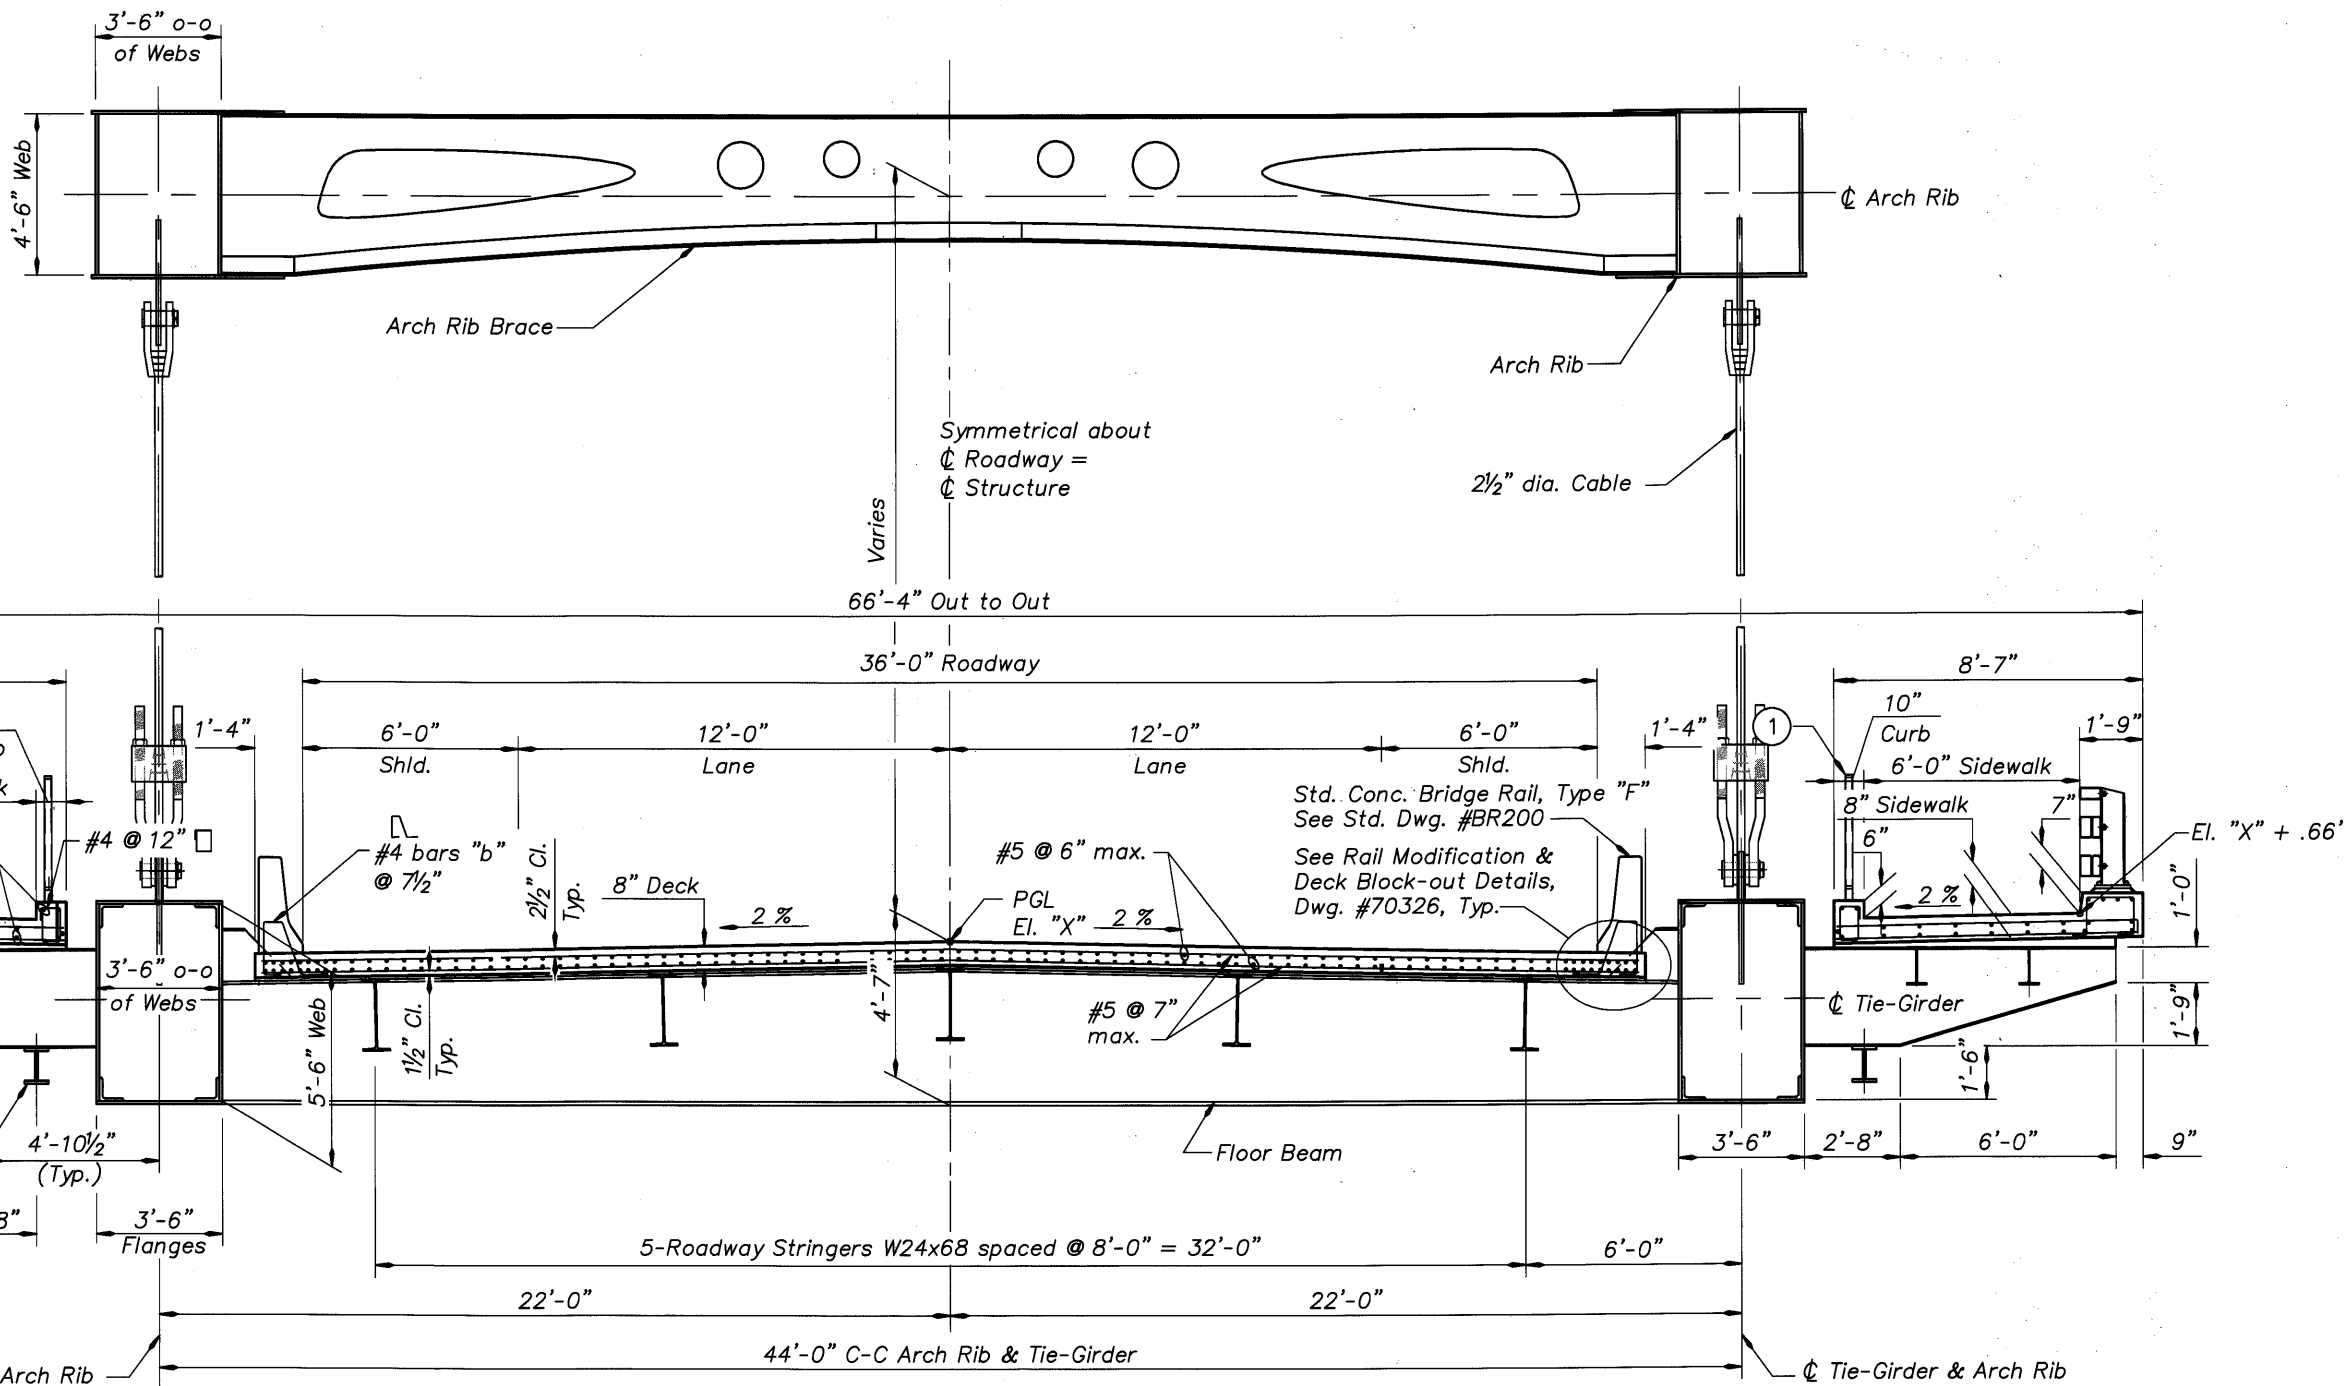

**TYPICAL SECTION - SPAN 3**

Scale: 3/8" = 1'-0"

(For details and reinforcement not shown, see Dwg. #70210, #70211, and #70324.)

① Std. Pedestrian Rail (Modified), (typ.) See Dwg. #70324.

Note: See Dwg. #70336 and #70337 for Deck Drainage details.  
 See Dwg. #70338 for sidewalk drainage details.  
 See Dwg. #70360 for utility conduit and hanger details.  
 See Dwg. #70343 to #70355 for lighting details and conduit locations.

DO NOT SCALE THIS DRAWING.  
 FOLLOW DIMENSIONS. INDICATED  
 SCALES CORRECT ONLY FOR  
 FULL SIZE SHEET (22"x34").

DATE	REVISION	BY
03/09	As-Constructed	TDF

DRAFTED: J. Patton  
 CHECKED: Shonn Mills  
 DESIGNED: Clifford Coulter

**REVIEWED**

REGISTERED PROFESSIONAL ENGINEER  
 74549 PE  
 OREGON  
 EXPIRES: 12-31-05

**DAVID EVANS AND ASSOCIATES INC.**  
 530 Center Street N.E., Suite 605  
 Salem Oregon 97301  
 Phone: 503.361.8635

CONNECTING COMMERCIAL AND COMMUNITY

**MULTNOMAH COUNTY BRIDGES**

TRANSPORTATION DIVISION

**OREGON DEPARTMENT OF TRANSPORTATION BRIDGE ENGINEERING SECTION**

BRIDGE NO. 20136  
 DATE Sept. 2005  
 CALC. BOOK

MULTNOMAH CHANNEL & PNWR ETC., SAUVIE ISLAND RD.

TYPICAL SECTION - SPAN 3


SHEET 27 OF 173  
 DRAWING NO. 70214

UNDEFORMED ARCH (FABRICATED) GEOMETRY (1)					
ARCH RIB			TIE-GIRDER		
W. P.	STATION	ELEVATION	W. P.	STATION	ELEVATION
A0	15+15.65	84.02	T0	15+15.65	84.02
A1	15+49.75	113.90	T1	15+38.11	84.41
A2	15+68.08	126.69	T2	15+60.58	84.77
A3	15+87.45	137.83	T3	15+83.04	85.03
A4	16+07.80	147.05	T4	16+05.51	85.15
A5	16+29.00	154.08	T5	16+27.97	85.15
A6	16+50.84	158.77	T6	16+50.44	85.03
A7	16+73.04	161.17	T7	16+72.90	84.83
A8	16+95.37	161.59	T8	16+95.37	84.56


FINAL D.L. PANEL POINT DEFLECTIONS (2)					
ARCH RIB			TIE-GIRDER		
W. P.	X	Y	W. P.	X	Y
A0	-0.08	0.00	T0	-0.08	0.00
A1	0.00	-0.11	T1	-0.07	-0.10
A2	0.01	-0.13	T2	-0.07	-0.19
A3	0.01	-0.13	T3	-0.07	-0.24
A4	0.00	-0.11	T4	-0.06	-0.24
A5	-0.02	-0.07	T5	-0.06	-0.21
A6	-0.03	-0.03	T6	-0.06	-0.16
A7	-0.04	0.01	T7	-0.05	-0.11
A8	-0.05	0.02	T8	-0.05	-0.09

NOTES:

- The Undeformed Arch (Fabricated) Geometry table is the geometry to which the arch and tie shall be fabricated assuming drop-in erection method shown on Dwg. #70198. The coordinates allow for deformation under final dead loads, including decks, sidewalks, utilities, and railings, and for cable tensioning adjustment and time dependent effects during construction excluding future wearing surface. These deformations are shown in the Final D.L. Panel Point Deflections table.
  - The Arch Rib and Tie-Girder shall be fabricated such that they conform to the Final Deformed Geometry table (see Dwg. #70218) after all final dead loads are placed, including deck, sidewalks, utilities, and railings and for tensioning adjustments and time dependent effects during construction excluding future wearing surface. Blocking to compensate for these deflections will produce the coordinates shown in the Undeformed Arch (Fabricated) Geometry table.
- See Dwg. #70217 for Geometry at intermediate construction stages.

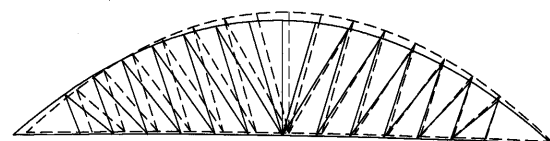

**BLOCKING DIAGRAM**  
N.T.S.

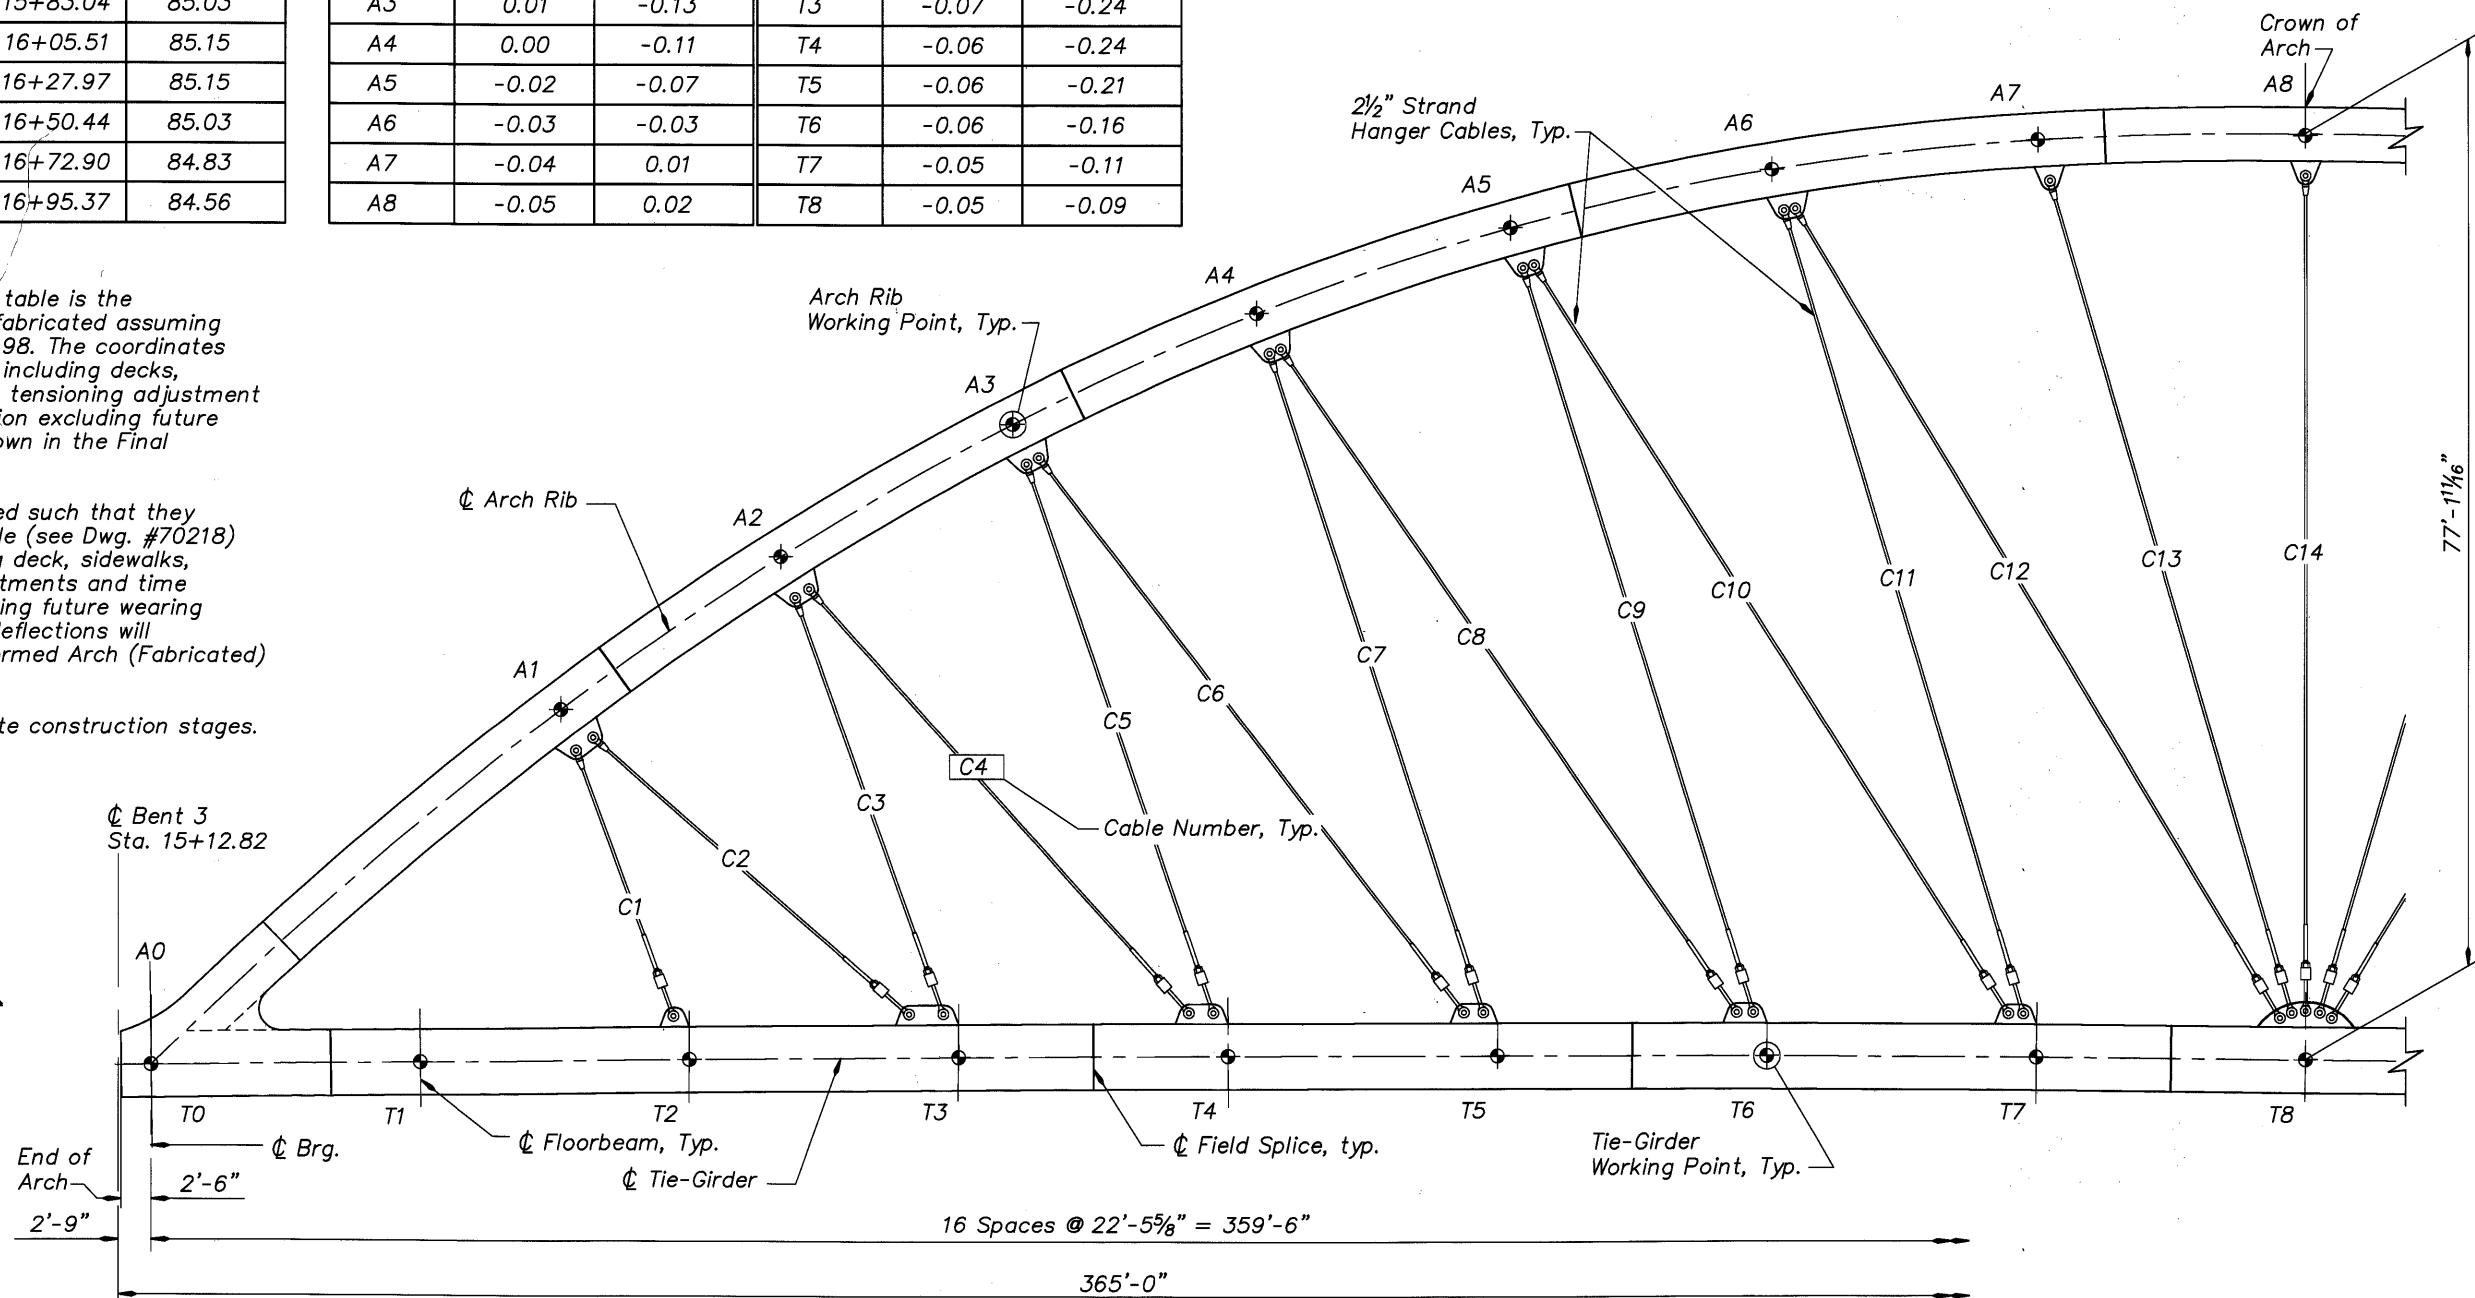

**HALF ARCH ELEVATION**  
(Final Deformed Geometry shown)  
Scale: 1/8" = 1'-0"

DO NOT SCALE THIS DRAWING.  
FOLLOW DIMENSIONS. INDICATED  
SCALES CORRECT ONLY FOR  
FULL SIZE SHEET (22"x34").

DATE	REVISION	BY
03/09	As-Constructed	TDF

DRAFTED:	J. Patton
CHECKED:	Oliver Mueller
DESIGNED:	Gernot Komar

REVIEWED

**DAVID EVANS AND ASSOCIATES, INC.**  
530 Center Street N.E., Suite 605  
Salem Oregon 97301  
Phone: 503.361.8635

EXPIRES: 6-30-06

CONNECTING COMMERCE AND COMMUNITY

**MULTNOMAH COUNTY BRIDGES**


TRANSPORTATION DIVISION

**OREGON DEPARTMENT OF TRANSPORTATION BRIDGE ENGINEERING SECTION**

BRIDGE NO.	20136	MULTNOMAH CHANNEL & PNWR ETC., SAUVIE ISLAND RD.	SHEET 28 OF 173.
DATE	Sept. 2005		
CALC. BOOK			
ARCH ELEVATION AND GEOMETRY (1 OF 3)		DRAWING NO. 70215	

UNDEFORMED ARCH (FABRICATED) GEOMETRY ①					
ARCH RIB			TIE-GIRDER		
W. P.	STATION	ELEVATION	W. P.	STATION	ELEVATION
A8	16+95.37	161.59	T8	16+95.37	84.56
A9	17+17.68	160.58	T9	17+17.83	84.24
A10	17+39.80	157.60	T10	17+40.30	83.86
A11	17+61.50	152.37	T11	17+62.77	83.39
A12	17+82.52	144.88	T12	17+85.23	82.81
A13	18+02.67	135.28	T13	18+07.70	82.10
A14	18+21.82	123.83	T14	18+30.16	81.26
A15	18+39.95	110.81	T15	18+52.62	80.29
A16	18+75.09	79.20	T16	18+75.09	79.20

FINAL D.L. PANEL POINT DEFLECTIONS ②					
ARCH RIB			TIE-GIRDER		
W. P.	X	Y	W. P.	X	Y
A8	-0.05	0.02	T8	-0.05	-0.09
A9	-0.05	0.01	T9	-0.05	-0.11
A10	-0.06	-0.03	T10	-0.04	-0.16
A11	-0.08	-0.07	T11	-0.04	-0.21
A12	-0.09	-0.11	T12	-0.04	-0.24
A13	-0.11	-0.13	T13	-0.03	-0.23
A14	-0.11	-0.13	T14	-0.03	-0.19
A15	-0.10	-0.11	T15	-0.02	-0.10
A16	-0.02	0.00	T16	-0.02	0.00

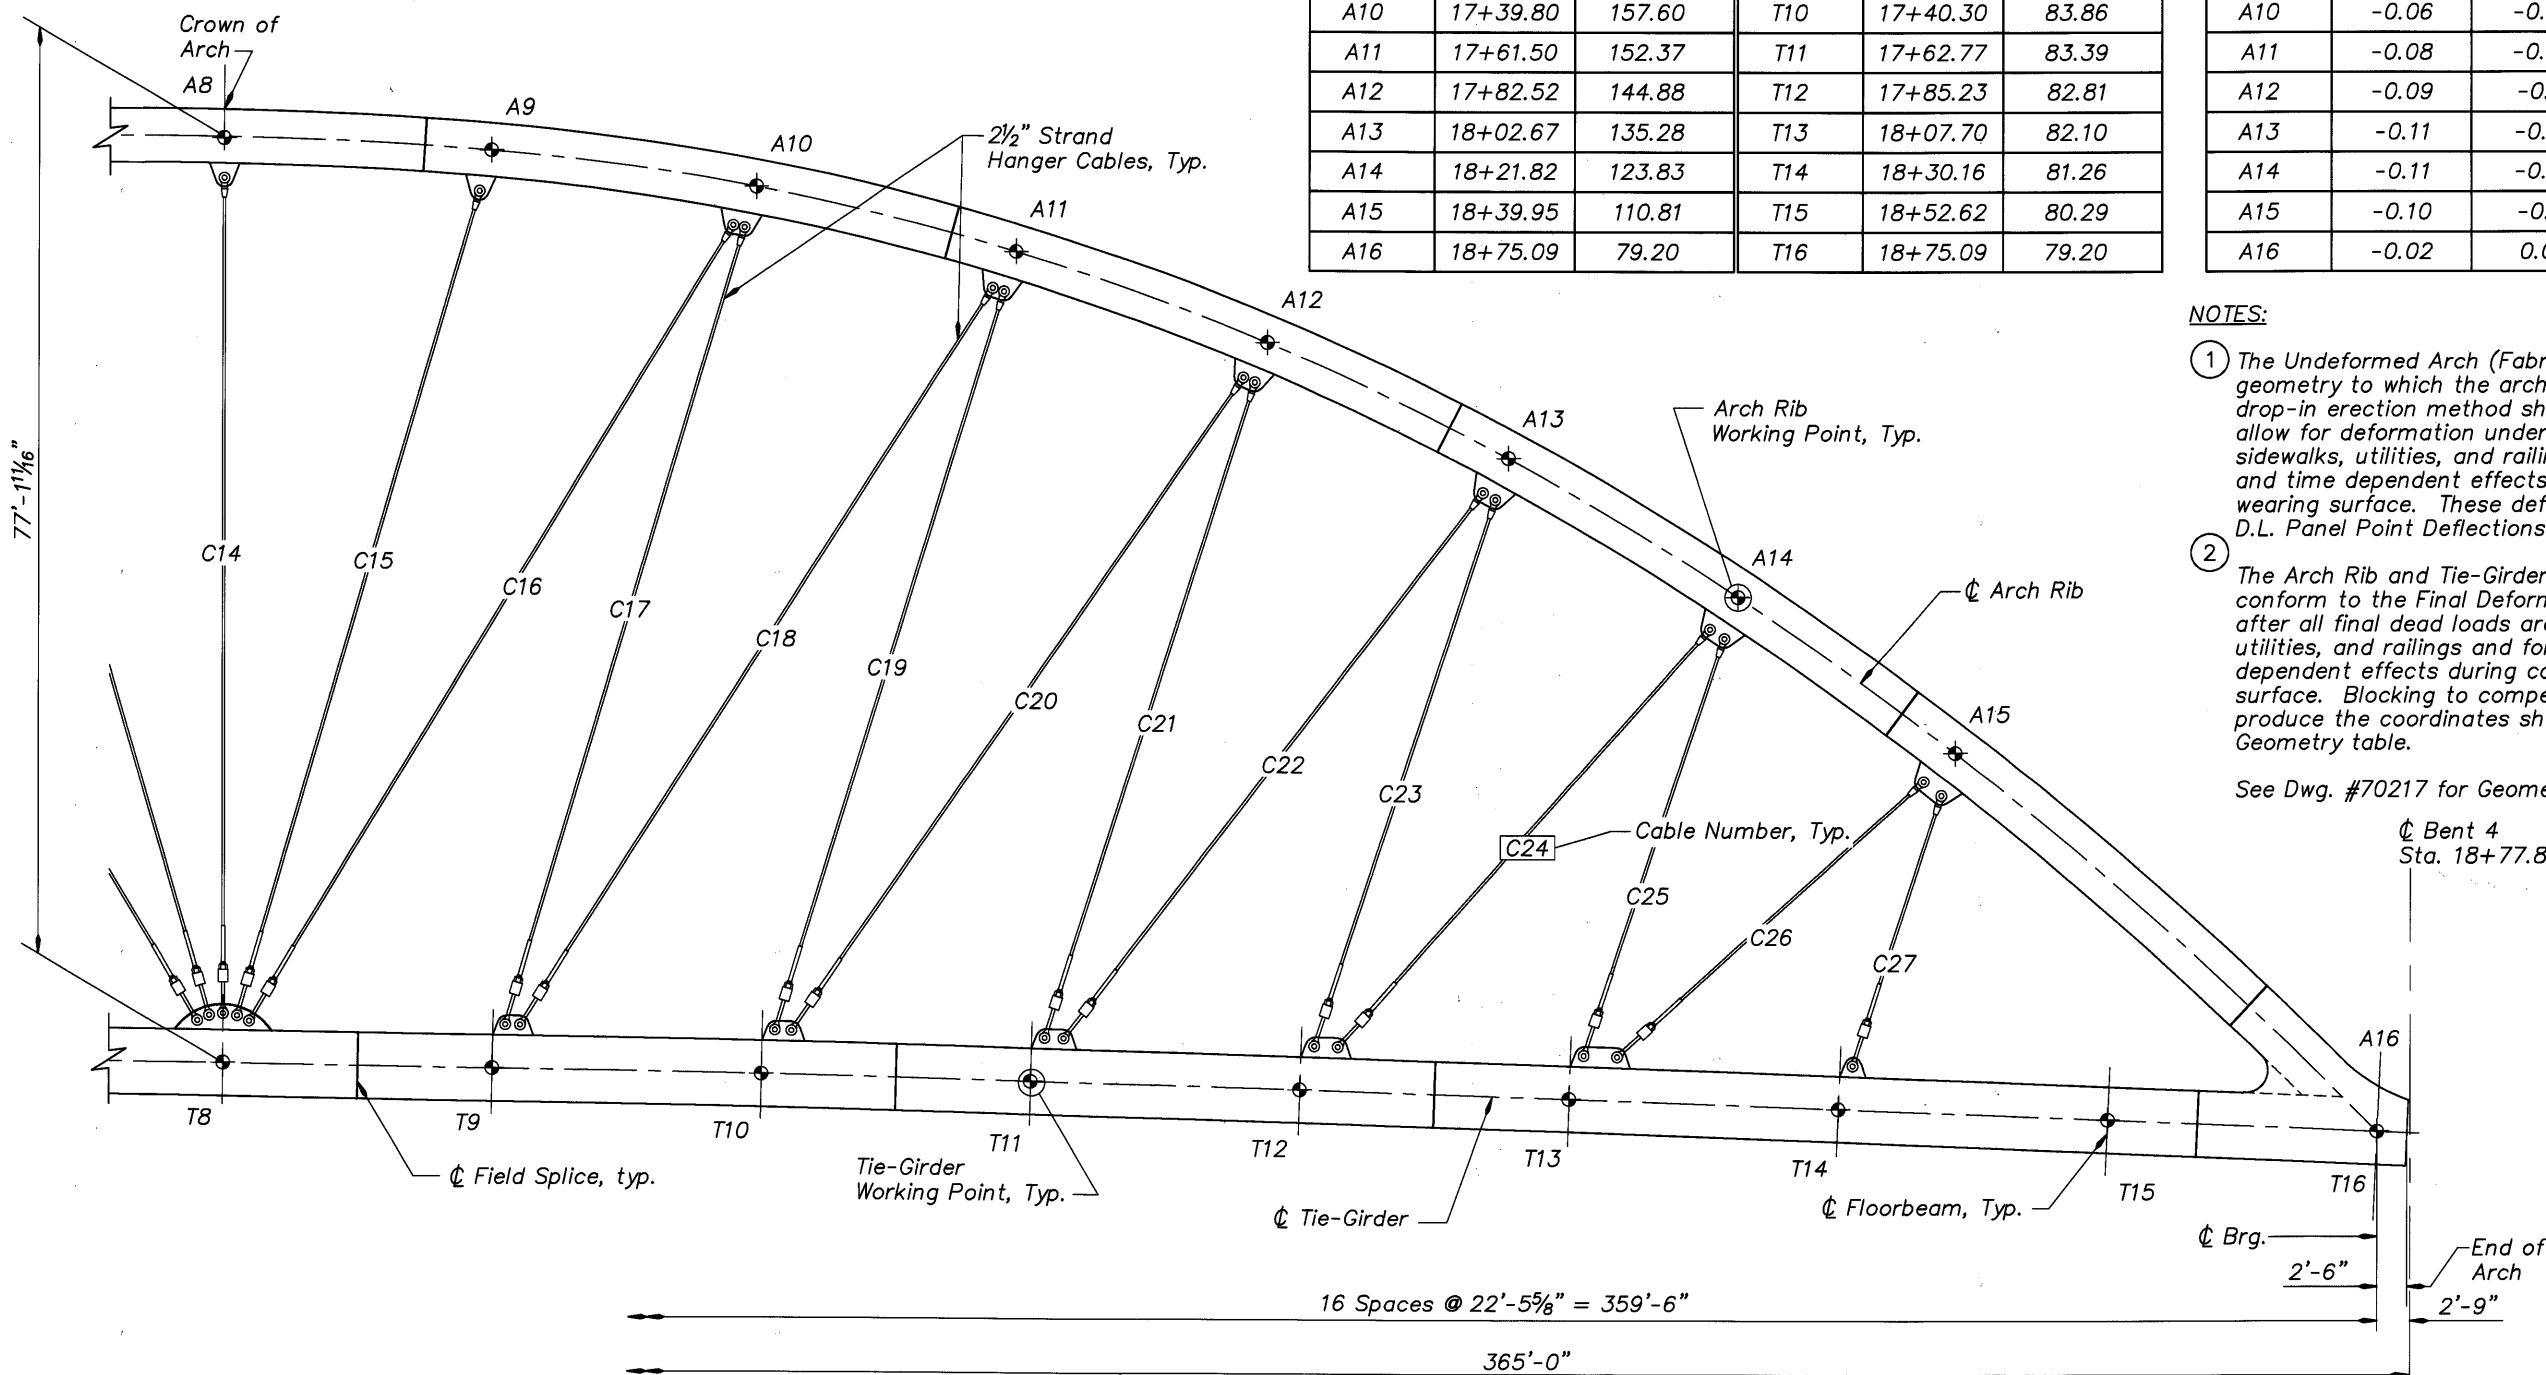

NOTES:

① The Undeformed Arch (Fabricated) Geometry table is the geometry to which the arch and tie shall be fabricated assuming drop-in erection method shown on Dwg. #70198. The coordinates allow for deformation under final dead loads, including decks, sidewalks, utilities, and railings, and for cable tensioning adjustment and time dependent effects during construction excluding future wearing surface. These deformations are shown in the Final D.L. Panel Point Deflections table.

② The Arch Rib and Tie-Girder shall be fabricated such that they conform to the Final Deformed Geometry table (see Dwg. #70218) after all final dead loads are placed, including deck, sidewalks, utilities, and railings and for tensioning adjustments and time dependent effects during construction excluding future wearing surface. Blocking to compensate for these deflections will produce the coordinates shown in the Undeformed Arch (Fabricated) Geometry table.

See Dwg. #70217 for Geometry at intermediate construction stages.

⊕ Bent 4  
Sta. 18+77.82

DO NOT SCALE THIS DRAWING. FOLLOW DIMENSIONS. INDICATED SCALES CORRECT ONLY FOR FULL SIZE SHEET (22"x34").

HALF ARCH ELEVATION  
(Final Deformed Geometry shown)  
Scale: 1/8" = 1'-0"

DATE	REVISION	BY
03/09	As-Constructed	TDF

DRAFTED: J. Patton  
CHECKED: Oliver Mueller  
DESIGNED: Gernot Komar

REVIEWED

DAVID EVANS AND ASSOCIATES INC.  
530 Center Street N.E., Suite 605  
Salem Oregon 97301  
Phone: 503.361.8635

CONNECTING COMMERCE AND COMMUNITY

MULTNOMAH COUNTY BRIDGES

TRANSPORTATION DIVISION

OREGON DEPARTMENT OF TRANSPORTATION  
BRIDGE ENGINEERING SECTION



BRIDGE NO.	20136
DATE	Sept. 2005
CALC. BOOK	

MULTNOMAH CHANNEL & PNWR ETC., SAUVIE ISLAND RD.

ARCH ELEVATION AND GEOMETRY (2 OF 3)

SHEET	29
OF	173
DRAWING NO.	70216

DO NOT SCALE THIS DRAWING. FOLLOW DIMENSIONS. INDICATED SCALES CORRECT ONLY FOR FULL SIZE SHEET (22"x34").

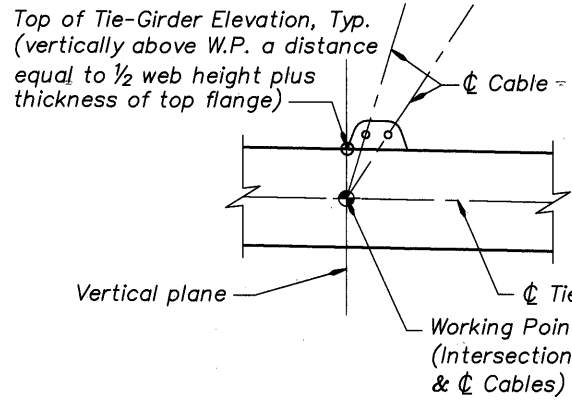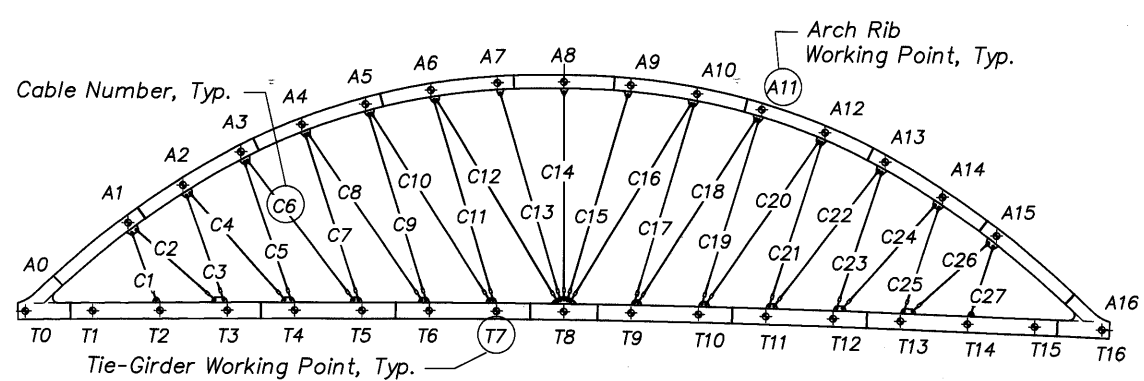

**CONSTRUCTION STAGES:**  
 Stages and associated values in table below represent the suggested schematic erection sequence shown on Dwg. #70198, and #70199.  
 Results shown are at the end of each stage. ZERO cable force is an adjustment after Stage 4.6b and must take place before deck pour, Stage 4.7a.  
 Refer to Arch Erection Notes on Dwg. #70199.

ARCH ELEVATION SCHEMATIC


TIE-GIRDER W.P.	CABLE	STAGE 4.6a				Adjustments before STAGE 4.6b	STAGE 4.6b				STAGE 4.7a				STAGE 4.7d				FINAL DEFORMED GEOMETRY					
		CABLE TENSION (k)	W.P. STATION	W.P. EL.	TOP of TIE-GIRDER ELEVATION	CABLE POST-TENSION (k)	CABLE TENSION (k)	W.P. STATION	W.P. EL.	TOP of TIE-GIRDER ELEVATION	CABLE TENSION (k)	W.P. STATION	W.P. EL.	TOP of TIE-GIRDER ELEVATION	CABLE TENSION (k)	W.P. STATION	W.P. EL.	TOP of TIE-GIRDER ELEVATION	CABLE TENSION (k)	W.P. STATION	W.P. EL.	TOP of TIE-GIRDER ELEVATION		
T1	—	—	15+38.08	84.35	87.19	—	—	15+38.08	84.35	87.19	—	15+38.06	84.33	87.17	—	15+38.04	84.31	87.14	—	15+38.04	84.30	87.13		
T2	C1	SLACK	15+60.54	84.67	87.50	—	ZERO	15+60.54	84.67	87.50	24.7	15+60.53	84.63	87.47	65.0	15+60.51	84.59	87.43	76.5	15+60.51	84.58	87.41		
T3	C2	25.6	15+83.01	84.90	87.73	—	ZERO	15+83.01	84.90	87.74	34.2	15+83.00	84.85	87.68	32.5	15+82.98	84.81	87.64	34.9	15+82.98	84.79	87.62		
	C3	SLACK																					59.0	69.4
T4	C4	19.7	16+05.48	85.02	87.86	20.0	ZERO	16+05.48	85.03	87.86	40.6	16+05.46	84.97	87.80	36.3	16+05.45	84.93	87.76	37.7	16+05.45	84.91	87.74		
	C5	SLACK																					59.3	69.6
T5	C6	34.2	16+27.94	85.04	87.87	20.0	ZERO	16+27.94	85.04	87.87	54.5	16+27.93	84.99	87.82	51.4	16+27.92	84.95	87.78	52.7	16+27.91	84.94	87.77		
	C7	SLACK																					58.0	68.0
T6	C8	48.4	16+50.41	84.95	87.78	—	ZERO	16+50.41	84.95	87.79	52.9	16+50.40	84.92	87.75	51.9	16+50.39	84.88	87.72	53.4	16+50.38	84.87	87.71		
	C9	SLACK																					52.6	61.6
T7	C10	56.3	16+72.88	84.77	87.60	—	ZERO	16+72.88	84.77	87.61	65.1	16+72.87	84.75	87.59	66.9	16+72.85	84.72	87.56	68.9	16+72.85	84.72	87.55		
	C11	SLACK																					45.5	53.3
T8	C12	56.3	16+95.34	84.51	87.34	—	ZERO	16+95.34	84.51	87.35	71.8	16+95.33	84.50	87.34	79.7	16+95.32	84.48	87.31	83.7	16+95.32	84.47	87.30		
	C13	SLACK																					46.6	54.6
	C14	SLACK																					56.3	66.0
	C15	SLACK																					46.7	54.8
T9	C16	55.5	17+17.81	84.19	87.02	—	ZERO	17+17.81	84.19	87.02	70.9	17+17.80	84.17	87.00	78.9	17+17.79	84.14	86.97	52.7	17+17.79	84.13	86.97		
	C17	SLACK																					45.0	67.2
T10	C18	55.2	17+40.28	83.78	86.61	—	ZERO	17+40.28	83.78	86.62	63.7	17+40.27	83.75	86.58	65.3	17+40.26	83.71	86.55	60.8	17+40.26	83.70	86.54		
	C19	SLACK																					51.9	60.8
T11	C20	47.1	17+62.75	83.28	86.11	—	ZERO	17+62.75	83.29	86.12	30.1	17+62.74	83.24	86.07	51.4	17+62.73	83.20	86.03	51.6	17+62.73	83.18	86.01		
	C21	SLACK																					57.2	67.1
T12	C22	33.1	17+85.21	82.68	85.51	20.0	ZERO	17+85.21	82.69	85.52	53.2	17+85.21	82.63	85.46	50.0	17+85.20	82.58	85.42	51.2	17+85.20	82.57	85.40		
	C23	SLACK																					58.4	68.6
T13	C24	19.4	18+07.68	81.98	84.81	—	ZERO	18+07.68	81.98	84.81	40.4	18+07.67	81.93	84.76	36.0	18+07.66	81.88	84.71	37.4	18+07.66	81.86	84.70		
	C25	SLACK																					58.3	68.6
T14	C26	27.6	18+30.15	81.16	83.99	—	ZERO	18+30.15	81.16	83.99	27.4	18+30.14	81.12	83.95	35.5	18+30.13	81.08	83.91	38.0	18+30.13	81.07	83.90		
	C27	SLACK																					65.0	76.5
T15	—	—	18+52.61	80.23	83.07	—	—	18+52.61	80.23	83.07	—	18+52.61	80.21	83.05	—	18+52.60	80.19	83.02	—	18+52.60	80.18	83.01		

Xref: Odobur.dwg, ODOT0460\_AG\_01.dwg, Arch2d.dwg

DATE 03/09	REVISION As-Constructed	BY TDF	DRAFTED: J. Patton	<p><b>DAVID EVANS AND ASSOCIATES INC.</b>                  530 Center Street N.E., Suite 605                  Salem Oregon 97301                  Phone: 503.361.8635</p>	<p>MULTNOMAH COUNTY BRIDGES</p>	TRANSPORTATION DIVISION OREGON DEPARTMENT OF TRANSPORTATION BRIDGE ENGINEERING SECTION	BRIDGE NO. 20136	MULTNOMAH CHANNEL & PNWR ETC., SAUVIE ISLAND RD.	SHEET 30 OF 173
			CHECKED: Oliver Mueller				DATE Sept. 2005		DRAWING NO. 70217
			DESIGNED: Gernot Komar				CALC. BOOK		ARCH ELEVATION AND GEOMETRY (3 OF 3)

INTERMEDIATE DEFORMED GEOMETRY (4)					
ARCH RIB			TIE-GIRDER		
W. P.	STATION	ELEVATION	W. P.	STATION	ELEVATION
A0	15+15.58	84.02	T0	15+15.58	84.02
A1	15+49.76	113.80	T1	15+38.04	84.31
A2	15+68.10	126.57	T2	15+60.51	84.59
A3	15+87.46	137.71	T3	15+82.98	84.81
A4	16+07.80	146.95	T4	16+05.45	84.93
A5	16+28.98	154.01	T5	16+27.92	84.95
A6	16+50.80	158.75	T6	16+50.39	84.88
A7	16+73.00	161.18	T7	16+72.85	84.72
A8	16+95.32	161.61	T8	16+95.32	84.48
A9	17+17.63	160.58	T9	17+17.79	84.14
A10	17+39.74	157.57	T10	17+40.26	83.71
A11	17+61.43	152.30	T11	17+62.73	83.20
A12	17+82.43	144.78	T12	17+85.20	82.58
A13	18+02.57	135.16	T13	18+07.67	81.88
A14	18+21.72	123.71	T14	18+30.13	81.08
A15	18+39.85	110.71	T15	18+52.60	80.19
A16	18+75.07	79.20	T16	18+75.07	79.20

FINAL DEFORMED GEOMETRY (5)					
ARCH RIB			TIE-GIRDER		
W. P.	STATION	ELEVATION	W. P.	STATION	ELEVATION
A0	15+15.57	84.02	T0	15+15.57	84.02
A1	15+49.76	113.79	T1	15+38.04	84.30
A2	15+68.10	126.56	T2	15+60.51	84.58
A3	15+87.46	137.70	T3	15+82.98	84.79
A4	16+07.80	146.94	T4	16+05.45	84.91
A5	16+28.98	154.01	T5	16+27.91	84.94
A6	16+50.80	158.75	T6	16+50.38	84.87
A7	16+73.00	161.18	T7	16+72.85	84.72
A8	16+95.32	161.61	T8	16+95.32	84.47
A9	17+17.62	160.58	T9	17+17.79	84.13
A10	17+39.74	157.57	T10	17+40.26	83.70
A11	17+61.42	152.30	T11	17+62.73	83.18
A12	17+82.43	144.77	T12	17+85.20	82.57
A13	18+02.56	135.15	T13	18+07.66	81.86
A14	18+21.71	123.70	T14	18+30.13	81.07
A15	18+39.84	110.70	T15	18+52.60	80.18
A16	18+75.07	79.20	T16	18+75.07	79.20

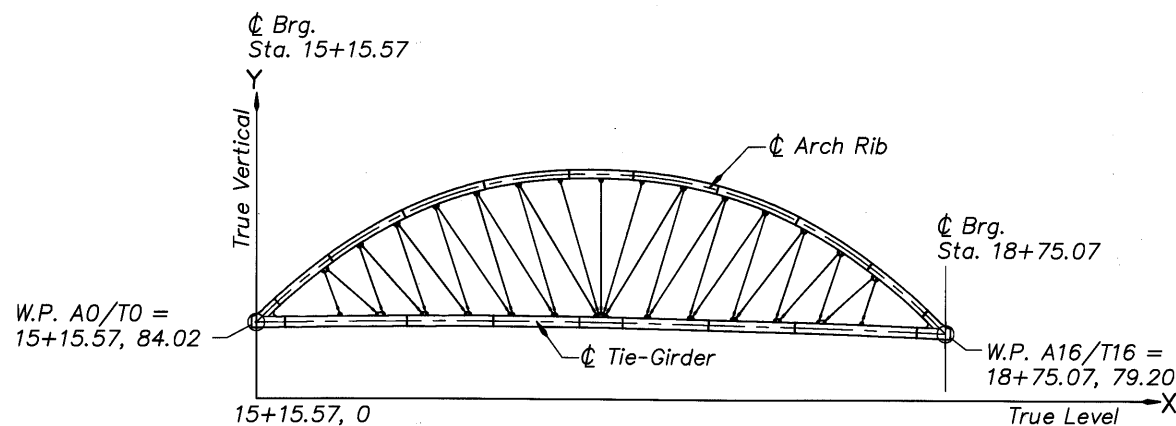

**EQUATION - FINAL DEFORMED ARCH RIB**

No Scale

- (3) **SPAN 3**  
 Equations: For  $X < 1695.32$ :  
 $Y = -0.00067622 (1695.32 - X)^{2.25} - 0.01340082 (X) + 184.33$   
 For  $X \geq 1695.32$ :  
 $Y = -0.00067622 (X - 1695.32)^{2.25} - 0.01340082 (X) + 184.33$

**Notes:**



- (3) Equations apply to arch after all superimposed dead loads are placed, including deck, sidewalks, utilities, and railings and for tensioning adjustments and time dependent effects during construction excluding future wearing surface. Refer to Final Deformed Geometry Table.
- (4) The Intermediate Deformed Geometry table gives the deformed shape of the arch and tie-girder after tensioning adjustments from Stage 6b, and after placement of deck and sidewalk loads of Stage 4.7d. Refer to Dwg. #70198, and #70199 for description of stages.
- (5) The Final Deformed Geometry table gives the final shape of the arch and tie-girder after all superimposed dead loads are placed, including deck, sidewalks, utilities, and railings and for tensioning adjustments and time dependent effects during construction excluding future wearing surface.

DO NOT SCALE THIS DRAWING. FOLLOW DIMENSIONS. INDICATED SCALES CORRECT ONLY FOR FULL SIZE SHEET (22"x34").

DATE 03/09	REVISION As-Constructed	BY TDF	DRAFTED: J. Patton	DESIGNER DAVID EVANS AND ASSOCIATES INC. 530 Center Street N.E., Suite 605 Salem Oregon 97301 Phone: 503.361.8835	CONNECTING COMMERCE AND COMMUNITY MULTNOMAH COUNTY BRIDGES TRANSPORTATION DIVISION OREGON DEPARTMENT OF TRANSPORTATION BRIDGE ENGINEERING SECTION	BRIDGE NO. 20136	MULTNOMAH CHANNEL & PNWR ETC., SAUVIE ISLAND RD.	SHEET 31 OF 173.
						DATE Sept. 2005		DRAWING NO. 70218
			CHECKED: Oliver Mueller	EXPIRES: 6-30-06		CALC. BOOK	ARCH AND TIE-GIRDER DEFORMED GEOMETRIES	
			REVIEWED: Clifford Coulter					


Xref: Odotbr.dwg ODOT0460 AG\_02.dwg Arch2.dwg



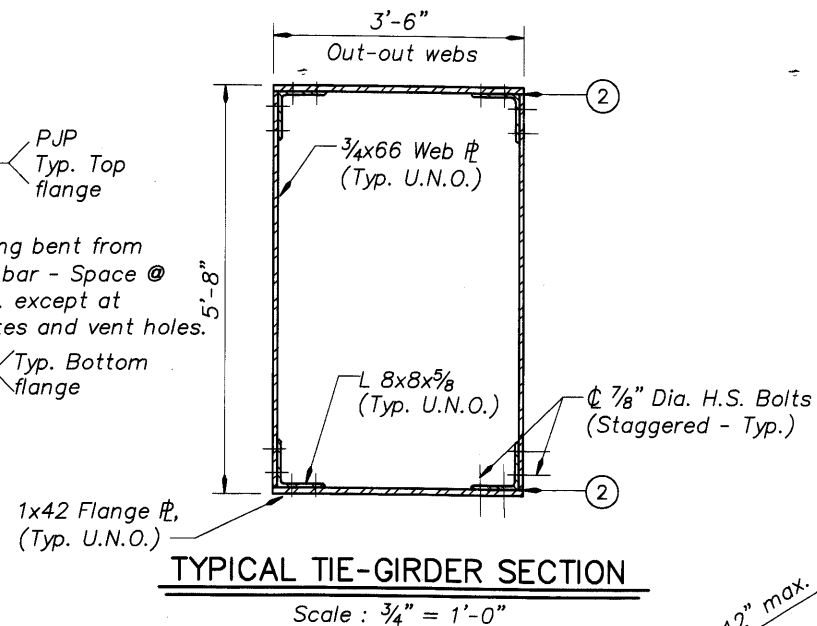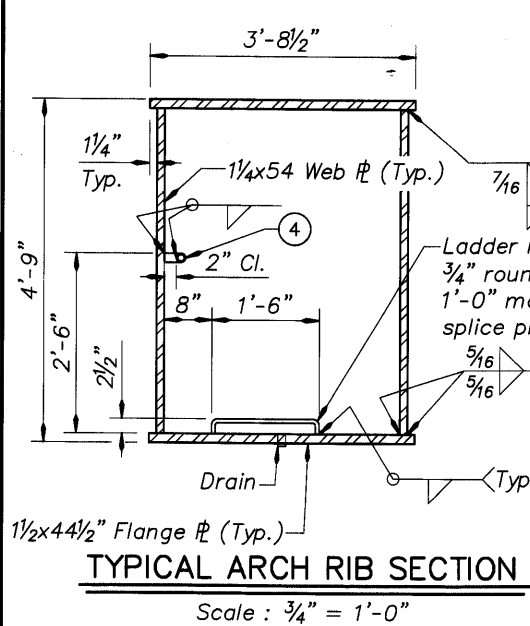

**Notes:**

- ① 2'-0"x3'-0" access opening centered on arch rib web face (Upper door on Traffic side of arch. Lower door on sidewalk side of arch). See Dwg. #70253.
- ② Maximum gap at edge of web plate = 1/8". Seal all gaps with clear silicone caulk.
- ③ Provide 3 - 6" dia. vent hole between each W.P. in bottom flange of tie-girder and arch rib. Space approximately as shown, maintaining 2'-6" min. clearance from flange splice plates and 1'-0" min. clearance from diaphragms. See Dwg. #70257 for details.
- ④ Provide 1 1/2" dia. Std. pipe handrail and supports continuous through each arch rib, between arch knuckle splices as shown in PART ELEVATION. Space support pipes at 5'-0" maximum. No handrail is required across bolted field splices or arch hanger areas.
- ⑤ For sizing and location of Commemorative Plaque see Specifications. For attachment use galvanized 3/16" Z-Bracket attached to existing knuckle web plate bolts.

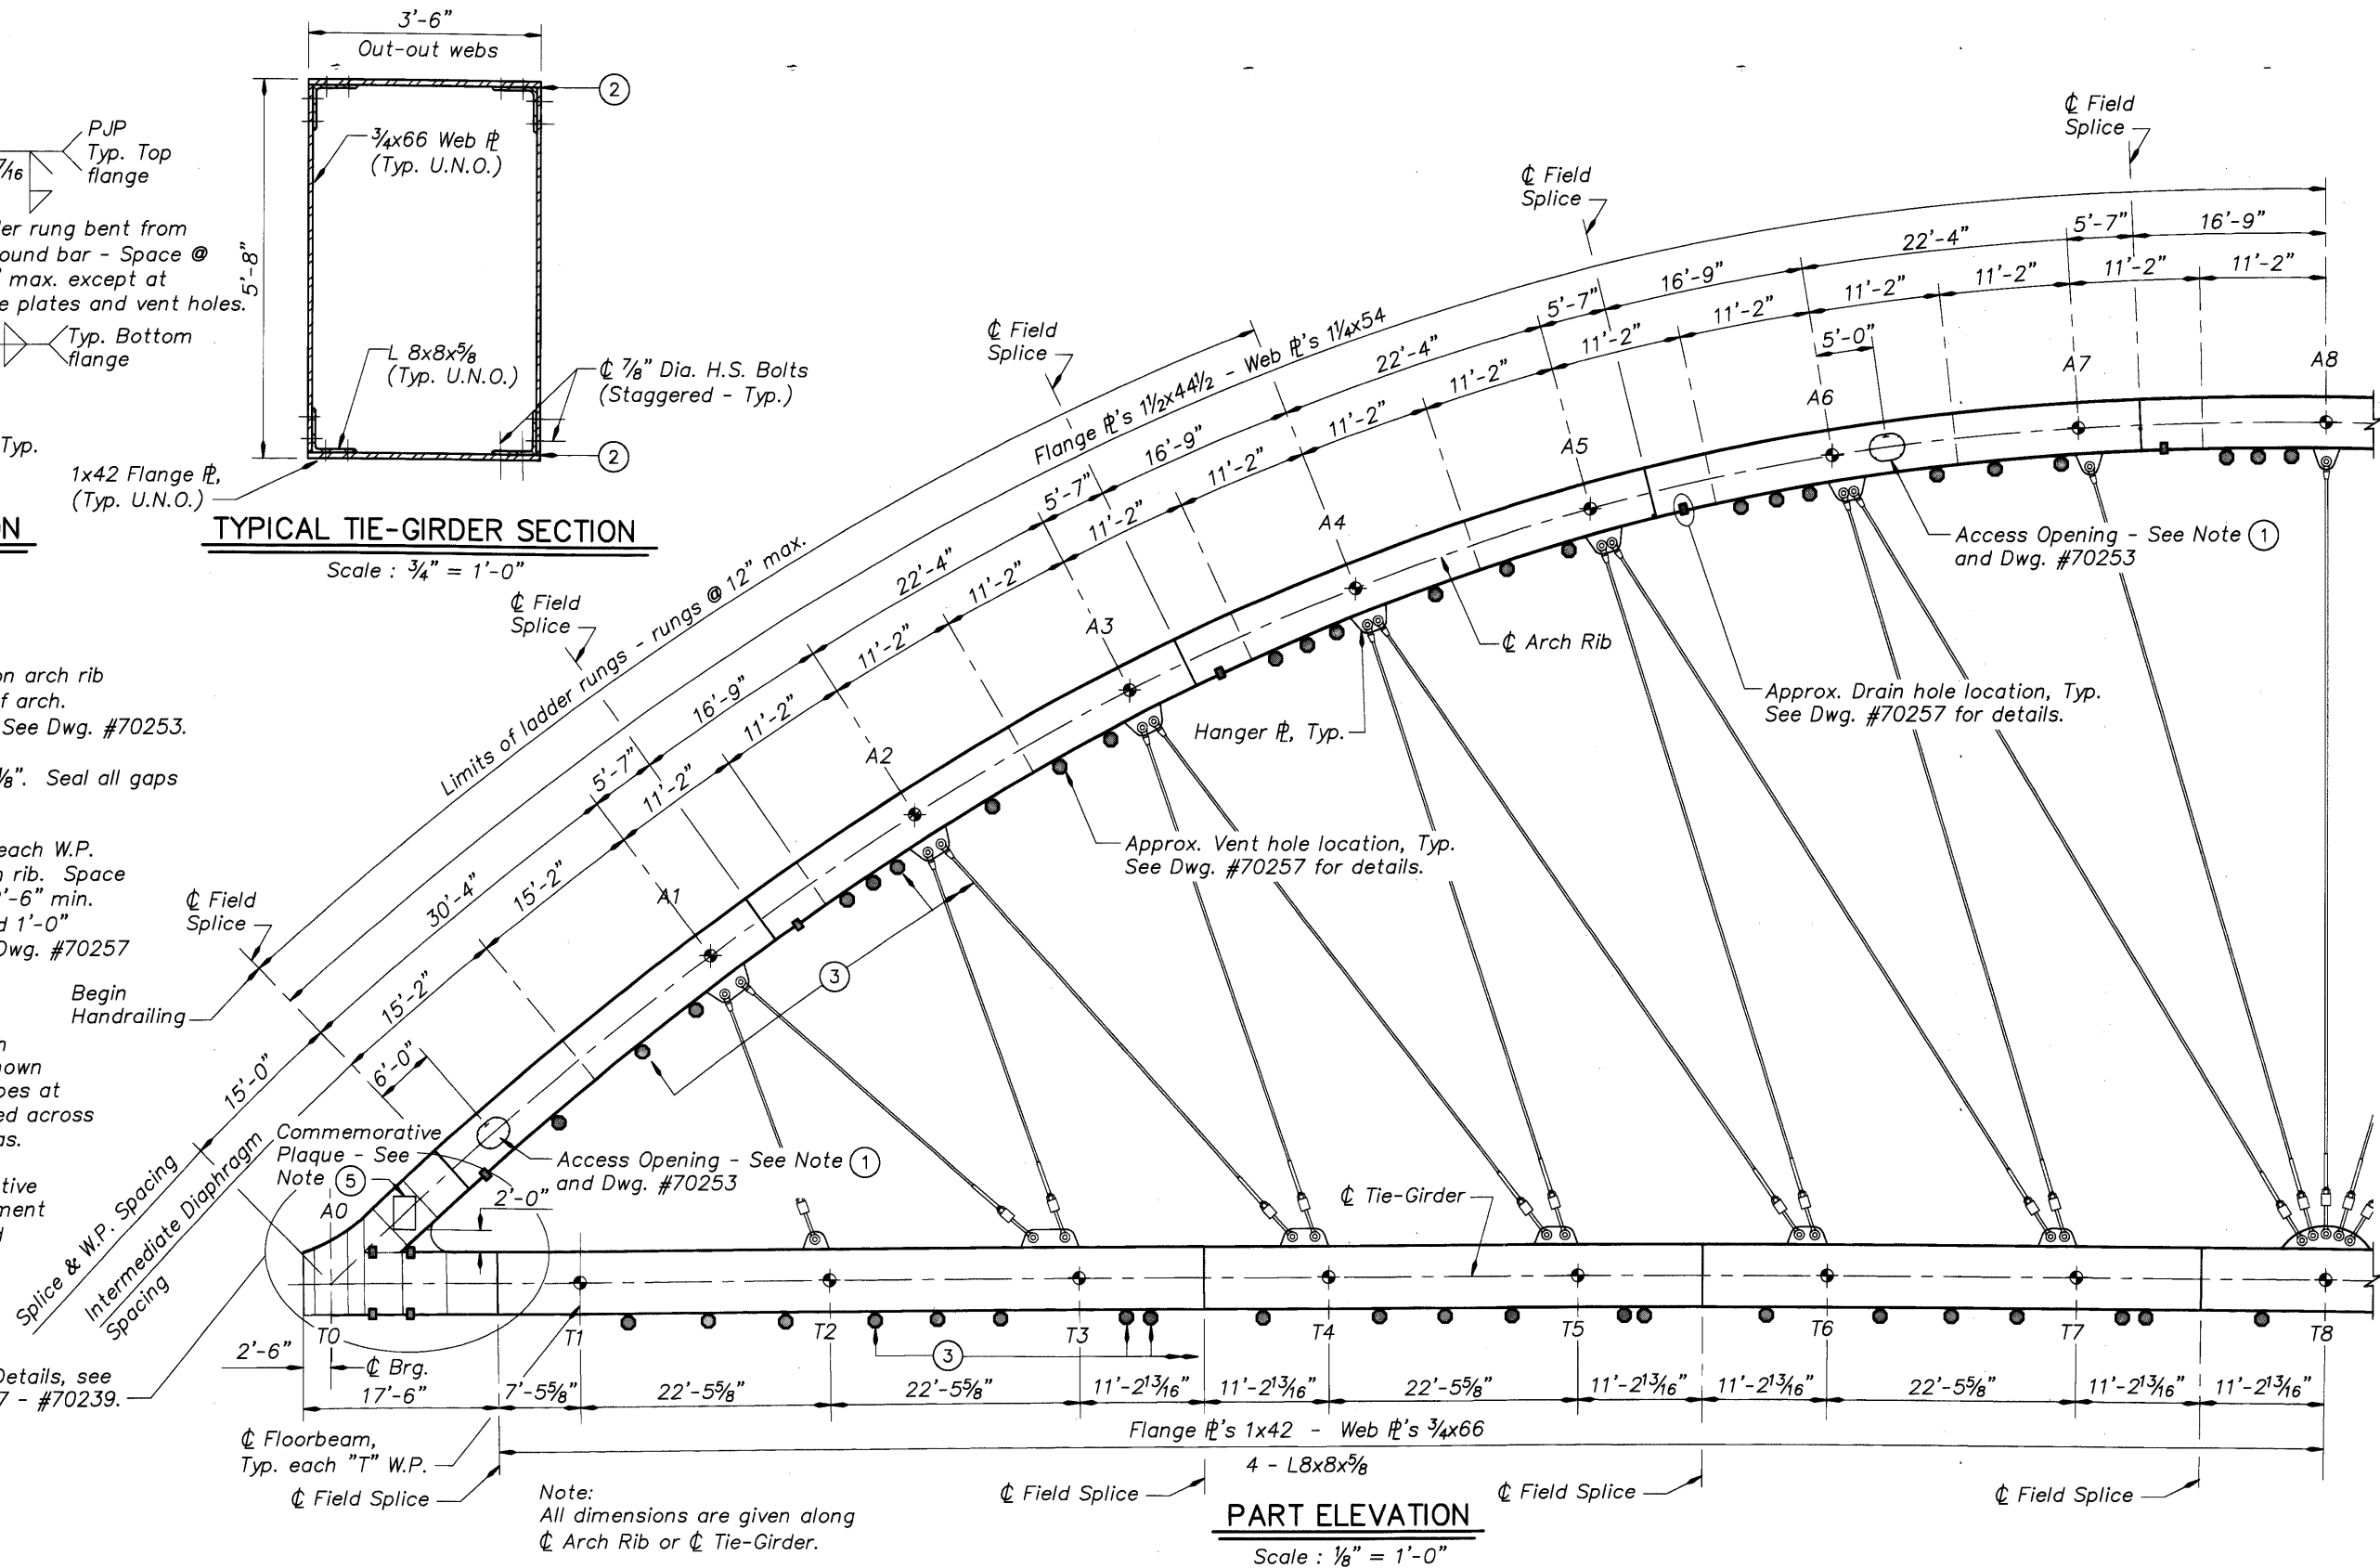

DO NOT SCALE THIS DRAWING. FOLLOW DIMENSIONS. INDICATED SCALES CORRECT ONLY FOR FULL SIZE SHEET (22"x34").

DATE	REVISION	BY
		J. Patton
		Oliver Mueller
		Clifford Coulter

DRAFTED: J. Patton  
 CHECKED: Oliver Mueller  
 DESIGNED: Clifford Coulter

**REVIEWED**

REGISTERED PROFESSIONAL ENGINEER  
 74549 PE  
 KENT COOPER  
 MARCH 09, 2004  
 KENT WILLIAM CORRIE

**DAVID EVANS AND ASSOCIATES INC.**  
 530 Center Street N.E., Suite 605  
 Salem Oregon 97301  
 Phone: 503.361.8635

EXPIRES: 12-31-05

CONNECTING COMMERCE AND COMMUNITY


**MULTNOMAH COUNTY BRIDGES**

TRANSPORTATION DIVISION

**OREGON DEPARTMENT OF TRANSPORTATION BRIDGE ENGINEERING SECTION**

<b>BRIDGE NO.</b> 20136	MULTNOMAH CHANNEL & PNWR ETC., SAUVIE ISLAND RD.	<b>SHEET</b> 32 OF 173.
<b>DATE</b> Sept. 2005		
<b>CALC. BOOK</b>	MEMBER TYPICAL SECTIONS (1 OF 2)	<b>DRAWING NO.</b> 70219



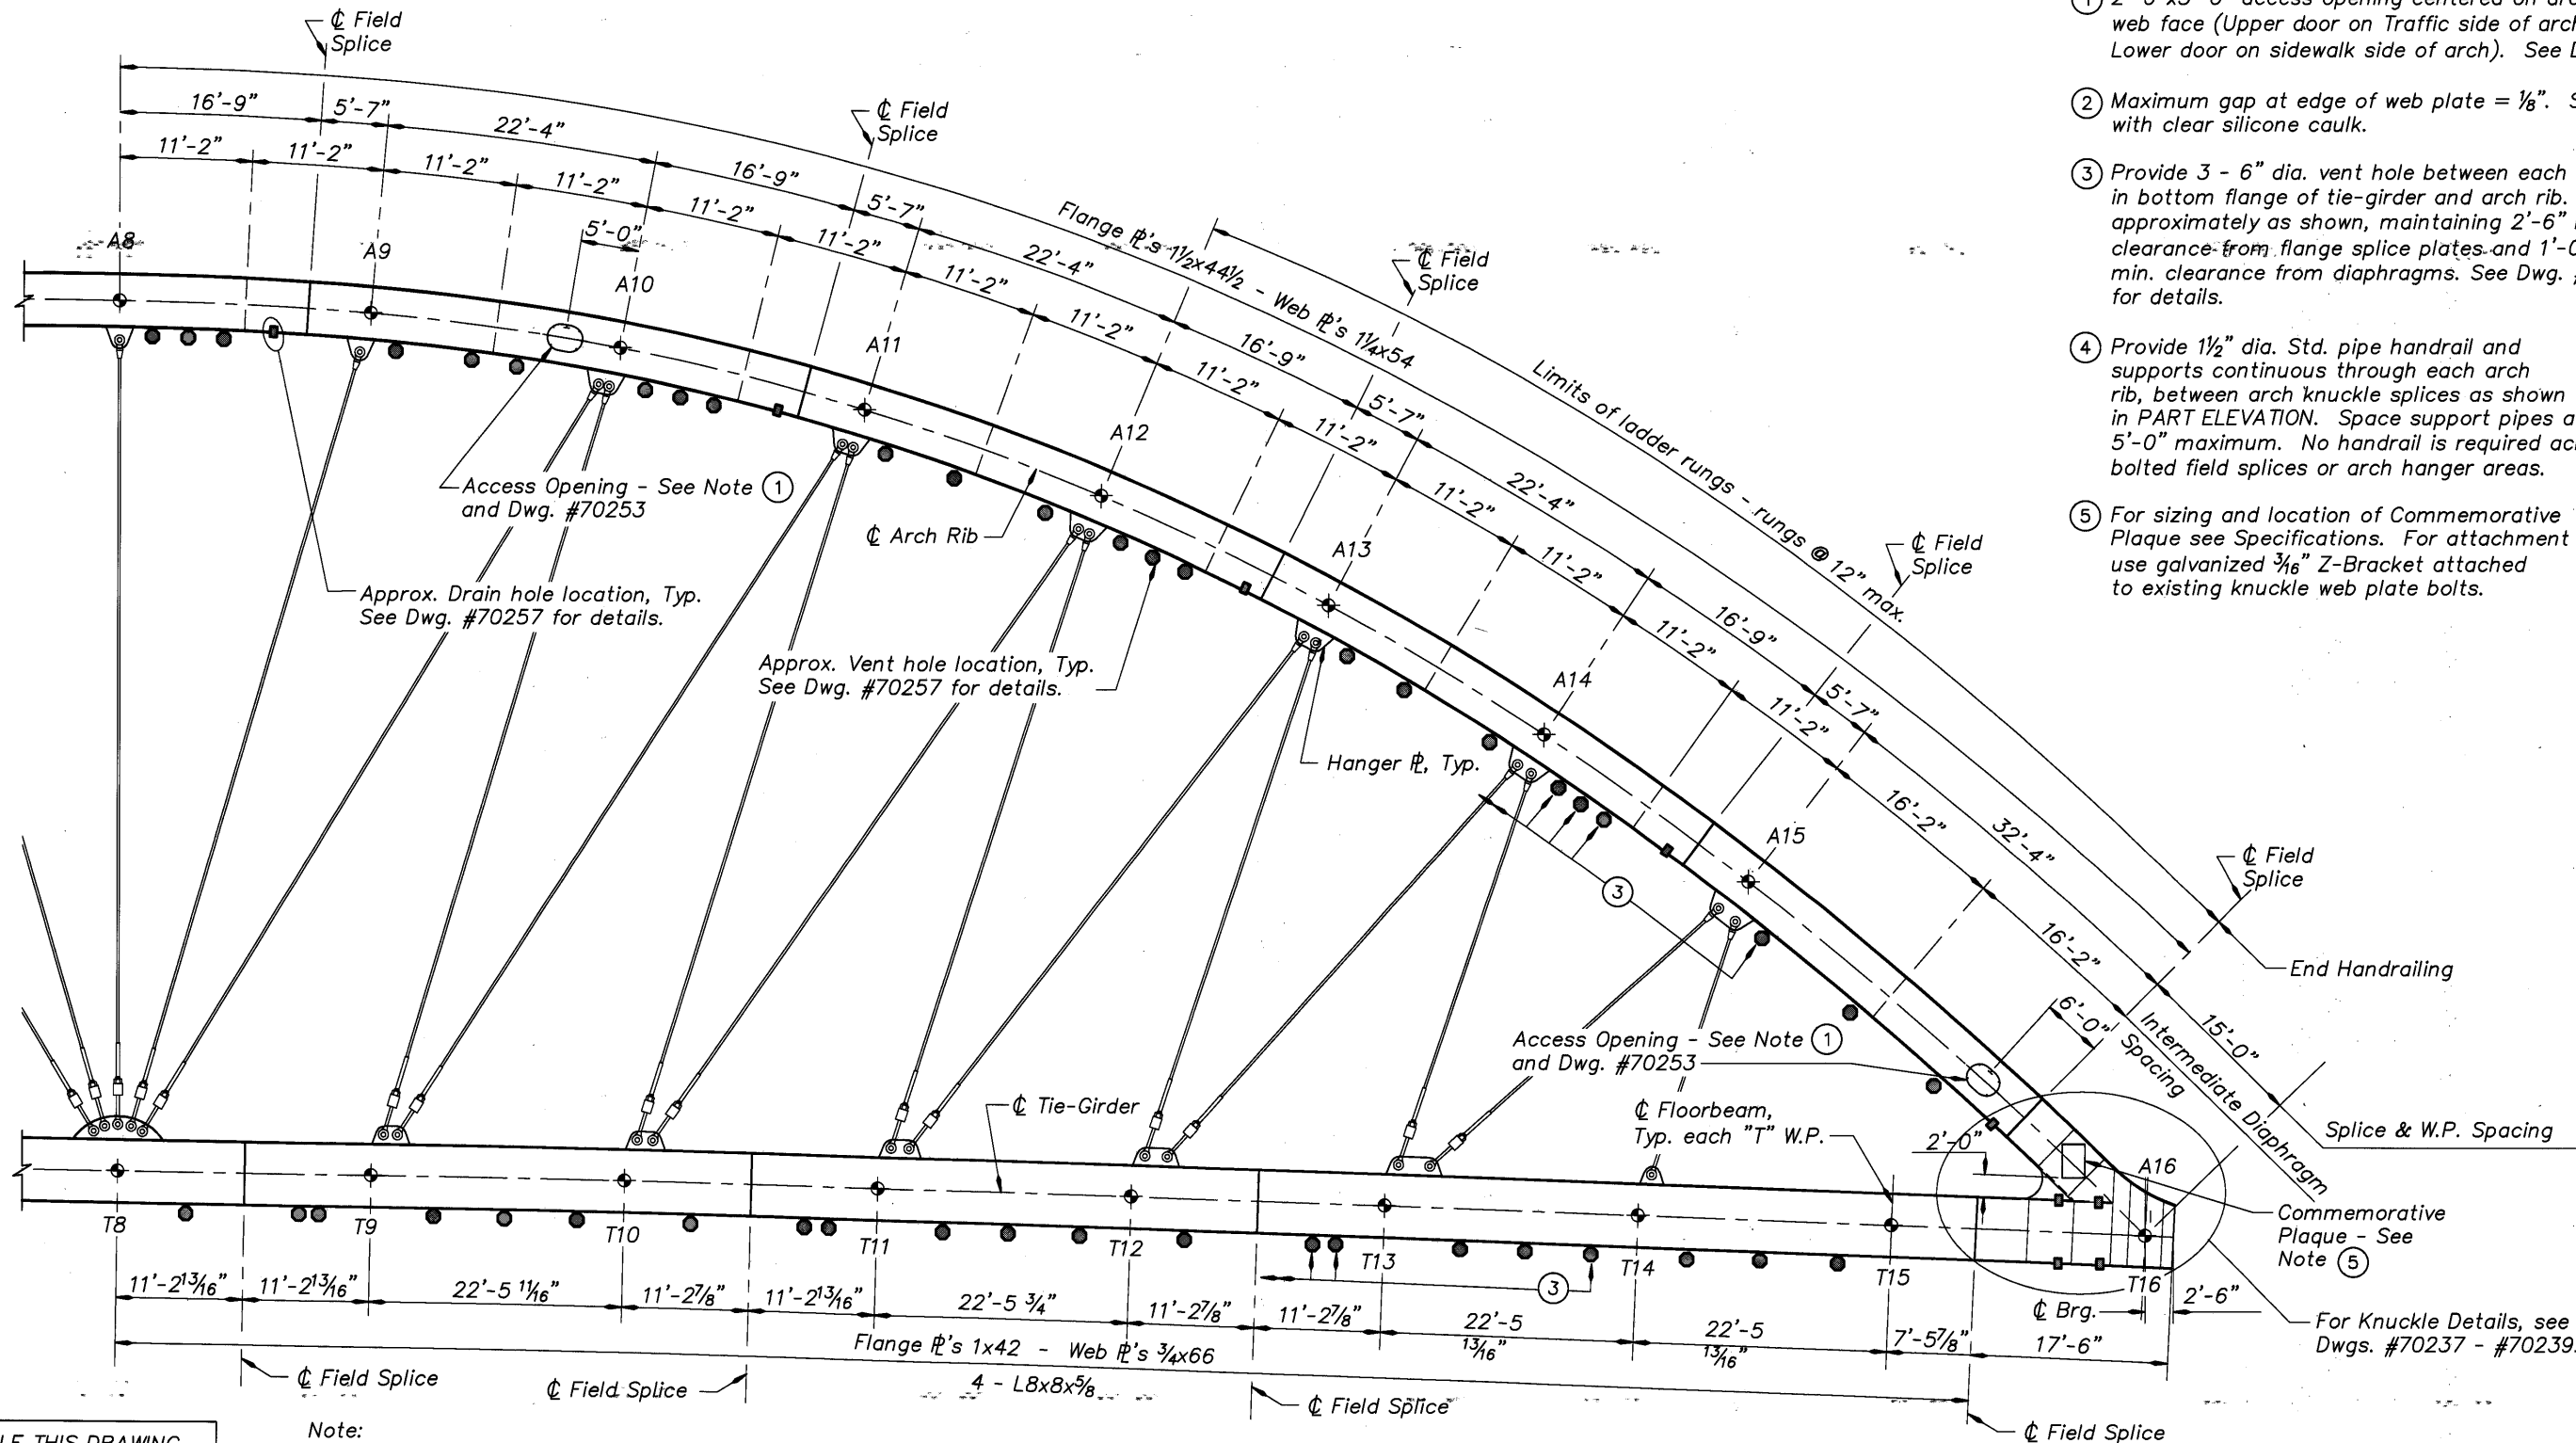

- Notes:
- 1 2'-0"x3'-0" access opening centered on arch rib web face (Upper door on Traffic side of arch. Lower door on sidewalk side of arch). See Dwg. #70253.
  - 2 Maximum gap at edge of web plate = 1/8". Seal all gaps with clear silicone caulk.
  - 3 Provide 3 - 6" dia. vent hole between each W.P. in bottom flange of tie-girder and arch rib. Space approximately as shown, maintaining 2'-6" min. clearance from flange splice plates and 1'-0" min. clearance from diaphragms. See Dwg. #70257 for details.
  - 4 Provide 1 1/2" dia. Std. pipe handrail and supports continuous through each arch rib, between arch knuckle splices as shown in PART ELEVATION. Space support pipes at 5'-0" maximum. No handrail is required across bolted field splices or arch hanger areas.
  - 5 For sizing and location of Commemorative Plaque see Specifications. For attachment use galvanized 3/8" Z-Bracket attached to existing knuckle web plate bolts.

Note:  
All dimensions are given along  $\bar{C}$  Arch Rib or  $\bar{C}$  Tie-Girder.

**PART ELEVATION**  
Scale : 1/8" = 1'-0"

DO NOT SCALE THIS DRAWING. FOLLOW DIMENSIONS. INDICATED SCALES CORRECT ONLY FOR FULL SIZE SHEET (22"x34").

DATE	03/09	REVISION	As-Constructed	BY	J. Patton	REVIEWED			TRANSPORTATION DIVISION BRIDGE NO. 20136	MULTNOMAH CHANNEL & PNWR ETC., SAUVIE ISLAND RD.	SHEET 33 OF 173
	DRAFTED:		Oliver Mueller		CHECKED:						
DESIGNED:						EXPIRES: 12-31-05	530 Center Street N.E., Suite 605 Salem Oregon 97301 Phone: 503.361.8635	BRIDGE NO. 20136	CALC. BOOK	MEMBER TYPICAL SECTIONS (2 OF 2)	






MEMBER		A12-A13				A13-A14				A14-A15				A15-A16			
LENGTH (ft.)		22'-4"				22'-4"				22'-4"				45'-4"			
LOCATION		A12		Mid-point		A13		Mid-point		A14		Mid-point		A15		Knuckle Field Splice	
INTERNAL FORCE		M	P	M	P	M	P	M	P	M	P	M	P	M	P	M	P
DEAD LOAD (UNFACTORED)	DC	960	-1380	910	-1380	1490	-1380	1270	-1370	1610	-1390	1350	-1400	1650	-1440	1410	-1470
	DW1	10	-20	10	-20	20	-20	20	-20	30	-20	30	-20	30	-20	20	-20
	DW2	50	-100	50	-100	100	-100	100	-100	140	-100	120	-100	150	-100	70	-100
LIVE LOAD PLUS IMPACT (UNFACTORED)	MAX. M	1000	-230	1100	-230	1400	-240	1380	-230	1550	-210	1440	-190	1540	-200	880	-120
	MIN. M	-570	-220	-690	-220	-700	-230	-710	-230	-620	-240	-590	-260	-490	-270	-260	-330
	MIN. P	450	-410	370	-410	480	-410	490	-430	620	-430	410	-430	530	-450	70	-450
MAX. INTERACTION ①		2910	-2610	2940	-2570	4340	-2590	4000	-2490	3880	-2760	3020	-2780	4290	-3000	2580	-2810
FLANGE $\phi$ 'S		1/2x44 1/2		1/2x44 1/2		1/2x44 1/2		1/2x44 1/2		1/2x44 1/2		1/2x44 1/2		1/2x44 1/2		1/2x44 1/2	
WEB $\phi$ 'S		1/4x54		1/4x54		1/4x54		1/4x54		1/4x54		1/4x54		1/4x54		1/4x54	
A gross (in <sup>2</sup> )		268		268		268		268		268		268		268		268	
I gross (in <sup>4</sup> )		135,633		135,633		135,633		135,633		135,633		135,633		135,633		135,633	

① See Note 1.

**Notes:**

1. Max. interaction force effects correspond to the Strength Limit State loading combination that produces the highest combined interaction value per AASHTO LRFD Design Specifications (Third Edition, 2004) Section 6.8.2.3 and Section 6.9.2.2.
2. DC includes the dead load of structural elements and components through the end of Stage 8.
3. DW1 and DW2 include force effects from future utilities and future wearing surface, respectively.
4. Member forces are symmetrical about  $\bar{C}$  Roadway.

M = Moment (k-ft.)  
 P = Axial Force (k)  
 - = Compression  
 + = Tension

	DATE	REVISION	BY	DRAFTED: J. Patton CHECKED: Oliver Mueller DESIGNED: Gernot Komar	 REGISTERED PROFESSIONAL ENGINEER JUEL BRANDON TURBS OREGON EXPIRES: 6-30-06	 DAVID EVANS AND ASSOCIATES INC. 530 Center Street N.E., Suite 605 Salem Oregon 97301 Phone: 503.361.8635	 MULTNOMAH COUNTY BRIDGES TRANSPORTATION DIVISION  OREGON DEPARTMENT OF TRANSPORTATION BRIDGE ENGINEERING SECTION	BRIDGE NO.	MULTNOMAH CHANNEL & PNWR ETC., SAUVIE ISLAND RD.	SHEET
	03/09	As-Constructed	TDF					20136		35
								DATE Sept. 2005		OF 173
							CALC. BOOK	ARCH RIB MEMBER FORCES (2 OF 2)	DRAWING NO.	
									70222	

**TIE-GIRDER FORCES AND PROPERTIES**

MEMBER		T0-T1				T1-T2				T2-T3				T3-T4				T4-T5				T5-T6			
LENGTH (ft.)		22'-5 5/8"				22'-5 5/8"				22'-5 5/8"				22'-5 5/8"				22'-5 5/8"				22'-5 5/8"			
LOCATION		Knuckle Field Splice		T1		Mid-point		T2		Mid-point		T3		Mid-point		T4		Mid-point		T5		Mid-point		T6	
INTERNAL FORCE		M	P	M	P	M	P	M	P	M	P	M	P	M	P	M	P	M	P	M	P	M	P	M	P
DEAD LOAD (UNFACTORED)	DC	290	1020	1560	1020	2120	950	2690	950	2790	930	2890	930	2660	930	2410	930	1900	950	1350	950	720	970	0	970
	DW1	20	10	40	10	40	10	30	10	40	10	30	10	40	10	30	10	30	10	20	10	10	10	0	10
	DW2	50	70	140	70	150	60	160	60	160	60	160	60	150	60	140	60	120	60	100	60	60	60	20	60
LIVE LOAD PLUS IMPACT (UNFACTORED)	MAX. M	960	100	1870	110	1770	120	2210	130	2060	160	2480	160	2180	170	2480	170	2080	180	2300	180	1870	190	2080	180
	MIN. M	-270	200	-310	180	-420	160	-500	160	-630	140	-750	140	-810	130	-870	130	-910	120	-950	110	-1000	110	-1080	120
	MAX. P	210	310	590	310	550	280	680	280	980	270	1180	270	1240	280	1430	280	1290	280	1510	280	1080	290	1230	290
MAX. INTERACTION (1)		790	2190	5520	1600	6010	1780	7370	1790	7350	1880	8260	1590	7300	1920	7320	1930	4960	2130	4380	2130	2730	2170	1410	2140
FLANGE ϕ'S		1x42		1x42		1x42		1x42		1x42		1x42		1x42		1x42		1x42		1x42		1x42		1x42	
WEB ϕ'S		3/4x66		3/4x66		3/4x66		3/4x66		3/4x66		3/4x66		3/4x66		3/4x66		3/4x66		3/4x66		3/4x66		3/4x66	
CONNECTION ANGLES		L8x8x5/8		L8x8x5/8		L8x8x5/8		L8x8x5/8		L8x8x5/8		L8x8x5/8		L8x8x5/8		L8x8x5/8		L8x8x5/8		L8x8x5/8		L8x8x5/8		L8x8x5/8	
A gross (in <sup>2</sup> )		222		222		222		222		222		222		222		222		222		222		222		222	
I gross (in <sup>4</sup> )		167,197		167,197		167,197		167,197		167,197		167,197		167,197		167,197		167,197		167,197		167,197		167,197	





MEMBER		T6-T7				T7-T8				T8-T9				T9-T10				T10-T11				T11-T12					
LENGTH (ft.)		22'-5 5/8"				22'-5 5/8"				22'-5 5/8"				22'-5 1/16"				22'-5 3/4"									
LOCATION		T6		Mid-point		T7		Mid-point		T8		Mid-point		T9		Mid-point		T10		Mid-point		T11		Mid-point		T12	
INTERNAL FORCE		M	P	M	P	M	P	M	P	M	P	M	P	M	P	M	P	M	P	M	P	M	P	M	P	M	P
DEAD LOAD (UNFACTORED)	DC	0	970	-820	1000	-1740	1040	-2680	1040	-3740	1040	-2670	1040	-1700	1000	-800	1000	20	970	730	970	1350	950	1880	950	2360	940
	DW1	0	10	-10	10	-30	10	-40	10	-70	10	-40	10	-30	10	-10	10	0	10	10	10	20	10	30	10	30	10
	DW2	20	60	-40	60	-100	60	-180	60	-270	60	-180	60	-90	60	-40	60	30	60	60	60	100	60	120	60	140	60
LIVE LOAD PLUS IMPACT (UNFACTORED)	MAX. M	2080	180	1610	180	1770	140	1180	150	1330	130	1180	150	1830	160	1620	210	2080	200	1860	200	2290	190	2060	190	2450	170
	MIN. M	-1080	120	-1190	130	-1360	150	-1400	160	-1610	190	-1410	150	-1370	120	-1200	100	-1080	100	-990	110	-940	110	-900	120	-870	120
	MAX. P	1230	290	810	290	540	280	120	280	-320	280	200	280	850	280	790	280	1090	280	980	280	970	270	850	270	1010	270
MAX. INTERACTION (1)		1410	2140	-110	2180	-4720	1740	-6380	1740	-8470	1790	-6380	1740	-4670	1630	-3180	1390	1560	2110	4300	1750	5920	1630	6220	1680	7550	1580
FLANGE ϕ'S		1x42		1x42		1x42		1x42		1x42		1x42		1x42		1x42		1x42		1x42		1x42		1x42		1x42	
WEB ϕ'S		3/4x66		3/4x66		3/4x66		3/4x66		3/4x66		3/4x66		3/4x66		3/4x66		3/4x66		3/4x66		3/4x66		3/4x66		3/4x66	
CONNECTION ANGLES		L8x8x5/8		L8x8x5/8		L8x8x5/8		L8x8x5/8		L8x8x5/8		L8x8x5/8		L8x8x5/8		L8x8x5/8		L8x8x5/8		L8x8x5/8		L8x8x5/8		L8x8x5/8		L8x8x5/8	
A gross (in <sup>2</sup> )		222		222		222		222		222		222		222		222		222		222		222		222		222	
I gross (in <sup>4</sup> )		167,197		167,197		167,197		167,197		167,197		167,197		167,197		167,197		167,197		167,197		167,197		167,197		167,197	

(1) See Note 1, Dwg. #70222





	DATE	REVISION	BY	J. Patton DRAFTED:		CONNECTING COMMERCE AND COMMUNITY <b>MULTNOMAH COUNTY</b> BRIDGES	TRANSPORTATION DIVISION	BRIDGE NO.	MULTNOMAH CHANNEL & PNWR ETC., SAUVIE ISLAND RD.	SHEET 36 OF 173
	08/05	Revised Max. Interaction Values	JBT					20136		
	03/09	As-Constructed	TDF	Oliver Mueller CHECKED:	DAVID EVANS AND ASSOCIATES, INC. 530 Center Street N.E., Suite 605 Salem Oregon 97301 Phone: 503.361.8635		OREGON DEPARTMENT OF TRANSPORTATION BRIDGE ENGINEERING SECTION	DATE	TIE-GIRDER MEMBER FORCES (1 of 2)	DRAWING NO. 70223
								Sept. 2005		
				Gernot Komar DESIGNED:	EXPIRES: 6-30-06			CALC. BOOK		

MEMBER	T12-T13				T13-T14				T14-T15				T15-T16				
LENGTH (ft.)	22'-5 <sup>3</sup> / <sub>4</sub> "				22'-5 <sup>3</sup> / <sub>16</sub> "				22'-5 <sup>3</sup> / <sub>16</sub> "				22'-5 <sup>7</sup> / <sub>8</sub> "				
LOCATION	T12		Mid-point		T13		Mid-point		T14		Mid-point		T15		Knuckle Field Splice		
INTERNAL FORCE	M	P	M	P	M	P	M	P	M	P	M	P	M	P	M	P	
DEAD LOAD (UNFACTORED)	DC	2360	940	2610	940	2830	930	2750	930	2660	960	2130	960	1590	1020	310	1020
	DW1	30	10	30	10	30	10	40	10	30	10	40	10	40	10	20	10
	DW2	140	60	150	60	160	60	150	60	160	60	150	60	140	70	50	70
LIVE LOAD PLUS IMPACT (UNFACTORED)	MAX. M	2450	170	2140	180	2440	160	2020	170	2170	140	1770	140	1880	120	1020	120
	MIN. M	-870	120	-800	130	-750	130	-630	130	-500	140	-430	150	-350	170	-360	160
	MAX. P	1010	270	840	270	830	270	690	270	650	270	500	270	540	290	260	290
MAX. INTERACTION ①	7550	1580	7300	1620	8110	1560	7270	1570	7380	1690	6020	1690	5530	1870	1590	2140	
FLANGE P'S	1x42		1x42		1x42		1x42		1x42		1x42		1x42		1x42		
WEB P'S	3/4x66		3/4x66		3/4x66		3/4x66		3/4x66		3/4x66		3/4x66		3/4x66		
CONNECTION ANGLES	L8x8x5/8		L8x8x5/8		L8x8x5/8		L8x8x5/8		L8x8x5/8		L8x8x5/8		L8x8x5/8		L8x8x5/8		
A gross (in <sup>2</sup> )	222		222		222		222		222		222		222		222		
I gross (in <sup>4</sup> )	167,197		167,197		167,197		167,197		167,197		167,197		167,197		167,197		


① See Note 1, Dwg. #70222

 	DATE	REVISION	BY	J. Patton DRAFTED: Oliver Mueller CHECKED: Gernot Komar DESIGNED:	<b>REVIEWED</b>  DAVID EVANS AND ASSOCIATES INC. 530 Center Street N.E., Suite 605 Salem Oregon 97301 Phone: 503.361.8635 EXPIRES: 6-30-06	CONNECTING COMMERCE AND COMMUNITY <b>MULTNOMAH COUNTY</b> BRIDGES  TRANSPORTATION DIVISION OREGON DEPARTMENT OF TRANSPORTATION BRIDGE ENGINEERING SECTION	BRIDGE NO.	MULTNOMAH CHANNEL & PNWR ETC., SAUVIE ISLAND RD.	SHEET
	08/05	Revised Max. Interaction Values	JBT				20136		37
	03/09	As-Constructed	TDF				DATE Sept. 2005		OF 173
							CALC. BOOK	TIE-GIRDER MEMBER FORCES (2 of 2)	DRAWING NO. 70224

Xref: Odobck.dwg, 00070460\_AG\_03.dwg

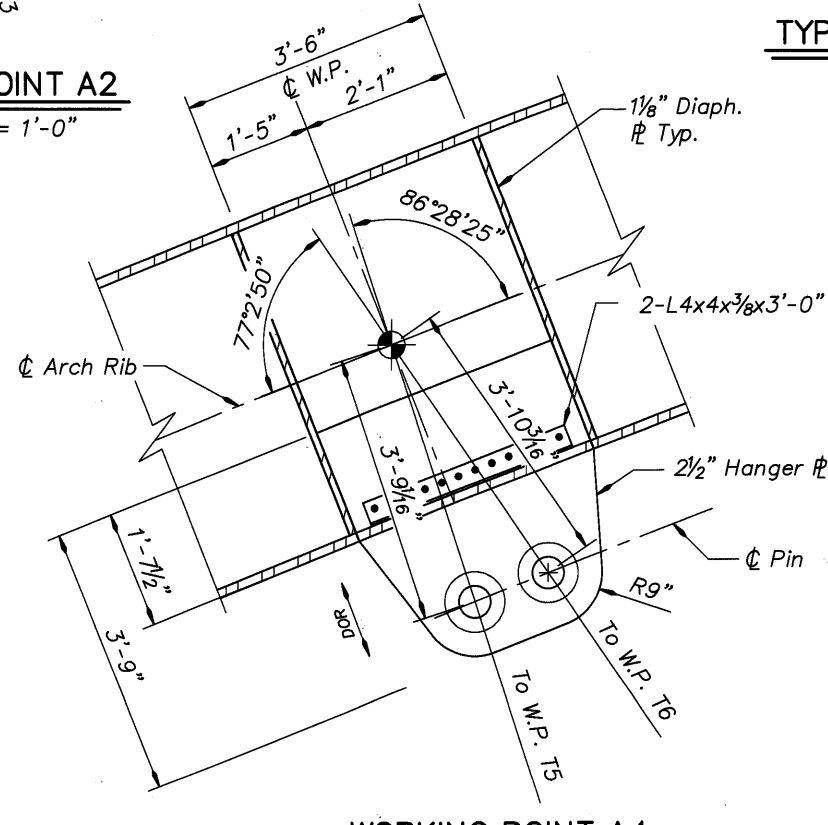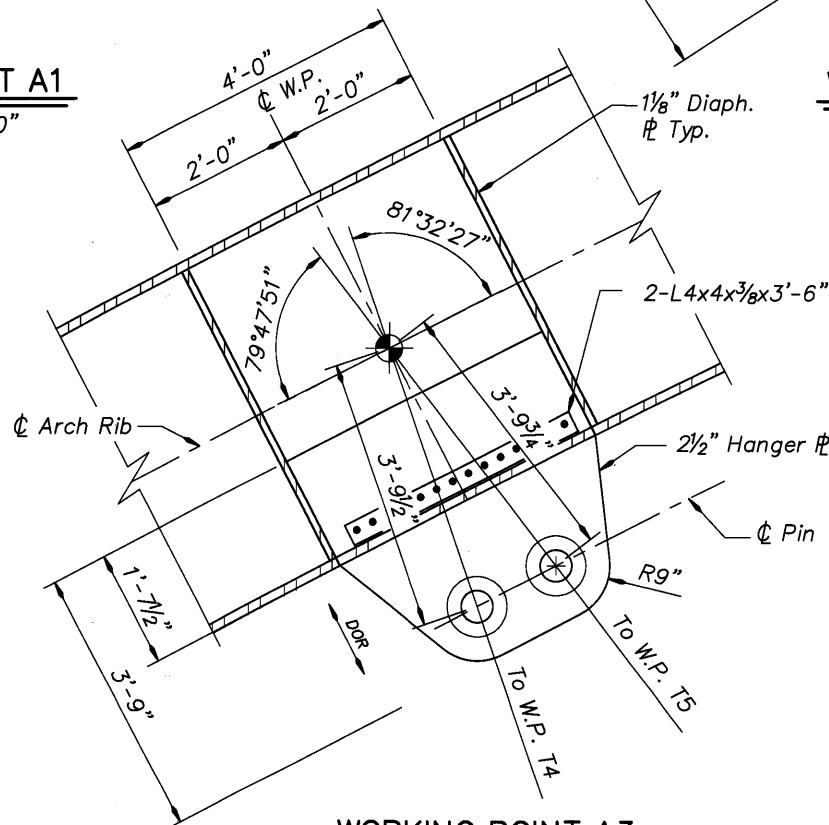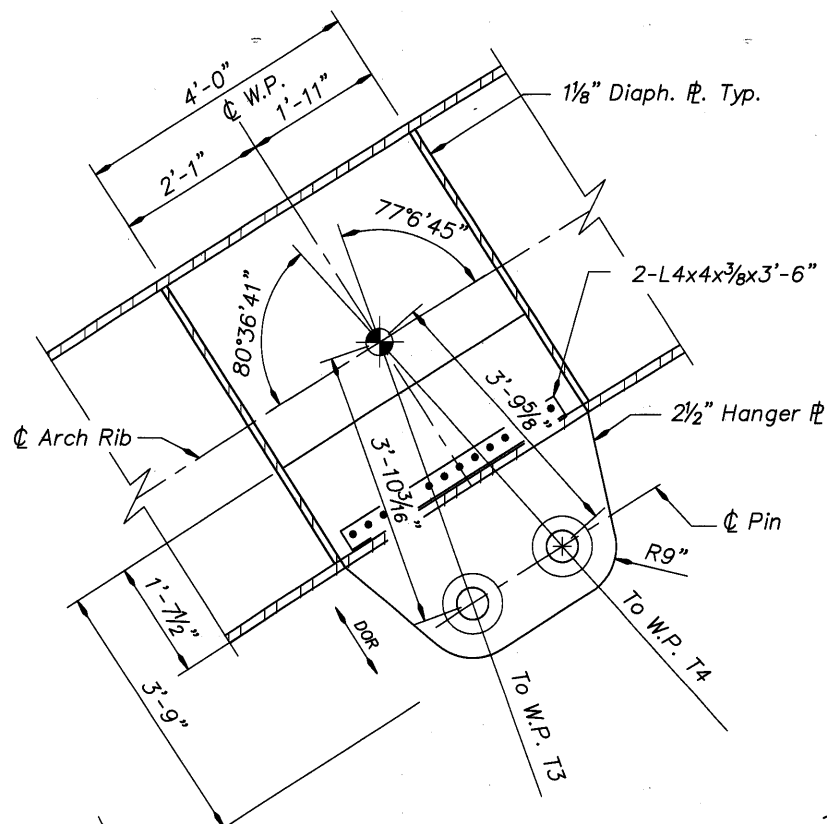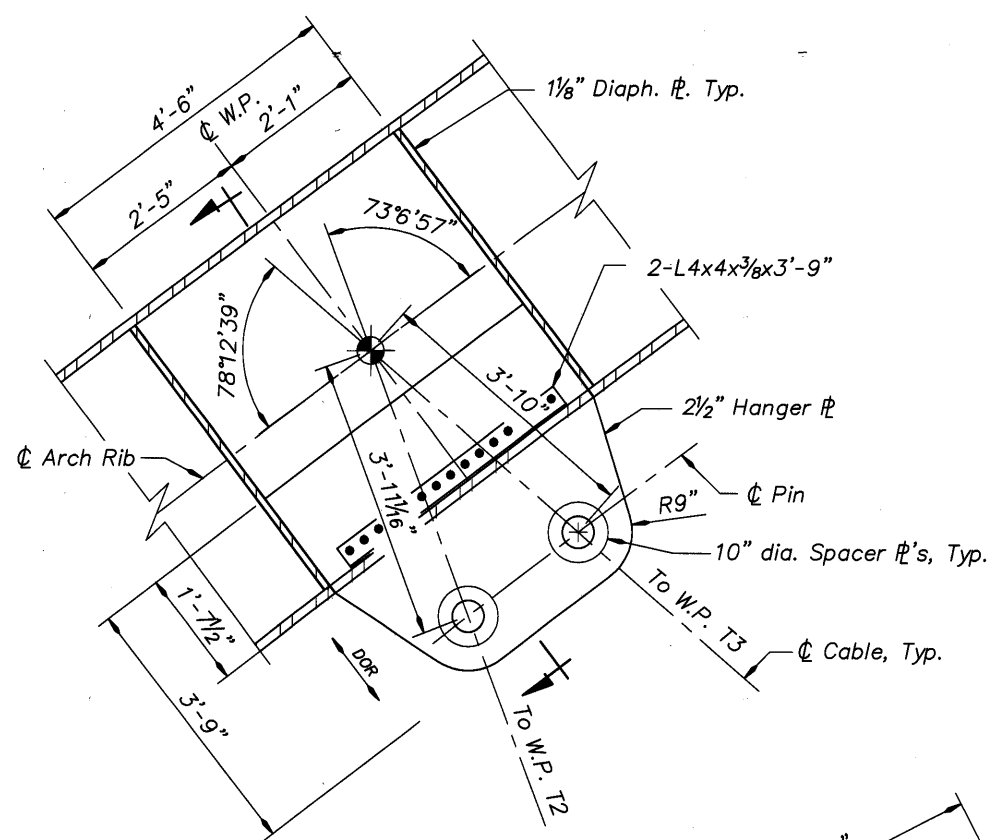

Hole for electrical conduit (diameter = OD conduit + 1/8") Refer to Dwg. #70346 thru #70349 and #70353.

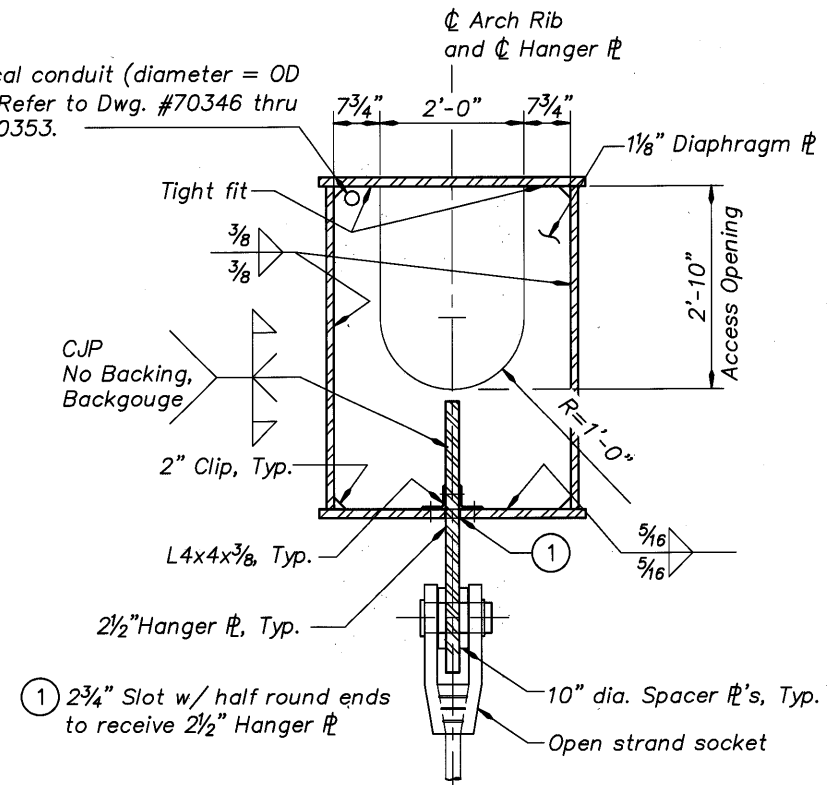


**Note:**  
Paint the hanger plate pin holes, pin hole circular spacer plates, and two inches past the outer edge of spacer plates. See General Notes, Dwg. #70191.

**Notes:**  
All angles shown are to local tangents to Arch Rib at working points. For Hanger Cable Details, see Dwg. #70242 and #70243.

**DOR** Denotes Direction of Roll  
**●** Denotes Working Point


DO NOT SCALE THIS DRAWING. FOLLOW DIMENSIONS. INDICATED SCALES CORRECT ONLY FOR FULL SIZE SHEET (22"x34").

DATE	03/09	REVISION	As-Constructed	BY	J. Patton	REVIEWED	DAVID EVANS AND ASSOCIATES INC.	BRIDGE NO.	20136	SHEET	38
							Oliver Mueller		REGISTERED PROFESSIONAL ENGINEER 74540 PE OREGON MARCH 09, 2004 KENT WILLIAM CORRY		DATE
					Paul Greco		530 Center Street N.E., Suite 605 Salem Oregon 97301 Phone: 503.361.8635	CALC. BOOK		DRAWING NO.	70225
								MULTNOMAH COUNTY BRIDGES TRANSPORTATION DIVISION		MULTNOMAH CHANNEL & PNWR ETC., SAUVIE ISLAND RD.	
								OREGON DEPARTMENT OF TRANSPORTATION BRIDGE ENGINEERING SECTION		ARCH RIB DETAILS (1 OF 5)	

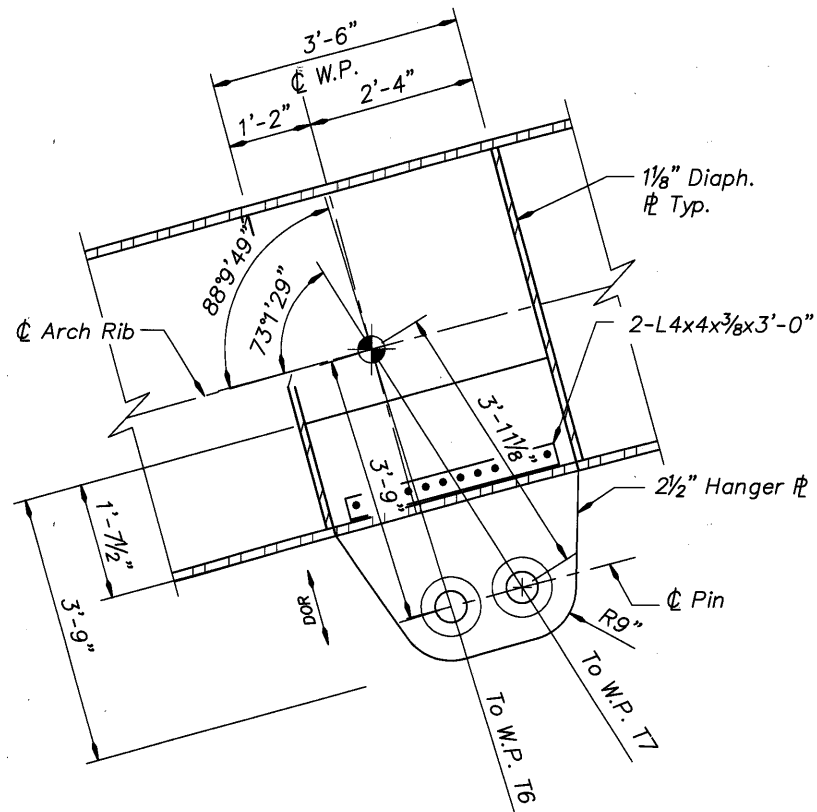


**WORKING POINT A5**

Scale : 3/4" = 1'-0"

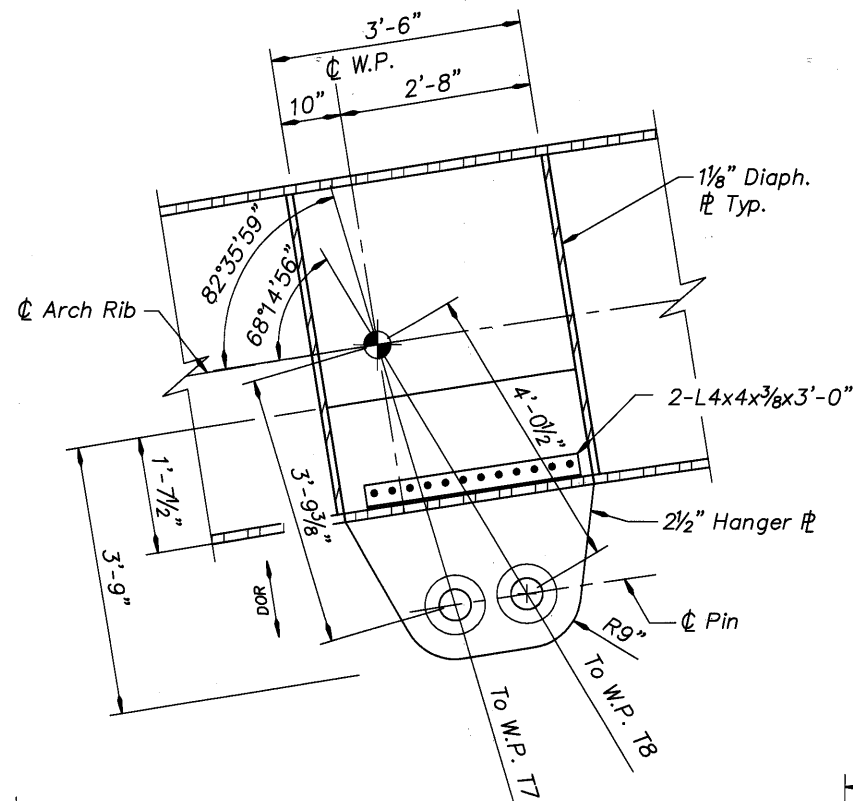


**WORKING POINT A6**

Scale : 3/4" = 1'-0"

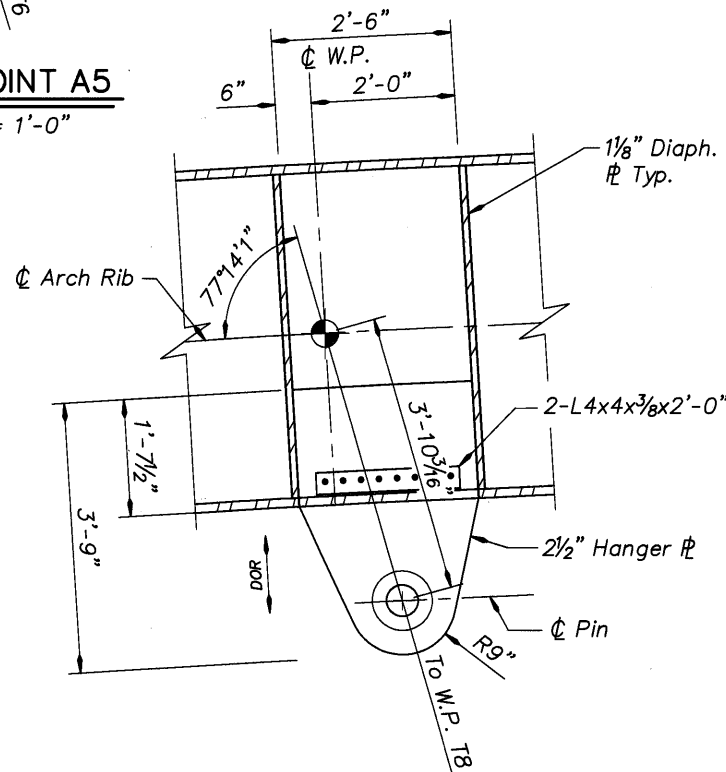

**WORKING POINT A7**


Scale : 3/4" = 1'-0"

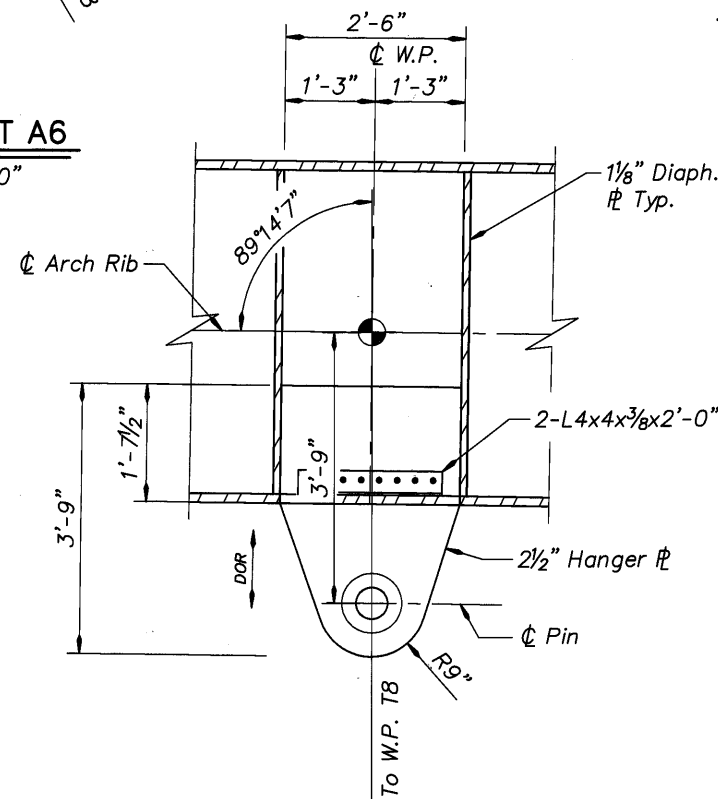

**WORKING POINT A8**

Scale : 3/4" = 1'-0"

① Hole for electrical conduit (diameter = OD conduit + 1/8") Refer to Dwg. #70346 thru. #70349 and #70353.

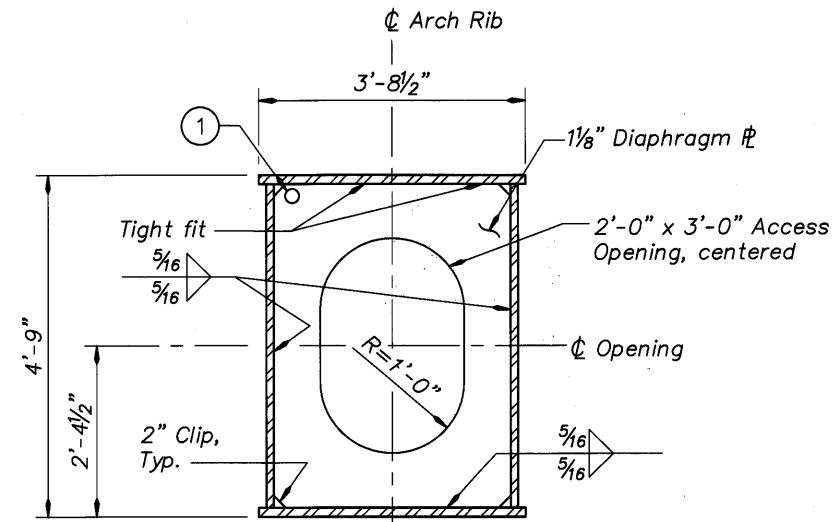

**INTERMEDIATE ARCH RIB DIAPHRAGM**

Scale : 3/4" = 1'-0"


Notes:  
 All angles shown are to local tangents to  $\phi$  Arch Rib at working points.  
 For Hanger Cable Details, see Dwg. #70242 and #70243.

DOR Denotes Direction of Roll


$\bullet$  Denotes Working Point

DO NOT SCALE THIS DRAWING. FOLLOW DIMENSIONS. INDICATED SCALES CORRECT ONLY FOR FULL SIZE SHEET (22"x34").


	DATE	REVISION	BY	J. Patton	<b>REVIEWED</b> 		TRANSPORTATION DIVISION <b>OREGON DEPARTMENT OF TRANSPORTATION</b> BRIDGE ENGINEERING SECTION	BRIDGE NO.	20136	MULTNOMAH CHANNEL & PNWR ETC., SAUVIE ISLAND RD.	SHEET	39
	03/09	As-Constructed	TDF	Shonn Mills				DATE	Sept. 2005		OF	173
				Paul Greco				CALC. BOOK			DRAWING NO.	70226

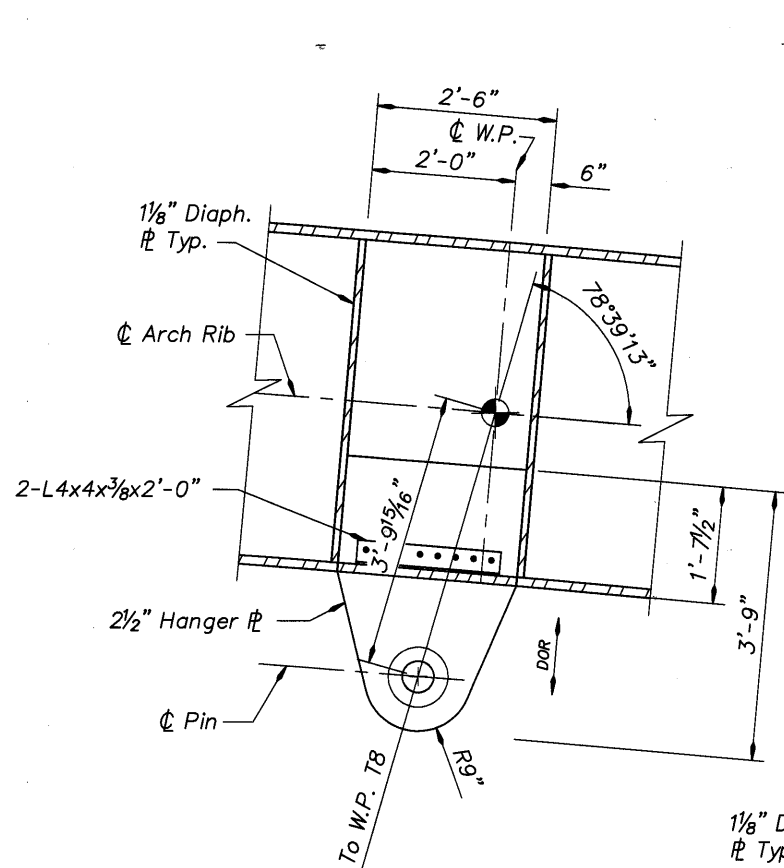


**WORKING POINT A9**  
 Scale : 3/4" = 1'-0"

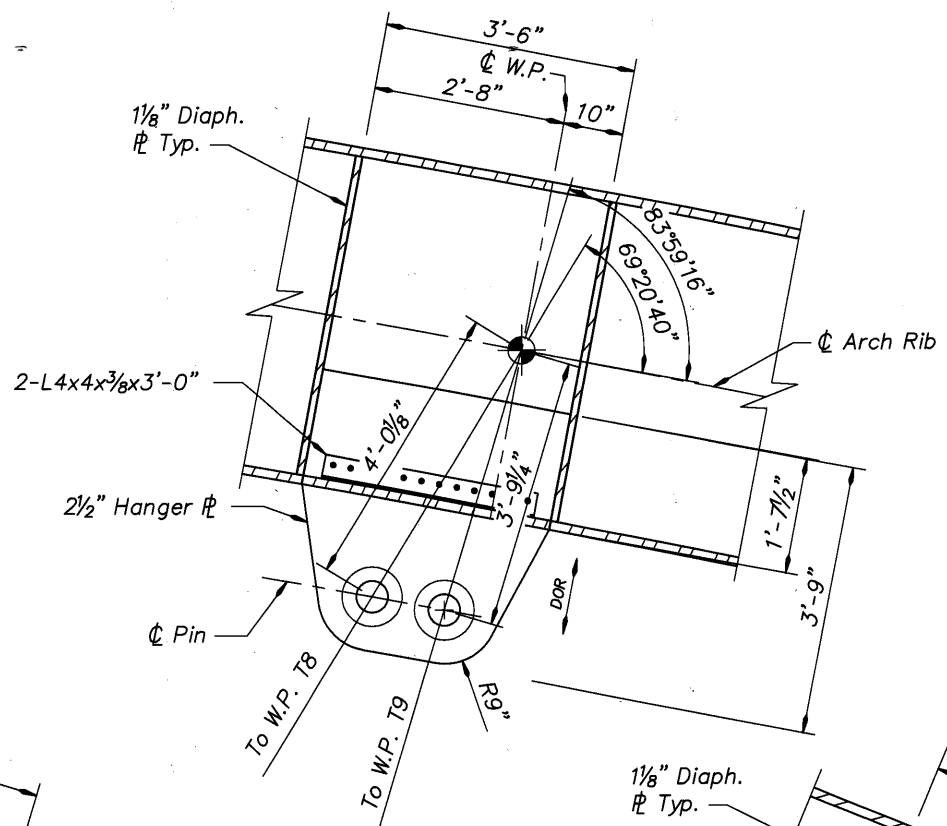

**WORKING POINT A10**  
 Scale : 3/4" = 1'-0"

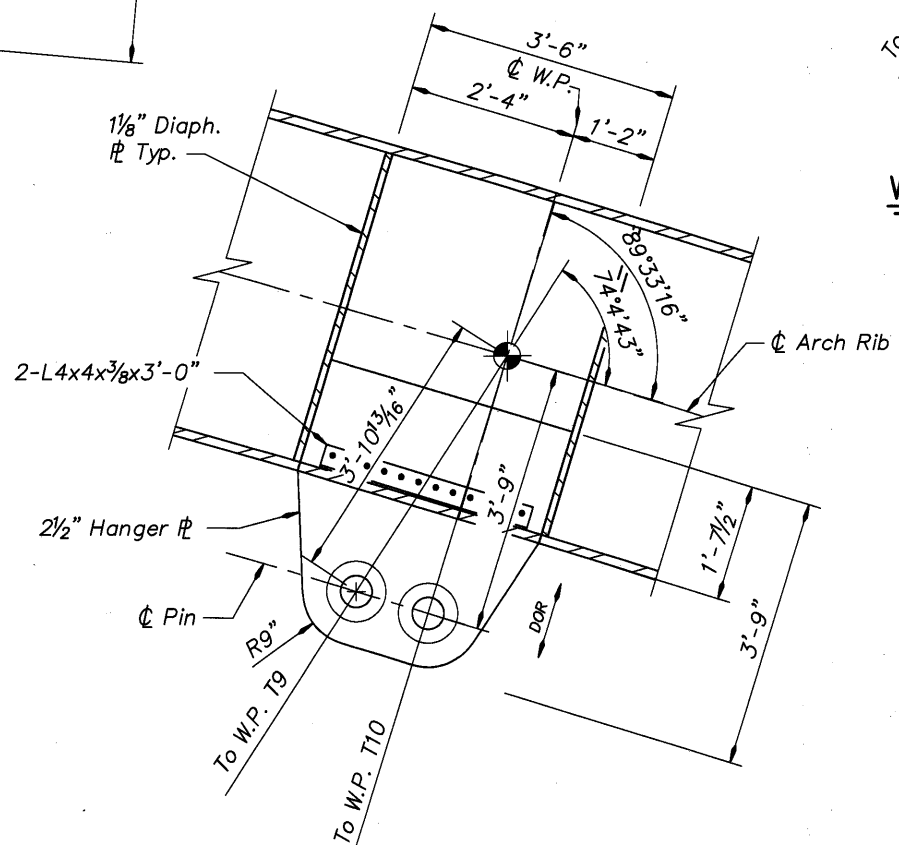

**WORKING POINT A11**  
 Scale : 3/4" = 1'-0"

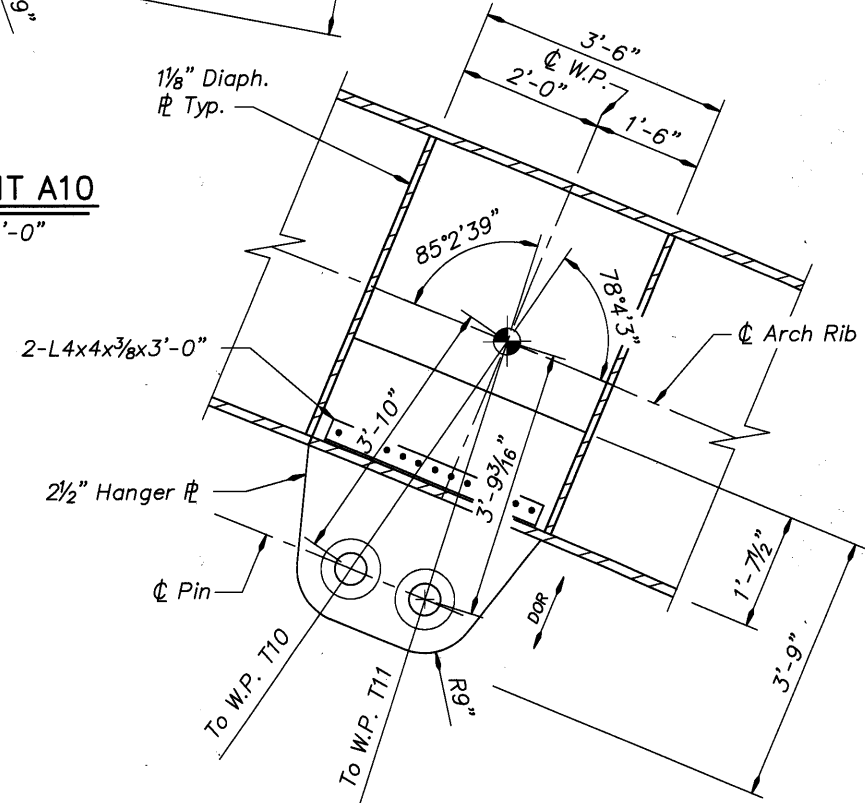

**WORKING POINT A12**  
 Scale : 3/4" = 1'-0"

**Notes:**  
 All angles shown are to local tangents to  
 Arch Rib at working points.  
 For Hanger Cable Details, see Dwg. #70242  
 and #70243.

DOR Denotes Direction of Roll

Denotes Working Point

DO NOT SCALE THIS DRAWING.  
 FOLLOW DIMENSIONS. INDICATED  
 SCALES CORRECT ONLY FOR  
 FULL SIZE SHEET (22"x34").

DATE	REVISION	BY
03/09	As-Constructed	TDF

DRAFTED: J. Patton  
 CHECKED: Shonn Mills  
 DESIGNED: Paul Greco

REVIEWED

REGISTERED PROFESSIONAL ENGINEER  
 74549 PE  
 OREGON  
 MARCH 09, 2005  
 WENT WILLIAM CORRY

DAVID EVANS AND ASSOCIATES INC.  
 530 Center Street N.E., Suite 605  
 Salem Oregon 97301  
 Phone: 503.361.8635

EXPIRES: 12-31-05

CONNECTING COMMERCE AND COMMUNITY

MULTNOMAH COUNTY BRIDGES

TRANSPORTATION DIVISION

OREGON DEPARTMENT OF TRANSPORTATION  
 BRIDGE ENGINEERING SECTION


BRIDGE NO. 20136  
 DATE Sept. 2005  
 CALC. BOOK

MULTNOMAH CHANNEL & PNWR ETC., SAUVIE ISLAND RD.


ARCH RIB DETAILS (3 OF 5)

SHEET 40 OF 173  
 DRAWING NO. 70227




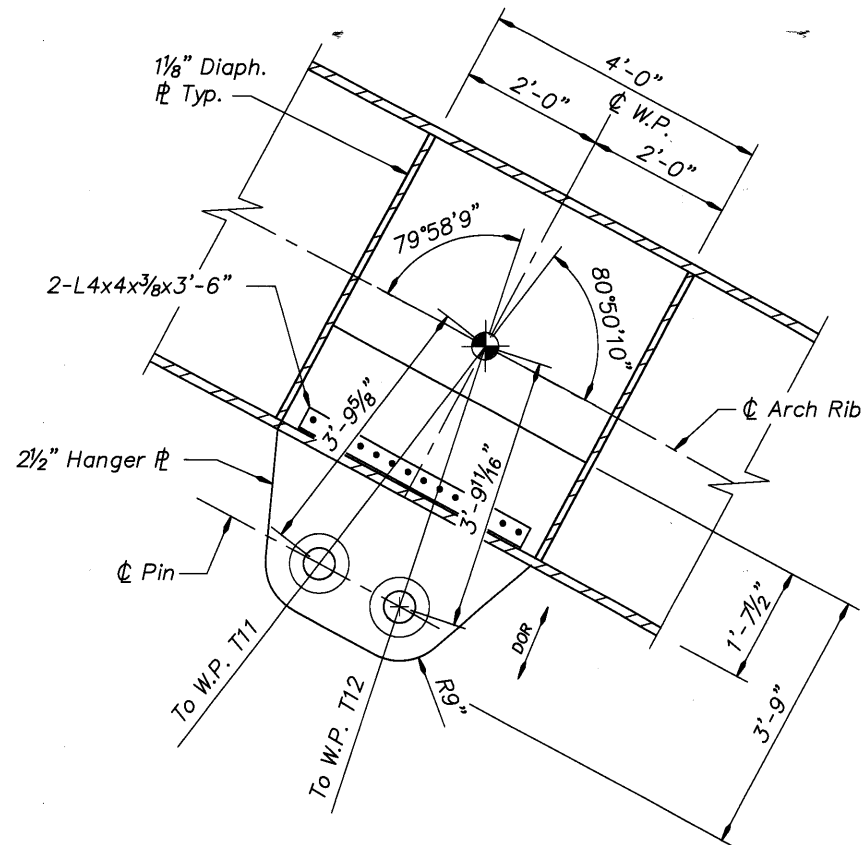

**WORKING POINT A13**  
Scale : 3/4" = 1'-0"

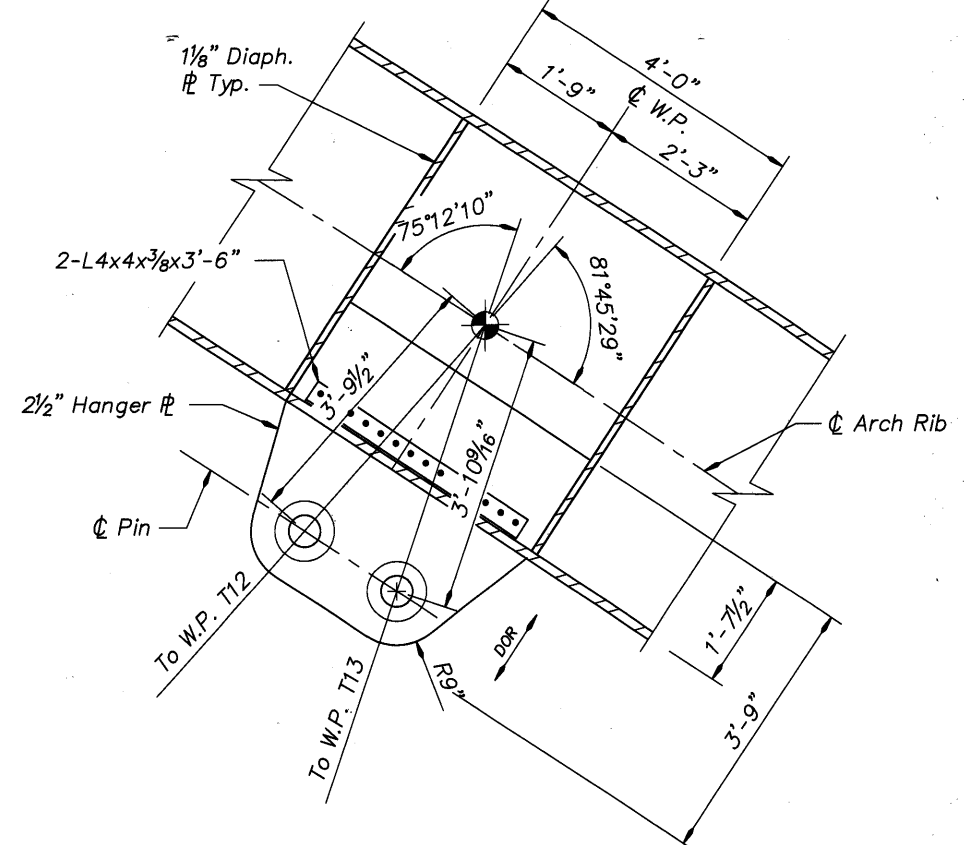

**WORKING POINT A14**  
Scale : 3/4" = 1'-0"

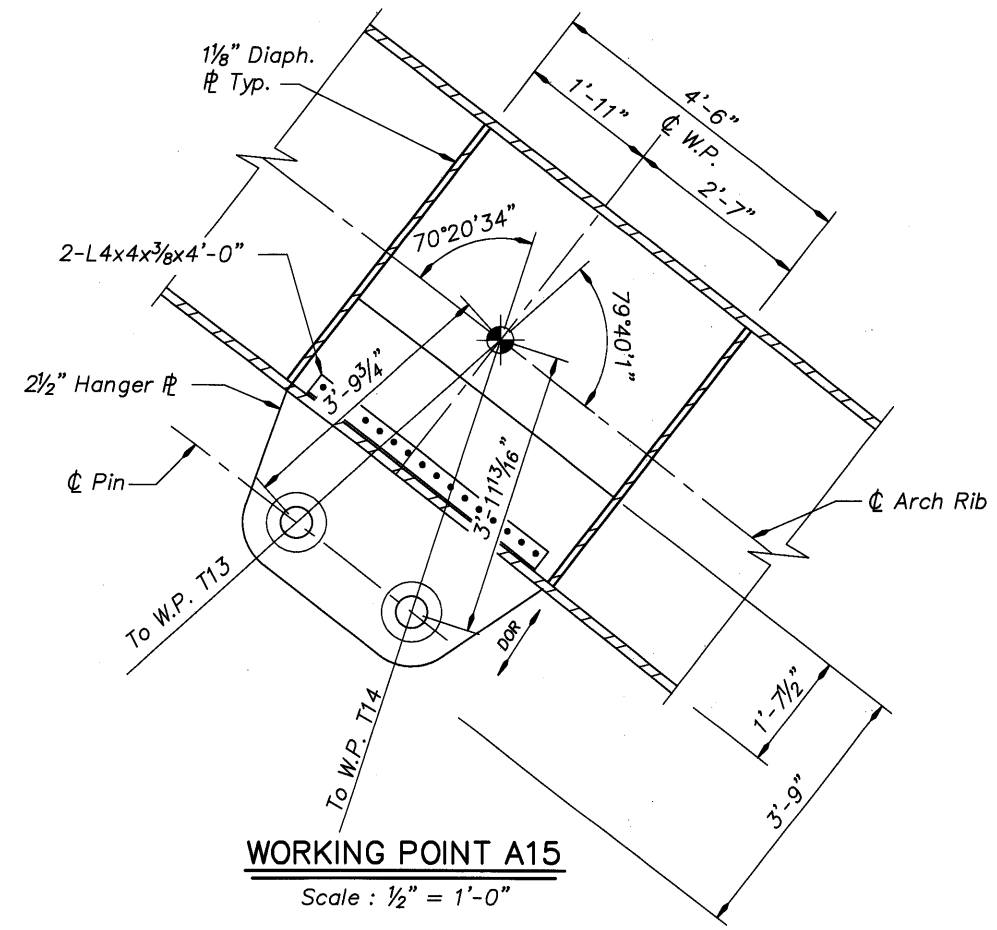

**WORKING POINT A15**  
Scale : 1/2" = 1'-0"

**Notes:**  
All angles shown are to local tangents to  
Arch Rib at working points.  
For Hanger Cable Details, see Dwg. #70242  
and #70243.

**DOR** Denotes Direction of Roll  
**WP** Denotes Working Point

DO NOT SCALE THIS DRAWING.  
FOLLOW DIMENSIONS. INDICATED  
SCALES CORRECT ONLY FOR  
FULL SIZE SHEET (22"x34").

DATE	REVISION	BY
03/09	As-Constructed	TDF

DRAFTED: J. Patton  
CHECKED: Shonn Mills  
DESIGNED: Paul Greco






**REVIEWED**  
REGISTERED PROFESSIONAL ENGINEER  
74549 PE  
DAVID EVANS AND ASSOCIATES INC.  
530 Center Street N.E., Suite 605  
Salem Oregon 97301  
Phone: 503.361.8635  
EXPIRES: 12-31-05

CONNECTING COMMERCE AND COMMUNITY  
**MULTNOMAH COUNTY BRIDGES**  
TRANSPORTATION DIVISION  
**OREGON DEPARTMENT OF TRANSPORTATION BRIDGE ENGINEERING SECTION**

BRIDGE NO. 20136  
DATE Sept. 2005  
CALC. BOOK

MULTNOMAH CHANNEL & PNWR ETC., SAUVIE ISLAND RD.  
ARCH RIB DETAILS (4 OF 5)

SHEET 41 OF 173  
DRAWING NO. 70228

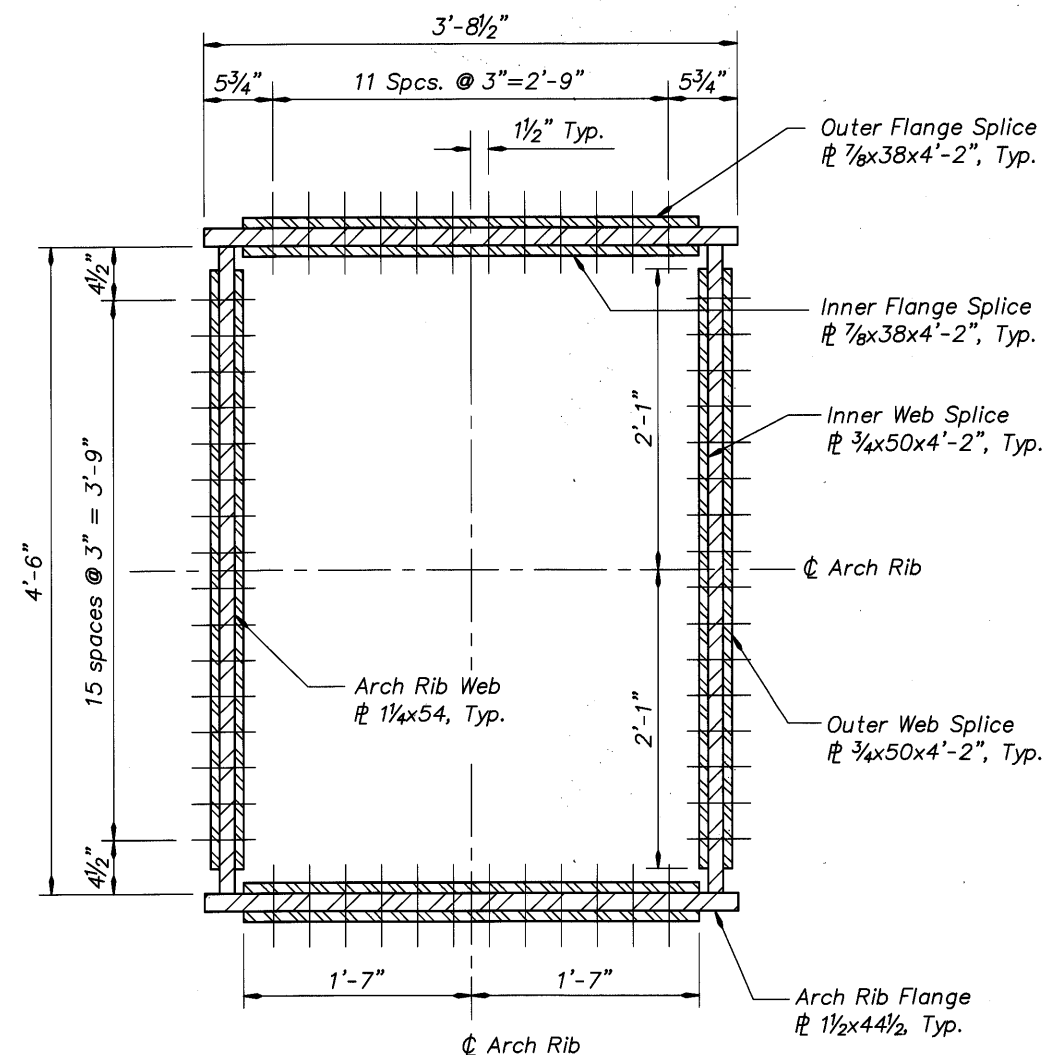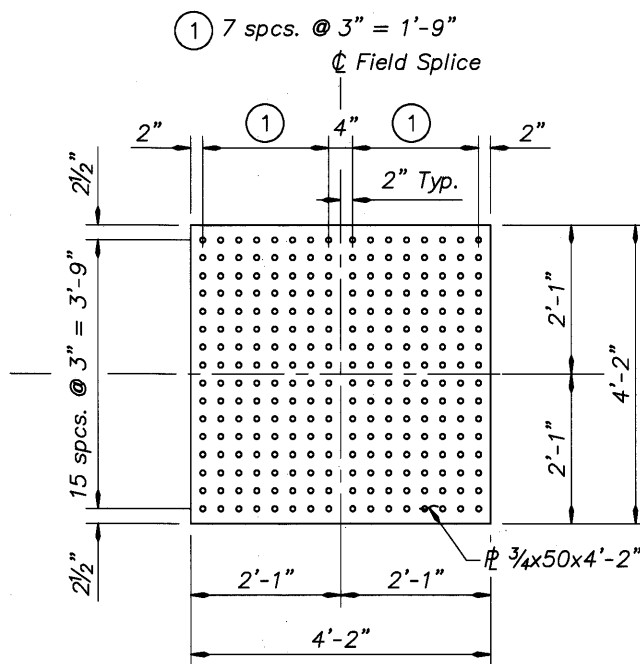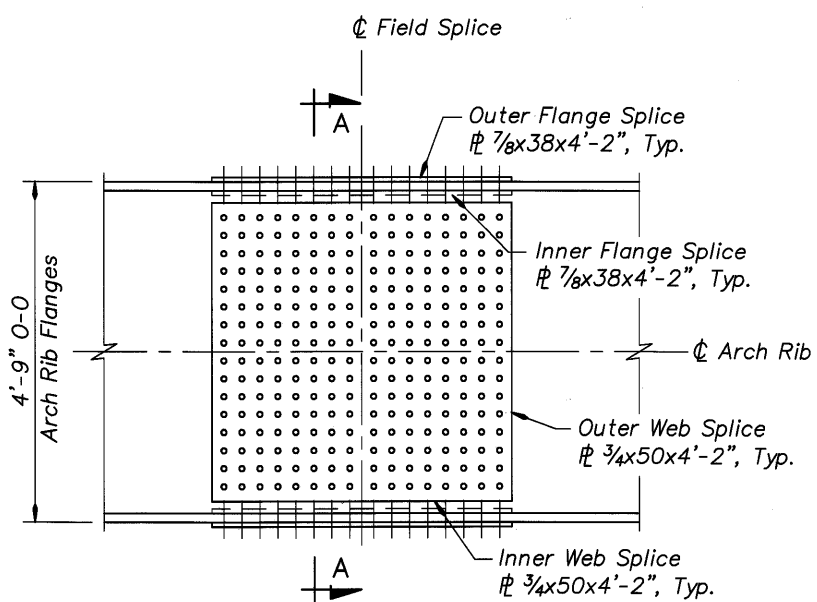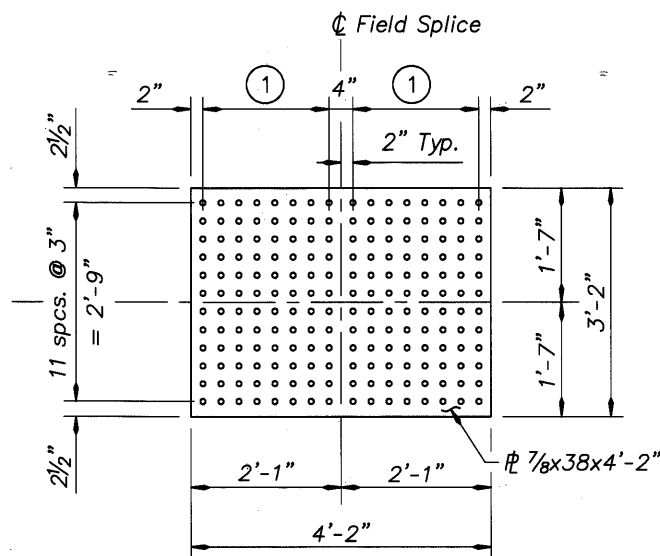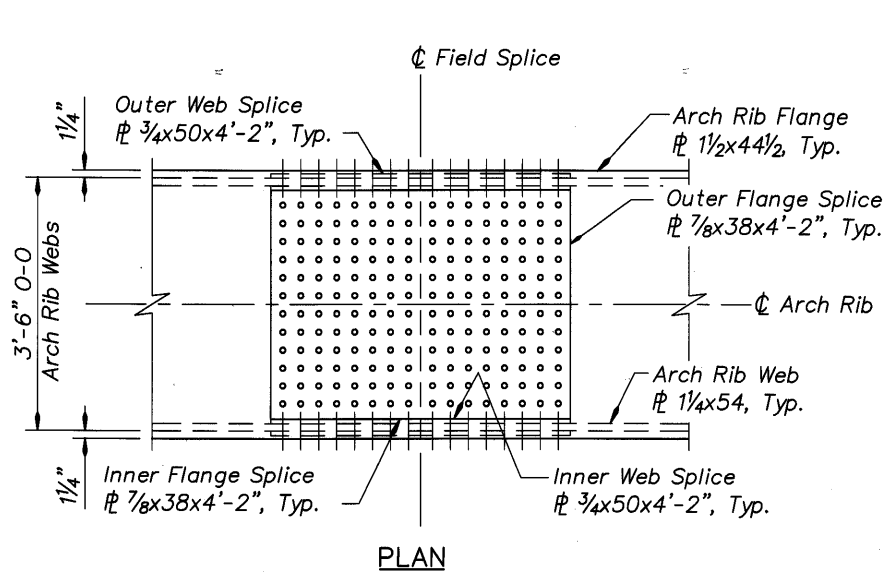


- Note:**
1. Typical Arch Rib splice is shown. See Dwg. #70219, and #70220 for specific locations. For Arch Rib/Knuckle splice, see Dwg. #70240.
  2. All bolts in splice are 7/8" dia. High Strength, Type 3 (Weathering) bolts designed to meet slip-critical criteria. See General Notes for further information.
  3. All splices are symmetrical about  $\phi$  Field Splice and Arch Rib web and flange plates.

**ARCH RIB SPLICE DETAILS**

Scale: 3/4" = 1'-0"

DO NOT SCALE THIS DRAWING. FOLLOW DIMENSIONS. INDICATED SCALES CORRECT ONLY FOR FULL SIZE SHEET (22"x34").


DATE	03/09	REVISION	As-Constructed	BY	J. Patton	REVIEWED	DAVID EVANS AND ASSOCIATES INC. 530 Center Street N.E., Suite 605 Salem Oregon 97301 Phone: 503.361.8635	MULTNOMAH COUNTY BRIDGES TRANSPORTATION DIVISION OREGON DEPARTMENT OF TRANSPORTATION BRIDGE ENGINEERING SECTION	BRIDGE NO.	20136	MULTNOMAH CHANNEL & PNWR ETC., SAUVIE ISLAND RD.	SHEET	42
	DATE		Sept. 2005		OF				173				
DESIGNED:	Eric Rau	EXPIRES:	6-30-06	CALC. BOOK		DRAWING NO.	70229						

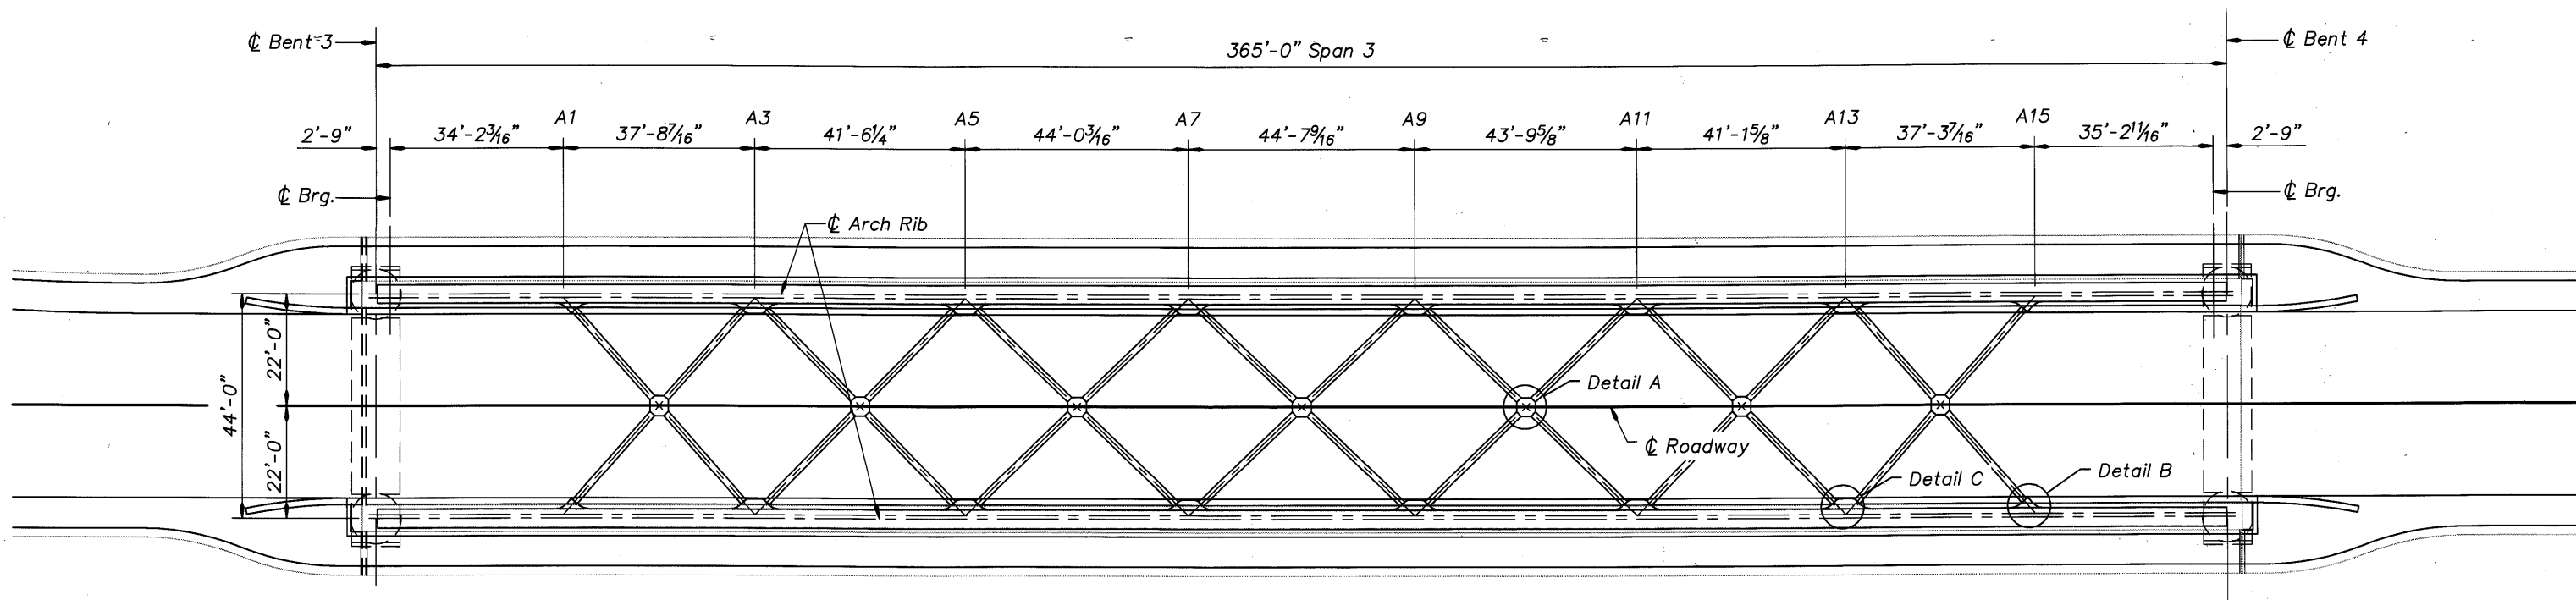

**ARCH RIB BRACING PLAN**

Scale: 1/16" = 1'-0"


Note: All dimensions shown are true horizontal.

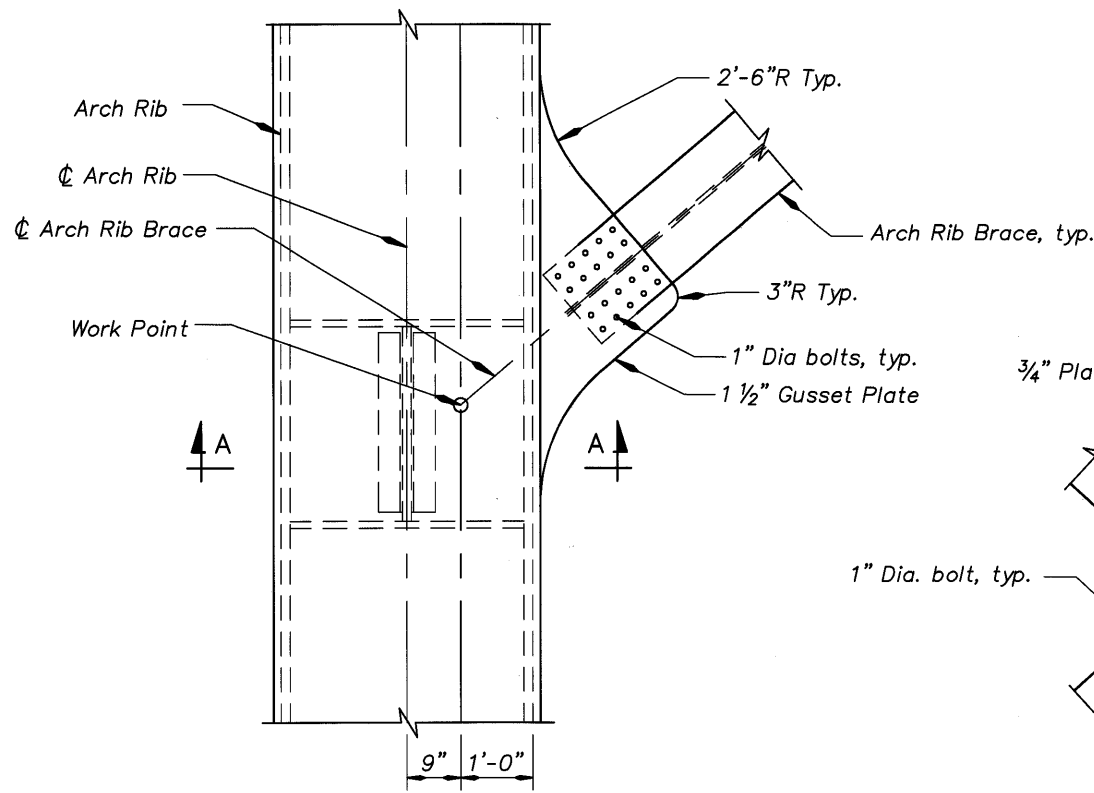

**DETAIL B**


Scale: 3/4" = 1'-0"

For Section A-A, see Dwg. #70209.

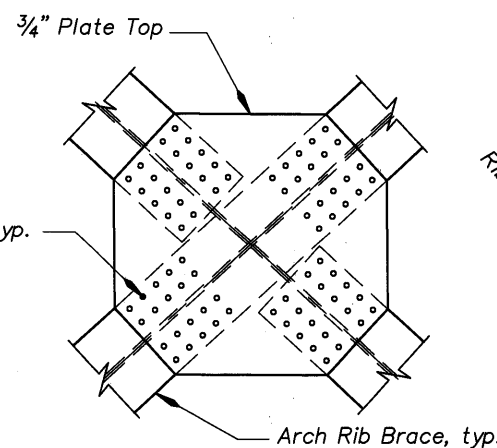

**DETAIL A TOP**

Scale: 3/4" = 1'-0"

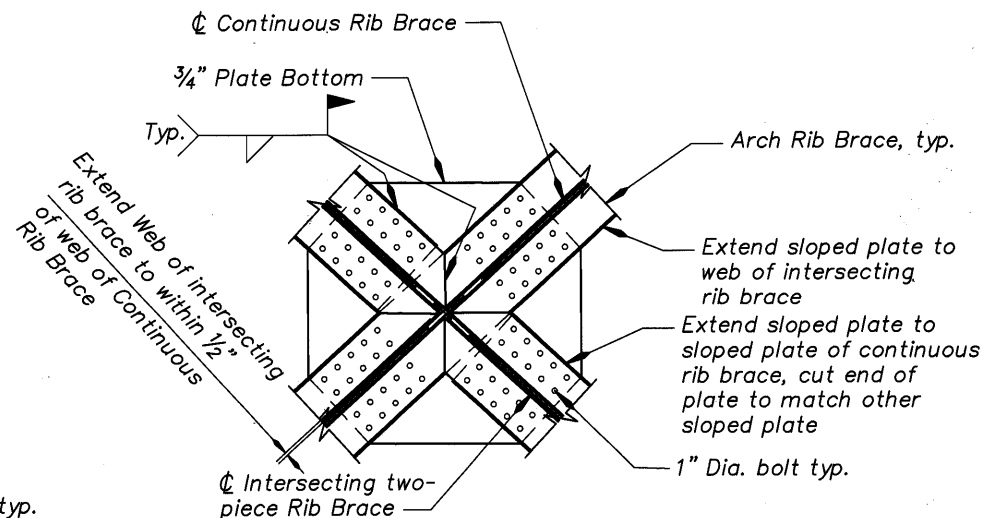


**DETAIL A BOTTOM**

Scale: 3/4" = 1'-0"

DO NOT SCALE THIS DRAWING. FOLLOW DIMENSIONS. INDICATED SCALES CORRECT ONLY FOR FULL SIZE SHEET (22"x34").

Xref: Odotbr.dwg, ODOT0460\_AF\_01.dwg, NEWSources\_Arch01.dwg, Arch2.dwg, C90TD460\_AS\_10.dwg

<table border="1"> <thead> <tr> <th>DATE</th> <th>REVISION</th> <th>BY</th> </tr> </thead> <tbody> <tr> <td>03/09</td> <td>As-Constructed</td> <td>TDF</td> </tr> </tbody> </table>	DATE	REVISION	BY	03/09	As-Constructed	TDF	J. Patton DRAFTED: Oliver Mueller CHECKED: Paul Greco DESIGNED:	REVIEWED  <b>DAVID EVANS AND ASSOCIATES INC.</b> 530 Center Street N.E., Suite 605 Salem Oregon 97301 Phone: 503.361.8635	CONNECTING COMMERCE AND COMMUNITY <b>MULTNOMAH COUNTY BRIDGES</b> TRANSPORTATION DIVISION 	BRIDGE NO. 20136 DATE Sept. 2005 CALC. BOOK	MULTNOMAH CHANNEL & PNWR ETC., SAUVIE ISLAND RD. ARCH RIB BRACING PLAN	SHEET 43 OF 173. DRAWING NO. 70230
	DATE	REVISION	BY									
03/09	As-Constructed	TDF										

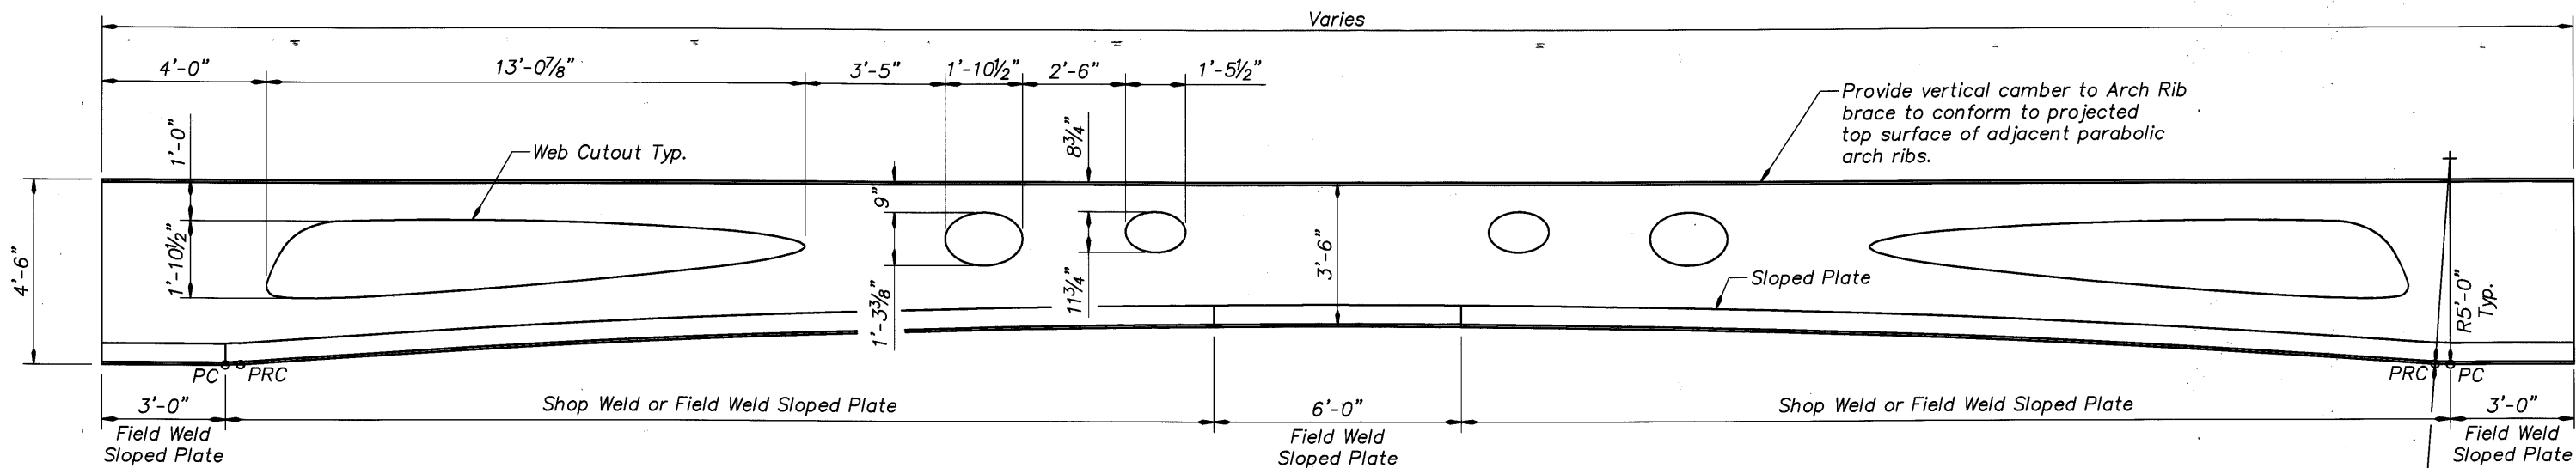


**ARCH RIB BRACE ELEVATION**

Scale: 1/2" = 1'-0"

Continuous Rib Brace Shown, Two-Piece Rib Brace Similar  
See Detail A Bottom for Intersecting Two-Piece Rib Brace and Sloped Plate Details


**NOTE:**  
CADD drawing files of web cutouts will be provided to the steel fabricator. Approximate cutout dimensions are provided for information only.

Maintain web of arch rib brace in a constant plane, determined at the intersection point of the two crossing braces. Vary the flange-to-web angle as required to conform to local arch gusset plate orientation. Increase arch gusset plate dimensions as required to fit brace flanges.

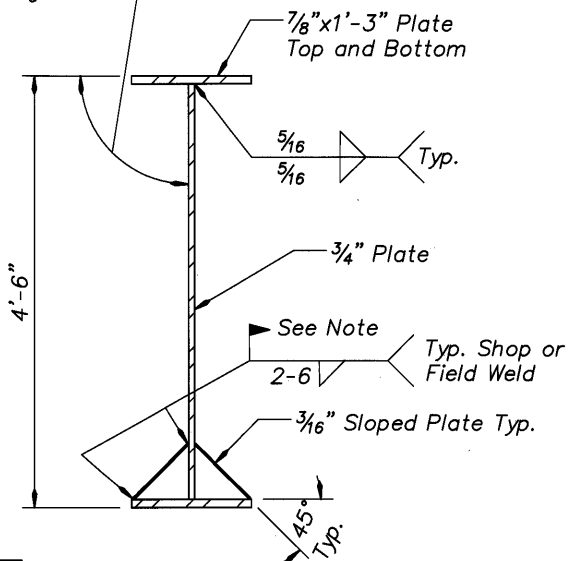


**SECTION B-B**

Scale: 1" = 1'-0"

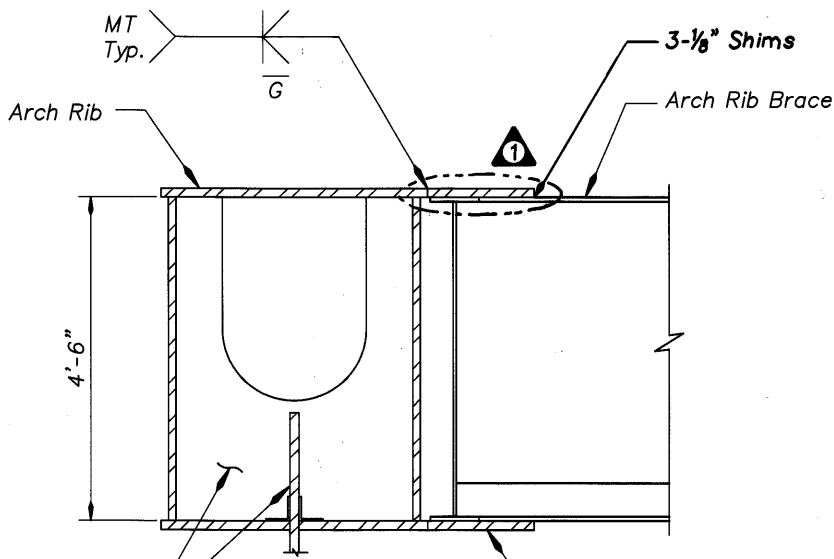

**SECTION A-A**

Scale: 3/4" = 1'-0"

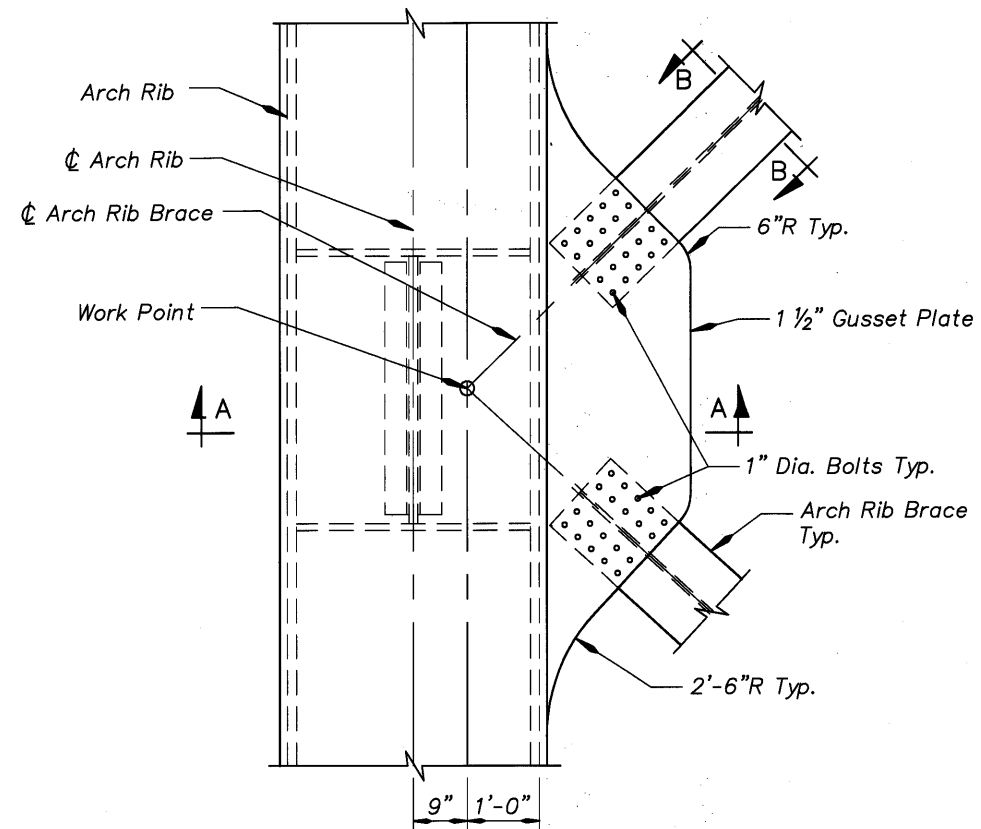

**DETAIL C**

Scale: 3/4" = 1'-0"

DO NOT SCALE THIS DRAWING. FOLLOW DIMENSIONS. INDICATED SCALES CORRECT ONLY FOR FULL SIZE SHEET (22"x34").

DATE	REVISION	BY
03/09	As-Constructed	TDF

DRAFTED: D. Gattshall  
CHECKED: Oliver Mueller  
DESIGNED: Paul Greco


**REVIEWED**  
REGISTERED PROFESSIONAL ENGINEER  
DAVID EVANS AND ASSOCIATES INC.  
530 Center Street N.E., Suite 605  
Salem Oregon 97301  
Phone: 503.361.8635  
EXPIRES: 12-31-05

CONNECTING COMMERCE AND COMMUNITY  
**MULTNOMAH COUNTY BRIDGES**  
TRANSPORTATION DIVISION  
**OREGON DEPARTMENT OF TRANSPORTATION BRIDGE ENGINEERING SECTION**

BRIDGE NO. 20136  
DATE Sept. 2005  
CALC. BOOK


MULTNOMAH CHANNEL & PNWR ETC., SAUVIE ISLAND RD.  
**ARCH RIB BRACING DETAILS**

SHEET 44 OF 173  
DRAWING NO. 70231

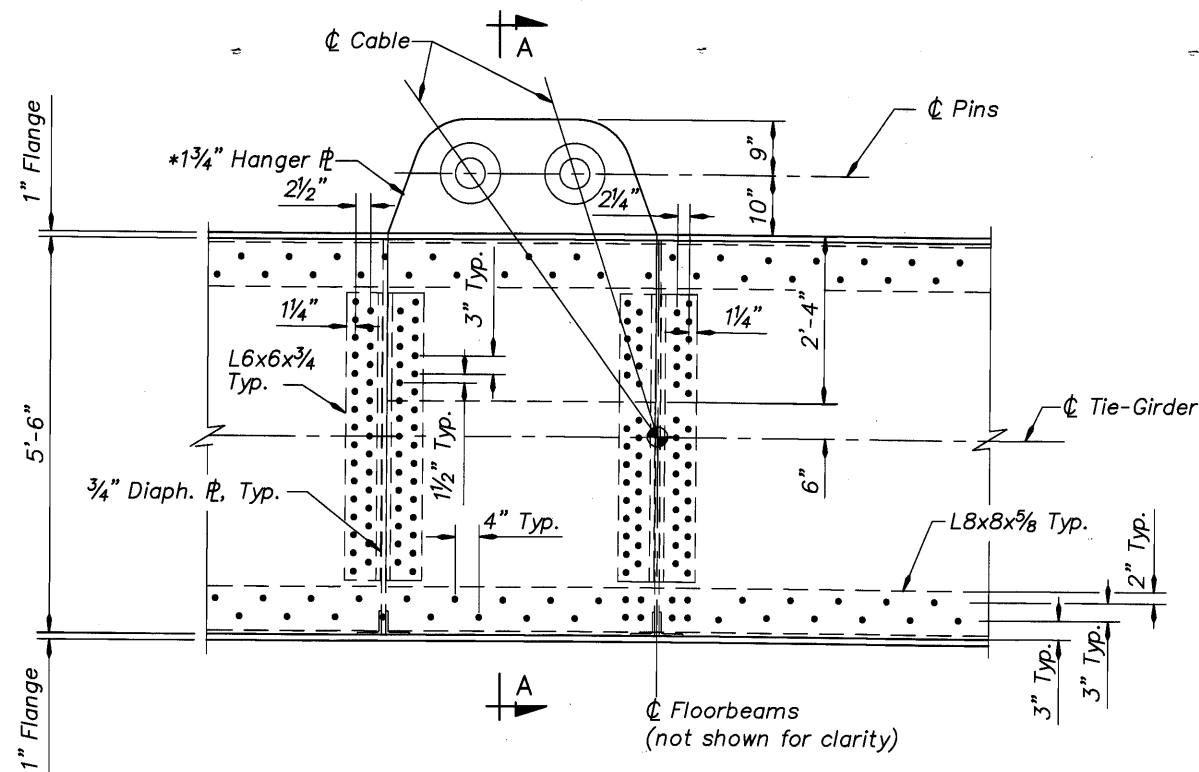

**TIE-GIRDER ELEVATION**

Scale : 3/4" = 1'-0"

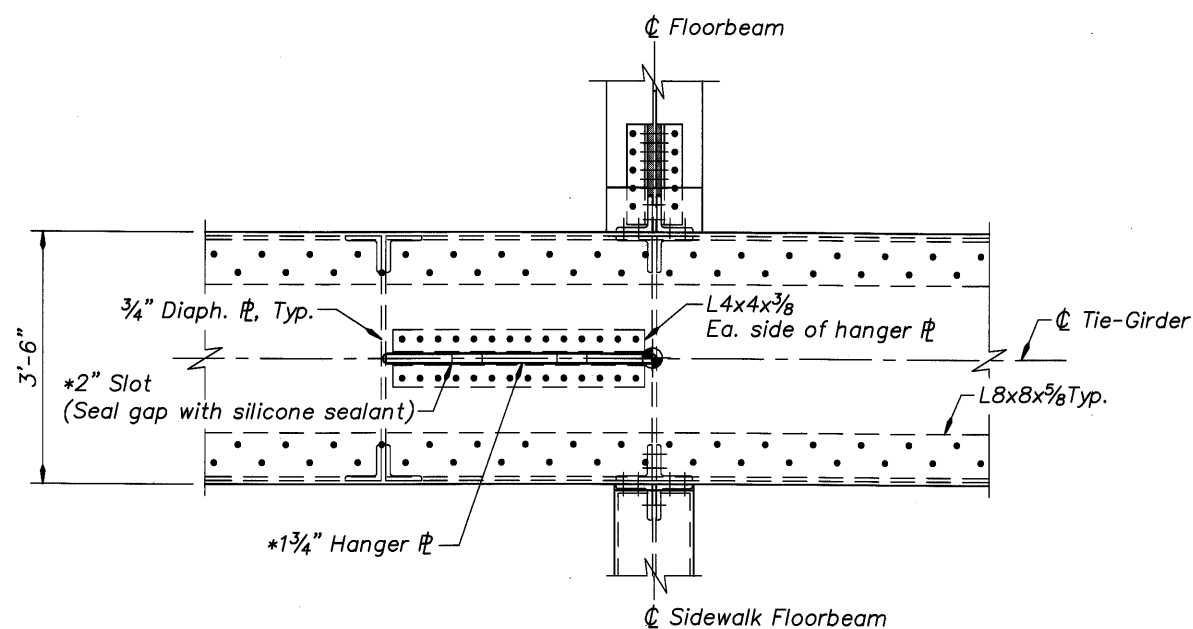


**TIE-GIRDER PLAN**

Scale : 3/4" = 1'-0"

\*Note:

All Tie-Girder hanger plates are 1 3/4" thick with 2" receiving slots in the tie-girder top flange except at Working Point T8. At that location the hanger plate is 3" thick and the receiving slot in the tie-girder top flange plate is 3 1/4" wide. Slots shall be 1/2" round ends. Seal all slots with clear silicone sealer.

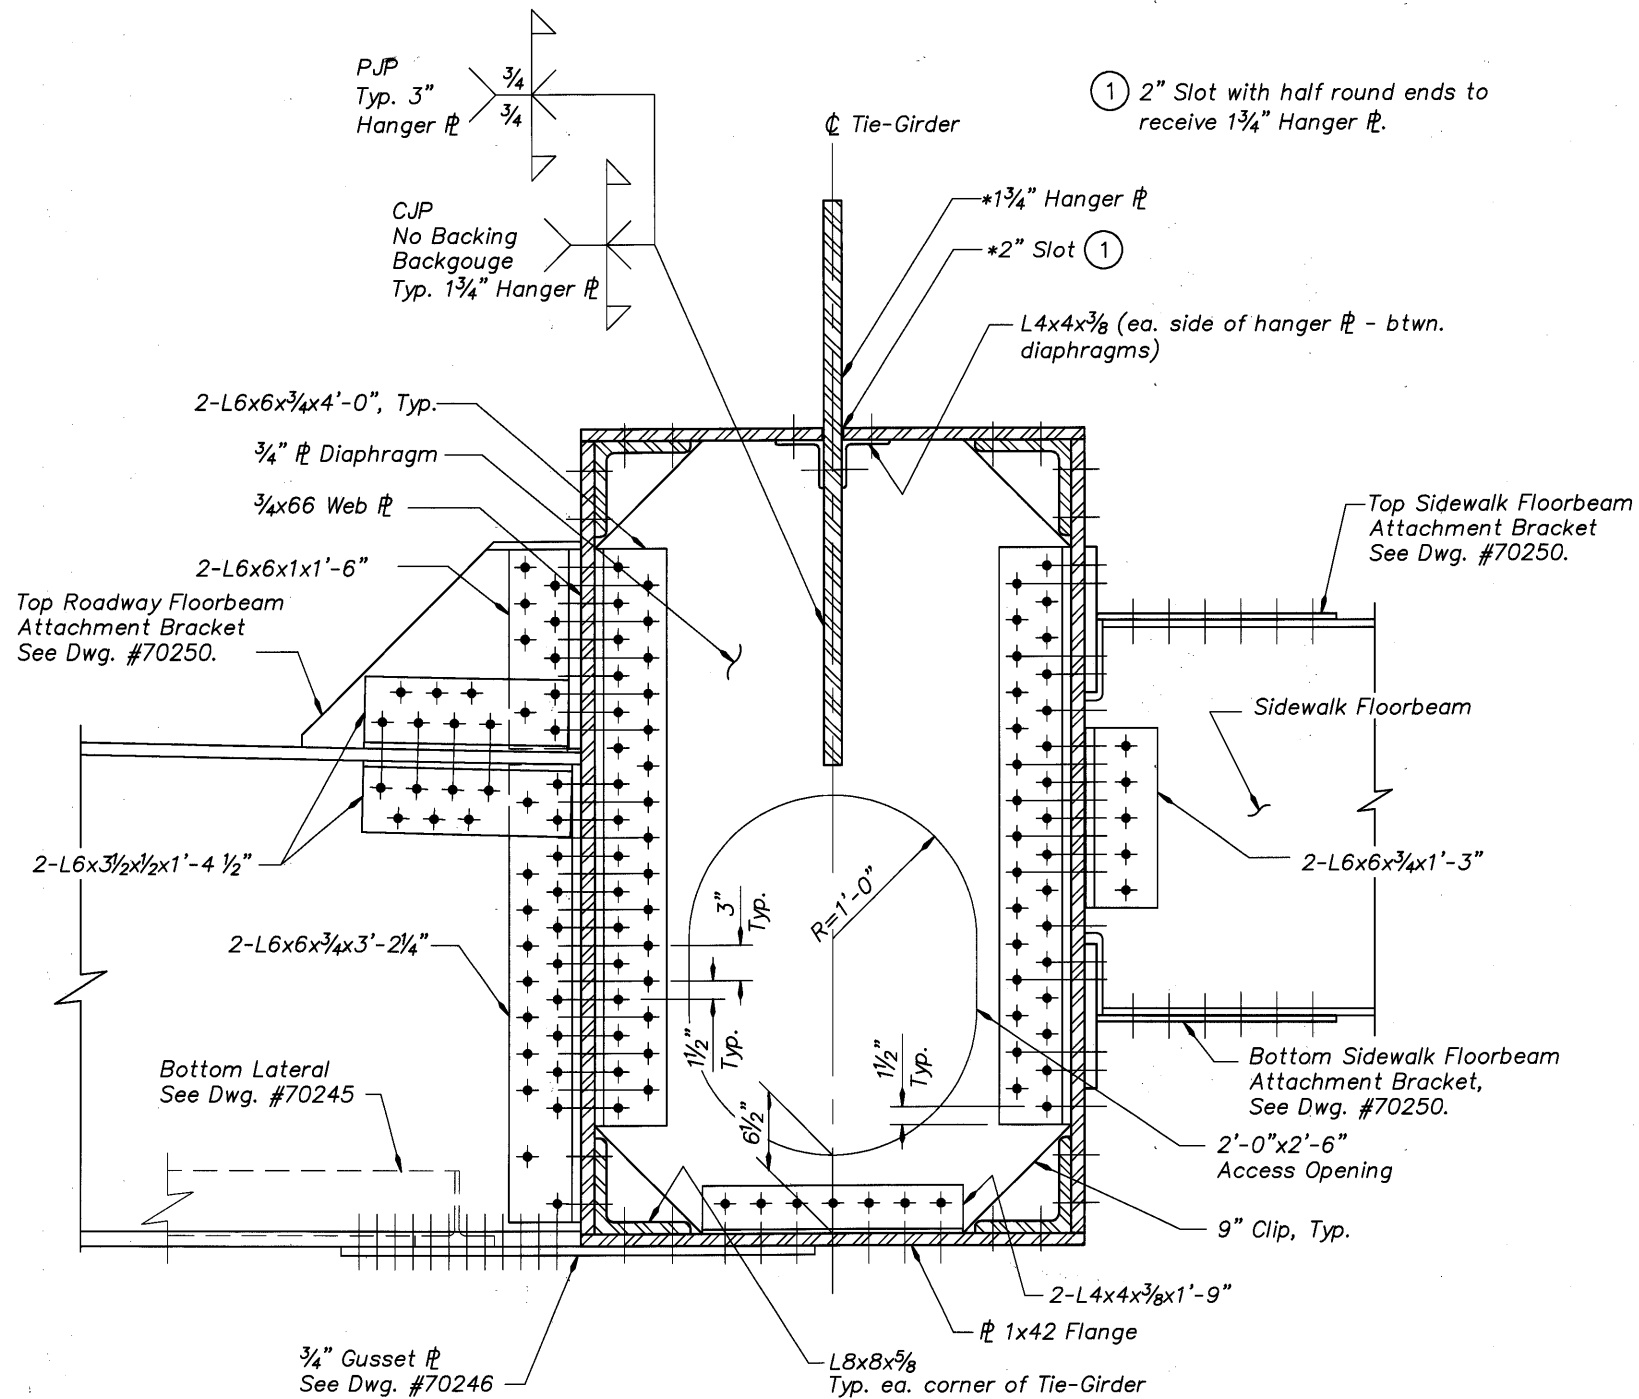

**SECTION A-A**

TYPICAL SECTION THROUGH TIE-GIRDER AT FLOORBEAM/HANGER

Scale : 1/2" = 1'-0"

Section A-A applies to all Tie-Girder diaphragms except T8 center diaphragm. For details at that location, see Dwg. #70235.

DO NOT SCALE THIS DRAWING. FOLLOW DIMENSIONS. INDICATED SCALES CORRECT ONLY FOR FULL SIZE SHEET (22"x34").

DATE	REVISION	BY
03/09	As-Constructed	TDF

DRAFTED: J. Patton  
 CHECKED: Shonn Mills  
 DESIGNED: Clifford Coulter

**REVIEWED**

**DAVID EVANS AND ASSOCIATES INC.**  
 530 Center Street N.E., Suite 605  
 Salem Oregon 97301  
 Phone: 503.361.8635

EXPIRES: 12-31-05







CONNECTING COMMERCE AND COMMUNITY

**MULTNOMAH COUNTY**  
 BRIDGES



TRANSPORTATION DIVISION

**OREGON DEPARTMENT OF TRANSPORTATION**  
 BRIDGE ENGINEERING SECTION

<b>BRIDGE NO.</b> 20136	<b>MULTNOMAH CHANNEL &amp; PNWR ETC., SAUVIE ISLAND RD.</b>	<b>SHEET</b> 45 OF 173
<b>DATE</b> Sept. 2005		
<b>CALC. BOOK</b>		
<b>TIE GIRDER DETAILS</b>		<b>DRAWING NO.</b> 70232

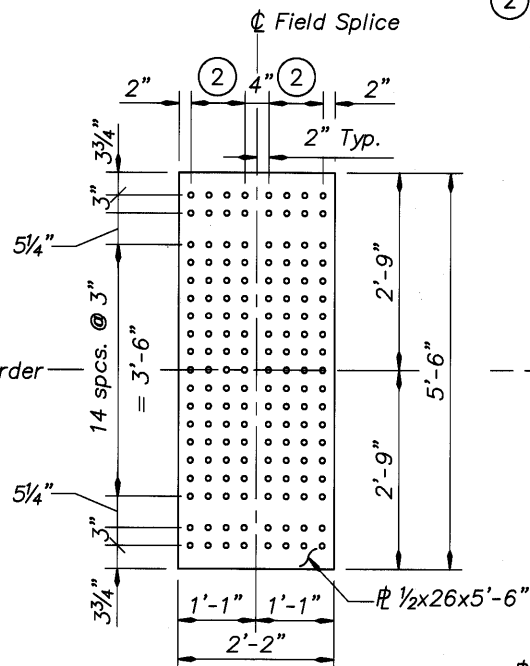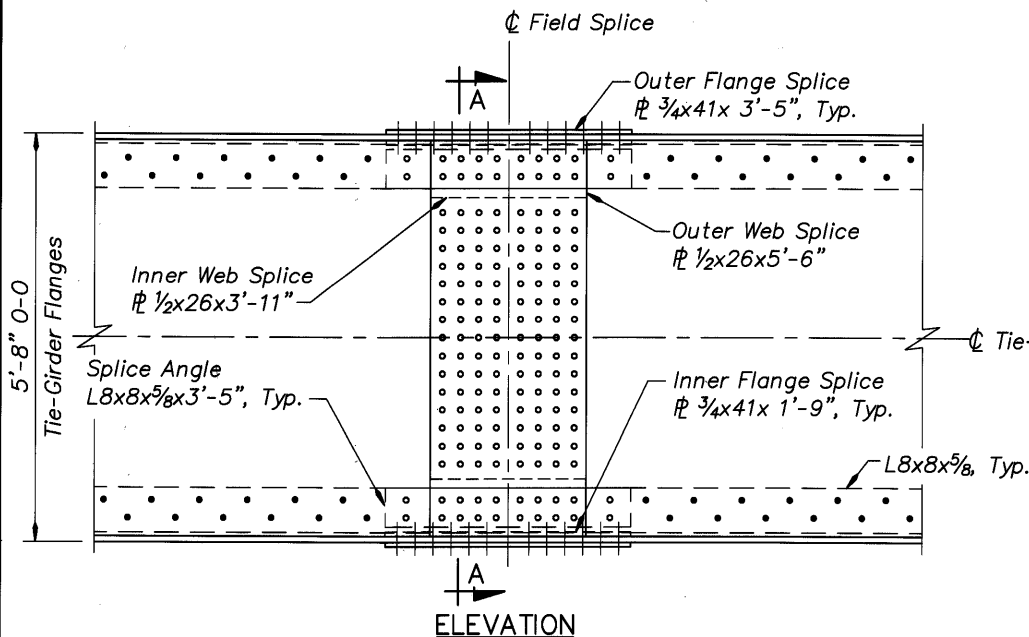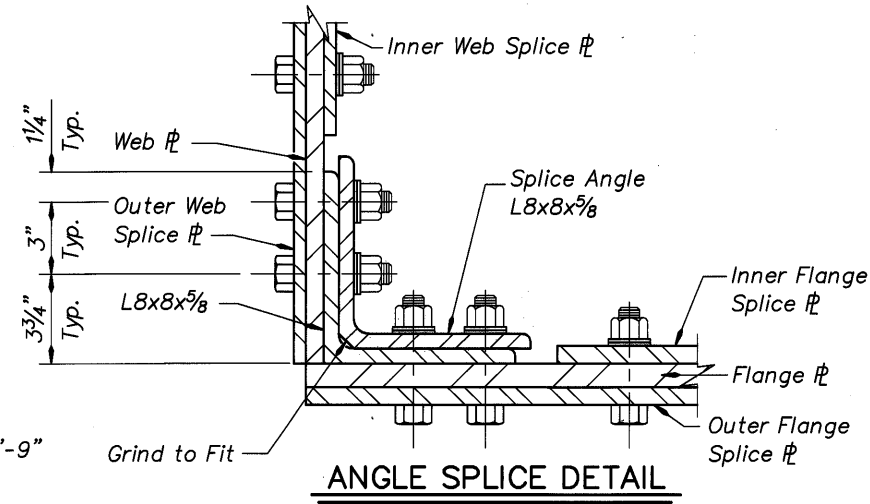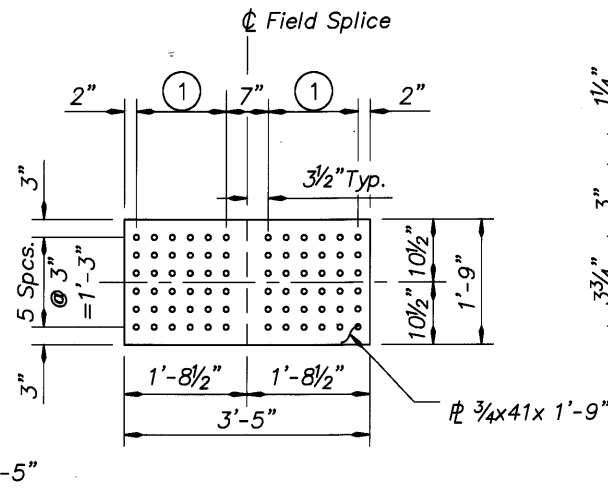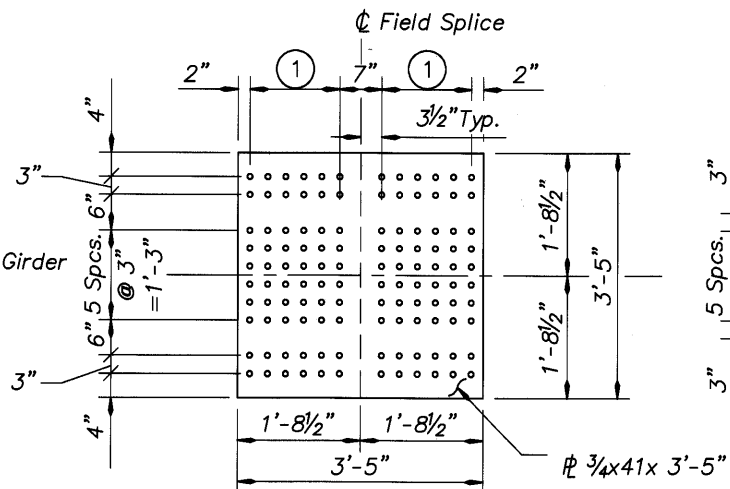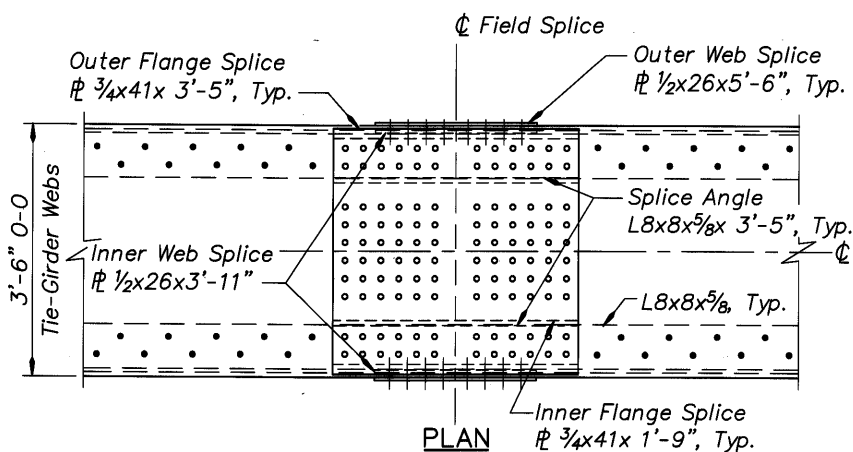

- ① 5 spcs. @ 3" = 1'-3"
- ② 3 spcs. @ 3" = 9"

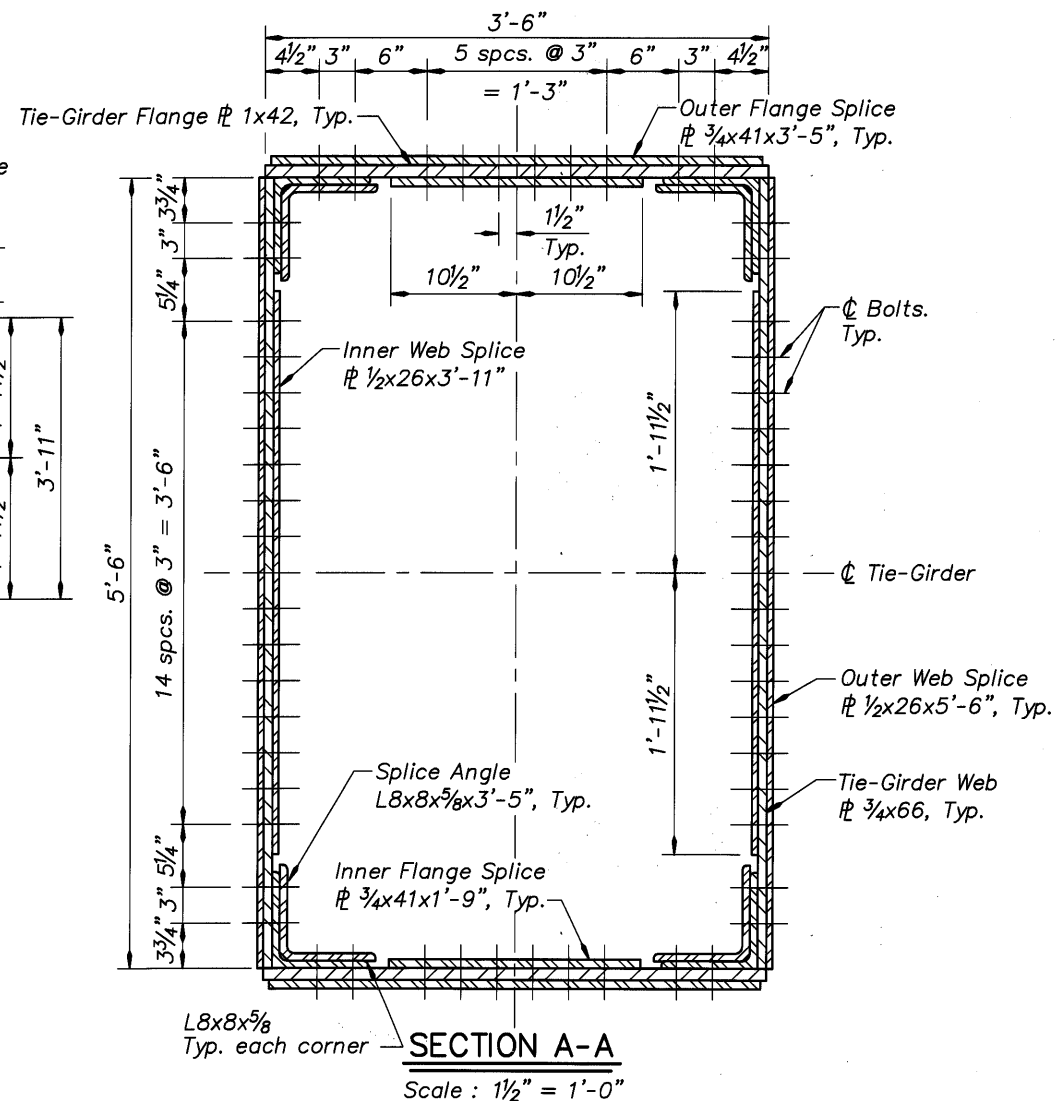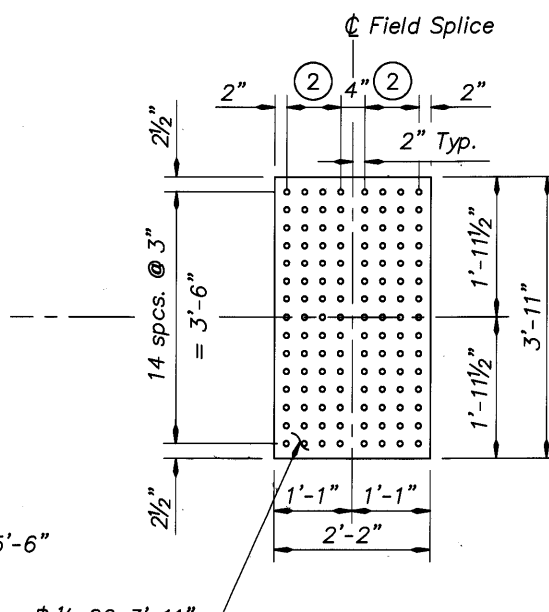

- Note:**
1. Typical Tie-Girder splices are shown. See Dwg. #70219 and #70220 for specific locations. For Tie-Girder/Knuckle splice, see Dwg. #70239.
  2. All bolts in splice are 7/8" dia. High Strength, Type 3 (Weathering) bolts designed to meet slip-critical criteria. See General Notes for further information.
  3. All Splices are symmetrical about  $\phi$  Field Splice and Tie-Girder web & flange plates.
  4. Caulk plate interfaces. See General Notes.

**TIE-GIRDER SPICE DETAILS**

Scale: 3/4" = 1'-0"

DO NOT SCALE THIS DRAWING. FOLLOW DIMENSIONS. INDICATED SCALES CORRECT ONLY FOR FULL SIZE SHEET (22"x34").

DATE	REVISION	BY	DRAFTED:
08/05	Added Note 4, removed sealant note	JBT	J. Patton
03/09	As-Constructed	TDF	Oliver Mueller
			Eric Rau

**REVIEWED**

REGISTERED PROFESSIONAL ENGINEER  
 OREGON  
 MAY 5, 2005  
 JEL BRANDON TUBBS

**DAVID EVANS AND ASSOCIATES INC.**  
 530 Center Street N.E., Suite 605  
 Salem Oregon 97301  
 Phone: 503.361.8635

EXPIRES: 6-30-06


CONNECTING COMMERCE AND COMMUNITY

**MULTNOMAH COUNTY BRIDGES**


TRANSPORTATION DIVISION

**OREGON DEPARTMENT OF TRANSPORTATION BRIDGE ENGINEERING SECTION**


BRIDGE NO. 20136	MULTNOMAH CHANNEL & PNWR ETC., SAUVIE ISLAND RD.	SHEET 46 OF 173
DATE Sept. 2005		DRAWING NO. 70233
CALC. BOOK		

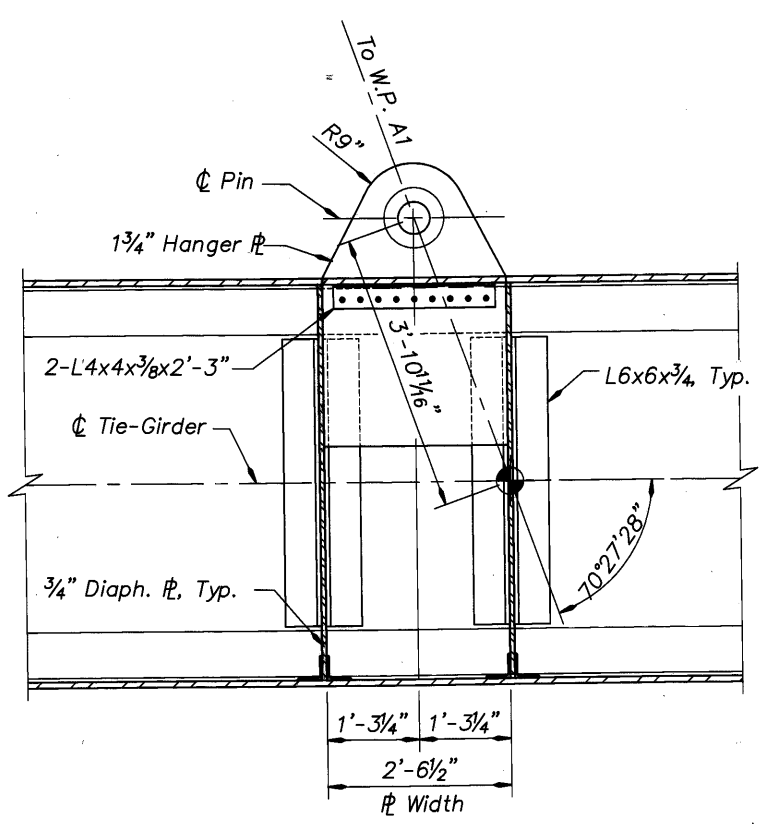


**WORKING POINT T2**  
Scale : 3/4" = 1'-0"

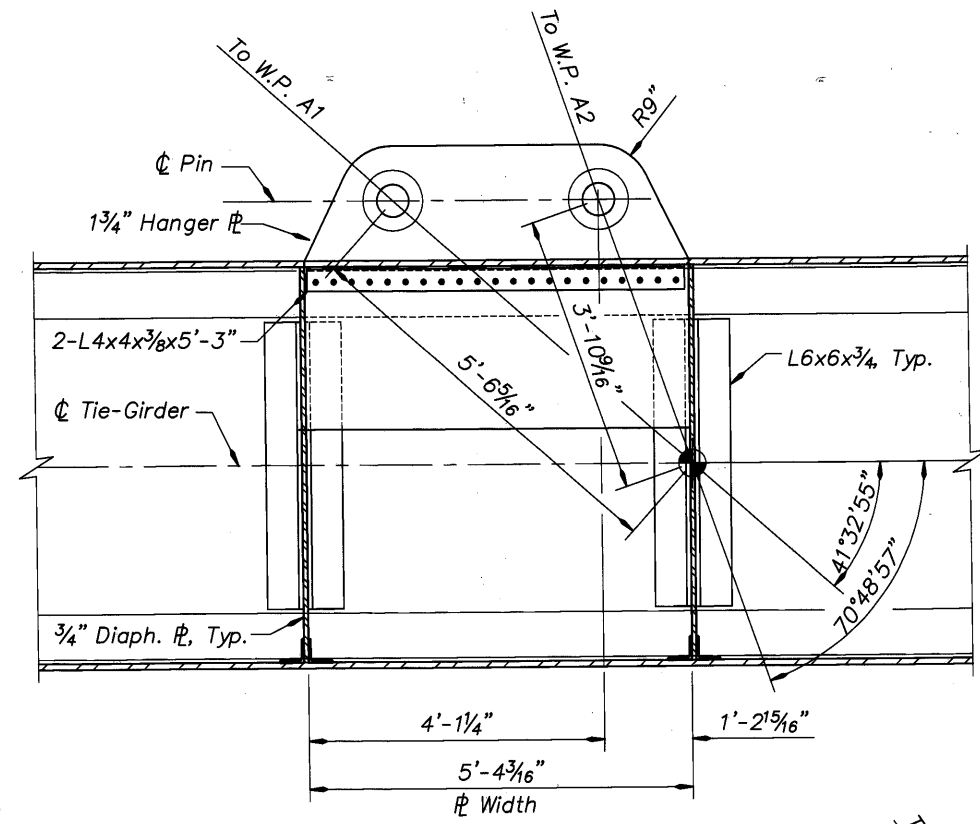


**WORKING POINT T3**  
Scale : 3/4" = 1'-0"

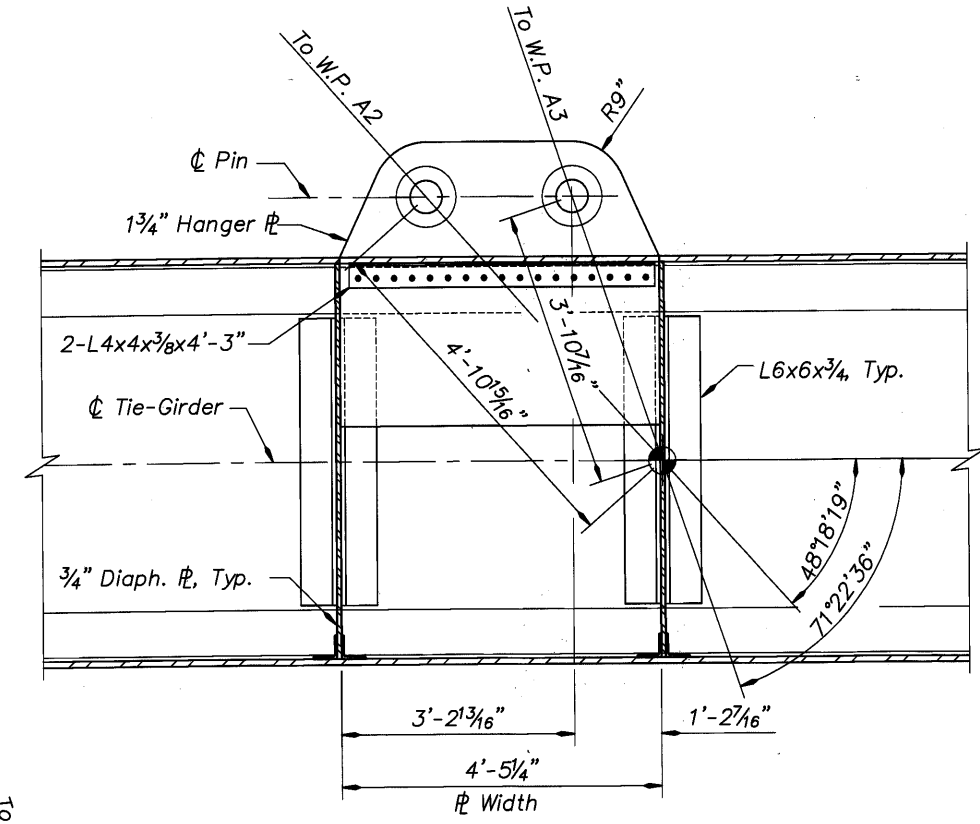

**WORKING POINT T4**  
Scale : 3/4" = 1'-0"

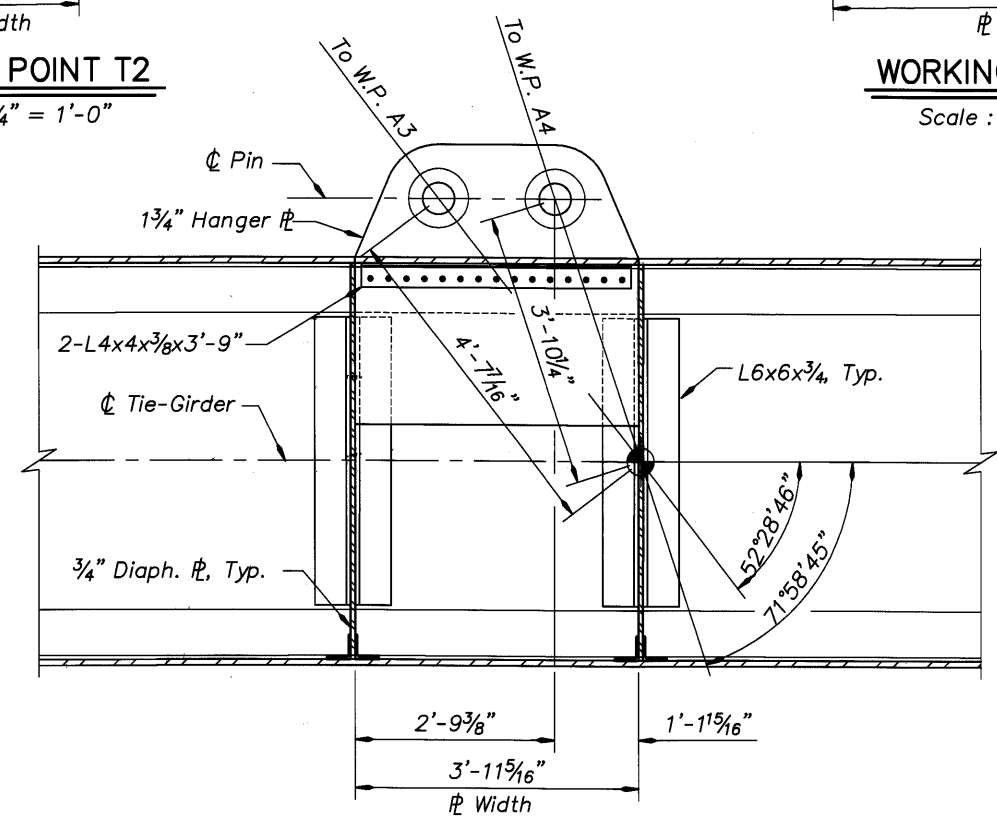

**WORKING POINT T5**  
Scale : 3/4" = 1'-0"

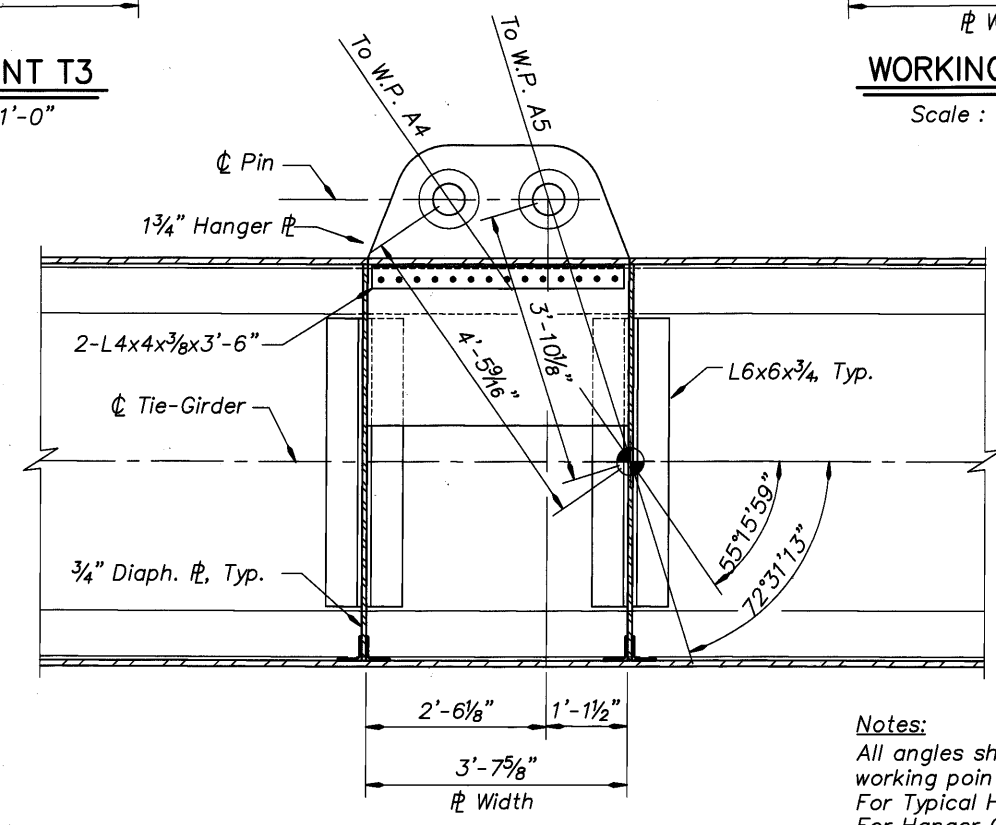

**WORKING POINT T6**  
Scale : 3/4" = 1'-0"

**Notes:**  
All angles shown are to local tangents to  $\phi$  Tie-Girder at working points.  
For Typical Hanger Detail, see Dwg. #70235.  
For Hanger Cable Details, see Dwg. #70242 and #70243.  
For Tie-Girder details not shown, see Dwg. #70232.  
 Denotes Working Point


DO NOT SCALE THIS DRAWING.  
FOLLOW DIMENSIONS. INDICATED  
SCALES CORRECT ONLY FOR  
FULL SIZE SHEET (22"x34").

DATE	03/09	REVISION	As-Constructed	BY	J. Patton	REVIEWED	 DAVID EVANS AND ASSOCIATES INC. 530 Center Street N.E., Suite 605 Salem Oregon 97301 Phone: 503.361.8635	BRIDGE NO.	20136	SHEET	47
	DATE		Sept. 2005		OF				173		
DESIGNED:	Paul Greco	CHECKED:	Shonn Mills	DRAFTED:	TDF	EXP. DATE:	12-31-05	CALC. BOOK		DRAWING NO.	70234
								TRANSPORTATION DIVISION	MULTNOMAH CHANNEL & PNWR ETC., SAUVIE ISLAND RD.		
								OREGON DEPARTMENT OF TRANSPORTATION BRIDGE ENGINEERING SECTION	TIE GIRDER HANGER DETAILS (1 OF 3)		

Xref: ODOT0460.dwg ODOT0460.dwg




DO NOT SCALE THIS DRAWING.  
FOLLOW DIMENSIONS. INDICATED  
SCALES CORRECT ONLY FOR  
FULL SIZE SHEET (22"x34").

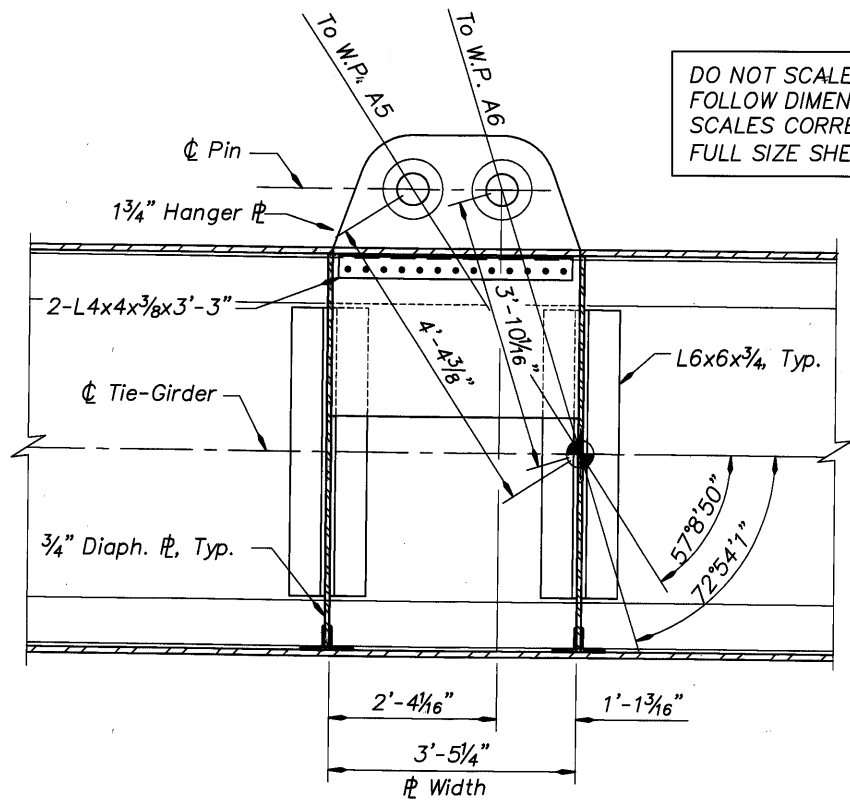


**WORKING POINT T7**

Scale : 3/4" = 1'-0"

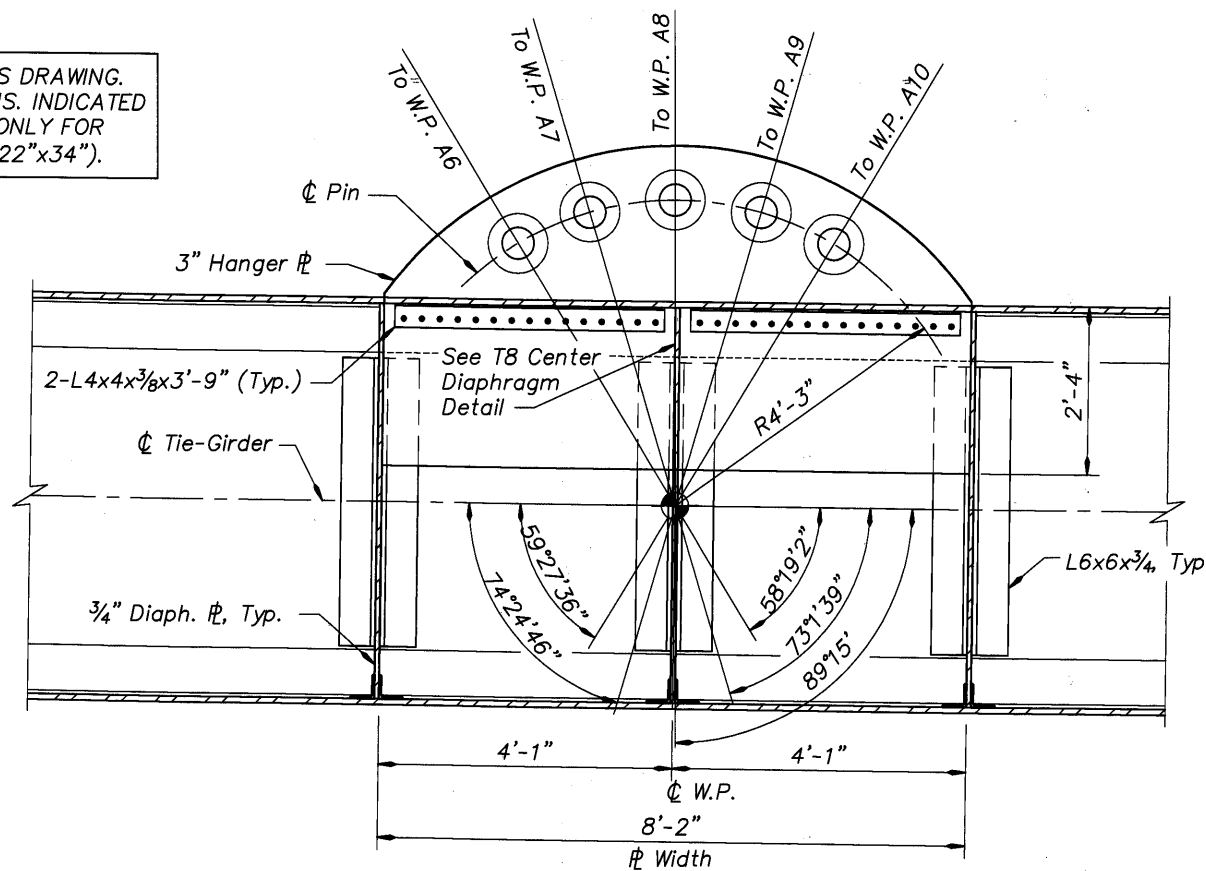


**WORKING POINT T8**

Scale : 3/4" = 1'-0"

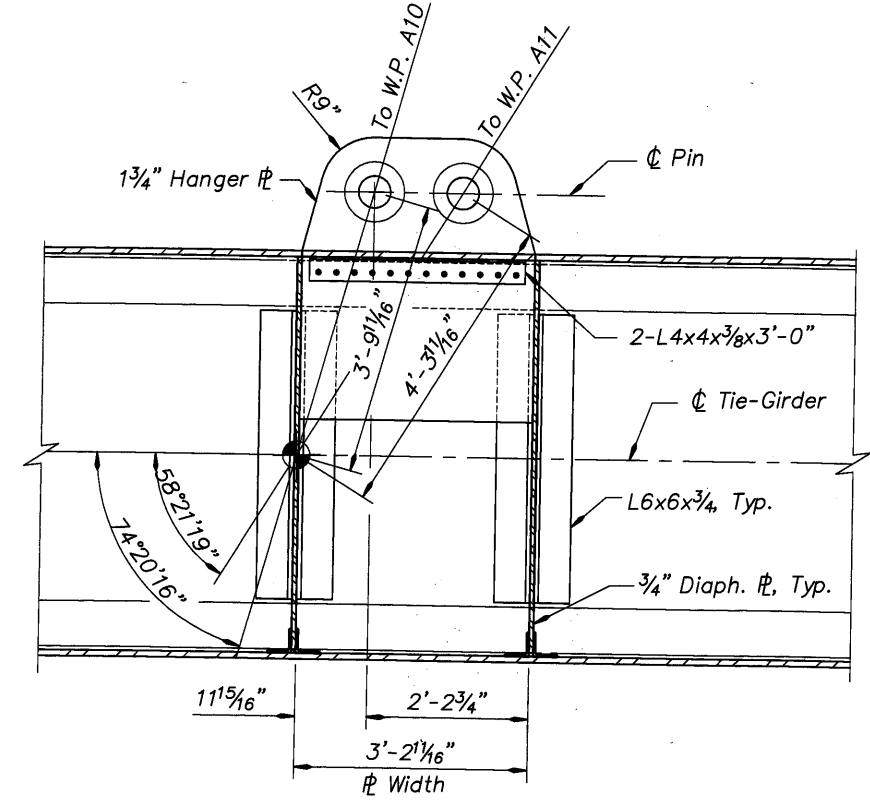


**WORKING POINT T9**

Scale : 3/4" = 1'-0"

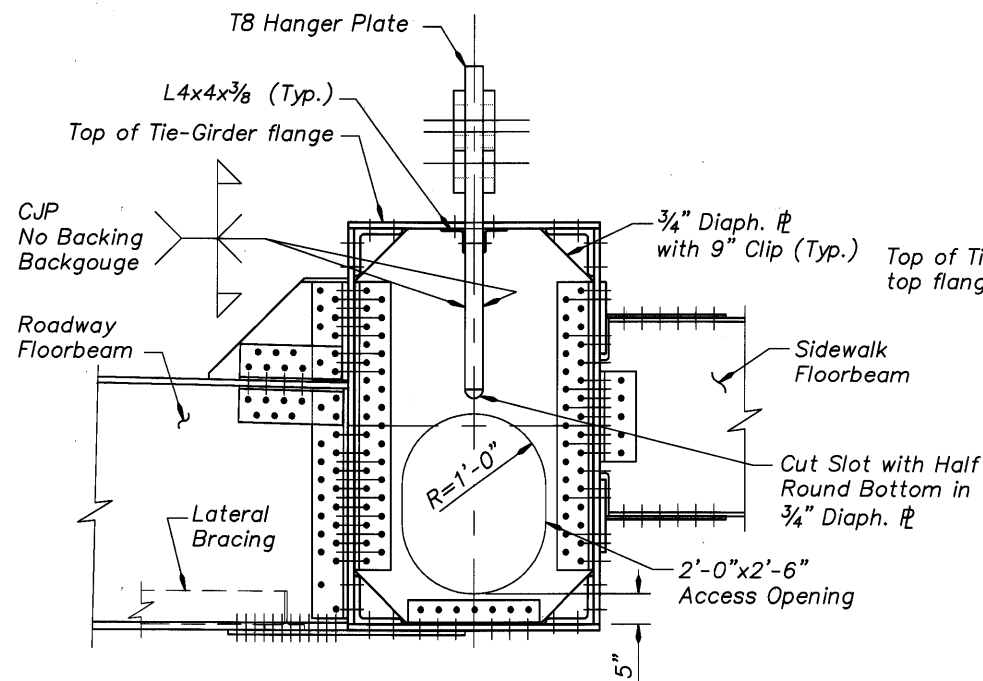


**T8 CENTER DIAPHRAGM DETAIL**

Scale : 3/4" = 1'-0"

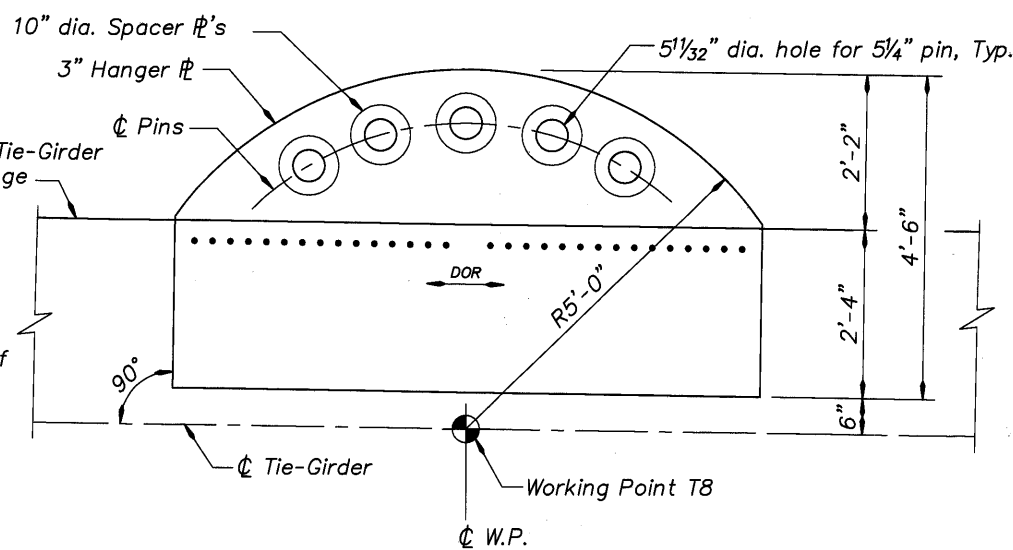

**HANGER PLATE AT WORKING POINT T8**

Scale : 3/4" = 1'-0"

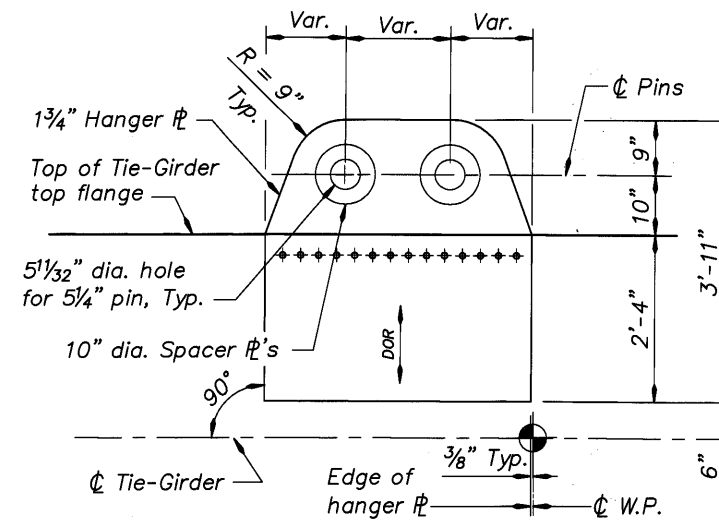

**TYPICAL HANGER PLATE**

Scale : 3/4" = 1'-0"

**Notes:**  
All angles shown are to local tangents to  $\phi$  Tie-Girder at working points.  
For Hanger Cable Details, see Dwg. #70242 and #70243.  
For Tie-Girder details not shown, see Dwg. #70232.

$\bullet$  Denotes Working Point

$\rightarrow$  DOR Denotes Direction of Roll

DATE	REVISION	BY
03/09	As-Constructed	TDF
		J. Patton
		Shonn Mills
		Paul Greco

**REVIEWED**

REGISTERED PROFESSIONAL ENGINEER  
74549 PE #  
Bentley  
MARCH 09, 2005  
WENT WILLIAM CORRY

**DAVID EVANS AND ASSOCIATES INC.**  
530 Center Street N.E., Suite 605  
Salem Oregon 97301  
Phone: 503.361.8635

EXPIRES: 12-31-05


CONNECTING COMMERCE AND COMMUNITY

**MULTNOMAH COUNTY BRIDGES**

TRANSPORTATION DIVISION

**OREGON DEPARTMENT OF TRANSPORTATION BRIDGE ENGINEERING SECTION**

BRIDGE NO. 20136	MULTNOMAH CHANNEL & PNWR ETC., SAUVIE ISLAND RD.	SHEET 48 OF 173.
DATE Sept. 2005		
CALC. BOOK		
TIE GIRDER HANGER DETAILS (2 OF 3)		DRAWING NO. 70235

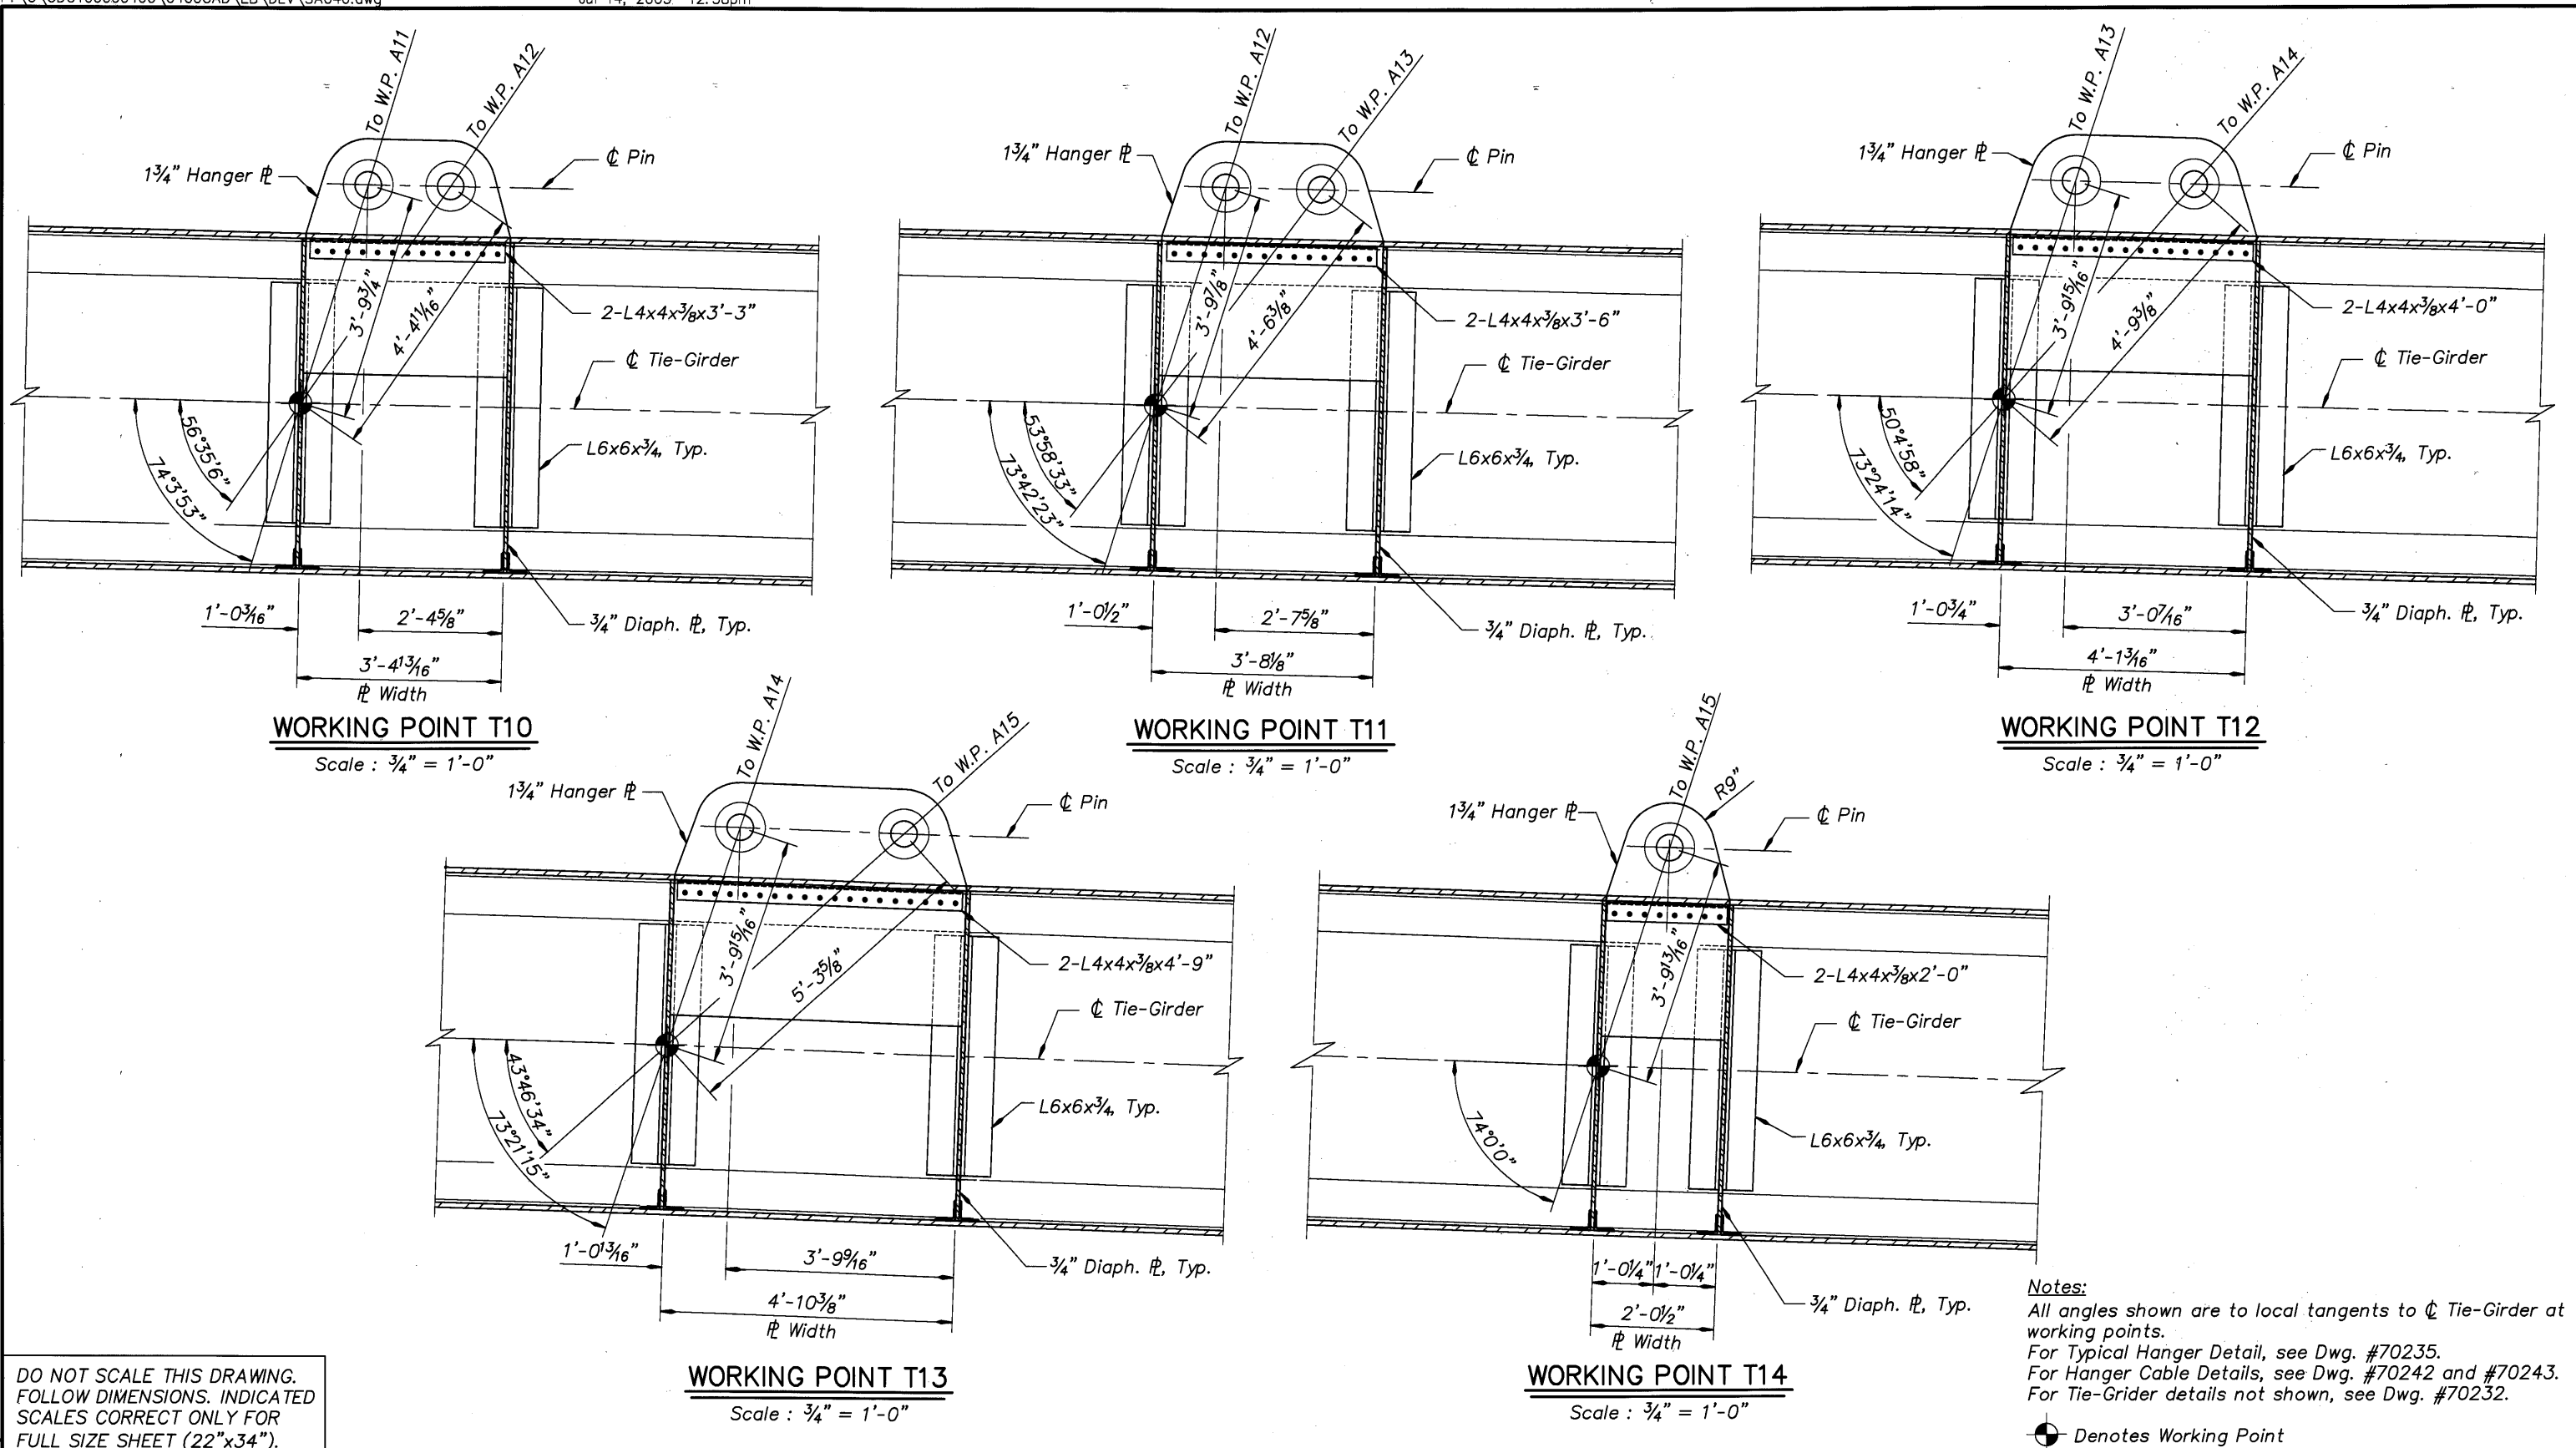

**WORKING POINT T10**

Scale : 3/4" = 1'-0"

**WORKING POINT T11**

Scale : 3/4" = 1'-0"

**WORKING POINT T12**

Scale : 3/4" = 1'-0"

**WORKING POINT T13**

Scale : 3/4" = 1'-0"

**WORKING POINT T14**

Scale : 3/4" = 1'-0"

**Notes:**  
 All angles shown are to local tangents to  $\phi$  Tie-Girder at working points.  
 For Typical Hanger Detail, see Dwg. #70235.  
 For Hanger Cable Details, see Dwg. #70242 and #70243.  
 For Tie-Girder details not shown, see Dwg. #70232.

$\bullet$  Denotes Working Point

DO NOT SCALE THIS DRAWING. FOLLOW DIMENSIONS. INDICATED SCALES CORRECT ONLY FOR FULL SIZE SHEET (22"x34").

DATE	REVISION	BY
03/09	As-Constructed	TDF

DRAFTED: J. Patton  
 CHECKED: Shonn Mills  
 DESIGNED: Paul Greco

**REVIEWED**  
 REGISTERED PROFESSIONAL ENGINEER  
 74540 PE  
 OREGON  
 MARCH 09, 2005  
 KENT WILLIAM COUNTY, OR  
**DAVID EVANS AND ASSOCIATES INC.**  
 530 Center Street N.E., Suite 605  
 Salem Oregon 97301  
 Phone: 503.361.8635  
 EXPIRES: 12-31-05




CONNECTING COMMERCE AND COMMUNITY  
**MULTNOMAH COUNTY BRIDGES**  
 TRANSPORTATION DIVISION  
**OREGON DEPARTMENT OF TRANSPORTATION BRIDGE ENGINEERING SECTION**

BRIDGE NO.	20136
DATE	Sept. 2005
CALC. BOOK	

MULTNOMAH CHANNEL & PNWR ETC., SAUVIE ISLAND RD.  
**TIE GIRDER HANGER DETAILS (3 OF 3)**

SHEET	49
OF	173
DRAWING NO.	70236

DO NOT SCALE THIS DRAWING.  
FOLLOW DIMENSIONS. INDICATED  
SCALES CORRECT ONLY FOR  
FULL SIZE SHEET (22"x34").

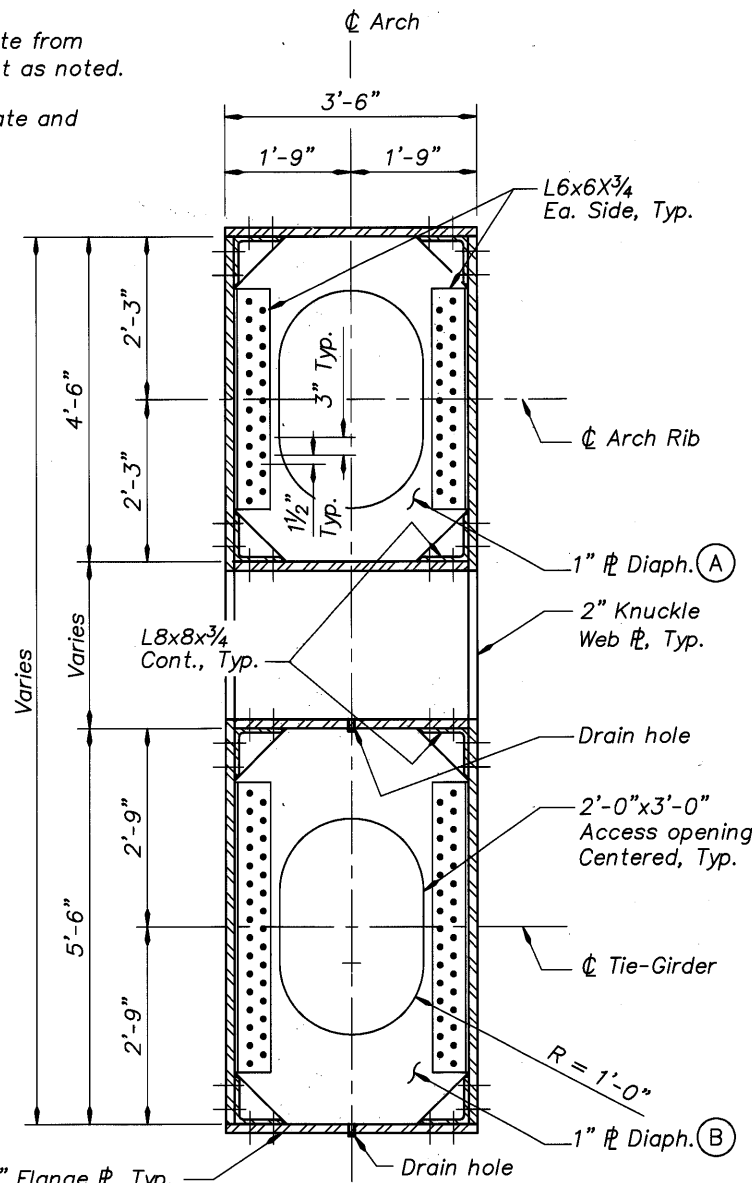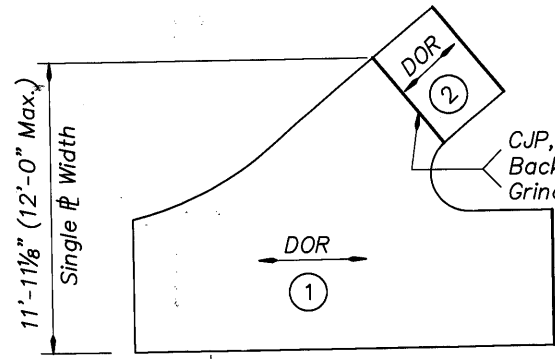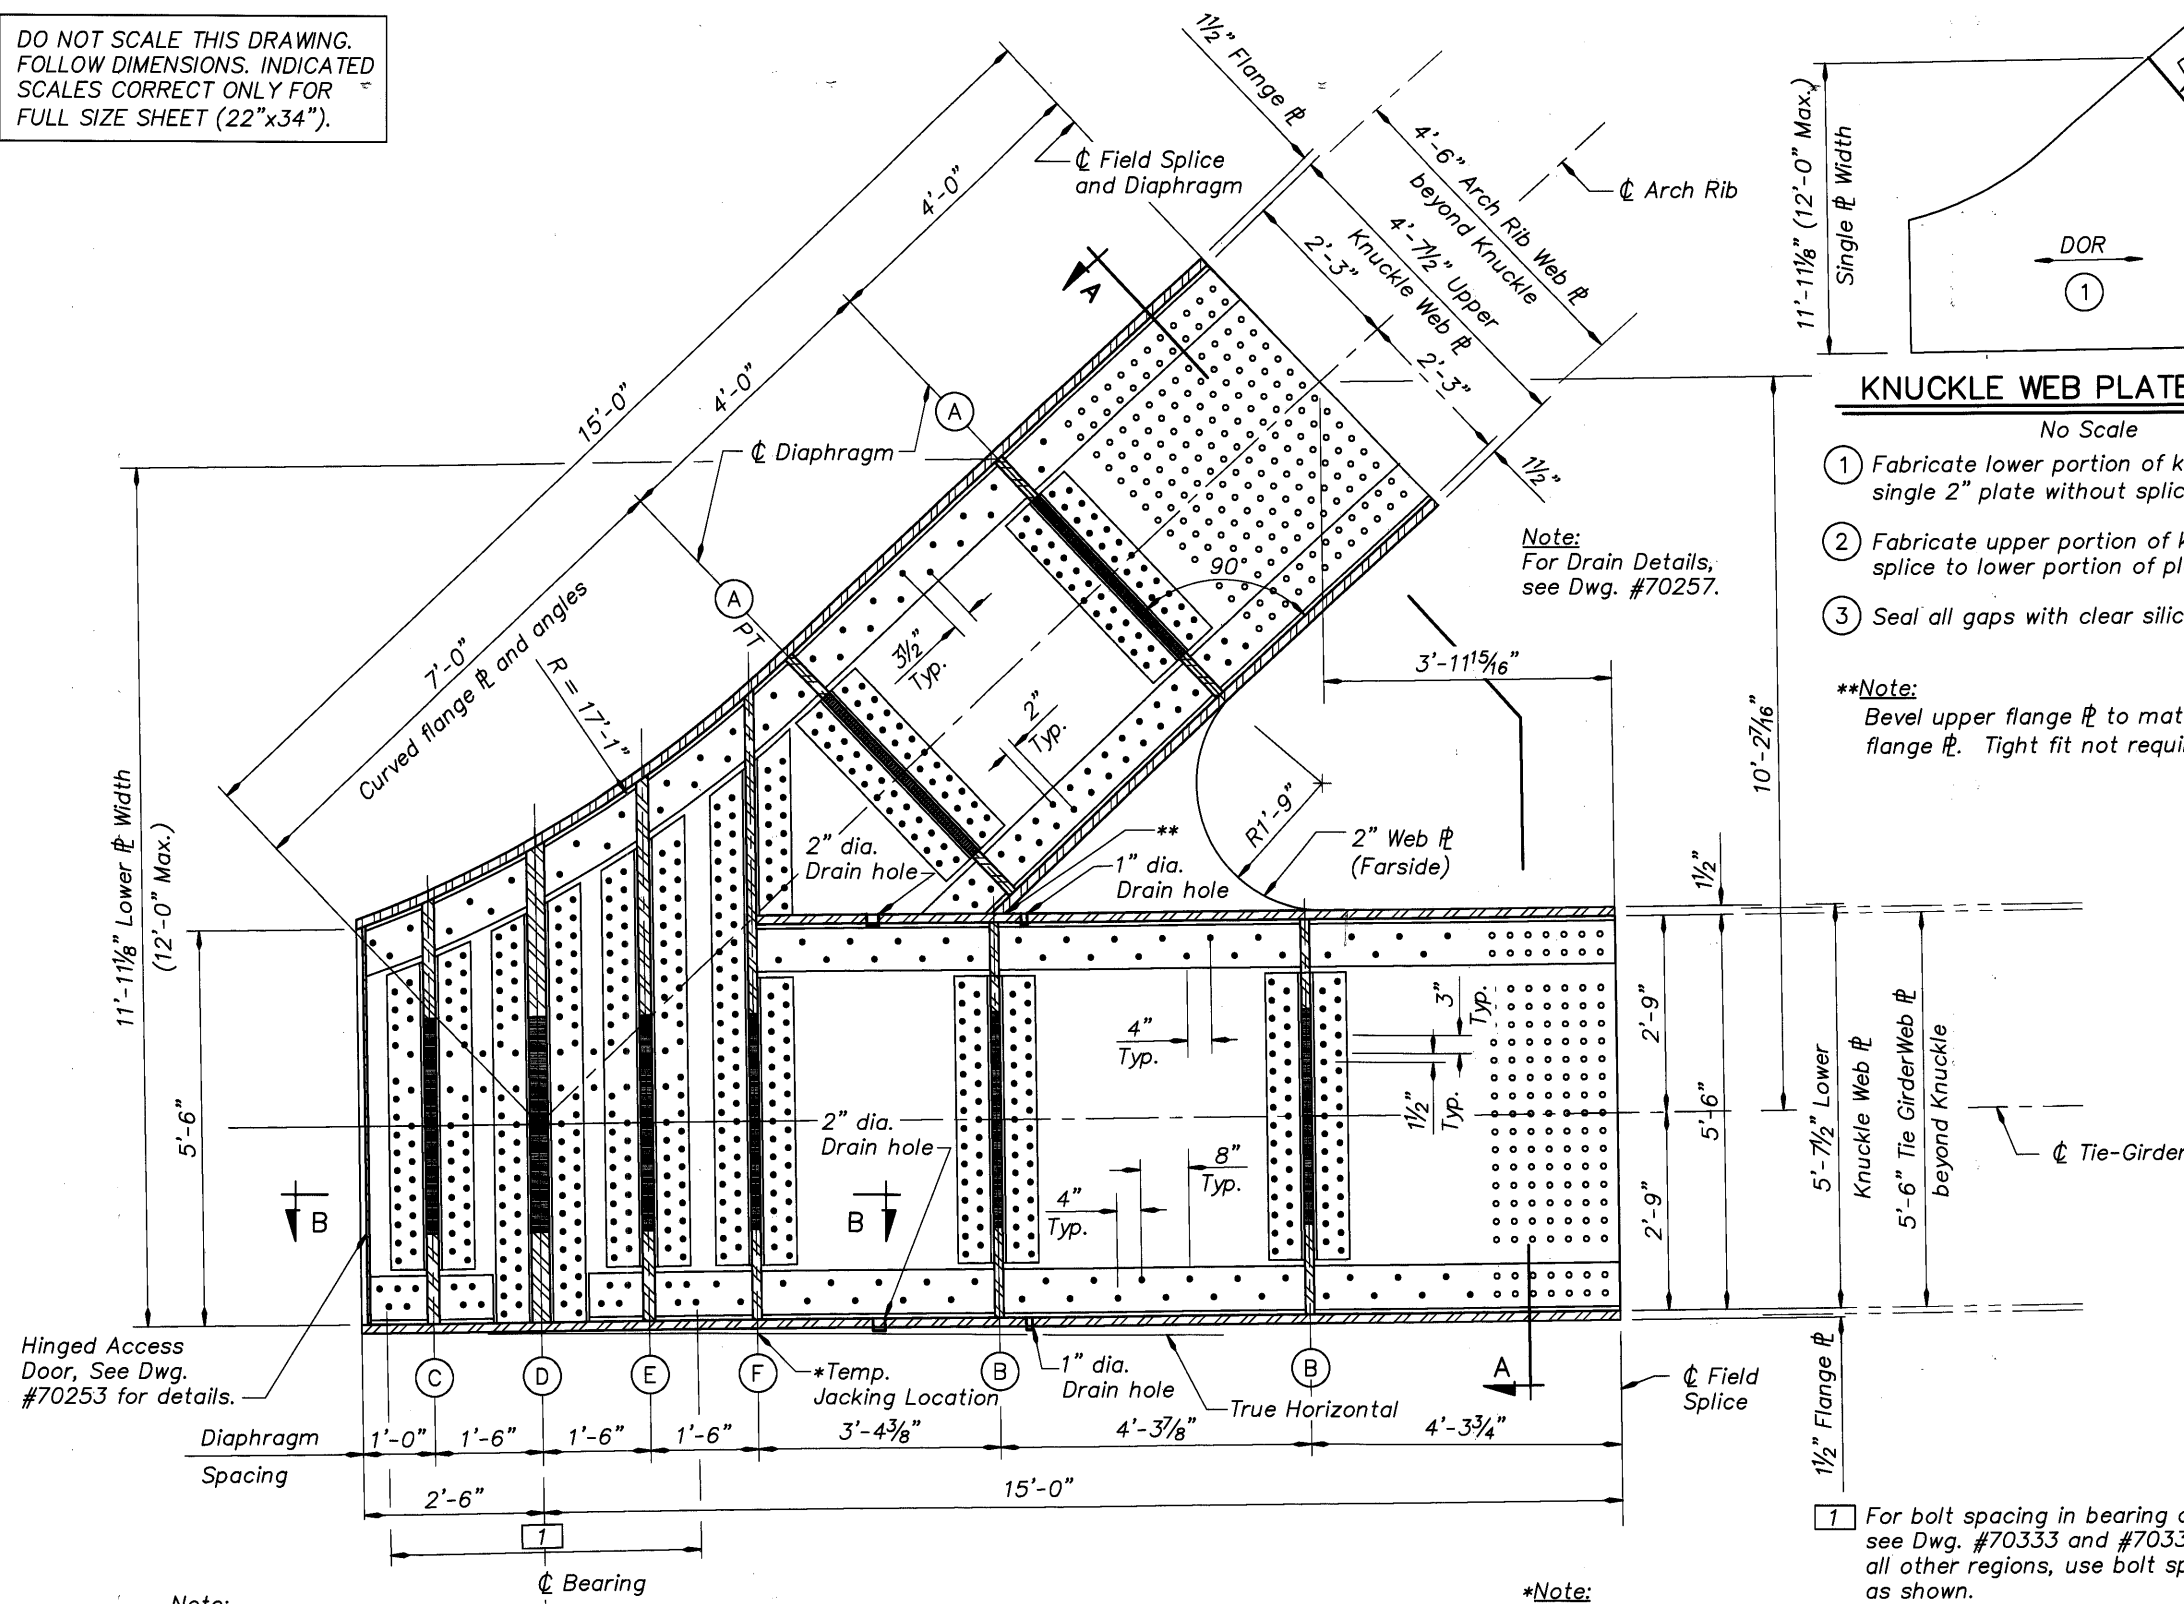

DATE	REVISION	BY
03/09	As-Constructed	TDF

DRAFTED: J. Patton  
CHECKED: Shonn Mills  
DESIGNED: Clifford Coulter

REVIEWED

REGISTERED PROFESSIONAL ENGINEER  
No. 74549, PE  
DAVID EVANS AND ASSOCIATES INC.  
530 Center Street N.E., Suite 605  
Salem Oregon 97301  
Phone: 503.361.8635  
EXPIRES: 12-31-05

CONNECTING COMMERCIAL AND COMMUNITY

MULTNOMAH COUNTY BRIDGES

TRANSPORTATION DIVISION


OREGON DEPARTMENT OF TRANSPORTATION  
BRIDGE ENGINEERING SECTION

BRIDGE NO.	20136
DATE	Sept. 2005
CALC. BOOK	

MULTNOMAH CHANNEL & PNWR ETC., SAUVIE ISLAND RD.


KNUCKLE DETAILS (1 OF 2)

SHEET 50 OF 173  
DRAWING NO. 70237

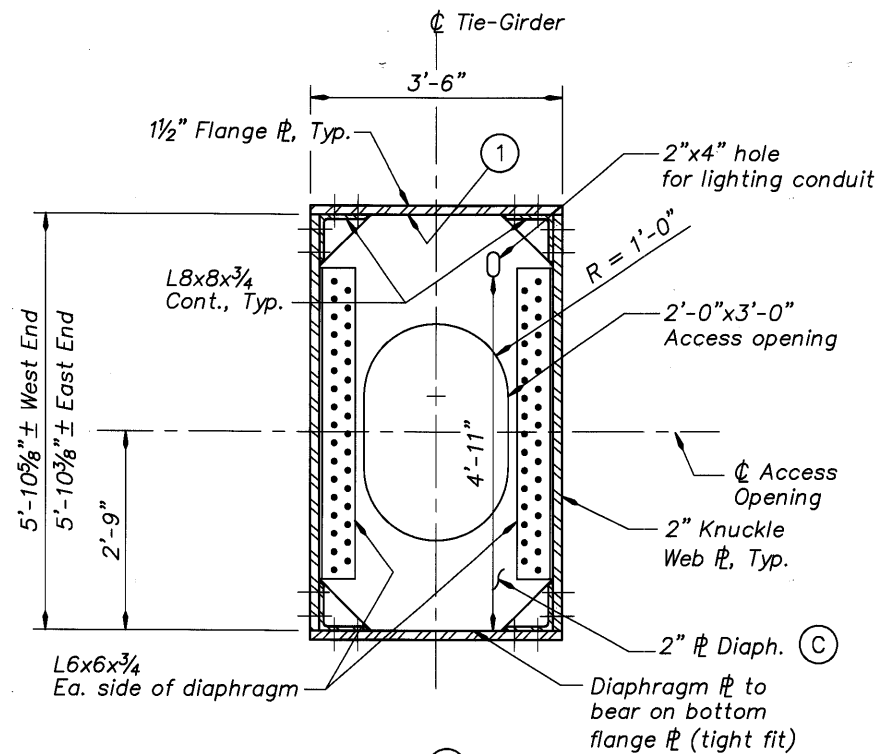

**DIAPHRAGM C ELEVATION**


Scale : 3/4" = 1'-0"

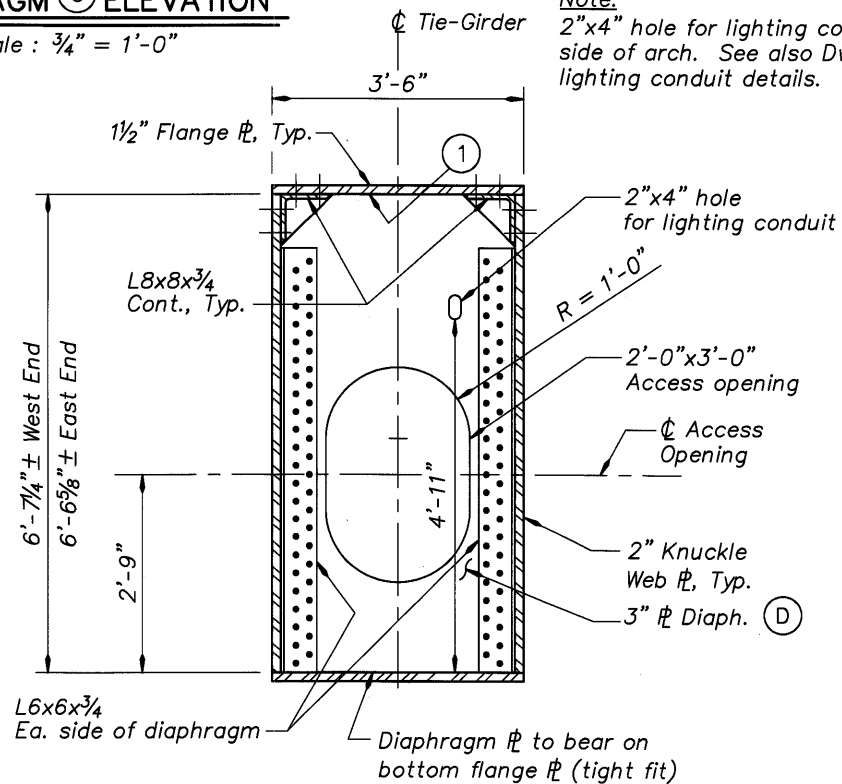

**DIAPHRAGM D ELEVATION**

Scale : 3/4" = 1'-0"


(Floorbeam connections omitted - see Dwg. #70247, #70249 & #70250)

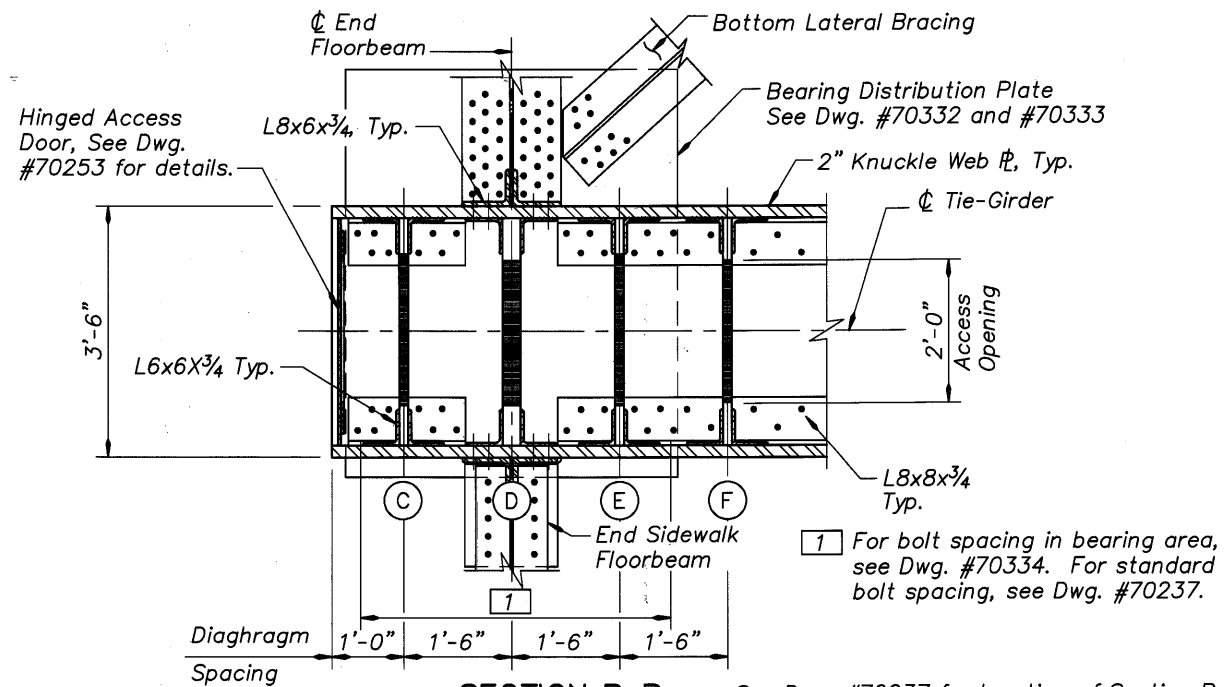

**SECTION B-B**


Scale : 3/4" = 1'-0"

See Dwg. #70237 for location of Section B-B.

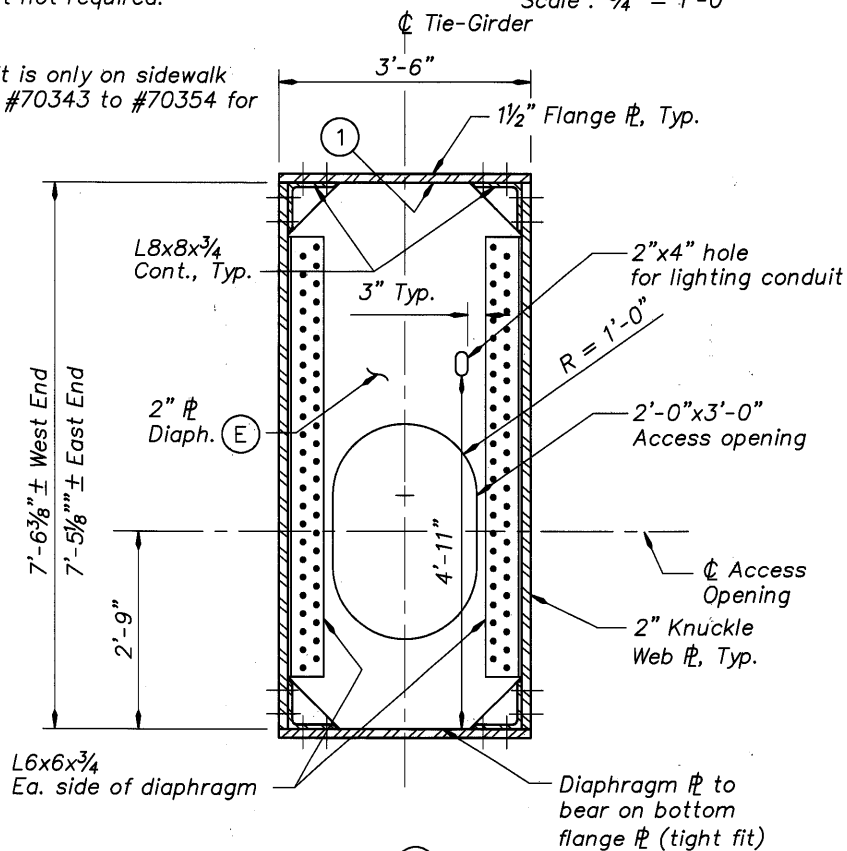

**DIAPHRAGM E ELEVATION**

Scale : 3/4" = 1'-0"

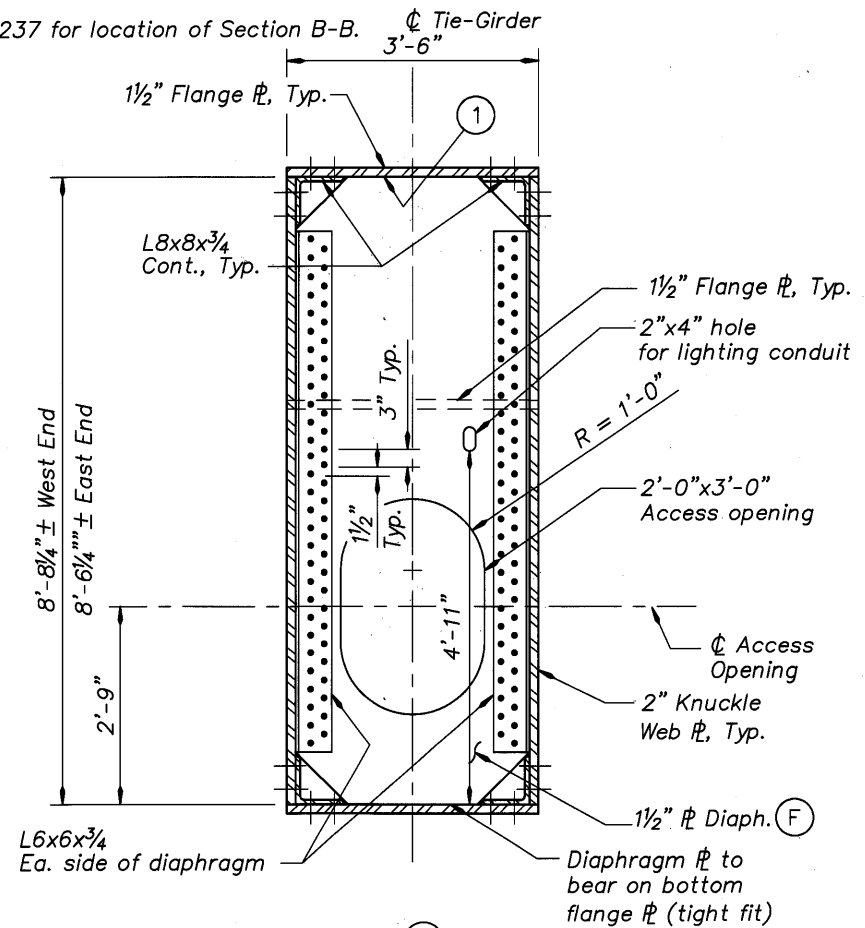

**DIAPHRAGM F ELEVATION**

Scale : 3/4" = 1'-0"

1 Note: Bevel top edge of diaphragm to match local tangent to curved top flange. Tight fit not required.

Note: 2"x4" hole for lighting conduit is only on sidewalk side of arch. See also Dwg. #70343 to #70354 for lighting conduit details.

1 For bolt spacing in bearing area, see Dwg. #70334. For standard bolt spacing, see Dwg. #70237.

DO NOT SCALE THIS DRAWING. FOLLOW DIMENSIONS. INDICATED SCALES CORRECT ONLY FOR FULL SIZE SHEET (22"x34").

DATE	REVISION	BY
03/09	As-Constructed	TDF

DRAFTED: J. Patton  
 CHECKED: Shonn Mills  
 DESIGNED: Clifford Coulter

**REVIEWED**

**DAVID EVANS AND ASSOCIATES INC.**  
 530 Center Street N.E., Suite 605  
 Salem Oregon 97301  
 Phone: 503.361.8635  
 EXPIRES: 12-31-05

CONNECTING COMMERCE AND COMMUNITY

**MULTNOMAH COUNTY BRIDGES**

TRANSPORTATION DIVISION






**OREGON DEPARTMENT OF TRANSPORTATION BRIDGE ENGINEERING SECTION**

BRIDGE NO. 20136  
 DATE Sept. 2005  
 CALC. BOOK

MULTNOMAH CHANNEL & PNWR ETC., SAUVIE ISLAND RD.

KNUCKLE DETAILS (2 OF 2)

SHEET 51 OF 173  
 DRAWING NO. 70238

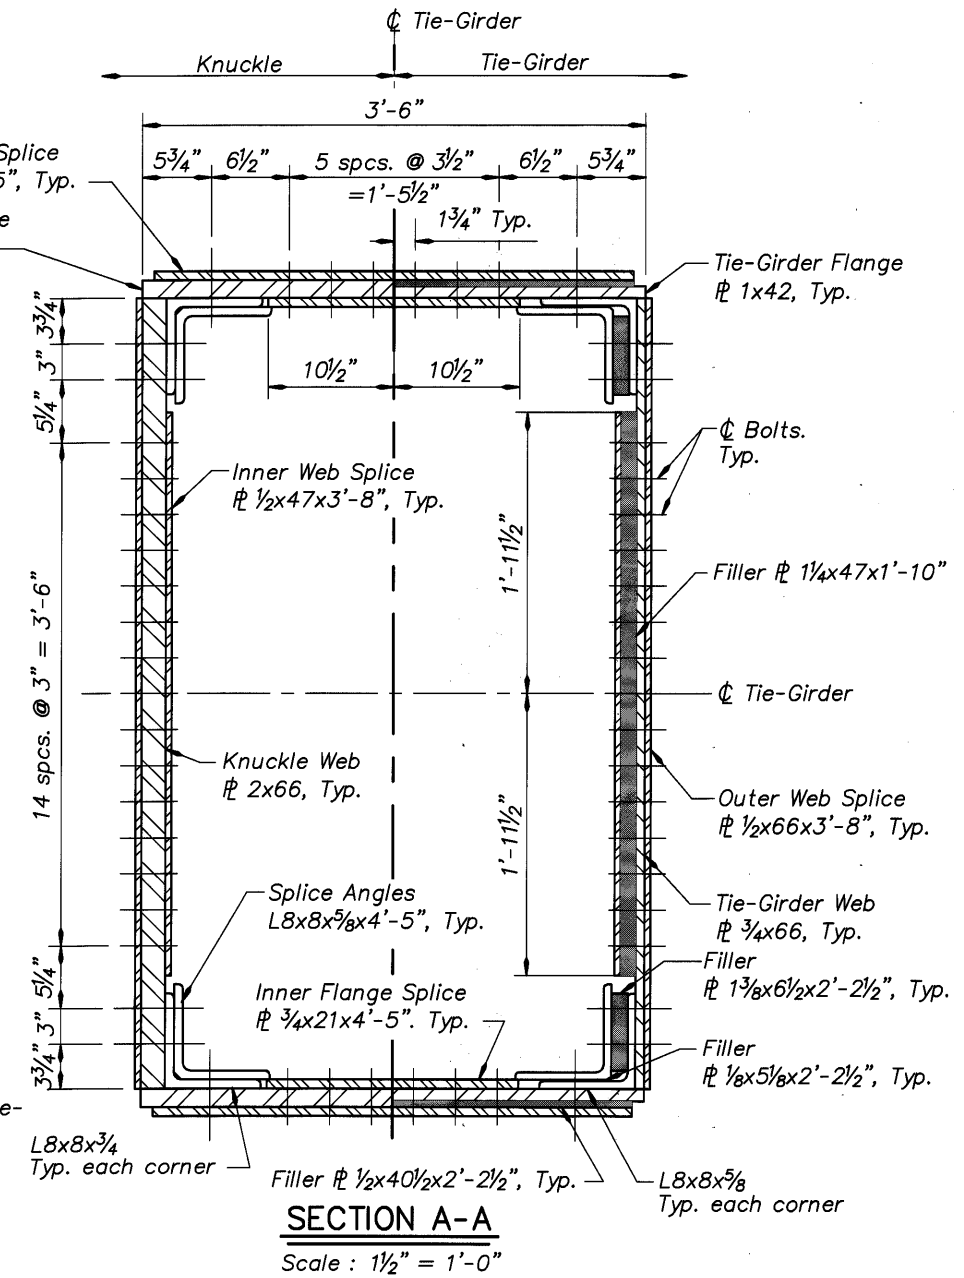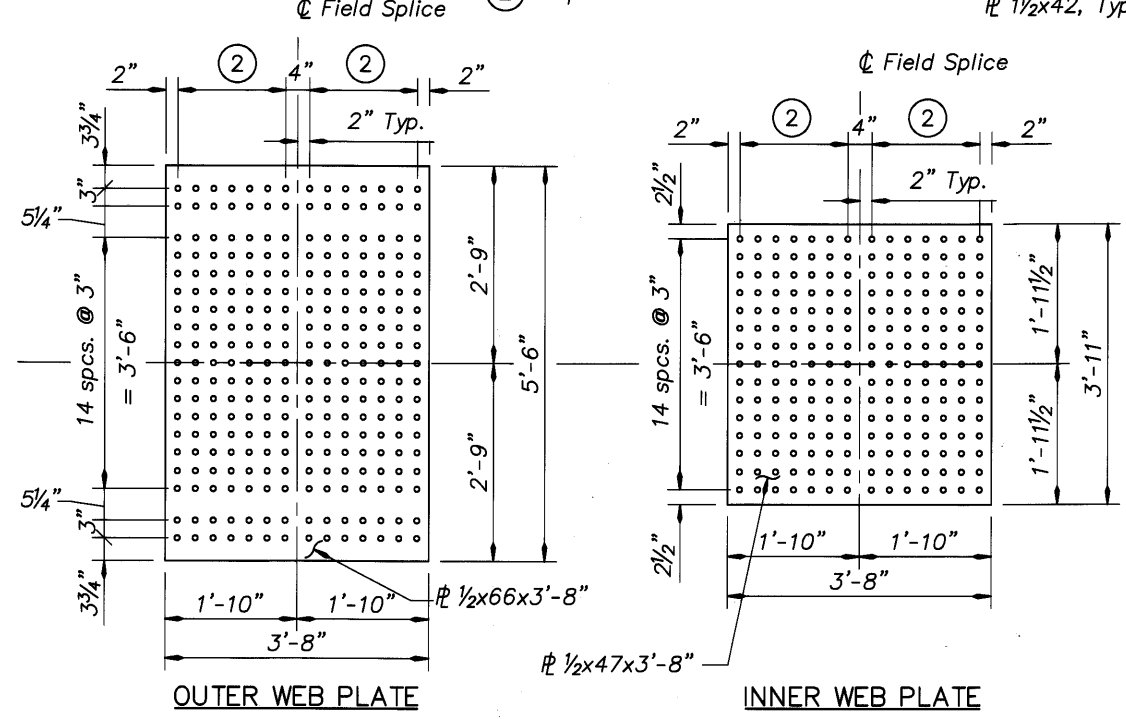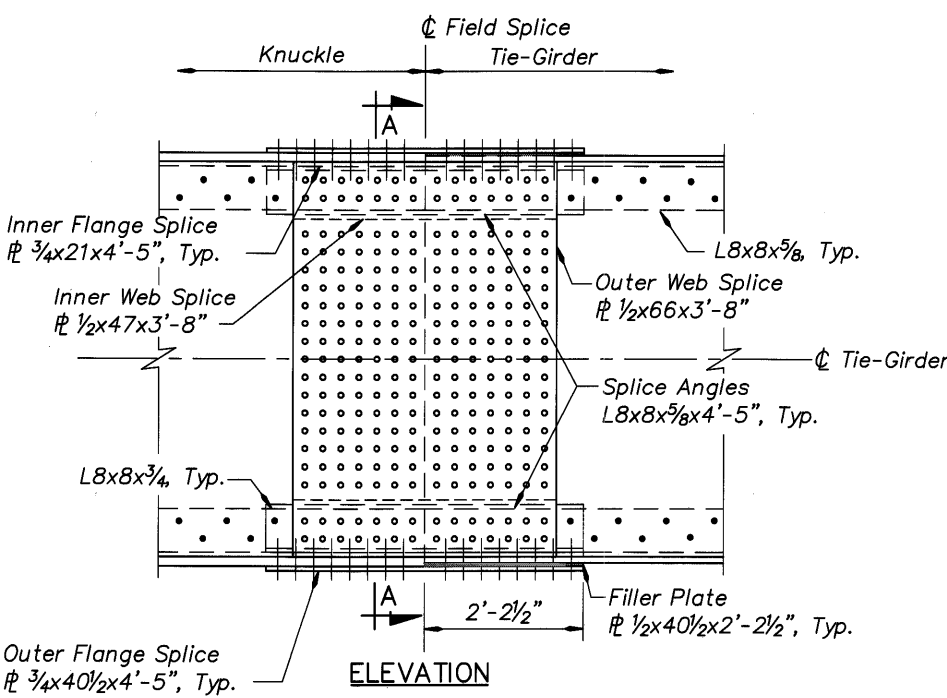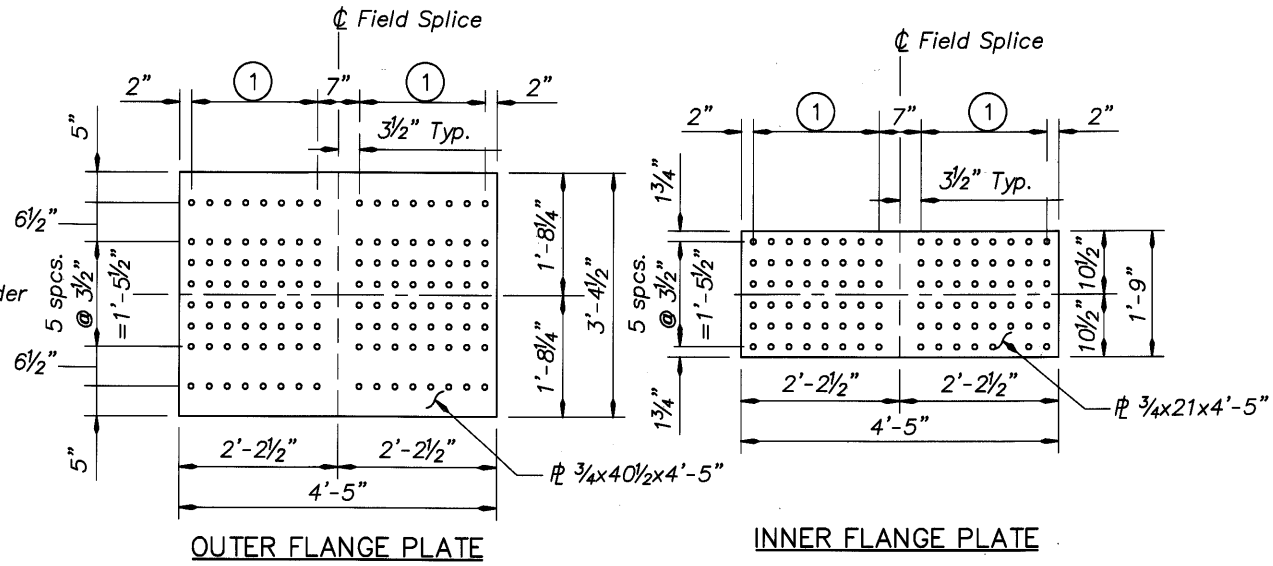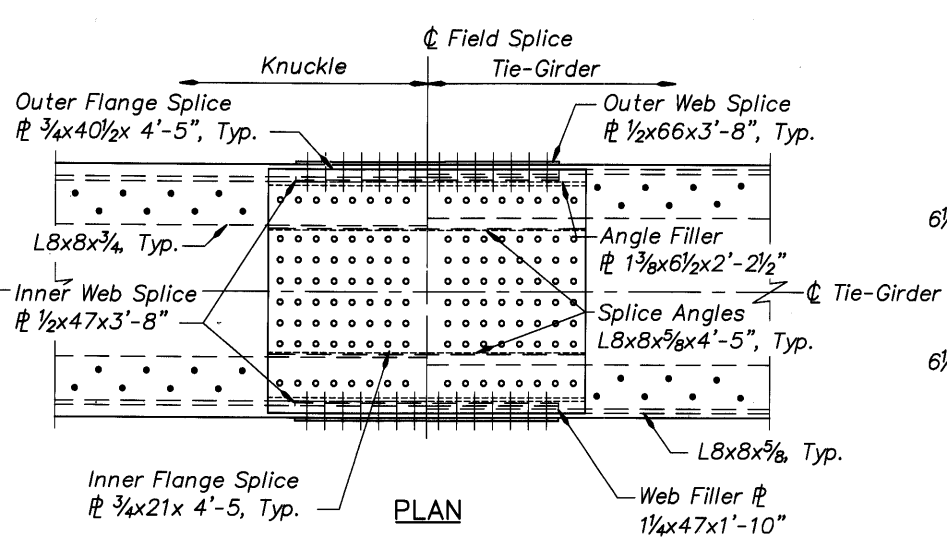

**KNUCKLE/TIE-GIRDER SPLICE DETAILS**  
 Scale: 3/4" = 1'-0"

- Note:**
1. Tie-Girder/Knuckle splice is shown. See Dwg. #70219, #70220 and #70237 for specific locations. For Typical Tie-Girder splice, see Dwg. #70233.
  2. All bolts in splice are 7/8" dia. High Strength, Type 3 (Weathering) bolts designed to meet slip-critical criteria. See General Notes for further information.
  3. For Angle Splice Details, see Dwg. #70241.
  4. Caulk plate interfaces. See General Notes.

DO NOT SCALE THIS DRAWING. FOLLOW DIMENSIONS. INDICATED SCALES CORRECT ONLY FOR FULL SIZE SHEET (22"x34").

DATE	REVISION	BY
08/05	Added Note 4, removed sealant note	JBT
03/09	As-Constructed	TDF

DRAFTED: J. Patton  
 CHECKED: Oliver Mueller  
 DESIGNED: Eric Rau

REVIEWED

**DAVID EVANS AND ASSOCIATES, INC.**  
 530 Center Street N.E., Suite 605  
 Salem Oregon 97301  
 Phone: 503.361.9635

CONNECTING COMMERCIAL AND COMMUNITY

**MULTNOMAH COUNTY BRIDGES**

TRANSPORTATION DIVISION




**OREGON DEPARTMENT OF TRANSPORTATION BRIDGE ENGINEERING SECTION**

BRIDGE NO.	20136
DATE	Sept. 2005
CALC. BOOK	




MULTNOMAH CHANNEL & PNWR ETC., SAUVIE ISLAND RD.

**KNUCKLE SPLICE DETAILS (1 OF 3)**

SHEET 52 OF 173  
 DRAWING NO. 70239

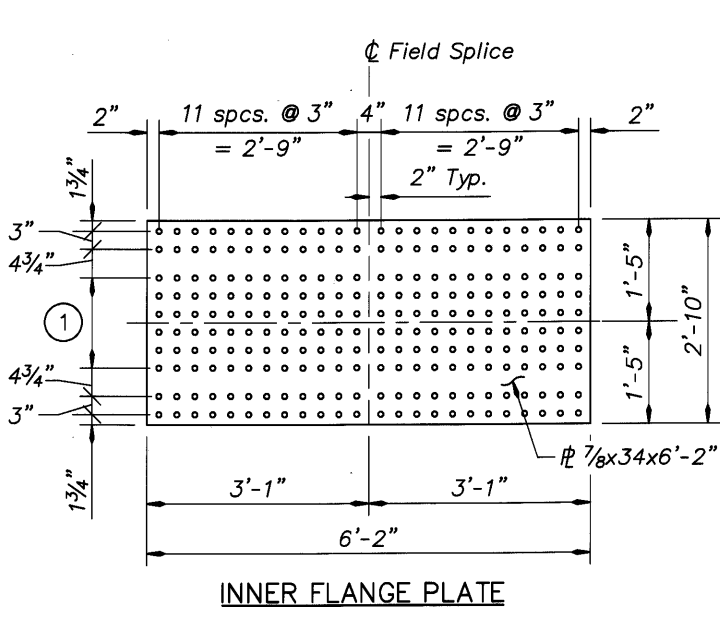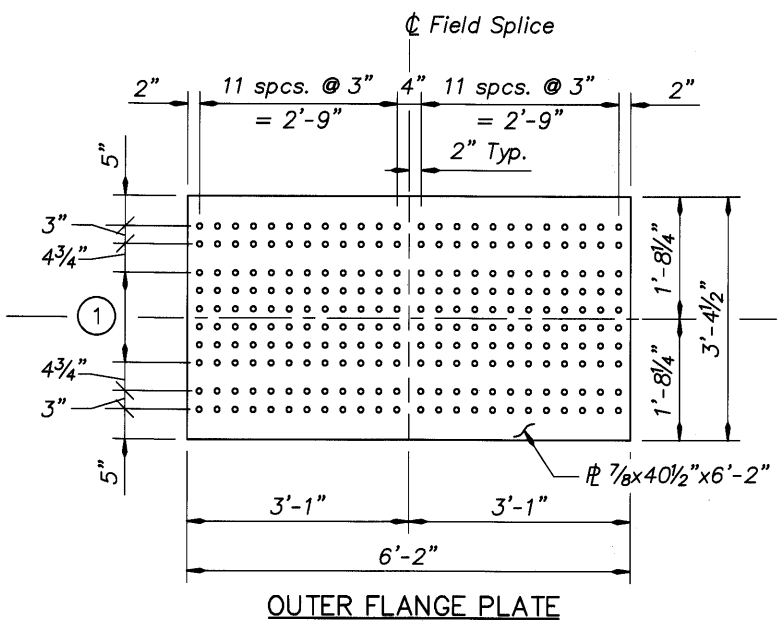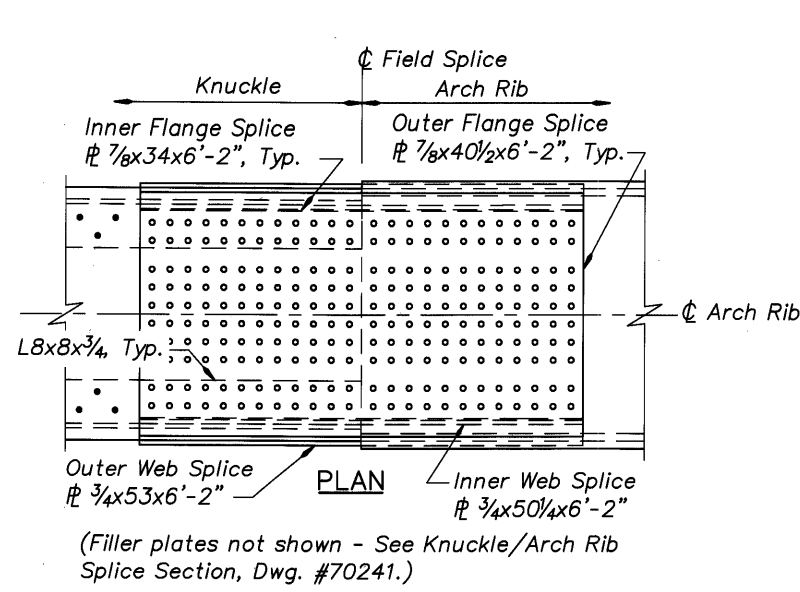

① 5 spcs. @ 3" = 1'-3"

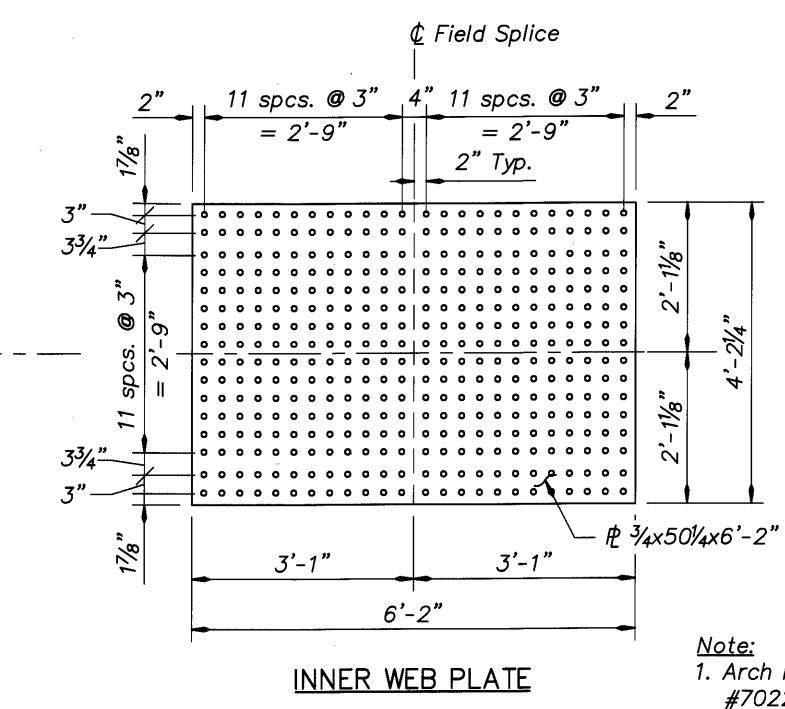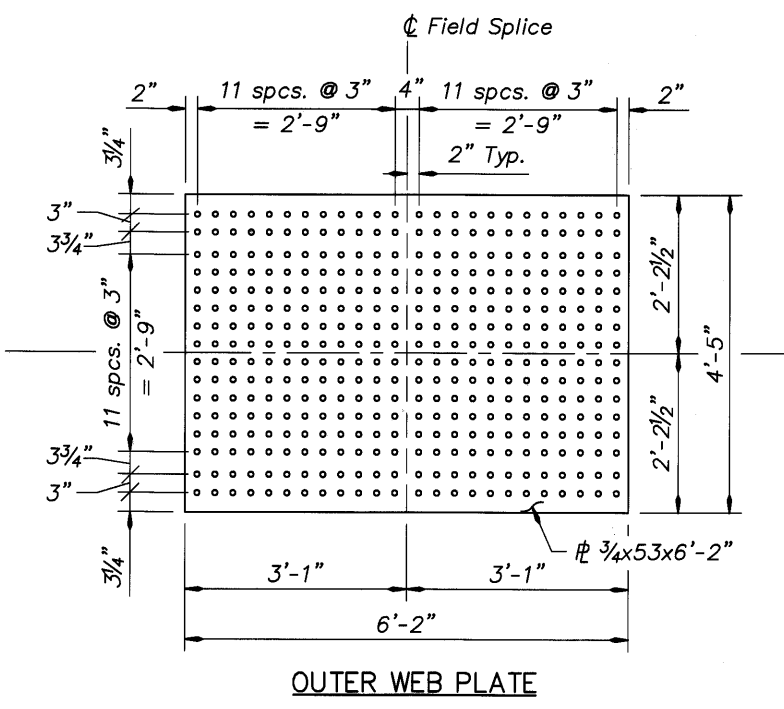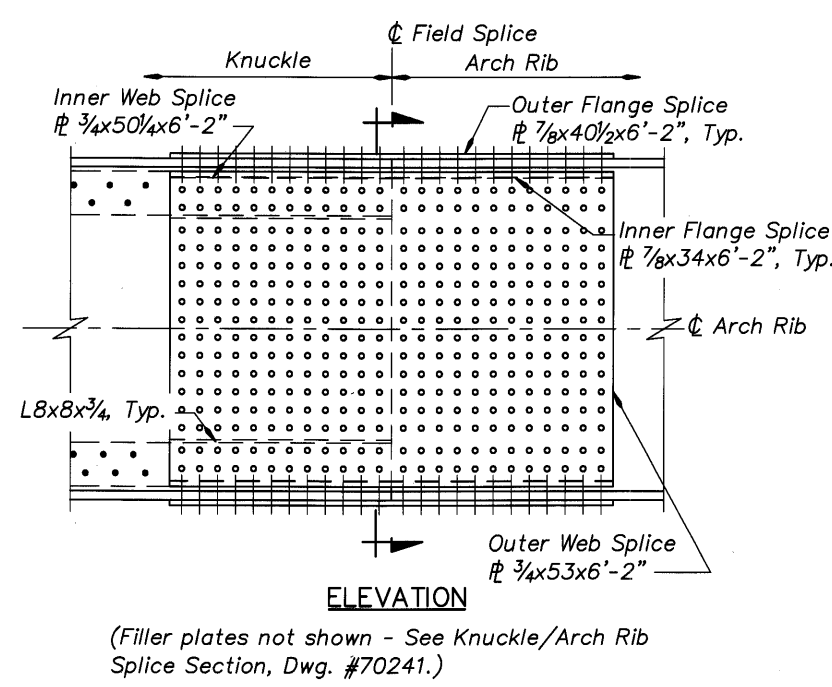

- Note:**
1. Arch Rib/Knuckle splice is shown. See Dwg. #70219, #70220 and #70237 for specific locations. For Typical Arch Rib splice, see Dwg. #70229.
  2. For Knuckle/Arch Rib Splice Section, see Dwg. #70241.
  3. All bolts in splice are 7/8" dia. High Strength, Type 3 (Weathering) bolts designed to meet slip-critical criteria. See General Notes for further information.
  4. Caulk plate interfaces. See General Notes.


**KNUCKLE/ARCH RIB SPLICE DETAILS**

Scale : 3/4" = 1'-0"

DO NOT SCALE THIS DRAWING.  
FOLLOW DIMENSIONS. INDICATED  
SCALES CORRECT ONLY FOR  
FULL SIZE SHEET (22"x34").


DATE 08/05 03/09	REVISION Added Note 4 As-Constructed	BY JBT TDF	DRAFTED: J. Patton CHECKED: Oliver Mueller DESIGNED: Eric Rau	REVIEWED  DAVID EVANS AND ASSOCIATES, INC. 530 Center Street N.E., Suite 605 Salem Oregon 97301 Phone: 503.361.8635 EXPIRES: 6-30-06	CONNECTING COMMERCE AND COMMUNITY  MULTNOMAH COUNTY BRIDGES TRANSPORTATION DIVISION  OREGON DEPARTMENT OF TRANSPORTATION BRIDGE ENGINEERING SECTION	BRIDGE NO. 20136	MULTNOMAH CHANNEL & PNWR ETC., SAUVIE ISLAND RD.	SHEET 53 OF 173.
						DATE Sept. 2005		CALC. BOOK

KNUCKLE SPLICE DETAILS (2 OF 3)

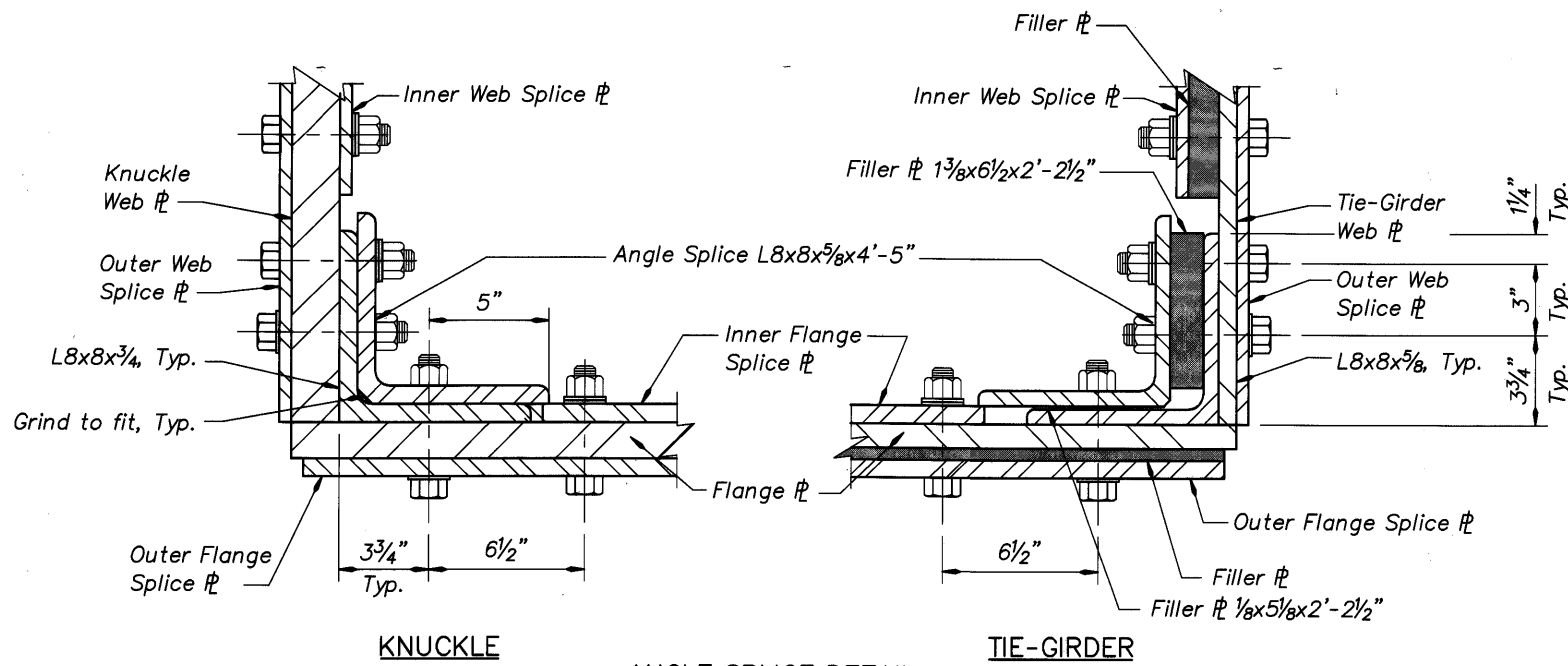

- Notes:**
1. Bolts and washers are shown for schematic purposes only.
  2. Actual bolt length and number of washers must be determined to ensure threads excluded condition.
  3. Washers must be provided under turning element (head or nut).
  4. Caulk plate interfaces. See General Notes.


**ANGLE SPLICE DETAIL**  
Scale : 3" = 1'-0"

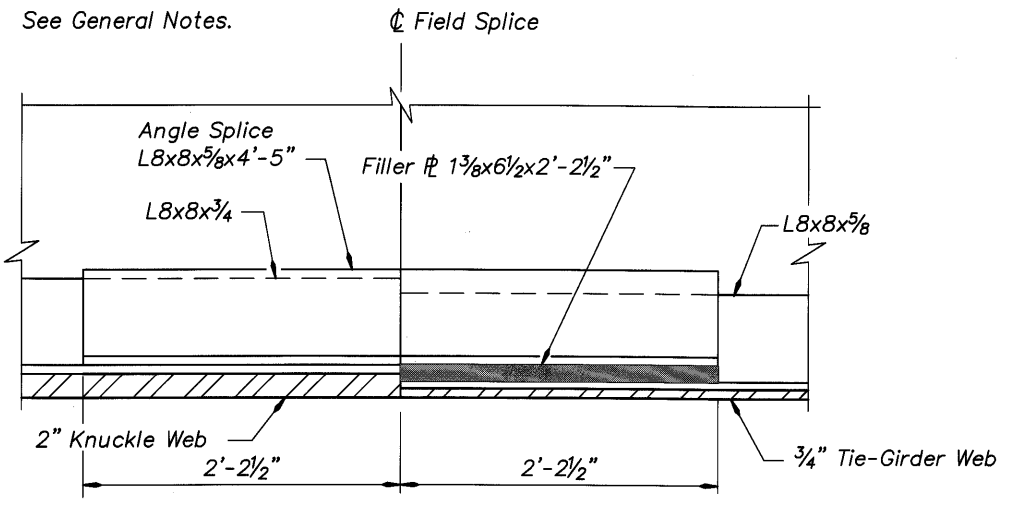

**ANGLE TERMINATION DETAIL - PLAN**  
Scale : 1 1/2" = 1'-0"  
(Splice plates and bolts not shown.)

**KNUCKLE/TIE-GIRDER ANGLE SPLICE DETAILS**

Details apply only to Knuckle/Tie-girder splice.  
See Dwg. #70239 for remaining Knuckle/Tie-girder splice details.

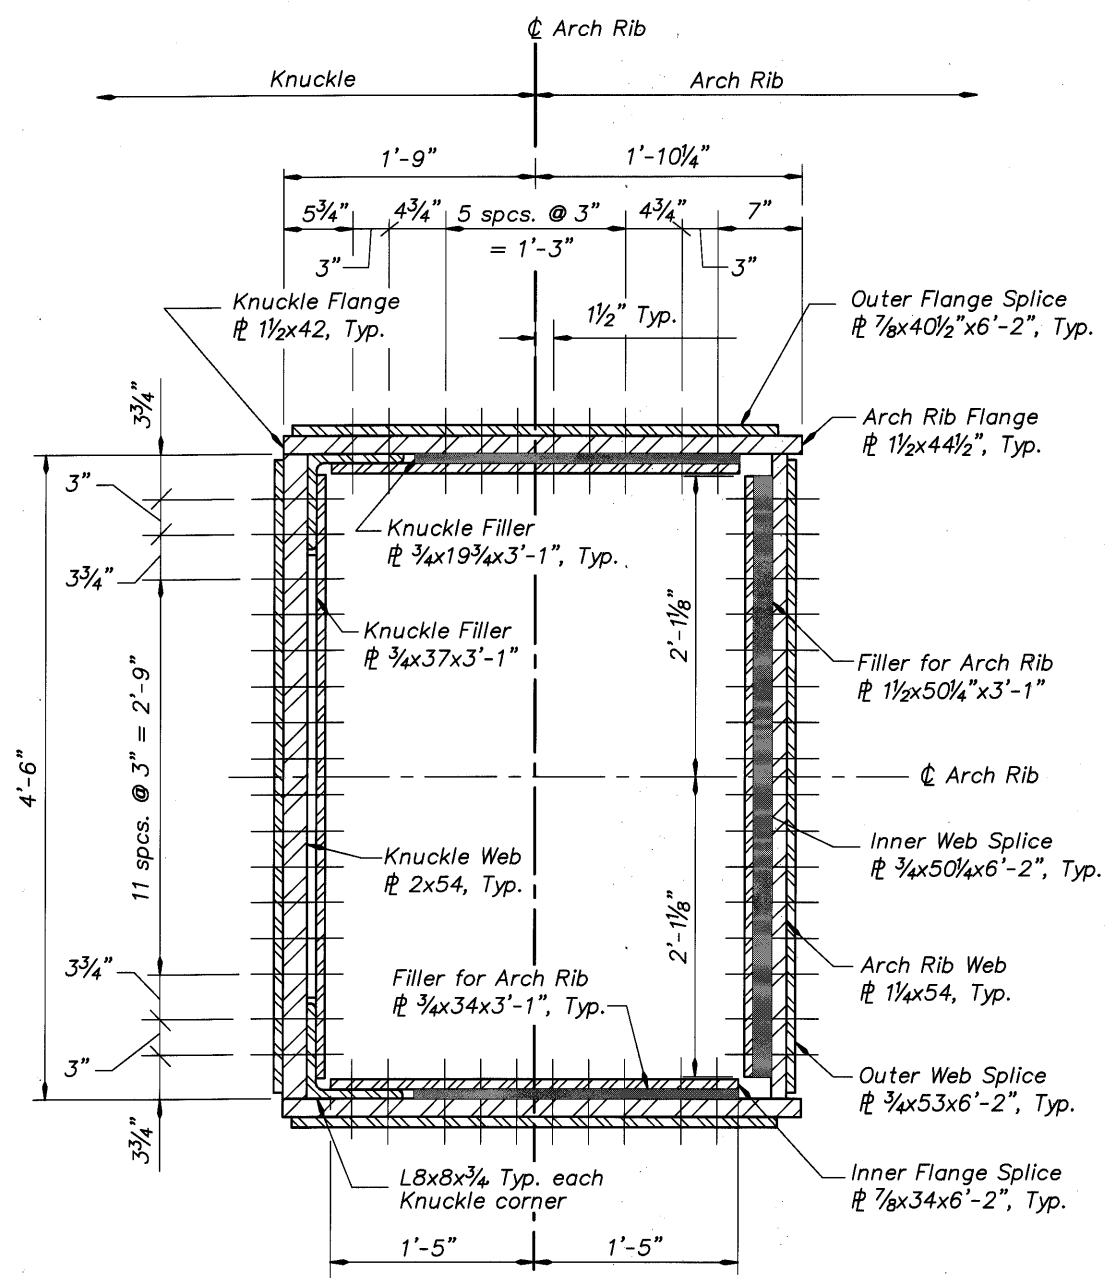

**KNUCKLE/ARCH RIB SPLICE SECTION**

Scale : 1 1/2" = 1'-0"  
For remaining Knuckle/Arch Rib splice details, see Dwg. #70240.

Xref: Odschbr.dwg 00070460\_Akn\_SP\_01.dwg

DATE	REVISION	BY
08/05	Added Note 4, removed sealant note	JBT
03/09	As-Constructed	TDF

**J. Patton**  
DRAFTED:  
**Oliver Mueller**  
CHECKED:  
**Eric Rau**  
DESIGNED:

**REVIEWED**

**DAVID EVANS AND ASSOCIATES INC.**  
530 Center Street N.E., Suite 605  
Salem Oregon 97301  
Phone: 503.361.8635

CONNECTING COMMERCE AND COMMUNITY

**MULTNOMAH COUNTY BRIDGES**

TRANSPORTATION DIVISION

**OREGON DEPARTMENT OF TRANSPORTATION BRIDGE ENGINEERING SECTION**

**BRIDGE NO.**  
20136

**DATE**  
Sept. 2005

**CALC. BOOK**


MULTNOMAH CHANNEL & PNWR ETC., SAUVIE ISLAND RD.

**KNUCKLE SPLICE DETAILS (3 OF 3)**

**SHEET**  
54  
**OF**  
173

**DRAWING NO.**  
70241



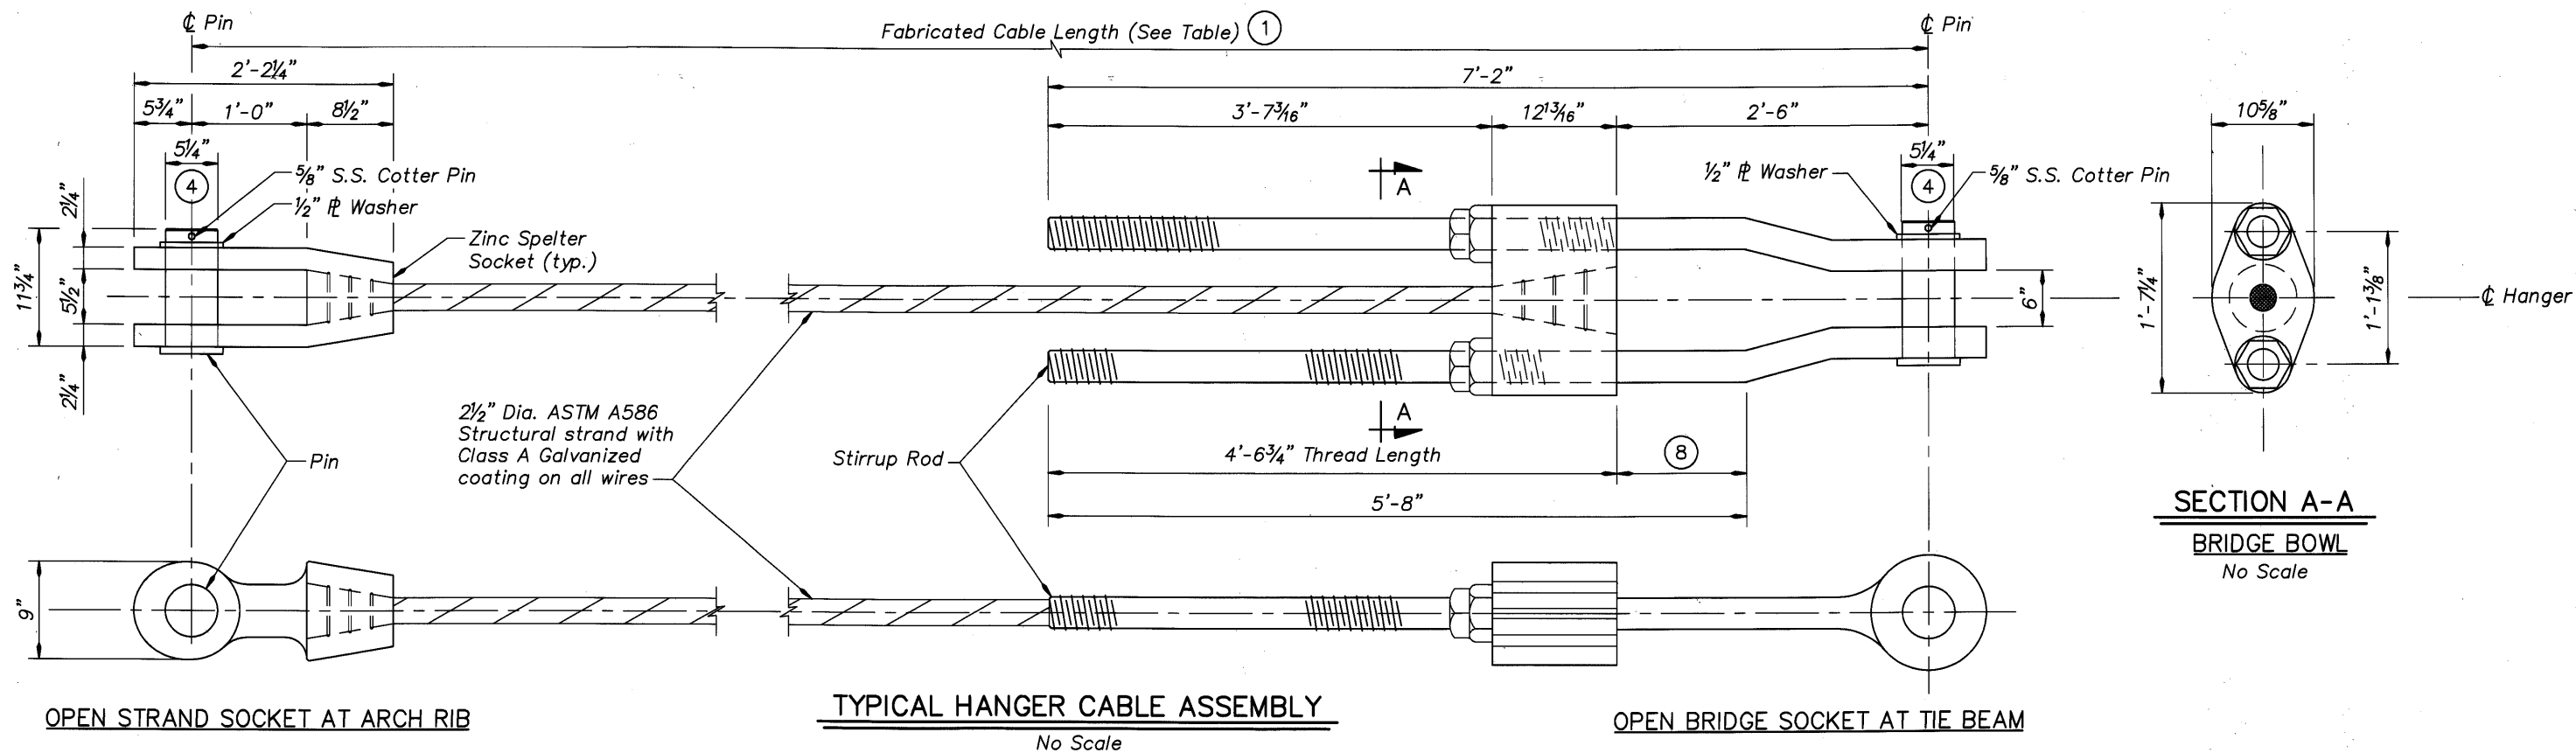

OPEN STRAND SOCKET AT ARCH RIB

TYPICAL HANGER CABLE ASSEMBLY

No Scale

OPEN BRIDGE SOCKET AT TIE BEAM

Notes:

- ① Cable length in undeformed arch as fabricated, prior to initial dead load deformation, at zero cable tension, measured to center of socket pins. These cable lengths are provided for information only, and must be verified by the Contractor prior to cable fabrication.
- ② Total number of cable assemblies of this length - includes both arches.
- ③ Open strand and open bridge sockets shall be designed by the manufacturer to meet or exceed the 2 1/2" dia. strand minimum breaking strength. All socket cross-section dimensions shown are for information only and shall be verified by the manufacturer. Overall socket dimensions and shape shall substantially conform to these details.
- ④ Pin O.D. shall be machined to 5 3/16" prior to galvanizing. Pin hole I.D. shall be line bored to 5 1/32" prior to galvanizing.
- ⑤ All castings shall be cast steel conforming to ASTM A148 Grade 90-60. All steel forgings shall conform to ASTM A668 Class F (G). Plate washers shall be A36 steel. Sockets, washers and pins shall be galvanized per ASTM A153.
- ⑥ 5/8" dia. cotter pins shall conform to the requirements of ASTM A276, Type 304, or equal, with minimum yield strength of 35.0 ksi.
- ⑦ All final tension adjustments shall be performed at the lower open bridge socket. Calibrated center-hole hydraulic jacks shall be employed simultaneously to tension against both threaded anchor rods. Refer to Jacking Detail on Dwg. #70243.
- ⑧ Provide 12" future adjustment of bridge bowl towards pin.
- ⑨ Unfactored dead load and live load plus impact cable forces in completed arch structure.
- ⑩ Jacking equipment and procedure are the contractor's responsibility. Prior to jacking any cables, submit proposed equipment details and jacking procedure for review.

Xref: Odobab.dwg, ODOT0460\_AD\_01.dwg


DATE 03/09	REVISION As-Constructed	BY TDF	DRAFTED: J. Patton	REVIEWED 		BRIDGE NO. 20136	MULTNOMAH COUNTY TRANSPORTATION DIVISION	SHEET 55 OF 173
			CHECKED: Oliver Mueller					
			DESIGNED: Paul Greco	DAVID EVANS AND ASSOCIATES INC. 530 Center Street N.E., Suite 605 Salem Oregon 97301 Phone: 503.361.8635		CALC. BOOK	OREGON DEPARTMENT OF TRANSPORTATION BRIDGE ENGINEERING SECTION	DRAWING NO. 70242
							HANGER CABLE DETAILS (1 of 2)	

**Note:**

All pin holes shall be line bored to 5 1/32" dia. after welding pin spacer plates. Holes shall be smooth, straight, and perpendicular to the axis of the hanger plate. Paint the hanger plate pin holes, pin hole circular spacer plates, and two inches past the outer edge of spacer plates. See General Notes, Dwg. #70191. Apply corrosion-inhibiting grease such as Eureka Chemical Co. "Fluid Film" gel or approved equal to pin hole surfaces, after painting.




~~Cut projecting rod after final adjustment.~~  
~~Apply cold galvanizing compound to cut end.~~

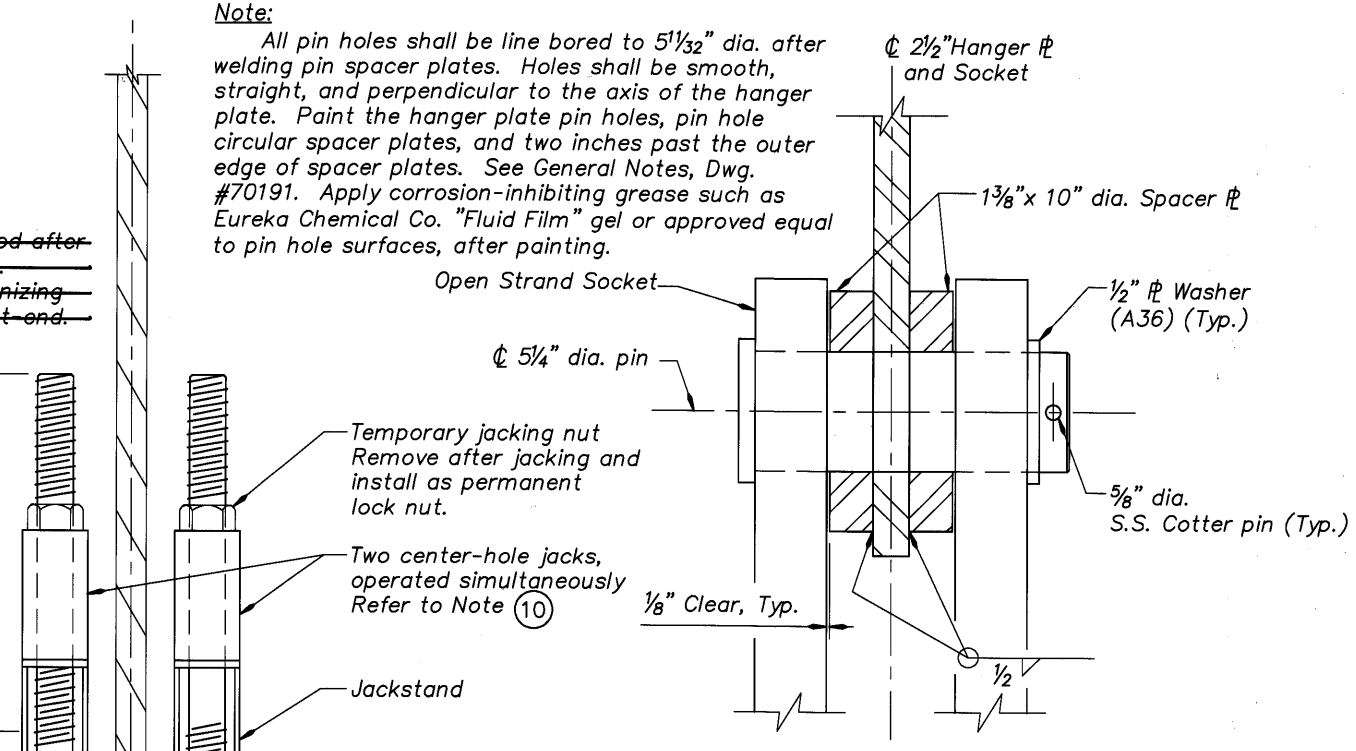

**HANGER PLATE DETAIL AT ARCH RIB**

No Scale

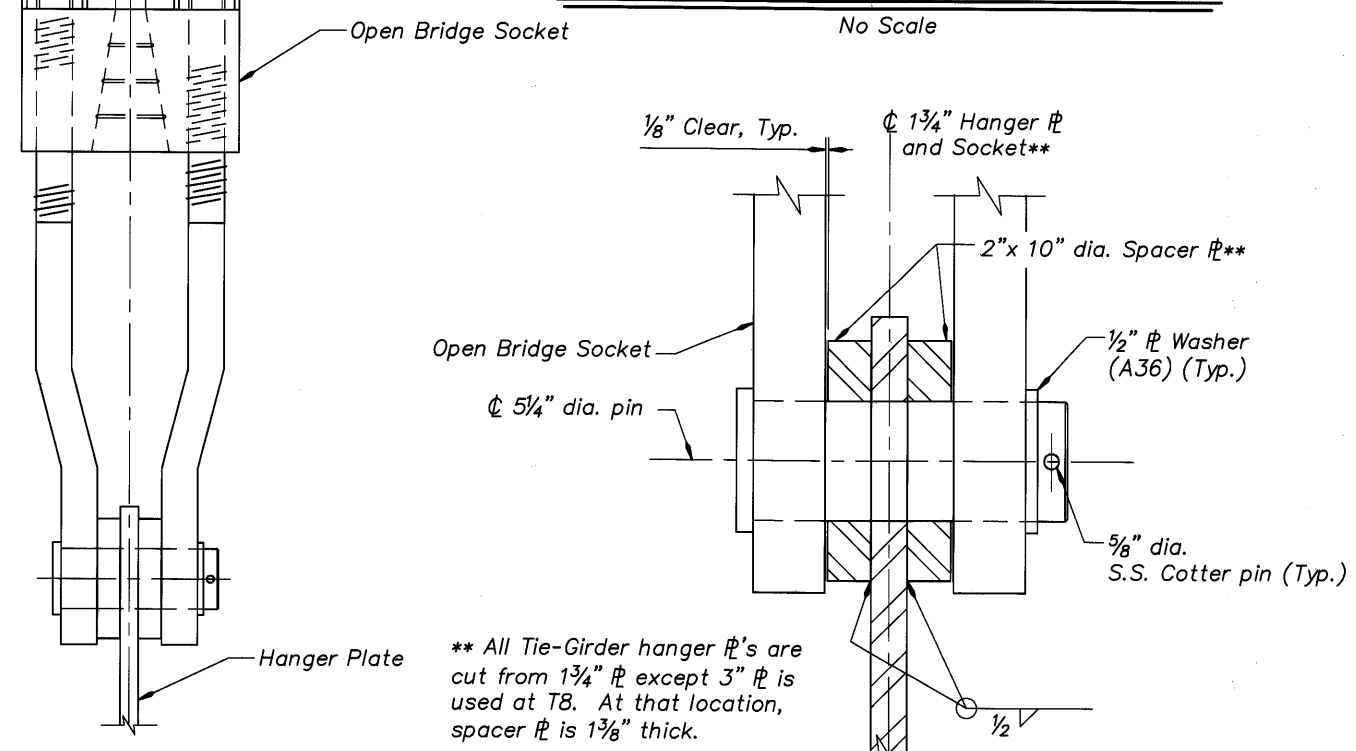

**HANGER PLATE DETAIL AT TIE-GIRDER**

No Scale

**JACKING DETAIL**

No Scale

HANGER CABLE ASSEMBLIES							
CABLE NUMBER	CABLE W.P.'S	NO. REQ'D. (2)	FABRICATED CABLE LENGTH (ft.) (1)	TOTAL CABLE DL ELONGATIONS (ft.)	CABLE FORCES (k) (9)		
					FINAL DL	Max. DL+LL+I	Min. DL+LL+I
C1	A1-T2	2	23.30	0.02	76.5	147.5	73.3
C2	A1-T3	2	34.73	0.01	34.9	59.8	10.3
C3	A2-T3	2	36.58	0.03	69.4	134.7	60.9
C4	A2-T4	2	47.21	0.02	37.7	64.9	4.9
C5	A3-T4	2	48.08	0.03	69.6	137.0	55.2
C6	A3-T5	2	58.03	0.03	52.7	82.9	17.4
C7	A4-T5	2	57.53	0.04	68.0	136.4	48.1
C8	A4-T6	2	66.92	0.04	53.4	87.0	18.3
C9	A5-T6	2	64.73	0.04	61.6	122.6	41.5
C10	A5-T7	2	73.67	0.05	68.9	109.6	31.0
C11	A6-T7	2	69.59	0.04	53.3	91.1	48.6
C12	A6-T8	2	78.23	0.07	83.7	146.8	33.5
C13	A7-T8	2	71.75	0.04	54.6	99.1	41.7
C14	A8-T8	2	69.09	0.05	66.0	99.2	65.4
C15	A9-T8	2	71.20	0.04	54.8	99.4	41.8
C16	A10-T8	2	77.21	0.07	82.7	146.9	31.8
C17	A10-T9	2	69.03	0.04	52.7	90.7	47.4
C18	A11-T9	2	72.68	0.05	67.2	108.1	28.8
C19	A11-T10	2	64.19	0.04	60.8	122.0	39.8
C20	A12-T10	2	65.95	0.04	51.6	85.5	15.9
C21	A12-T11	2	57.04	0.04	67.1	135.5	46.5
C22	A13-T11	2	57.12	0.03	51.2	81.9	15.4
C23	A13-T12	2	47.71	0.03	68.6	136.0	53.6
C24	A14-T12	2	46.41	0.02	37.4	65.6	3.9
C25	A14-T13	2	36.40	0.02	68.6	134.4	59.8
C26	A15-T13	2	34.09	0.01	38.0	64.8	12.6
C27	A15-T14	2	23.37	0.02	76.5	147.4	73.5

TOTAL NO. CABLES REQ'D.=54

See notes on Dwg. #70242.

DO NOT SCALE THIS DRAWING. FOLLOW DIMENSIONS. INDICATED SCALES CORRECT ONLY FOR FULL SIZE SHEET (22"x34").

DATE	REVISION	BY
03/09	As-Constructed	TDF

DRAFTED: J. Patton  
 CHECKED: Oliver Mueller  
 DESIGNED: Clifford Coulter

REVIEWED

DAVID EVANS AND ASSOCIATES INC.  
 530 Center Street N.E., Suite 605  
 Salem Oregon 97301  
 Phone: 503.361.8835

CONNECTING COMMERCE AND COMMUNITY

MULTNOMAH COUNTY BRIDGES

TRANSPORTATION DIVISION

OREGON DEPARTMENT OF TRANSPORTATION  
 BRIDGE ENGINEERING SECTION

BRIDGE NO.	20136
DATE	Sept. 2005
CALC. BOOK	


MULTNOMAH CHANNEL & PNWR ETC., SAUVIE ISLAND RD.

HANGER CABLE DETAILS (2 OF 2)

SHEET 56 OF 173

DRAWING NO. 70243




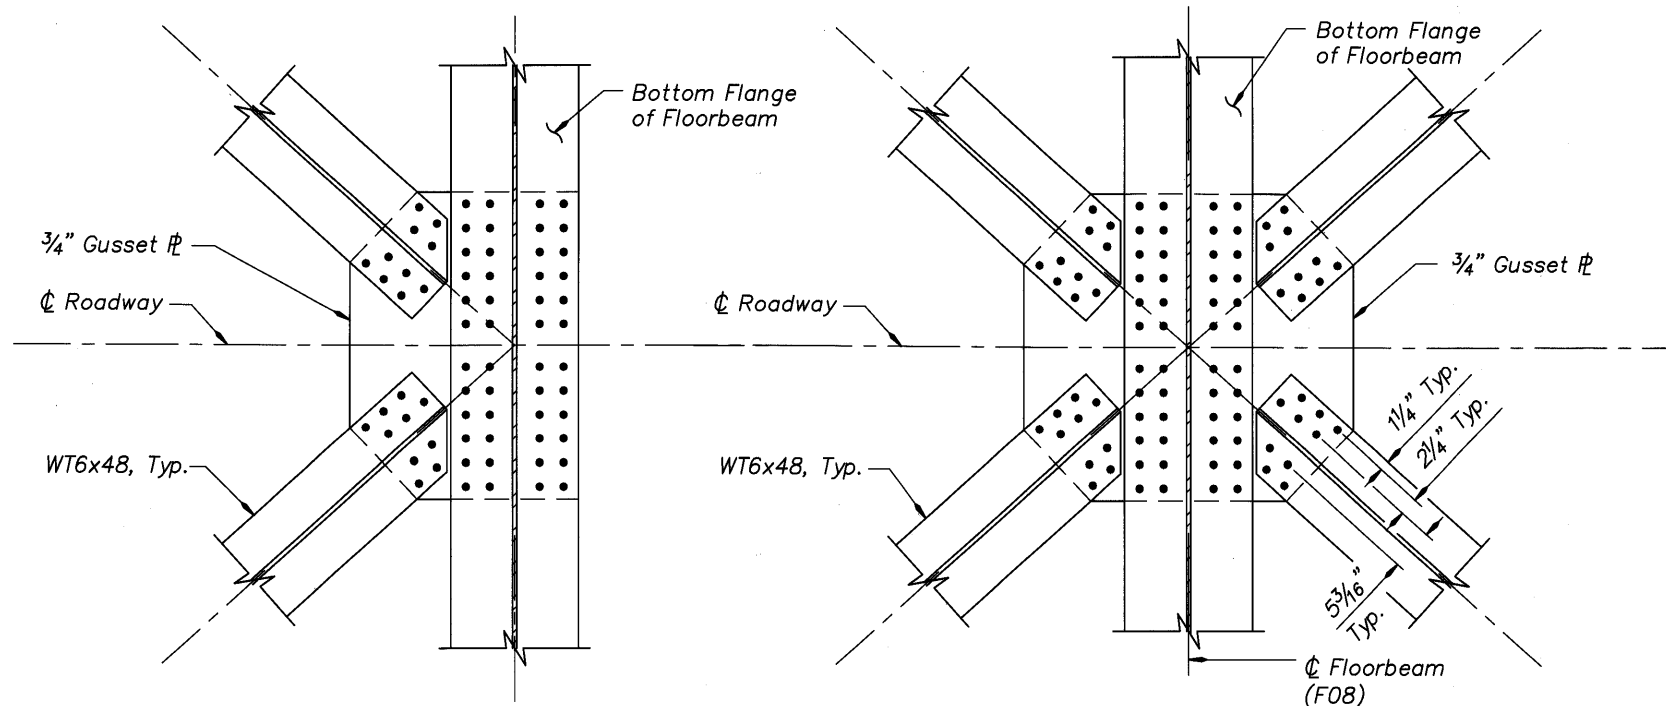

**DETAIL "A"**  
Scale: 1" = 1'-0"


**DETAIL "B"**  
Scale: 1" = 1'-0"

Note:  
Bolt spacing shown for Bottom Lateral Bracing is typical for all similar connections.

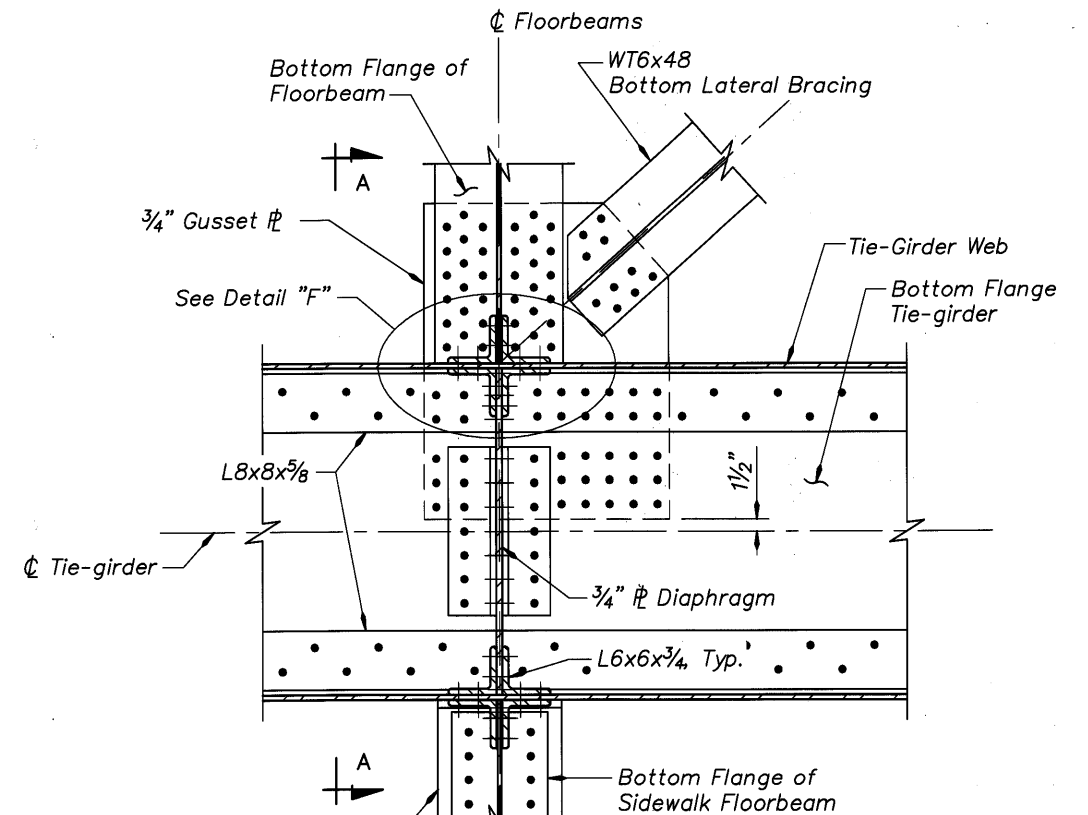


**DETAIL "C"**  
Scale: 1" = 1'-0"


Note:  
For Section A-A, see Dwg. #70232.

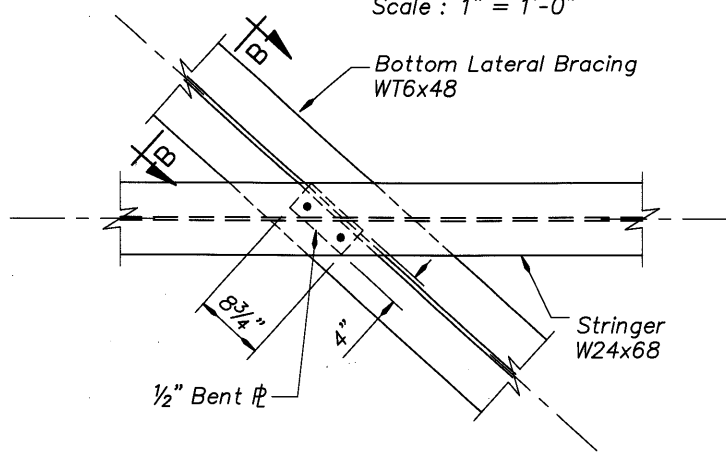


**DETAIL "D"**  
Scale: 1" = 1'-0"

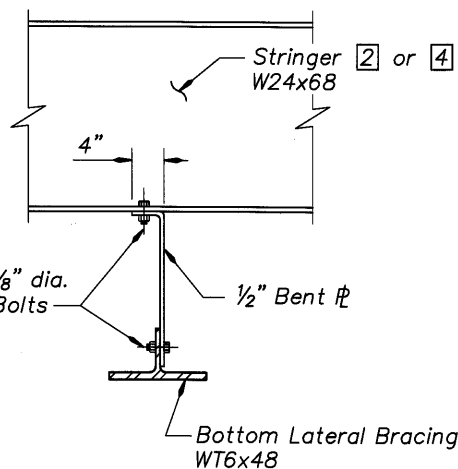

**SECTION B-B**  
Scale: 1" = 1'-0"

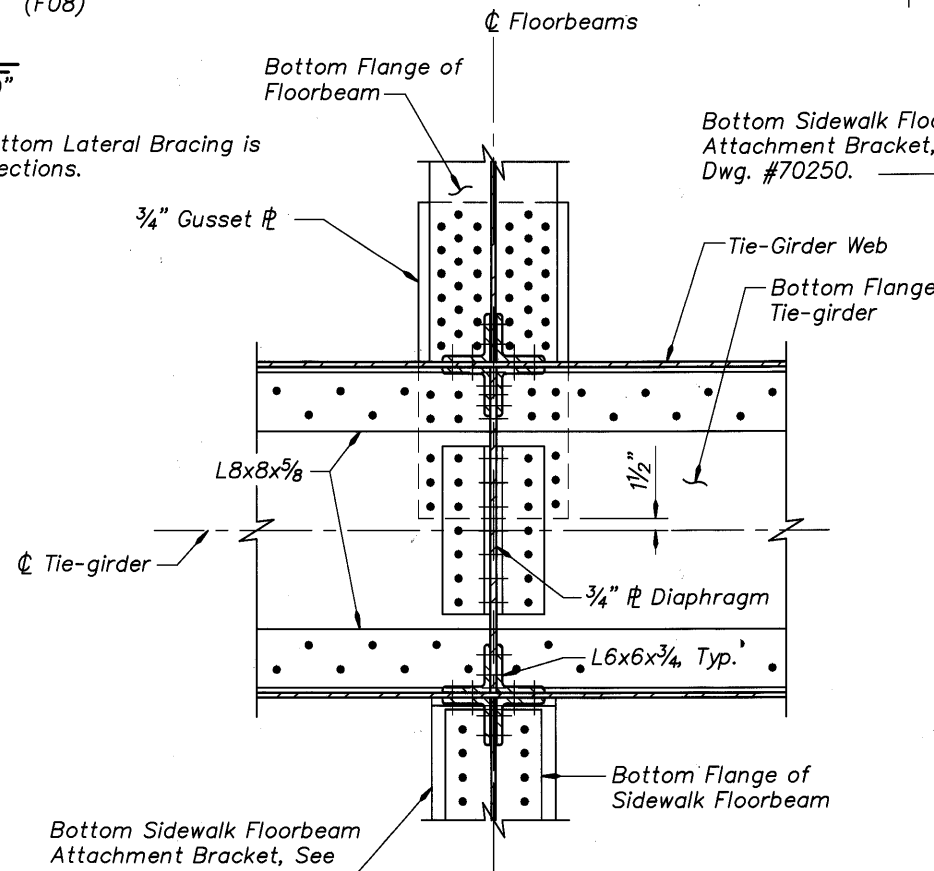


**DETAIL "E"**  
Scale: 1" = 1'-0"

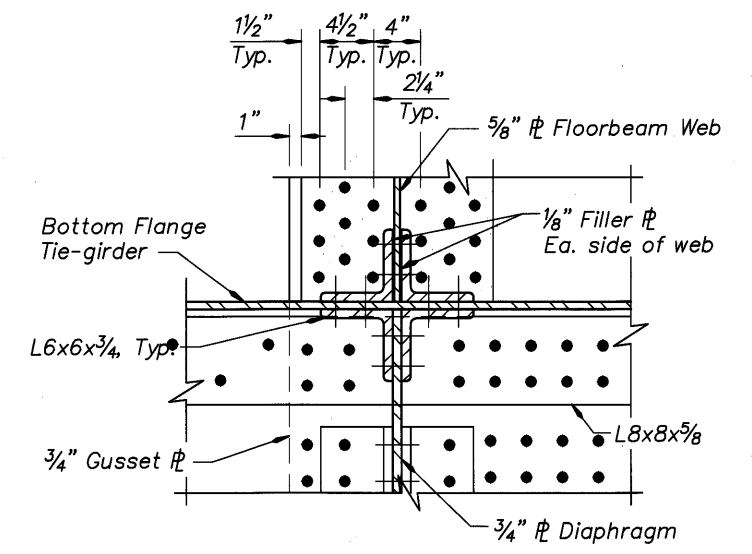

**DETAIL "F"**  
Scale: 1 1/2" = 1'-0"

DO NOT SCALE THIS DRAWING.  
FOLLOW DIMENSIONS. INDICATED  
SCALES CORRECT ONLY FOR  
FULL SIZE SHEET (22"x34").


	DATE	REVISION	BY	J. Patton	REVIEWED  <b>DAVID EVANS AND ASSOCIATES INC.</b> 530 Center Street N.E., Suite 605 Salem Oregon 97301 Phone: 503.361.8635 EXPIRES: 12-31-05	BRIDGE NO. 20136 DATE Sept. 2005 CALC. BOOK	MULTNOMAH CHANNEL & PNWR ETC., SAUVIE ISLAND RD.	SHEET 58 OF 173. DRAWING NO. 70245	
	03/09	As-Constructed	TDF	Shonn Mills					TRANSPORTATION DIVISION
				Clifford Coulter					OREGON DEPARTMENT OF TRANSPORTATION BRIDGE ENGINEERING SECTION
									DECK FRAMING PLAN ARCH FLOOR SYSTEM (2 OF 2)

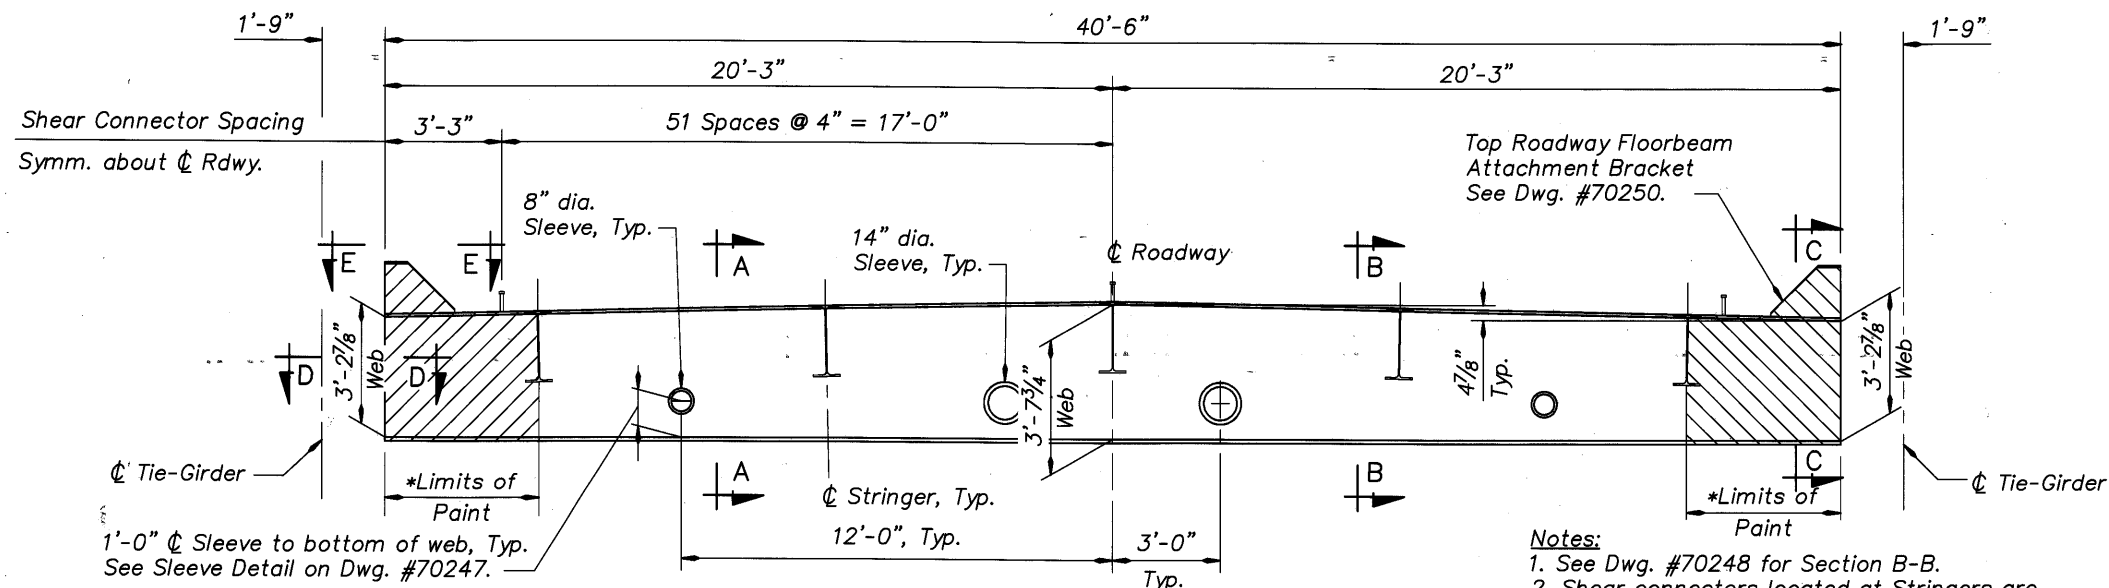

**TYPICAL FLOORBEAM ELEVATION - SPAN 3**


Scale : 3/8" = 1'-0"

- Notes:**
1. See Dwg. #70248 for Section B-B.
  2. Shear connectors located at Stringers are welded to top splice flange. See detail on Dwg. #70248.
  3. Floorbeam perpendicular to Tie-Girder (not parallel to true Vertical).
  4. Do not camber floorbeam. Ends of floorbeam are vertical.

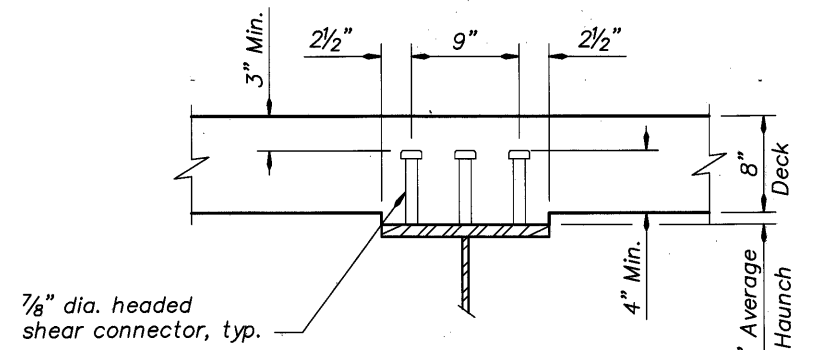


**FLOORBEAM SHEAR CONNECTOR DETAIL**

Scale : 1/2" = 1'-0"

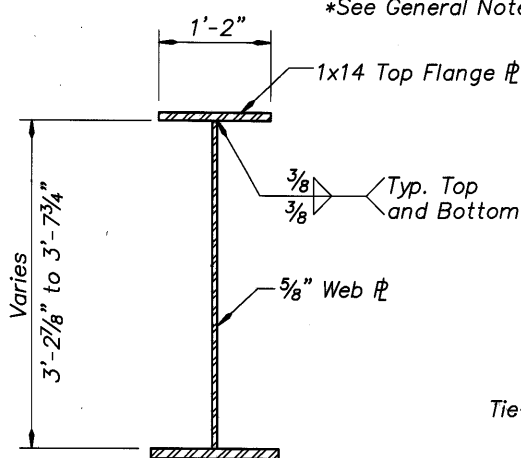


**SECTION A-A**

Scale : 1" = 1'-0"

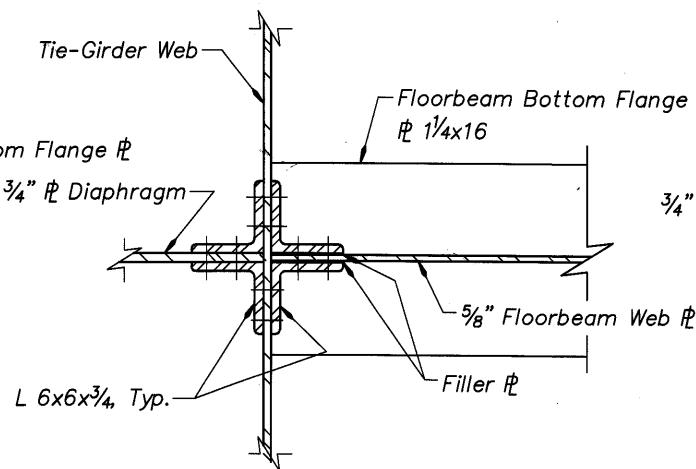

**SECTION D-D**


Scale : 1/2" = 1'-0"

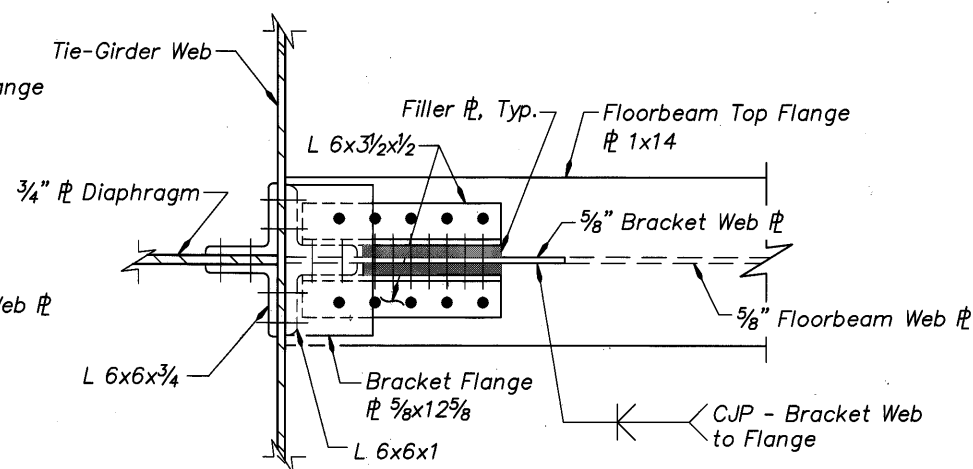

**SECTION E-E**

Scale : 1/2" = 1'-0"

See Dwg. #70250 for Top Roadway Floorbeam Attachment Bracket Details.

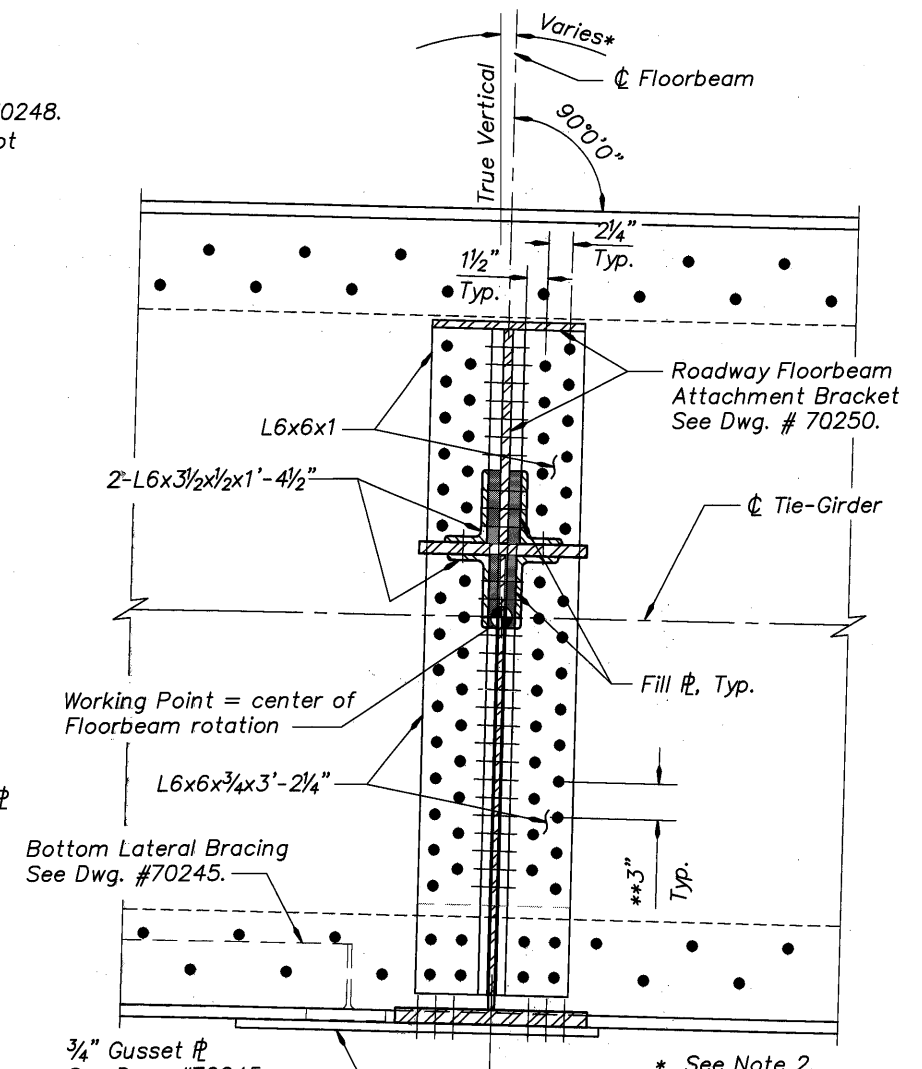

**SECTION C-C**

Scale : 1/2" = 1'-0"

\* See Note 2.  
\*\* See Section A-A on Dwg. #70232

DO NOT SCALE THIS DRAWING. FOLLOW DIMENSIONS. INDICATED SCALES CORRECT ONLY FOR FULL SIZE SHEET (22"x34").

DATE	REVISION	BY
03/09	As-Constructed	TDF

DRAFTED:	J. Patton
CHECKED:	Shonn Mills
DESIGNED:	Paul Greco

**REVIEWED**

REGISTERED PROFESSIONAL ENGINEER  
 74549 PE  
 OREGON  
 David Evans and Associates Inc.  
 530 Center Street N.E., Suite 605  
 Salem Oregon 97301  
 Phone: 503.361.8635

EXPIRES: 12-31-05

CONNECTING COMMERCE AND COMMUNITY

**MULTNOMAH COUNTY BRIDGES**

TRANSPORTATION DIVISION





**OREGON DEPARTMENT OF TRANSPORTATION BRIDGE ENGINEERING SECTION**

BRIDGE NO.	20136
DATE	Sept. 2005
CALC. BOOK	


MULTNOMAH CHANNEL & PNWR ETC., SAUVIE ISLAND RD.

**TYPICAL FLOORBEAM DETAILS**

SHEET	59
OF	173
DRAWING NO.	70246

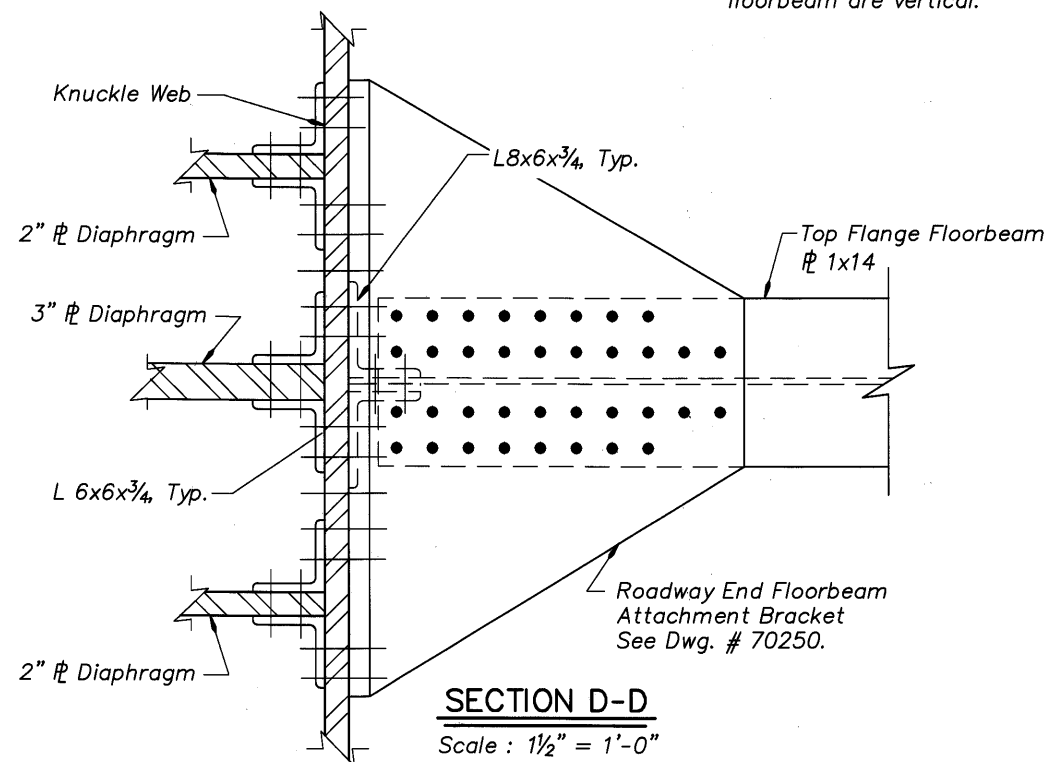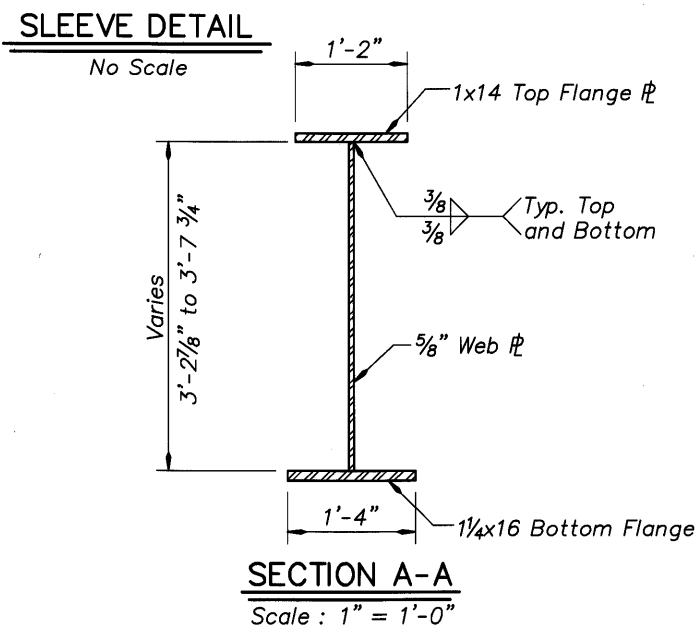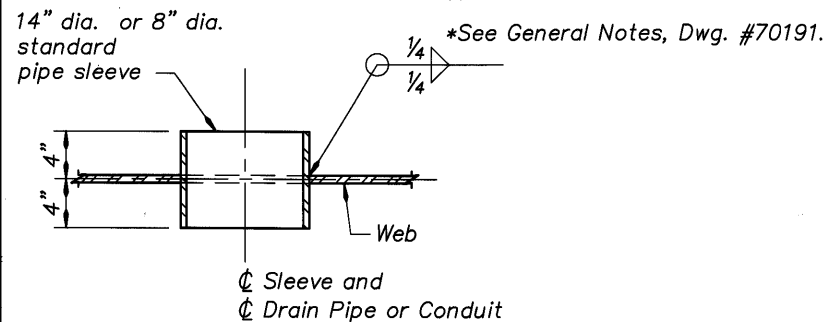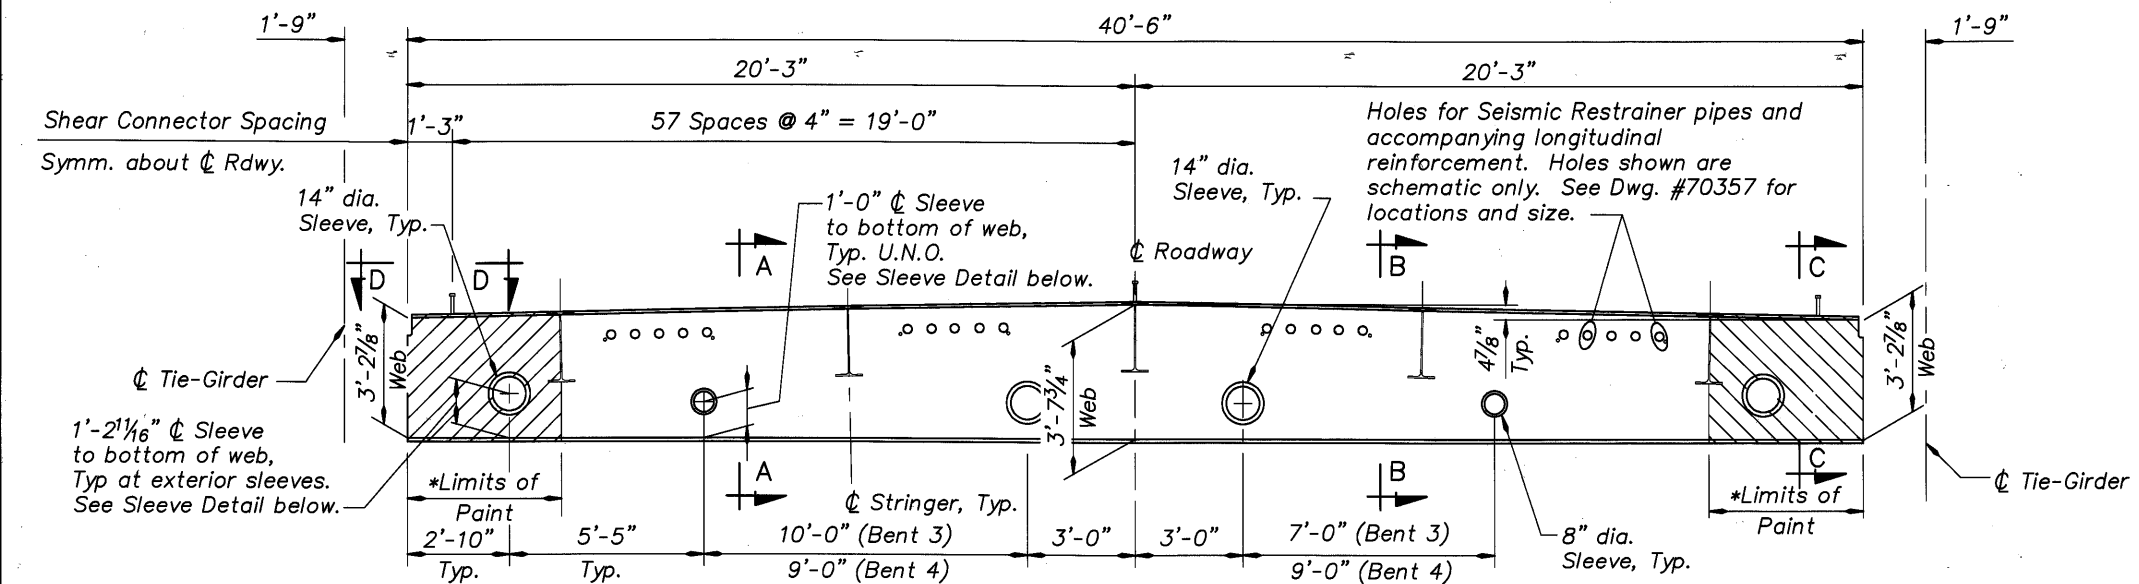

- Notes:**
- See Dwg. #70248 for Section B-B.
  - For Floorbeam Shear Connector Detail, See Dwg. #70246.
  - $\phi$  Floorbeam perpendicular to  $\phi$  Tie-Girder (not parallel to true vertical).
  - Do not camber floorbeam. Ends of floorbeam are vertical.

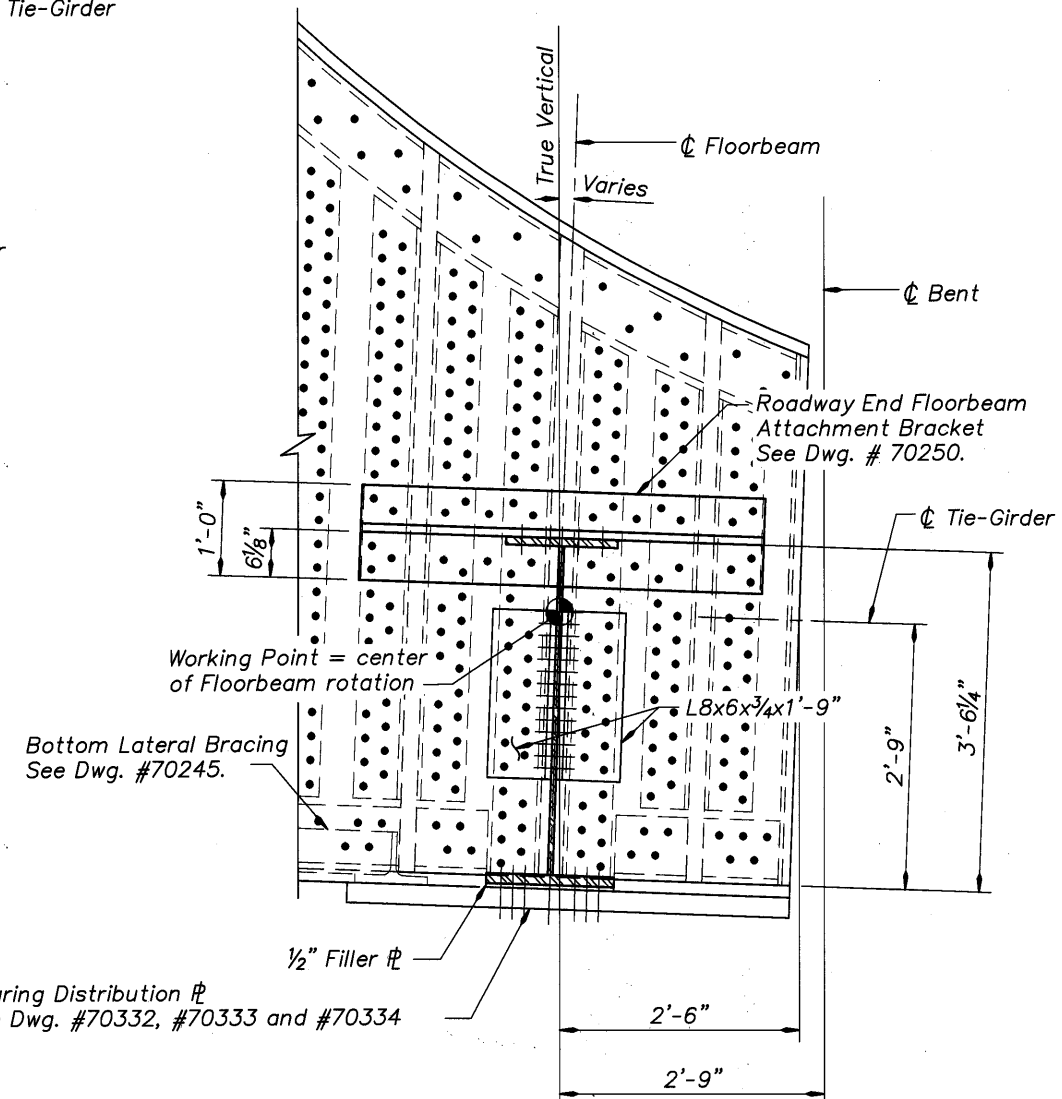

DO NOT SCALE THIS DRAWING. FOLLOW DIMENSIONS. INDICATED SCALES CORRECT ONLY FOR FULL SIZE SHEET (22"x34").

DATE	REVISION	BY
03/09	As-Constructed	TDF
		J. Patton
		Shonn Mills
		Eric Rau

**REVIEWED**

REGISTERED PROFESSIONAL ENGINEER  
DAVID EVANS AND ASSOCIATES INC.  
530 Center Street N.E., Suite 605  
Salem Oregon 97301  
Phone: 503.361.8635

EXPIRES: 6-30-06

CONNECTING COMMERCE AND COMMUNITY

**MULTNOMAH COUNTY BRIDGES**

TRANSPORTATION DIVISION


**OREGON DEPARTMENT OF TRANSPORTATION BRIDGE ENGINEERING SECTION**

BRIDGE NO.	20136
DATE	Sept. 2005
CALC. BOOK	

MULTNOMAH CHANNEL & PNWR ETC., SAUVIE ISLAND RD.


**END FLOORBEAM DETAILS**

SHEET	60
OF	173
DRAWING NO.	70247

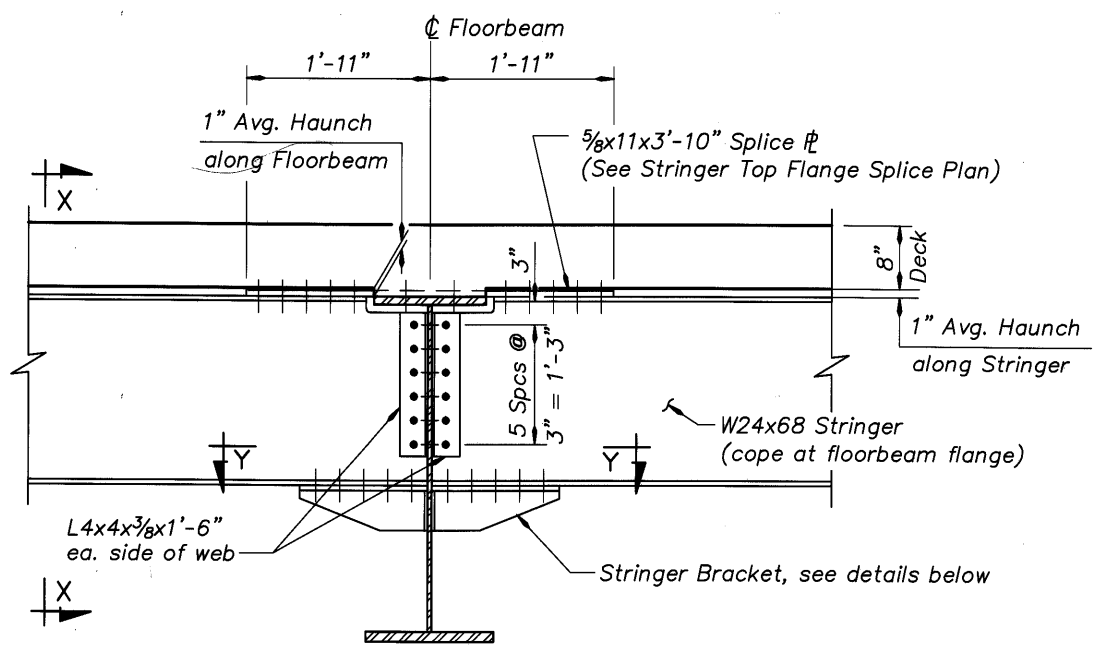


**SECTION B-B**  
Scale: 1" = 1'-0"

**Note:**  
For location of Section B-B, see Dwg. #70246.

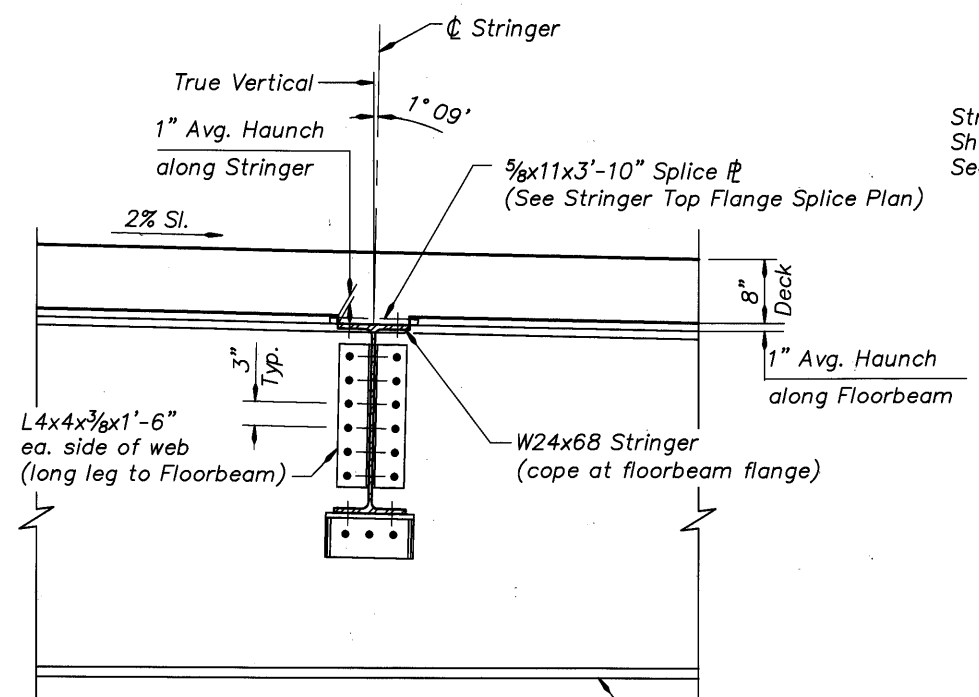


**SECTION X-X**  
Scale: 1" = 1'-0"

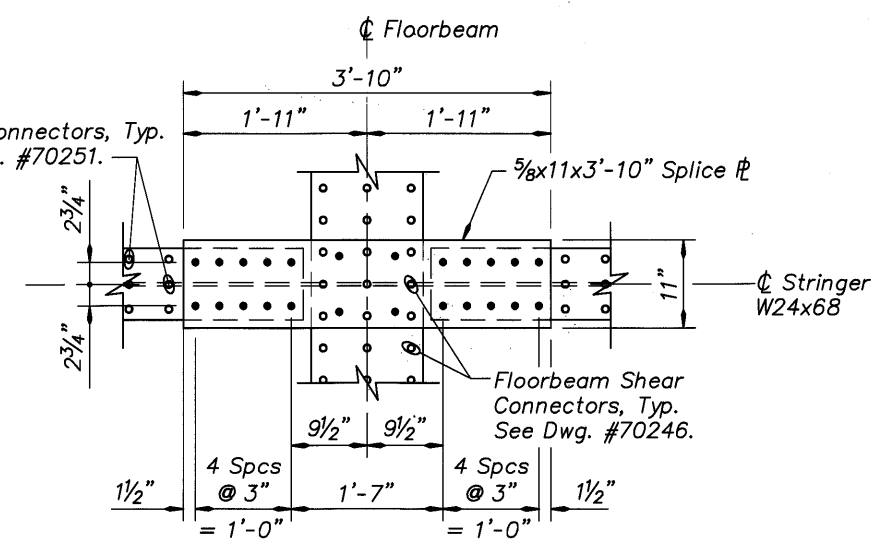


**STRINGER TOP FLANGE SPLICE PLAN**  
Scale: 1" = 1'-0"

Typical Roadway Stringer (W24x68) shown  
Typical Sidewalk Stringer (W12x35) splice similar - See Dwg. #70249 for details.

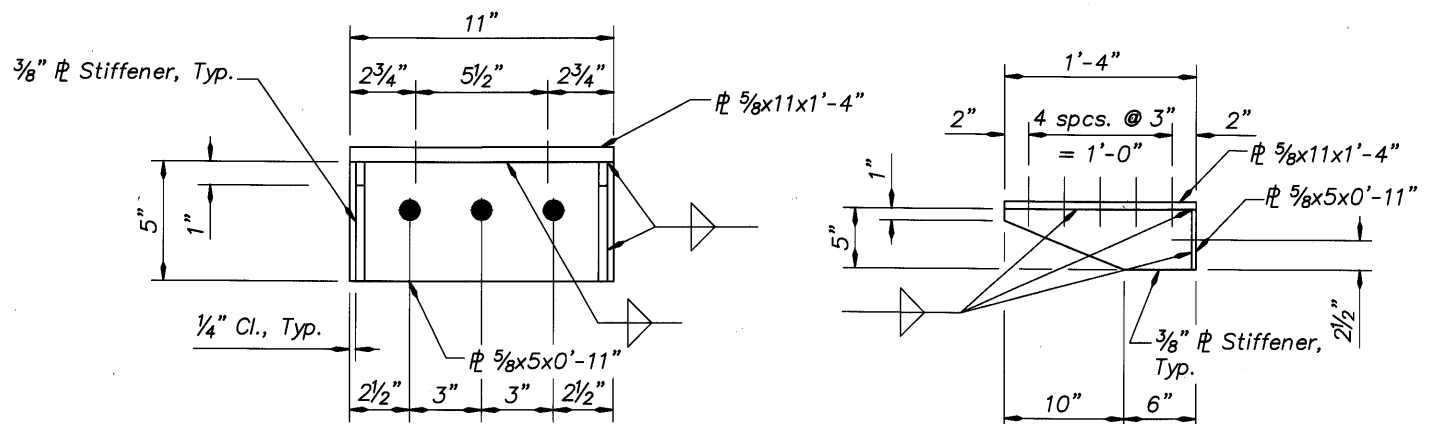

**STRINGER BRACKET DETAILS**  
Scale: 3" = 1'-0" (End Elevation)  
Scale: 1 1/2" = 1'-0" (Side Elevation)

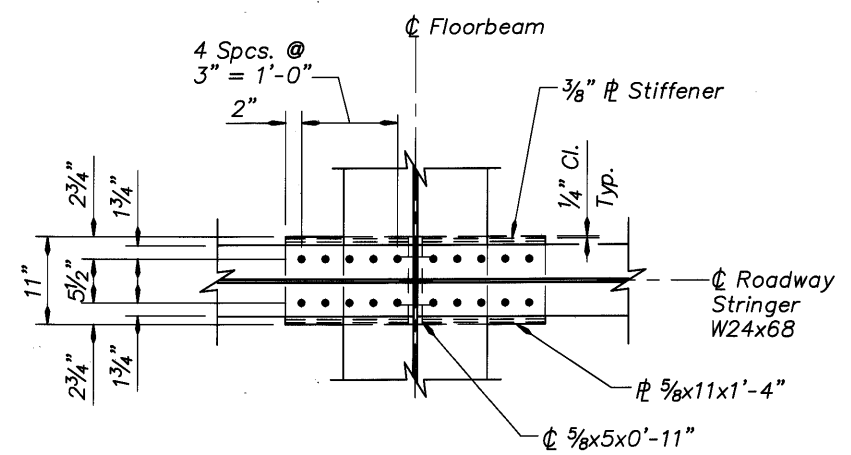


**SECTION Y-Y AT ROADWAY STRINGER**  
Scale: 1" = 1'-0"

DO NOT SCALE THIS DRAWING.  
FOLLOW DIMENSIONS. INDICATED  
SCALES CORRECT ONLY FOR  
FULL SIZE SHEET (22"x34").

DATE	03/09	REVISION	As-Constructed	BY	J. Patton	REVIEWED			BRIDGE NO.	20136	SHEET	61
					Oliver Mueller				DATE	Sept. 2005		OF
					Eric Rau				CALC. BOOK			173.
												DRAWING NO.
												70248

Xref: Odotbdr.dwg 0000460\_AFB\_03.dwg




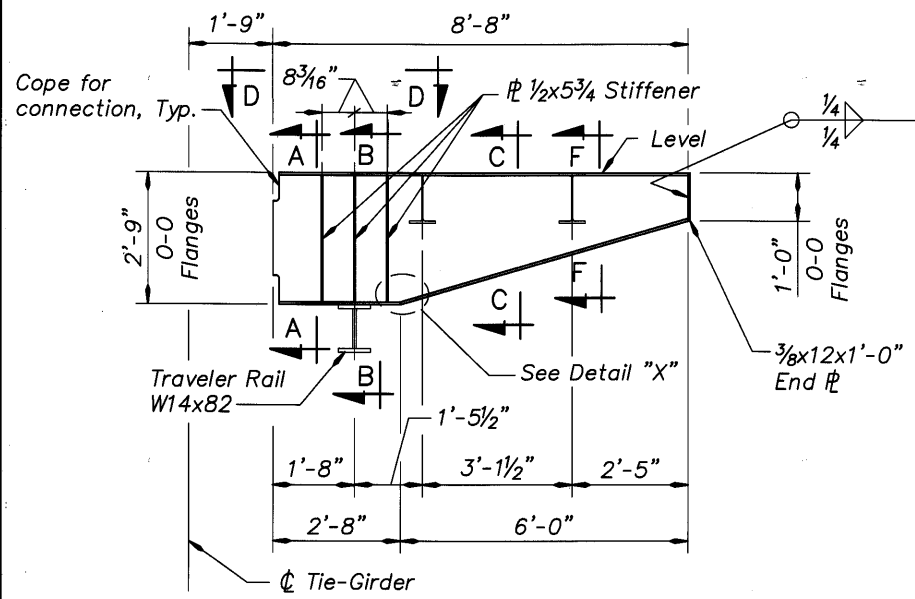

**TYPICAL SIDEWALK FLOORBEAM ELEVATION - SPAN 3**


Scale : 1/2" = 1'-0"

For Traveler Rail details, see Dwg. #70256.

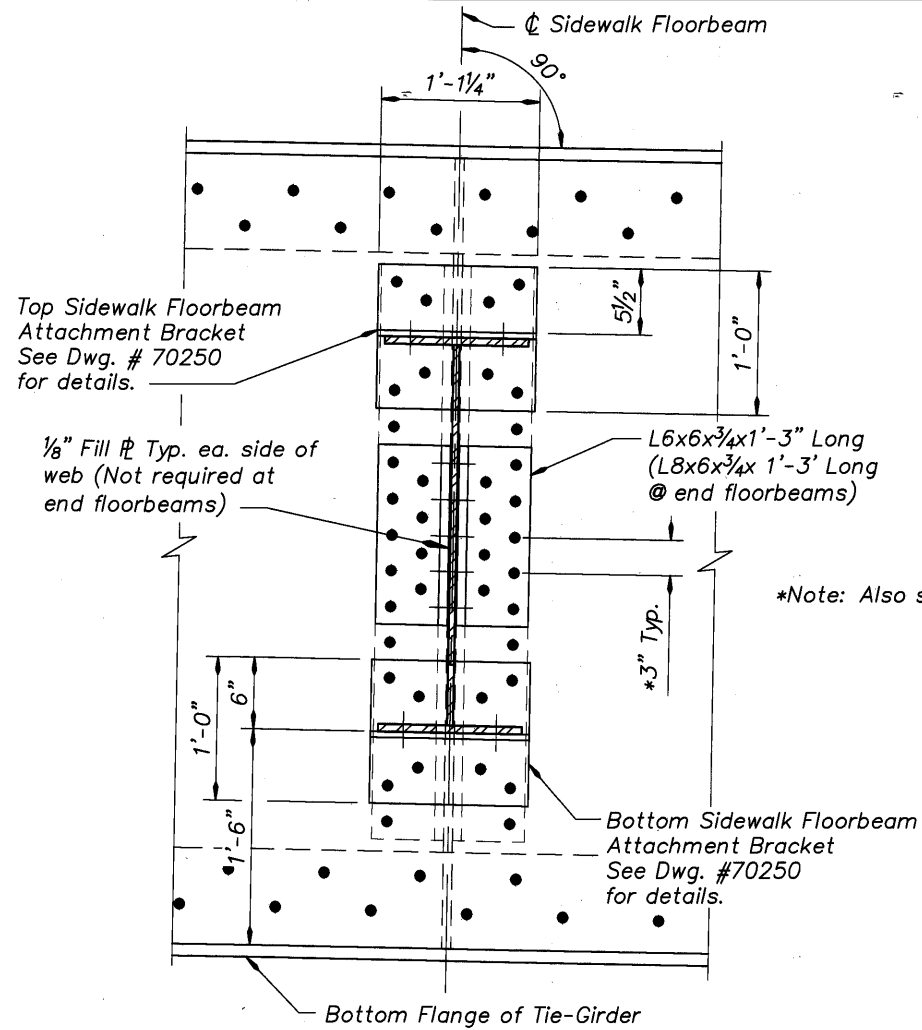

**SECTION A-A**

Scale : 1 1/2" = 1'-0"

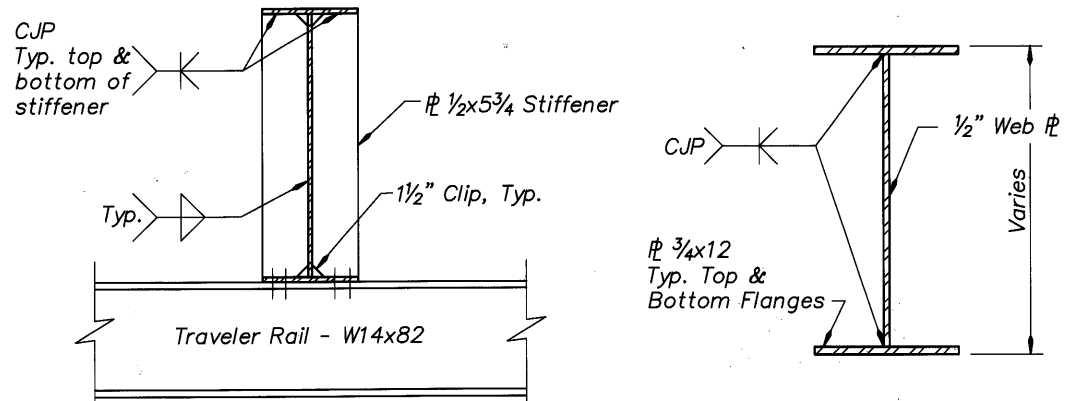


**SECTION B-B**

Scale : 1" = 1'-0"  
(At Stiffener locations)

**SECTION C-C**


Scale : 1 1/2" = 1'-0"

\*Note: Also see Section A-A, Dwg. #70232.

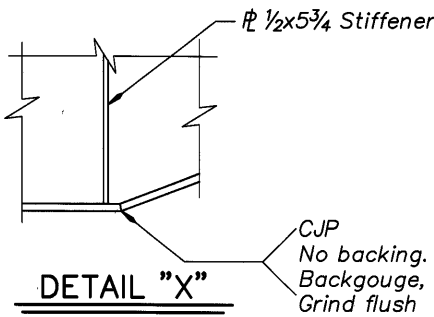


**DETAIL "X"**

Scale : 1 1/2" = 1'-0"

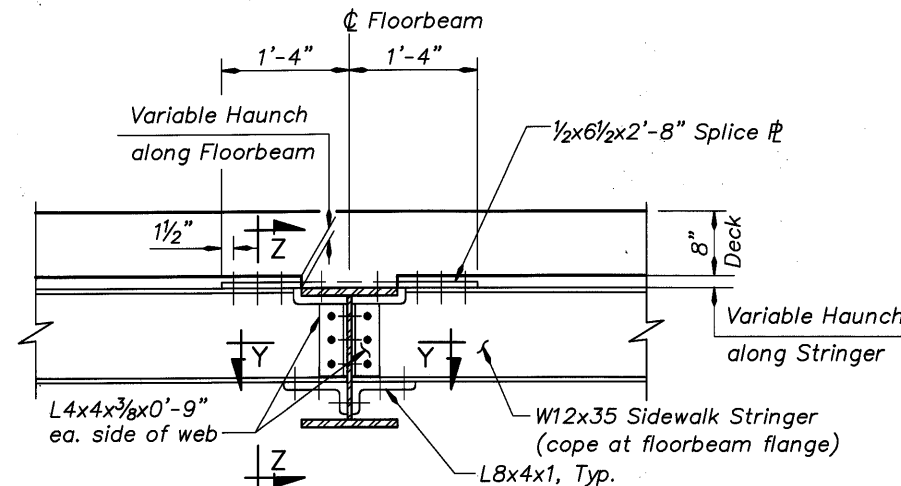

**SECTION F-F**


Scale : 1" = 1'-0"  
(Showing Floorbeam/Stranger connection)

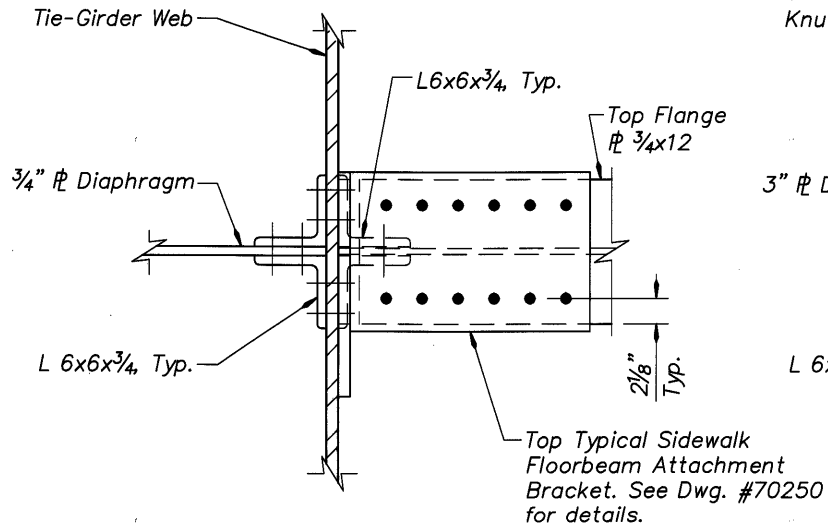


**TYPICAL SIDEWALK FLOORBEAM**

**SECTION D-D**

Scale : 1 1/2" = 1'-0"

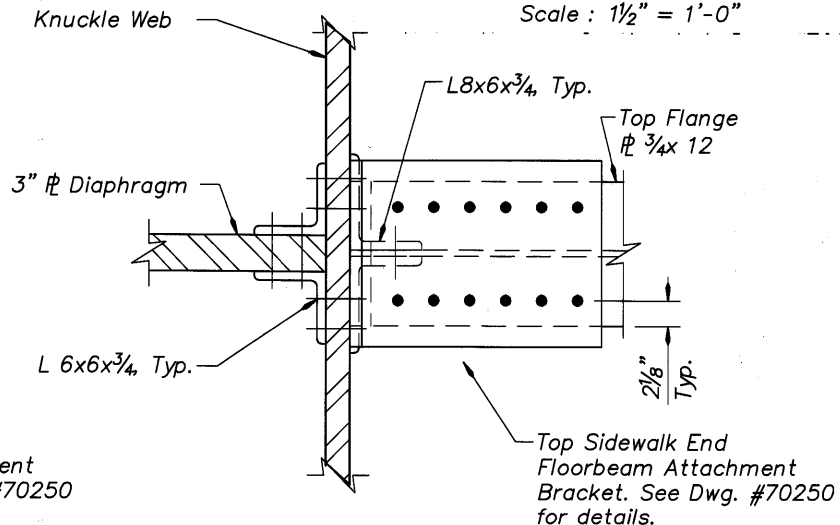


**END SIDEWALK FLOORBEAM**

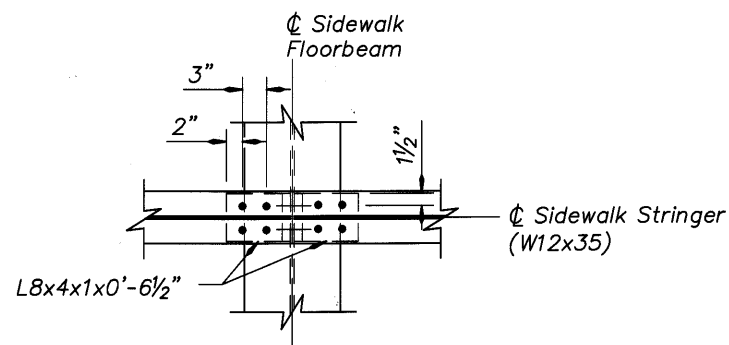

**SECTION Y-Y AT SIDEWALK STRINGER**

Scale : 1" = 1'-0"

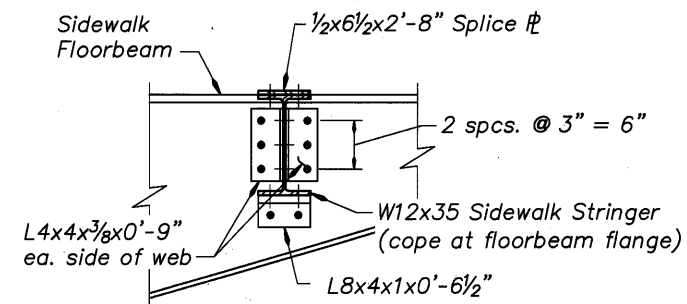

**SECTION Z-Z**

Scale : 1" = 1'-0"

DO NOT SCALE THIS DRAWING.  
FOLLOW DIMENSIONS. INDICATED  
SCALES CORRECT ONLY FOR  
FULL SIZE SHEET (22"x34").

DATE	REVISION	BY
03/09	As-Constructed	TDF

DRAFTED:	J. Patton
CHECKED:	Shonn Mills
DESIGNED:	Eric Rau

**REVIEWED**

**DAVID EVANS AND ASSOCIATES INC.**  
530 Center Street N.E., Suite 605  
Salem Oregon 97301  
Phone: 503.361.8635


CONNECTING COMMERCE AND COMMUNITY

**MULTNOMAH COUNTY BRIDGES**

TRANSPORTATION DIVISION


**OREGON DEPARTMENT OF TRANSPORTATION BRIDGE ENGINEERING SECTION**

BRIDGE NO.	20136	MULTNOMAH CHANNEL & PNWR ETC., SAUVIE ISLAND RD.	SHEET 62 OF 173.
DATE	Sept. 2005		
CALC. BOOK		SIDEWALK STRINGER AND FLOORBEAM DETAILS	DRAWING NO. 70249

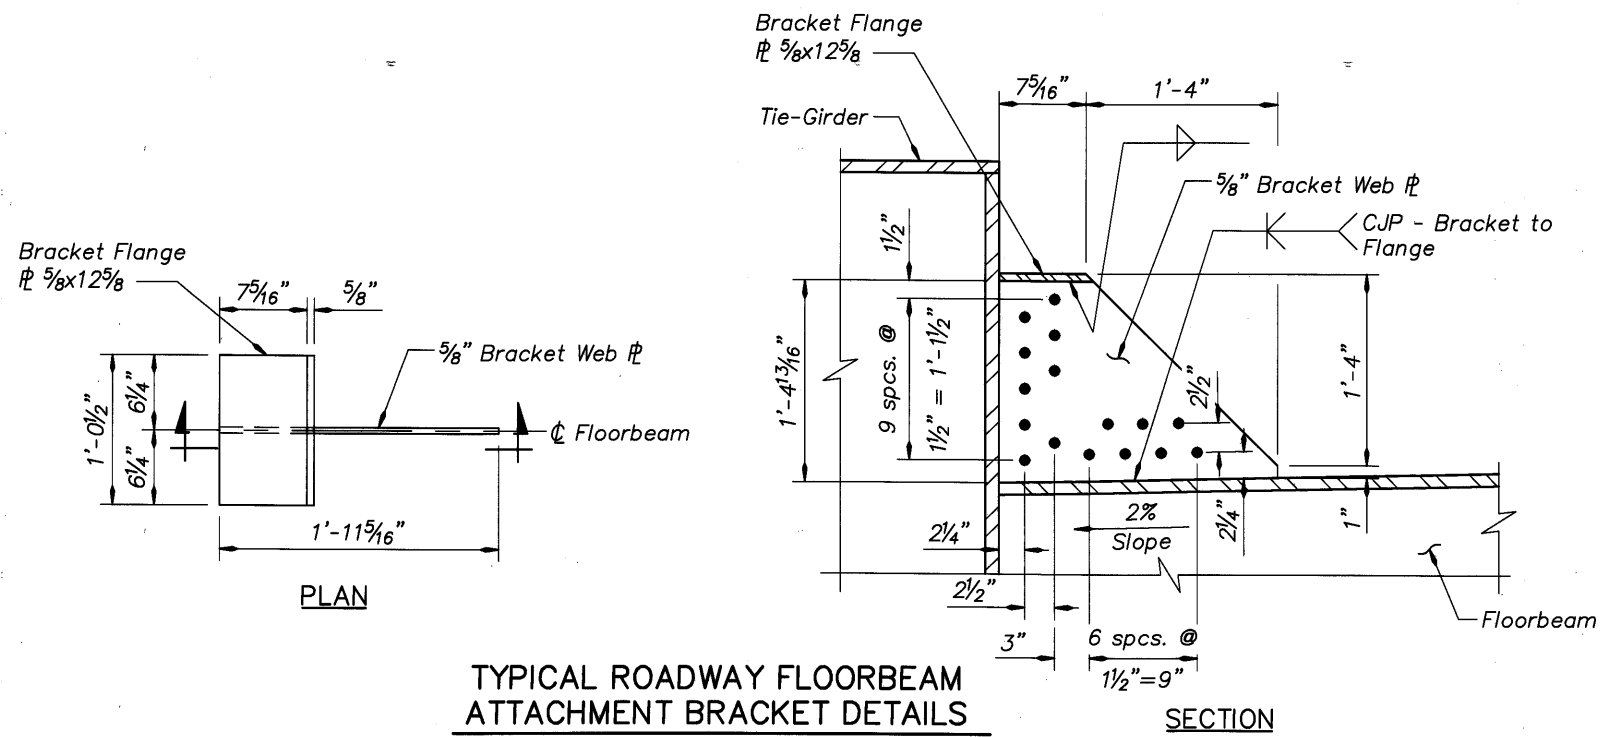


**TYPICAL ROADWAY FLOORBEAM ATTACHMENT BRACKET DETAILS**

Scale : 1/2" = 1'-0"

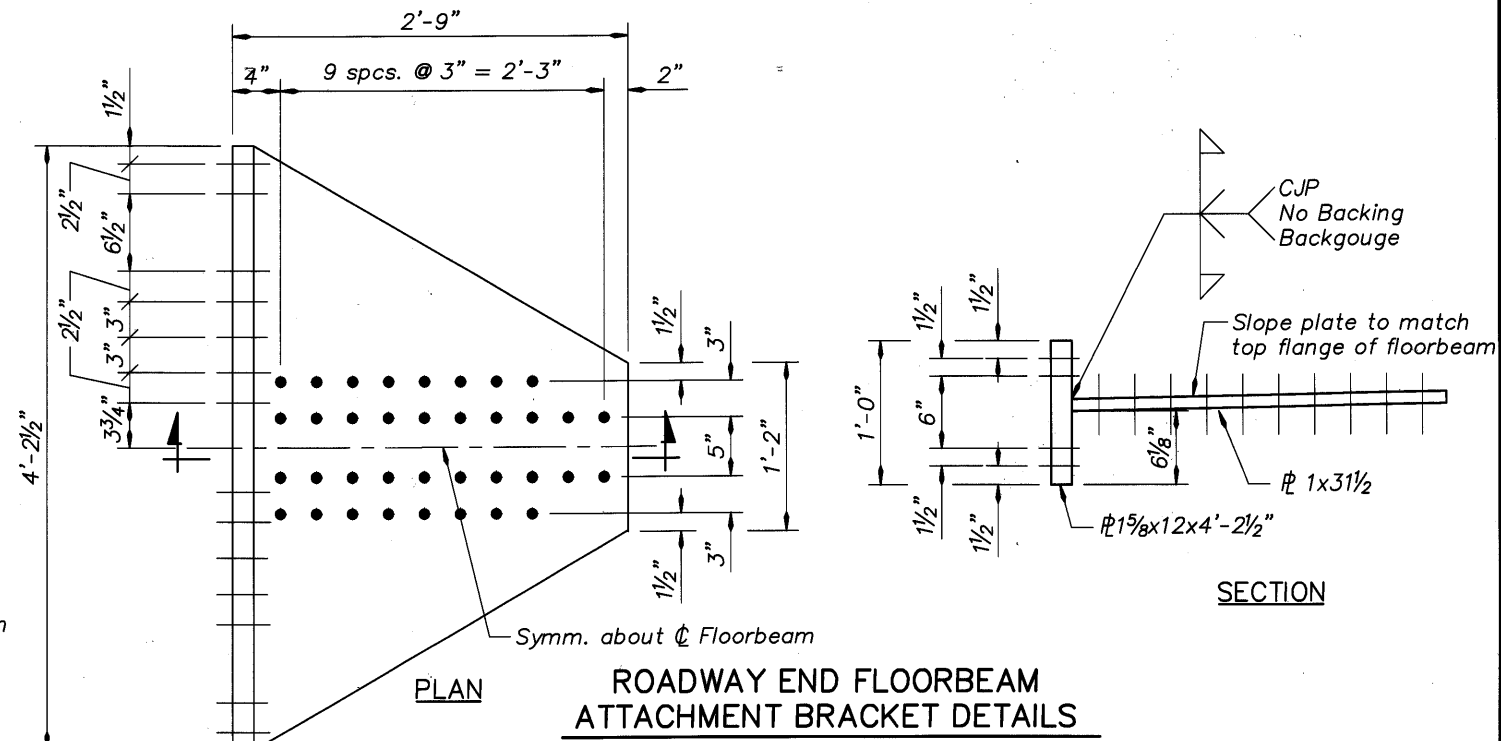


**ROADWAY END FLOORBEAM ATTACHMENT BRACKET DETAILS**

Scale : 1/2" = 1'-0"

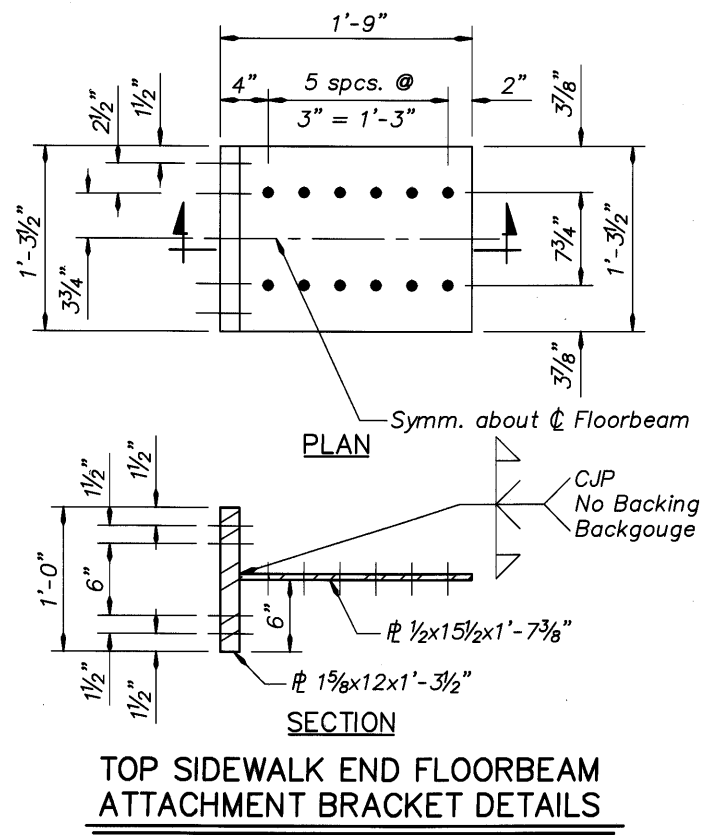


**TOP SIDEWALK END FLOORBEAM ATTACHMENT BRACKET DETAILS**

Scale : 1/2" = 1'-0"

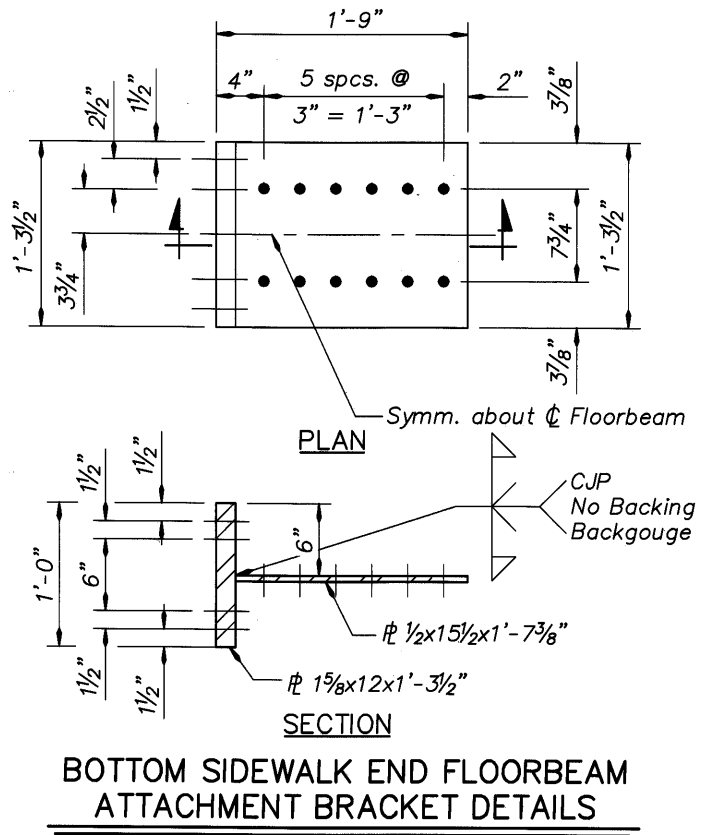


**BOTTOM SIDEWALK END FLOORBEAM ATTACHMENT BRACKET DETAILS**

Scale : 1/2" = 1'-0"

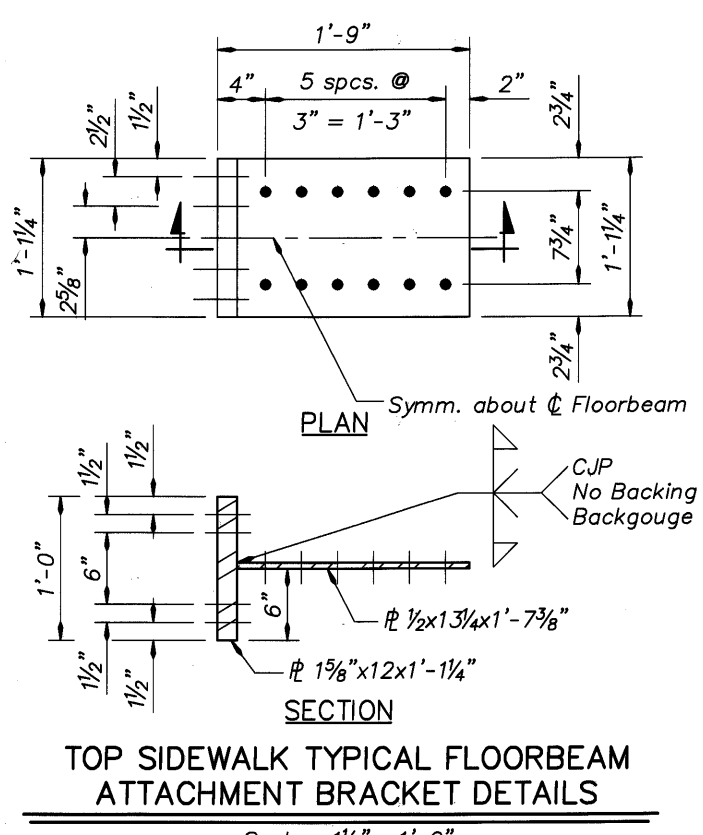

**TOP SIDEWALK TYPICAL FLOORBEAM ATTACHMENT BRACKET DETAILS**

Scale : 1/2" = 1'-0"


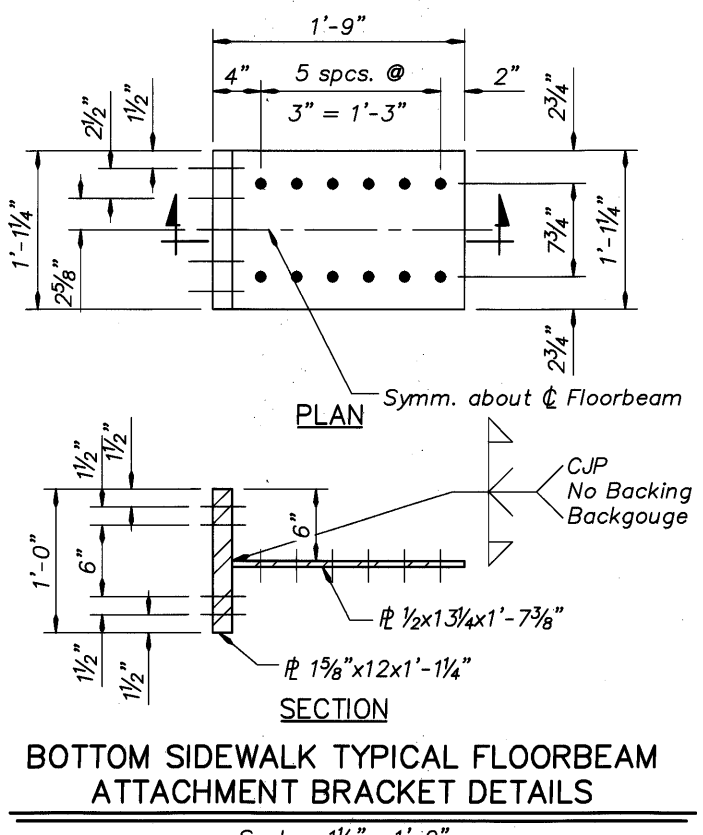


**BOTTOM SIDEWALK TYPICAL FLOORBEAM ATTACHMENT BRACKET DETAILS**

Scale : 1/2" = 1'-0"

	DATE	REVISION	BY	J. Patton	REVIEWED DAVID EVANS AND ASSOCIATES INC. 530 Center Street N.E., Suite 805 Salem Oregon 97301 Phone: 503.361.8635	BRIDGE NO. 20136	MULTNOMAH CHANNEL & PNWR ETC., SAUVIE ISLAND RD.	SHEET 63 OF 173.	
	03/09	As-Constructed	TDF	Shonn Mills					TRANSPORTATION DIVISION DATE Sept. 2005
				Clifford Coulter					OREGON DEPARTMENT OF TRANSPORTATION BRIDGE ENGINEERING SECTION
									CALC. BOOK FLOORBEAM ATTACHMENT BRACKET DETAILS
				EXP. 12-31-05			DRAWING NO. 70250		


Xref: C:\odot\0460\_AFB\_03.dwg

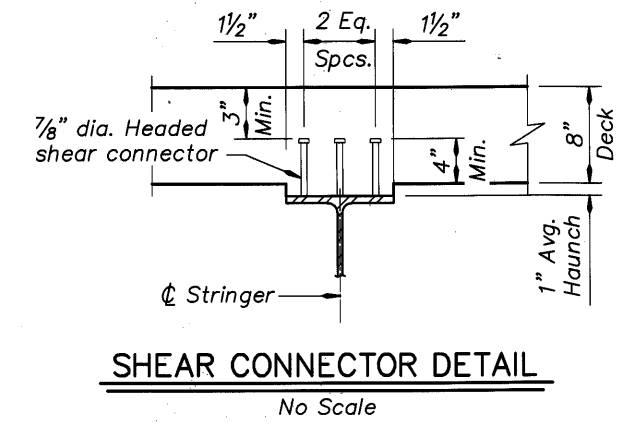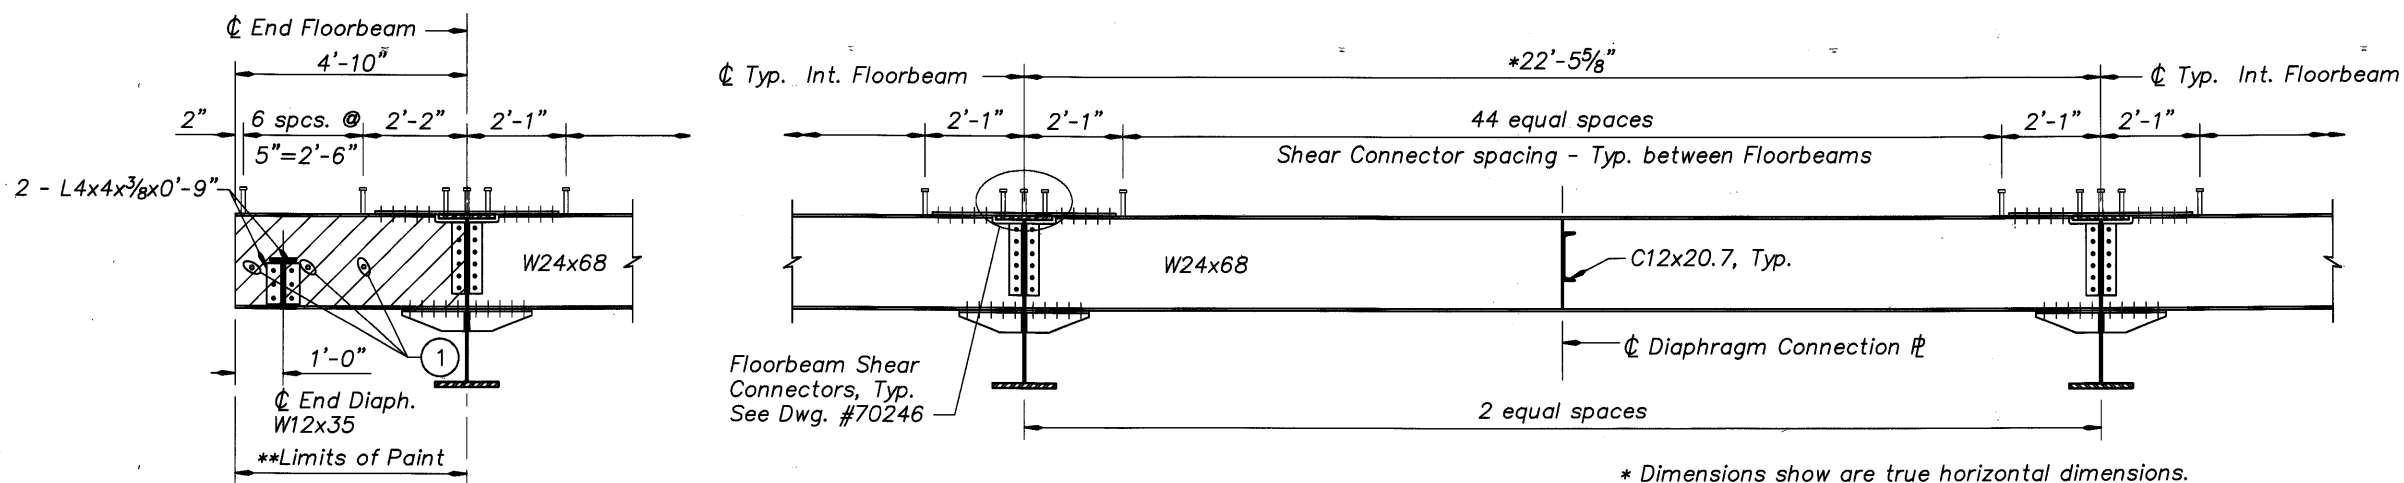

① 1" dia. holes for expansion joint breakout reinforcement. See Dwg. #70339 for details. \*\*See General Notes, Dwg. #70191.

**ROADWAY STRINGER ELEVATION - SPAN 3**


Scale : 1/2" = 1'-0"

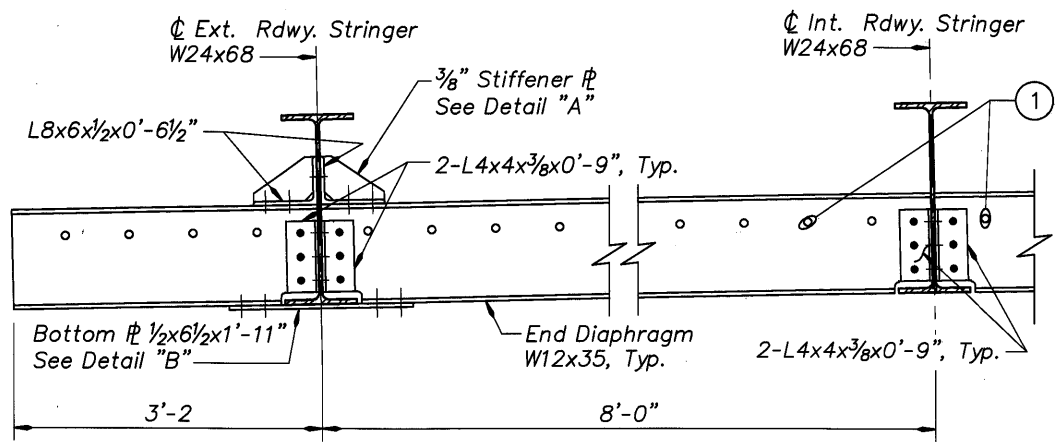

**END DIAPHRAGM**


Scale : 1" = 1'-0"

Note: Entire end diaphragm will be painted at each end of span 3. See General Notes, Dwg. #70191.

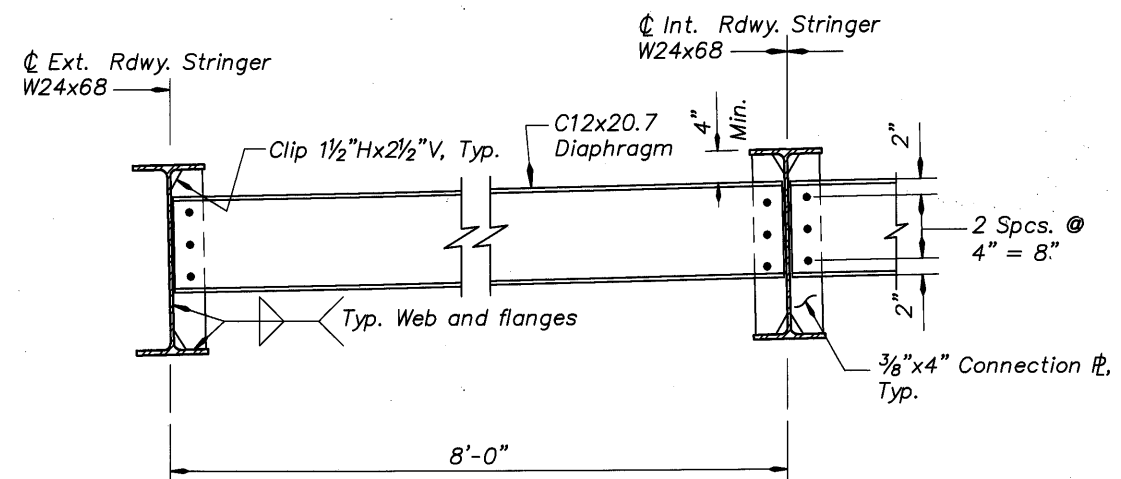

**TYPICAL DIAPHRAGM**

Scale : 1" = 1'-0"

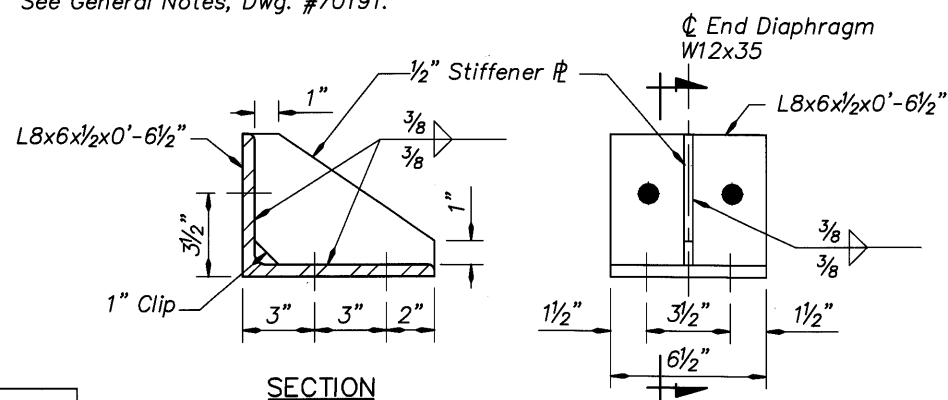


**SECTION**

**DETAIL "A" END VIEW**

Scale : 3" = 1'-0"

**Notes:**

1.  $\phi$  Floorbeam perpendicular to  $\phi$  Tie-Girder alignment (not parallel to true vertical). Ends of stringer fabricated parallel to  $\phi$  Floorbeam.
2. For stringer to floorbeam connections, see Dwg. #70248.

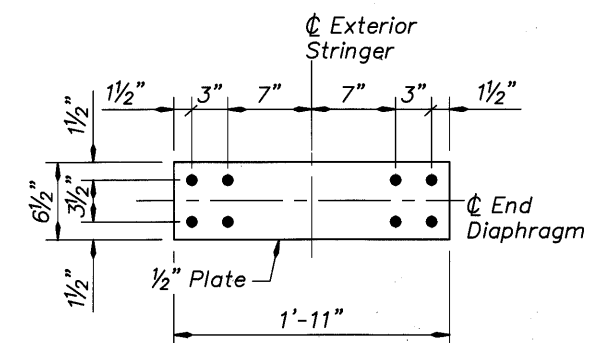


**DETAIL "B"**

Scale : 1/2" = 1'-0"

DO NOT SCALE THIS DRAWING. FOLLOW DIMENSIONS. INDICATED SCALES CORRECT ONLY FOR FULL SIZE SHEET (22"x34").


	DATE	REVISION	BY	J. Patton			BRIDGE NO.	MULTNOMAH CHANNEL & PNWR ETC., SAUVIE ISLAND RD.	SHEET
	03/09	As-Constructed	TDF	Oliver Mueller			20136		64
				Eric Rau			DATE		173
						TRANSPORTATION DIVISION BRIDGE ENGINEERING SECTION	Sept. 2005 CALC. BOOK	DRAWING NO.	
					530 Center Street N.E., Suite 605 Salem Oregon 97301 Phone: 503.361.8635				70251

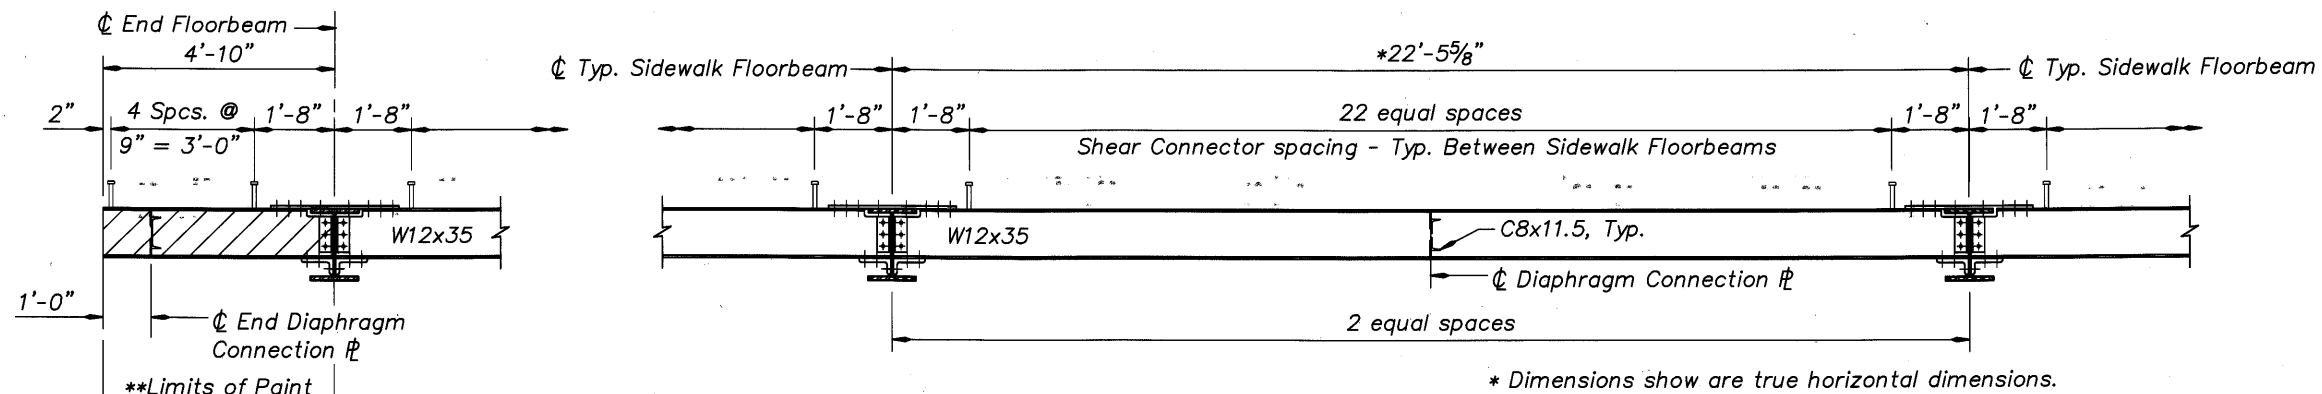

**SIDEWALK STRINGER ELEVATION - SPAN 3**


Scale : 1/2" = 1'-0"

\*\*See General Notes, Dwg. #70191.

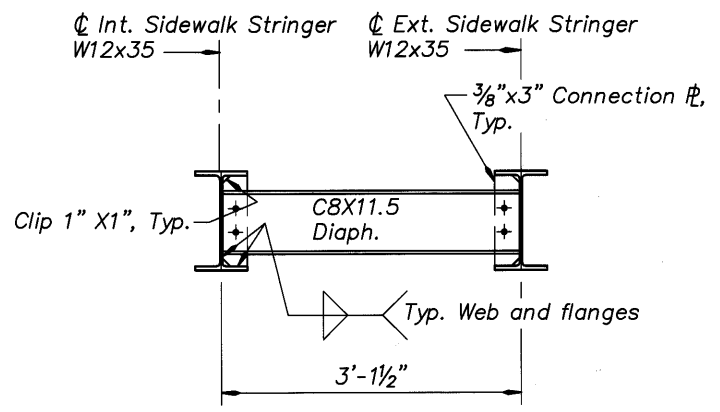

**TYPICAL DIAPHRAGM**

Scale : 1" = 1'-0"

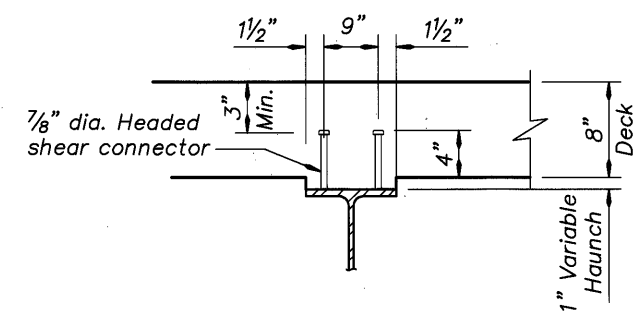

**SHEAR CONNECTOR DETAIL**


No Scale

**Notes:**

1.  $\phi$  Floorbeam perpendicular to  $\phi$  Tie-Girder alignment (not parallel to true vertical). Ends of stringer fabricated parallel to  $\phi$  Floorbeam.
2. For stringer to sidewalk floorbeam connections, see Dwg. #70249.

DO NOT SCALE THIS DRAWING. FOLLOW DIMENSIONS. INDICATED SCALES CORRECT ONLY FOR FULL SIZE SHEET (22"x34").


DATE	03/09	REVISION	As-Constructed	BY	J. Patton	REVIEWED				TRANSPORTATION DIVISION OREGON DEPARTMENT OF TRANSPORTATION BRIDGE ENGINEERING SECTION	BRIDGE NO.	20136	SHEET	65	
				CHECKED:	Shonn Mills						DATE	Sept. 2005	DRAWING NO.	70252	
				DESIGNED:	Eric Rau						CALC. BOOK				
											MULTNOMAH CHANNEL & PNWR ETC., SAUVIE ISLAND RD.		DRAWING NO.		70252
											SIDEWALK STRINGER DETAILS				

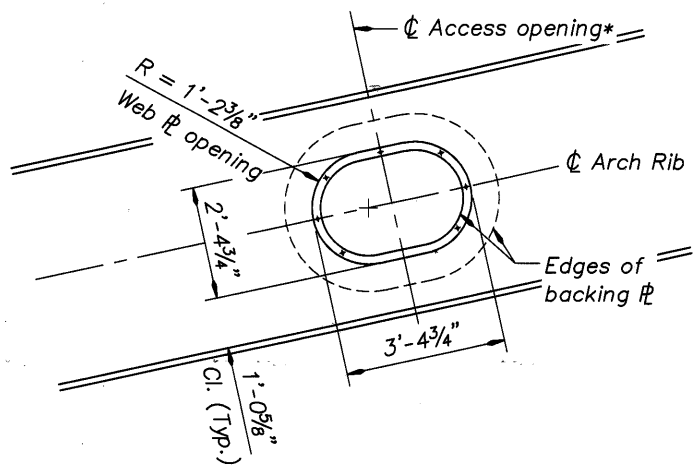

**ARCH RIB WEB PLATE OPENING DETAIL**


Scale: 1/2" = 1'-0"

\* Access Opening/Door shall be perpendicular to local tangent of Arch Rib. For clarity, access door is omitted from this view. See other details this sheet for door in place.

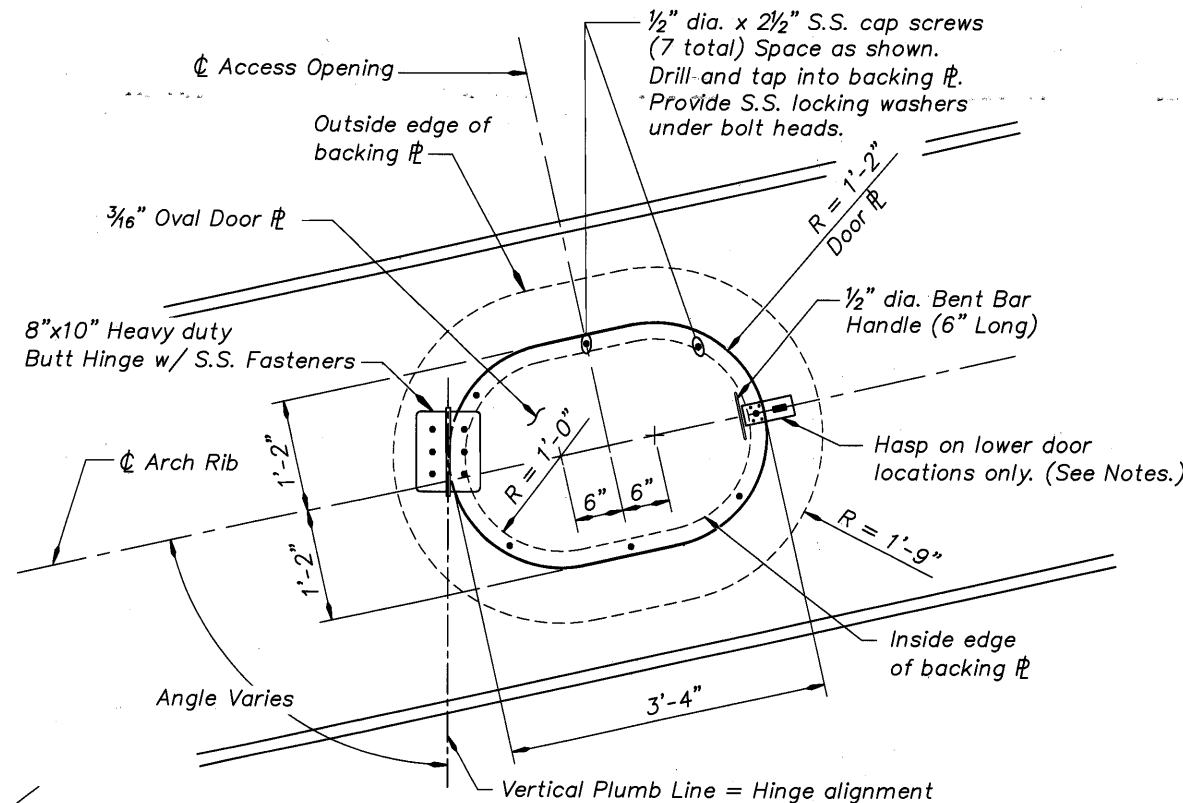

**ARCH RIB ACCESS DOOR DETAIL**

Scale: 1" = 1'-0"

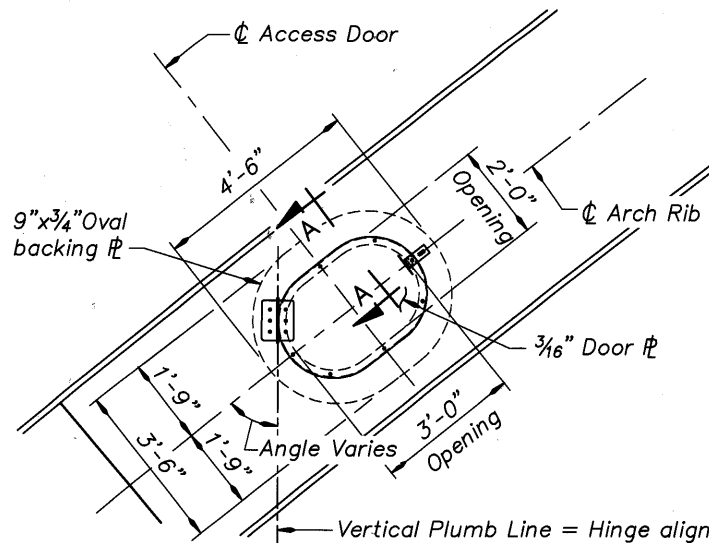


**ARCH RIB ACCESS DOOR - IN PLACE**

Scale: 1/2" = 1'-0"


**ARCH RIB ACCESS DOOR DETAILS**

Note: For locations of Arch Rib Access Doors, see Dwg. #70219 and #70220.

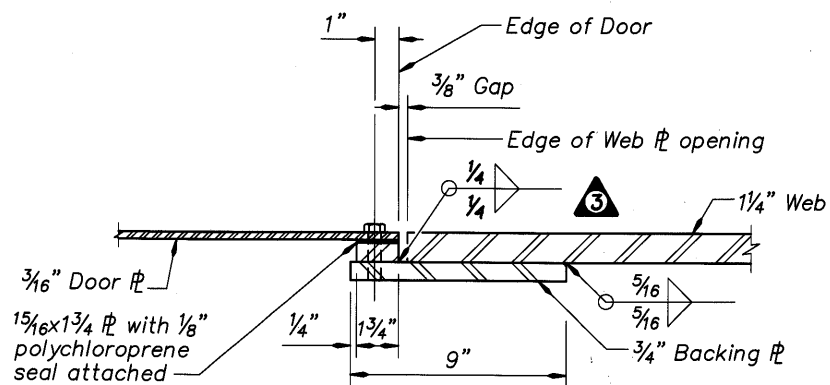

**SECTION A-A**


No Scale

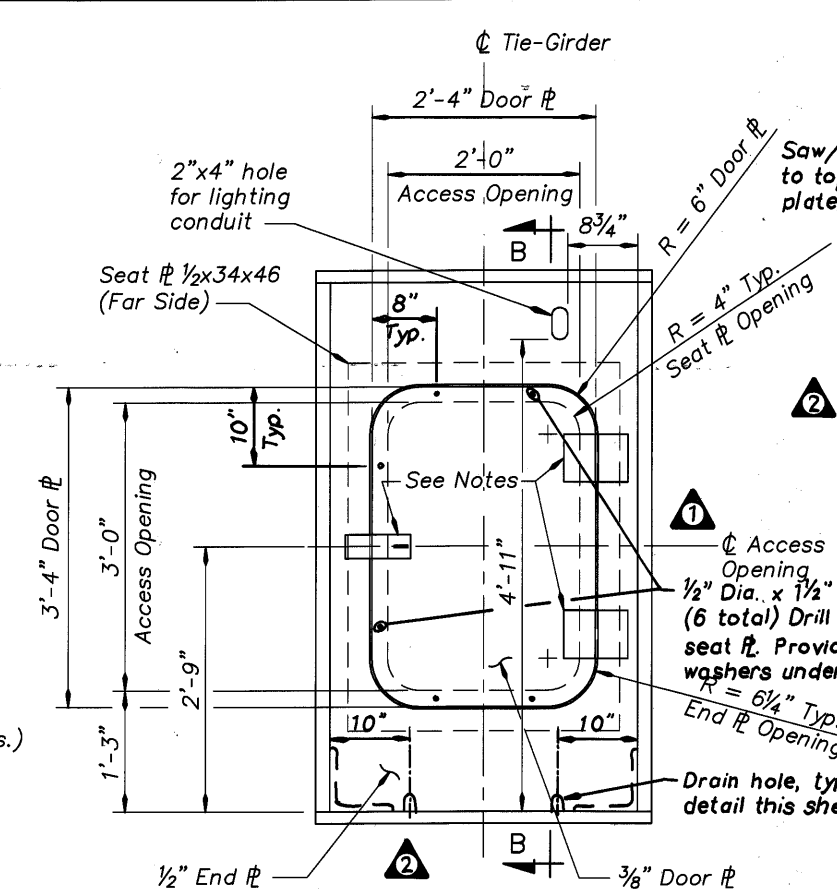

**KNUCKLE END ELEVATION**

Scale: 1" = 1'-0"

DO NOT SCALE THIS DRAWING. FOLLOW DIMENSIONS. INDICATED SCALES CORRECT ONLY FOR FULL SIZE SHEET (22"x34").

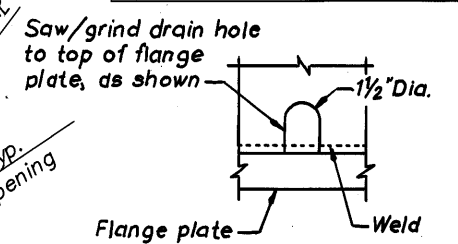

**DRAIN HOLE DETAIL**

Scale: 3" = 1'-0"

**Notes:**


For each Arch Rib access door, provide one 8'x10" heavy duty butt hinge. For each lower Arch Rib access door, also provide one padlock hasp. For each Knuckle access door, provide two 6-inch butt hinges and one padlock hasp. All hardware to be stainless steel. Make each hinge axis plumb.

Locate hasp towards the roadway.

Secure with stainless steel tamper-resistant fasteners.

Provide continuous 1/8"x2" polychloroprene seal bonded to seat plate in door frames.

See also Dwg. #70343 to #70354 for lighting conduit details.

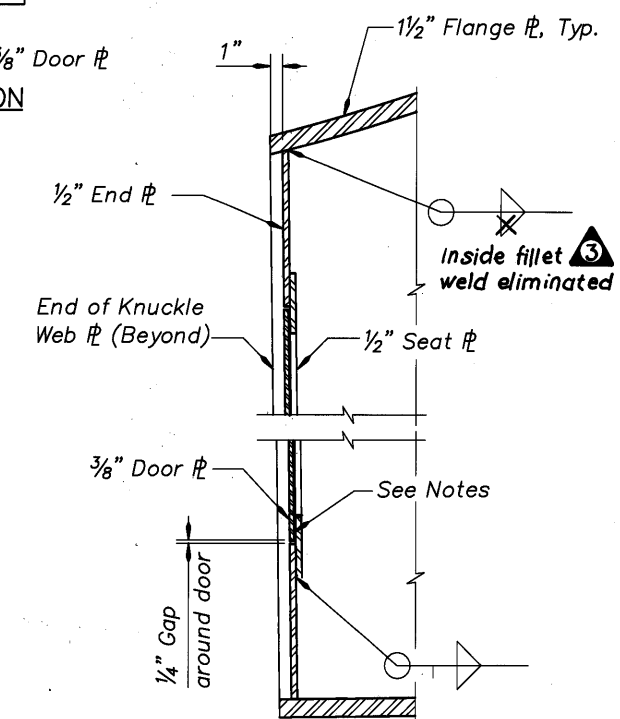

**SECTION B-B**

Scale: 1/2" = 1'-0"

**KNUCKLE/TIE-GIRDER ACCESS DOOR DETAILS**

DATE	REVISION	BY	DRAFTED:
11/06	REVISED KNUCKLE END ELEVATION	KWC	J. Patton
07/07	ADDED DRAIN HOLE DETAILS	KWC	Oliver Mueller
03/09	As-Constructed	TDF	Clifford Coulter

**REVIEWED**

REGISTERED PROFESSIONAL ENGINEER  
 74840 PE  
 OREGON  
 Burt C. Coulter  
 MARCH 09, 2005  
 WENT WILLIAM CORRELL

**DAVID EVANS AND ASSOCIATES INC.**  
 530 Center Street N.E., Suite 605  
 Salem Oregon 97301  
 Phone: 503.361.8635

EXPIRES: 12-31-05

CONNECTING COMMERCE AND COMMUNITY


**MULTNOMAH COUNTY BRIDGES**

TRANSPORTATION DIVISION

**OREGON DEPARTMENT OF TRANSPORTATION BRIDGE ENGINEERING SECTION**

BRIDGE NO. 20136	MULTNOMAH CHANNEL & PNWR ETC., SAUVIE ISLAND RD.	SHEET 66 OF 173.
DATE Sept. 2005		DRAWING NO. 70253
CALC. BOOK	ARCH AND TIE GIRDER ACCESS DETAILS	

Xref: ODOT0460\_AA\_02.dwg ODOT0460\_AD\_KN\_01.dwg












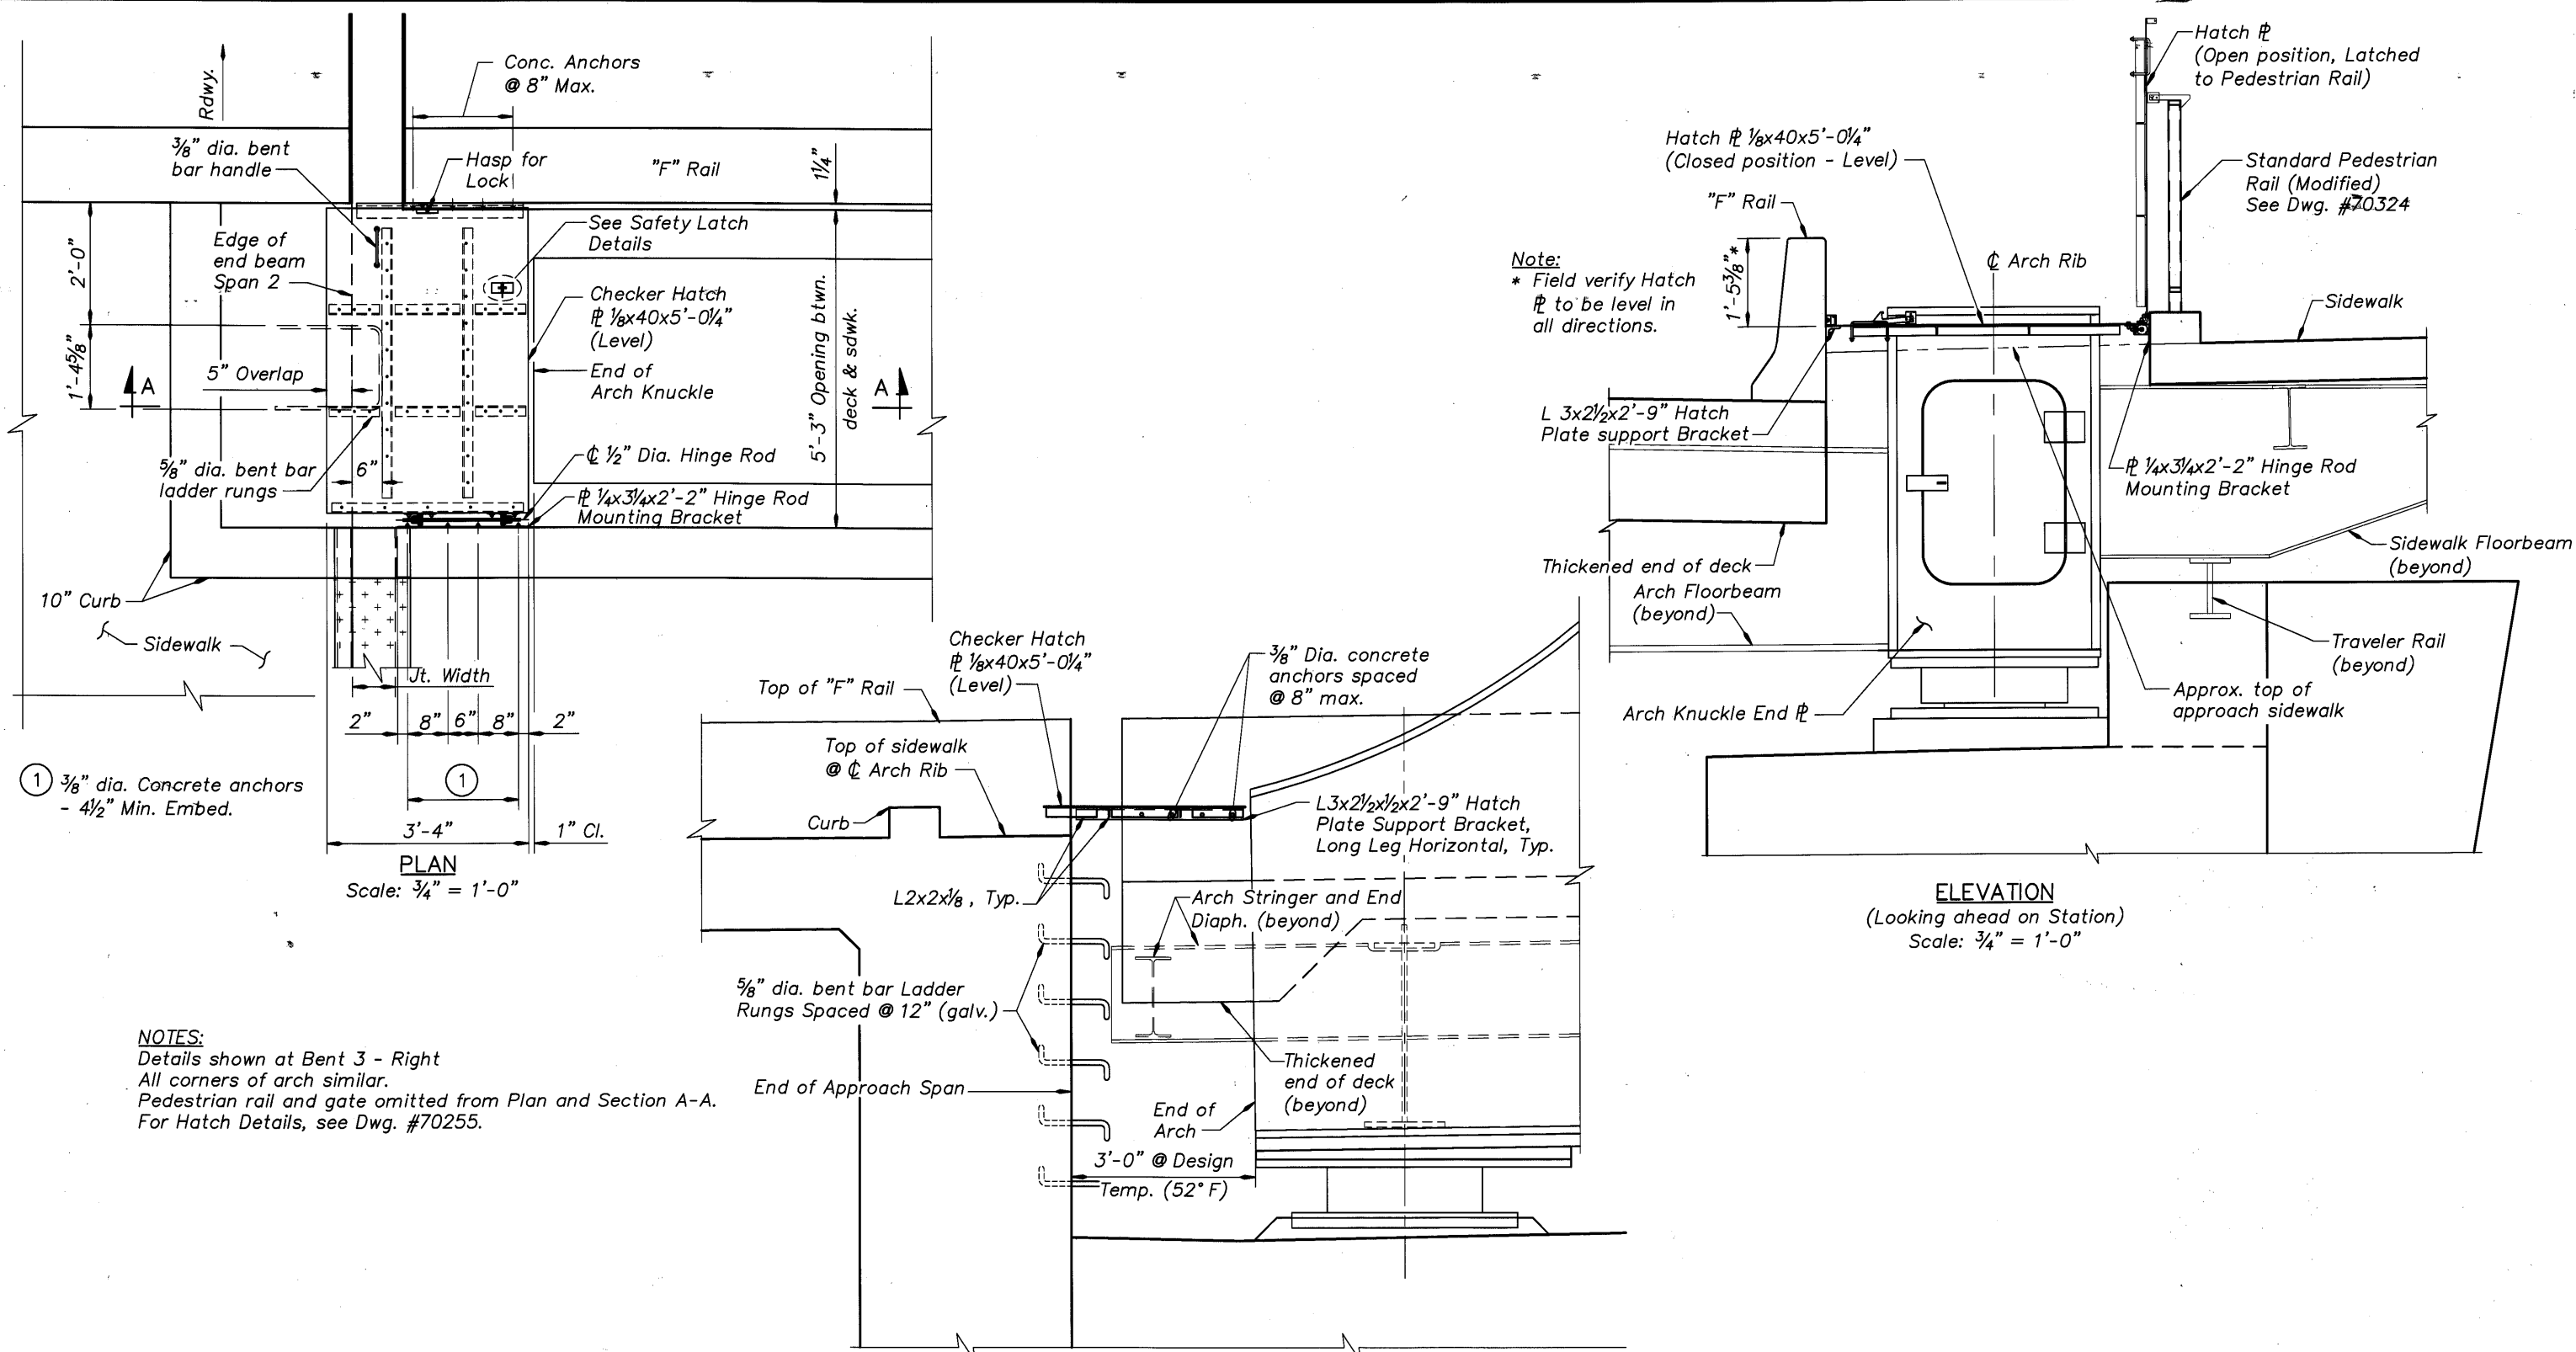


① 3/8" dia. Concrete anchors - 4 1/2" Min. Embed.


**NOTES:**  
Details shown at Bent 3 - Right  
All corners of arch similar.  
Pedestrian rail and gate omitted from Plan and Section A-A.  
For Hatch Details, see Dwg. #70255.

DO NOT SCALE THIS DRAWING.  
FOLLOW DIMENSIONS. INDICATED  
SCALES CORRECT ONLY FOR  
FULL SIZE SHEET (22"x34").

DATE	03/09	REVISION	As-Constructed	BY	J. Patton	DESIGNER			TRANSPORTATION DIVISION OREGON DEPARTMENT OF TRANSPORTATION BRIDGE ENGINEERING SECTION	BRIDGE NO.	20136	MULTNOMAH CHANNEL & PNWR ETC., SAUVIE ISLAND RD.	SHEET	67
	DRAFTED:	TDF	Checked:	Oliver Mueller	DATE						Sept. 2005			OF
REVIEWED:		Checked:	Clifford Coulter	DESIGNER	DAVID EVANS AND ASSOCIATES INC.	EXPIRES:	6-30-07		530 Center Street N.E., Suite 605 Salem Oregon 97301 Phone: 503.361.8635	CALC. BOOK		DRAWING NO.	70254	
											ACCESS DETAILS (1 OF 2)			

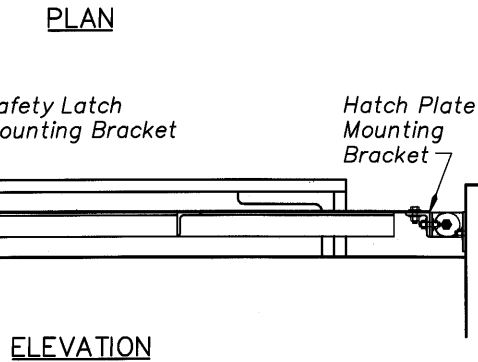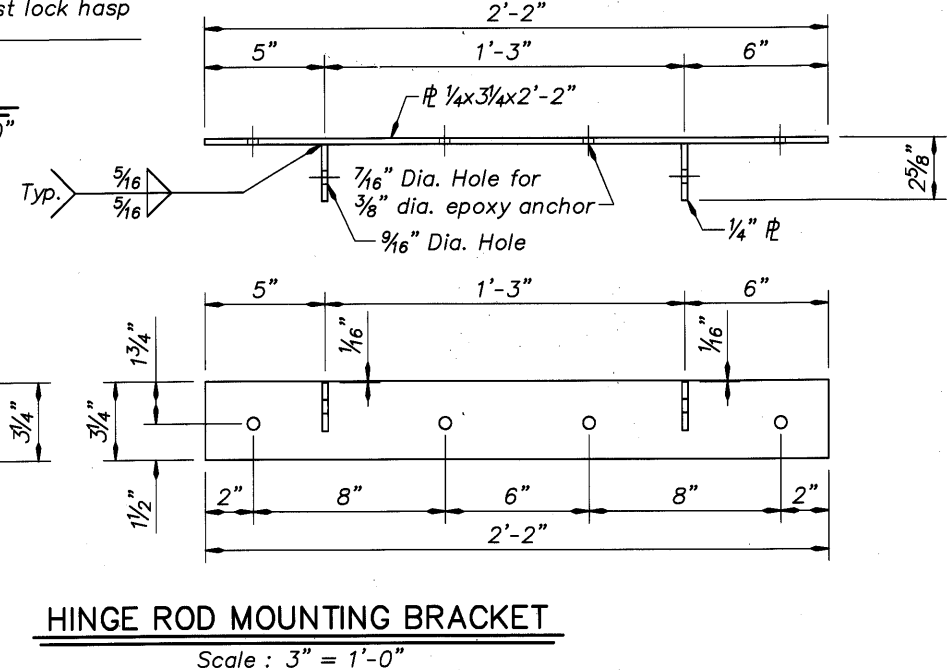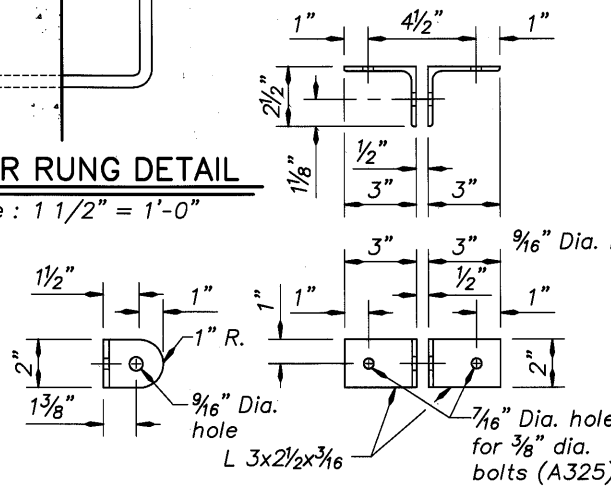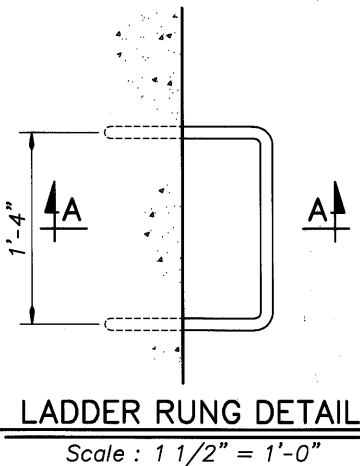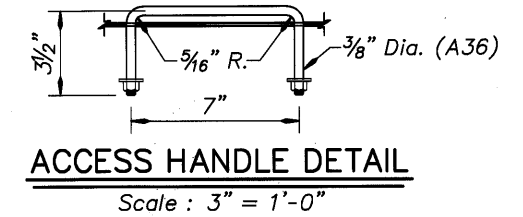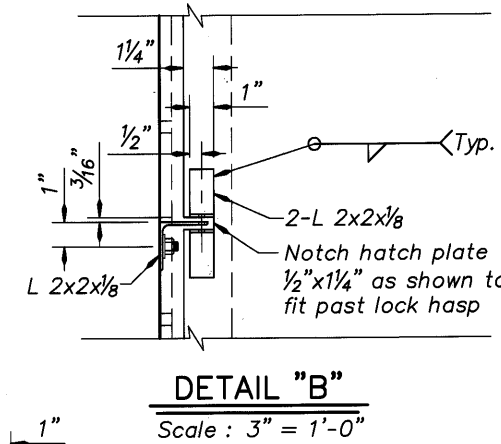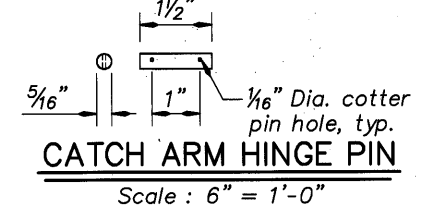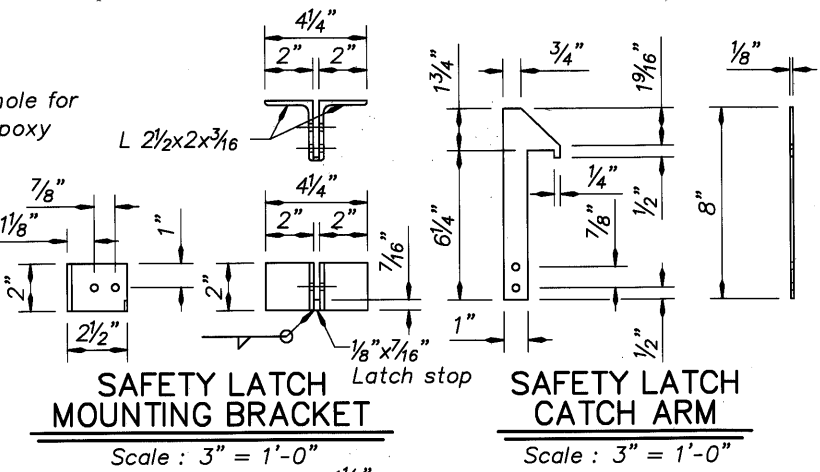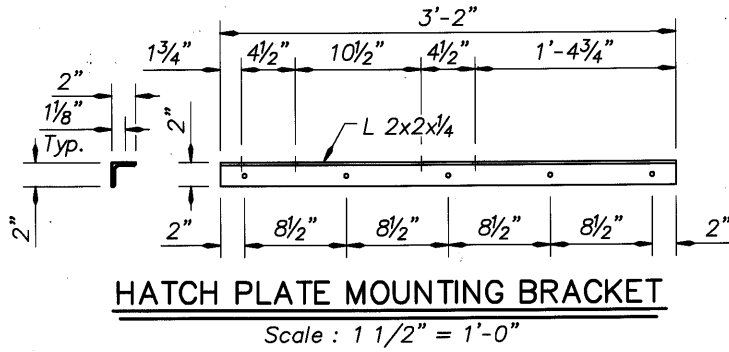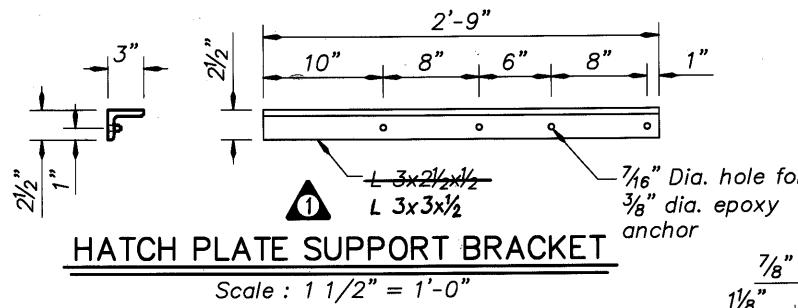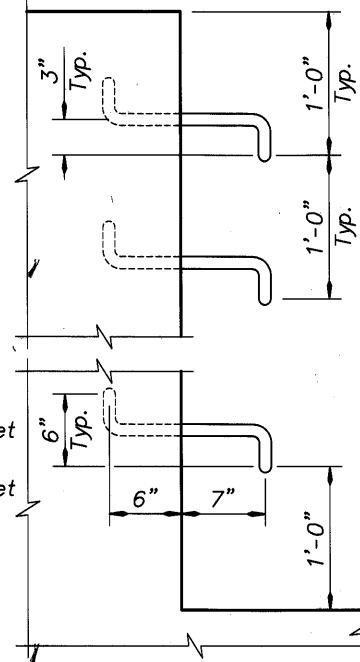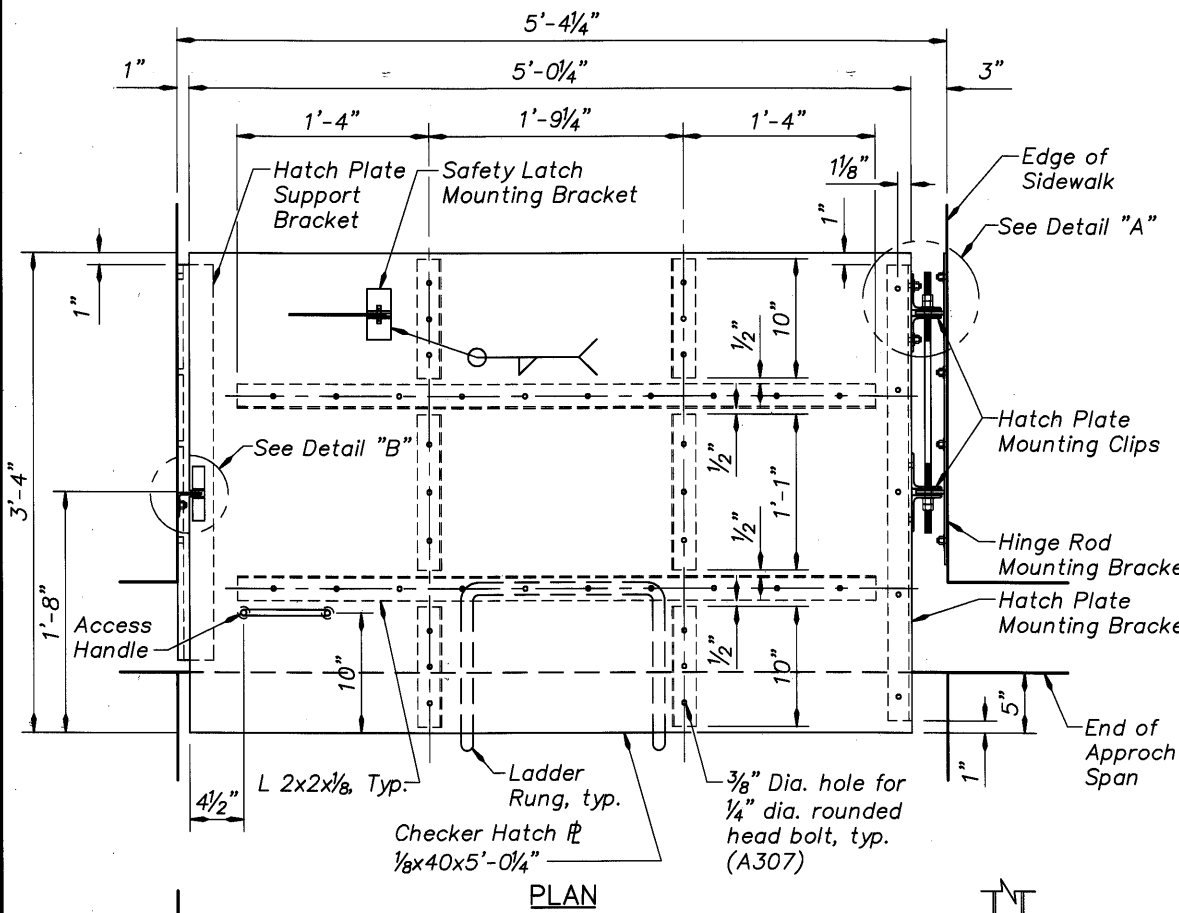

**HATCH PLATE**  
Scale: 1 1/2" = 1'-0"

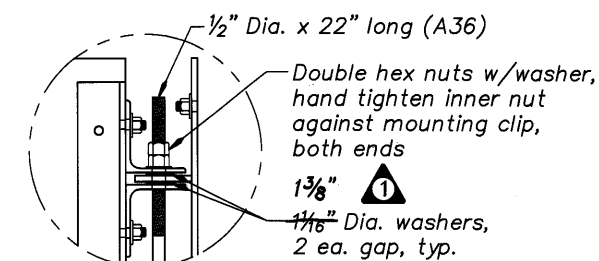

**Notes:**  
All Hatch Plate structural components and hardware shall be hot-dipped galvanized unless otherwise shown on plans.

All 3/8" dia. epoxy anchors shall have a minimum embedment of 4 1/2" into the concrete face.

Grind down any protuberances prior to welding the safety latch and locking hasps to the top of the checker plate.

DO NOT SCALE THIS DRAWING. FOLLOW DIMENSIONS. INDICATED SCALES CORRECT ONLY FOR FULL SIZE SHEET (22"x34").

DATE	REVISION	BY
03/09	As-Constructed	J. Patton
		Oliver Mueller
		Clifford Coulter

**DESIGNER**  
REGISTERED PROFESSIONAL ENGINEER  
DAVID EVANS AND ASSOCIATES INC.  
530 Center Street N.E., Suite 605  
Salem Oregon 97301  
Phone: 503.361.8635




CONNECTING COMMERCE AND COMMUNITY  
**MULTNOMAH COUNTY BRIDGES**  
TRANSPORTATION DIVISION  
OREGON DEPARTMENT OF TRANSPORTATION  
BRIDGE ENGINEERING SECTION

BRIDGE NO.	20136
DATE	Sept. 2005
CALC. BOOK	



MULTNOMAH CHANNEL & PNWR ETC., SAUVIE ISLAND RD.  
ACCESS DETAILS (2 OF 2)

SHEET	68
OF	173
DRAWING NO.	70255



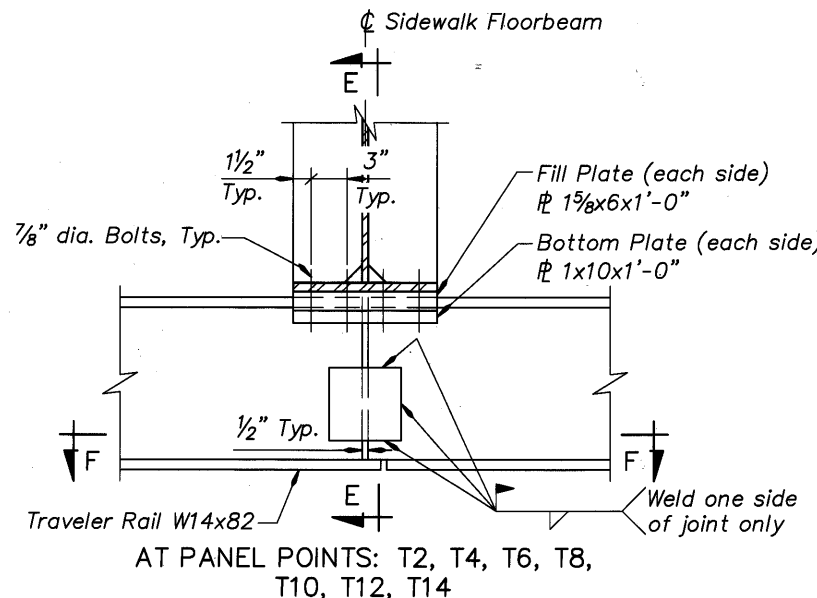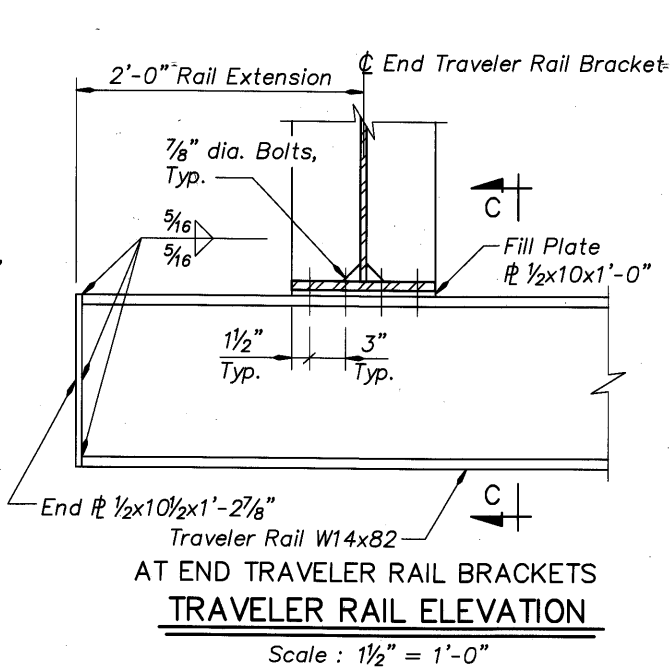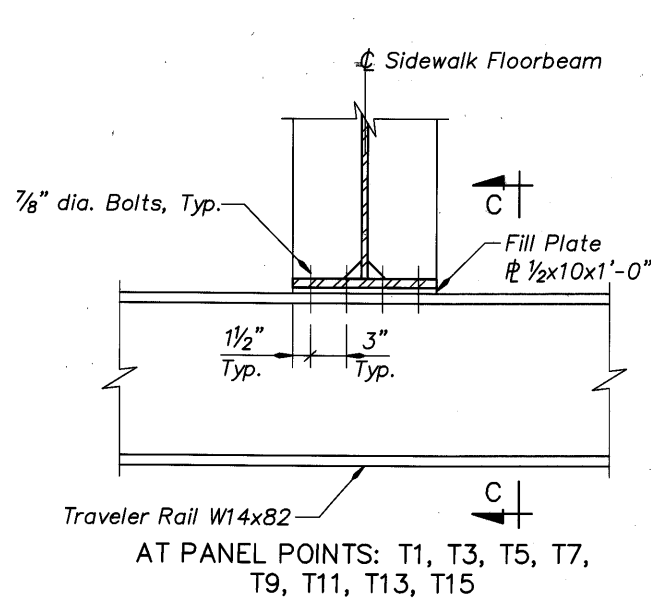

Note:  
Provide continuous W14x82 Traveler Rail between even-numbered panel points, as shown. Force will be required to conform to shape of W14x82 to vertical profile of sidewalk brackets.

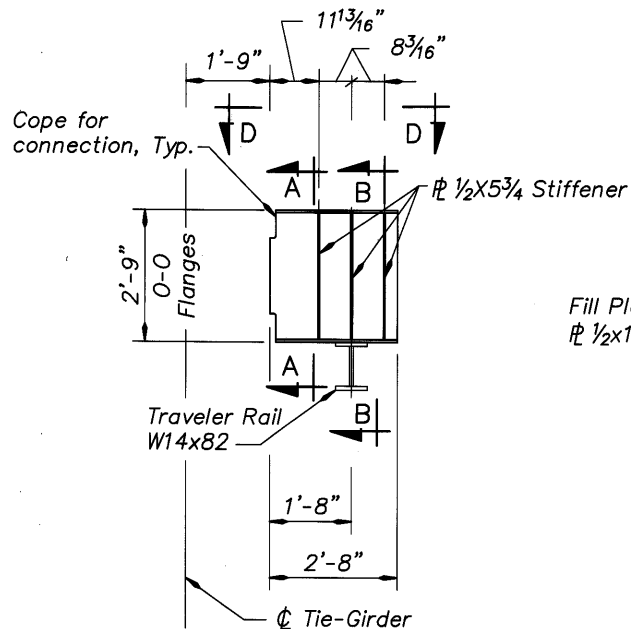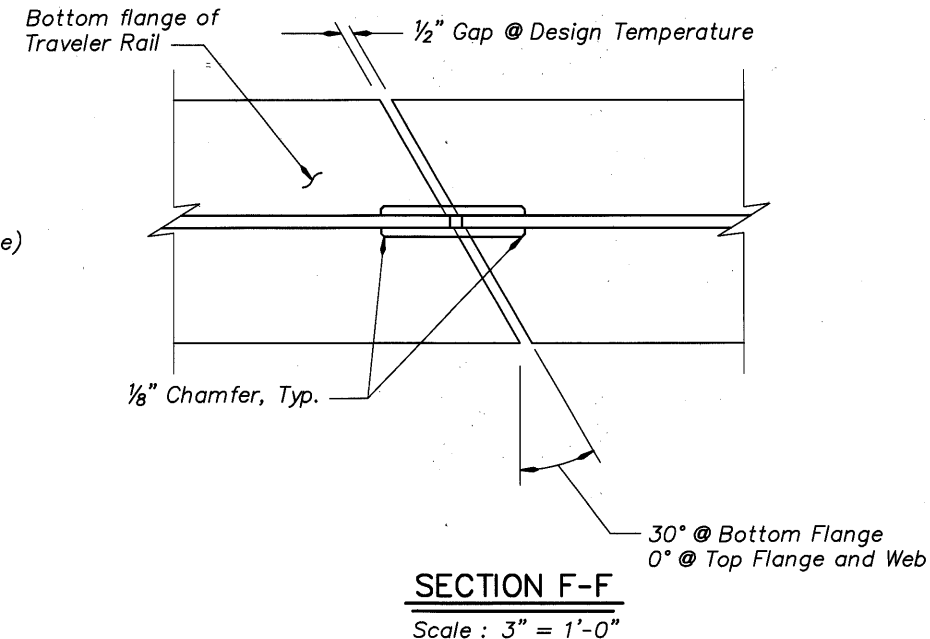


**END TRAVELER RAIL BRACKET**

Scale : 1/2" = 1'-0"


For Sections A-A, B-B, & D-D, see Dwg. #70249.

Traveler Rail Bracket connection to Knuckle is similar to typical Sidewalk Floorbeam to Tie-girder connection shown on Dwg. #70249. Add 1/8" filler  $\phi$  each side of bracket web to accommodate thicker knuckle diaphragm.

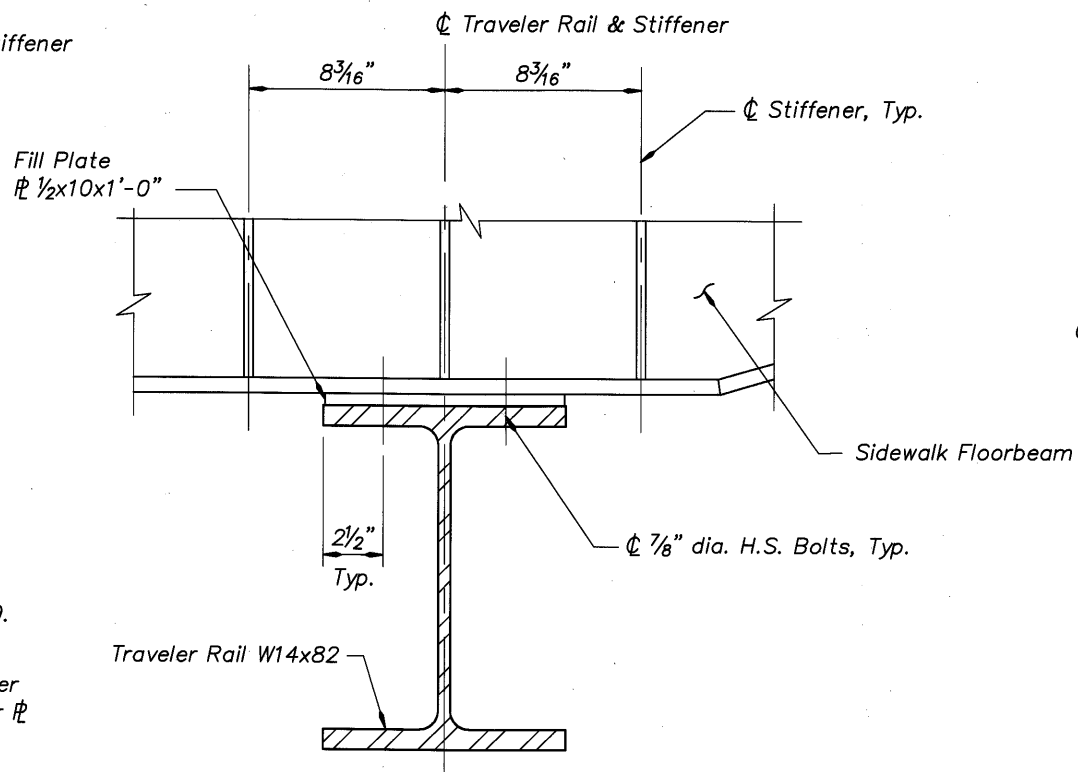

**SECTION C-C**

Scale : 3" = 1'-0"


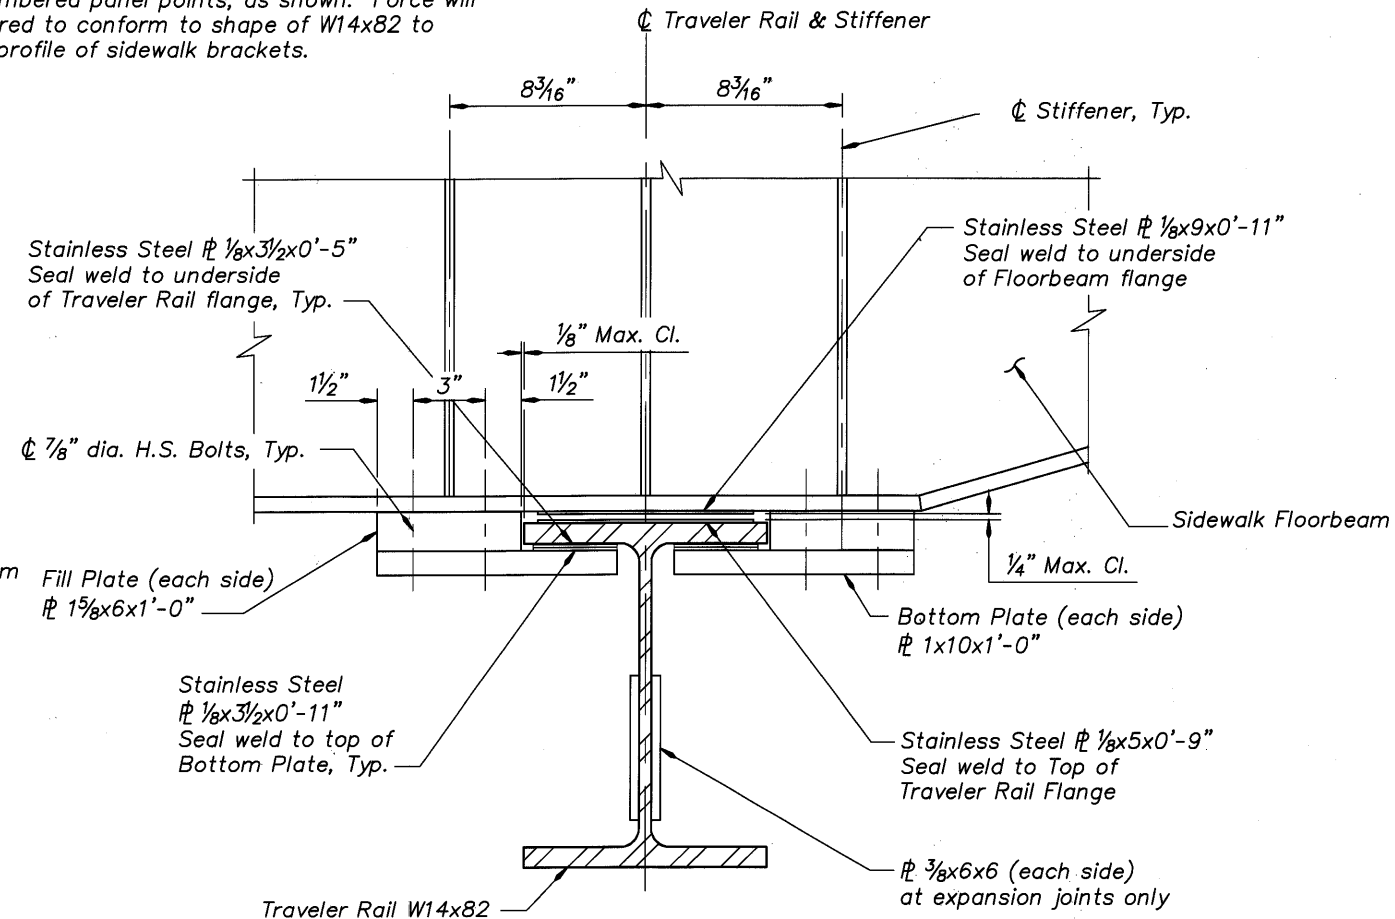


**SECTION E-E**



Scale : 3" = 1'-0"

DO NOT SCALE THIS DRAWING. FOLLOW DIMENSIONS. INDICATED SCALES CORRECT ONLY FOR FULL SIZE SHEET (22"x34").


	DATE	REVISION	BY	J. Patton			TRANSPORTATION DIVISION OREGON DEPARTMENT OF TRANSPORTATION BRIDGE ENGINEERING SECTION	BRIDGE NO.	20136	MULTNOMAH CHANNEL & PNWR ETC., SAUVIE ISLAND RD.	SHEET	69
	03/09	As-Constructed	TDF	Oliver Mueller				DATE	Sept. 2005		OF	173
				Clifford Coulter				CALC. BOOK			DRAWING NO.	70256

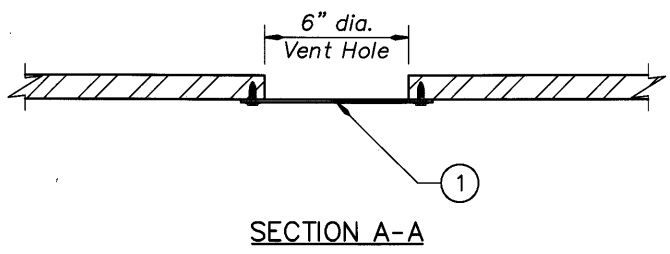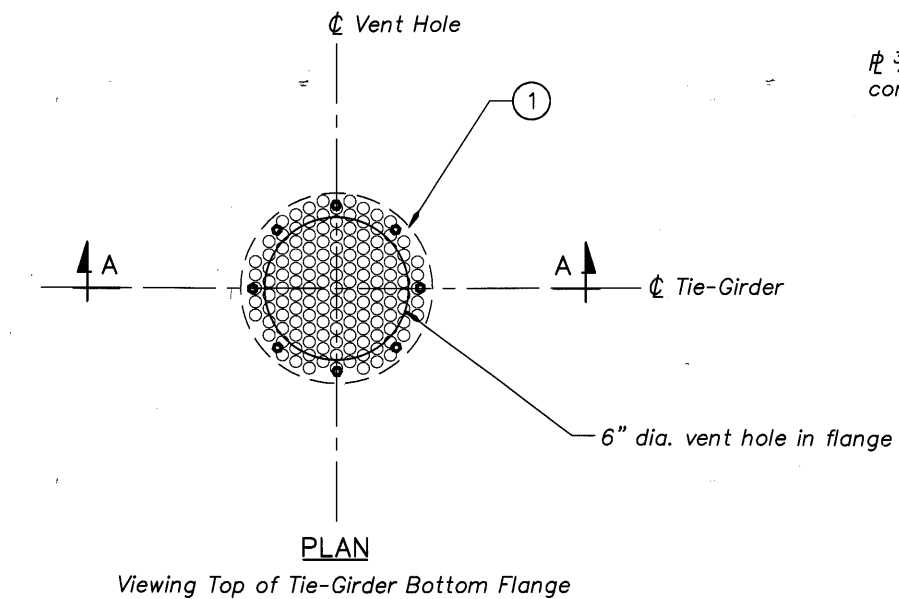


Scale: 3" = 1'-0"  
(Refer to Part-Elevation on Dwg. #70219 and #70220 for vent hole locations.)

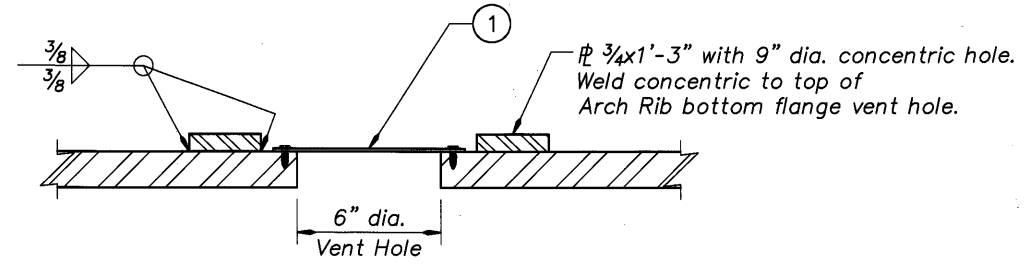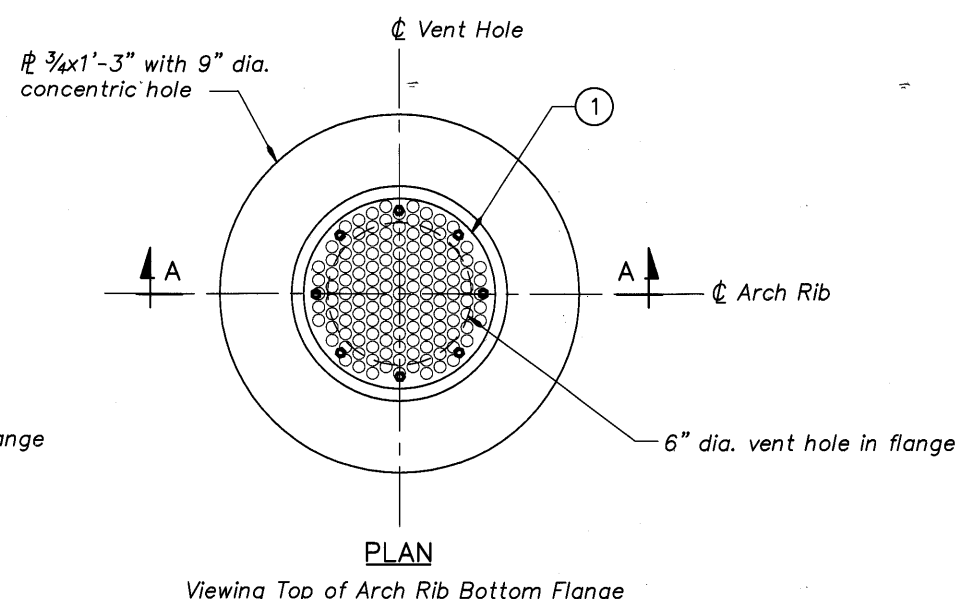

Scale: 3" = 1'-0"  
(Refer to Part-Elevation on Dwg. #70219 and #70220 for vent hole locations.)

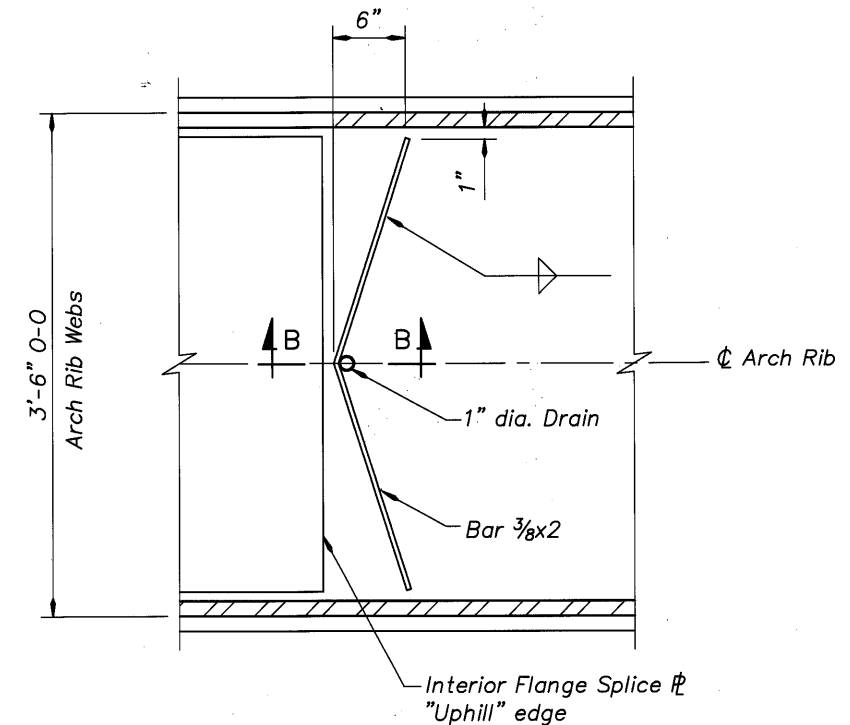



Scale: 1 1/2" = 1'-0"

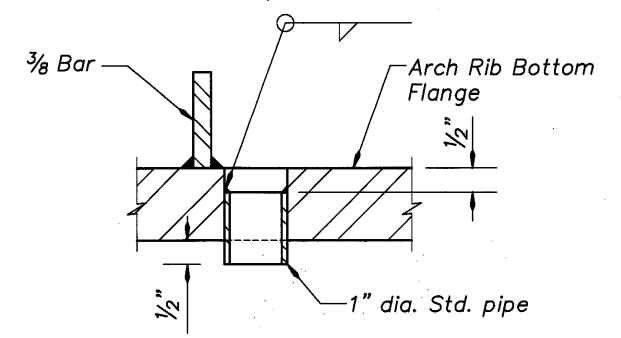

Scale: 6" = 1'-0"

Note:  
Details shown are for 1" dia. std. pipe. 2" dia. drains required in the knuckle are similar, using 2" dia. std. pipe.

1 Provide 8" dia. x min 1/8" thickness stainless steel perforated plate or flattened expanded mesh. Attach with 8 - 1/4" dia. x 1" S.S. cap screws, washers and lock washers drilled and tapped into flange.

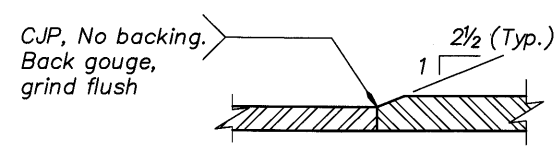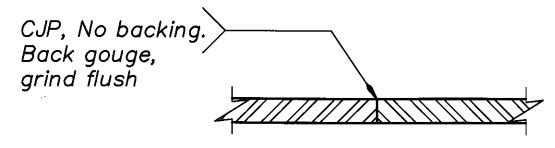



SHOP SPLICE DETAILS  
No Scale

- Notes:
1. Welded flange and web splices are permitted as shown in arch ribs, tie-girders, floorbeams, and top lateral bracing.
  2. Weld splice details also apply to tie-girder L8x8.
  3. Only one welded splice per bay (between work points) is permitted in arch rib and tie-girder web or flange plates.
  4. Do not locate any welded splice closer than 6'-0" to an arch rib or tie-girder work point.
  5. Refer to Dwg. #70237 for permissible location of welded splice in knuckle web plate.
  6. Obtain approval for all welded splice locations prior to steel fabrication.

DO NOT SCALE THIS DRAWING. FOLLOW DIMENSIONS. INDICATED SCALES CORRECT ONLY FOR FULL SIZE SHEET (22"x34").

Xref: Odette.dwg 0000460-AD-SF-01.dwg 0000460-AD-02.dwg

DATE	03/09	REVISION	As-Constructed	BY	TDF	DRAFTED:	J. Patton	REVIEWED			TRANSPORTATION DIVISION BRIDGE ENGINEERING SECTION	BRIDGE NO.	20136	MULTNOMAH CHANNEL & PNWR ETC., SAUVIE ISLAND RD.	SHEET	70
	DATE	Sept. 2005	DESIGNED:	Clifford Coulter	EXP. DATE		12-31-05					PHONE	503.361.8635		DATE	Sept. 2005
												CALC. BOOK		DRAWING NO.		70257
												MISCELLANEOUS STEEL DETAILS				

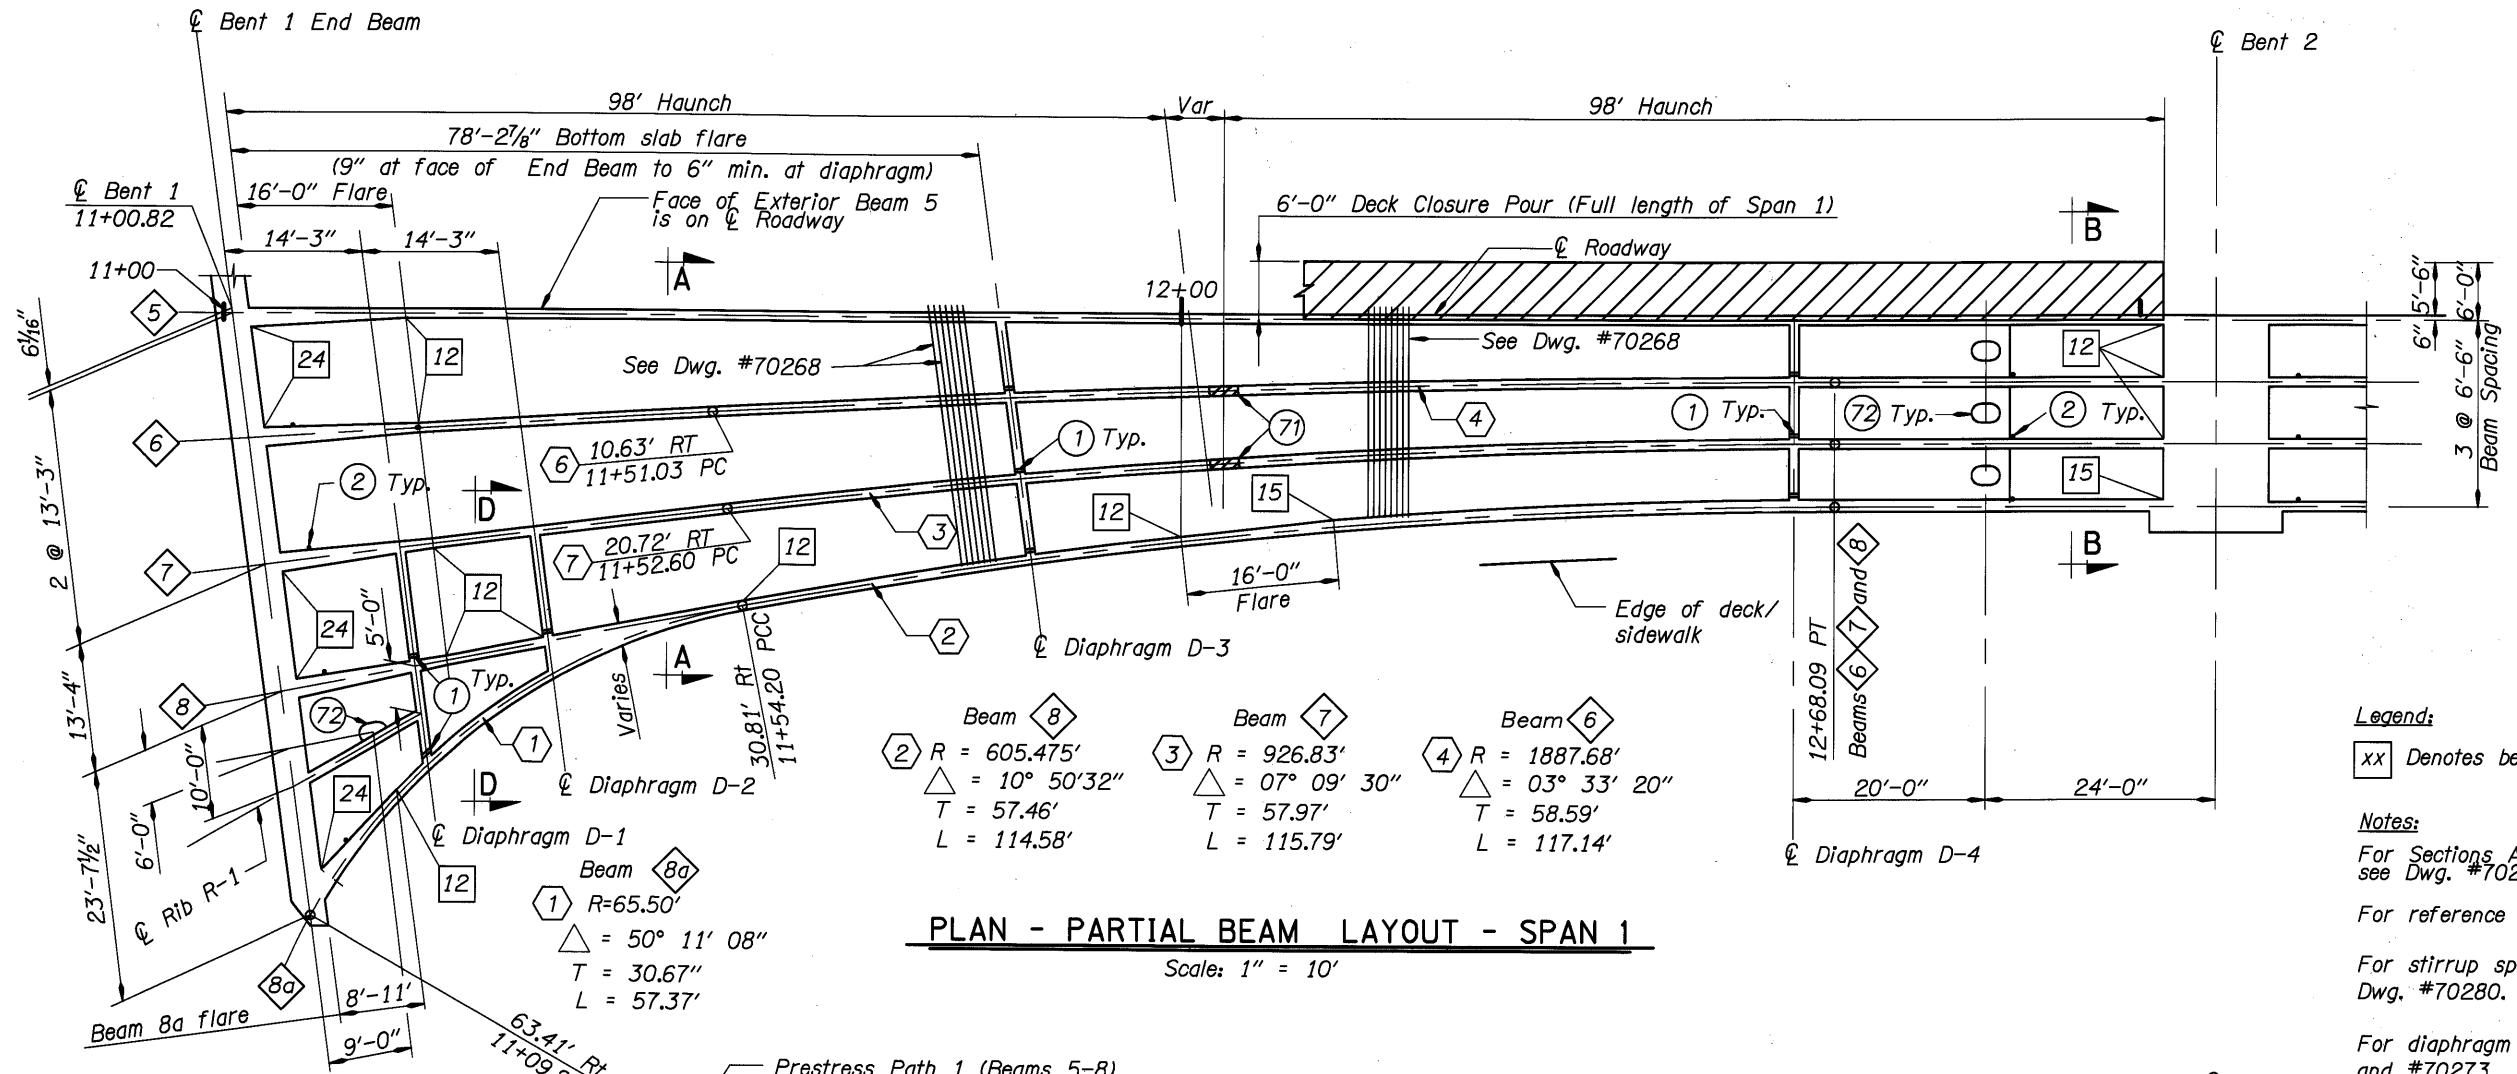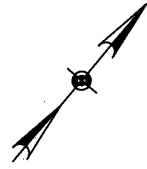

**PLAN - PARTIAL BEAM LAYOUT - SPAN 1**

Scale: 1" = 10'


**Legend:**  
xx Denotes beam stem width in inches

**Notes:**  
For Sections A-A, B-B, and D-D, see Dwg. #70262.

For reference notes, see Dwg. #70206.

For stirrup spacing and Camber diagram, see Dwg. #70280.

For diaphragm details, see Dwg. #70272 and #70273.

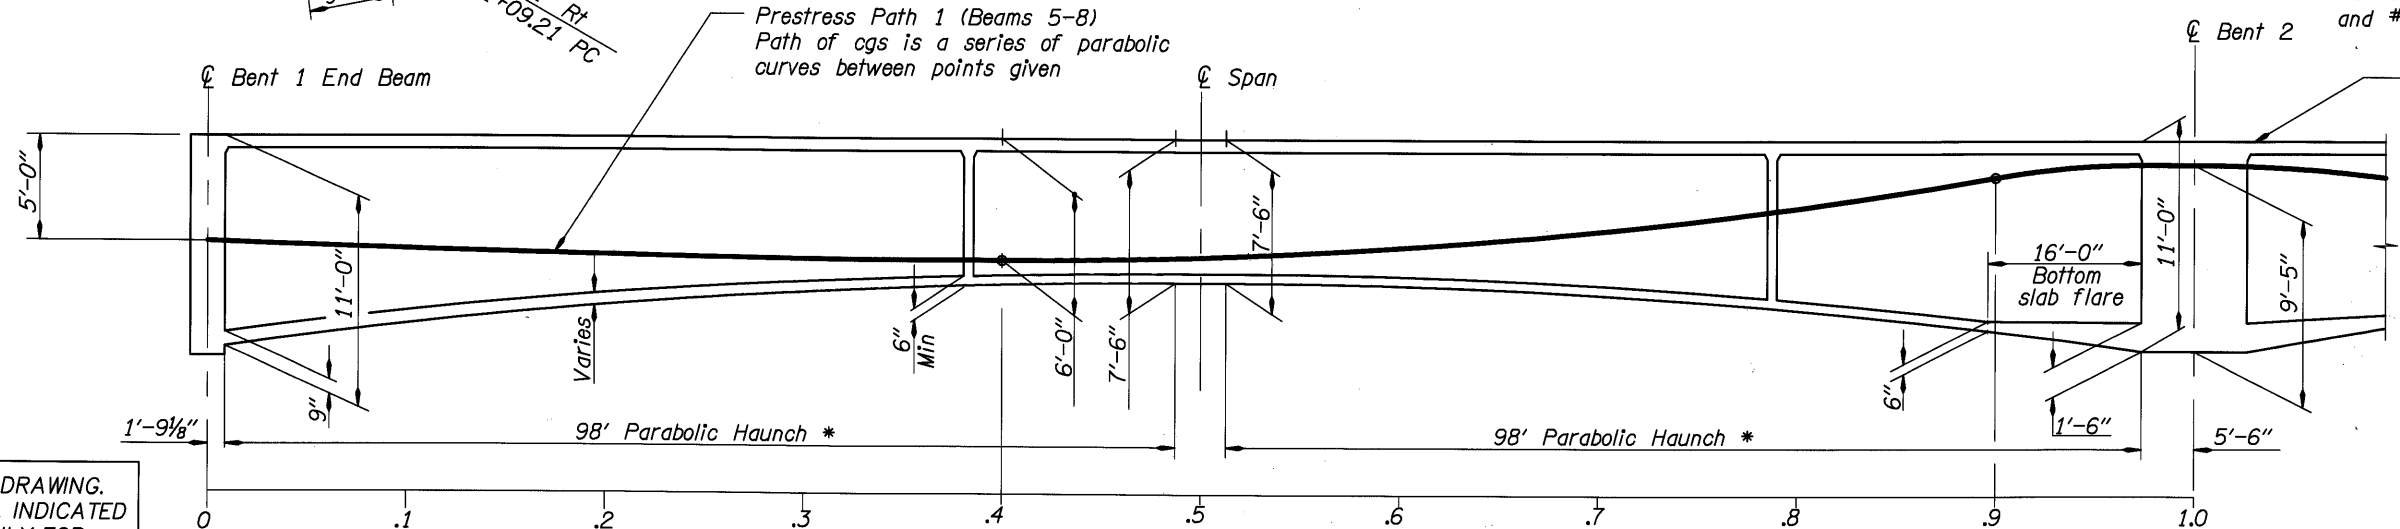

**LONGITUDINAL BEAM ELEVATION (BEAMS 5-8)**

DO NOT SCALE THIS DRAWING. FOLLOW DIMENSIONS. INDICATED SCALES CORRECT ONLY FOR FULL SIZE SHEET (22"x34").

DATE	REVISION	BY
03/09	As-Constructed	TDF

DRAFTED: Ken Johnson  
 CHECKED: Gernot Komar  
 DESIGNED: Josh Hewes


**REVIEWED**  
  
**DAVID EVANS AND ASSOCIATES, INC.**  
 530 Center Street N.E., Suite 605  
 Salem Oregon 97301  
 Phone: 503.361.8635

No Scale  
 CONNECTING COMMERCIAL AND COMMUNITY  
  
 TRANSPORTATION DIVISION

BRIDGE NO.	20136
DATE	Sept. 2005
CALC. BOOK	

MULTNOMAH CHANNEL & PNWR ETC., SAUVIE ISLAND RD.  
**LONGITUDINAL BEAM LAYOUT SPAN 1 RIGHT SIDE**

SHEET 71 OF 173  
 DRAWING NO. 70258

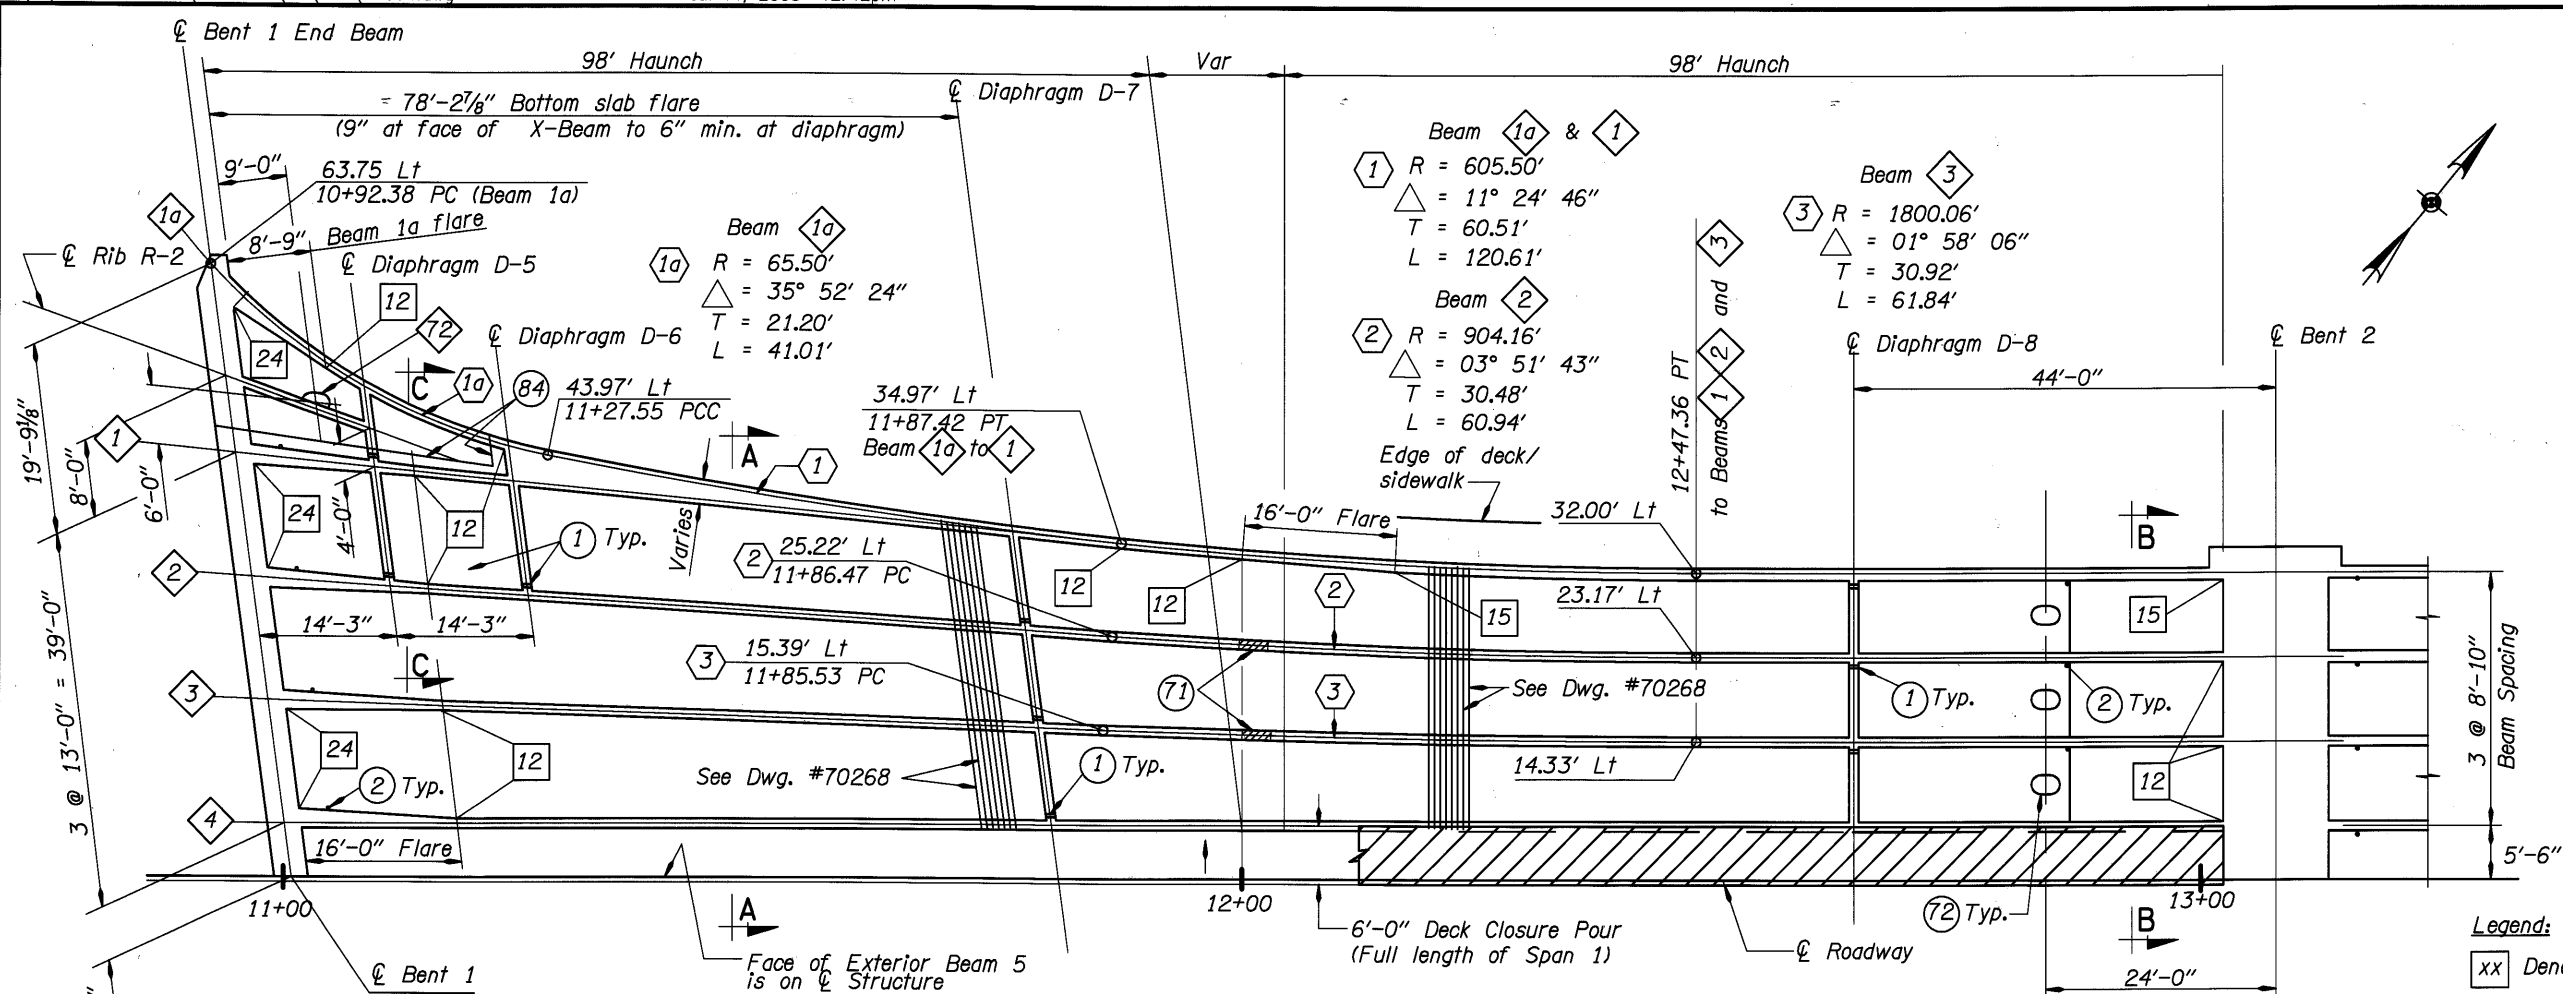


**PLAN - PARTIAL BEAM LAYOUT - SPAN 1**  
Scale: 1"=10'

**Legend:**  
xx Denotes beam stem width in inches

\* Haunch length measured parallel to  $\phi$  Roadway, see "Plan-Partial Beam Layout-Span 1"


**Notes:**  
For Sections A-A, B-B, and C-C, see Dwg. #70262.  
For reference notes, see Dwg. #70206.  
For stirrup spacing and Camber Diagram, see Dwg. #70280.  
For diaphragm details, see Dwg. #70272 and #70273.

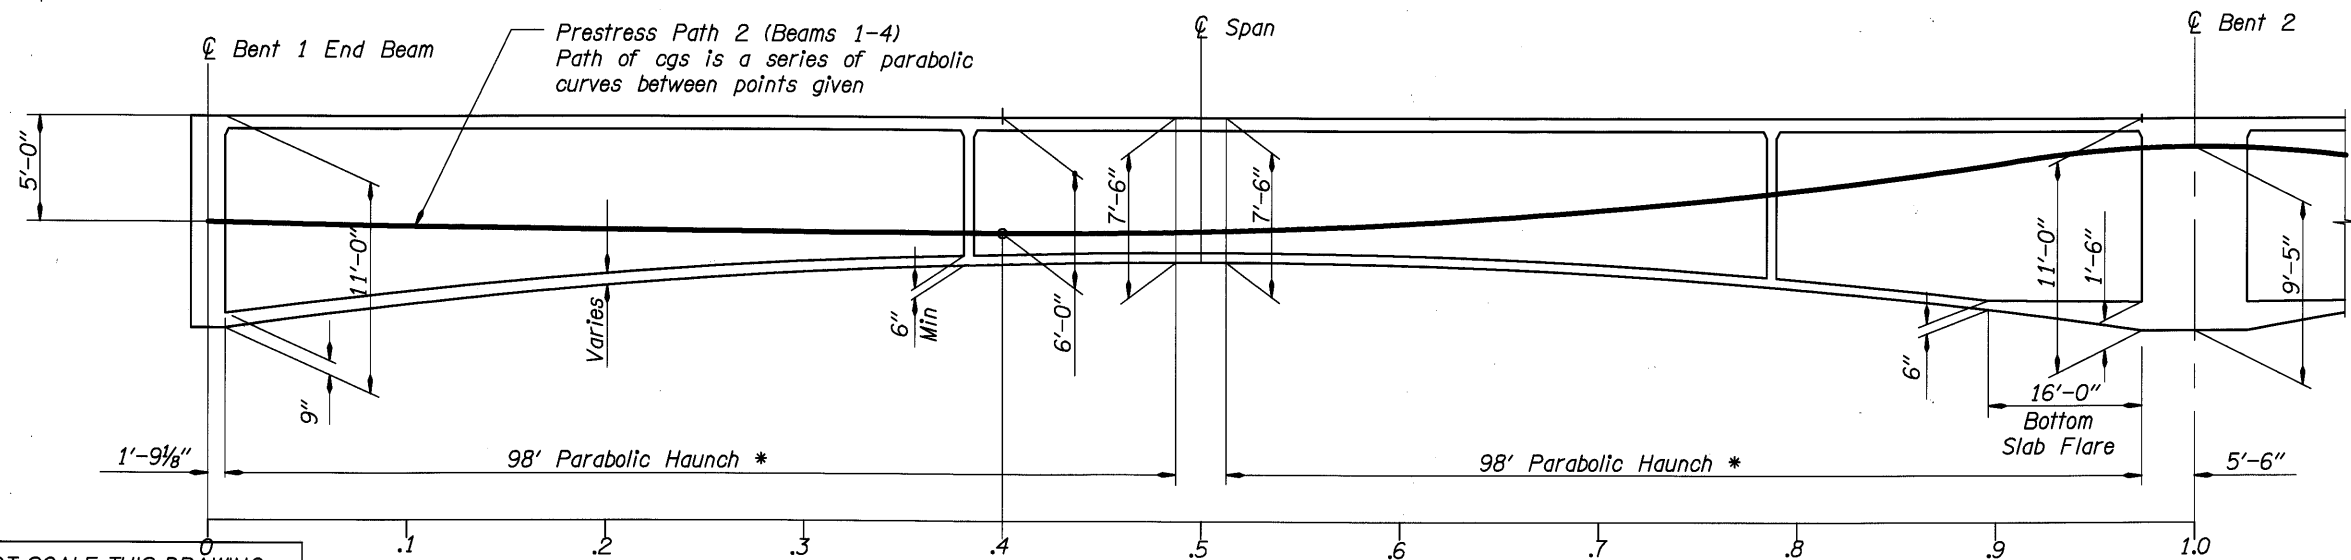

**LONGITUDINAL BEAM ELEVATION (BEAMS 1-4)**  
No Scale


DO NOT SCALE THIS DRAWING. FOLLOW DIMENSIONS. INDICATED SCALES CORRECT ONLY FOR FULL SIZE SHEET (22"x34").

<table border="1"> <tr> <th>DATE</th> <th>REVISION</th> <th>BY</th> </tr> <tr> <td>03/09</td> <td>As-Constructed</td> <td>TDF</td> </tr> </table>	DATE	REVISION	BY	03/09	As-Constructed	TDF	DRAFTED: Ken Johnson CHECKED: Gernot Komar DESIGNED: Josh Hewes	<table border="1"> <tr> <th>REVIEWED</th> </tr> <tr> <td>                  DAVID EVANS AND ASSOCIATES INC.                  530 Center Street N.E., Suite 605                  Salem Oregon 97301                  Phone: 503.361.8635                  EXPIRES: 12-31-05             </td> </tr> </table>	REVIEWED	DAVID EVANS AND ASSOCIATES INC. 530 Center Street N.E., Suite 605 Salem Oregon 97301 Phone: 503.361.8635 EXPIRES: 12-31-05	<table border="1"> <tr> <th>BRIDGE NO.</th> <td>20136</td> </tr> <tr> <th>DATE</th> <td>Sept. 2005</td> </tr> <tr> <th>CALC. BOOK</th> <td></td> </tr> </table>	BRIDGE NO.	20136	DATE	Sept. 2005	CALC. BOOK		MULTNOMAH COUNTY TRANSPORTATION DIVISION OREGON DEPARTMENT OF TRANSPORTATION BRIDGE ENGINEERING SECTION	MULTNOMAH CHANNEL & PNWR ETC., SAUVIE ISLAND RD.	SHEET 72 OF 173
	DATE	REVISION	BY																	
03/09	As-Constructed	TDF																		
REVIEWED																				
DAVID EVANS AND ASSOCIATES INC. 530 Center Street N.E., Suite 605 Salem Oregon 97301 Phone: 503.361.8635 EXPIRES: 12-31-05																				
BRIDGE NO.	20136																			
DATE	Sept. 2005																			
CALC. BOOK																				
LONGITUDINAL BEAM LAYOUT SPAN 1 LEFT SIDE					DRAWING NO. 70259															

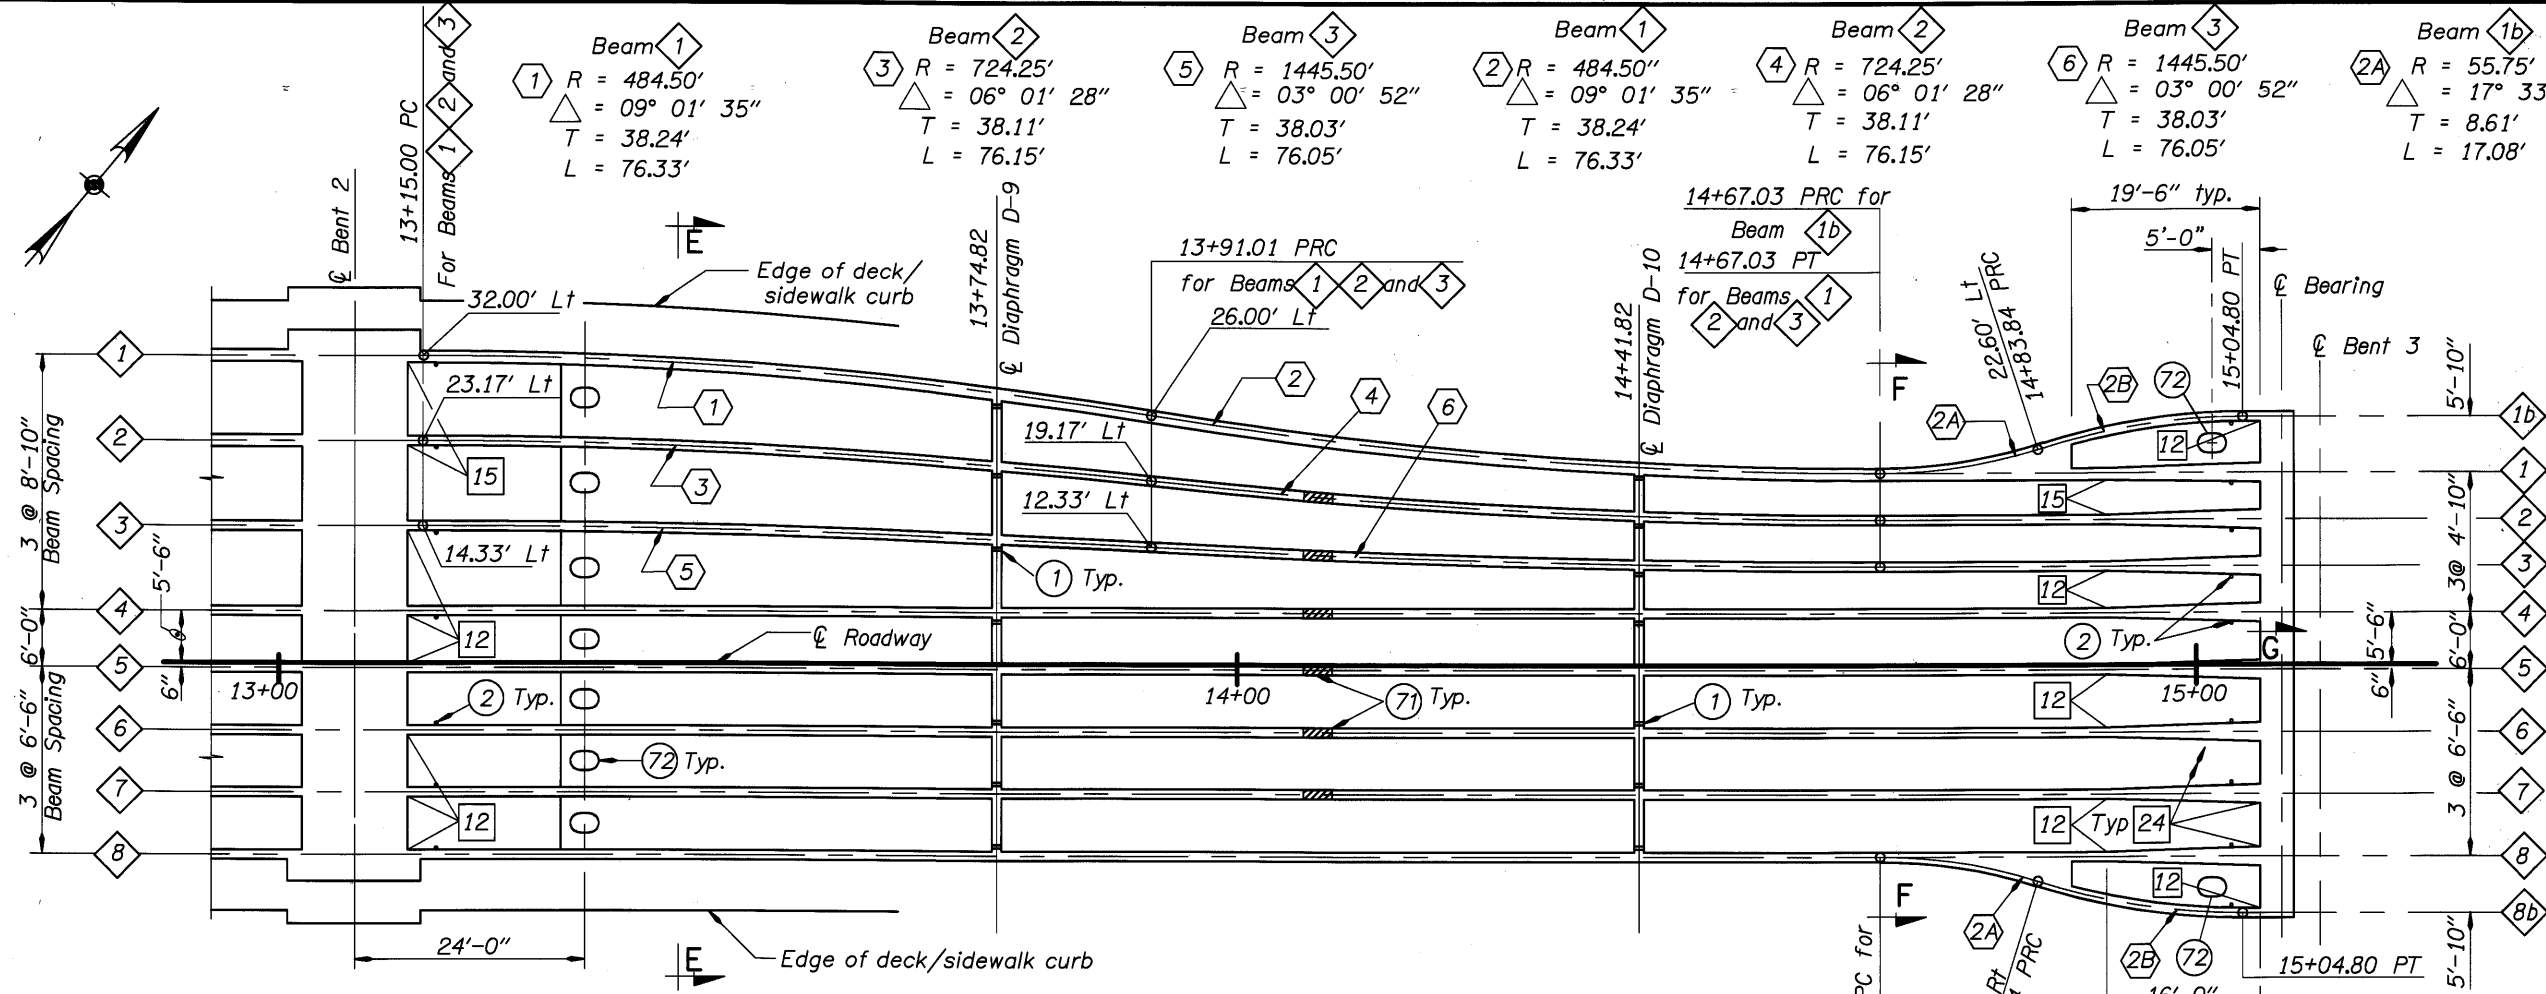

**LONGITUDINAL BEAM LAYOUT**

Scale: 1=10'

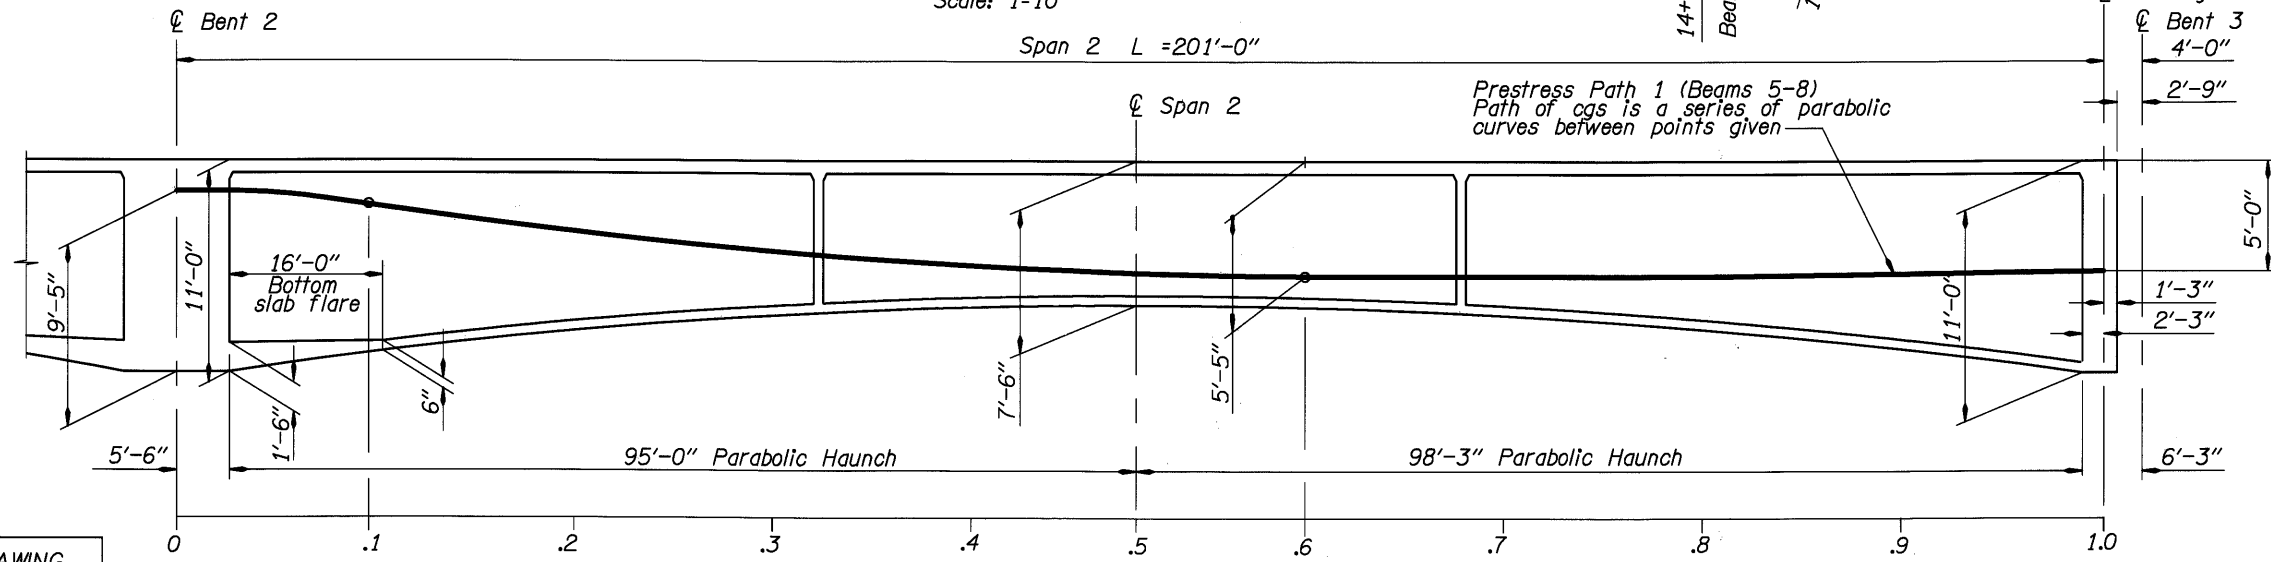


**LONGITUDINAL BEAM ELEVATION (BEAMS 5-8)**

No Scale

- Legend:**  
xx Denotes beam stem width in inches
- Notes:**  
For Sections E-E, F-F, and G-G, see Dwg. #70264.  
For reference notes, see Dwg. #70206.  
For stirrup spacing and Camber Diagram, see Dwg. #70280.  
For Diaphragm details, see Dwg. #70273.  
For beams 9a and 13a reinforcement details, see Dwg. #70266 and #70267.

DO NOT SCALE THIS DRAWING. FOLLOW DIMENSIONS. INDICATED SCALES CORRECT ONLY FOR FULL SIZE SHEET (22"x34").

DATE 03/09	REVISION As-Constructed	BY TDF	DRAFTED: Ken Johnson			BRIDGE NO. 20136	SHEET 73 OF 173	
			CHECKED: Gernot Komar					TRANSPORTATION DIVISION
			DESIGNED: Josh Hewes			CALC. BOOK	DRAWING NO. 70260	
MULTNOMAH CHANNEL & PNWR ETC., SAUVIE ISLAND RD.							LONGITUDINAL BEAM LAYOUT SPAN 2 (1 OF 2)	

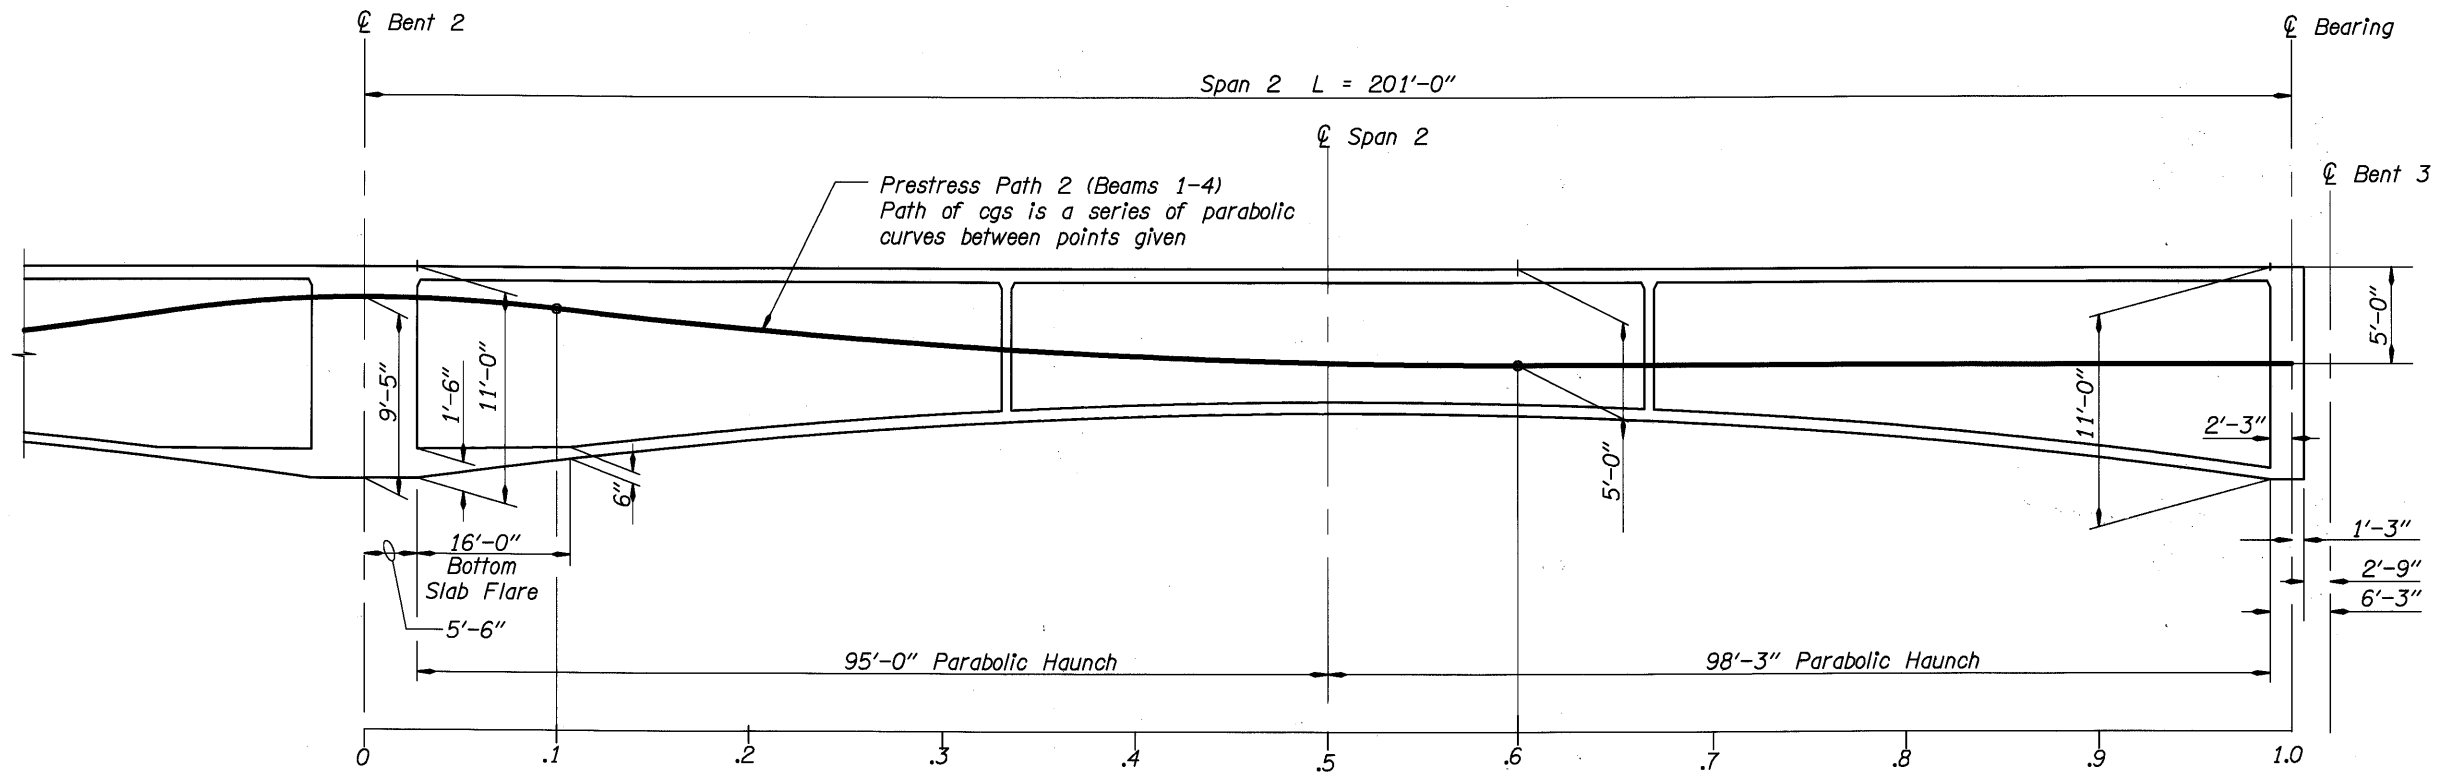



**ELEVATION-LONGITUDINAL (BEAMS 1-4)**

No Scale

**Notes:**  
For stirrup spacing and Camber Diagram, see Dwg. #70280.


DO NOT SCALE THIS DRAWING. FOLLOW DIMENSIONS. INDICATED SCALES CORRECT ONLY FOR FULL SIZE SHEET (22"x34").

DATE	03/09	REVISION	As-Constructed	BY	Ken Johnson	REVIEWED				TRANSPORTATION DIVISION	BRIDGE NO.	20136	MULTNOMAH CHANNEL & PNWR ETC., SAUVIE ISLAND RD.	SHEET	74
	DRAFTED:		TDF		Gernot Komar						CHECKED:	Josh Hewes		DESIGNED:	DATE
											CALC. BOOK		LONGITUDINAL BEAM LAYOUT	DRAWING NO.	70261
													SPAN 2 (2 OF 2)		

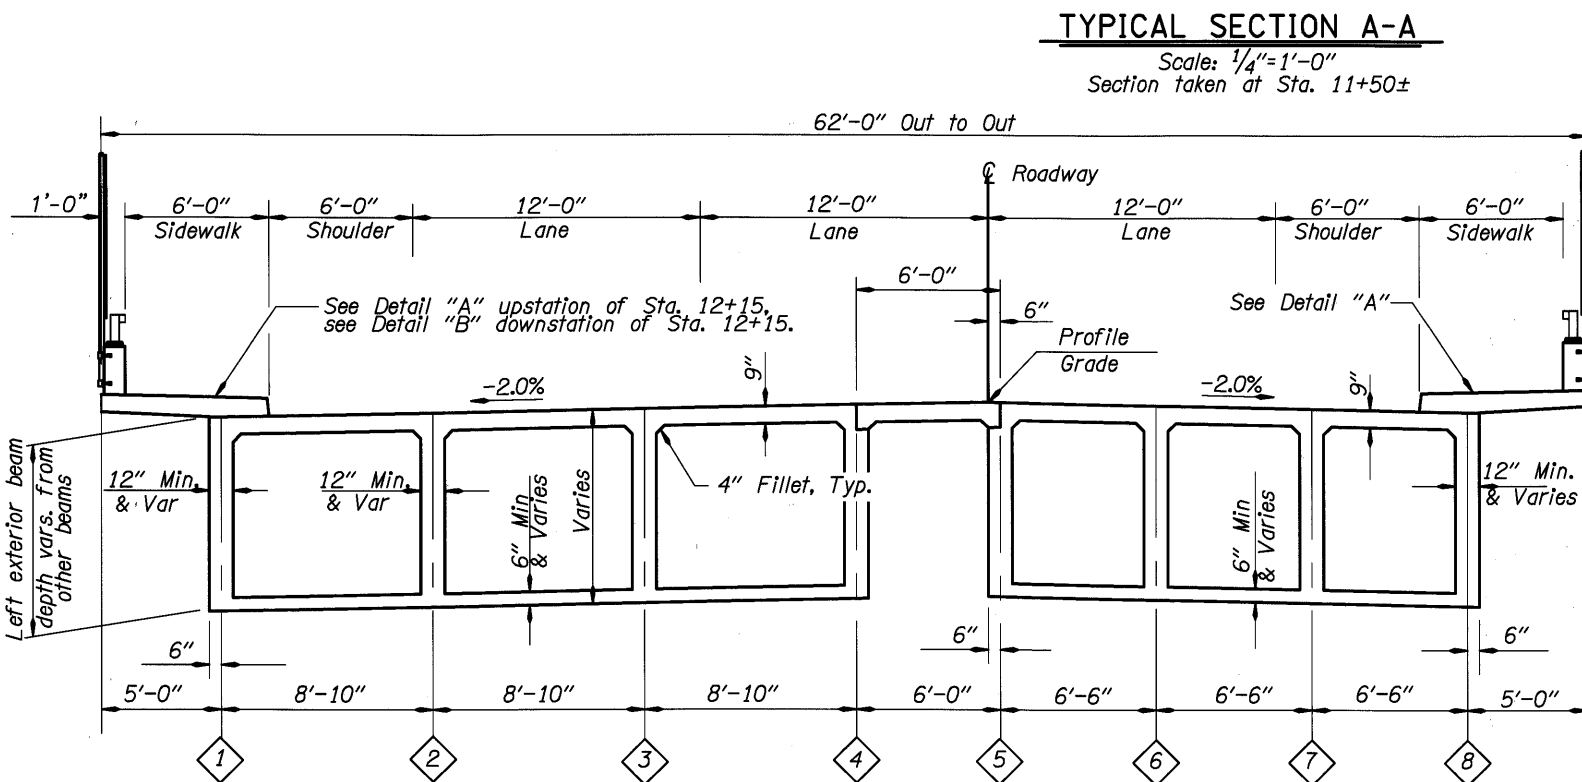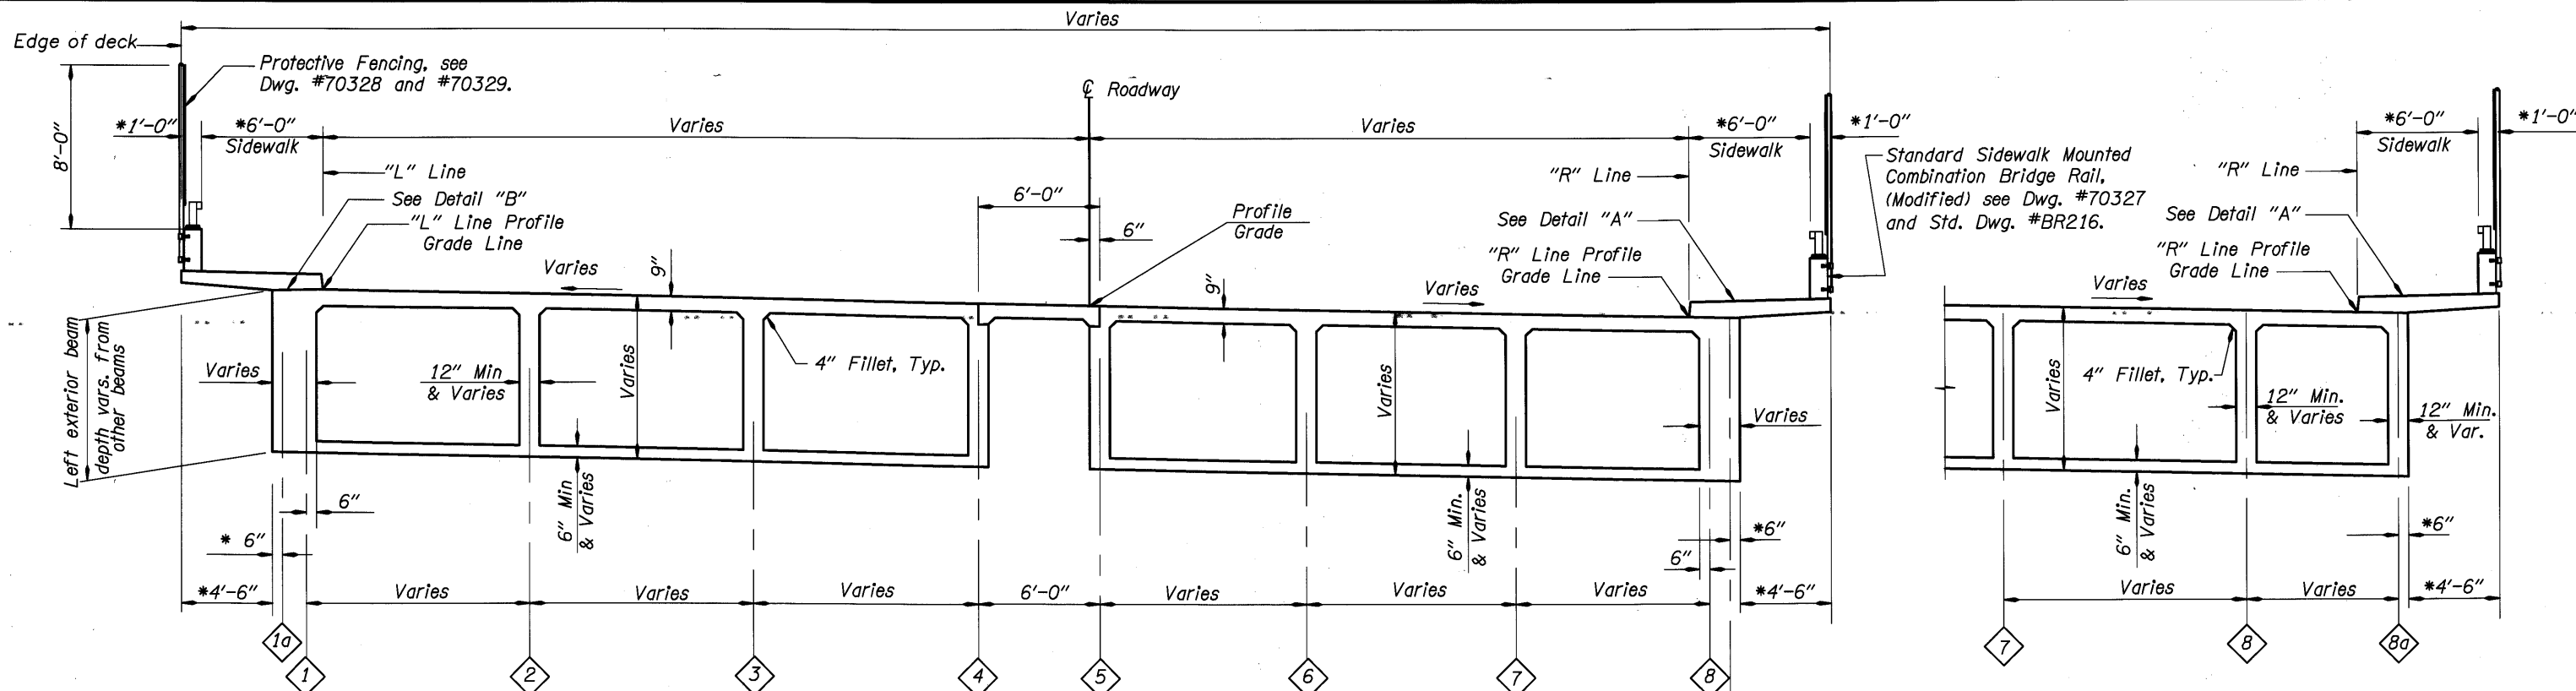

**Note:**  
See Dwg. #BR135 and #BR136 for details of vent tube through stem.  
See Dwg. #70263 for Detail "A" and Detail "B"  
See Dwg. #70336 and #70337 for deck drainage details.  
See Dwg. #70343 to #70355 for lighting details and conduit locations.  
See Dwg. #70360 for utility conduit and hanger details.

**Legend:**  
\* x'-x" Denotes dimensions measured normal to edge of deck

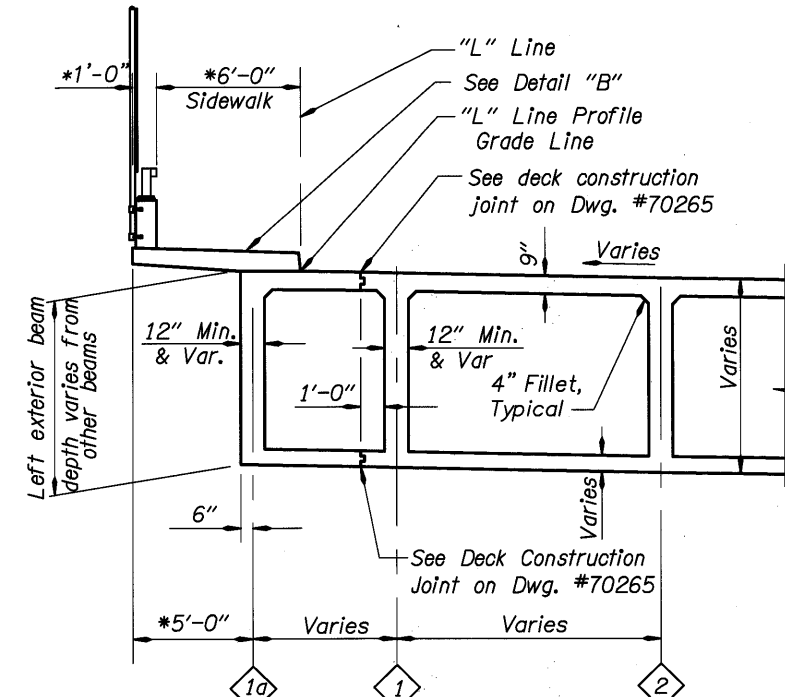


DO NOT SCALE THIS DRAWING.  
FOLLOW DIMENSIONS. INDICATED  
SCALES CORRECT ONLY FOR  
FULL SIZE SHEET (22"x34").

DATE 03/09	REVISION As-Constructed	BY TDF	DRAFTED: Ken Johnson	REVIEWED  DAVID EVANS AND ASSOCIATES INC. 530 Center Street N.E., Suite 605 Salem Oregon 97301 Phone: 503.361.8635	CONNECTING COMMERCE AND COMMUNITY  MULTNOMAH COUNTY BRIDGES	TRANSPORTATION DIVISION	BRIDGE NO. 20136	SHEET 75 OF 173
			CHECKED: Gernot Komar				OREGON DEPARTMENT OF TRANSPORTATION BRIDGE ENGINEERING SECTION	
		DESIGNED: Josh Hewes	EXPIRES: 12-31-05				CALC. BOOK	DRAWING NO. 70262
							TYPICAL SECTIONS - SPAN 1 (1 OF 2)	





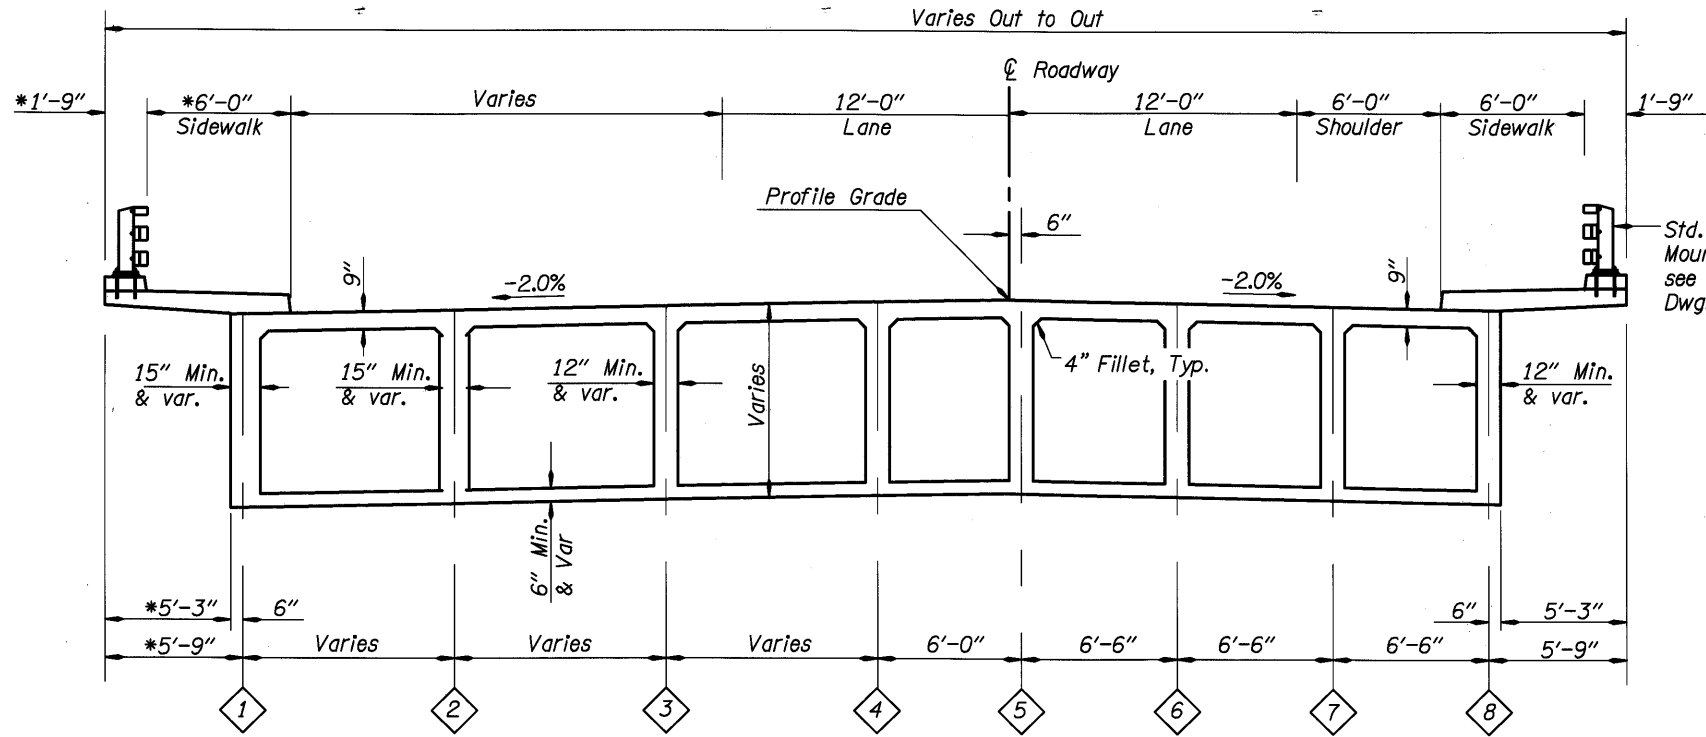

Std. 3 Tube Curb Mounted Rail (Modified), see Dwg. #70324 and Dwg. #70327

**Legend:**


\*x'-x" Denotes dimensions measured normal to edge of deck.

**Notes:**

- See Dwg. #BR135 and BR136 for details of vertical tubes through stems.
- See Dwg. #70336 and #70337 for deck drainage details.
- See Dwg. #70343 to #70355 for lighting details and conduit locations.
- See Dwg. #70360 for utility conduit and hanger details.

**TYPICAL SECTION E-E**


Scale: 1/4"=1'-0"  
Section taken at Sta. 13+35±

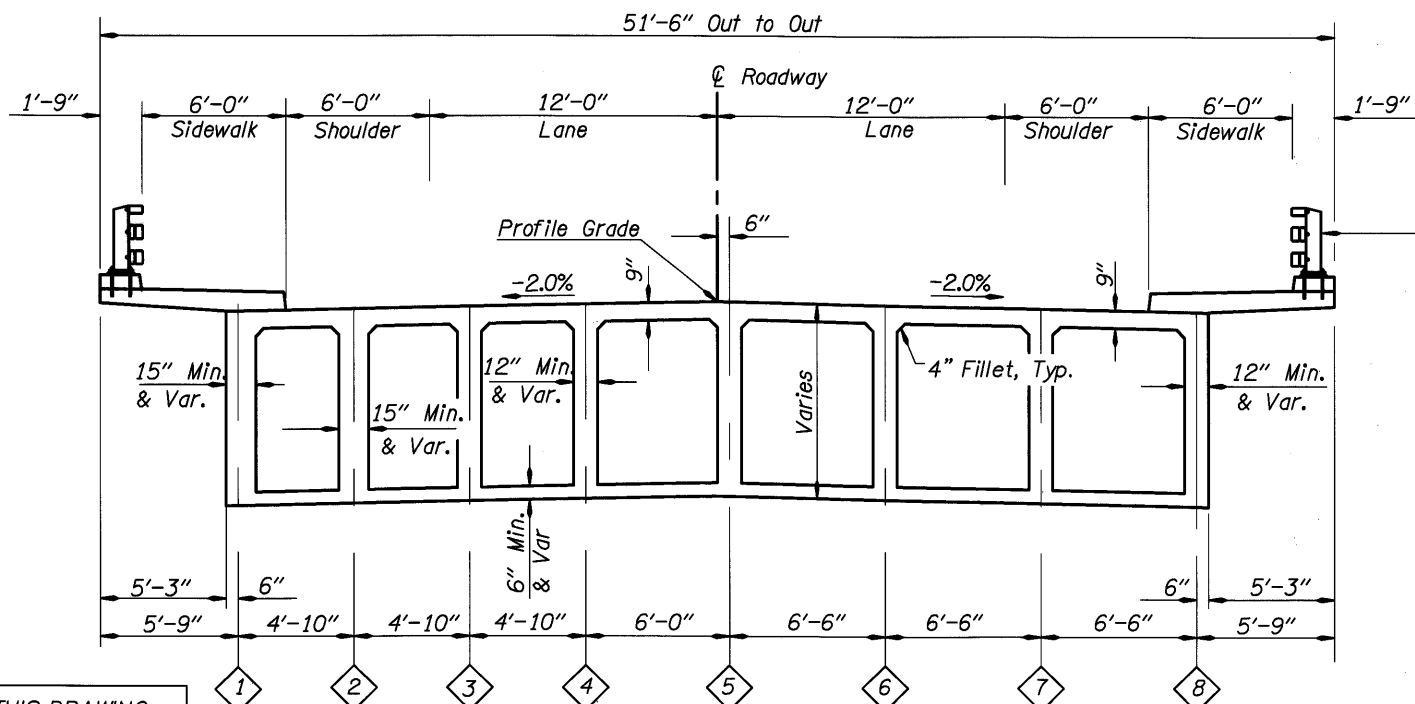

Std. 3 Tube Curb Mounted Rail (Modified), see Dwg. #70324 and Dwg. #70327

**TYPICAL SECTION F-F**

Scale: 1/4"=1'-0"  
Section taken at Sta. 14+67.03

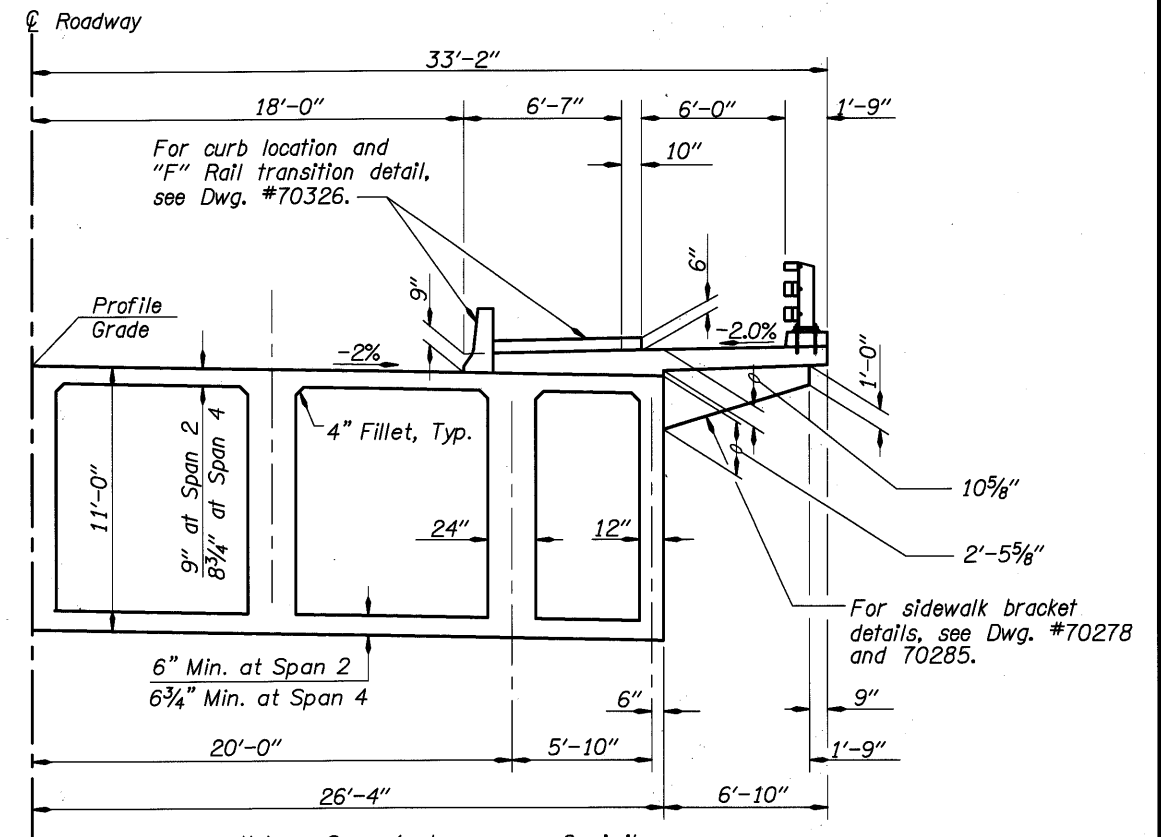


Note - Span 4 shown, span 2 similar.

**PART SECTION G-G**

Scale: 1/4"=1'-0"  
Section taken at face of end beam

DO NOT SCALE THIS DRAWING. FOLLOW DIMENSIONS. INDICATED SCALES CORRECT ONLY FOR FULL SIZE SHEET (22"x34").

DATE	03/09	REVISION	As-Constructed	BY	Ken Johnson	REVIEWED			TRANSPORTATION DIVISION OREGON DEPARTMENT OF TRANSPORTATION BRIDGE ENGINEERING SECTION	BRIDGE NO.	20136	SHEET	77
					TDF						Gernot Komar		DAVID EVANS AND ASSOCIATES INC.
					Josh Hewes					CALC. BOOK		DRAWING NO.	70264
											TYPICAL SECTIONS - SPAN 2		

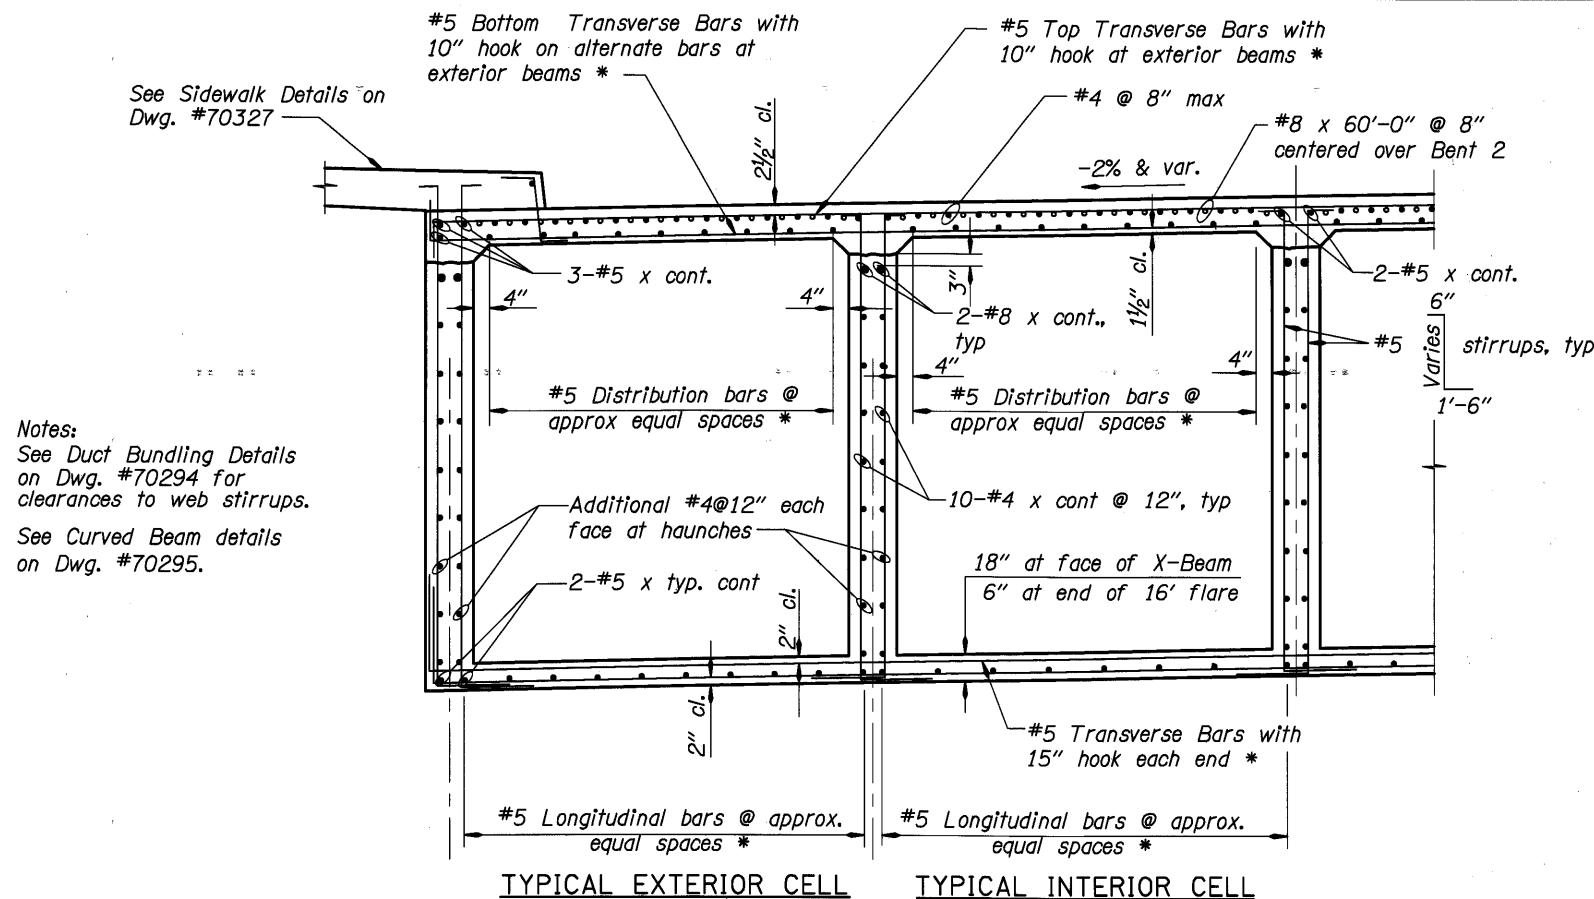


Notes:  
See Duct Bundling Details on Dwg. #70294 for clearances to web stirrups.  
See Curved Beam details on Dwg. #70295.

\* See Table on Dwg. #70268 for bar spacing and placement.


**PART TYPICAL SECTION - SPANS 1 AND 2**

Scale: 1/2" = 1'-0"

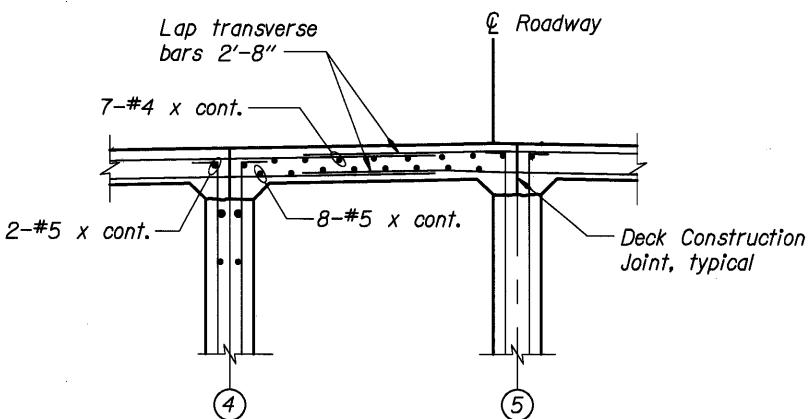


**SPAN 1 DECK CLOSURE POUR**

Scale: 1/2" = 1'-0"

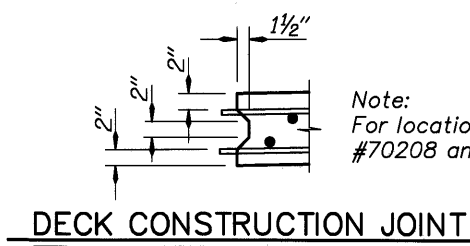


**DECK CONSTRUCTION JOINT**

No Scale

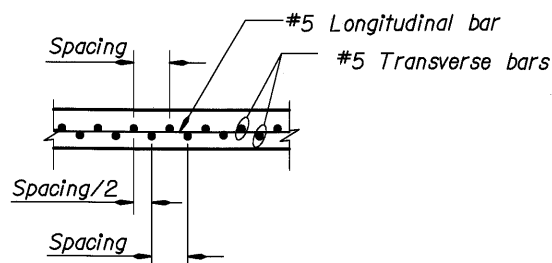


**BOTTOM SLAB**

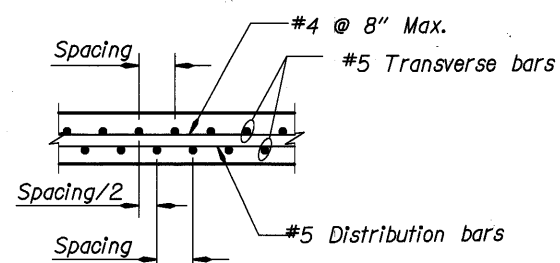

**DECK SLAB**


**TRANSVERSE STEEL SPACING DIAGRAMS**

No scale

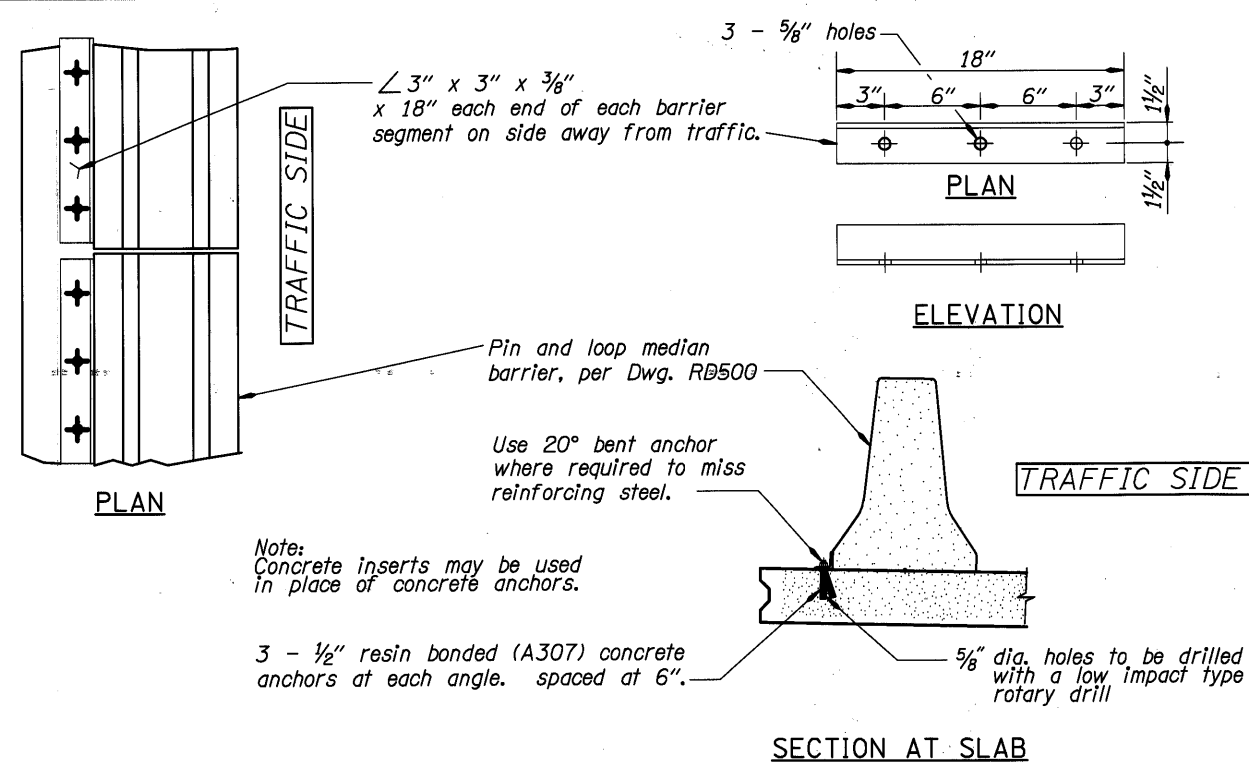

**TEMPORARY BARRIER RESTRAINT DETAIL**

No Scale

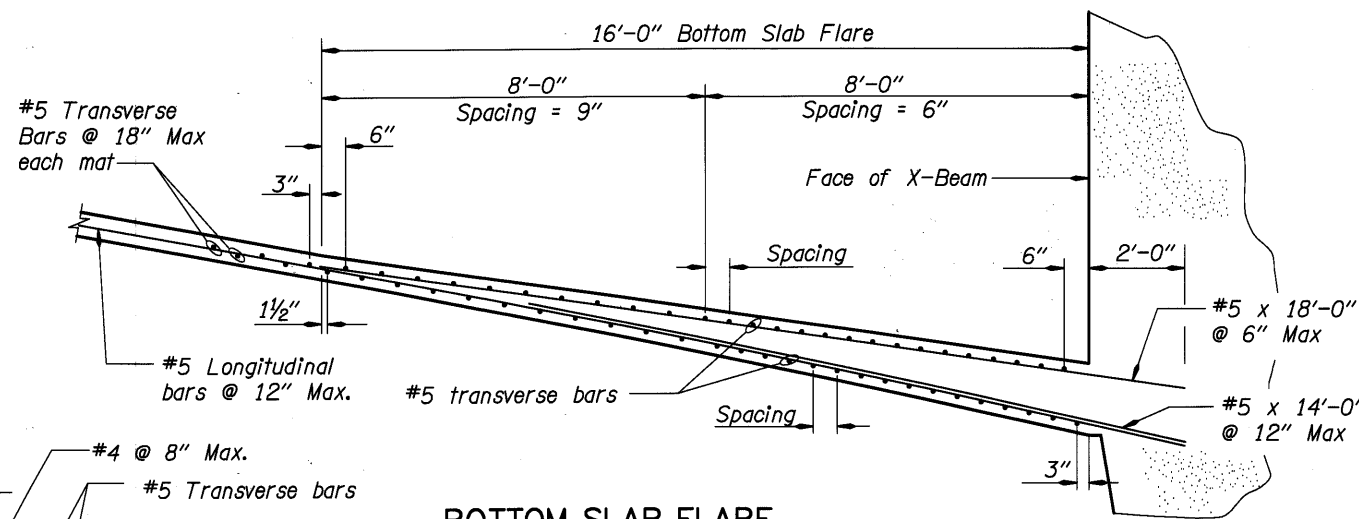

**BOTTOM SLAB FLARE**

Scale: 1/2" = 1'-0"

Note:  
For additional reinforcement at columns, see Section A-A on Dwg. #70276

DO NOT SCALE THIS DRAWING. FOLLOW DIMENSIONS. INDICATED SCALES CORRECT ONLY FOR FULL SIZE SHEET (22"x34").

DATE	REVISION	BY
03/09	As-Constructed	TDF


DRAWN BY: Ken Johnson  
CHECKED BY: Josh Hewes  
REVIEWED BY: Adrienne Dietrich

DESIGNER  
  
**DAVID EVANS AND ASSOCIATES INC.**  
 530 Center Street N.E., Suite 605  
 Salem Oregon 97301  
 Phone: 503.361.8635  
 EXPIRES: 12-31-05

CONNECTING COMMERCE AND COMMUNITY  
  
**MULTNOMAH COUNTY BRIDGES**  
 TRANSPORTATION DIVISION  
  
**OREGON DEPARTMENT OF TRANSPORTATION BRIDGE ENGINEERING SECTION**


BRIDGE NO. 20136	MULTNOMAH CHANNEL & PNWR ETC., SAUVIE ISLAND RD.
DATE Sept. 2005	
CALC. BOOK	
<b>BOX GIRDER REINFORCEMENT SPANS 1 AND 2 (1 OF 3)</b>	

SHEET 78 OF 173
DRAWING NO. 70265

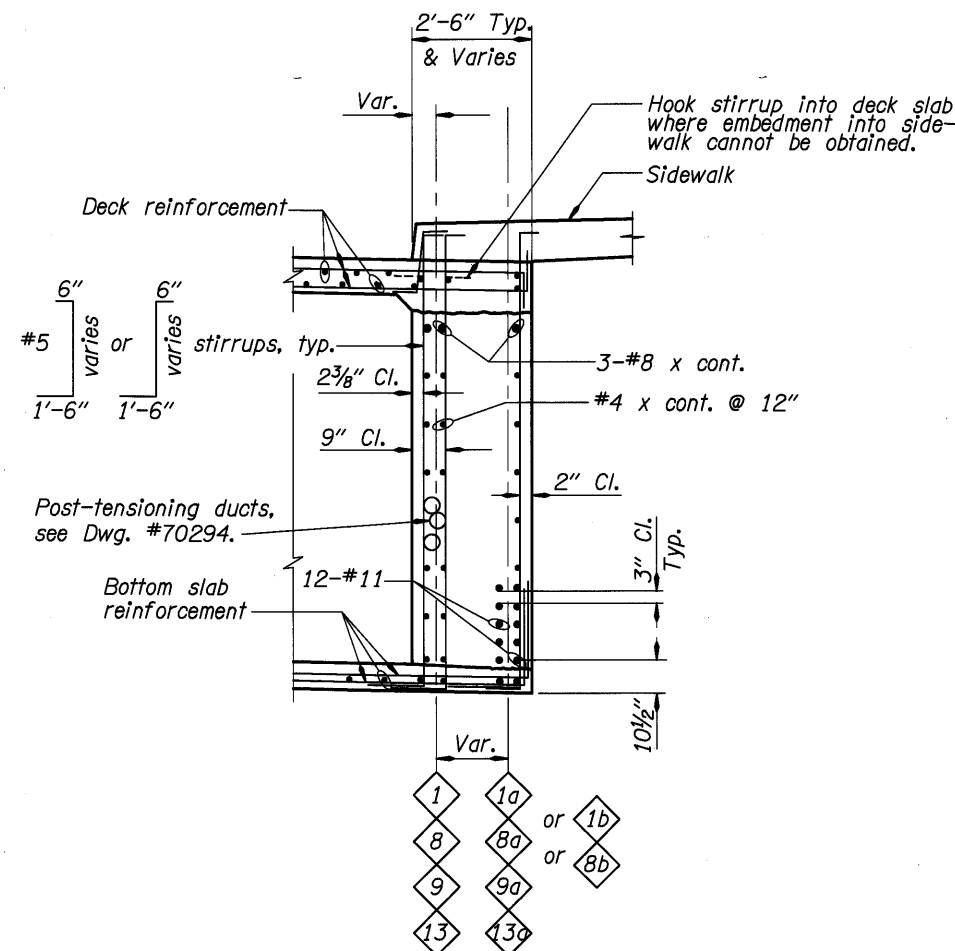


**MERGING BEAM DETAIL**

Scale: 1/2"=1'-0"

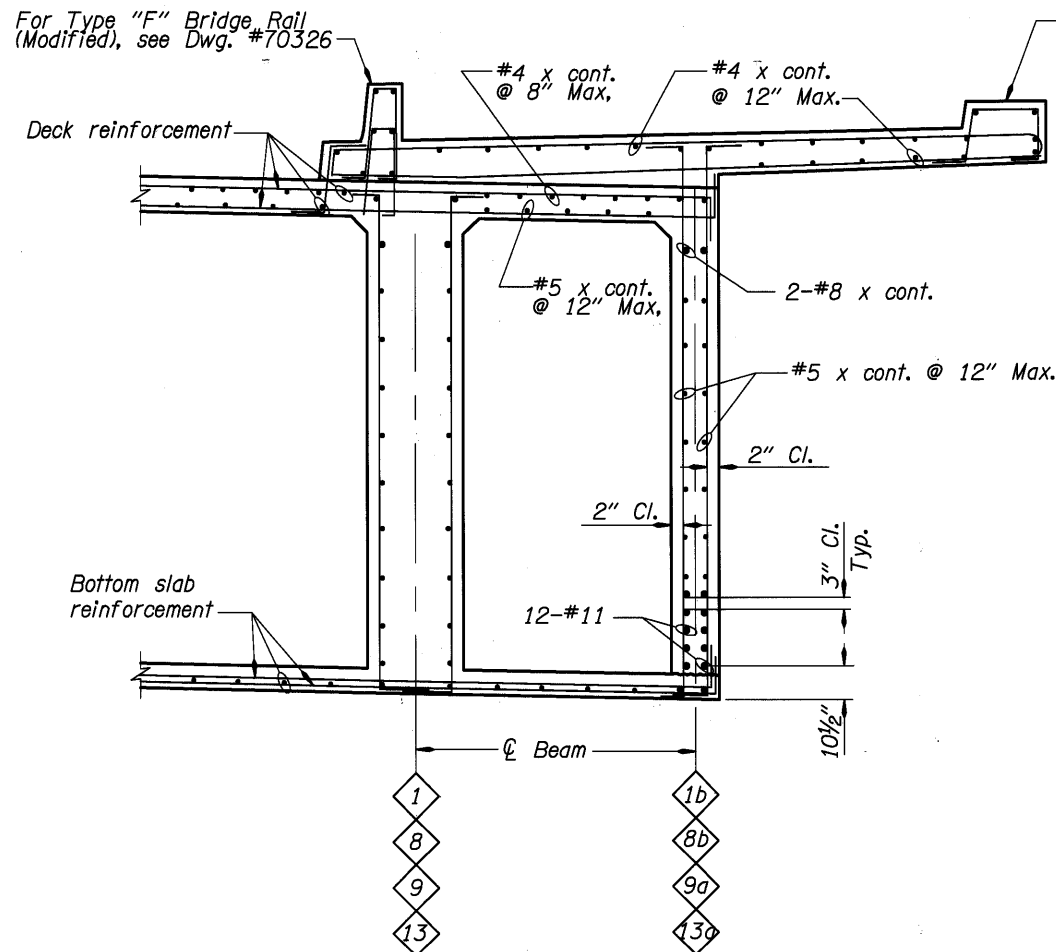


**PART SECTION - BEAMS 1b, 8b, 9a, AND 13a**

Scale: 1/2"=1'-0"

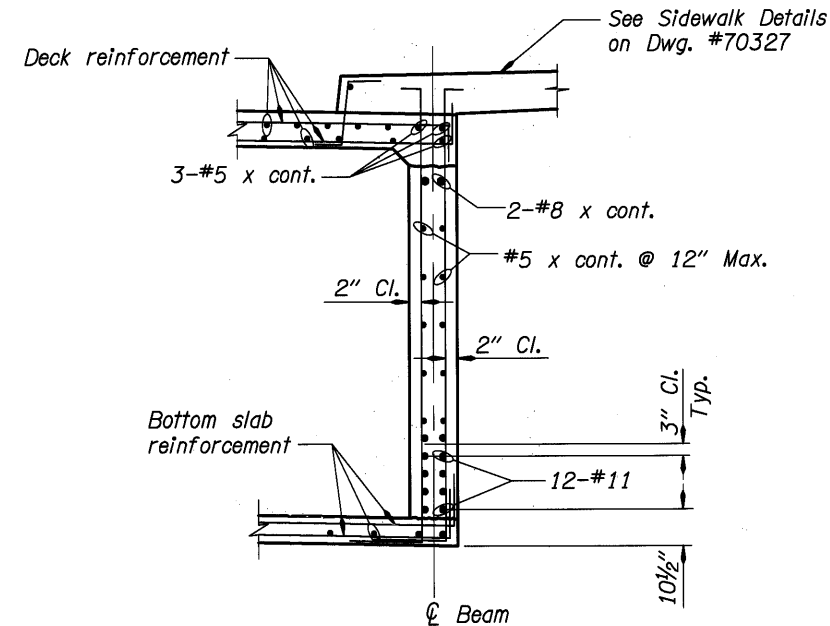

**PART SECTION - BEAMS 1a AND 8a**

Scale: 1/2"=1'-0"

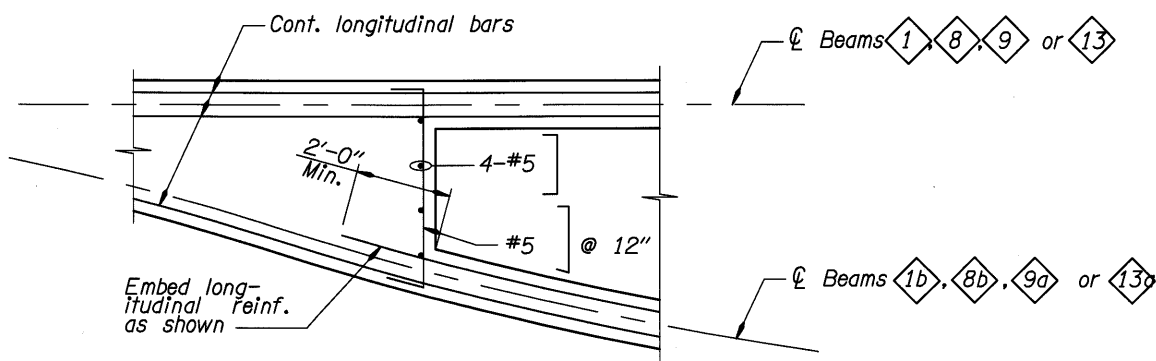


**PART PLAN AT BEAM BIFURCATION**

Scale: 1/2"=1'-0"


DO NOT SCALE THIS DRAWING. FOLLOW DIMENSIONS. INDICATED SCALES CORRECT ONLY FOR FULL SIZE SHEET (22"x34").

	DATE	REVISION	BY	DESIGNER Ken Johnson DRAFTED: Josh Hewes CHECKED: Adrienne Dietrich REVIEWED:	REGISTERED PROFESSIONAL ENGINEER 174540 PC OREGON MARCH 09, 2004 KEVIN WILLIAM CORTELL EXPIRES: 12-31-05	MULTNOMAH COUNTY BRIDGES TRANSPORTATION DIVISION OREGON DEPARTMENT OF TRANSPORTATION BRIDGE ENGINEERING SECTION	BRIDGE NO.	MULTNOMAH CHANNEL & PNWR ETC., SAUVIE ISLAND RD.	SHEET 79 OF 173
	03/09	As-Constructed	TDF				20136		
							DATE	BOX GIRDER REINFORCEMENT - SPANS 1 AND 2 (2 OF 3)	DRAWING NO. 70266
							Sept. 2005		
							CALC. BOOK		

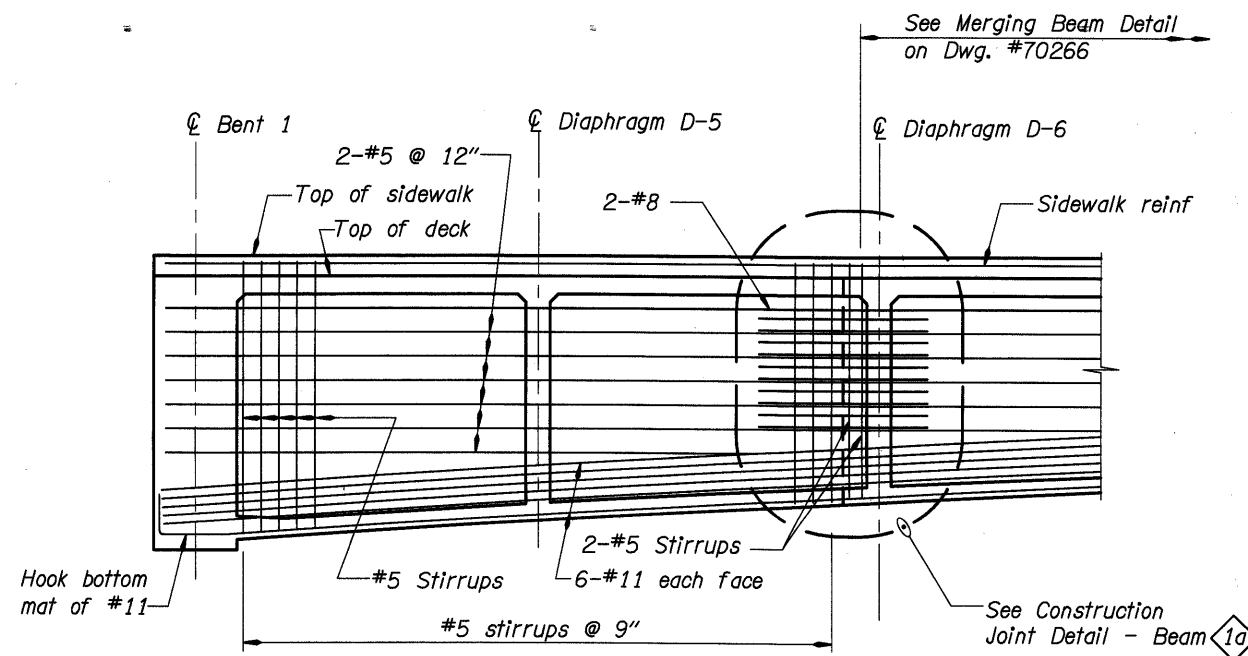

**PART ELEVATION - LONGITUDINAL BEAM 1a**

Scale: 1/4"=1'-0"

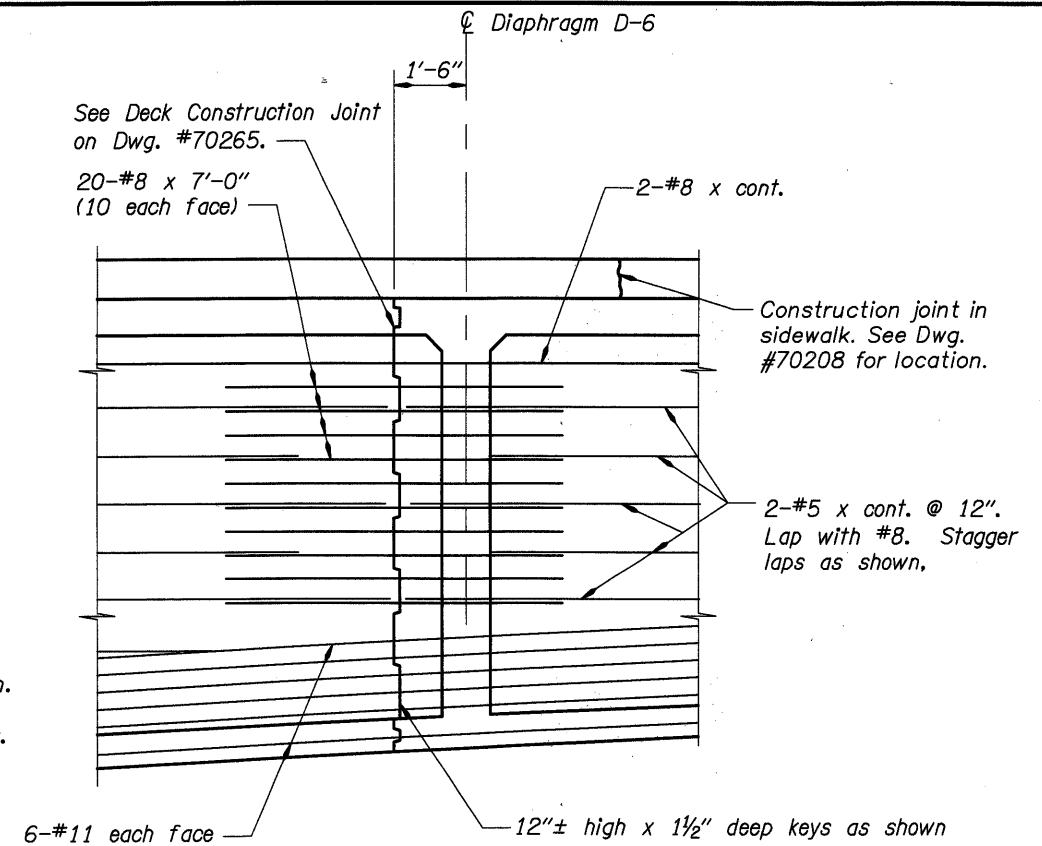


**CONSTRUCTION JOINT DETAIL - BEAM 1a**

Scale: 1/2"=1'-0"


**Notes:**

1. All reinforcement not shown.
2. Roughen construction joints.

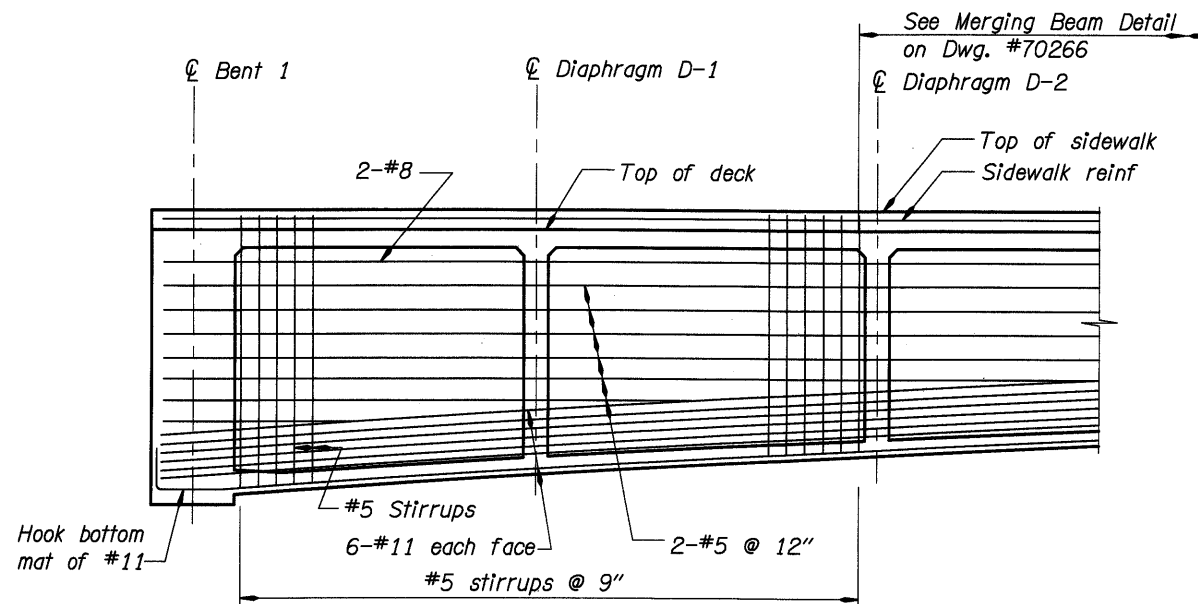

**PART ELEVATION - LONGITUDINAL BEAM 8a**

Scale: 1/4"=1'-0"

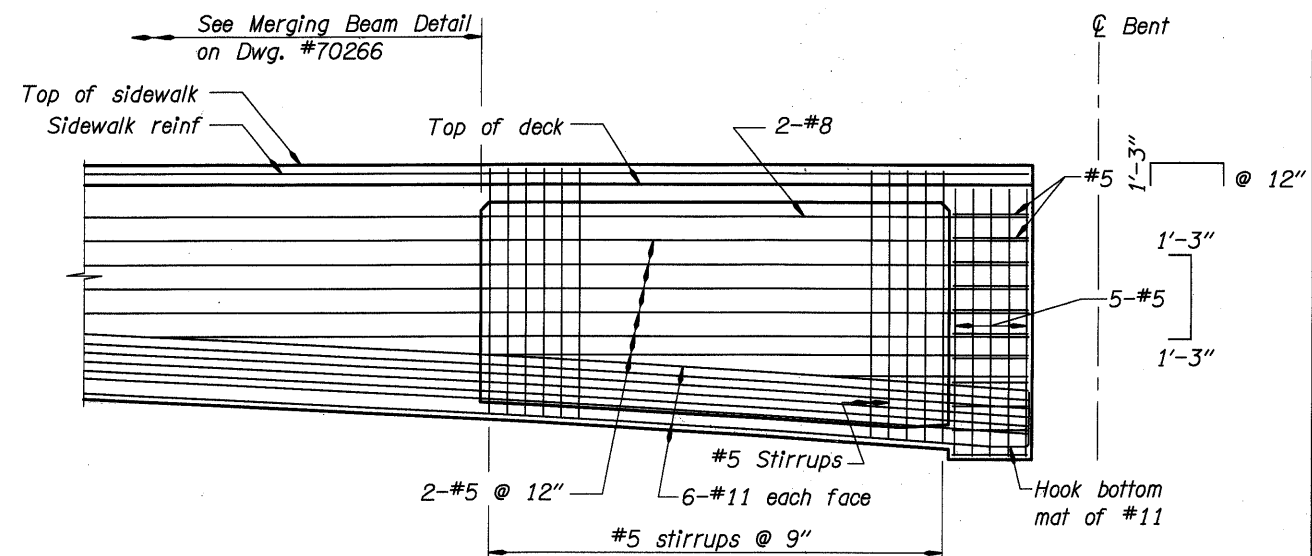


**PART ELEVATION - LONGITUDINAL BEAM 1b, 8b, 9a, AND 3a**


Scale: 1/4"=1'-0"

DO NOT SCALE THIS DRAWING. FOLLOW DIMENSIONS. INDICATED SCALES CORRECT ONLY FOR FULL SIZE SHEET (22"x34").

	DATE	REVISION	BY	DESIGNER			BRIDGE NO. 20136	MULTNOMAH CHANNEL & PNWR ETC., SAUVIE ISLAND RD.	SHEET 80 OF 173
	03/09	As-Constructed	TDF	DRAFTED: Ken Johnson CHECKED: Josh Hewes REVIEWED: Adrienne Dietrich					
					530 Center Street N.E., Suite 605 Salem Oregon 97301 Phone: 503.361.8635		CALC. BOOK	BOX GIRDER REINFORCEMENT - SPANS 1 AND 2 (3 OF 3)	

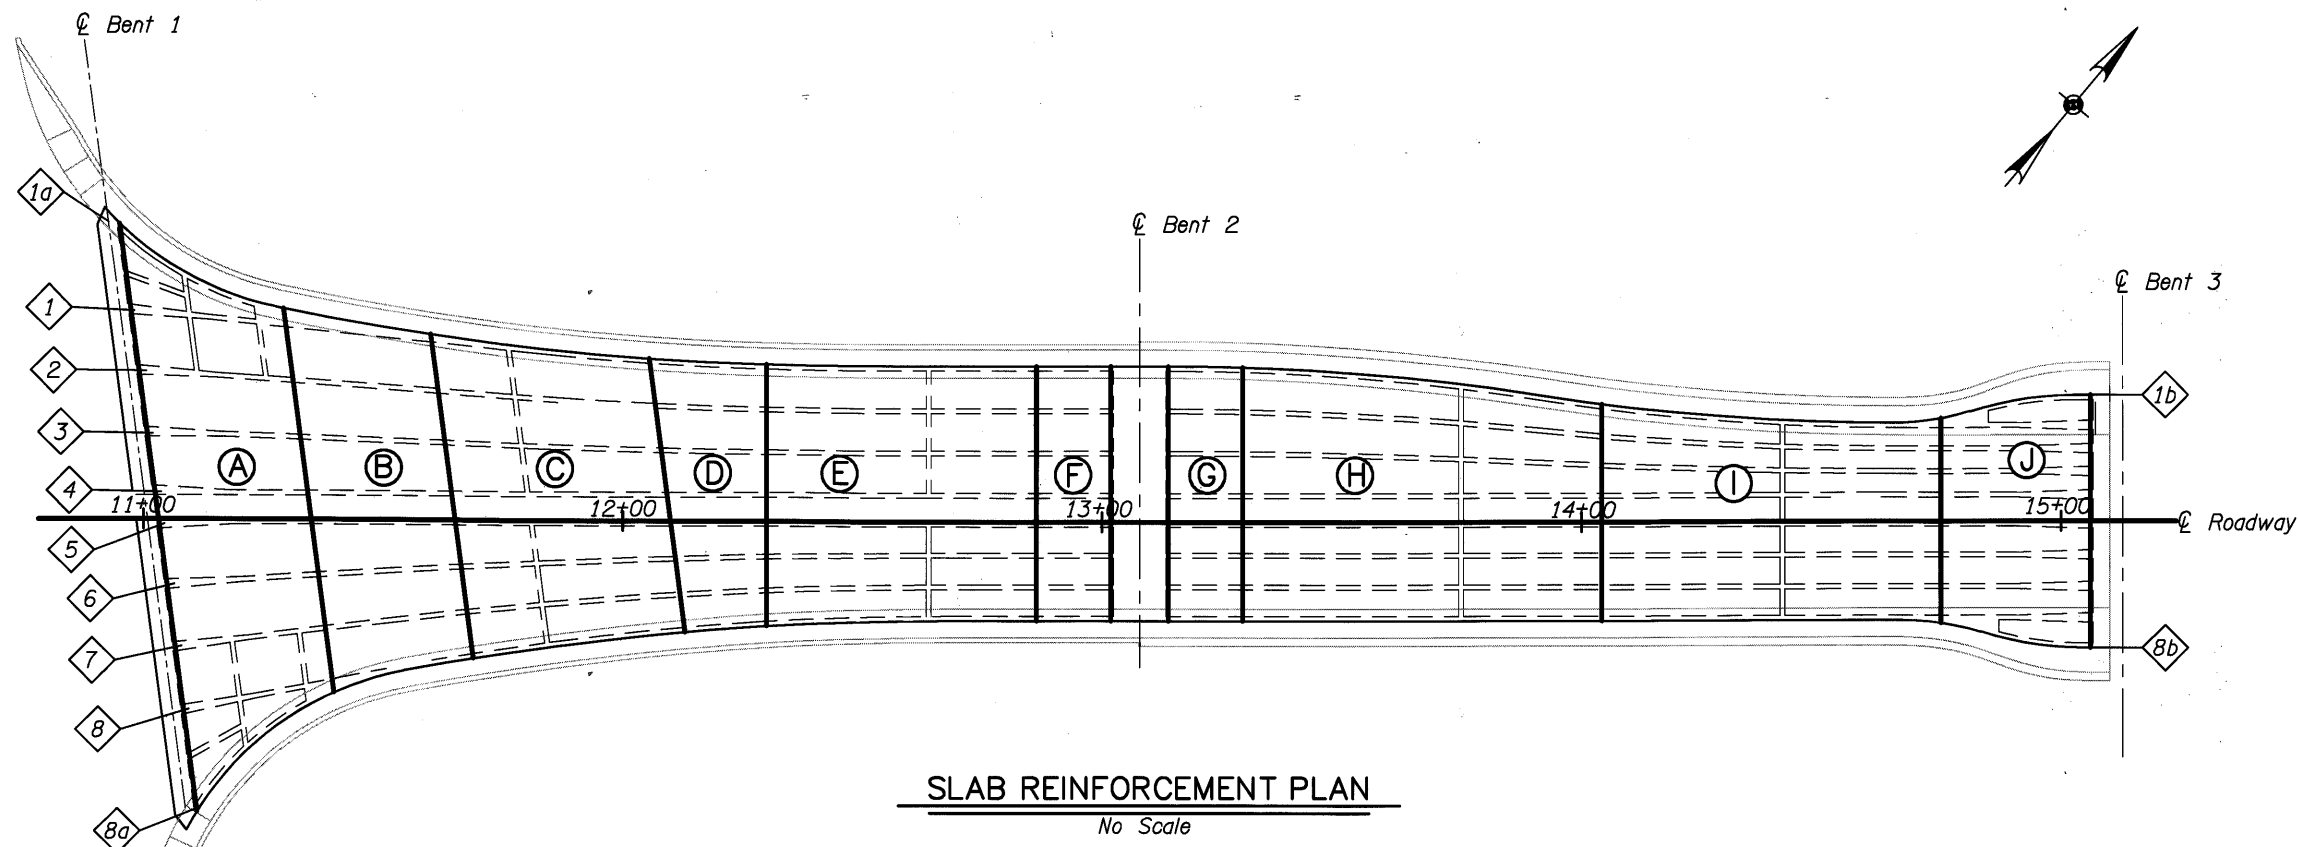

**SLAB REINFORCEMENT PLAN**  
No Scale

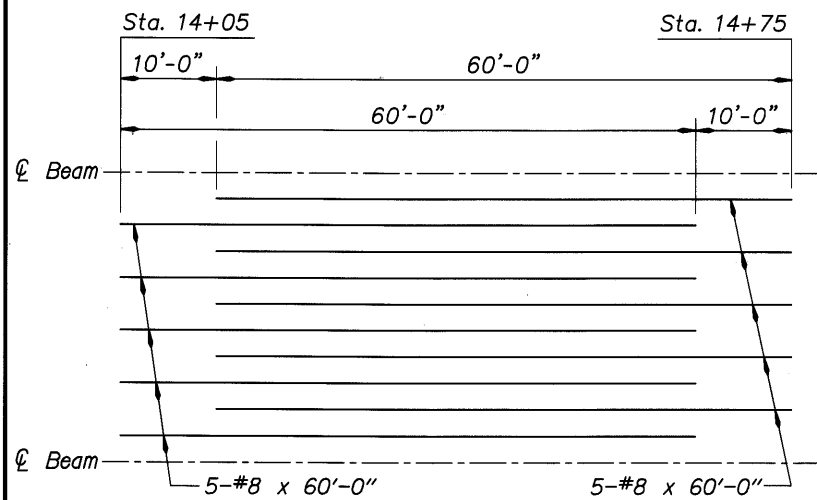

**REGION I DETAIL**  
No Scale

Note:  
All reinforcement  
not shown

DO NOT SCALE THIS DRAWING.  
FOLLOW DIMENSIONS. INDICATED  
SCALES CORRECT ONLY FOR  
FULL SIZE SHEET (22"x34").

SPANS 1 & 2 - SLAB REINFORCEMENT						
Region See Note 1	Begin Station	End Station	Deck Reinforcement		Bottom Slab Reinforcement	
			Transverse Bars (Each Mat)	Distribution Bars (Bottom Mat)	Transverse Bars (Each Mat)	Longitudinal Bars (1 Mat)
<b>Span 1</b>						
A	Bent 1	11+35	#5@4"	#5@6" Max.	#5@12"	#5@8" Max.
B	11+35	11+65	#5@5"	#5@7½" Max	#5@15"	#5@9" Max.
C	11+65	12+10	#5@6"	#5@9" Max.	#5@18"	#5@11" Max.
D	12+10	12+30	#5@7"	#5@10½" Max.	#5@18"	#5@12" Max.
E	12+30	12+86.32	#5@8"	#5@12" Max.	#5@18"	#5@12" Max.
F	12+86.32	Bent 2	#5@8"	#5@12" Max.	See Note 2	See Note 2
<b>Span 2</b>						
G	Bent 2	13+29.32	#5@8"	#5@12" Max.	See Note 2	See Note 2
H	13+29.32	14+05	#5@8"	#5@12" Max.	#5@18"	#5@12" Max.
I	14+05	14+75	#5@8"	#5@12" Max.	#5@18"	See Note 8
J	14+75	Bent 3	#5@8"	#5@12" Max.	#5@18"	#5@12" Max.

**NOTES**

1. See Slab Reinforcement Plan for limits of each region.
2. For reinforcement at bottom slab flare, see Bottom Slab Flare details on Dwg. #70265.
3. Place transverse bars in Region A through C parallel to centerline Bent 1.
4. Place transverse bars in Region E through H parallel to centerline Bent 2.
5. Place transverse bars in Region D parallel to centerline Bent 1 at Station 12+10 and parallel to centerline Bent 2 at Station 12+30. Transition placement between these limits.
6. Space transverse bars for Beams 1-4 along centerline Beam 1 in Region D.
7. Space transverse bars for Beams 5-8 along centerline Beam 5 in Region D.
8. For longitudinal bars in bottom slab of Region I, provide 70-#8 x 60'-0" (10 per bay) in addition to #5 x cont. @ 12" max. Bundle alternate #8 bars with #5 bars. See Region I Detail.
9. For additional deck and bottom slab reinforcement adjacent to end beams, see Dwg. #70293.

DATE	REVISION	BY
03/09	As-Constructed	TDF

DRAFTED: Ken Johnson  
CHECKED: Josh Hewes  
REVIEWED: Adrienne Dietrich

**DESIGNER**

REGISTERED PROFESSIONAL ENGINEER  
774548 PE 2  
MARCH 09, 2004  
KENT WILLIAM CORBITZ

**DAVID EVANS AND ASSOCIATES INC.**  
530 Center Street N.E., Suite 605  
Salem Oregon 97301  
Phone: 503.361.8635

EXPIRES: 12-31-05

CONNECTING COMMERCE AND COMMUNITY

**MULTNOMAH COUNTY BRIDGES**

TRANSPORTATION DIVISION


**OREGON DEPARTMENT OF TRANSPORTATION BRIDGE ENGINEERING SECTION**

BRIDGE NO.	20136
DATE	Sept. 2005
CALC. BOOK	

MULTNOMAH CHANNEL & PNWR ETC., SAUVIE ISLAND RD.


**DECK REINFORCEMENT SPANS 1 AND 2 (1 OF 2)**

SHEET	81
OF	173
DRAWING NO.	70268

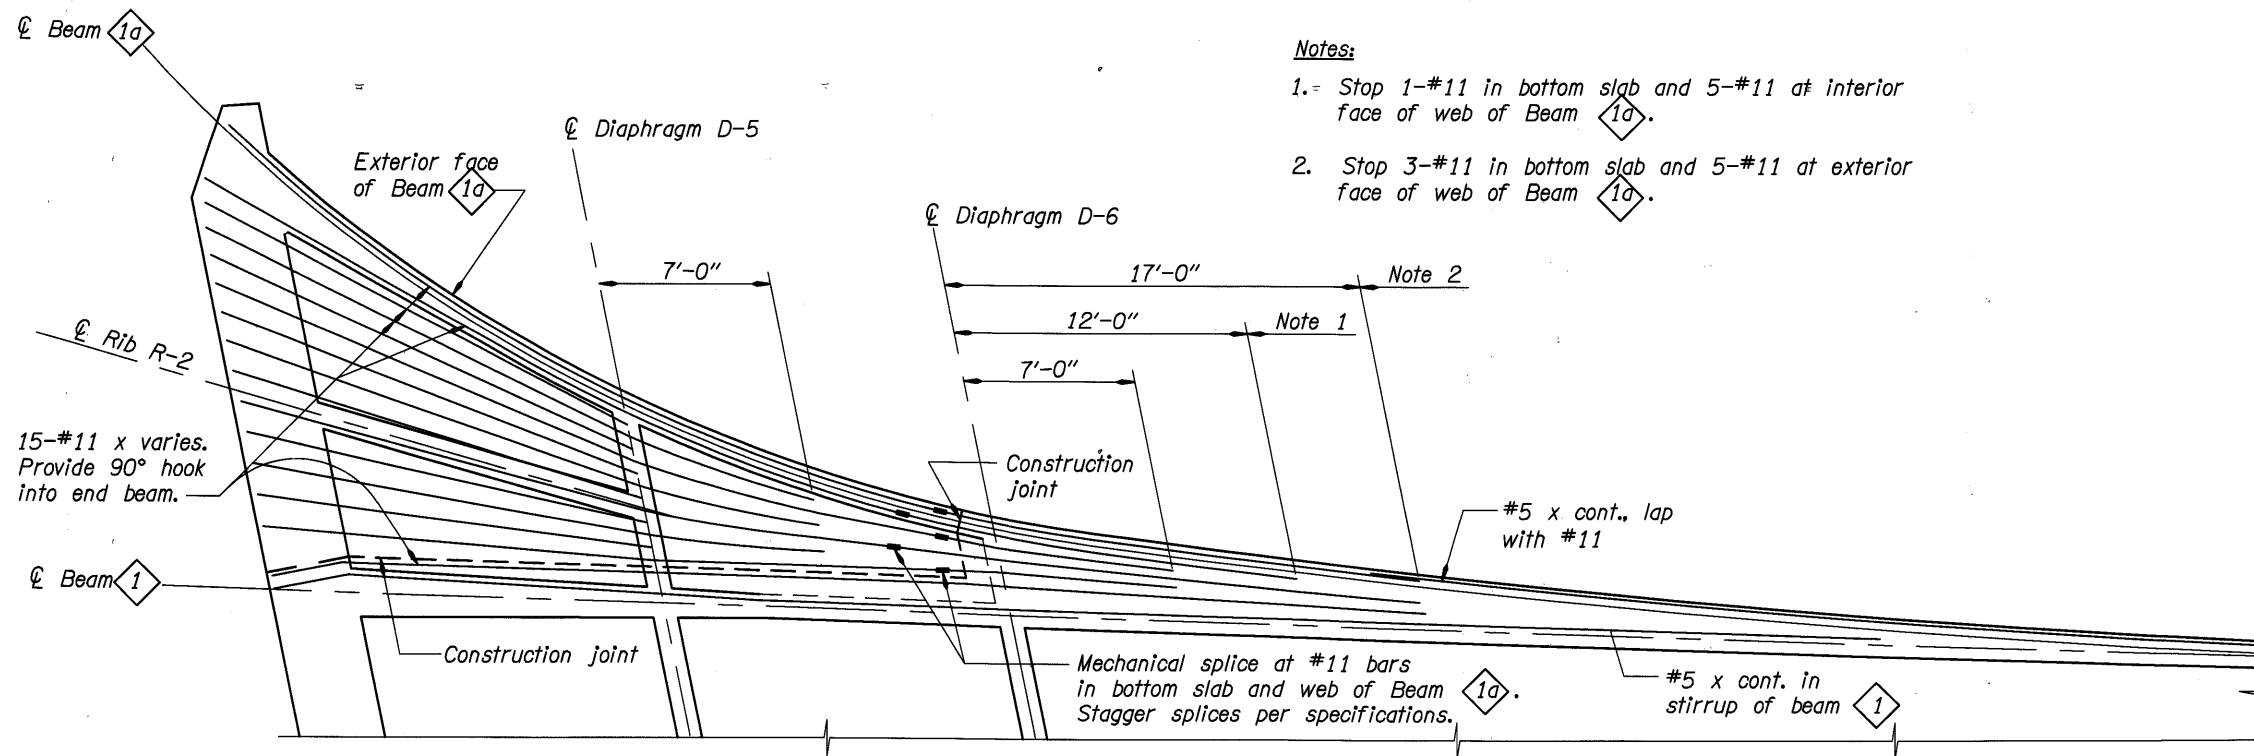

**BOTTOM REINFORCEMENT PLAN - BEAM 1a**


Scale: 1/4"=1'-0"

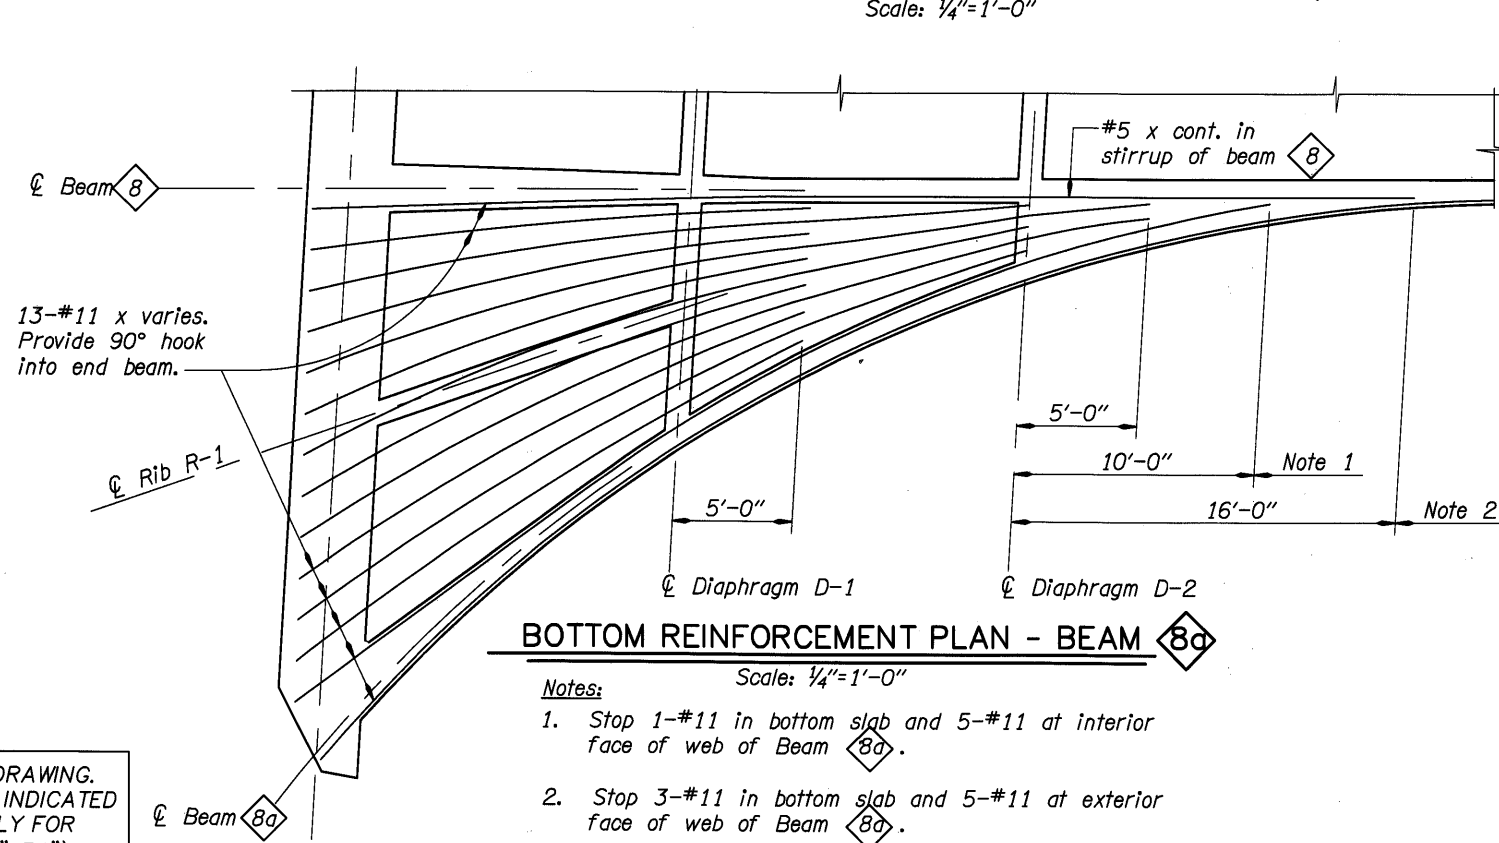

**BOTTOM REINFORCEMENT PLAN - BEAM 8a**

Scale: 1/4"=1'-0"

- Notes:**
1. Stop 1-#11 in bottom slab and 5-#11 at interior face of web of Beam 8a.
  2. Stop 3-#11 in bottom slab and 5-#11 at exterior face of web of Beam 8a.

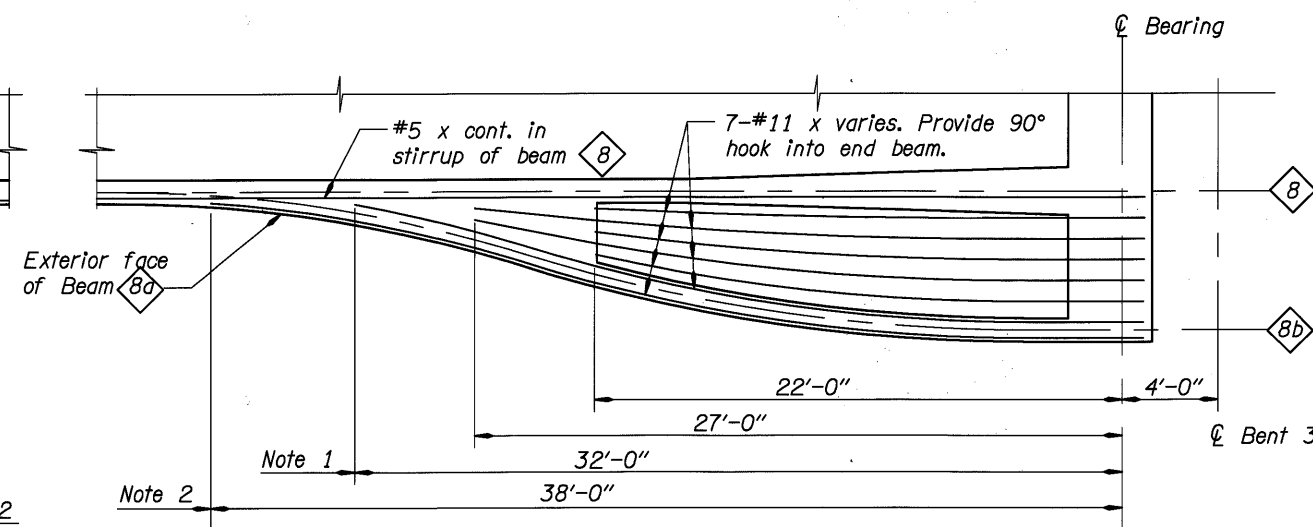

**BOTTOM REINFORCEMENT PLAN - BEAMS 1b, 8b, 9a, AND 13a**


Scale: 1/4"=1'-0"

1. Stop 1-#11 in bottom slab and 5-#11 at interior face of web of Beam 8b.
2. Stop 1-#11 in bottom slab and 5-#11 at exterior face of web of Beam 8b.
3. Plan shown for Beam 8b, Beams 1b, 9a, and 13a are similar


DO NOT SCALE THIS DRAWING. FOLLOW DIMENSIONS. INDICATED SCALES CORRECT ONLY FOR FULL SIZE SHEET (22"x34").

	DATE	REVISION	BY	DESIGNER			BRIDGE NO. 20136	SHEET 82 OF 173
	03/09	As-Constructed	TDF	Ken Johnson				
				Josh Hewes			MULTNOMAH CHANNEL & PNWR ETC., SAUVIE ISLAND RD.	DRAWING NO. 70269
				Adrienne Dietrich				




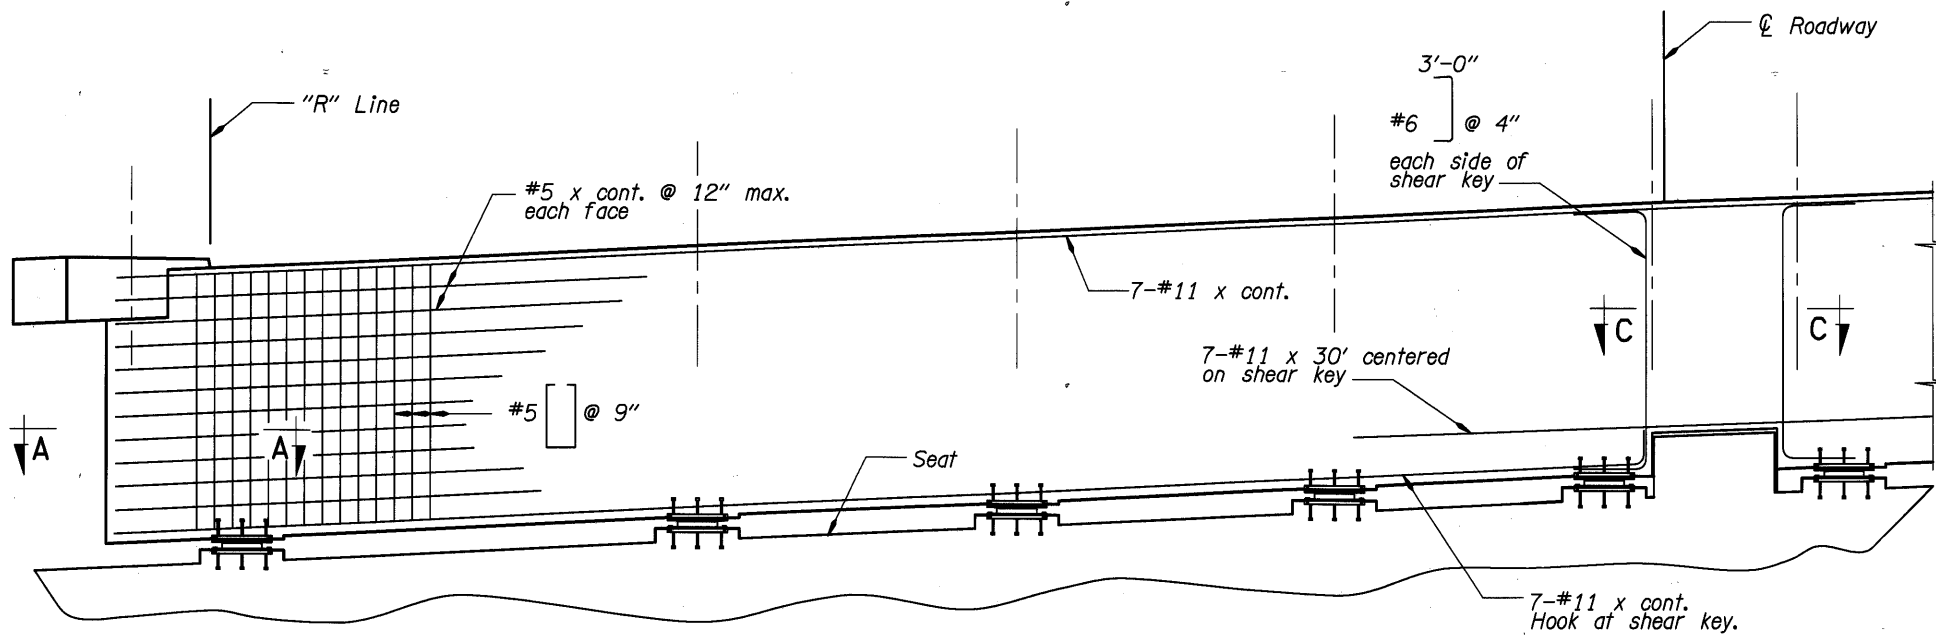


**BENT 1 END BEAM ELEVATION - RIGHT SIDE**  
Scale: 1/4"=1'-0"

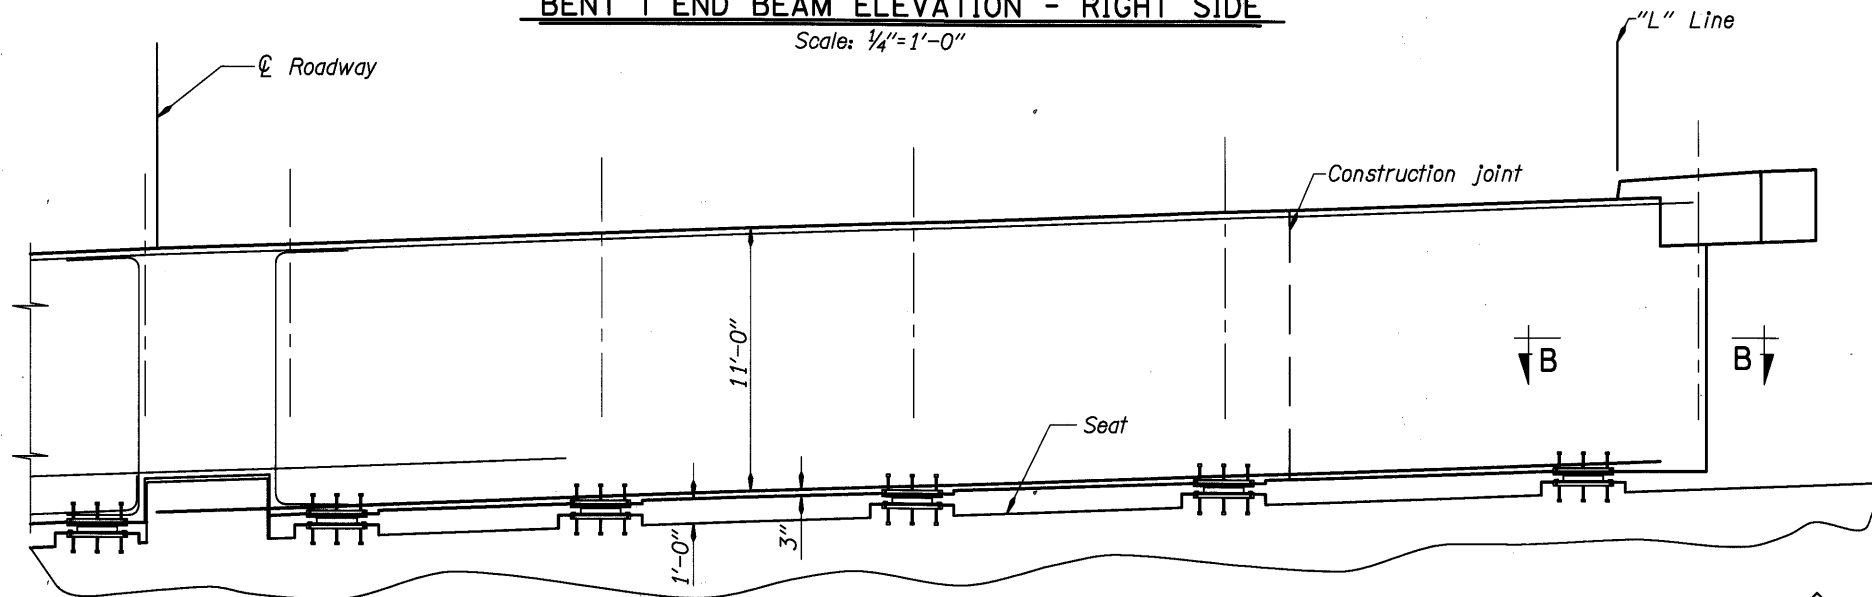


**BENT 1 END BEAM ELEVATION - LEFT SIDE**  
Scale: 1/4"=1'-0"

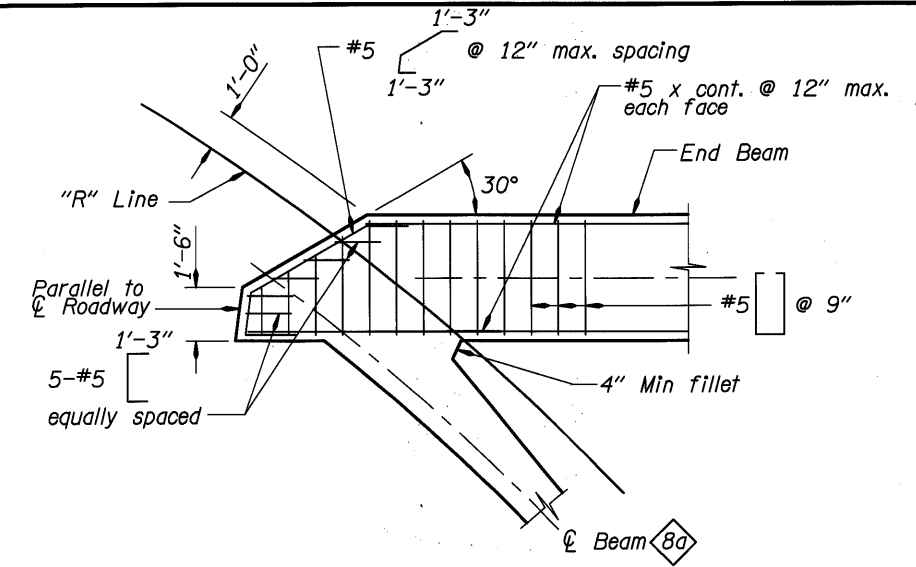

**SECTION A-A**  
Scale: 3/8"=1'-0"

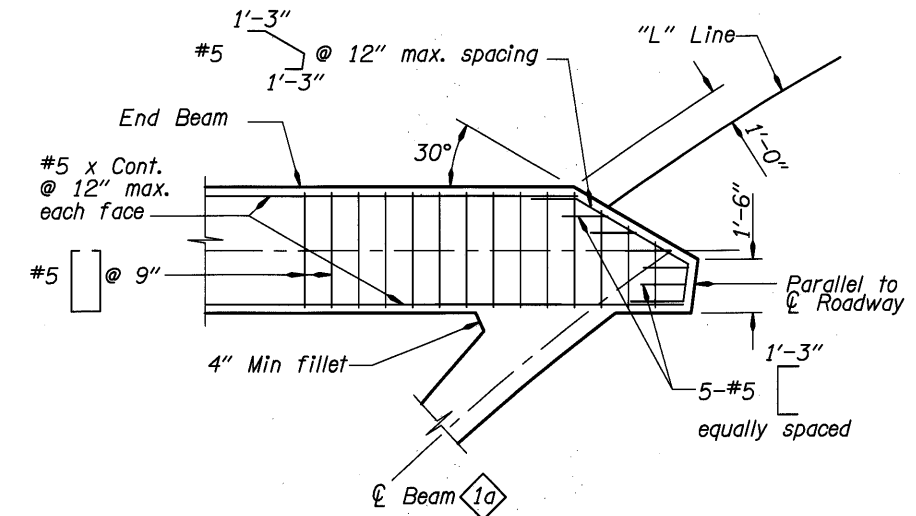

**SECTION B-B**  
Scale: 3/8"=1'-0"

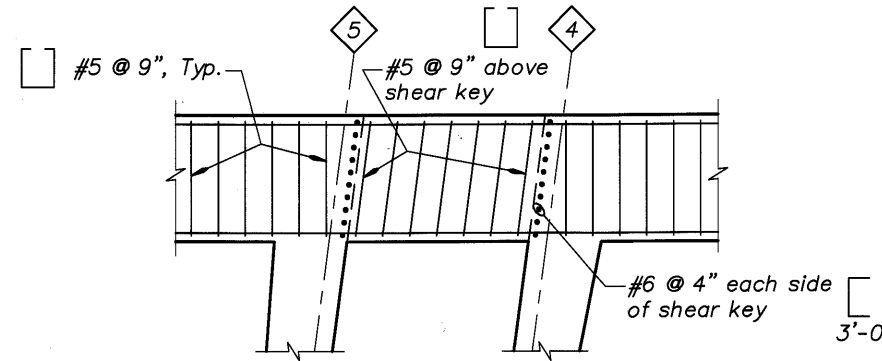

**SECTION C-C**  
Scale: 3/8"=1'-0"

Note:  
For end beam reinforcement  
and details, see Dwg. #70293.


Note:  
See Dwg. #70336 and #70337 for deck  
drainage details.

See Dwg. #70343 to #70355 for lighting  
details and conduit locations.

See Dwg. #70360 for utility conduit and  
hanger details.


DO NOT SCALE THIS DRAWING.  
FOLLOW DIMENSIONS. INDICATED  
SCALES CORRECT ONLY FOR  
FULL SIZE SHEET (22"x34").

DATE	03/09	REVISION	As-Constructed	BY	Ken Johnson	DESIGNER	 DAVID EVANS AND ASSOCIATES INC. 530 Center Street N.E., Suite 605 Salem Oregon 97301 Phone: 503.361.8635	BRIDGE NO.	20136	SHEET	83
	DATE		Sept. 2005		OF				173		
REVISION		BY		DRAFTED:	Josh Hewes	TRANSPORTATION DIVISION	OREGON DEPARTMENT OF TRANSPORTATION BRIDGE ENGINEERING SECTION	DATE	Sept. 2005	DRAWING NO.	70270
		CHECKED:		REVIEWED:	Adrienne Dietrich	MULTNOMAH COUNTY BRIDGES	BRIDGE NO.	20136	MULTNOMAH CHANNEL & PNWR ETC., SAUVIE ISLAND RD.		
						EXPIRES: 12-31-05		CALC. BOOK		BENT 1 - END BEAM DETAILS	

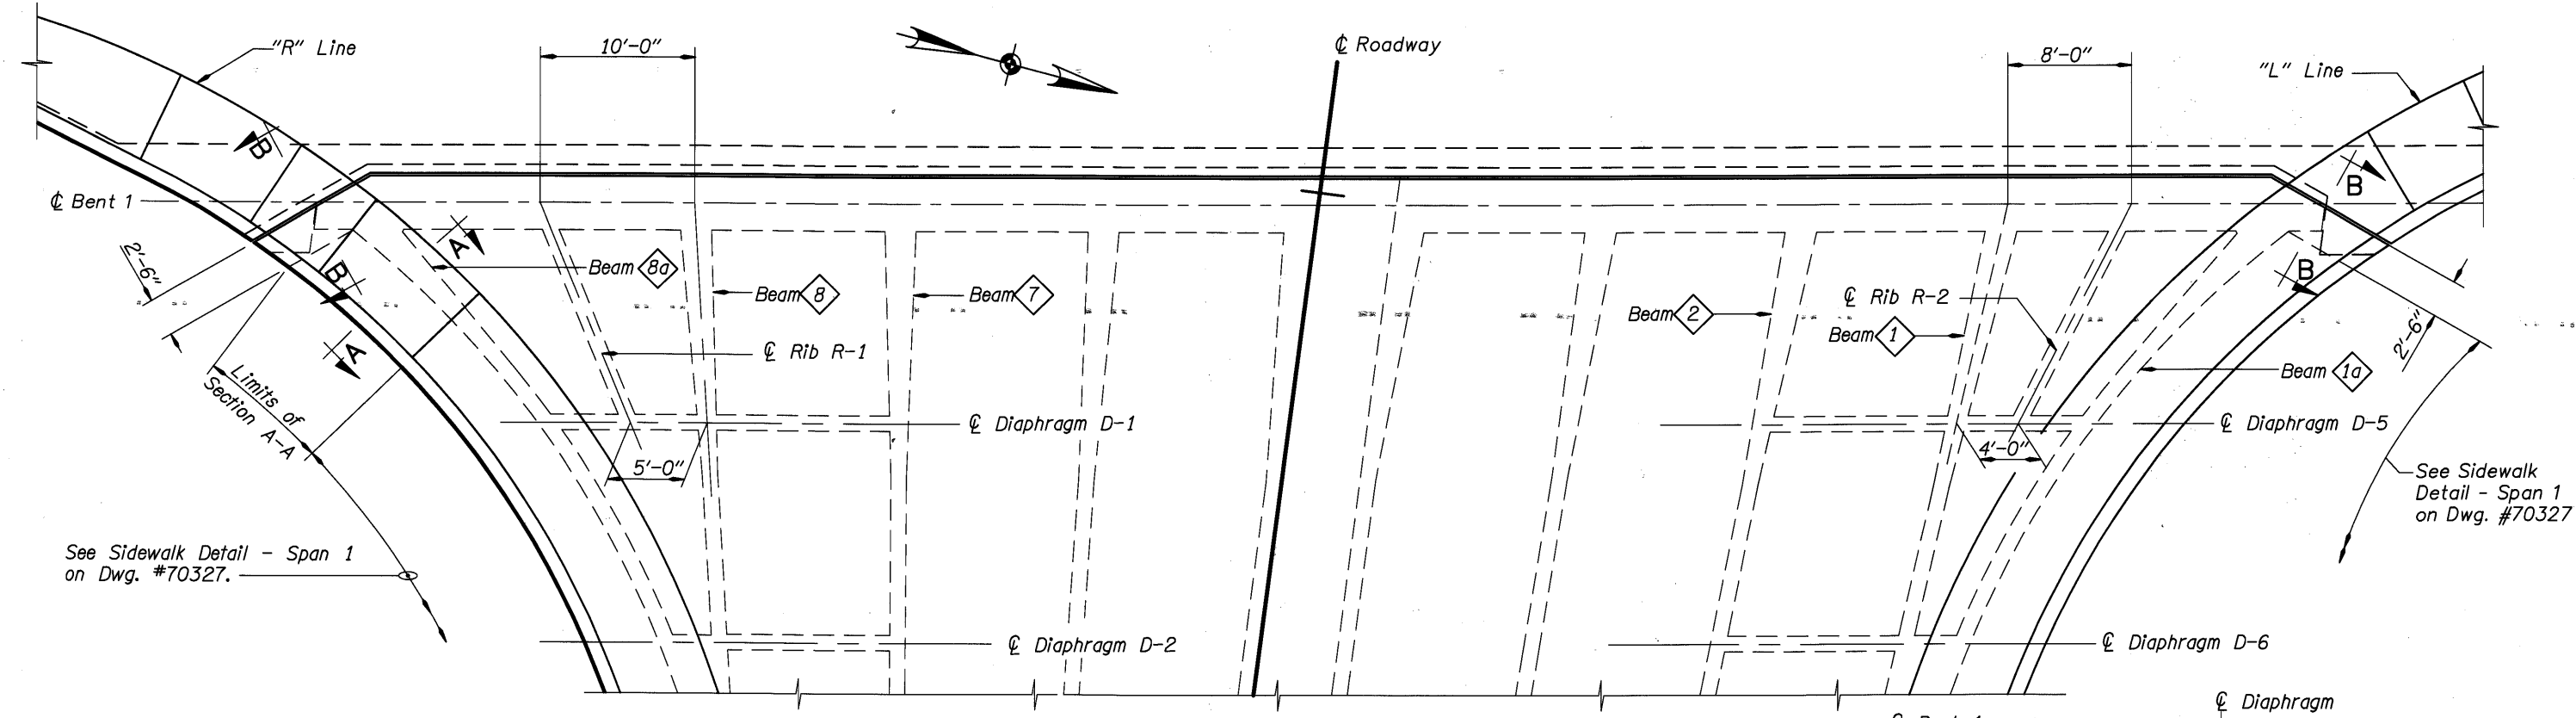

PLAN - BENT 1


Scale: 3/16" = 1'-0"

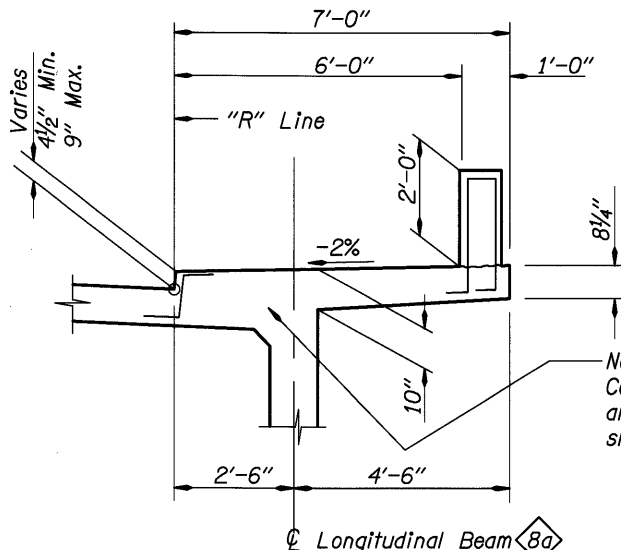

SECTION A-A


Scale: 1/2" = 1'-0"

For reinforcement, see Sidewalk Details - Span 1 on Dwg. #70327.

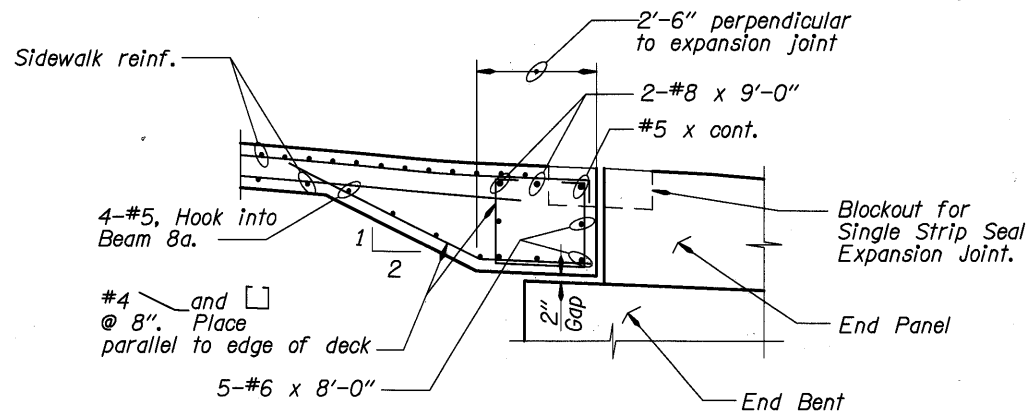


SECTION B-B

Scale: 1/2" = 1'-0"

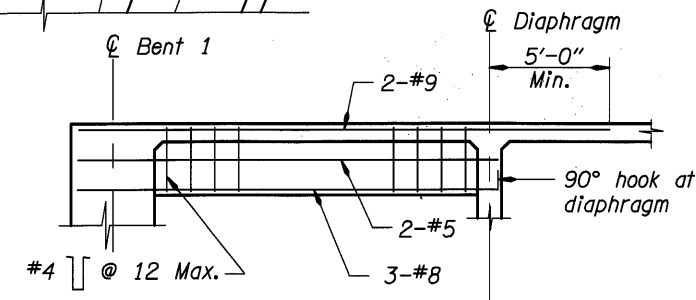

DECK RIB ELEVATION

Scale: 1/4" = 1'-0"

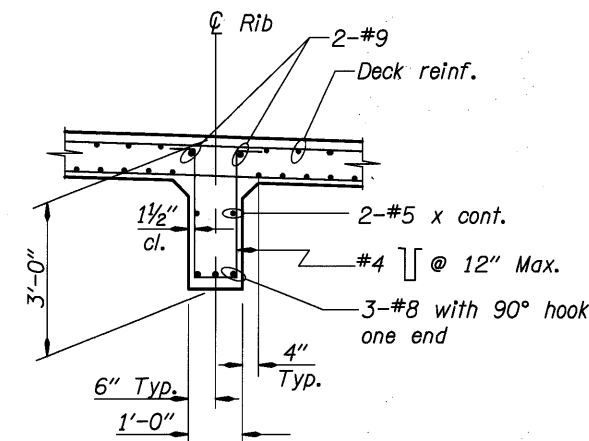


DECK RIB SECTION

Scale: 1/2" = 1'-0"


DO NOT SCALE THIS DRAWING. FOLLOW DIMENSIONS. INDICATED SCALES CORRECT ONLY FOR FULL SIZE SHEET (22"x34").

	DATE	REVISION	BY	DESIGNER		BRIDGE NO.	MULTNOMAH CHANNEL & PNWR ETC., SAUVIE ISLAND RD.	SHEET 84 OF 173.
	03/09	Aa- Constructed	TDF	Ken Johnson		TRANSPORTATION DIVISION		
				Checked: Josh Hewes		DATE		DRAWING NO. 70271
				Reviewed: Adrienne Dietrich		Sept. 2005		
				DAVID EVANS AND ASSOCIATES INC. 530 Center Street N.E., Suite 605 Salem Oregon 97301 Phone: 503.361.8635		CALC. BOOK		
				REGISTERED PROFESSIONAL ENGINEER 74549 PE OREGON MARCH 09, 2004 WENT WILLIAM CORDT				
				EXPIRES: 12-31-05				

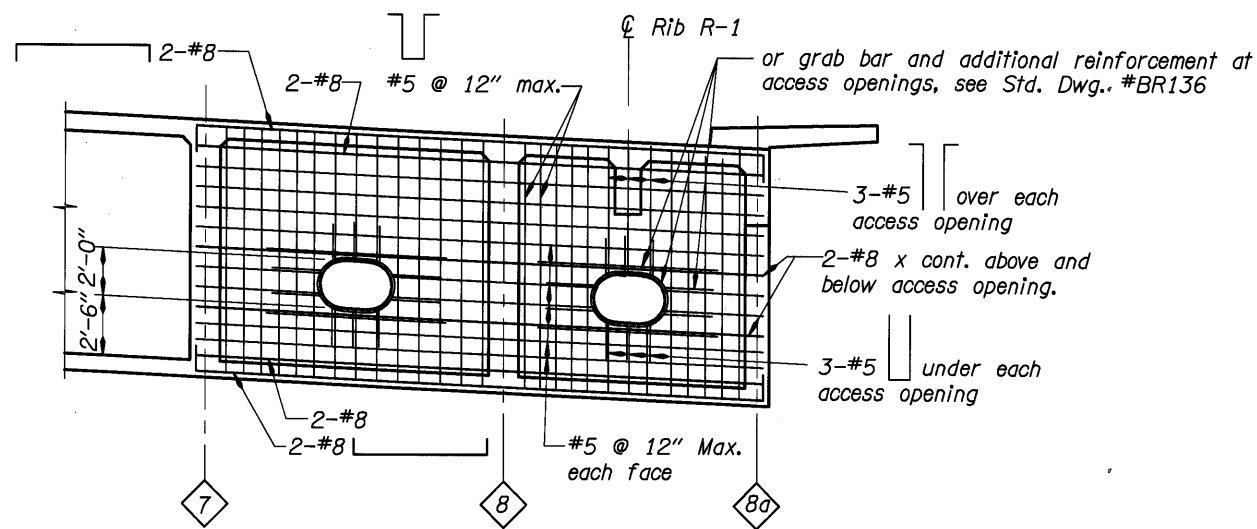

**DIAPHRAGM D-1**


Scale: 1/4"=1'-0"

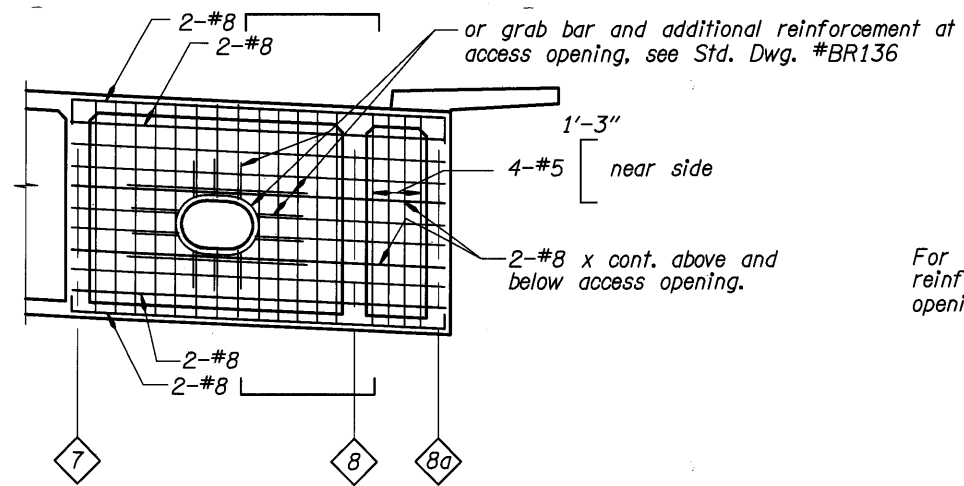

**DIAPHRAGM D-2**


Scale: 1/4"=1'-0"

For details and reinforcement not shown or noted, see Diaphragm D-1.

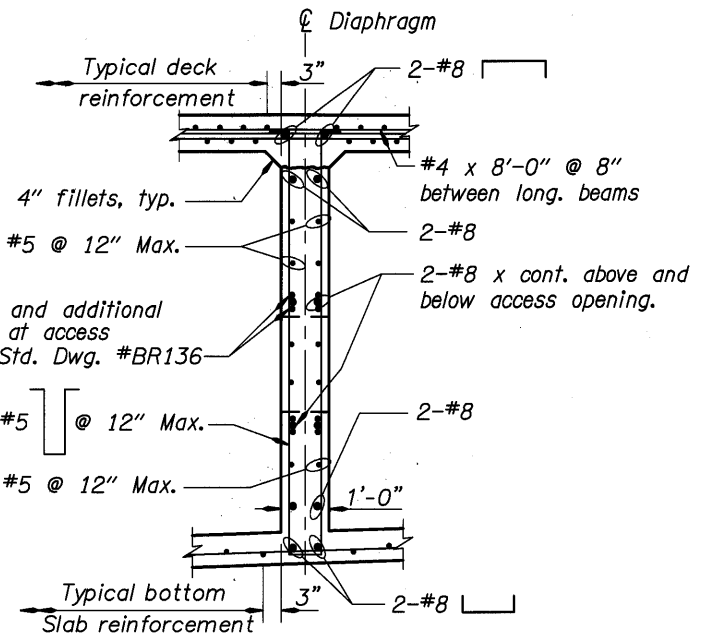

**SECTION - DIAPHRAGMS D-1, D-2, D-5 AND D-6**


Scale: 1/2"=1'-0"

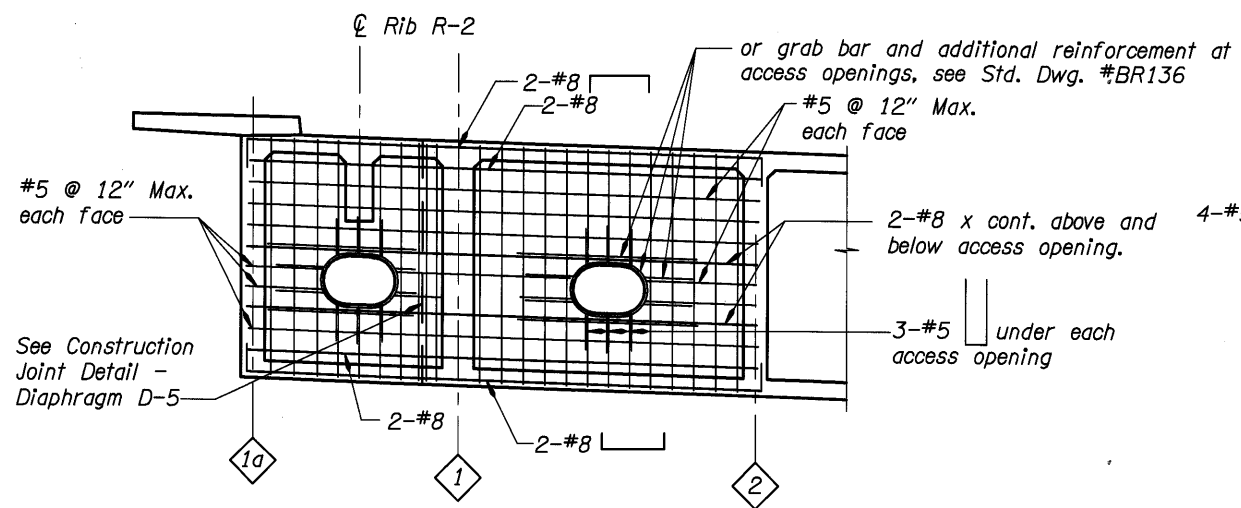

**DIAPHRAGM D-5**

Scale: 1/4"=1'-0"


For details and reinforcement not shown or noted, see Diaphragm D-1.

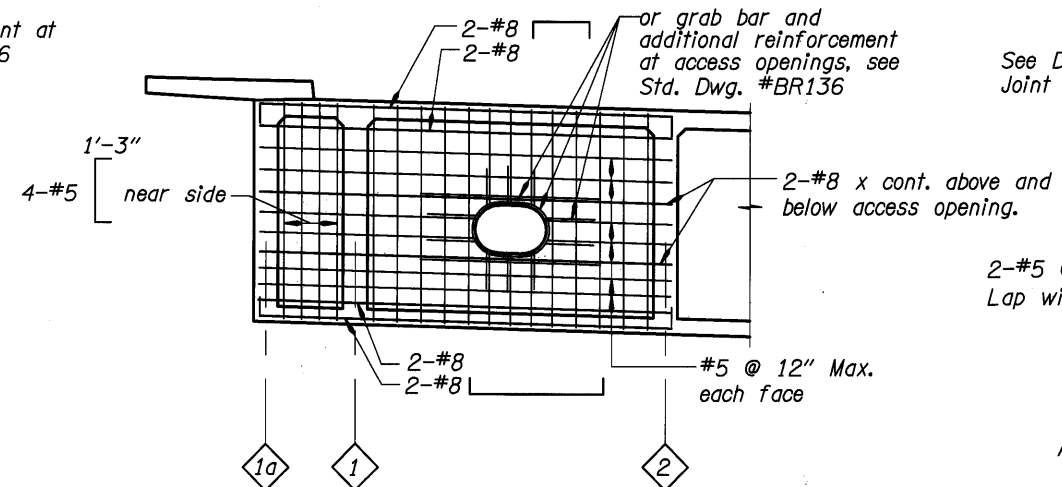

**DIAPHRAGM D-6**

Scale: 1/4"=1'-0"

For details and reinforcement not shown or noted, see Diaphragm D-1.

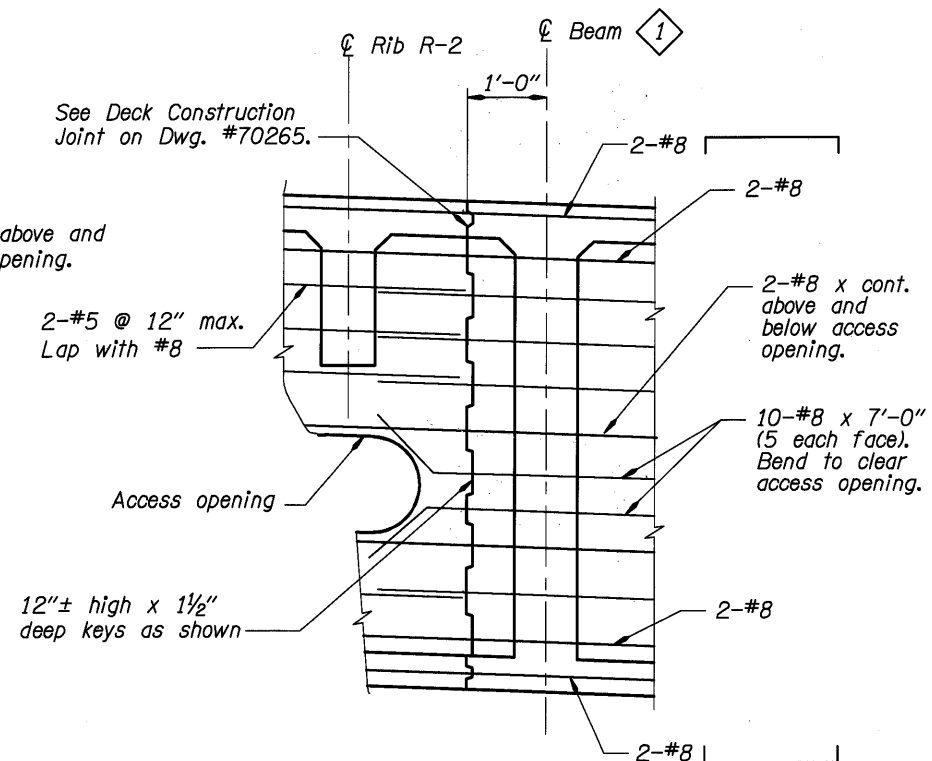

**CONSTRUCTION JOINT DETAIL -DIAPHRAGM D-5**

Scale: 1/2"=1'-0"

- Notes:
- All reinforcement not shown.
  - Roughen construction joints.

DO NOT SCALE THIS DRAWING. FOLLOW DIMENSIONS. INDICATED SCALES CORRECT ONLY FOR FULL SIZE SHEET (22"x34").

Note:  
See Dwg. #70336 and #70337 for deck drainage details.

See Dwg. #70343 to #70355 for lighting details and conduit locations.

See Dwg. #70360 for utility conduit and hanger details.

DATE	REVISION	BY
03/09	As-Constructed	TDF

DRAFTED:	Ken Johnson
CHECKED:	Josh Hewes
REVIEWED:	Adrienne Dietrich

DESIGNER

**DAVID EVANS AND ASSOCIATES, INC.**  
530 Center Street N.E., Suite 605  
Salem Oregon 97301  
Phone: 503.361.8635

EXPIRES: 12-31-05

CONNECTING COMMERCE AND COMMUNITY

MULTNOMAH COUNTY BRIDGES


TRANSPORTATION DIVISION

OREGON DEPARTMENT OF TRANSPORTATION  
BRIDGE ENGINEERING SECTION

BRIDGE NO.	20136
DATE	Sept. 2005
CALC. BOOK	


MULTNOMAH CHANNEL & PNWR ETC., SAUVIE ISLAND RD.
DIAPHRAGM DETAILS

SHEET	85
OF	173
DRAWING NO.	70272

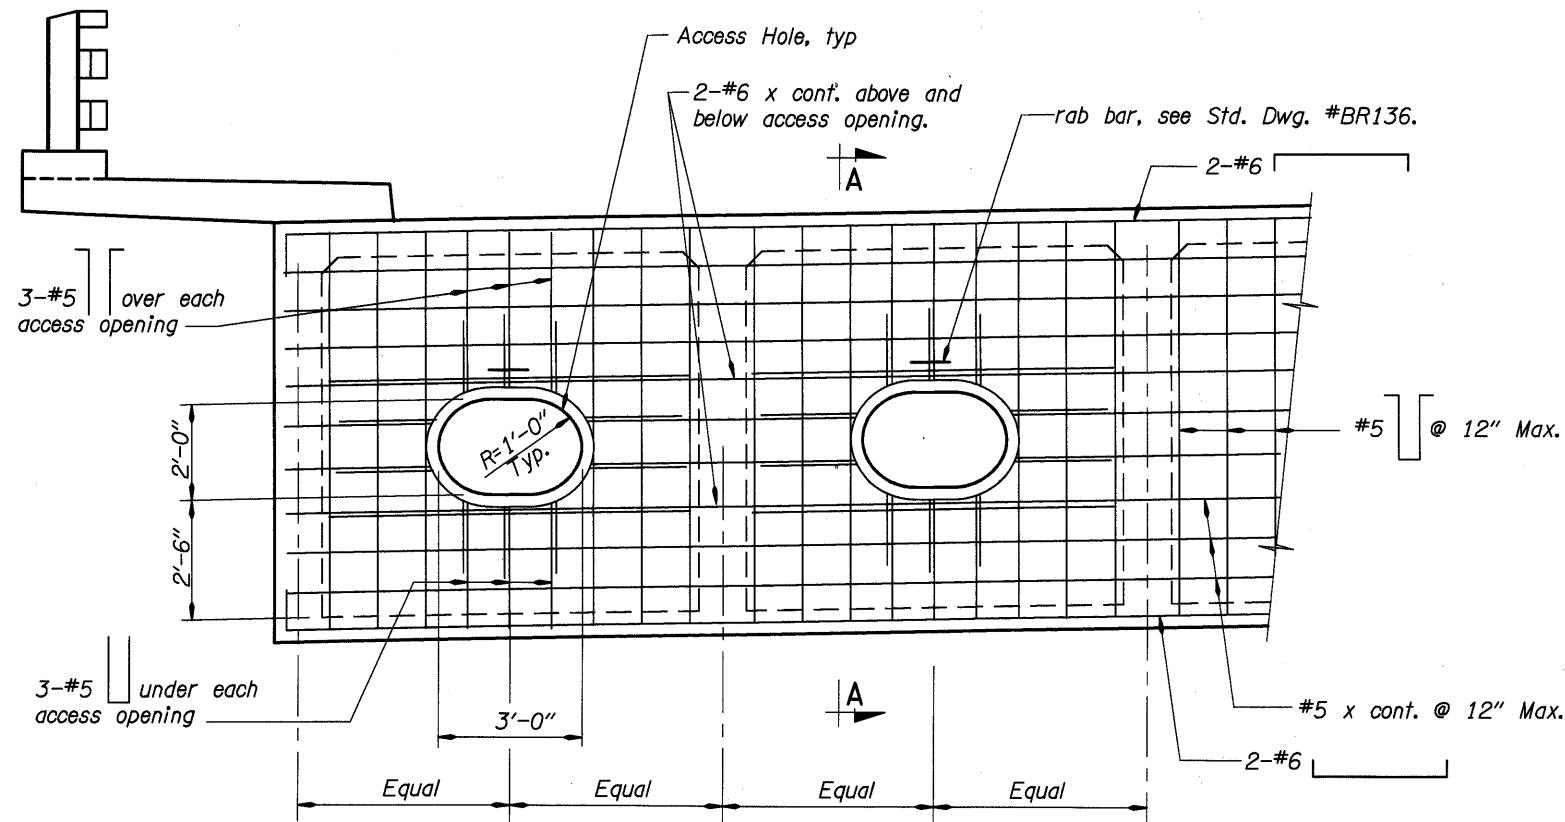

**TYPICAL DIAPHRAGM ELEVATION**

Scale: 1/2" = 1'-0"  
 For additional reinforcement at access opening, see Std. Dwg. #BR136.

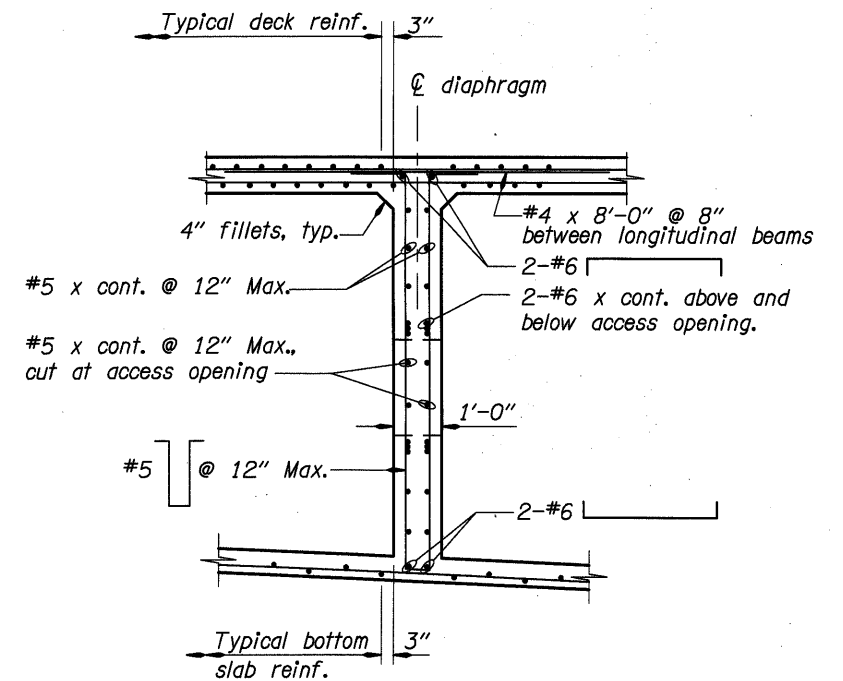

**SECTION A-A**

Scale: 1/2" = 1'-0"




**Note:**  
 See Dwg. #70336 and #70337 for deck drainage details.

See Dwg. #70343 to #70355 for lighting details and conduit locations.

See Dwg. #70360 for utility conduit and hanger details.

DO NOT SCALE THIS DRAWING. FOLLOW DIMENSIONS. INDICATED SCALES CORRECT ONLY FOR FULL SIZE SHEET (22"x34").


DATE	03/09	REVISION	As-Constructed	BY	Ken Johnson	DESIGNER	 DAVID EVANS AND ASSOCIATES INC. 530 Center Street N.E., Suite 605 Salem Oregon 97301 Phone: 503.361.8635 EXPIRES: 12-31-05	 MULTNOMAH COUNTY BRIDGES TRANSPORTATION DIVISION	BRIDGE NO.	20136	SHEET	86
	DRAFTED:		Josh Hewes		DATE				Sept. 2005	OF		173
CHECKED:	Adrienne Dietrich	REVIEWED:		REVIEWED:		 OREGON DEPARTMENT OF TRANSPORTATION BRIDGE ENGINEERING SECTION	CALC. BOOK		MULTNOMAH CHANNEL & PNWR ETC., SAUVIE ISLAND RD.	DRAWING NO.	70273	

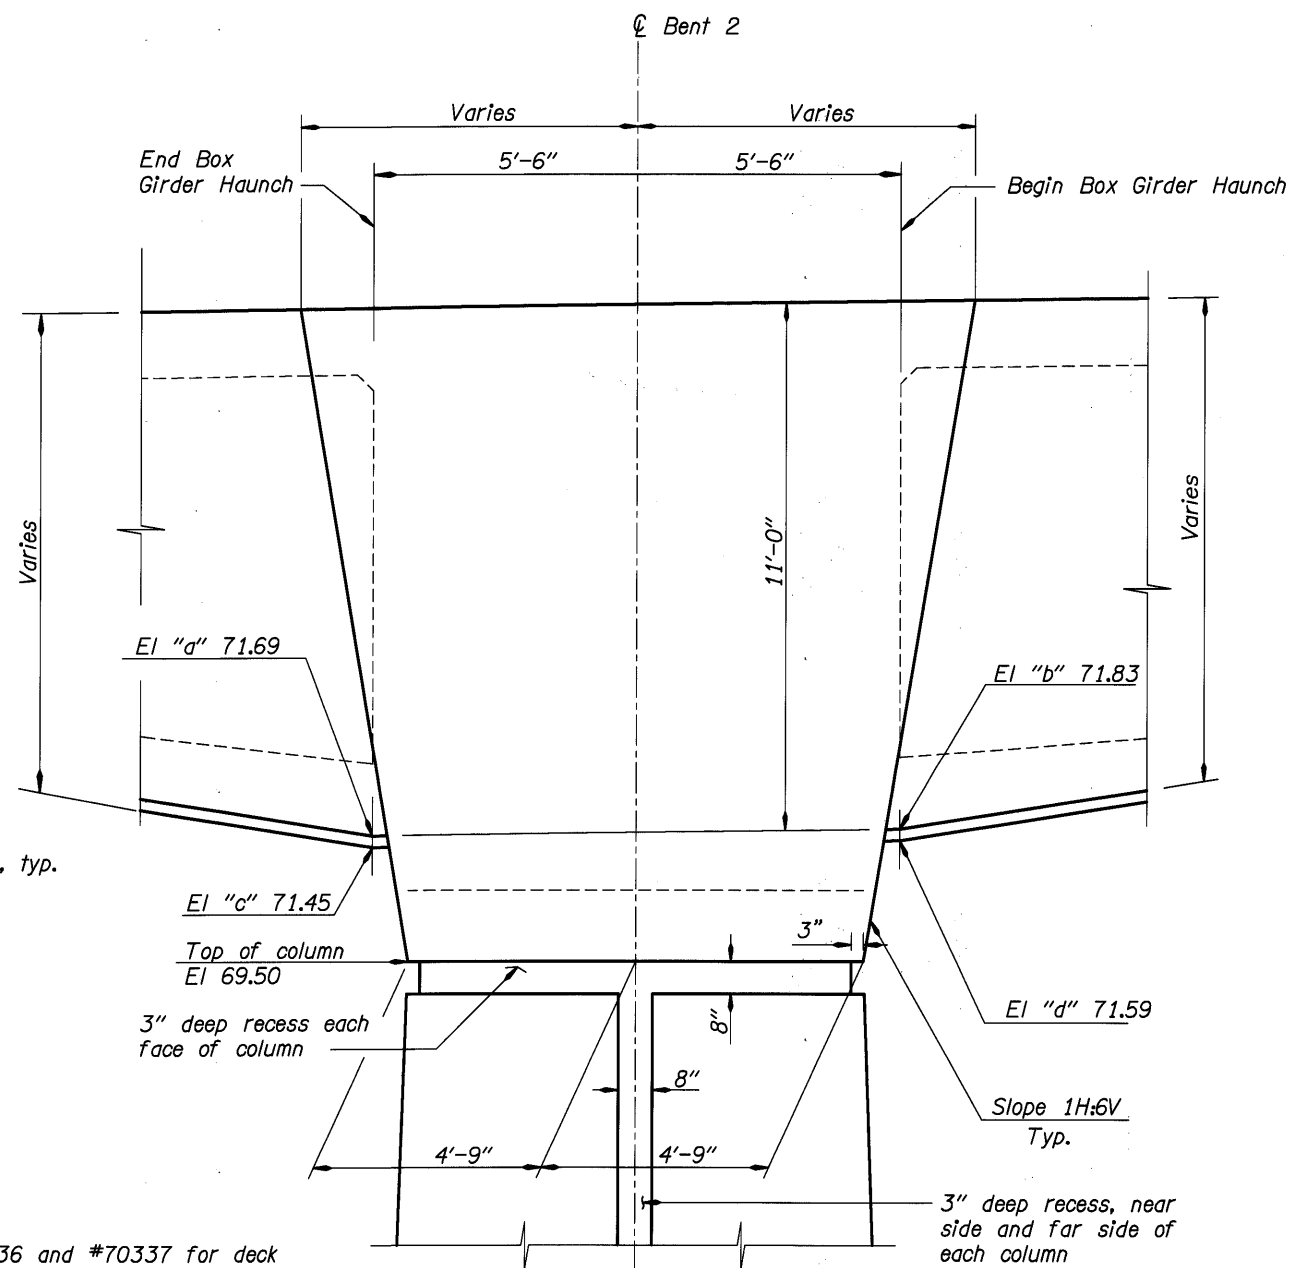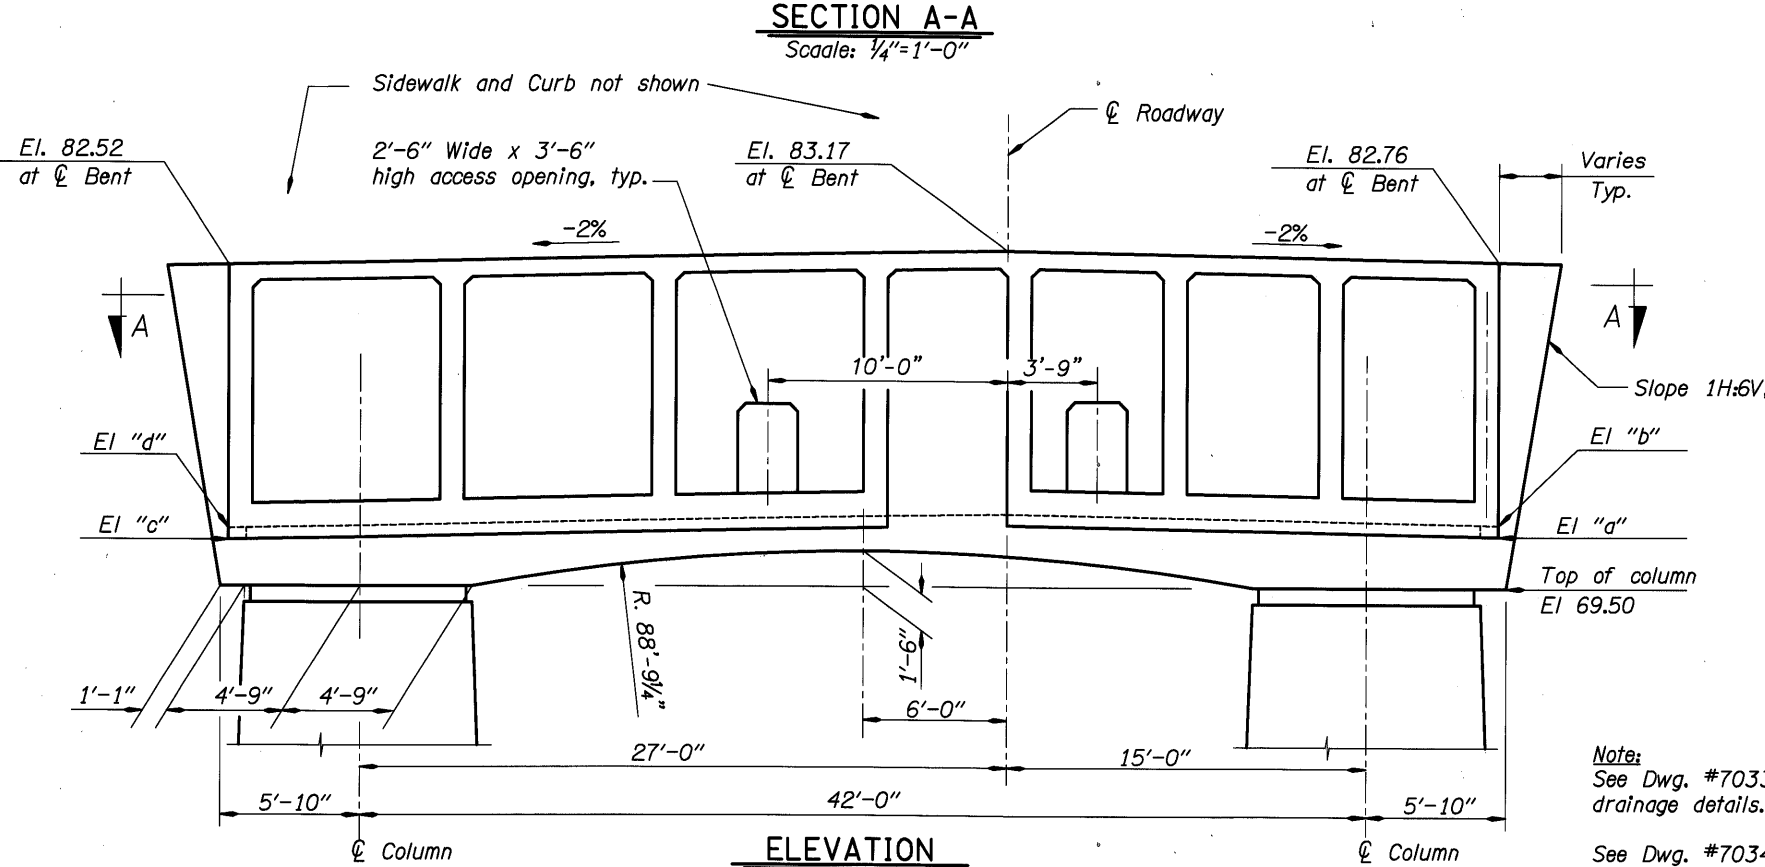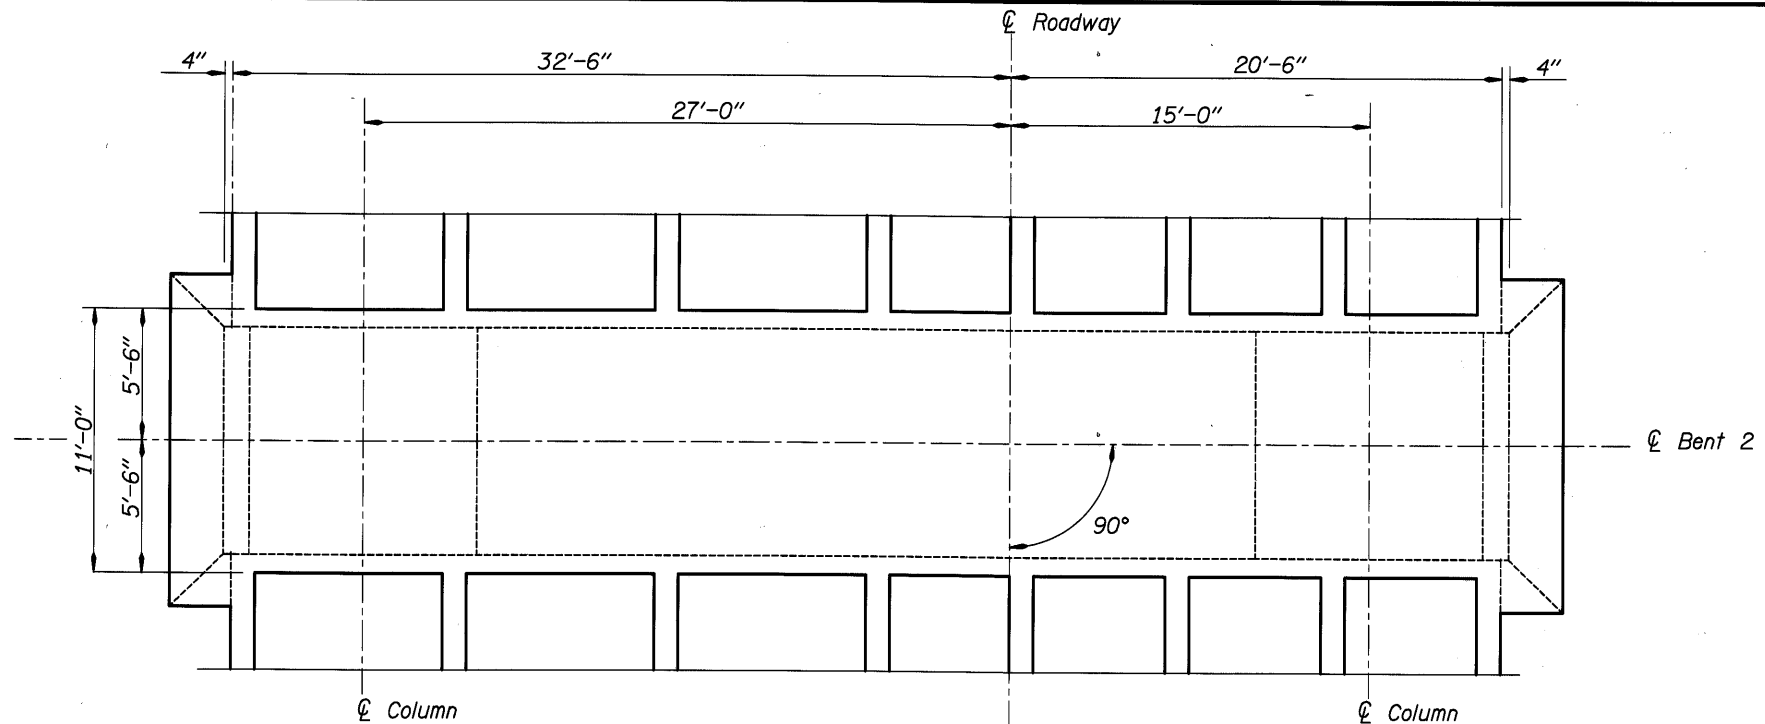

Note:  
See Dwg. #70336 and #70337 for deck drainage details.  
See Dwg. #70343 to #70355 for lighting details and conduit locations.  
See Dwg. #70360 for utility conduit and hanger details.

DO NOT SCALE THIS DRAWING.  
FOLLOW DIMENSIONS. INDICATED  
SCALES CORRECT ONLY FOR  
FULL SIZE SHEET (22"x34").

	DATE	REVISION	BY	DESIGNER Ken Johnson DRAFTED: Ken Johnson CHECKED: Josh Hewes REVIEWED: Adrienne Dietrich	DAVID EVANS AND ASSOCIATES INC. 530 Center Street N.E., Suite 605 Salem Oregon 97301 Phone: 503.361.8635 EXPIRES: 12-31-05	BRIDGE NO. 20136 DATE Sept. 2005 CALC. BOOK	MULTNOMAH COUNTY TRANSPORTATION DIVISION OREGON DEPARTMENT OF TRANSPORTATION BRIDGE ENGINEERING SECTION	MULTNOMAH CHANNEL & PNWR ETC., SAUVIE ISLAND RD.	SHEET 87 OF 173 DRAWING NO. 70274
	08/05	Revised Columns	KWC						
	03/09	As-Constructed	TDF						

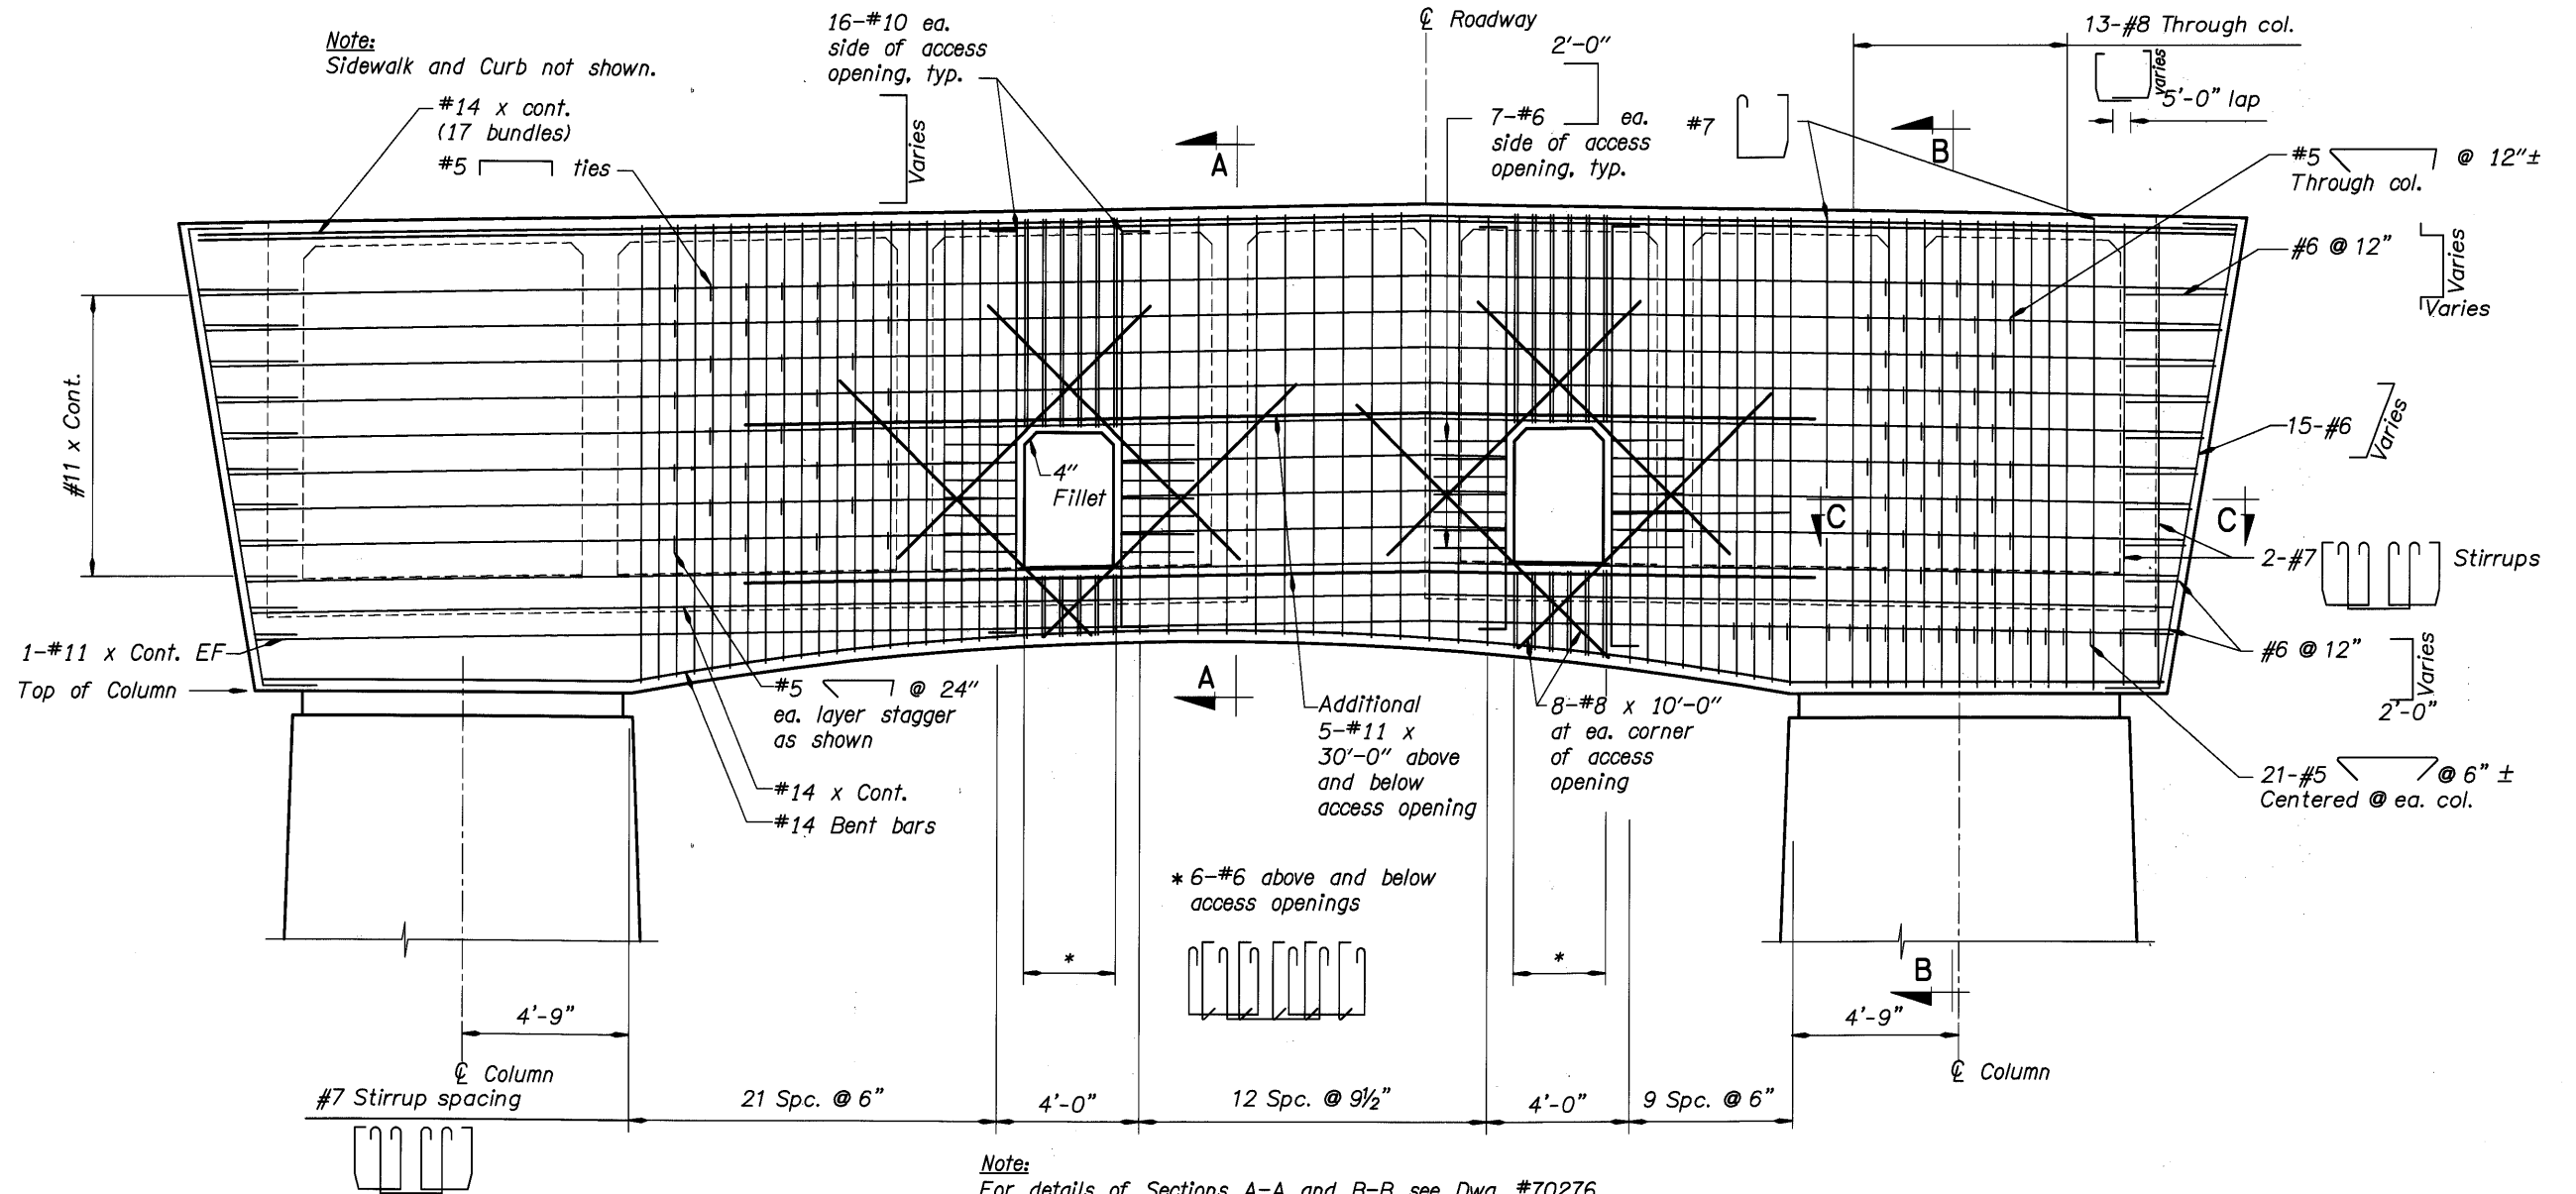


Note:  
For details of Sections A-A and B-B see Dwg. #70276.  
For details of Sections C-C see Dwg. #70277.

**ELEVATION**  
Scale: 3/8"=1'-0"


DO NOT SCALE THIS DRAWING.  
FOLLOW DIMENSIONS. INDICATED  
SCALES CORRECT ONLY FOR  
FULL SIZE SHEET (22"x34").

	DATE	REVISION	BY	DRAFTED: Ken Johnson CHECKED: Josh Hewes REVIEWED: Adrienne Dietrich		DAVID EVANS AND ASSOCIATES INC. 530 Center Street N.E., Suite 605 Salem Oregon 97301 Phone: 503.361.8635	MULTNOMAH COUNTY BRIDGES OREGON DEPARTMENT OF TRANSPORTATION BRIDGE ENGINEERING SECTION	BRIDGE NO.	MULTNOMAH CHANNEL & PNWR ETC., SAUVIE ISLAND RD.	SHEET
	08/05	Revised Columns	KWC					20136		88
	03/09	As-Constructed	TDF					DATE Sept. 2005		OF 173.
								CALC. BOOK	BENT 2 - INTEGRAL X-BEAM DETAILS (1 OF 3)	DRAWING NO. 70275

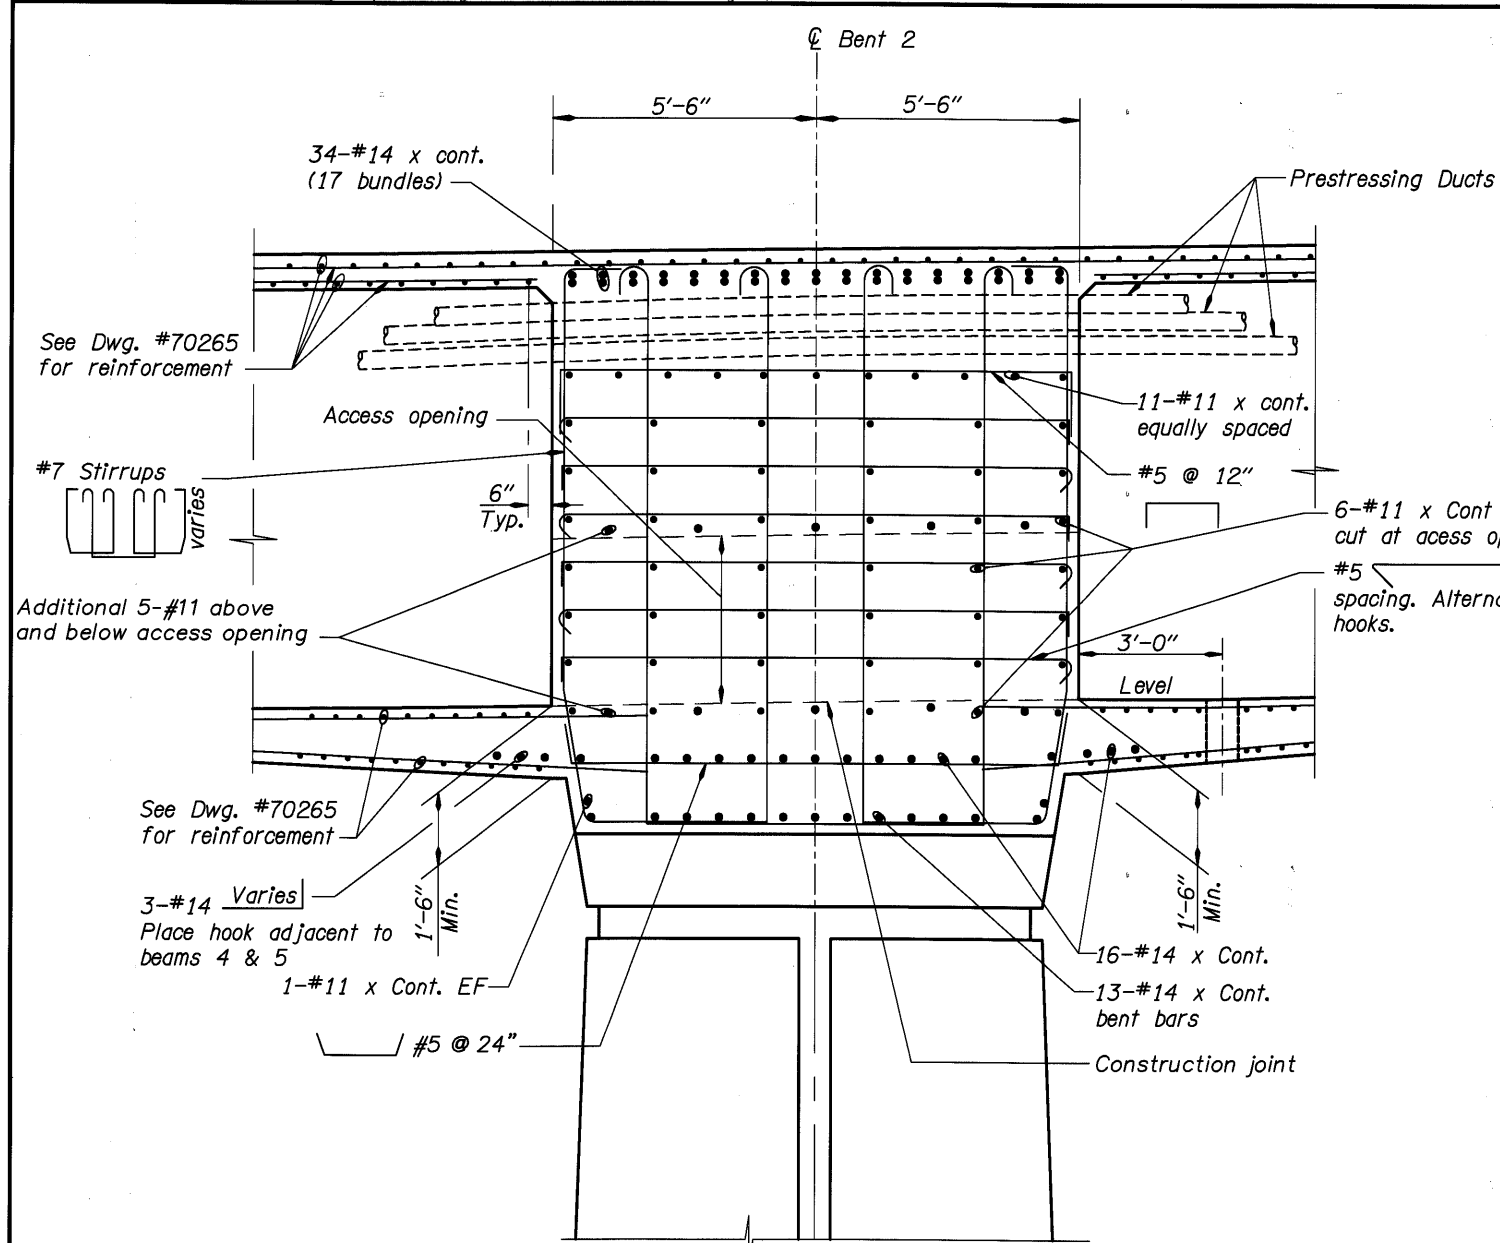

**SECTION A-A**  
Scale: 1/2"=1'-0"

**Note:**  
For Section A-A and B-B location,  
see Dwg. #70275.

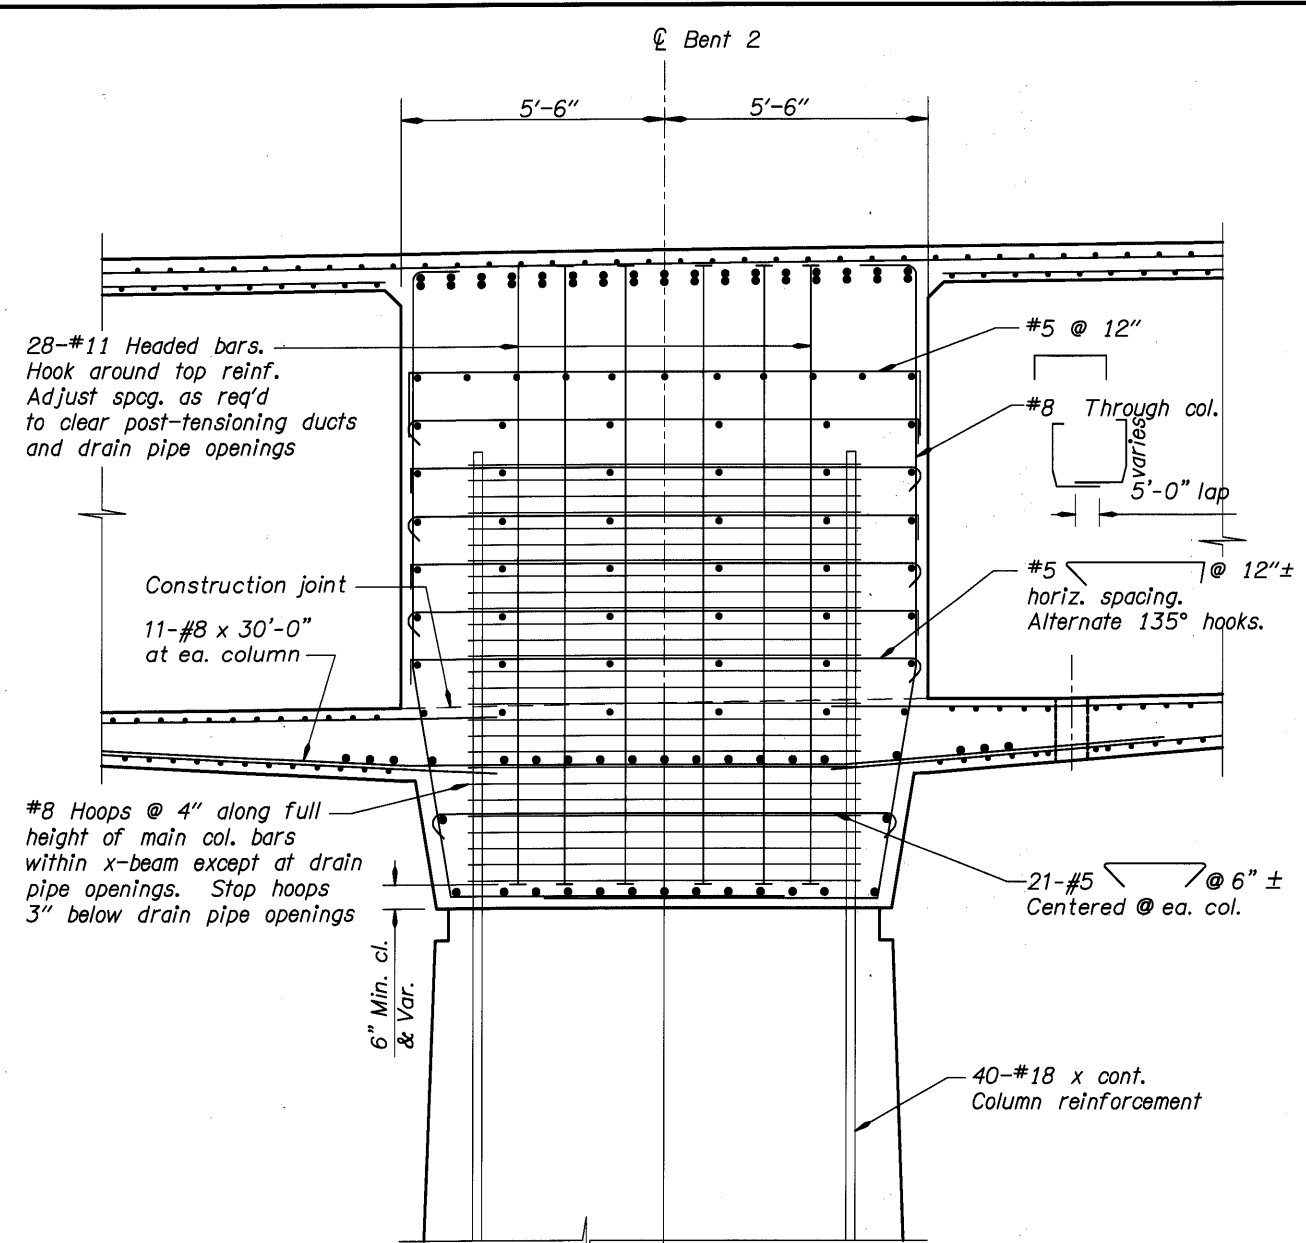

**SECTION B-B**  
Scale: 1/2"=1'-0"


**Note:**  
For details not shown, see Section A-A.

DO NOT SCALE THIS DRAWING.  
FOLLOW DIMENSIONS. INDICATED  
SCALES CORRECT ONLY FOR  
FULL SIZE SHEET (22"x34").

	DATE	REVISION	BY	Ken Johnson DRAFTED:	<b>DESIGNER</b>  <b>DAVID EVANS AND ASSOCIATES INC.</b> 530 Center Street N.E., Suite 605 Salem Oregon 97301 Phone: 503.361.8635	 TRANSPORTATION DIVISION	BRIDGE NO.	MULTNOMAH CHANNEL & PNWR ETC., SAUVIE ISLAND RD.	SHEET 89 OF 173
	08/05	Revised Columns	KWC				20136		
	03/09	As-Constructed	TDF	Josh Hewes CHECKED:	<b>OREGON DEPARTMENT OF TRANSPORTATION                  BRIDGE ENGINEERING SECTION</b>	DATE	DRAWING NO. 70276		
				Adrienne Dietrich REVIEWED:		Sept. 2005			
						CALC. BOOK	BENT 2 INTEGRAL X-BEAM DETAILS (2 OF 3)		






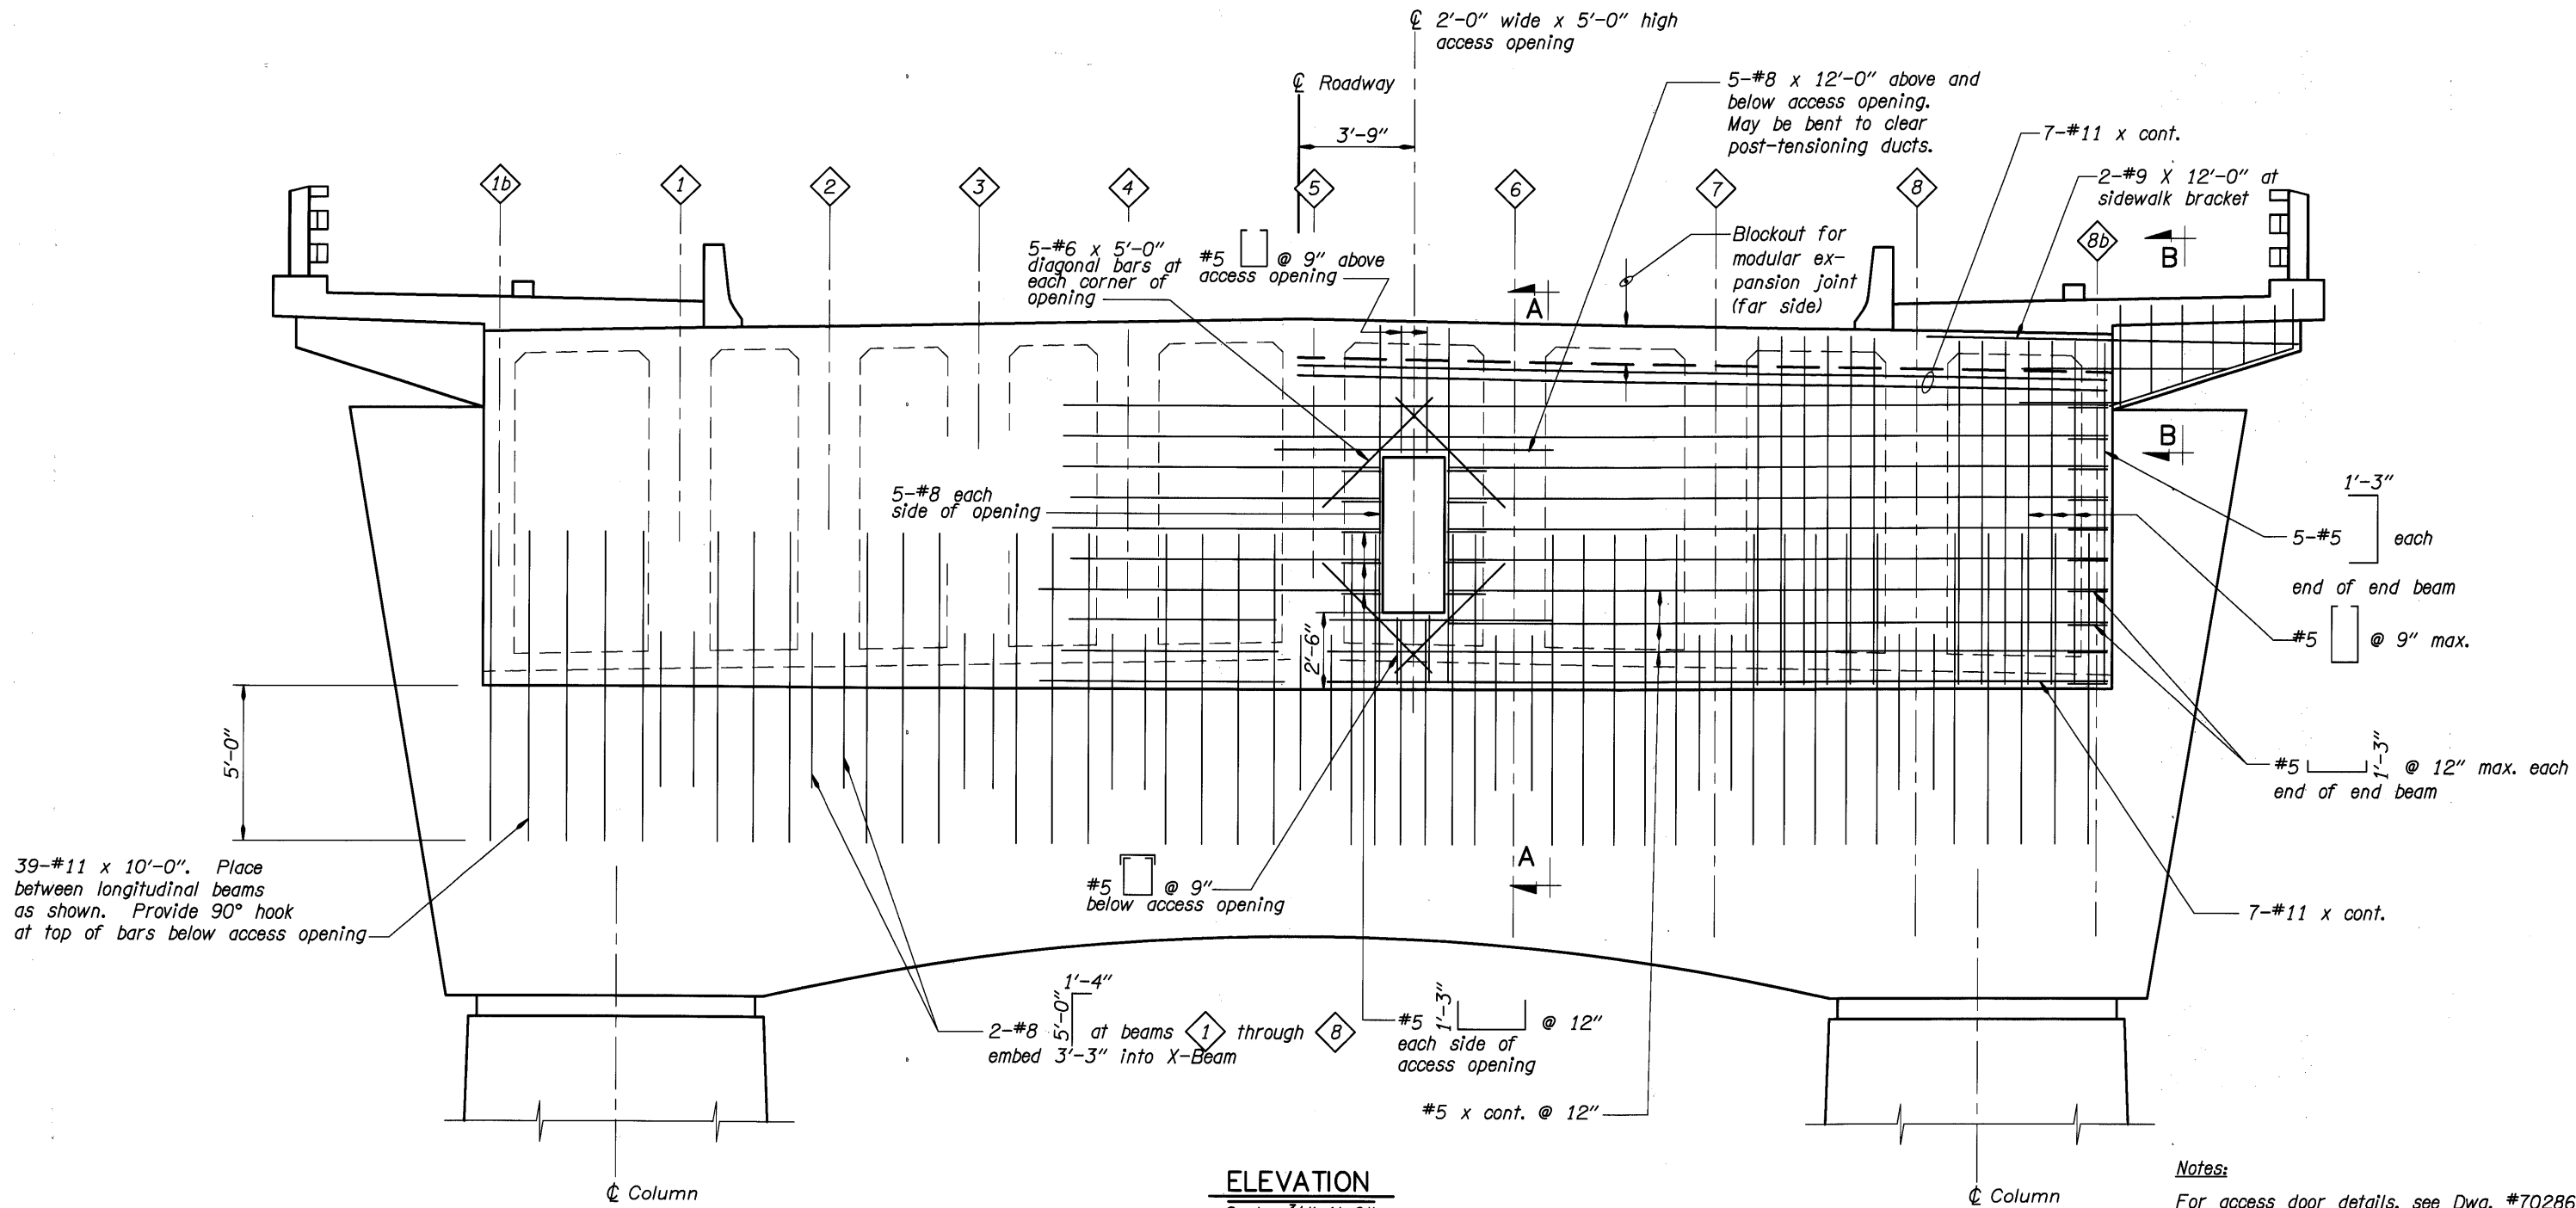


**Notes:**  
 For access door details, see Dwg. #70286.  
 For Sections A-A, see Dwg. # 70279.  
 For Section B-B, see Dwg. #70279.  
 See Dwg. #70336 and #70337 for deck drainage details.  
 See Dwg. #70343 to #70355 for lighting details and conduit locations.  
 See Dwg. #70360 for utility conduit and hanger details.

DO NOT SCALE THIS DRAWING. FOLLOW DIMENSIONS. INDICATED SCALES CORRECT ONLY FOR FULL SIZE SHEET (22"x34").

	DATE	REVISION	BY	DESIGNER Ken Johnson DRAFTED: Josh Hewes CHECKED: Adrienne Dietrich REVIEWED:	DAVID EVANS AND ASSOCIATES INC. 530 Center Street N.E., Suite 605 Salem Oregon 97301 Phone: 503.361.8635 EXPIRES: 12-31-05	MULTNOMAH COUNTY BRIDGES TRANSPORTATION DIVISION OREGON DEPARTMENT OF TRANSPORTATION BRIDGE ENGINEERING SECTION	BRIDGE NO.	MULTNOMAH CHANNEL & PNWR ETC., SAUVIE ISLAND RD.	SHEET
	08/05	Revised Columns	KWC				20136		91
	03/09	As-Constructed	TDF				DATE Sept. 2005		OF 173
							CALC. BOOK	BENT 3 - END BEAM DETAILS (1 OF 2)	DRAWING NO. 70278

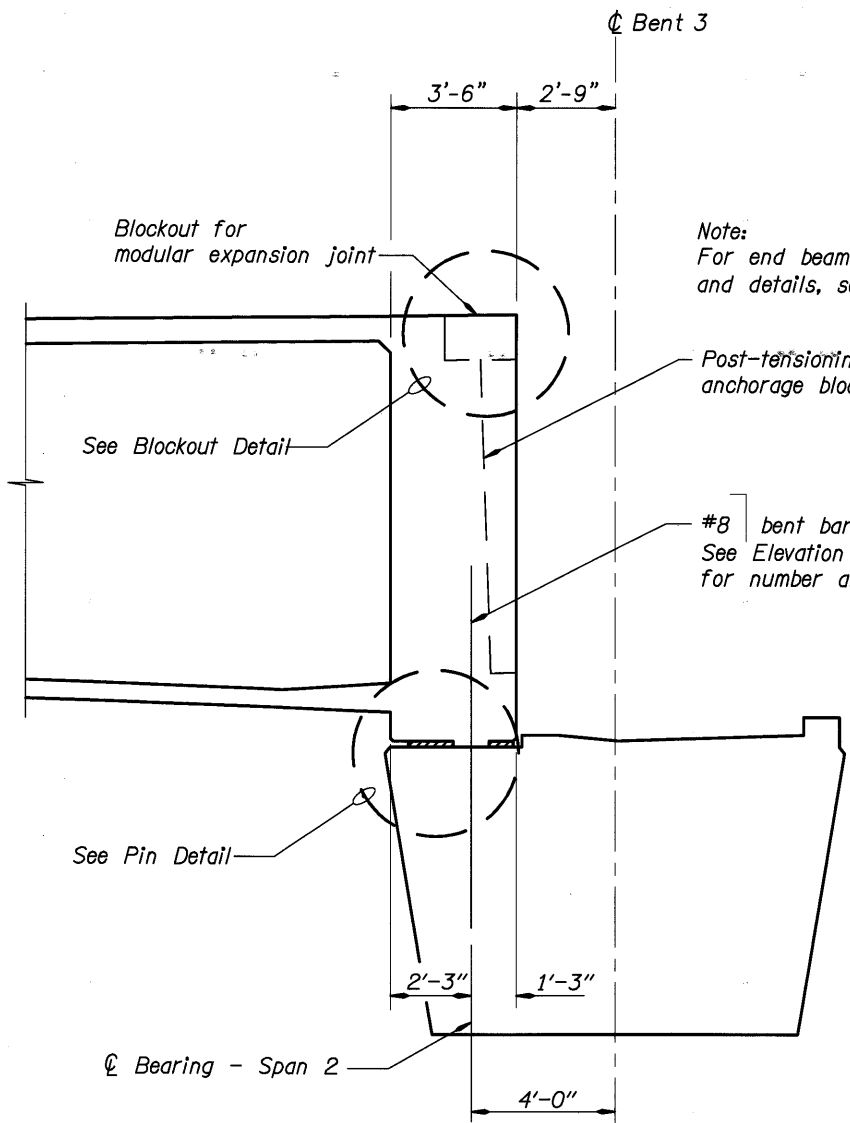


**SECTION A-A**  
Scale: 3/8"=1'-0"

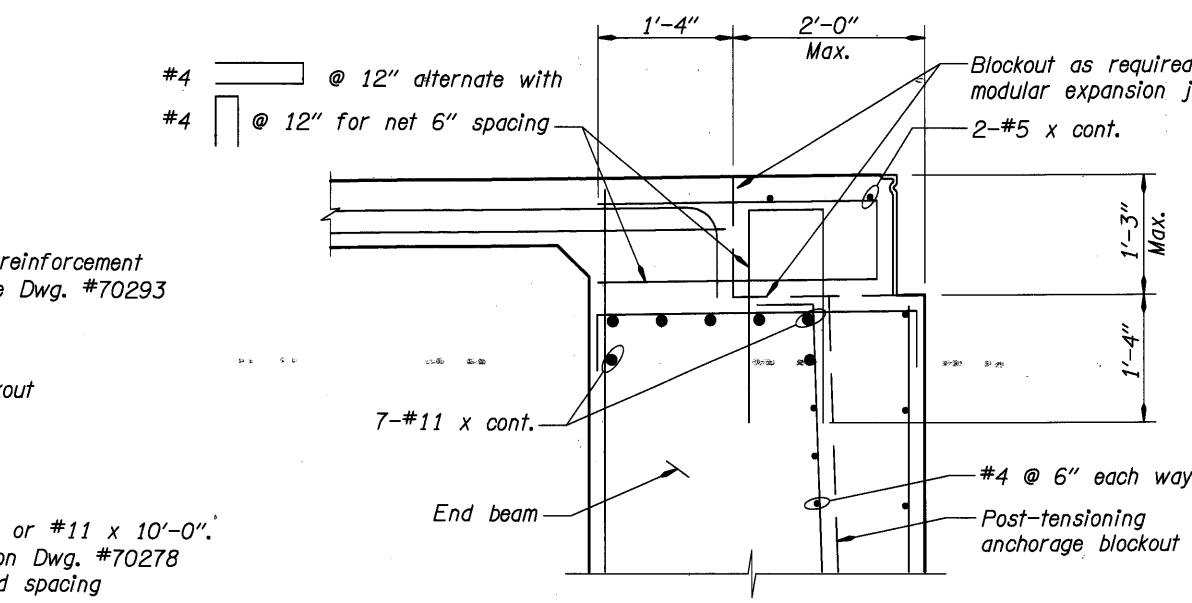


**BLOCKOUT DETAIL**  
Scale: 1"=1'-0"

**Notes:**  
Blockout reinforcing may be manipulated as necessary to accommodate installation at the joint seal assembly upon approval of the joint shop plans and as directed by the Engineer.  
For end beam reinforcement and details not shown, see Dwg. #70293.

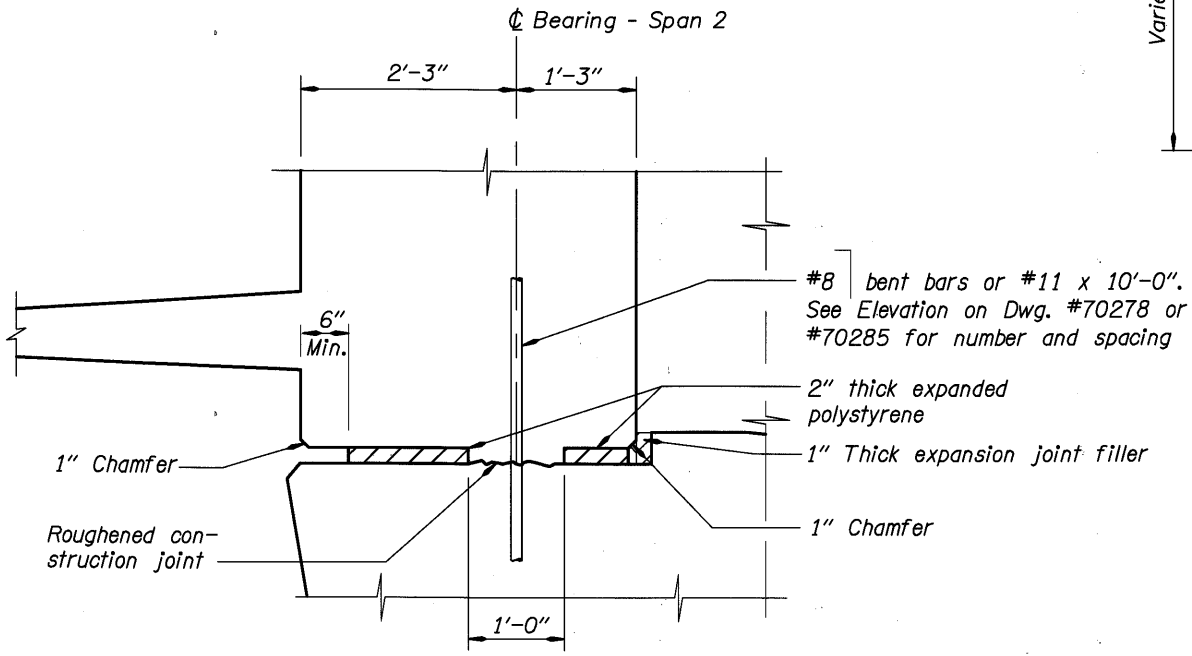

**PIN DETAIL**  
Scale: 1"=1'-0"  
Bent 3 shown, Bent 4 similar.

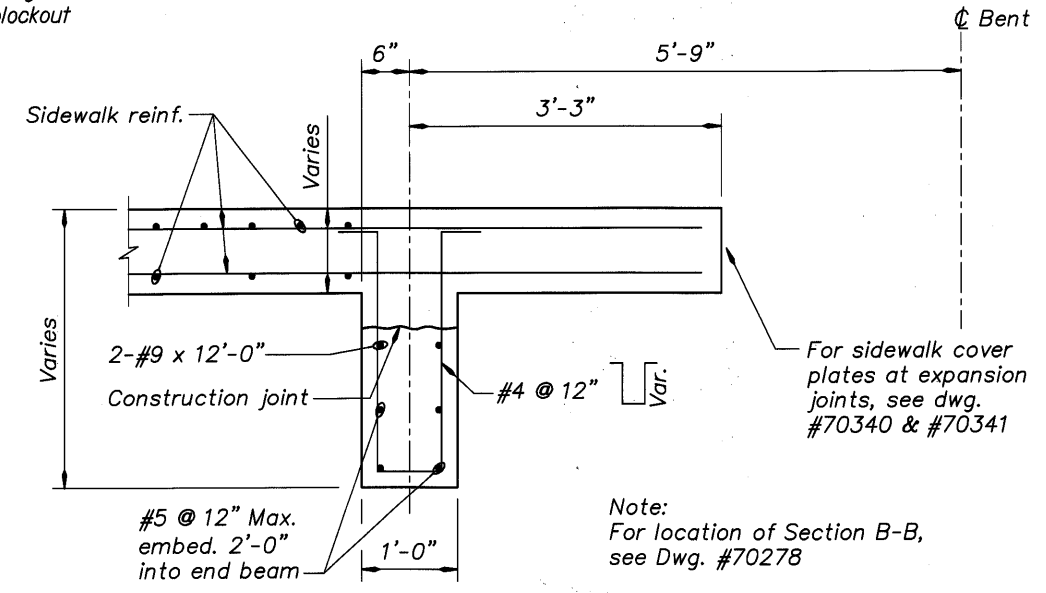


**SECTION B-B**  
Scale: 1"=1'-0"

**Note:**  
For location of Section B-B, see Dwg. #70278

DO NOT SCALE THIS DRAWING. FOLLOW DIMENSIONS. INDICATED SCALES CORRECT ONLY FOR FULL SIZE SHEET (22"x34").


DATE	03/09	REVISION	As-Constructed	BY	Ken Johnson	DESIGNER	 DAVID EVANS AND ASSOCIATES INC. 530 Center Street N.E., Suite 605 Salem Oregon 97301 Phone: 503.361.8635	 MULTNOMAH COUNTY BRIDGES TRANSPORTATION DIVISION	BRIDGE NO.	20136	SHEET	92
	DRAFTED:		Josh Hewes		DATE					Sept. 2005		OF
				CHECKED:	Adrienne Dietrich	DESIGNER	 KENT WILLIAM CORVITZ REGISTERED PROFESSIONAL ENGINEER 474848 PE OREGON MARCH 09, 2004	 OREGON DEPARTMENT OF TRANSPORTATION BRIDGE ENGINEERING SECTION	CALC. BOOK		DRAWING NO.	70279
										MULTNOMAH CHANNEL & PNWR ETC., SAUVIE ISLAND RD.		
										BENT 3 - END BEAM DETAILS (2 OF 2)		

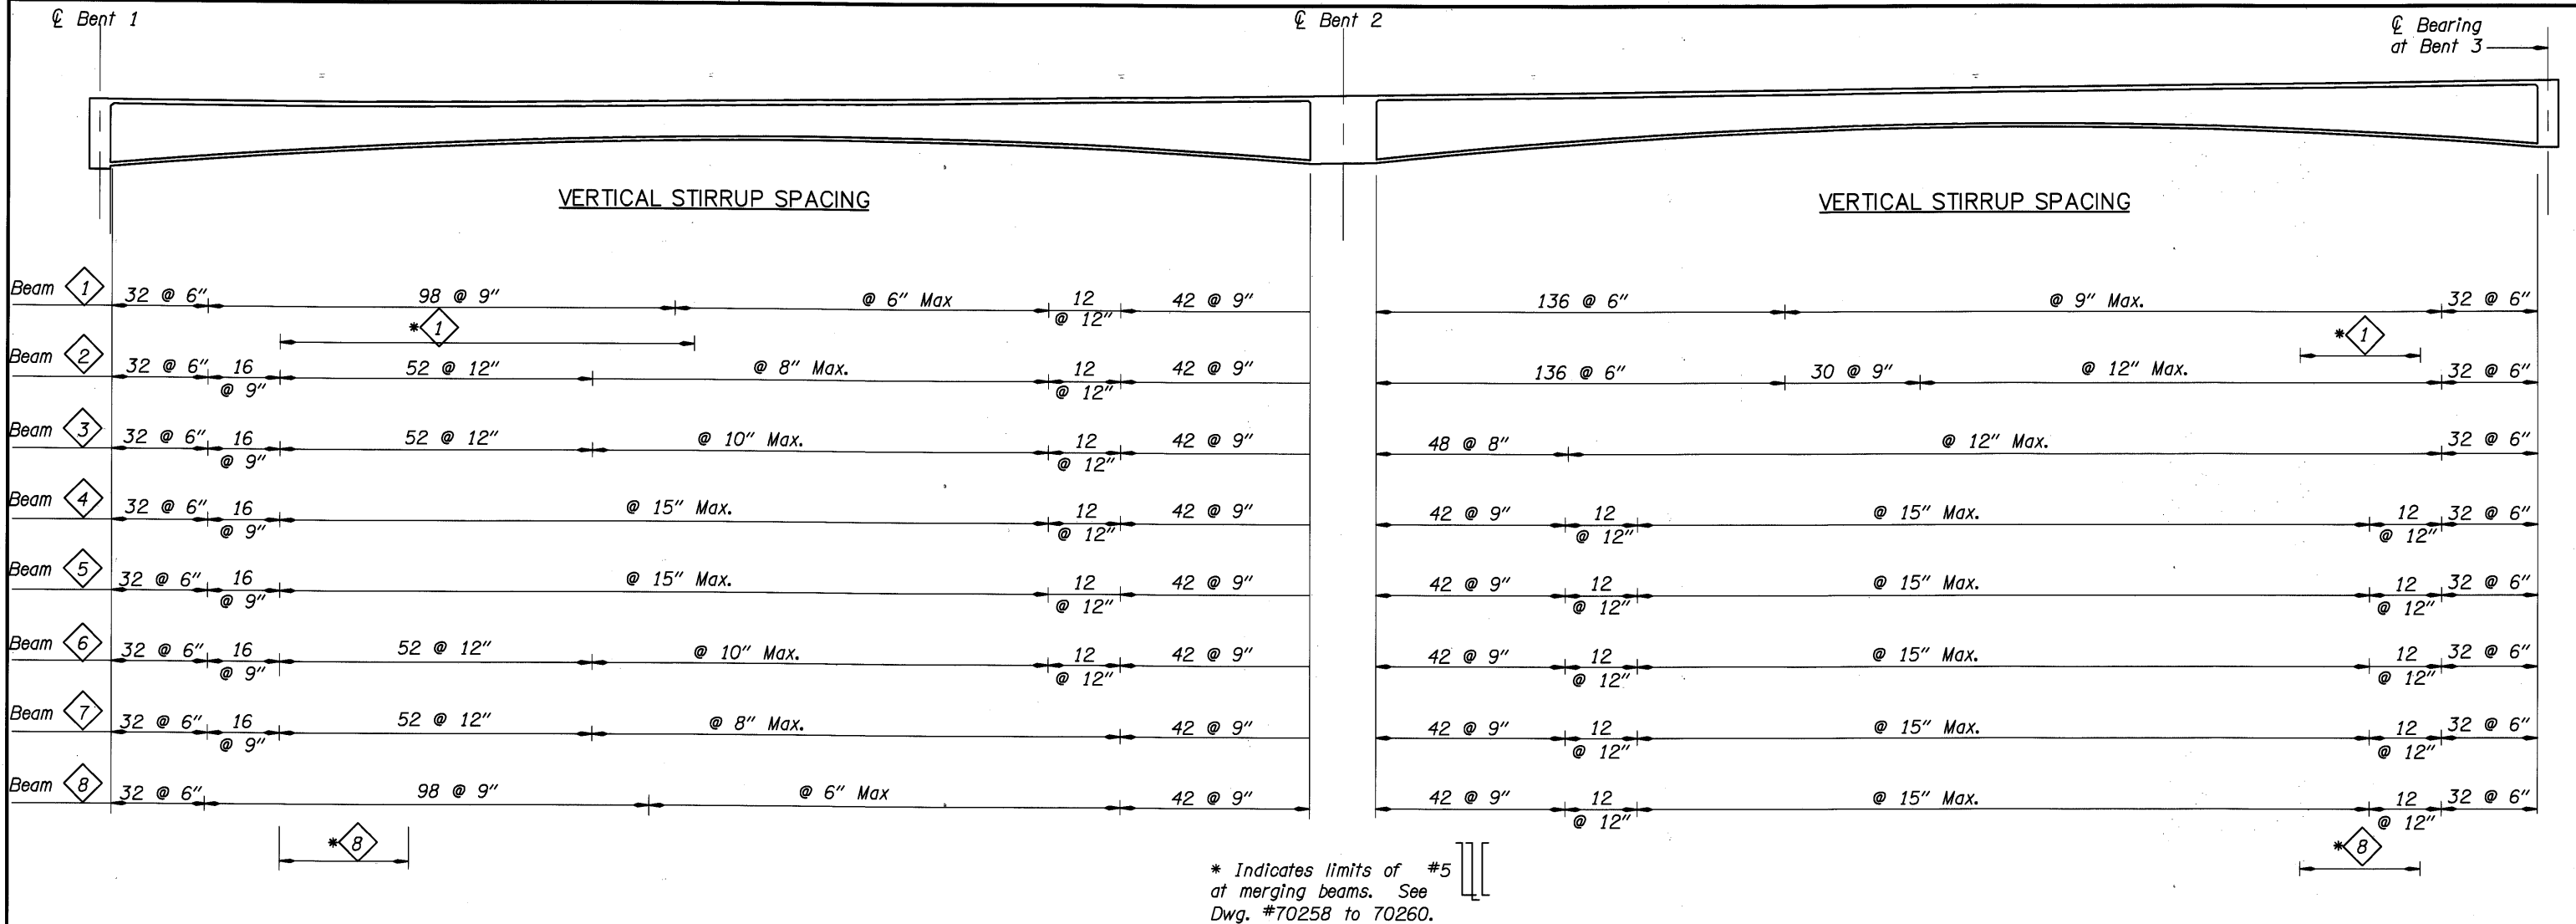

**LONGITUDINAL BEAM ELEVATION - SPANS 1 AND 2**

No Scale

**Note:**  
Camber is designed to compensate for deflection due to post-tensioning, the dead load of all concrete and reinforcing steel and the long term effects of shrinkage and creep.

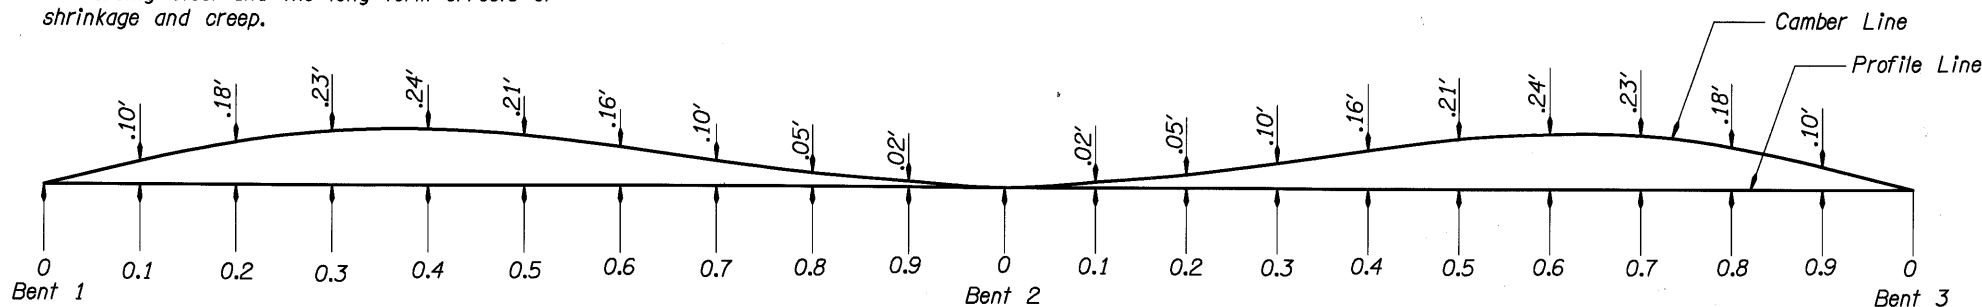

**CAMBER DIAGRAM**


No Scale

**Notes:**

- Spacing of #5 stirrups is measured along  $\bar{C}$  Beam.
- Stirrups are #5  $\left[ \right]$  at Beams  $\diamond 1$  and  $\diamond 8$   
 #5  $\left[ \right]$  at Beams  $\diamond 4$  and  $\diamond 5$  in Span 1,  
 #5  $\left[ \right]$  at Beams  $\diamond 4$  and  $\diamond 5$  in Span 2,  
 and #5  $\left[ \right]$  at Beams  $\diamond 2$ ,  $\diamond 3$ ,  $\diamond 6$ , and  $\diamond 7$  unless noted otherwise.
- For stirrup spacing at Beams  $\diamond 1a$ ,  $\diamond 1b$ ,  $\diamond 8a$  and  $\diamond 8b$  see Dwg. #70267.

DO NOT SCALE THIS DRAWING. FOLLOW DIMENSIONS. INDICATED SCALES CORRECT ONLY FOR FULL SIZE SHEET (22"x34").


DATE 03/09	REVISION As-Constructed	BY TDF	DRAFTED: Ken Johnson				TRANSPORTATION DIVISION OREGON DEPARTMENT OF TRANSPORTATION BRIDGE ENGINEERING SECTION	BRIDGE NO. 20136	MULTNOMAH CHANNEL & PNWR ETC., SAUVIE ISLAND RD.	SHEET 93 OF 173.
			CHECKED: Gernot Komar					DESIGNED: Josh Hewes		DATE Sept. 2005

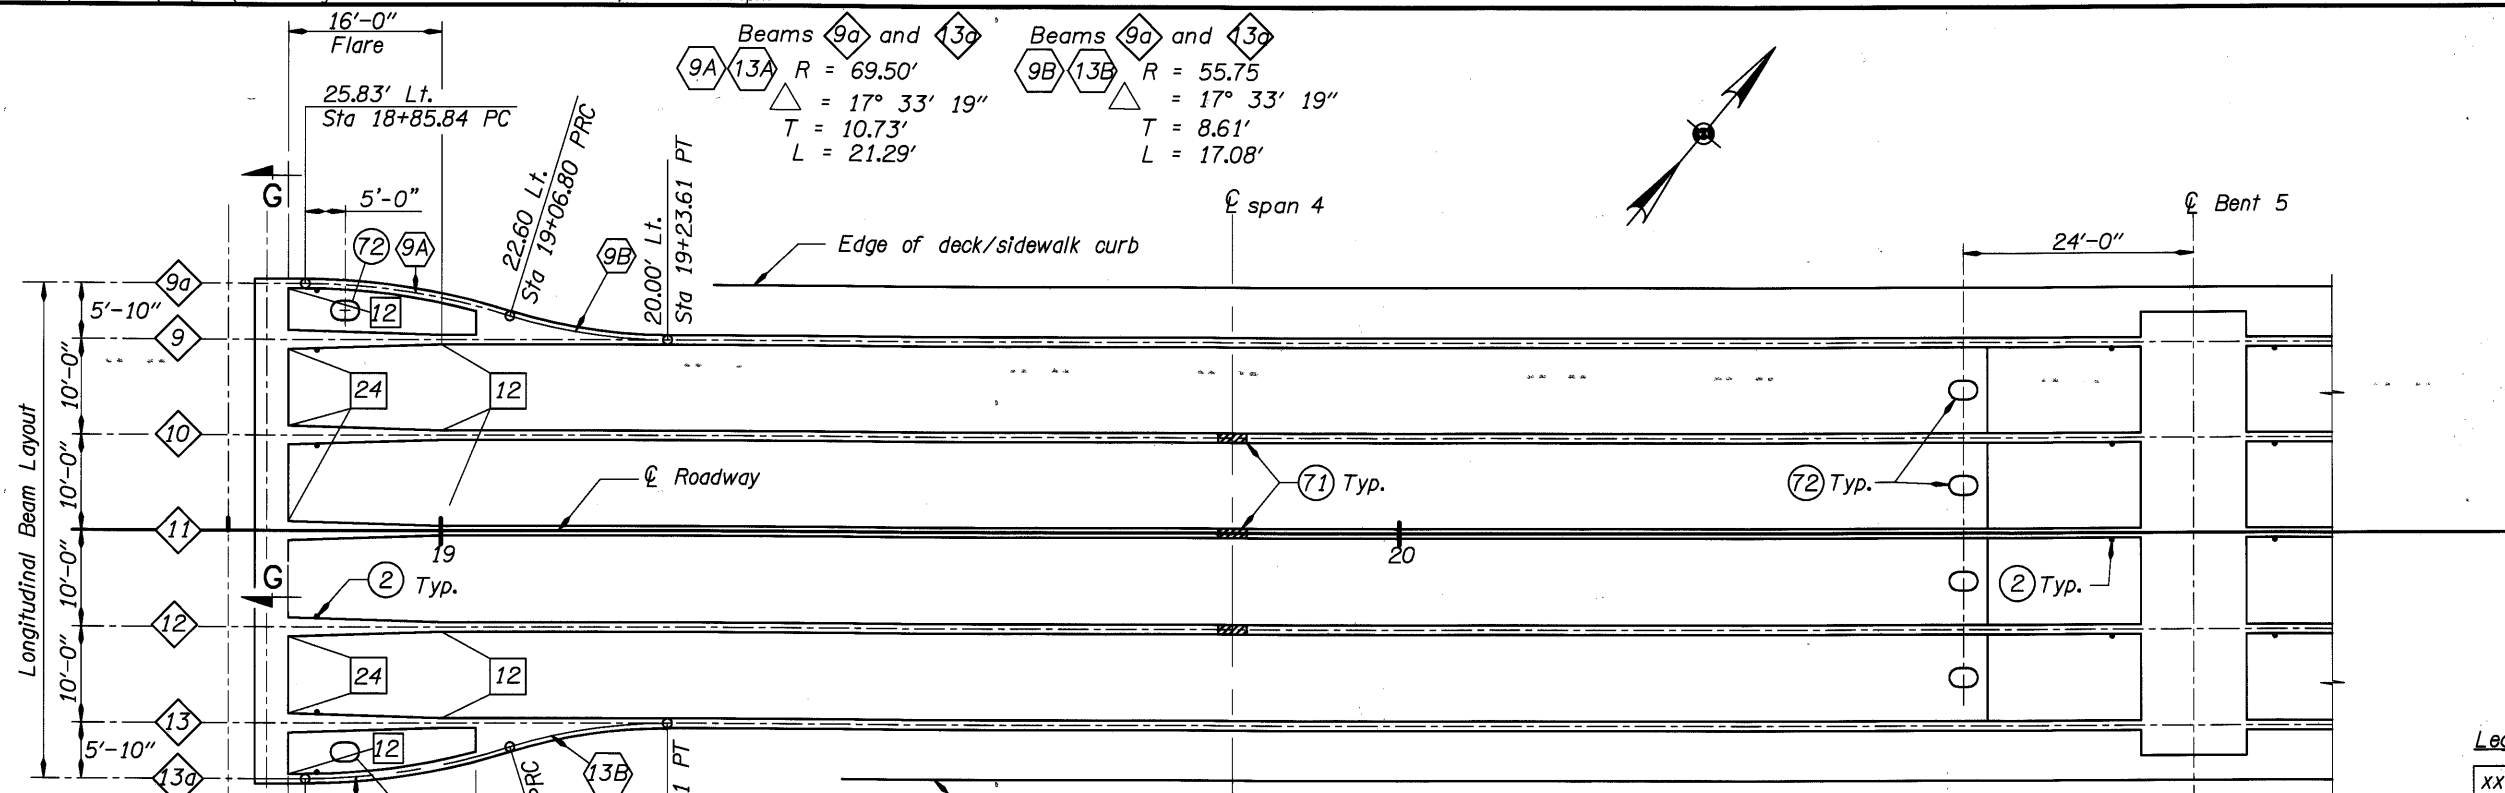

**LONGITUDINAL BEAM LAYOUT**

Scale : 1" = 10'

Span 4 L=201'-0"

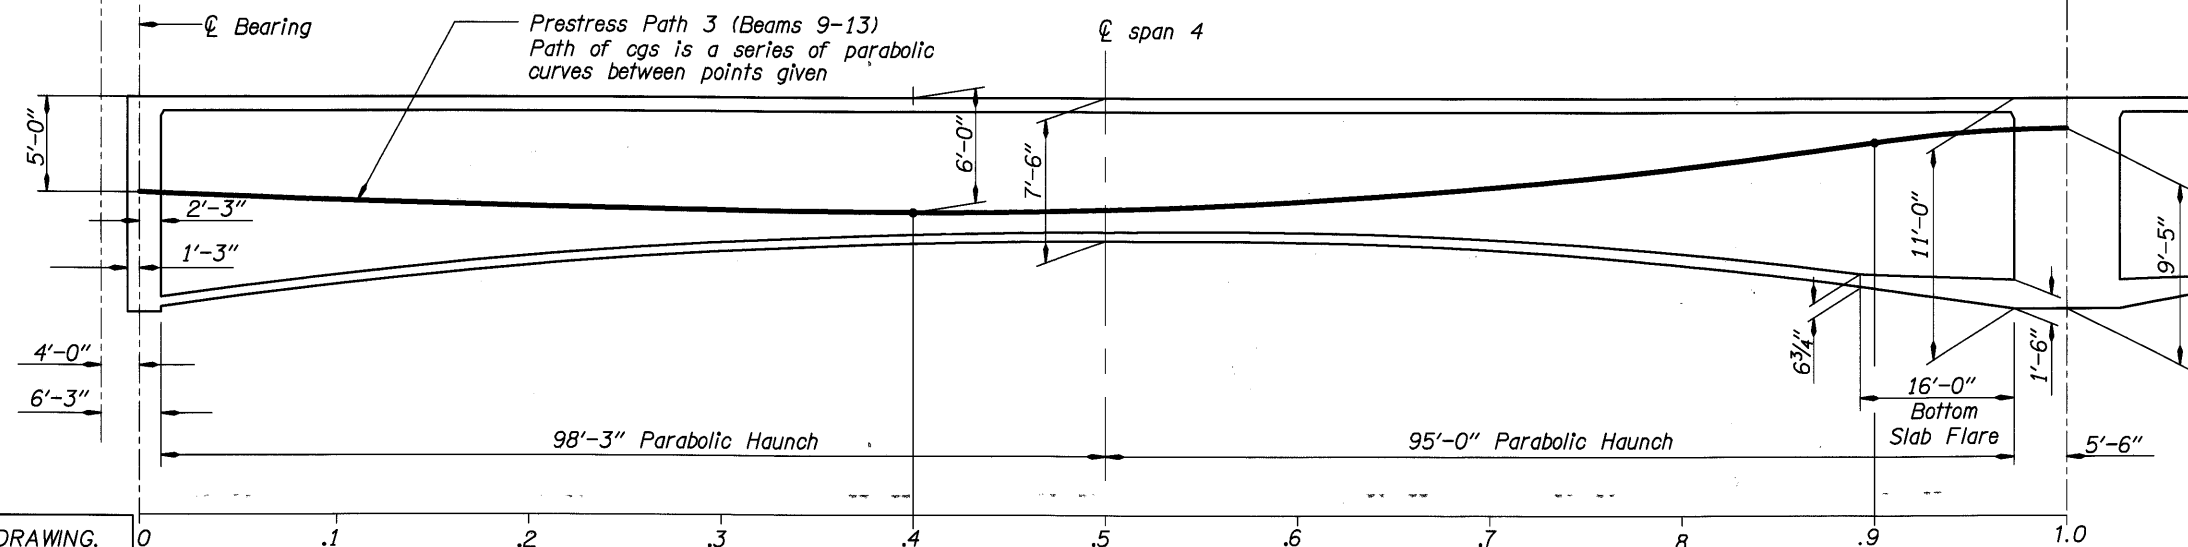

**LONGITUDINAL BEAM ELEVATION**

No Scale

**Legend:**

xx Denotes beam stem width in inches.

**Notes:**

For Section G-G see Dwg. #70264.


For reference notes, see Dwg. #70206.

For stirrup spacing and Camber Diagram, see Dwg. 70292.

For beams 9a and 13a reinforcement details, see Dwg. #70266 and #70267.


DO NOT SCALE THIS DRAWING. FOLLOW DIMENSIONS. INDICATED SCALES CORRECT ONLY FOR FULL SIZE SHEET (22"x34").

DATE 03/09	REVISION As-Constructed	BY TDF	DRAFTED: Ken Johnson			TRANSPORTATION DIVISION OREGON DEPARTMENT OF TRANSPORTATION BRIDGE ENGINEERING SECTION	BRIDGE NO. 20136	MULTNOMAH CHANNEL & PNWR ETC., SAUVIE ISLAND RD.	SHEET 94 OF 173
			CHECKED: Gernot Komar				DATE Sept. 2005		DRAWING NO. 70281
			DESIGNED: Adrienne Dietrich	EXPIRES: 12-31-05			CALC. BOOK	LONGITUDINAL BEAM LAYOUT - SPAN 4	

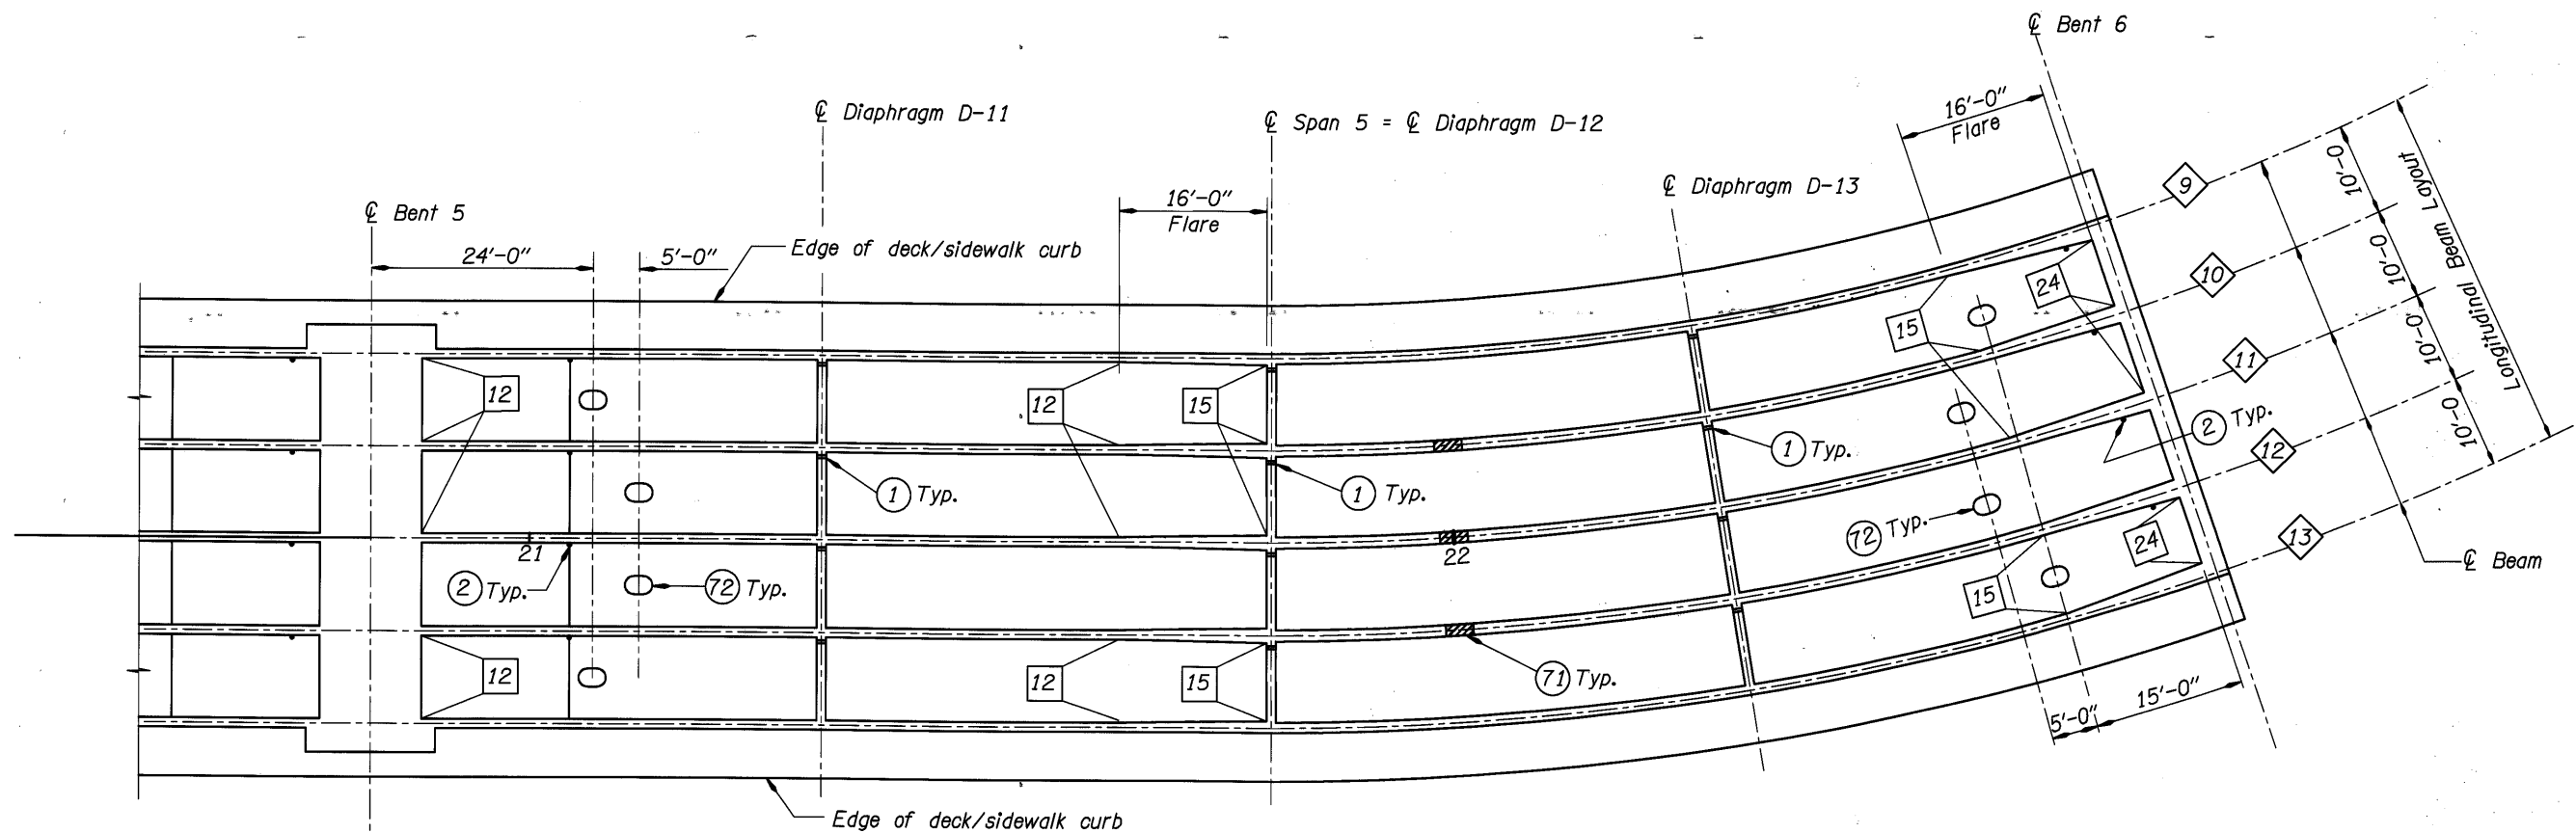

**LONGITUDINAL BEAM LAYOUT**

Scale : 1"=10'

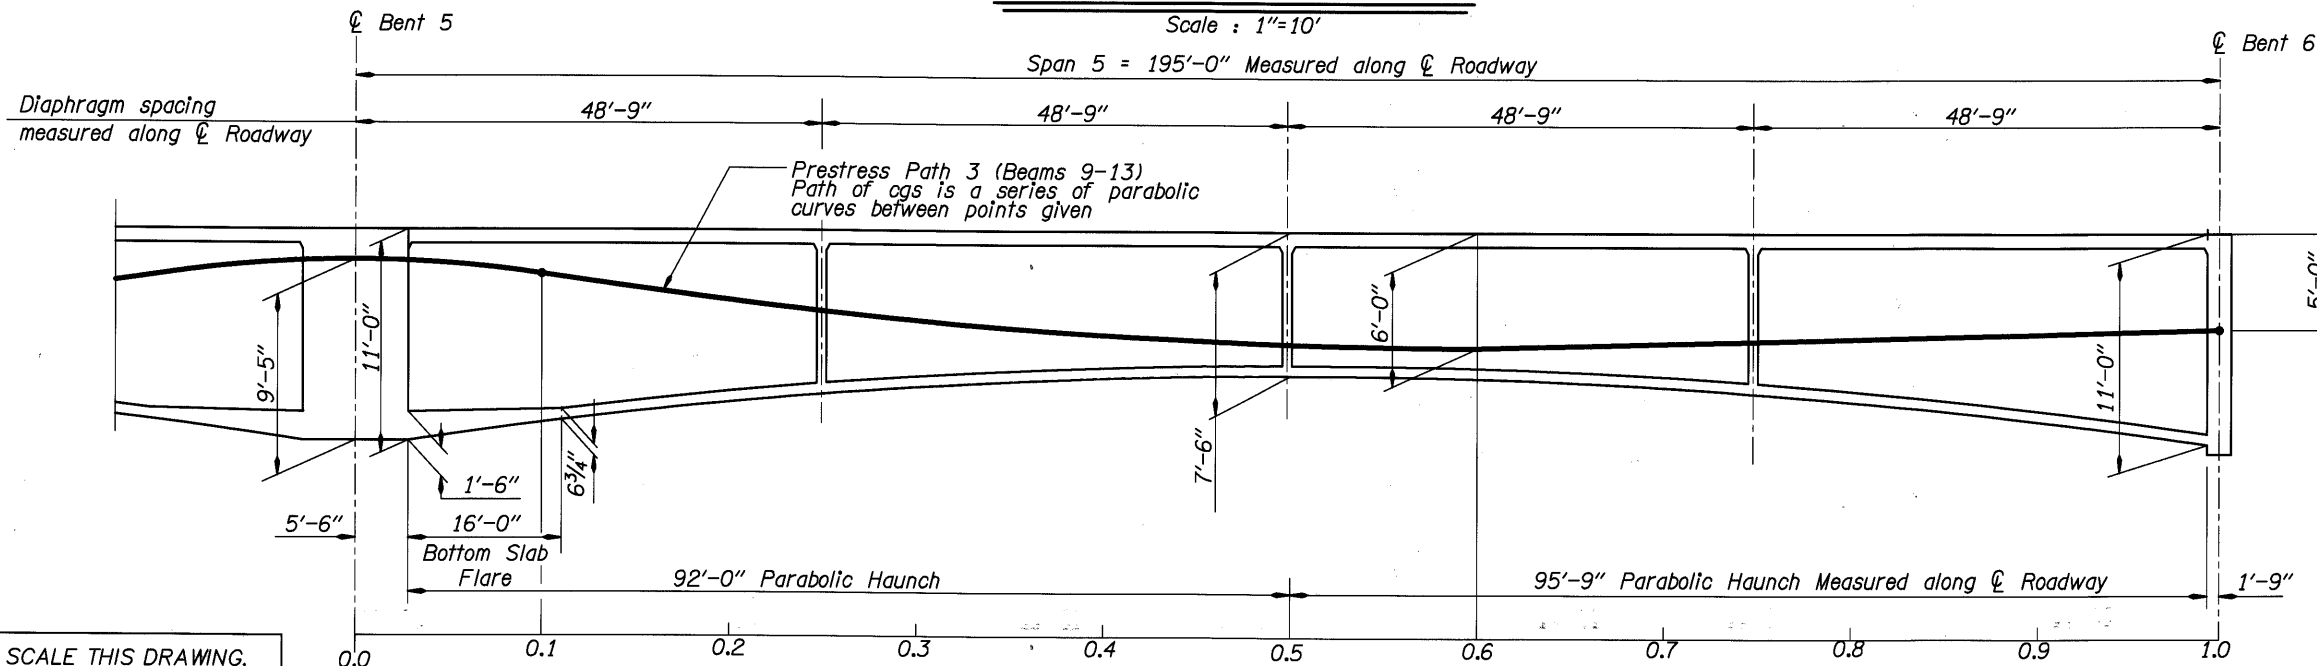

**LONGITUDINAL BEAM ELEVATION**

Scale : 1"=10'

**Legend:**

xx Denotes beam stem width in inches.

**Notes:**

For reference notes, see Dwg. #70206.

For stirrup spacing and Camber Diagram, see Dwg. #70292.


For diaphragm details, see Dwg. #70273.

Beam	*L
9	188.47'
10	191.73'
11	195.00'
12	198.27'
13	201.53'

\*Measured along  $\phi$  Beam

DO NOT SCALE THIS DRAWING. FOLLOW DIMENSIONS. INDICATED SCALES CORRECT ONLY FOR FULL SIZE SHEET (22"x34").

	DATE	REVISION	BY	Ken Johnson DRAFTED:			BRIDGE NO. 20136	MULTNOMAH CHANNEL & PNWR ETC., SAUVIE ISLAND RD.	SHEET 95 OF 173.
	03/09	As-Constructed	TDF						
				EXPIRES: 12-31-05		CALC. BOOK		LONGITUDINAL BEAM LAYOUT - SPAN 5	

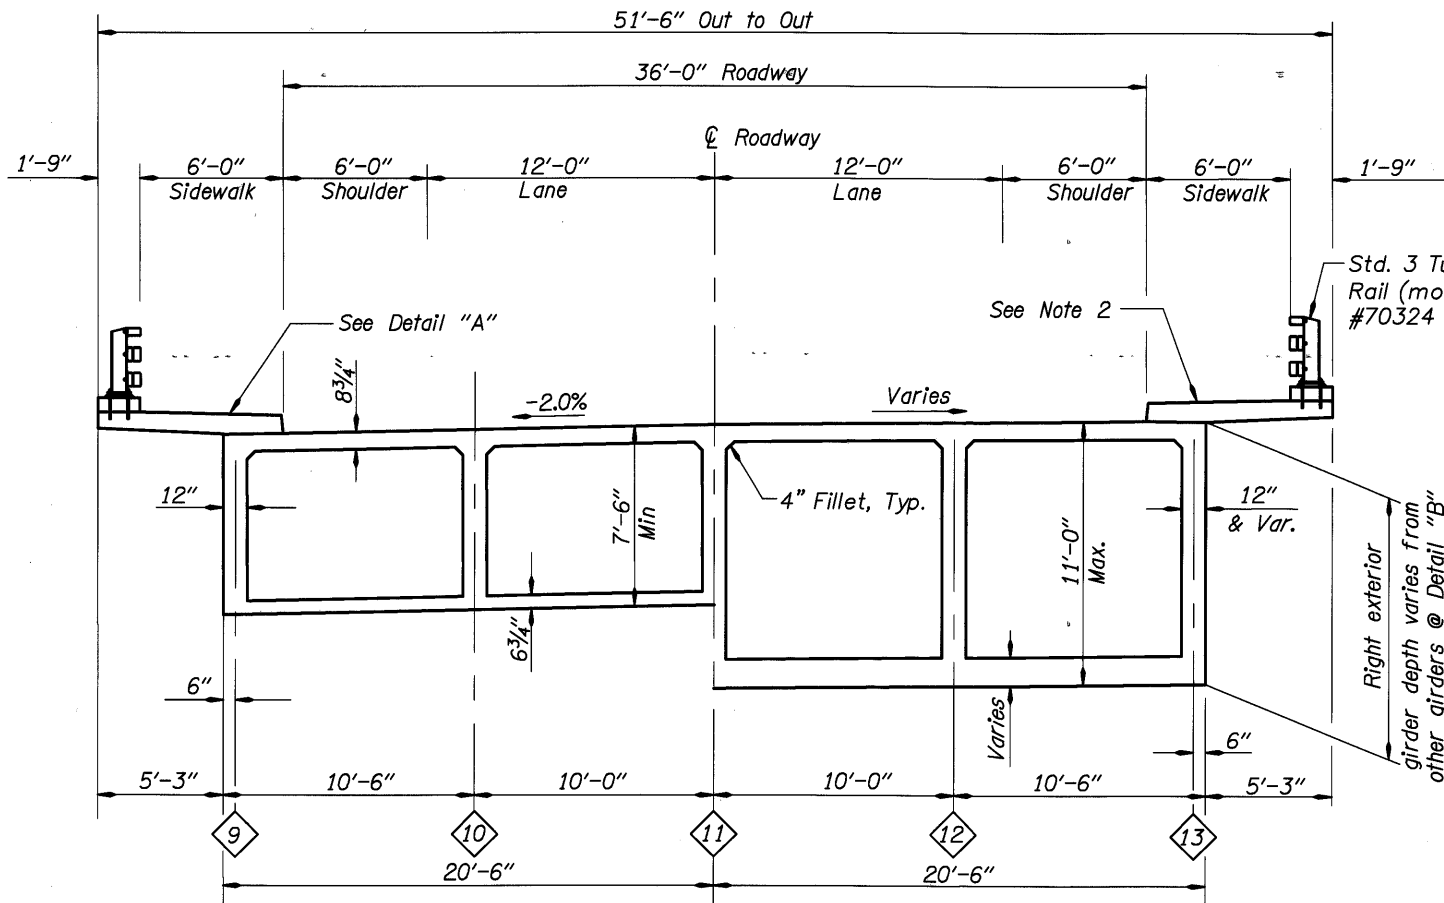


SHOWN AT  $\text{CL}$  SPAN 4

SHOWN AT BENT 5

**TYPICAL SECTION - SPAN 4**

Scale:  $\frac{1}{4}''=1'-0''$

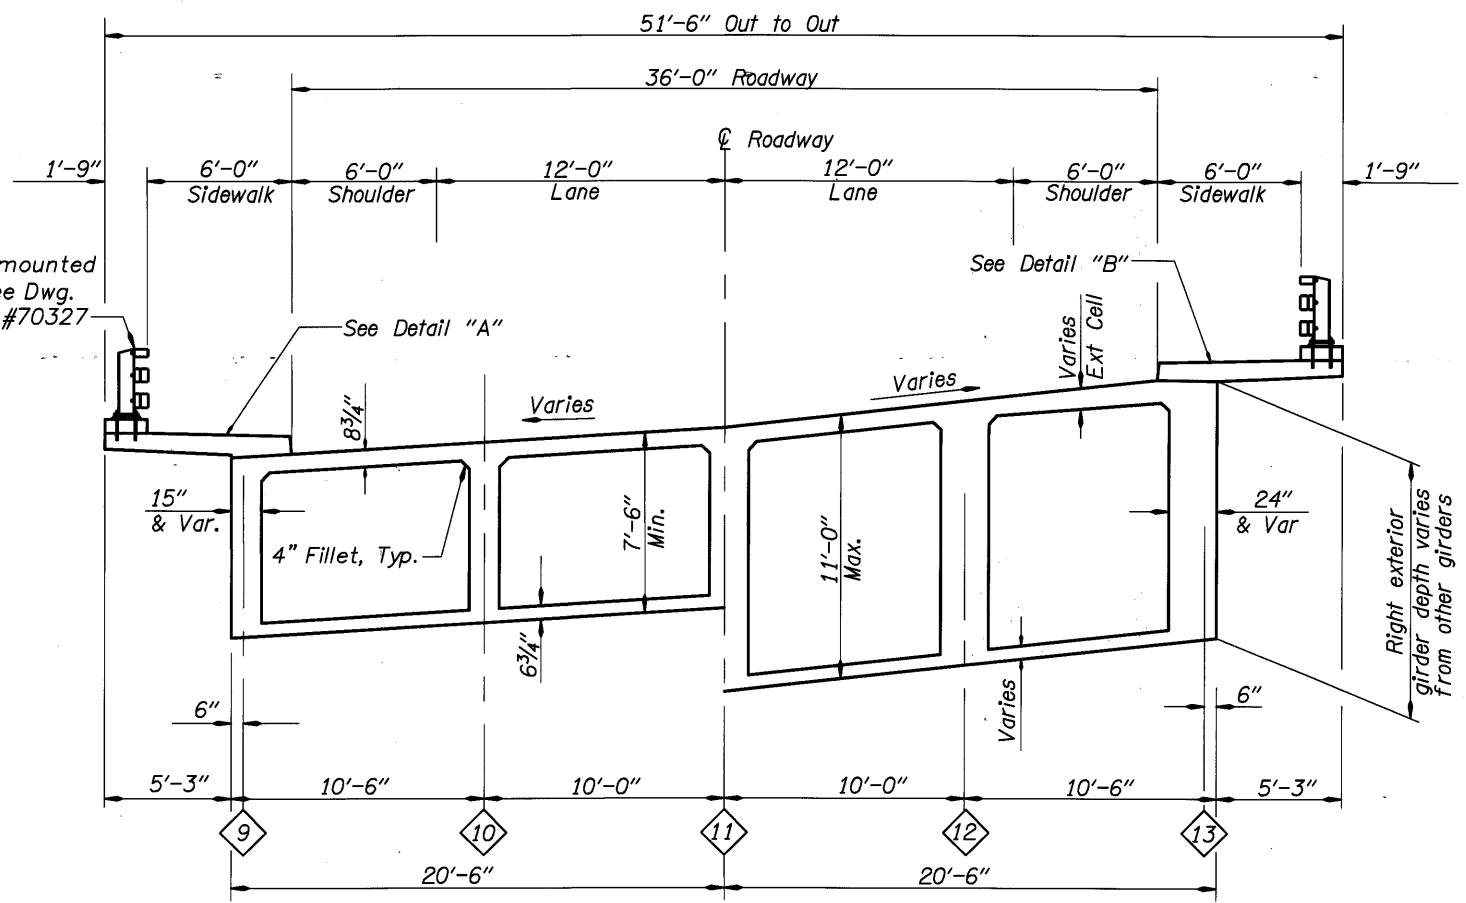

SHOWN AT  $\text{CL}$  SPAN 5


SHOWN AT BENT 6

**TYPICAL SECTION - SPAN 5**

Scale:  $\frac{1}{4}''=1'-0''$


**Notes:**

1. See Dwg. #BR135 and BR136 for details of vent tube through stems.
2. For right sidewalk, use Detail "A" from  $\text{CL}$  Bent 4 to Sta 20+50 and Detail "B" from Sta 20+50 to  $\text{CL}$  Bent 5
3. See Dwg. #70336 and #70337 for deck drainage details.
4. See Dwg. #70343 to #70355 for lighting details and conduit locations.
5. See Dwg. #70360 for utility conduit and hanger details.

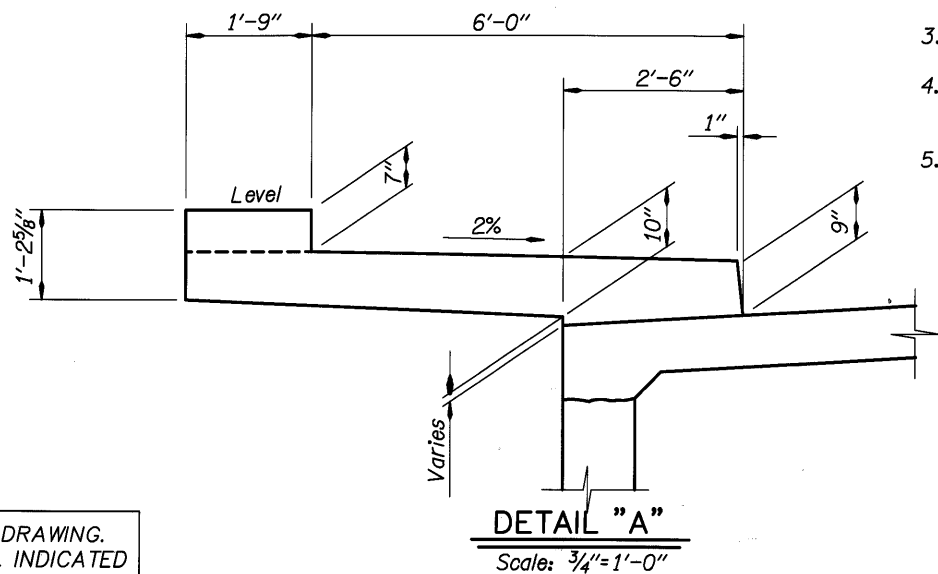

**DETAIL "A"**

Scale:  $\frac{3}{4}''=1'-0''$

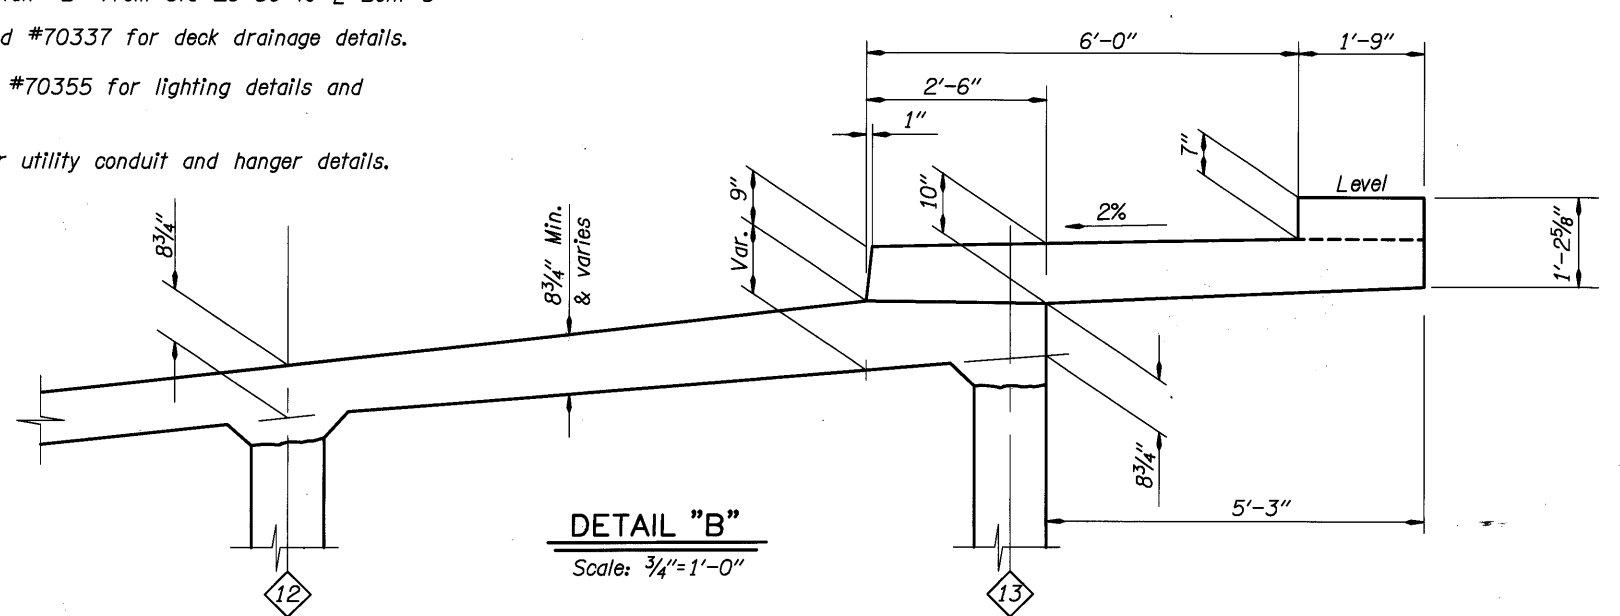

**DETAIL "B"**

Scale:  $\frac{3}{4}''=1'-0''$

DO NOT SCALE THIS DRAWING. FOLLOW DIMENSIONS. INDICATED SCALES CORRECT ONLY FOR FULL SIZE SHEET (22"x34").

DATE	REVISION	BY
03/09	As-Constructed	TDF

DRAFTED: Ken Johnson  
 CHECKED: Gernot Komar  
 DESIGNED: Adrienne Dietrich

**REVIEWED**

REGISTERED PROFESSIONAL ENGINEER  
 74349 PE  
 DAVID EVANS AND ASSOCIATES INC.  
 530 Center Street N.E., Suite 605  
 Salem Oregon 97301  
 Phone: 503.361.8635

EXPIRES: 12-31-05

CONNECTING COMMERCE AND COMMUNITY

**MULTNOMAH COUNTY BRIDGES**

TRANSPORTATION DIVISION

**OREGON DEPARTMENT OF TRANSPORTATION BRIDGE ENGINEERING SECTION**


BRIDGE NO.	20136
DATE	Sept. 2005
CALC. BOOK	

MULTNOMAH CHANNEL & PNWR ETC., SAUVIE ISLAND RD.

TYPICAL SECTIONS - SPANS 4 AND 5

SHEET 96 OF 173

DRAWING NO. 70283

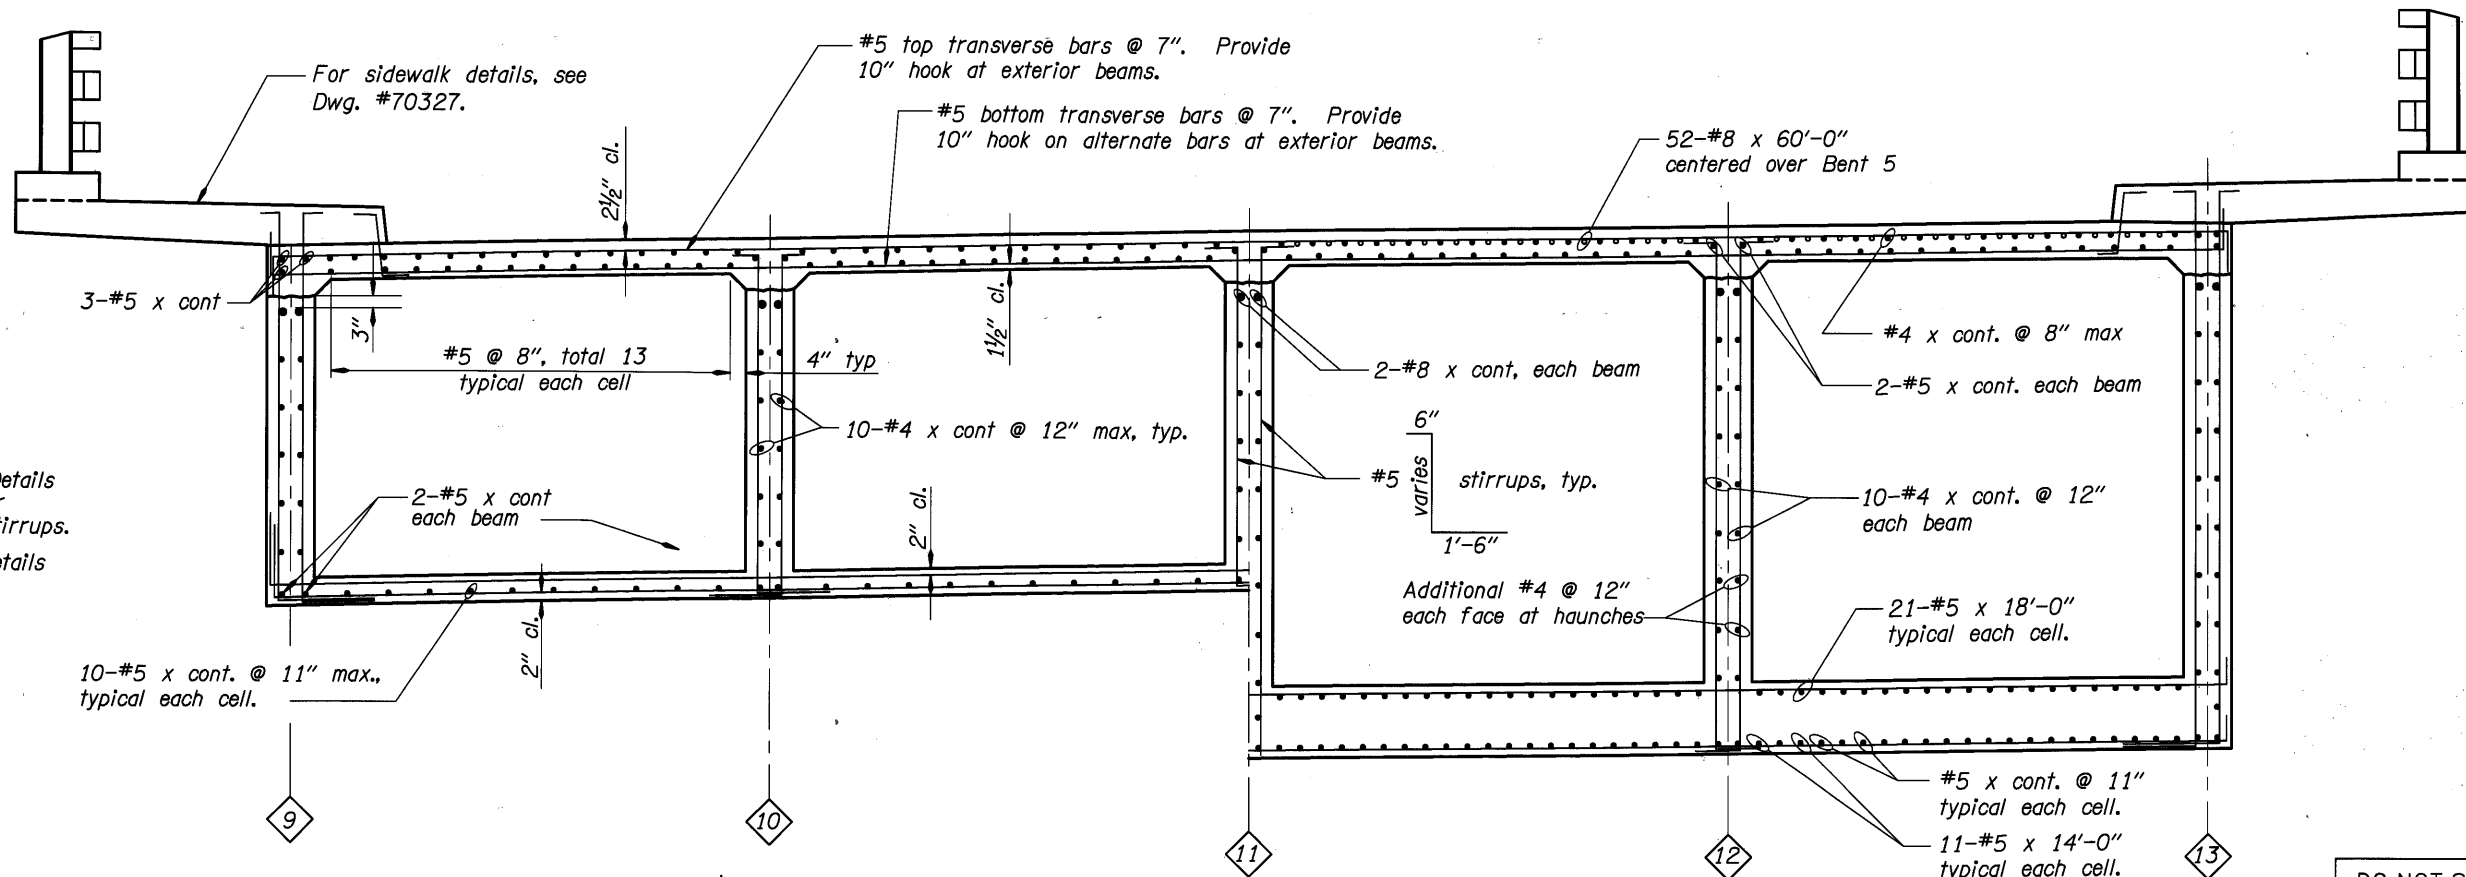

**Notes:**  
See Duct Bundling Details on Dwg. #70294 for clearances to web stirrups.  
See Curved Beam Details on Dwg. #70295.

DO NOT SCALE THIS DRAWING. FOLLOW DIMENSIONS. INDICATED SCALES CORRECT ONLY FOR FULL SIZE SHEET (22"x34").

**TYPICAL SECTION**  
Scale: 1/2"=1'-0"

**TYPICAL DECK STEEL**


**Transverse Steel**  
#5 straight or bent bars at 7" centers max, top and bottom, see Transverse Steel Spacing Diagram on Dwg. #70265. Stop transverse bars 6" clear of transverse beams. Place transverse bars perpendicular to centerline of bridge. Space along centerline of beam 13.

**Longitudinal Steel**  
56-#4 bars as shown @ 8" ctrs. max top of deck  
52-#5 bars as shown @ 8" ctrs. max bottom of deck  
2-#5 x cont. at each interior stem.  
3-#5 x cont. at each exterior stem.  
Place longitudinal bars parallel to centerline of bridge.

**TYPICAL BOTTOM SLAB STEEL**

**Transverse Steel**  
#5 w/ 1'-3" hook into web each end @ 18" ctrs. Alternate above and below longitudinal bars @ 9". see Transverse Steel Spacing Diagram on Dwg. #70265. Stagger all splices. Stop bottom transverse bars 3" clear of transverse beams. Place transverse bars perpendicular to centerline of bridge. Space along centerline of beam 13.

**Longitudinal Steel**  
2-#5 x cont. at each stem.  
10-#5 x cont. in each cell  
Extend all longitudinal bars 2'-0" into X-beam. Place longitudinal bars parallel to centerline of bridge.  
See Bottom Slab Flare for additional reinforcement at bottom slab flares at Bent 5.

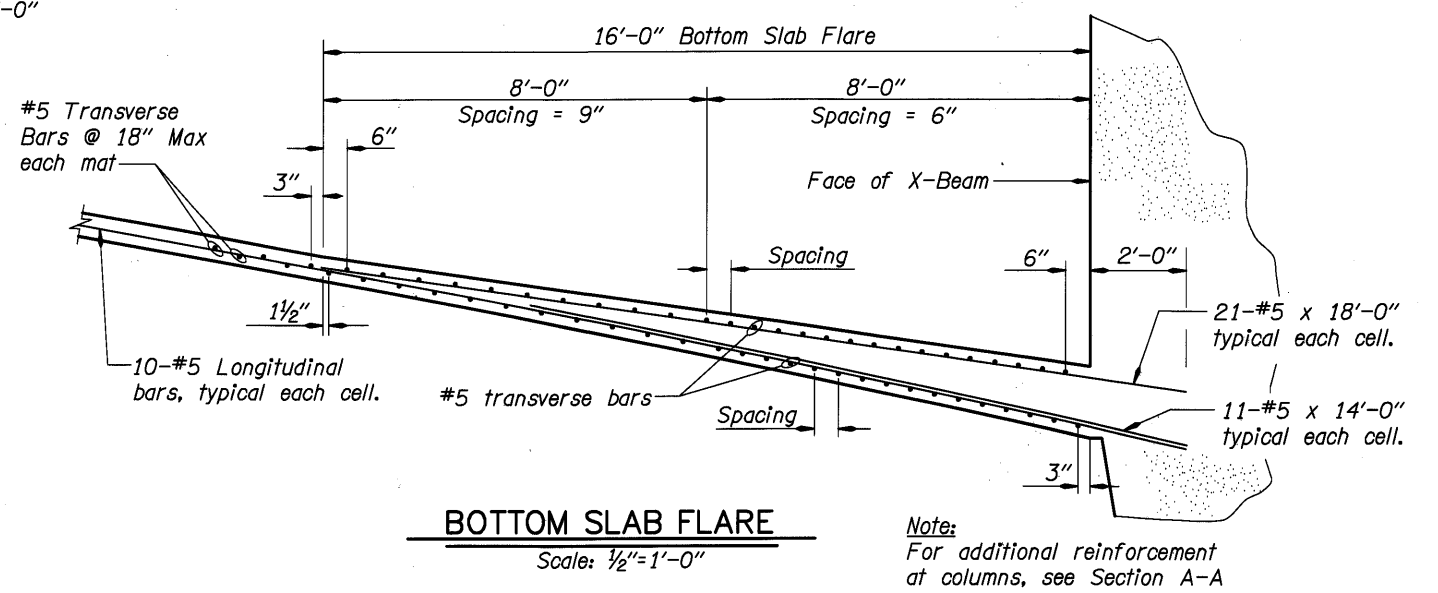

**BOTTOM SLAB FLARE**  
Scale: 1/2"=1'-0"

**Note:**  
For additional reinforcement at columns, see Section A-A on Dwg. #70289


DATE	03/09	REVISION	As-Constructed	BY	Ken Johnson	DESIGNER	 DAVID EVANS AND ASSOCIATES INC. 530 Center Street N.E., Suite 605 Salem Oregon 97301 Phone: 503.361.8635	BRIDGE NO.	20136	MULTNOMAH COUNTY BRIDGES	TRANSPORTATION DIVISION	BRIDGE NO.	20136	SHEET	97
	DATE		Sept. 2005		DATE				Sept. 2005				OF		173.
REVIEWED:	Josh Hewes	CHECKED:	Adrienne Dietrich	REVIEWED:	Josh Hewes	EXPIRES:	12-31-05	CALC. BOOK		OREGON DEPARTMENT OF TRANSPORTATION	BRIDGE ENGINEERING SECTION	CALC. BOOK		DRAWING NO.	70284
											MULTNOMAH CHANNEL & PNWR ETC., SAUVIE ISLAND RD.		DRAWING NO.		70284
											BOX GIRDER REINFORCEMENT - SPANS 4 AND 5				






Note:  
For end beam reinforcement  
and details, see Dwg. #70293


#8 bent bars or #11 x 10'-0".  
See Elevation on Dwg. #70285  
for number and spacing

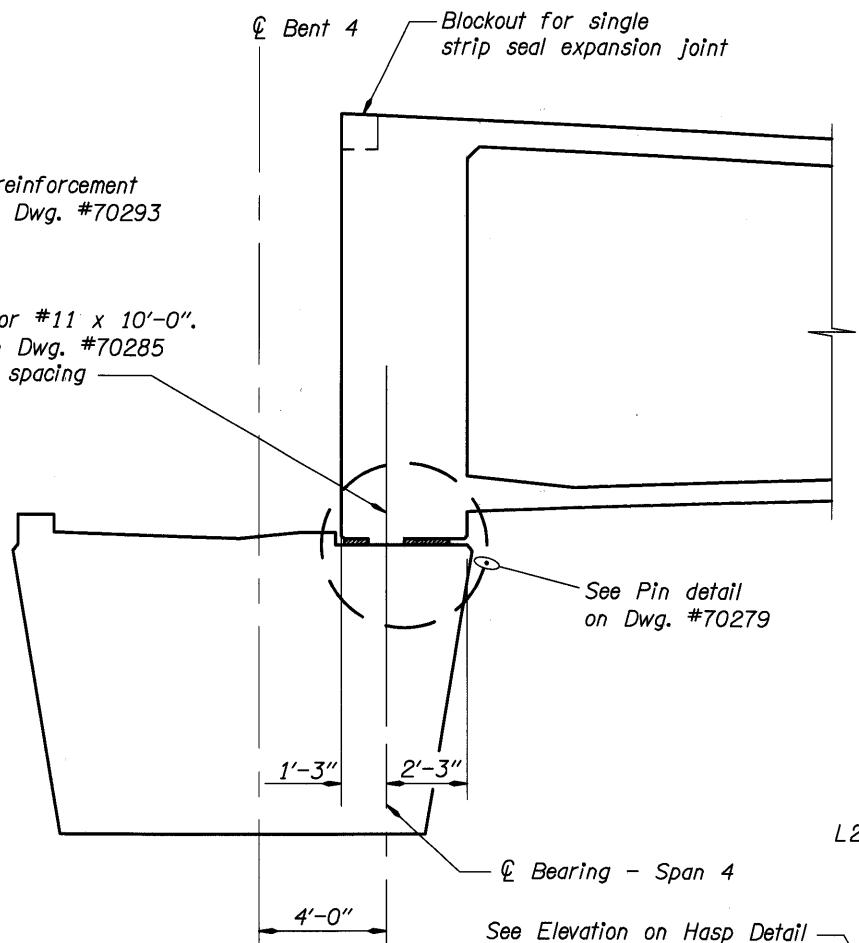


**SECTION A-A**  
Scale: 3/8"=1'-0"

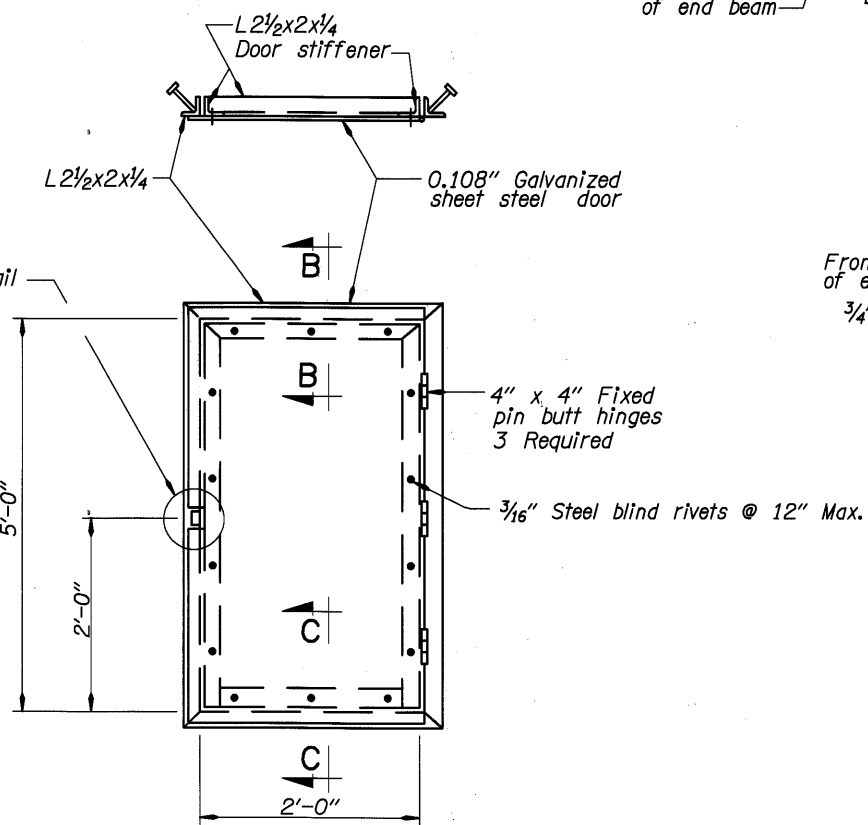


**ACCESS DOOR DETAILS**  
No Scale

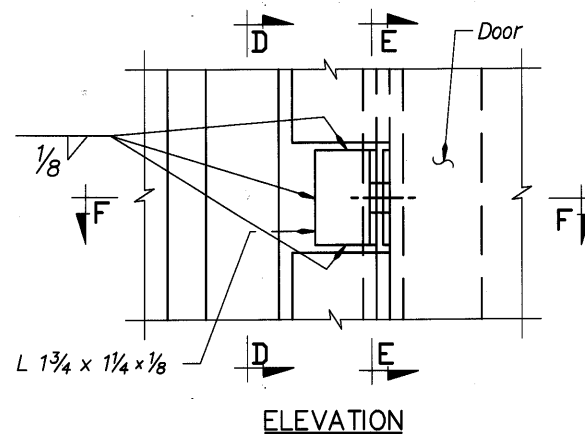


**ELEVATION**

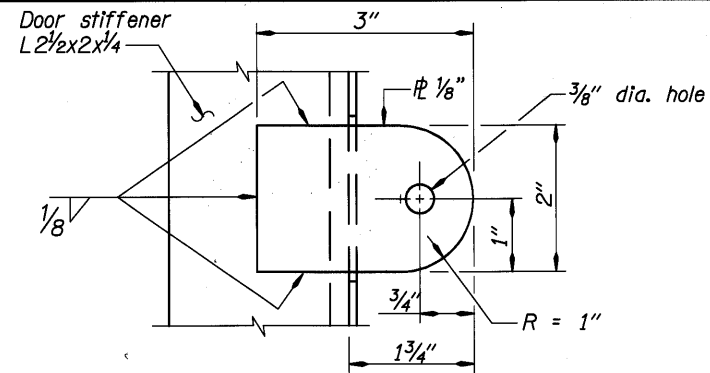


**SECTION E-E**

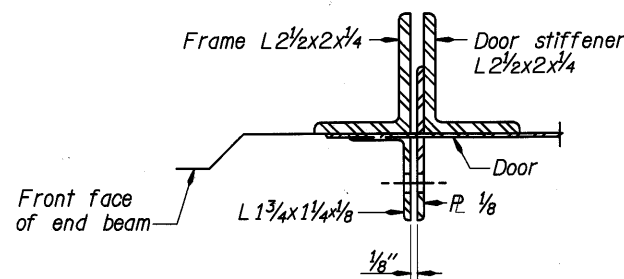

**SECTION F-F**

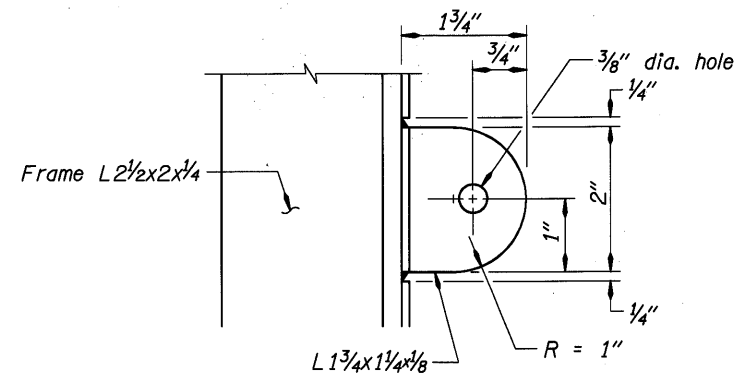


**SECTION D-D**

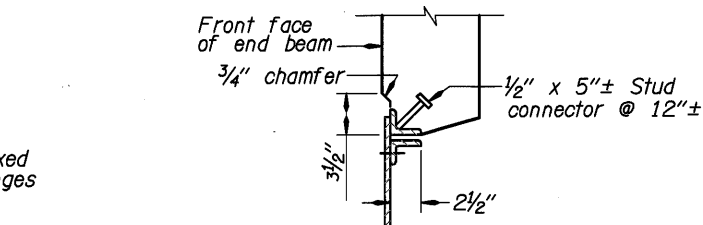

**SECTION B-B**

**HASP DETAIL**  
No Scale

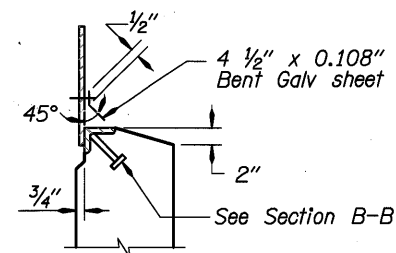


**SECTION C-C**

Notes:  
Galvanize frame assemblies and door stiffener  
angles after welding and fabrication.  
Attach door stiffener angles and bent sheet  
to steel door with blind rivets.

DO NOT SCALE THIS DRAWING.  
FOLLOW DIMENSIONS. INDICATED  
SCALES CORRECT ONLY FOR  
FULL SIZE SHEET (22"x34").


	DATE	REVISION	BY	DESIGNER		BRIDGE NO.	MULTNOMAH CHANNEL & PNWR ETC., SAUVIE ISLAND RD.	SHEET
	03/09	As-Constructed	TDF	Ken Johnson		TRANSPORTATION DIVISION		20136
				Adrienne Dietrich		DATE		DRAWING NO.
				Josh Hewes		Sept. 2005		
					530 Center Street N.E., Suite 605 Salem Oregon 97301 Phone: 503.361.8635	CALC. BOOK	BENT 4 - END BEAM DETAILS (2 OF 2)	

DO NOT SCALE THIS DRAWING.  
FOLLOW DIMENSIONS. INDICATED  
SCALES CORRECT ONLY FOR  
FULL SIZE SHEET (22"x34").

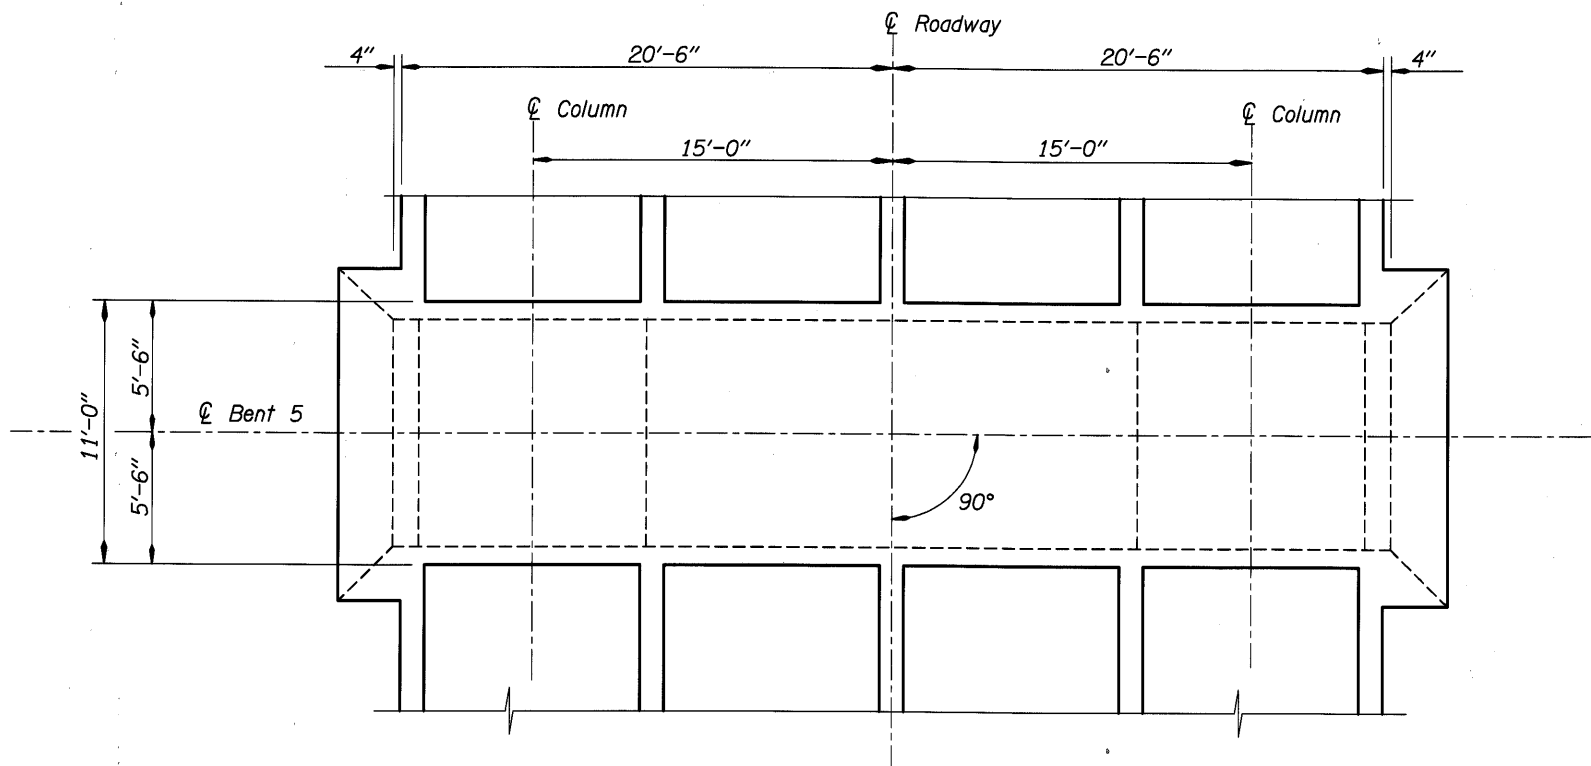

**SECTION A-A**


Scale: 1/4"=1'-0"

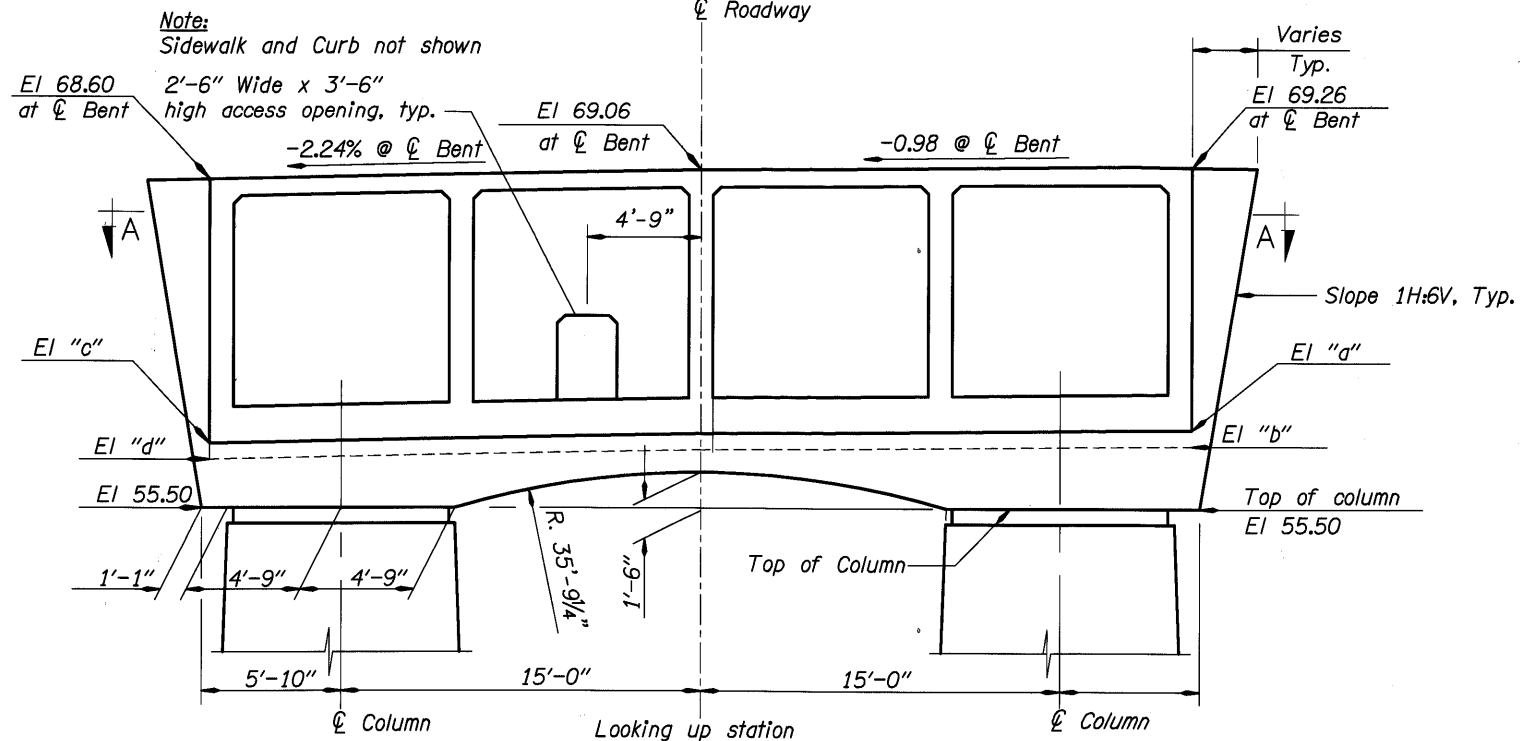

**ELEVATION**

Scale: 1/4"=1'-0"


**Note:**  
See Dwg. #70336 and #70337 for deck  
drainage details.  
  
See Dwg. #70343 to #70355 for lighting  
details and conduit locations.  
  
See Dwg. #70360 for utility conduit and  
hanger details.

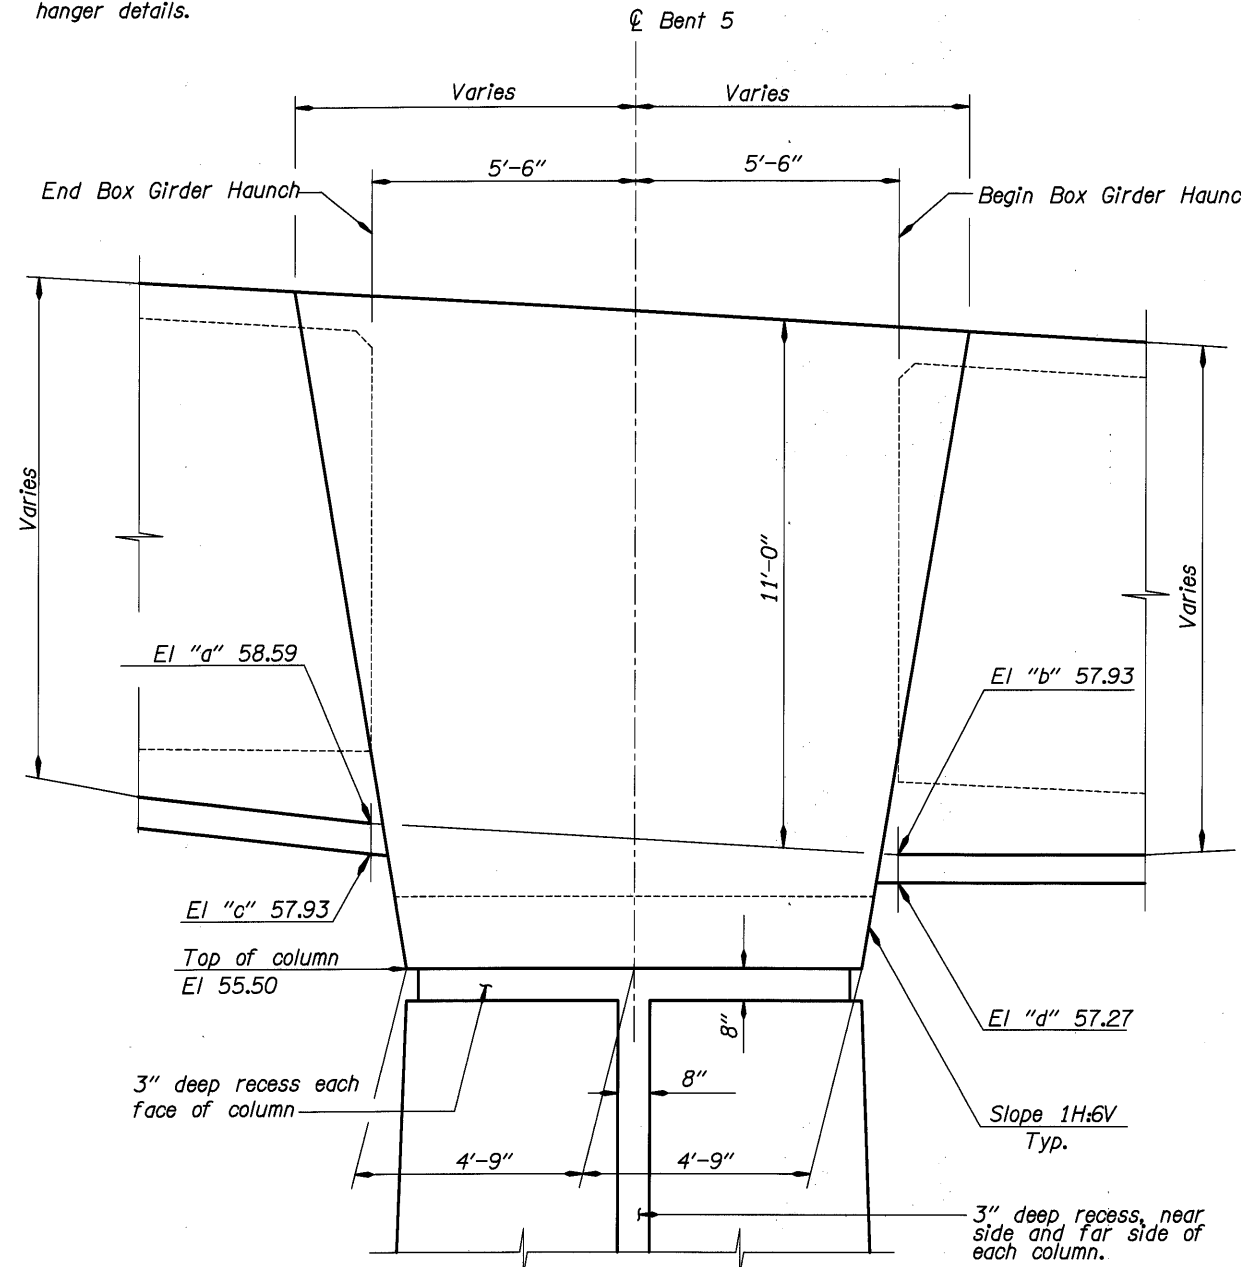

**RIGHT SIDE ELEVATION**

Scale: 1/2"=1'-0"


	DATE	REVISION	BY	Ken Johnson DRAFTED: Adrienne Dietrich CHECKED: Josh Hewes REVIEWED:	<b>DESIGNER</b>  <b>DAVID EVANS AND ASSOCIATES INC.</b> 530 Center Street N.E., Suite 605 Salem Oregon 97301 Phone: 503.361.8635 EXPIRES: 12-31-05	 TRANSPORTATION DIVISION <b>OREGON DEPARTMENT OF TRANSPORTATION</b> BRIDGE ENGINEERING SECTION	BRIDGE NO.	MULTNOMAH CHANNEL & PNWR ETC., SAUVIE ISLAND RD.	SHEET
	08/05	Revised Columns	KWC				20136		100
	03/09	As-Constructed	TDF				DATE Sept. 2005		OF 173
							CALC. BOOK	DRAWING NO.	
							BENT 5 - INTEGRAL X-BEAM PLAN AND ELEVATION		70287

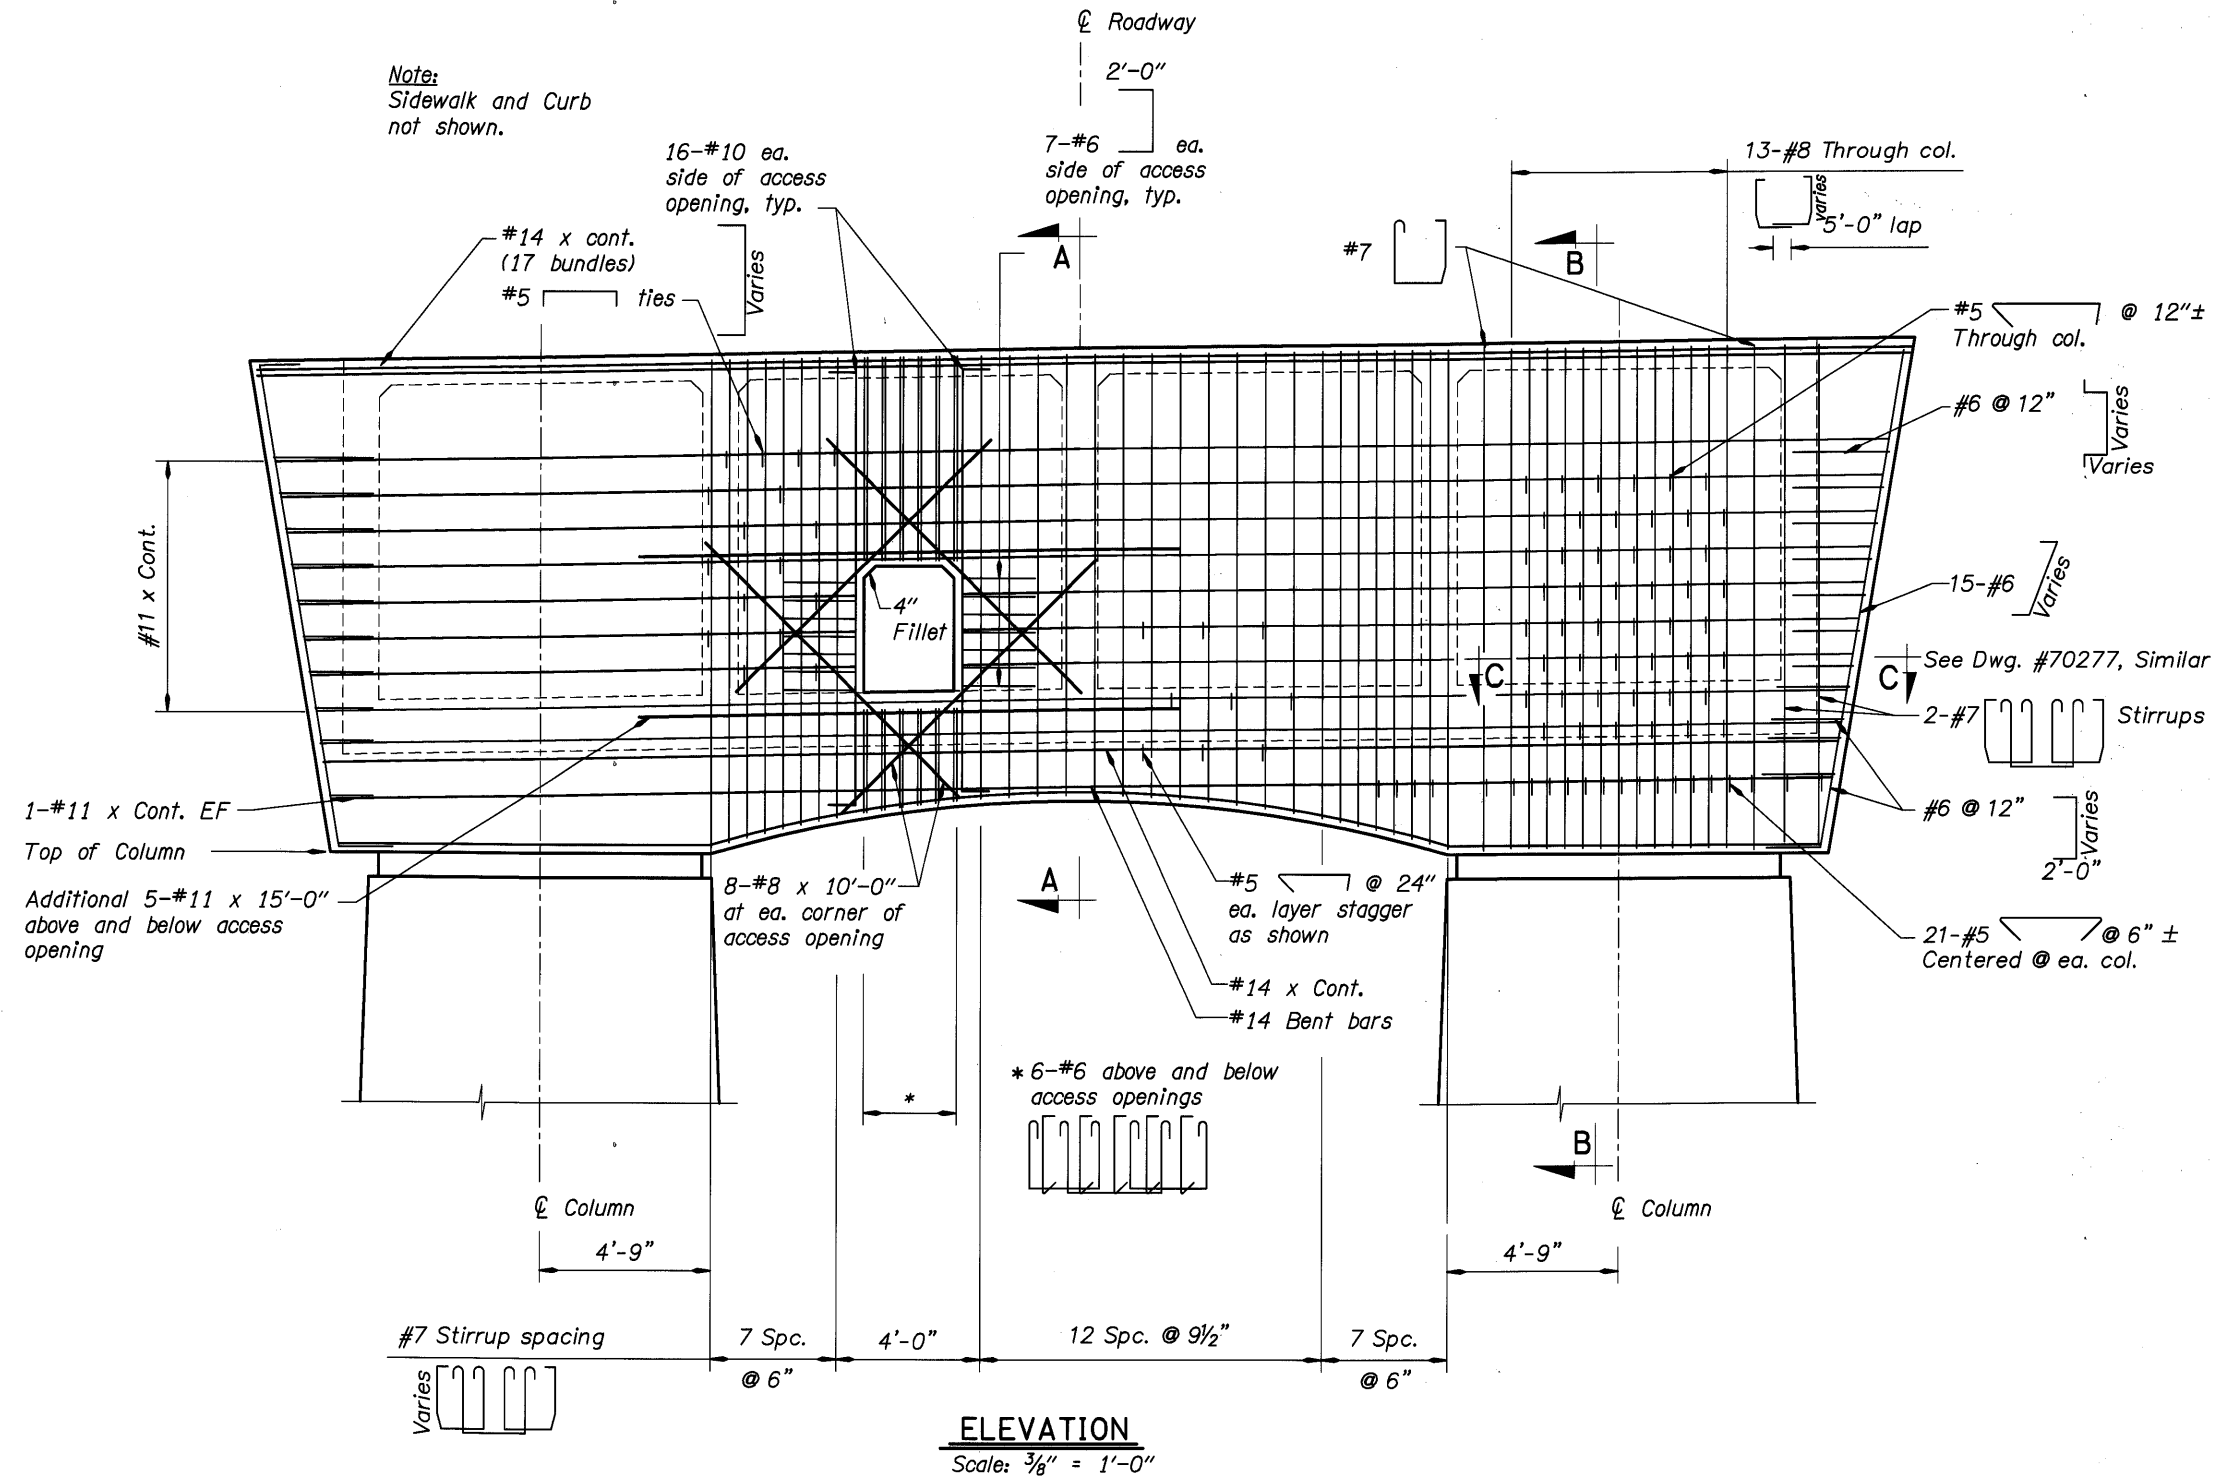


**Note:**  
For details of Sections A-A and B-B see Dwg. #70289.  
For details of Sections C-C see Dwg. #70277.

DO NOT SCALE THIS DRAWING.  
FOLLOW DIMENSIONS. INDICATED  
SCALES CORRECT ONLY FOR  
FULL SIZE SHEET (22"x34").

	DATE	REVISION	BY	Ken Johnson DRAFTED:	<b>DESIGNER</b> DAVID EVANS AND ASSOCIATES, INC. 530 Center Street N.E., Suite 605 Salem Oregon 97301 Phone: 503.361.8635 EXPIRES: 12-31-05	CONNECTING COMMERCE AND COMMUNITY <b>MULTNOMAH COUNTY</b> BRIDGES OREGON DEPARTMENT OF TRANSPORTATION BRIDGE ENGINEERING SECTION	BRIDGE NO.	MULTNOMAH CHANNEL & PNWR ETC., SAUVIE ISLAND RD.	SHEET 101 OF 173.
	08/05	Revised Columns	KWC				20136		
	03/09	As-Constructed	TDF	Adrienne Dietrich CHECKED:			DATE	BENT 5 - INTEGRAL X-BEAM DETAILS (1 OF 2)	DRAWING NO. 70288
				Josh Hewes REVIEWED:			Sept. 2005		
							CALC. BOOK		

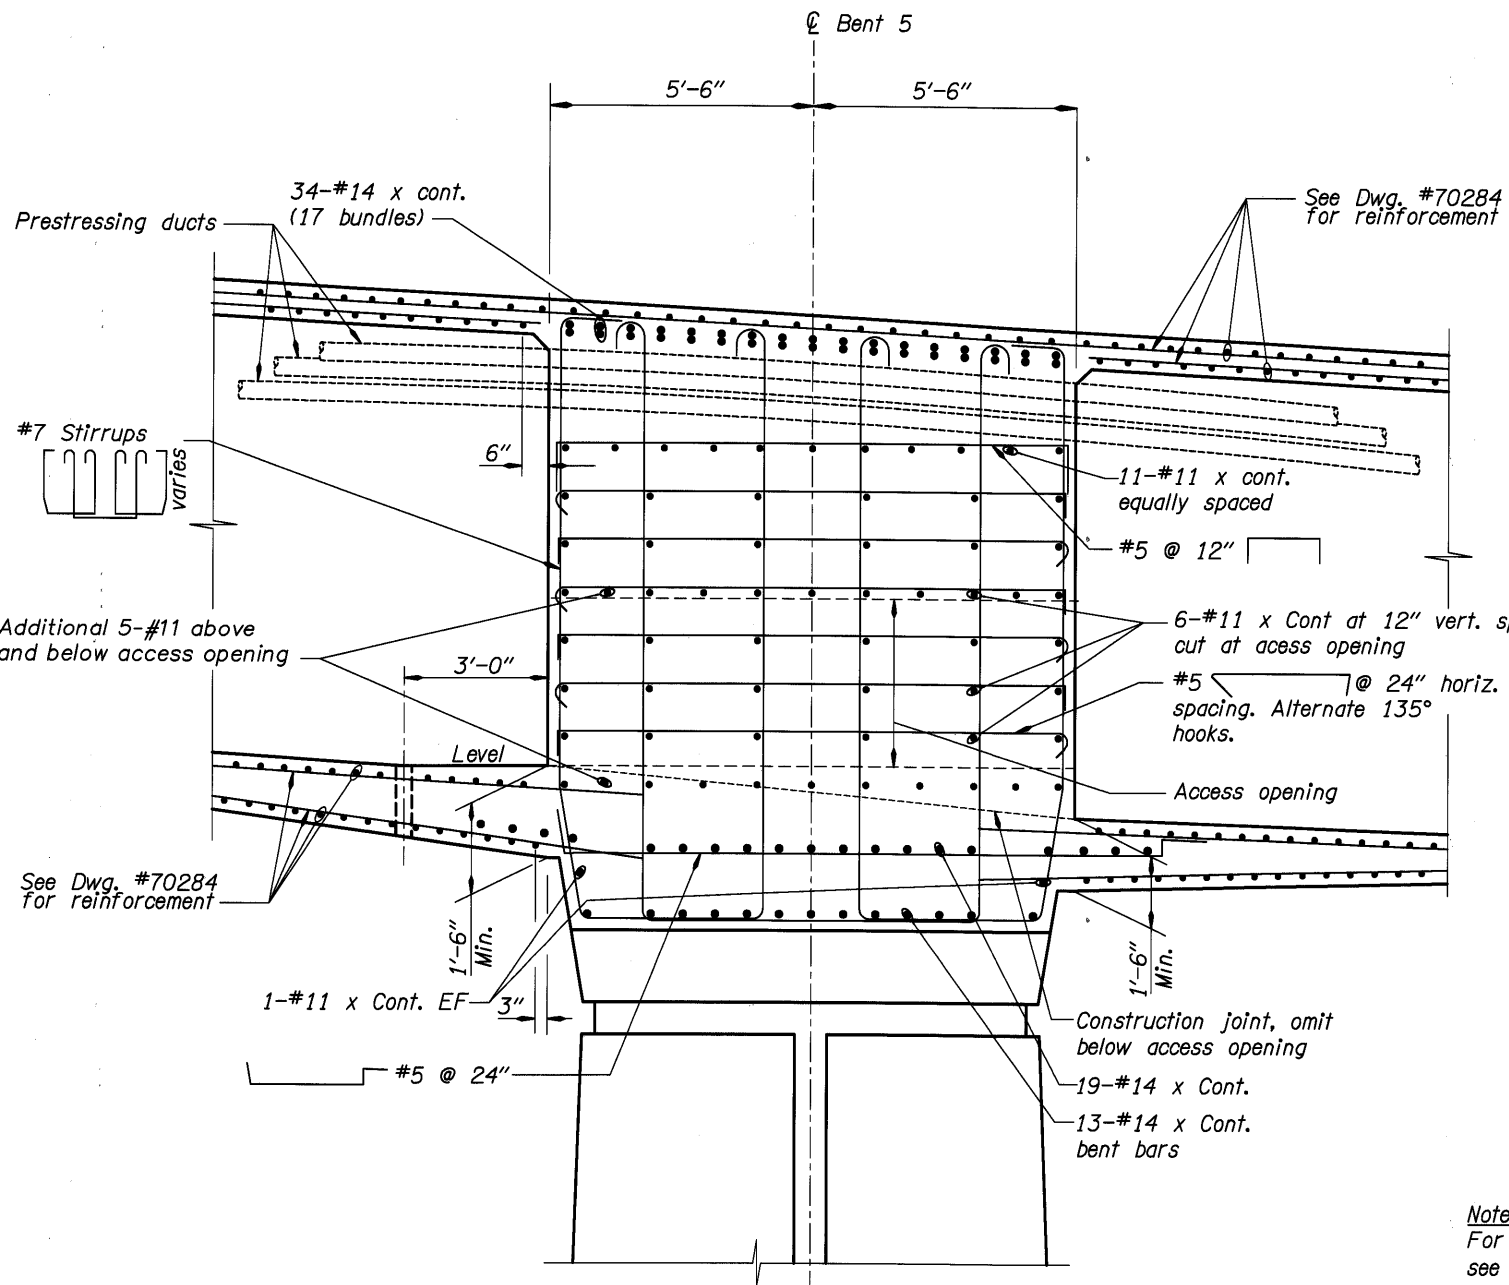

**SECTION A-A**  
Scale: 1/2"=1'-0"

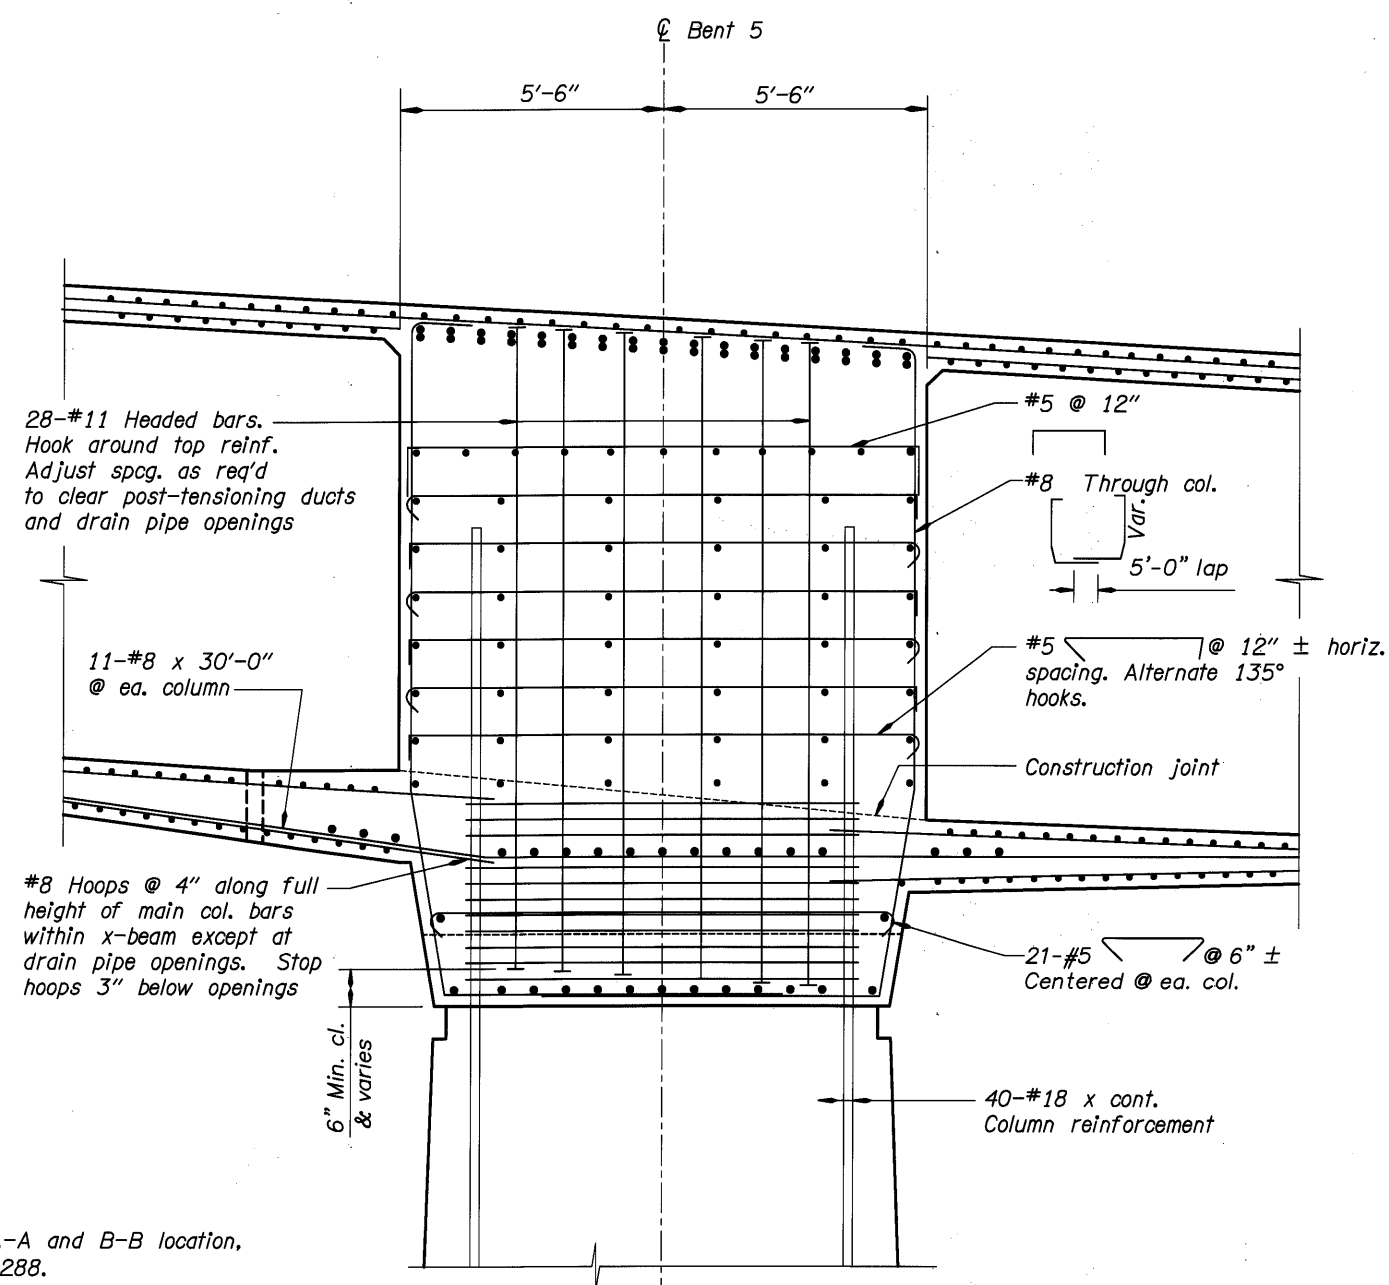


**SECTION B-B**  
Scale: 1/2"=1'-0"

**Note:**  
For Section A-A and B-B location,  
see Dwg. #70288.

**Note:**  
For details not shown, see Sections A-A.

DO NOT SCALE THIS DRAWING.  
FOLLOW DIMENSIONS. INDICATED  
SCALES CORRECT ONLY FOR  
FULL SIZE SHEET (22"x34").

DATE 08/05 03/09	REVISION Revised Columns As-Constructed	BY KWC TDF	DESIGNER Ken Johnson DRAFTED: Adrienne Dietrich CHECKED: Josh Hewes REVIEWED:	DESIGNER  <b>DAVID EVANS AND ASSOCIATES INC.</b> 530 Center Street N.E., Suite 605 Salem Oregon 97301 Phone: 503.361.8635	CONNECTING COMMERCE AND COMMUNITY  TRANSPORTATION DIVISION 	BRIDGE NO. 20136	MULTNOMAH CHANNEL & PNWR ETC., SAUVIE ISLAND RD.	SHEET 102 OF 173
						DATE Sept. 2005		DRAWING NO. 70289
						CALC. BOOK	BENT 5- INTEGRAL X-BEAM DETAILS (2 OF 2)	

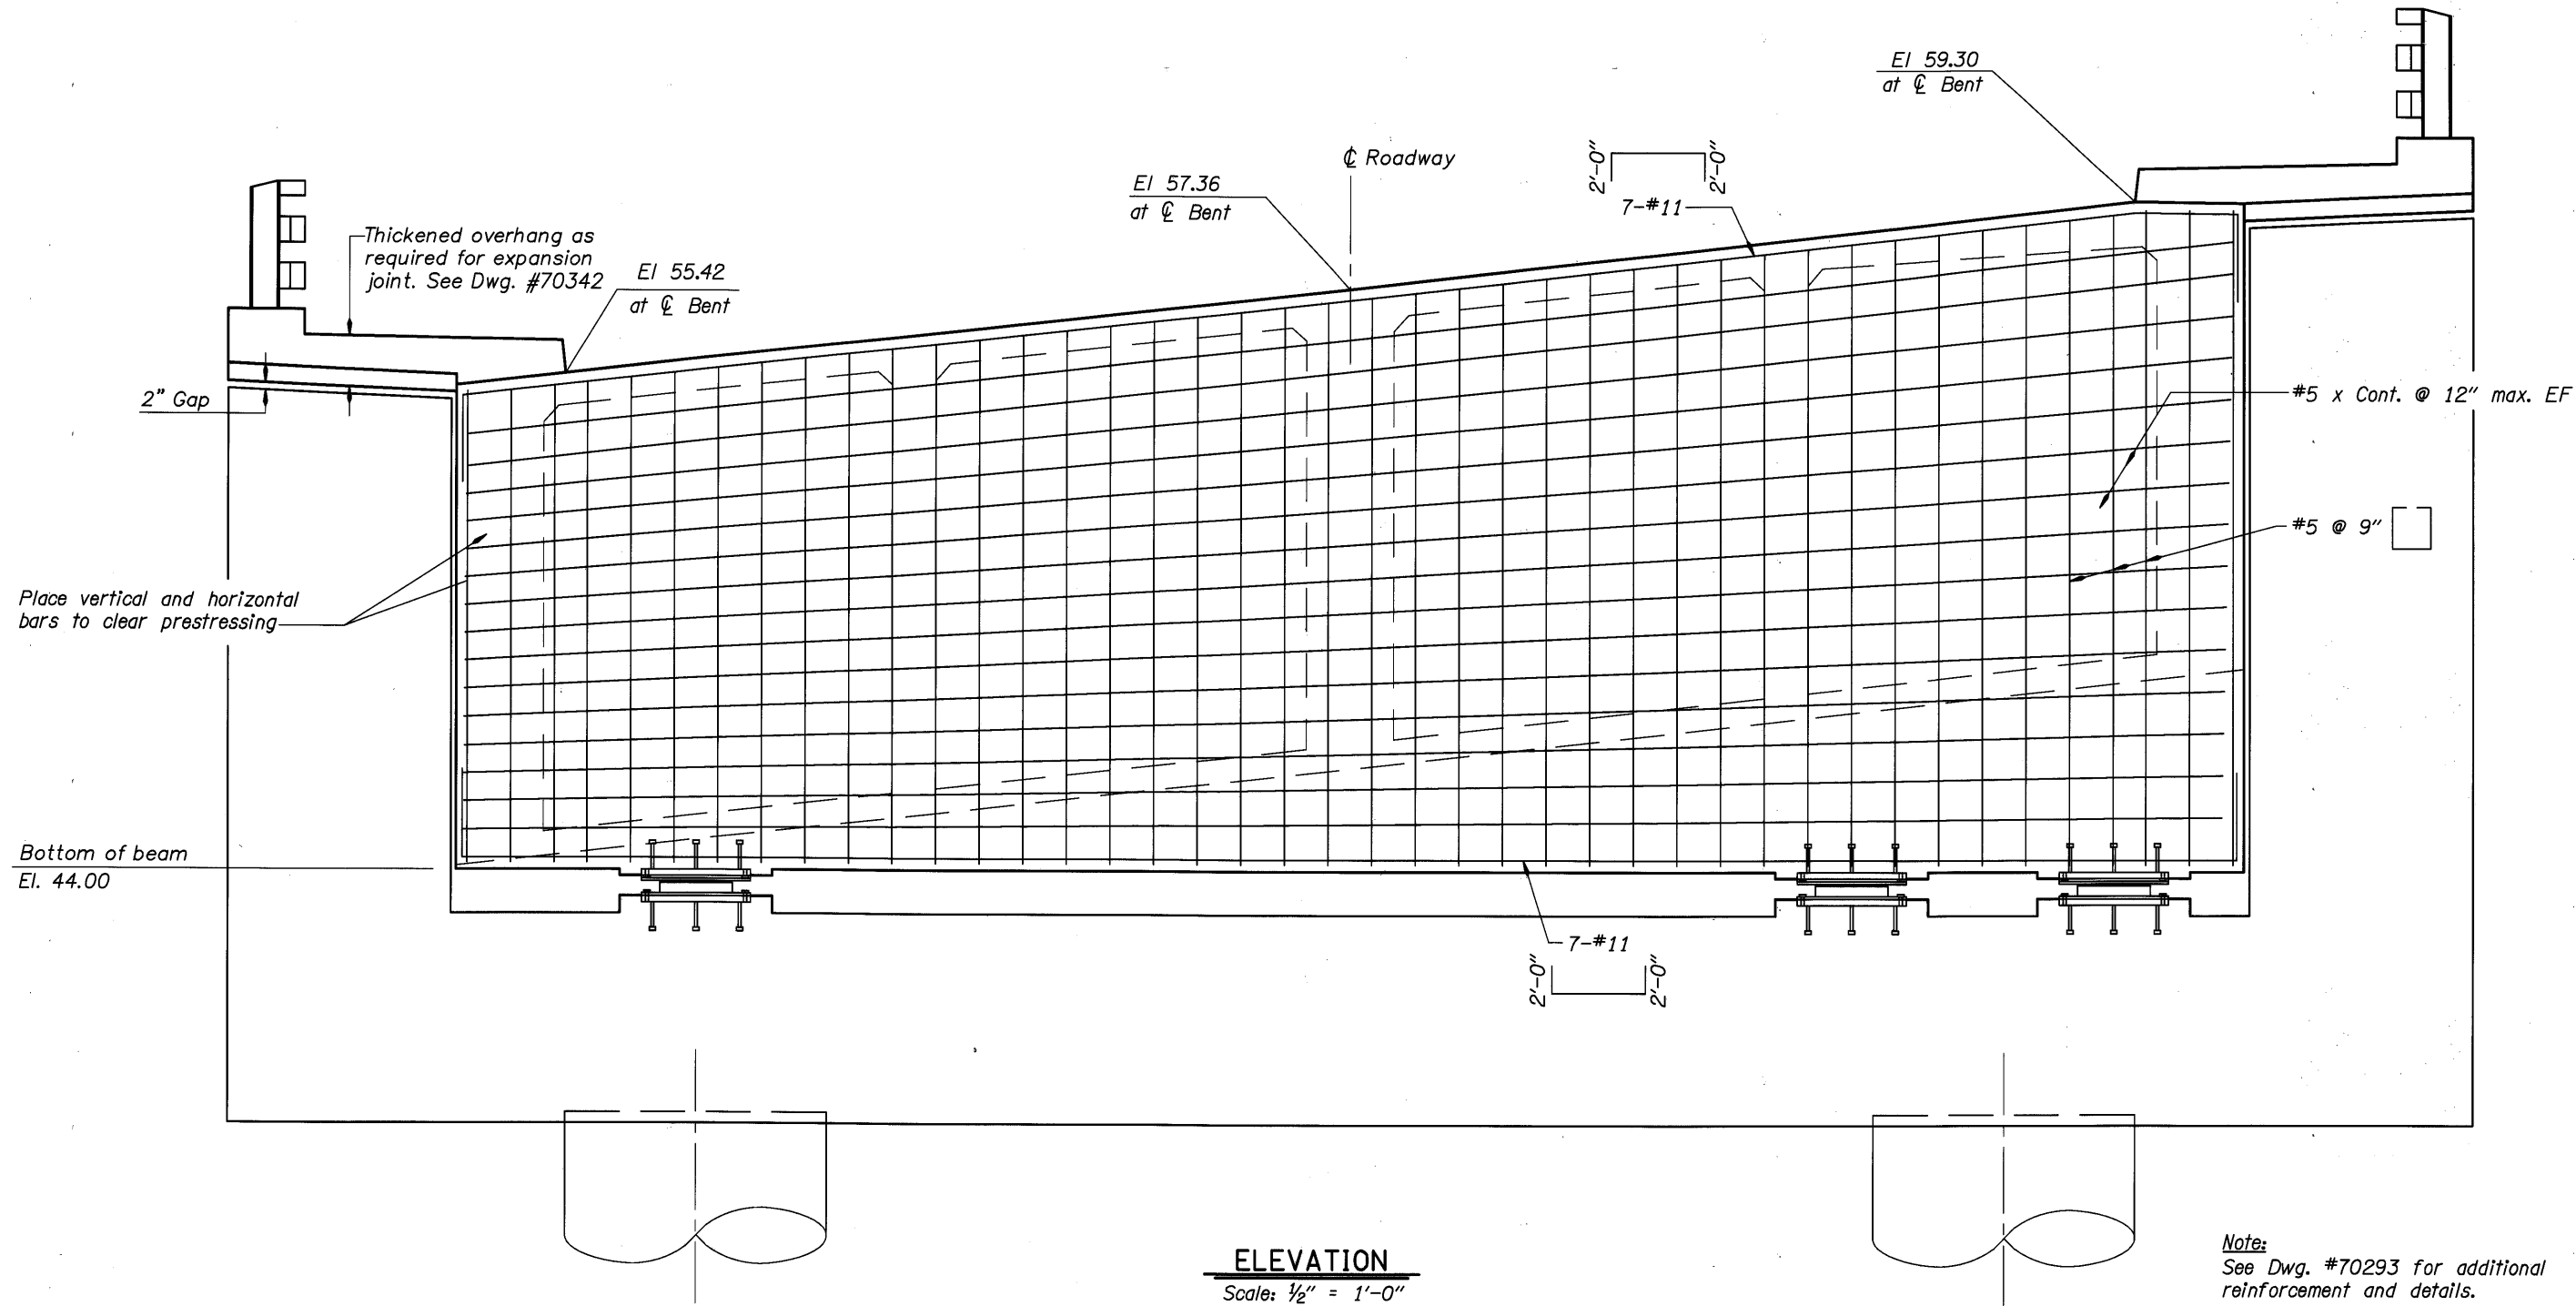


**ELEVATION**

Scale: 1/2" = 1'-0"

**Note:**  
 See Dwg. #70293 for additional reinforcement and details.  
 See Dwg. #70336 and #70337 for deck drainage details.  
 See Dwg. #70343 to #70355 for lighting details and conduit locations.  
 See Dwg. #70360 for utility conduit and hanger details.

DO NOT SCALE THIS DRAWING. FOLLOW DIMENSIONS. INDICATED SCALES CORRECT ONLY FOR FULL SIZE SHEET (22"x34").


	DATE	REVISION	BY	Ken Johnson DRAFTED:	REVIEWED 	TRANSPORTATION DIVISION	BRIDGE NO.	MULTNOMAH CHANNEL & PNWR ETC., SAUVIE ISLAND RD.	SHEET 103 OF 173.
	03/09	As-Constructed	TDF				Josh Hewes CHECKED:		
				Adrienne Dietrich DESIGNED:			DATE Sept. 2005	BENT 6 - END BEAM DETAILS (1 OF 2)	DRAWING NO. 70290
							CALC. BOOK		

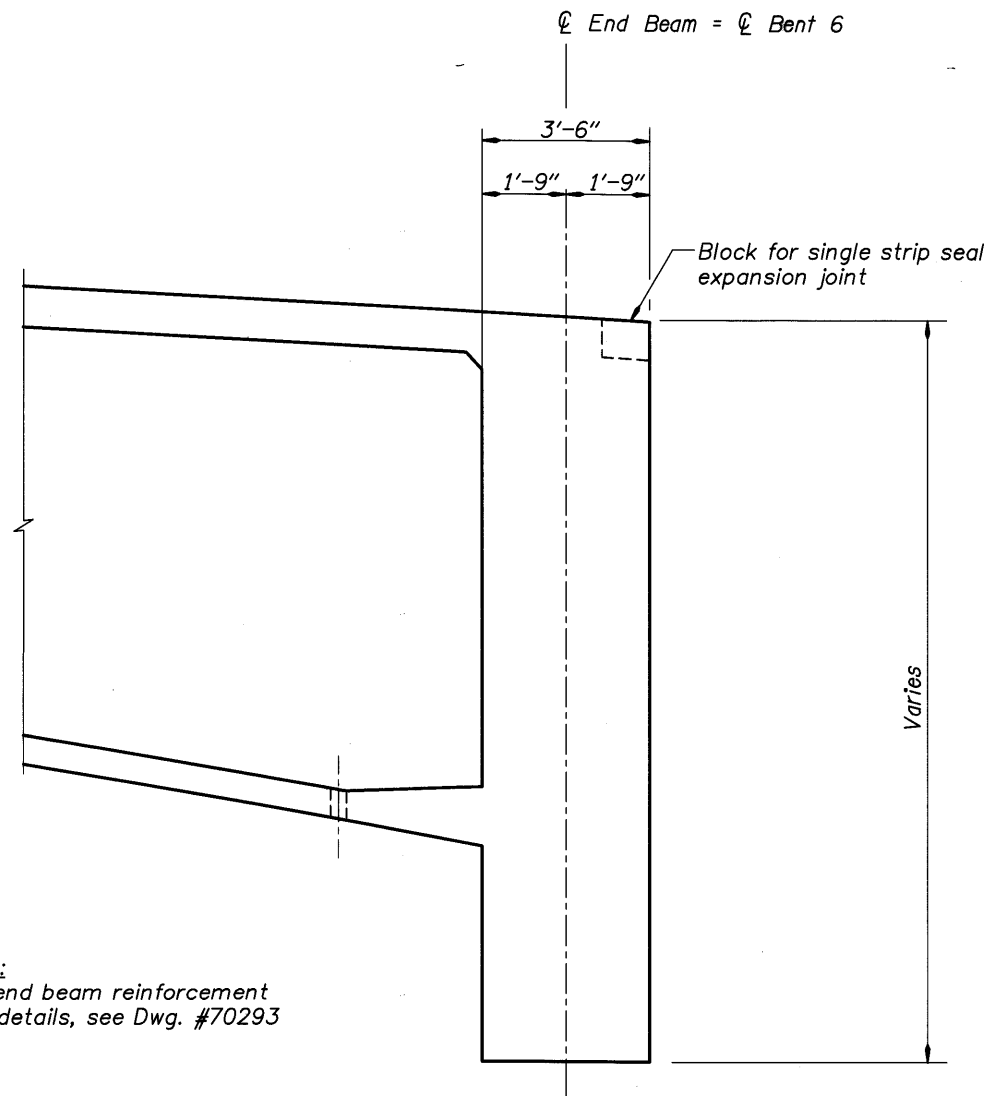

Note:  
For end beam reinforcement  
and details, see Dwg. #70293

**END BEAM SECTION**

Scale: 1/2"=1'-0"

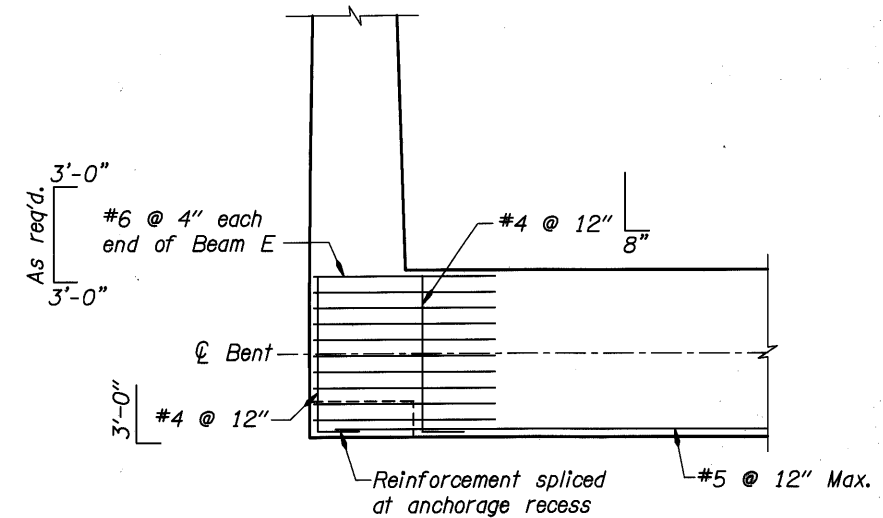


**PARTIAL PLAN SECTION BEAM-E END**

Scale: 1/2"=1'-0"

DO NOT SCALE THIS DRAWING.  
FOLLOW DIMENSIONS. INDICATED  
SCALES CORRECT ONLY FOR  
FULL SIZE SHEET (22"x34").


	DATE	REVISION	BY	DRAFTED: Ken Johnson CHECKED: Josh Hewes DESIGNED: Adrienne Dietrich	REVIEWED DAVID EVANS AND ASSOCIATES INC. 530 Center Street N.E., Suite 605 Salem Oregon 97301 Phone: 503.361.8635 EXPIRES: 12-31-05	TRANSPORTATION DIVISION OREGON DEPARTMENT OF TRANSPORTATION BRIDGE ENGINEERING SECTION	BRIDGE NO.	MULTNOMAH CHANNEL & PNWR ETC., SAUVIE ISLAND RD.	SHEET 104 OF 173
	03/09	As-Constructed	TDF				20136		
							DATE	BENT 6 - END BEAM DETAILS (2 OF 2)	DRAWING NO. 70291
							Sept. 2005		
							CALC. BOOK		

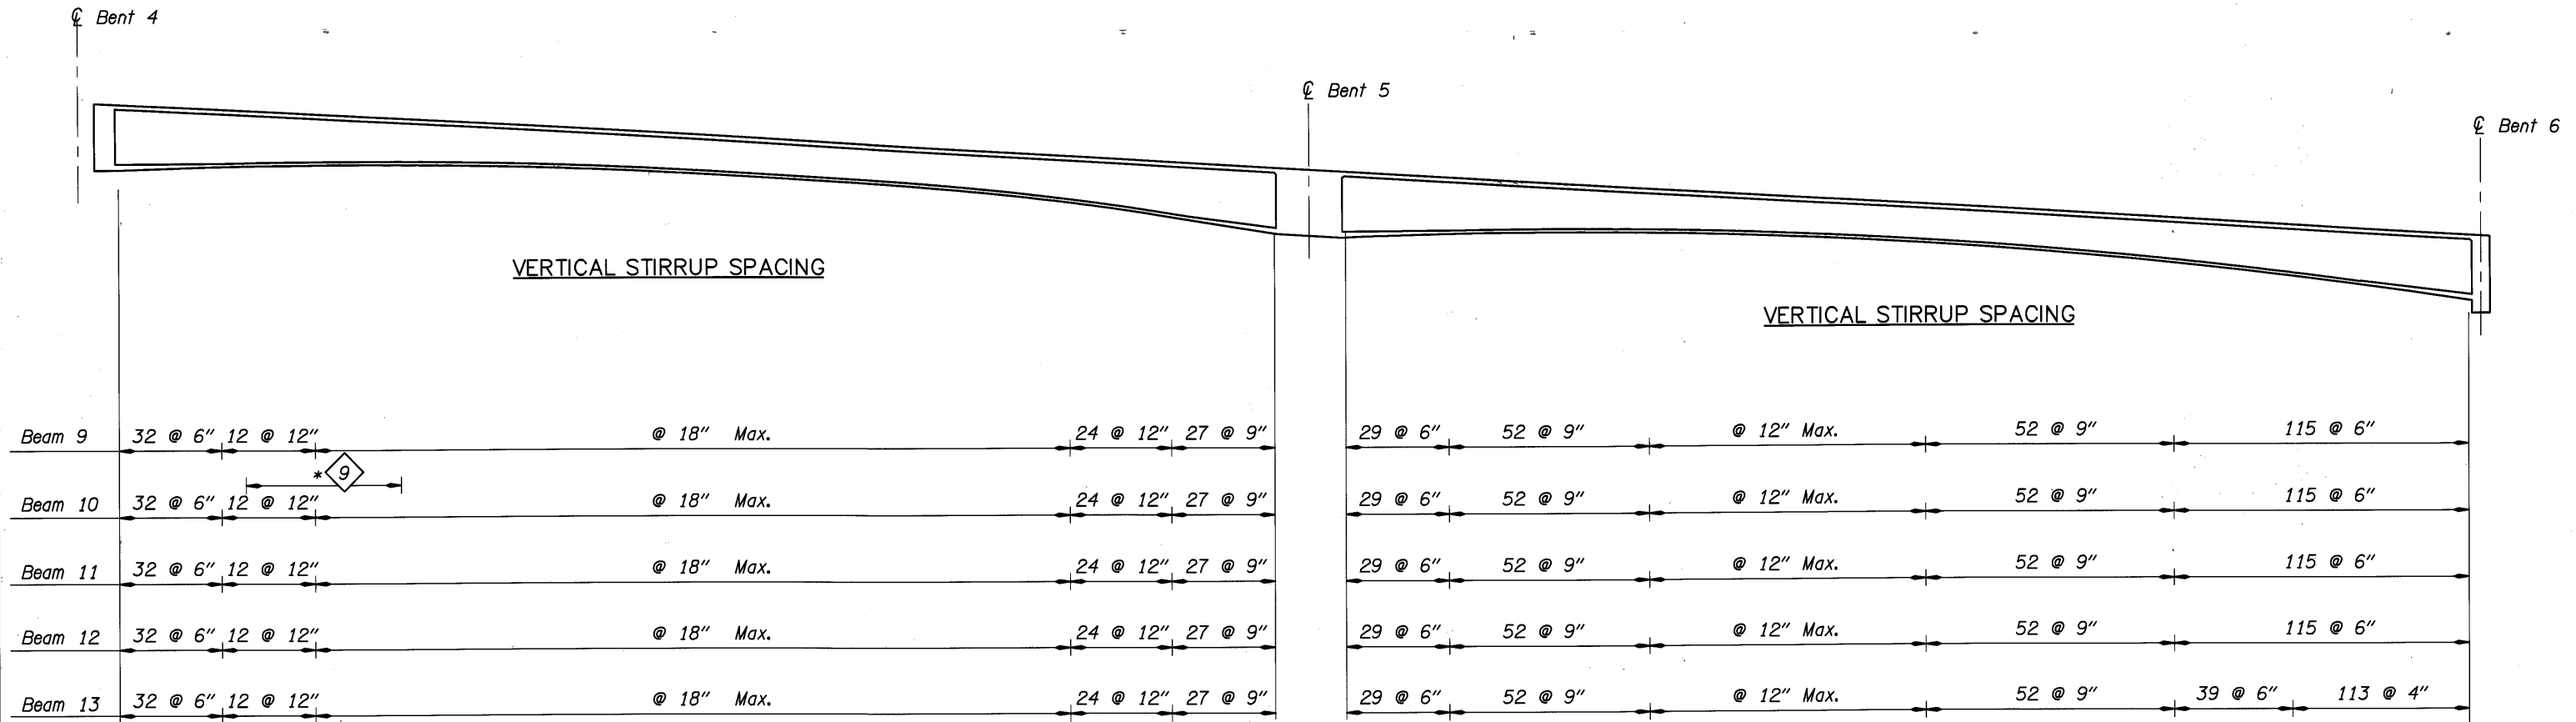

Indicates limits of #5  
at merging beams, see Dwg. #70281.

**LONGITUDINAL BEAM ELEVATION - SPANS 4 AND 5**

No Scale

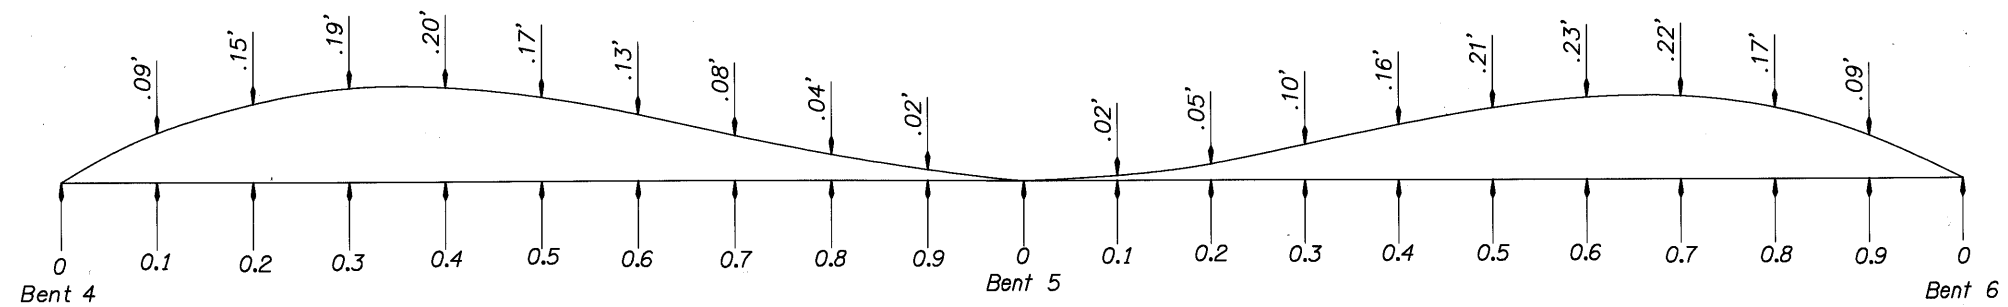

**CAMBER DIAGRAM**

No Scale


Note:  
Camber is designed to compensate for deflection due to post-tensioning, the dead load of all concrete and reinforcing steel and the long term effects of shrinkage and creep.

**Notes:**

- Spacing of #5 stirrups is measured along  $\bar{c}$  Beam.
- Stirrups are #5  $\diamond$  at Beams  $\diamond 9$  and  $\diamond 13$ .  
and #5  $\square$  at Beams  $\diamond 10$ ,  $\diamond 11$ , and  $\diamond 12$  unless noted otherwise.
- For stirrup spacing at beams  $\diamond 9a$  and  $\diamond 13a$ , see Dwg. #70267.


DO NOT SCALE THIS DRAWING.  
FOLLOW DIMENSIONS. INDICATED  
SCALES CORRECT ONLY FOR  
FULL SIZE SHEET (22"x34").

DATE 03/09	REVISION As-Constructed	BY TDF	DRAFTED: Ken Johnson	REVIEWED 		CONNECTING COMMERCE AND COMMUNITY <b>MULTNOMAH COUNTY</b> BRIDGES	TRANSPORTATION DIVISION	BRIDGE NO. 20136	MULTNOMAH CHANNEL & PNWR ETC., SAUVIE ISLAND RD.	SHEET 105 OF 173.
			CHECKED: Gernot Komar					DAVID EVANS AND ASSOCIATES INC. 530 Center Street N.E., Suite 605 Salem Oregon 97301 Phone: 503.361.8635		
			DESIGNED: Adrienne Dietrich	EXPIRES: 12-31-05			OREGON DEPARTMENT OF TRANSPORTATION BRIDGE ENGINEERING SECTION	CALC. BOOK	CAMBER DIAGRAM - SPANS 4 AND 5	

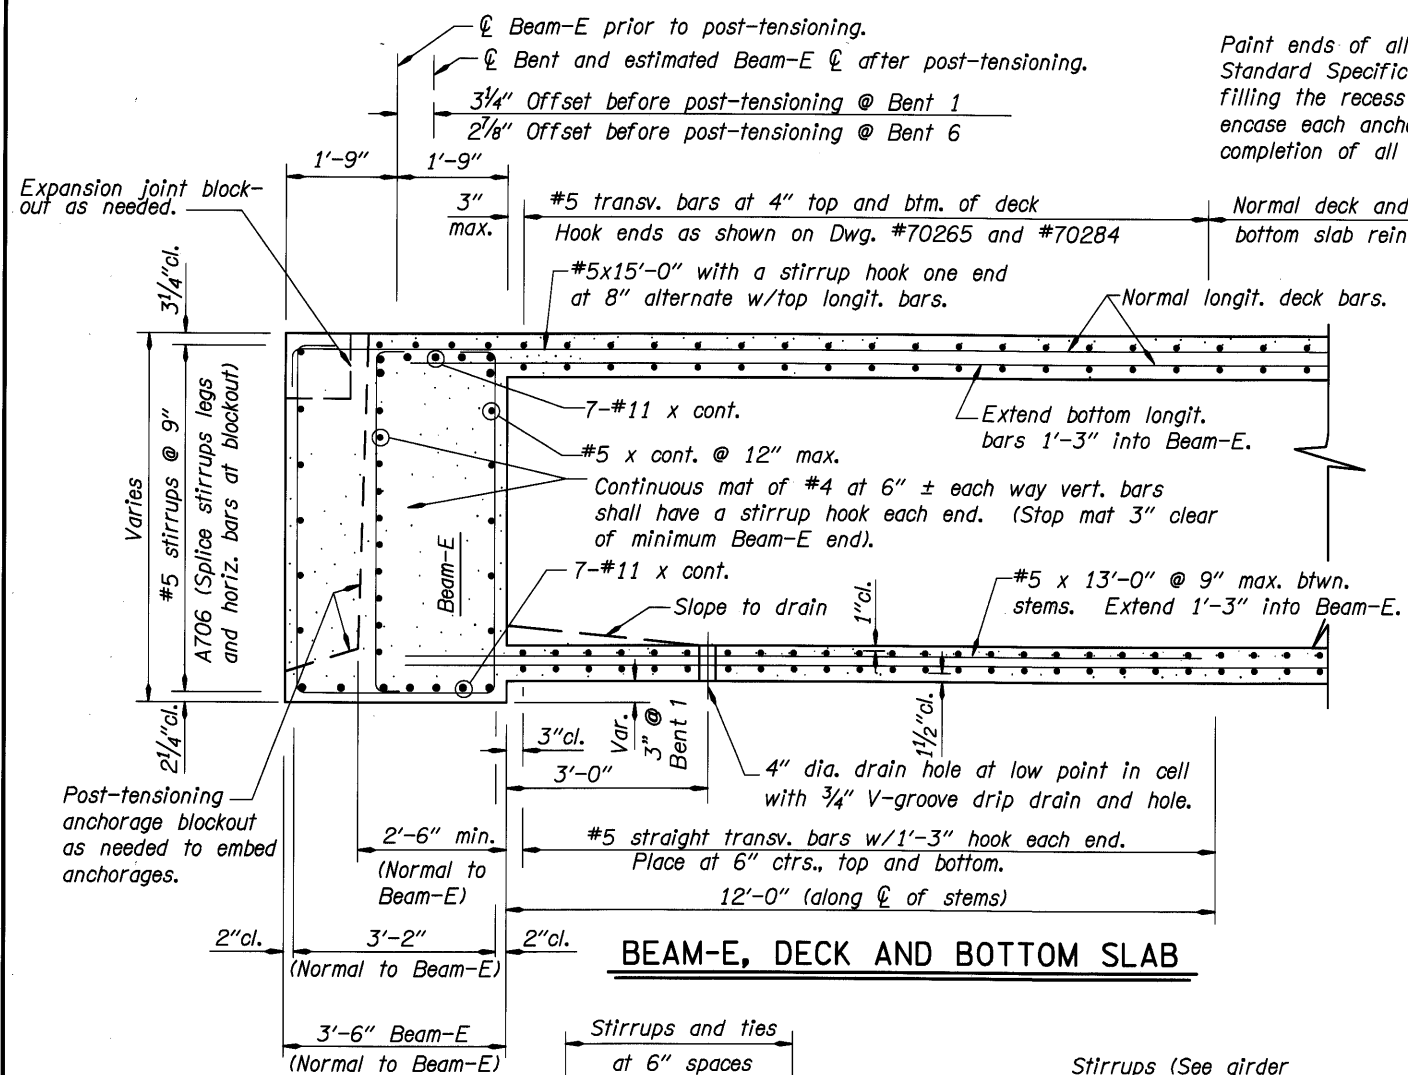

**BEAM-E, DECK AND BOTTOM SLAB**


Paint ends of all post-tensioning anchors per Standard Specifications 00582.38 prior to filling the recess with concrete, then completely encase each anchorage device in concrete at completion of all post tensioning operations.

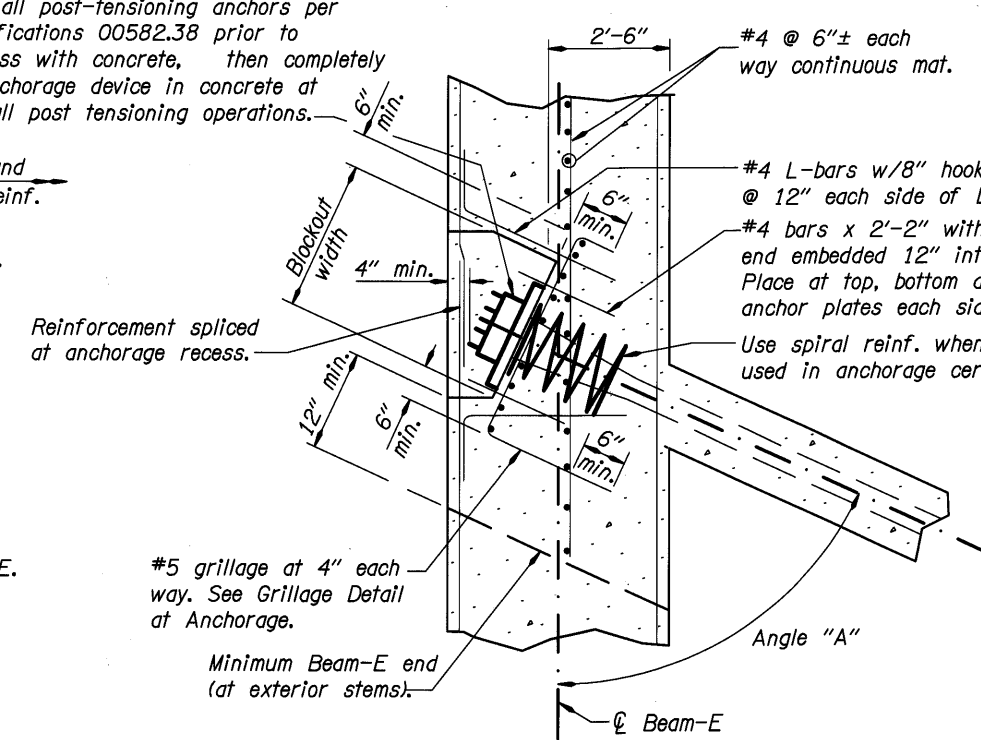


**BEAM ANCHORAGE DETAILS**

#5 grillage at 4" each way behind anchorages. Place 1" clear of anchorages. Use 4" hks. each end of verticals. Hook horizontal bars 6" min. past Beam-E mat as shown in details. Spread bars conflicting with post-tensioning ducts.

**GRILLAGE AT ANCHORAGE**

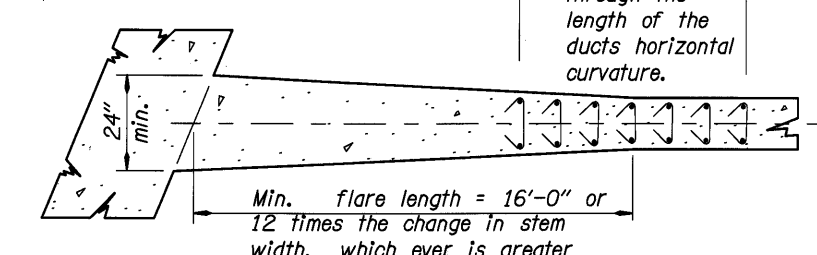


**GIRDER STEM FLARE**

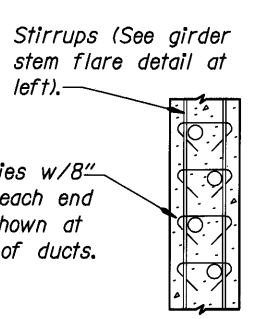

**HORIZONTAL TIE DETAILS**

(In areas with horizontal curved ducts)

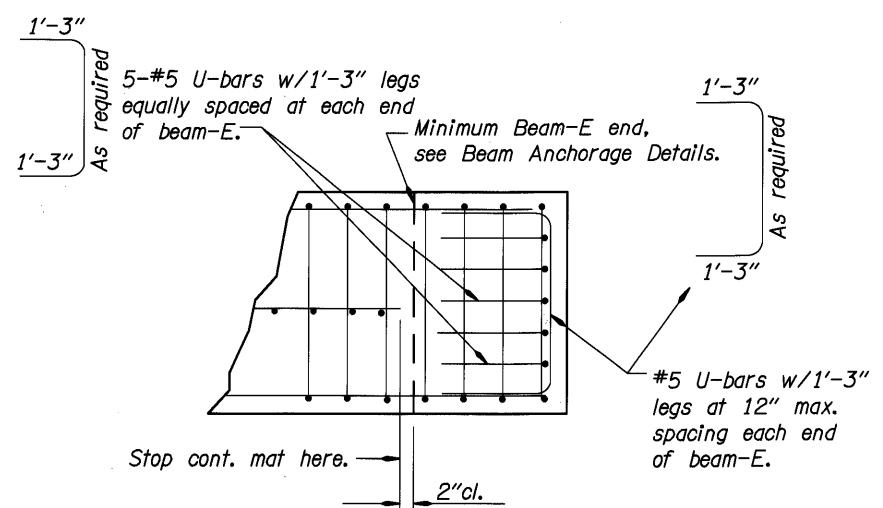

**PARTIAL PLAN SECTION BEAM-E END**

Typical for Bents 3, and 4.  
See Dwg. #70270 for Bent 1 and Dwg. #70291 for Bent 6.

DO NOT SCALE THIS DRAWING. FOLLOW DIMENSIONS. INDICATED SCALES CORRECT ONLY FOR FULL SIZE SHEET (22"x34").

NOTE :  
Flare interior face only of exterior stems.

DO NOT SCALE THIS DRAWING. FOLLOW DIMENSIONS. INDICATED SCALES CORRECT ONLY FOR FULL SIZE SHEET (22"x34").

DATE	03/09	REVISION	As-Constructed	BY	Ken Johnson	DESIGNER	 DAVID EVANS AND ASSOCIATES INC. 530 Center Street N.E., Suite 605 Salem Oregon 97301 Phone: 503.361.8635	BRIDGE NO.	20136	SHEET	106
					TDF				Josh Hewes		 MULTNOMAH COUNTY BRIDGES TRANSPORTATION DIVISION
					Adrienne Dietrich	 OREGON DEPARTMENT OF TRANSPORTATION BRIDGE ENGINEERING SECTION				DRAWING NO.	70293
								CALC. BOOK		GENERAL DETAILS - POST-TENSIONING	



**PRESTRESSING NOTES**

**CONCRETE:**

All concrete in post-tensioned box girder, bottom slab, stems is Class 5000 - 3/4".  
 All concrete in deck is Class HPC 5000 - 3/4".  
 Apply prestressing force after concrete has attained a strength of 5000 psi but not until a minimum of 14 days after final placement.

**PRESTRESSING STEEL:**


For Prestressing Force CGS Diagram, see Dwg. #70258, #70259, #70260, #70261, #70281, and #70282.  
 Use low relaxation seven wire strand (bright wire) (AASHTO M203 (ASTM A416), Grade 270, Supplement 1 with a minimum ultimate strength f's = 270 ksi.  
 Allowable initial stress before anchor set is 0.75 f's  
 Allowable initial stress at anchorages and couplers after anchor set is 0.70 f's.  
 Allowable initial stress at any other point after anchor set is 0.74 f's.  
 Allowable final service load stress after losses at any point is 0.72 f's.

**DUCTS:**

Provide ducts for prestressing steel in accordance with the specifications. Ducts may be bundled as shown. Stagger coupling locations in adjacent ducts. Securely fasten ducts to stirrups to prevent movement. The maximum permissible duct diameter is 0.4 times the minimum stem thickness. The duct area shall be at least 2.5 times the net prestressing steel contained.


**GROUTING:**

Pressure grout prestressing steel in accordance with the Specifications.

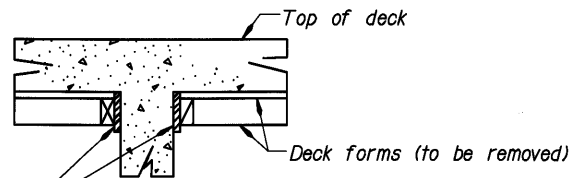

Place 1/2" preformed expansion joint filler between end of deck forms and transverse beams and at 25'-0" spacing, to provide for shortening between deck form sections.

**INTERIOR FORM DETAIL**

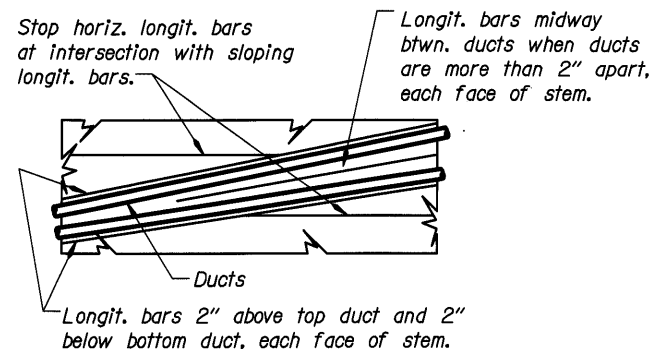

**LONGITUDINAL STEM REINFORCING AT DUCT PART ELEVATION OF GIRDER STEM**

**STRESSING DETAILS:**

Initial force before anchor set, Pj, is as follows:

$$A_s = \frac{P_j}{0.75f's}$$

Initial force before anchor set, Pj, is as follows:

Beams	Path	Pj	Minimum final force and location
1-4	2	13,010,000 lbs	10,480,000 lbs at Bent 1 9,300,000 lbs at Bent 3
5-8	1	11,430,000 lbs	9,140,000 lbs at Bent 1 8,180,000 lbs at Bent 3
9-13	3	14,940,000 lbs	11,990,000 lbs at Bent 4 10,000,000 lbs at Bent 6

Jack tendons to (As) (0.75f's) and anchor at an equivalent anchor set of 3/8 inch. The prestress force is designed to be distributed equally to all girders unless shown otherwise. The prestress force per girder may vary by 5% from the design value provided that the total force is symmetrical about center line of structure.

Stress each tendon as follows:

Beams	Path	Stress
1-4	2	Stress from Bent 1 end of structure
5-8	1	Stress from Bent 1 end of structure
9-13	3	Stress from Bent 4 end of structure

Stress no more than 50% of strands in one girder before an equal number are stressed in the other girders. No more than 1/6 of total prestressing force is to be eccentric about center line of structure at any one time. Begin stressing at or near center line of section.

**DESIGN DATA**

Use friction factors of u = 0.25, k = 0.0002 to compute losses. Assume loss of stress in post-tensioned prestressing steel to be 25,000 psi due to creep and shrinkage of concrete, creep of steel, and sequence of stressing.

**CONSTRUCTION NOTES:**

Allow for total long term structure shortening (due to effects of prestressing, elastic shortening, creep and shrinkage).  
 The anticipated total shortening is 3/4" at Bent 1, 2 1/2" at Bent 3, 2 1/8" at Bent 4 and 2 1/8" at Bent 6.

Construct falsework to permit the superstructure to lift off the falsework and shorten during stressing operations. Other exterior forms are to be free of falsework and any interior forms in cells are not to resist shortening during stressing operation. Do not remove falsework under the bottom slab of the box girder until after stressing.


Dimensions of concrete sections and the anchorage reinforcement shown on plans determine pay quantities. Changes requested by contractor to accommodate a given post-tensioning system are not reason for extra payment.

Paint ends of all post-tensioning anchors per Standard Specifications Sec. 00582.38 prior to filling the recess with concrete.

Place concrete for sidewalks prior to stressing.


Place concrete for bridge rails in Span 1 after stressing and grouting operations.

Obtain approval of the Engineer for any changes.

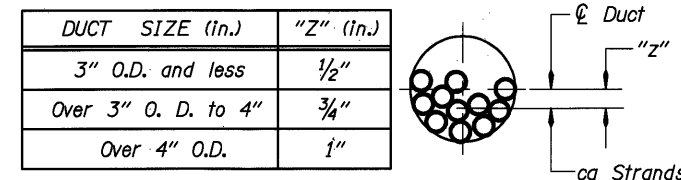


Consider the amount of tendon offset ("z") within the duct as shown for the purpose of calculating the center of gravity of prestressing steel.


**TENDON OFFSET DETAIL**

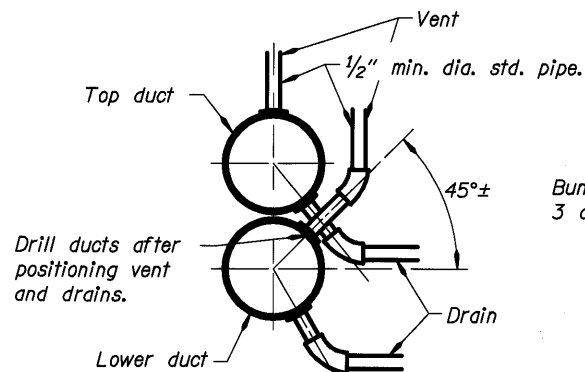

**GROUT VENT DETAIL FOR HIGH POINT VENTS AND LOW POINT DRAINS**

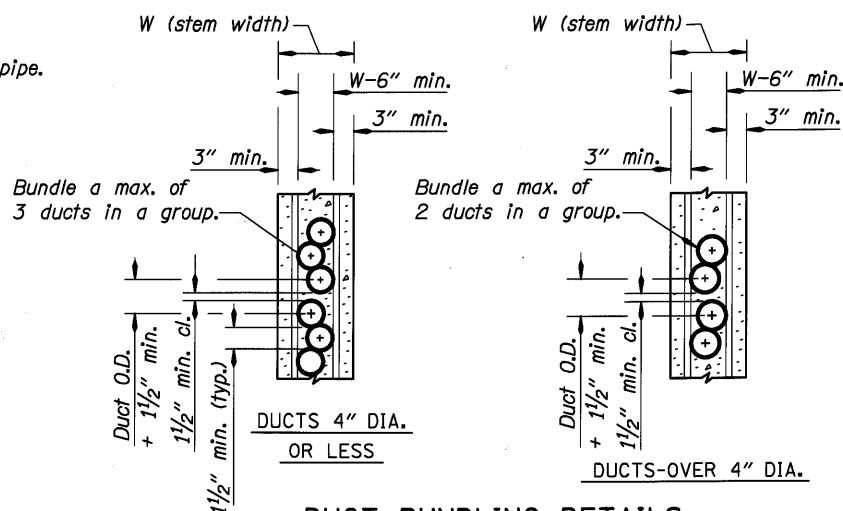

**DUCT BUNDLING DETAILS**

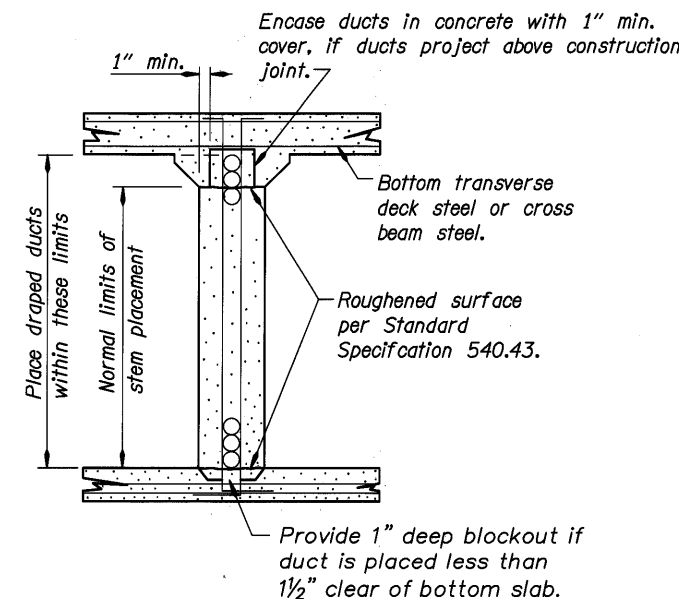






**TENDON LIMITATION DETAILS**

DO NOT SCALE THIS DRAWING. FOLLOW DIMENSIONS. INDICATED SCALES CORRECT ONLY FOR FULL SIZE SHEET (22"x34").

DATE	REVISION	BY	REVIEWED	BRIDGE NO.	SHEET
03/09	As-Constructed	TDF	Ken Johnson	20136	107
			Gernot Komar	DATE	OF
			Josh Hewes	Sept. 2005	173.
				CALC. BOOK	DRAWING NO.
					70294


xref: 07929-11\_DLVA.dwg 001BDR.dwg 07929-12.dwg

LIMITS OF CURVED BEAM DETAIL				
Span No.	Beam No.	Direction	Begin Station	End Station
1	1	Left	11+87.42	12+47.36
	2	Left	11+86.47	12+47.36
	3	Left	11+85.53	12+47.36
	6	Right	11+51.03	12+68.09
	7	Right	11+52.60	12+68.09
	8	Right	11+54.20	12+68.09
2	1	Right	13+15.00	13+91.02
	1	Left	13+91.02	14+67.03
	2	Right	13+15.00	13+91.02
	2	Left	13+91.02	14+67.03
	3	Right	13+15.00	13+91.02
	3	Left	13+91.02	14+67.03
5	9	Left	21+79.84	22+76.07
	10	Left	21+79.84	22+76.07
	11	Left	21+79.84	22+76.07
	12	Left	21+79.84	22+76.07
	13	Left	21+79.84	22+76.07

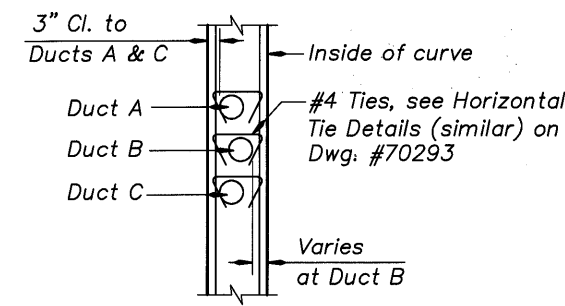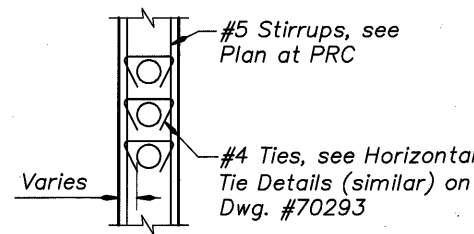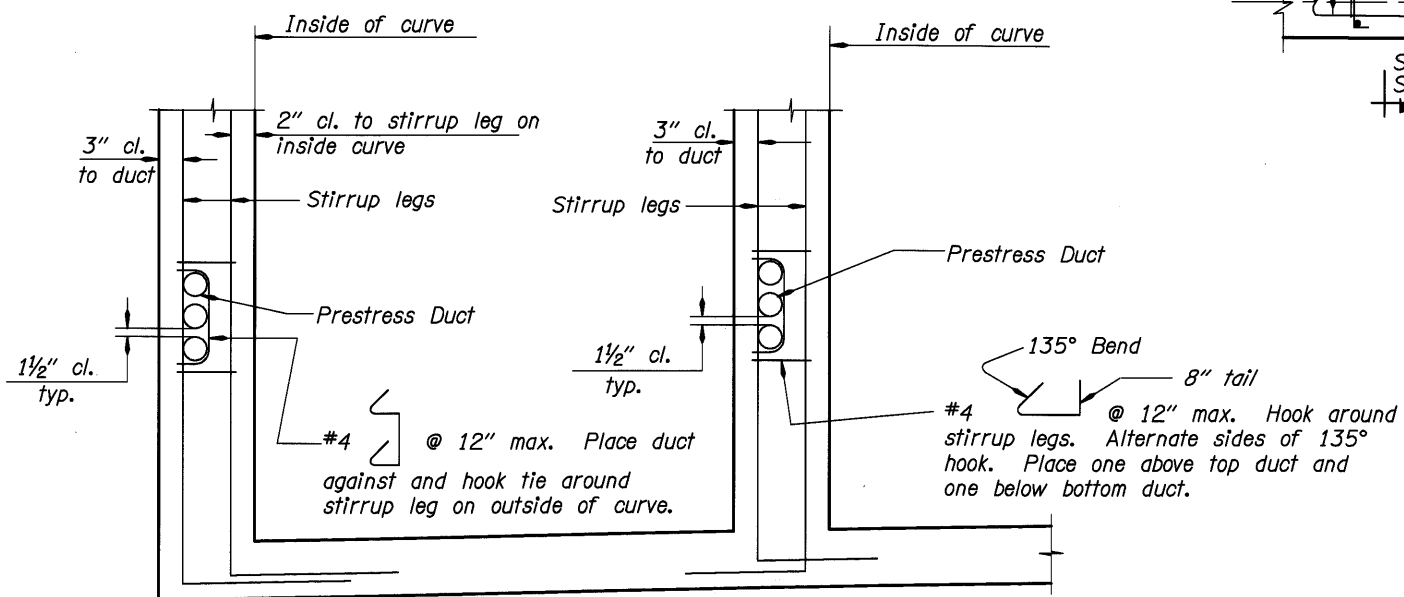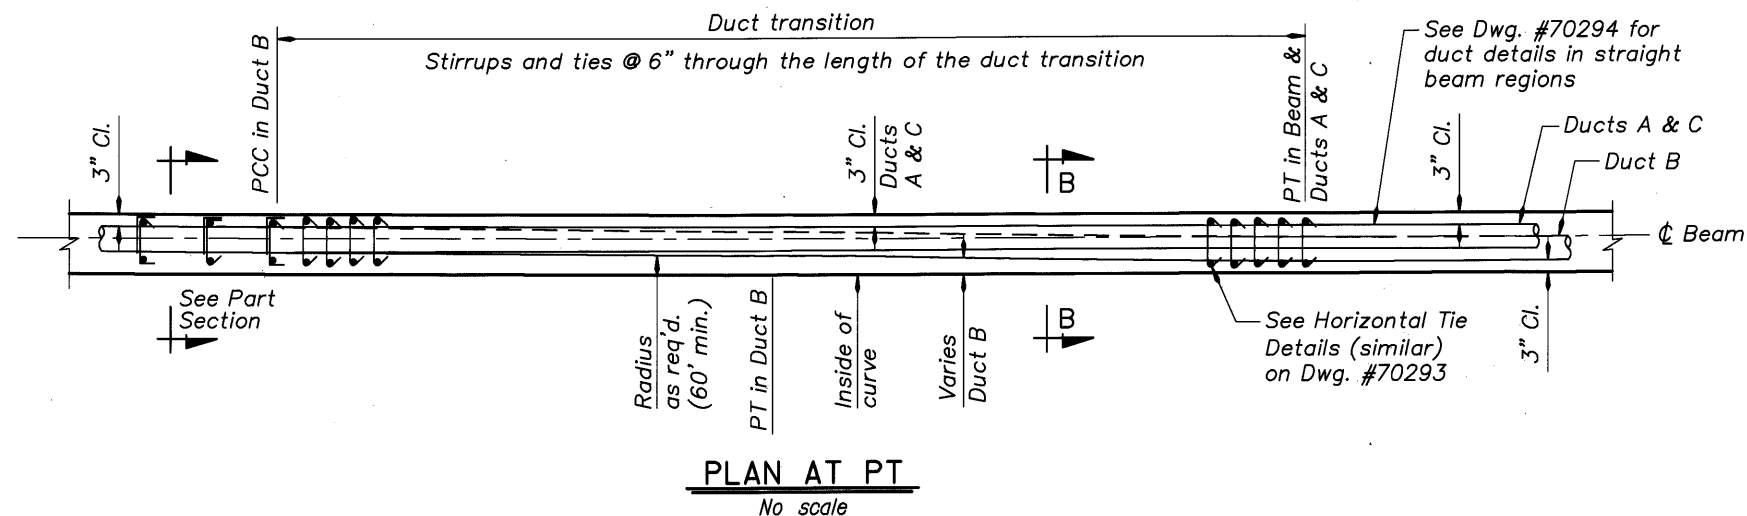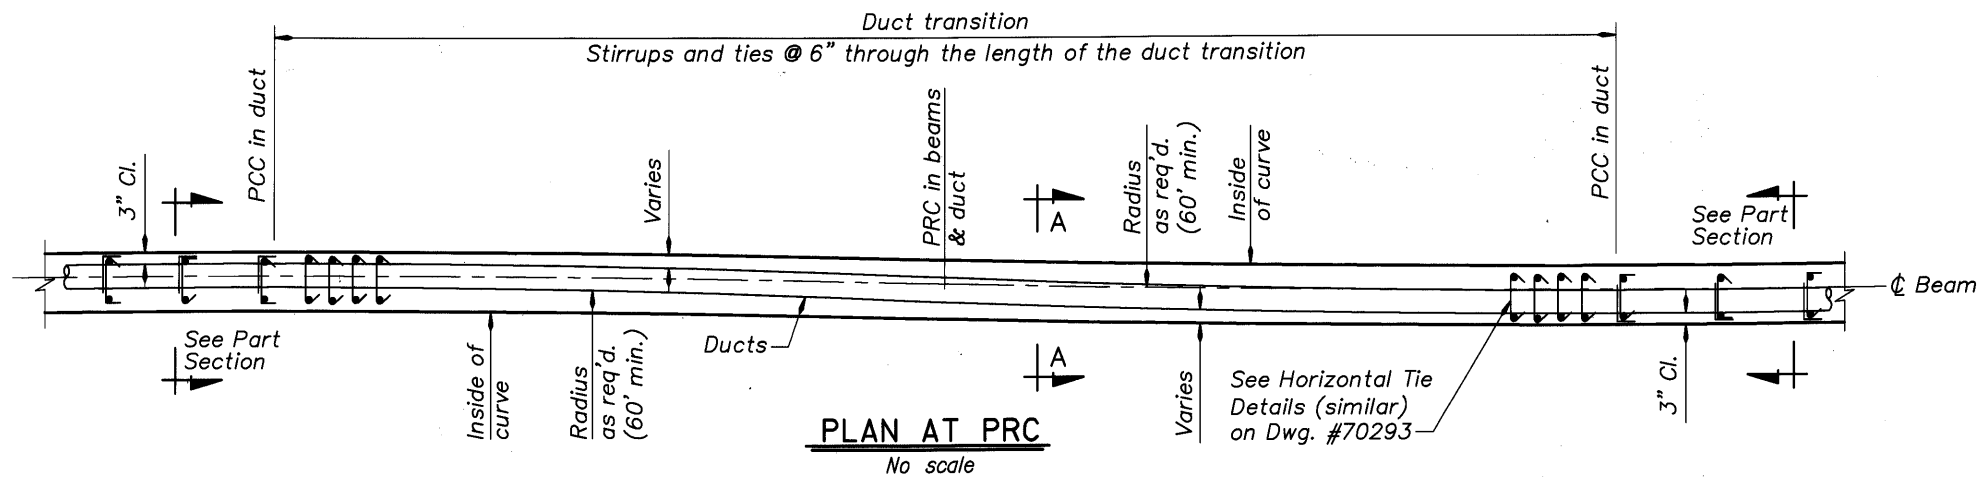


DO NOT SCALE THIS DRAWING. FOLLOW DIMENSIONS. INDICATED SCALES CORRECT ONLY FOR FULL SIZE SHEET (22"x34").


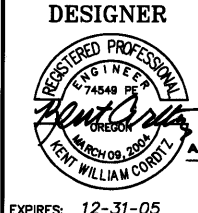
DATE	03/09	REVISION	As-Constructed	BY	Ken Johnson	DESIGNER	DAVID EVANS AND ASSOCIATES INC. 530 Center Street N.E., Suite 605 Salem Oregon 97301 Phone: 503.361.8635	BRIDGE NO.	20136	DATE	Sept. 2005	CALC. BOOK	MULTNOMAH CHANNEL & PNWR ETC., SAUVIE ISLAND RD.	SHEET	108
	03/09		As-Constructed		Ken Johnson				20136		Sept. 2005				108
DATE		REVISION		BY	Josh Hewes	DESIGNER	MULTNOMAH COUNTY BRIDGES TRANSPORTATION DIVISION OREGON DEPARTMENT OF TRANSPORTATION BRIDGE ENGINEERING SECTION	BRIDGE NO.		DATE		CALC. BOOK		OF	173.
DATE		REVISION		BY	Adrienne Dietrich	DESIGNER								DRAWING NO.	70295

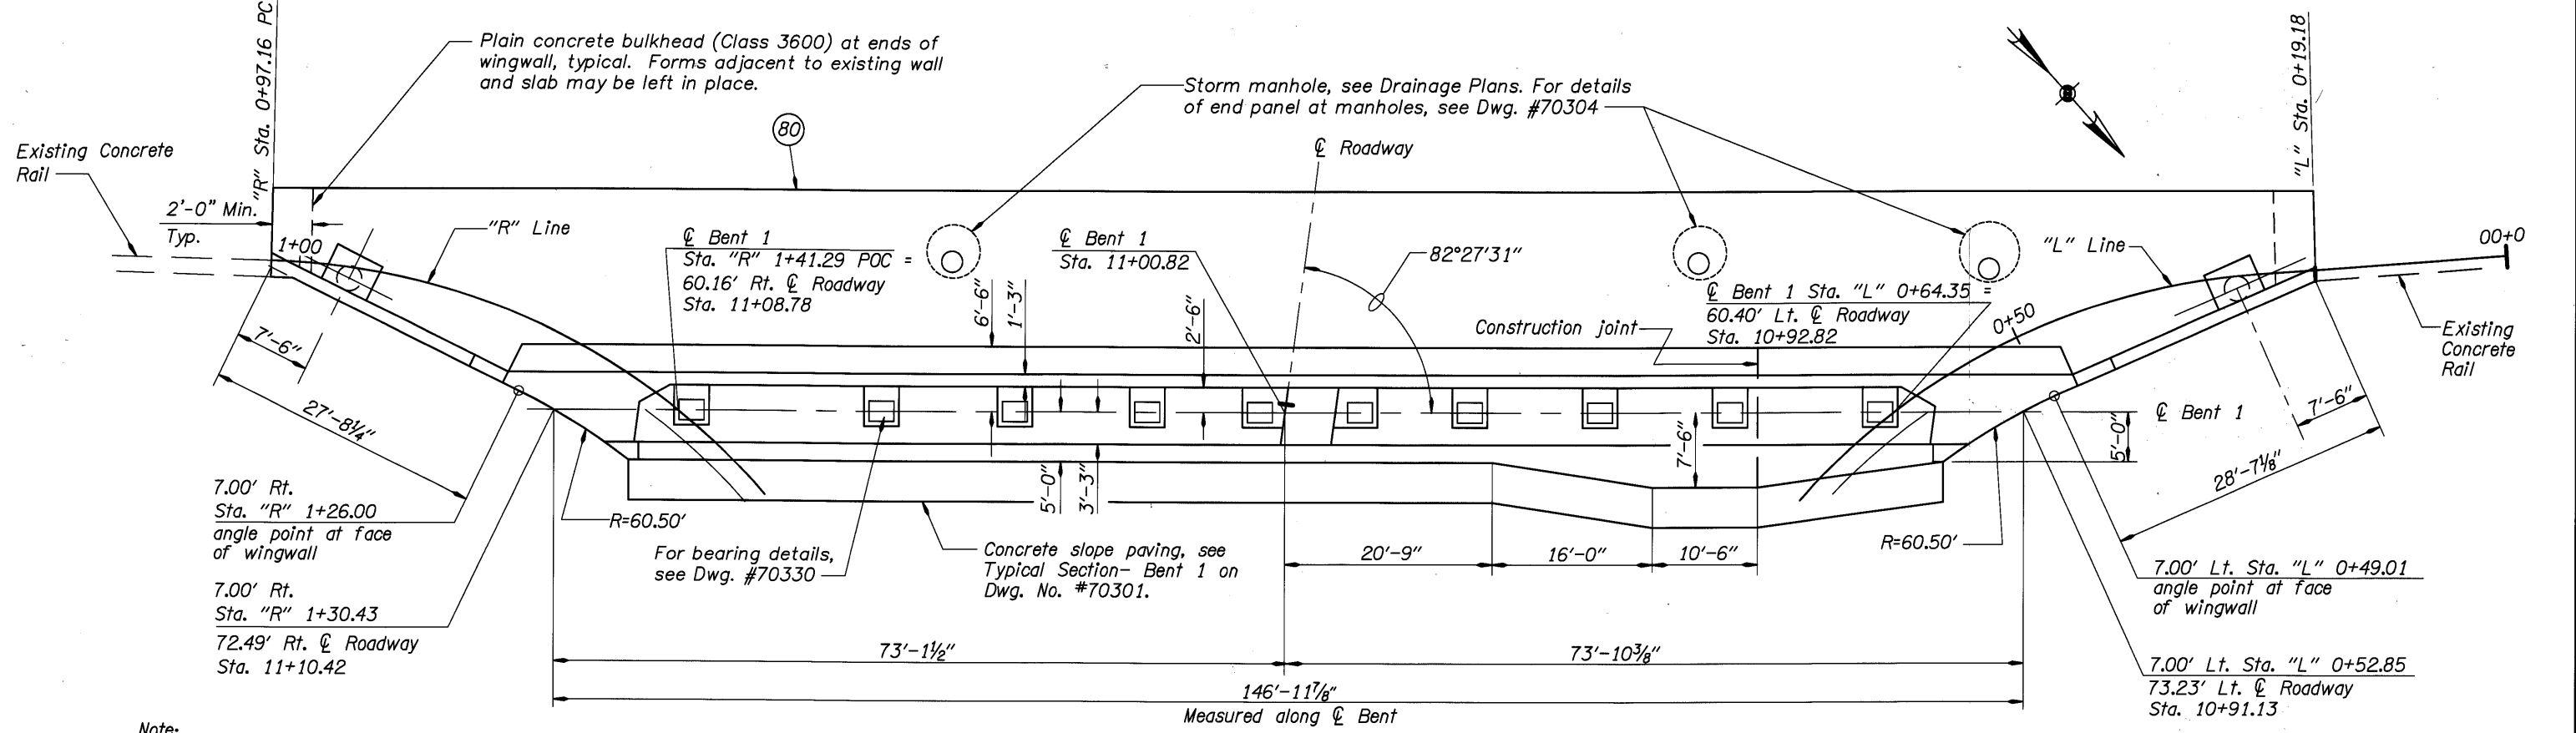


**Note:**  
 See Dwg. #70336 and #70337 for deck drainage details.  
 See Dwg. #70343 to #70355 for lighting details and conduit locations.  
 See Dwg. #70360 for utility conduit and hanger details.

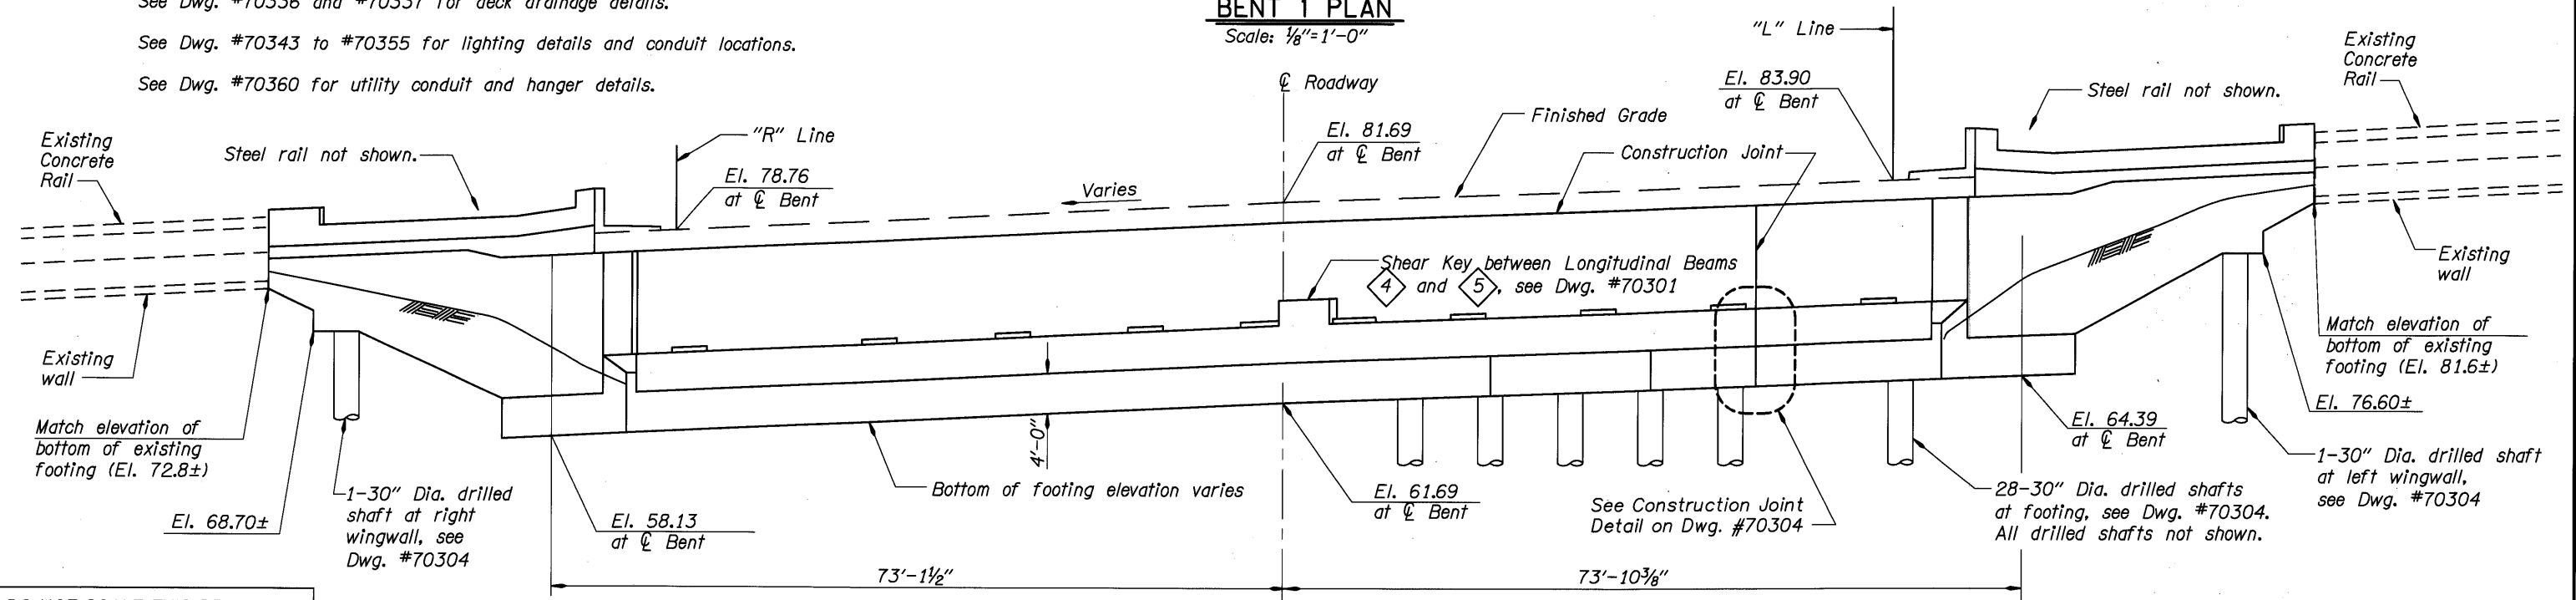

**DO NOT SCALE THIS DRAWING. FOLLOW DIMENSIONS. INDICATED SCALES CORRECT ONLY FOR FULL SIZE SHEET (22"x34").**


	DATE	REVISION	BY	DESIGNER	 TRANSPORTATION DIVISION OREGON DEPARTMENT OF TRANSPORTATION BRIDGE ENGINEERING SECTION	BRIDGE NO.	MULTNOMAH CHANNEL & PNWR ETC., SAUVIE ISLAND RD.	SHEET
	03/09	As-Constructed	TDF	Ken Johnson		20136		109
				Josh Hewes	DATE	173		
				Adrienne Dietrich	Sept. 2005		DRAWING NO.	
				 DAVID EVANS AND ASSOCIATES INC. 530 Center Street N.E., Suite 605 Salem Oregon 97301 Phone: 503.361.8635	CALC. BOOK	BENT 1 - PLAN AND ELEVATION		70296

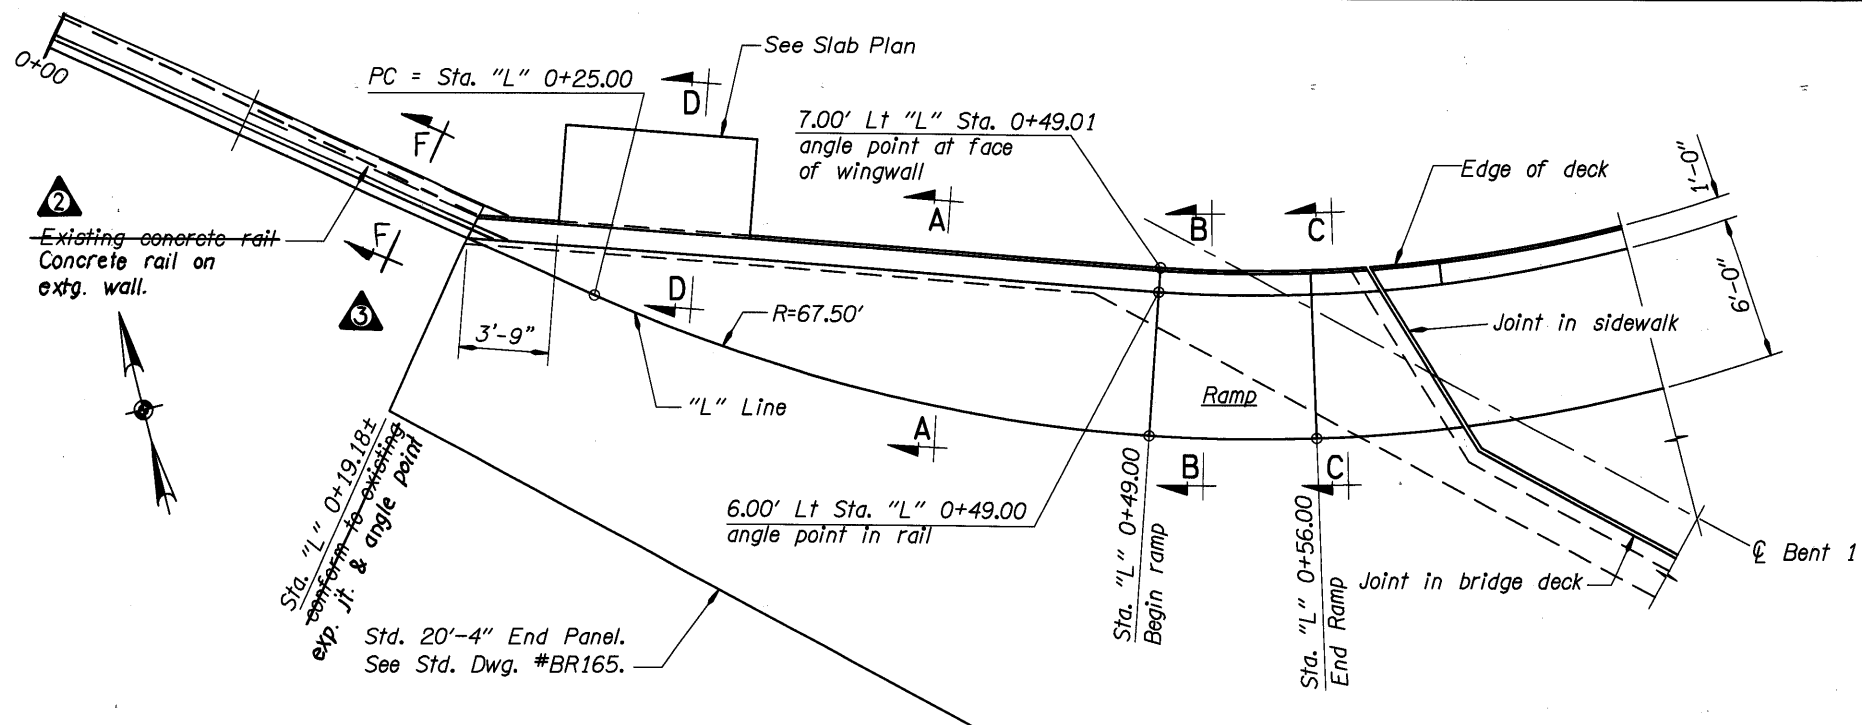

**SIDEWALK PLAN**


Scale: 1/4"=1'-0"

For details of Section A-A, B-B, and C-C, see Dwg. #70299.

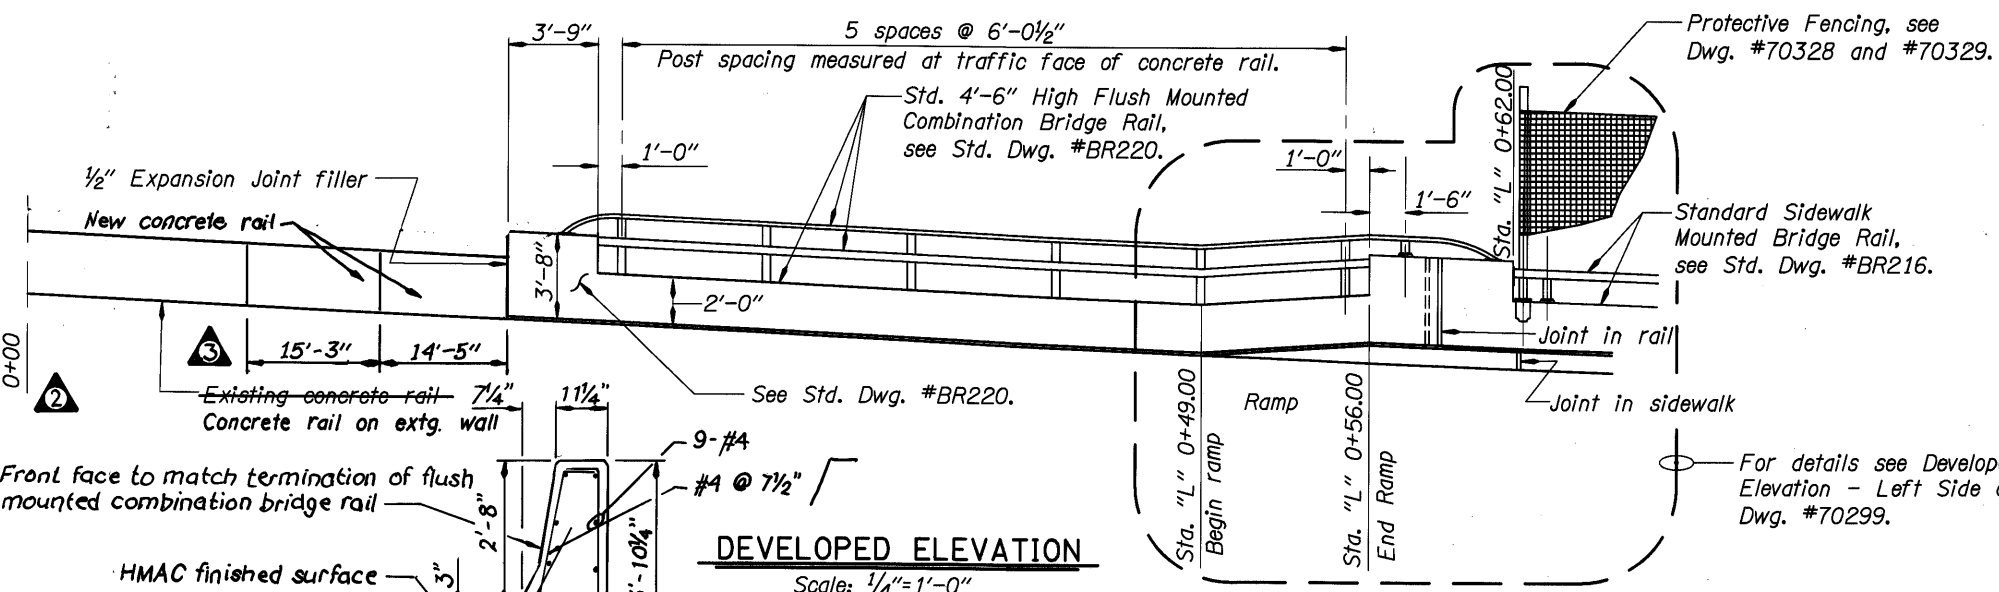


**DEVELOPED ELEVATION**

Scale: 1/4"=1'-0"

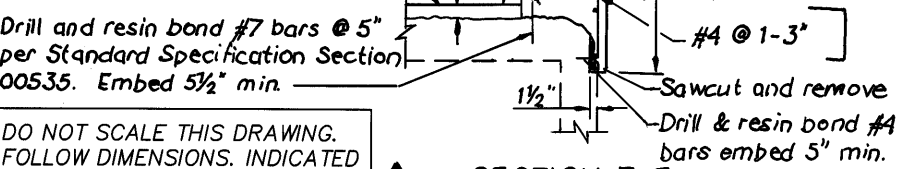


**SECTION F-F**

No Scale

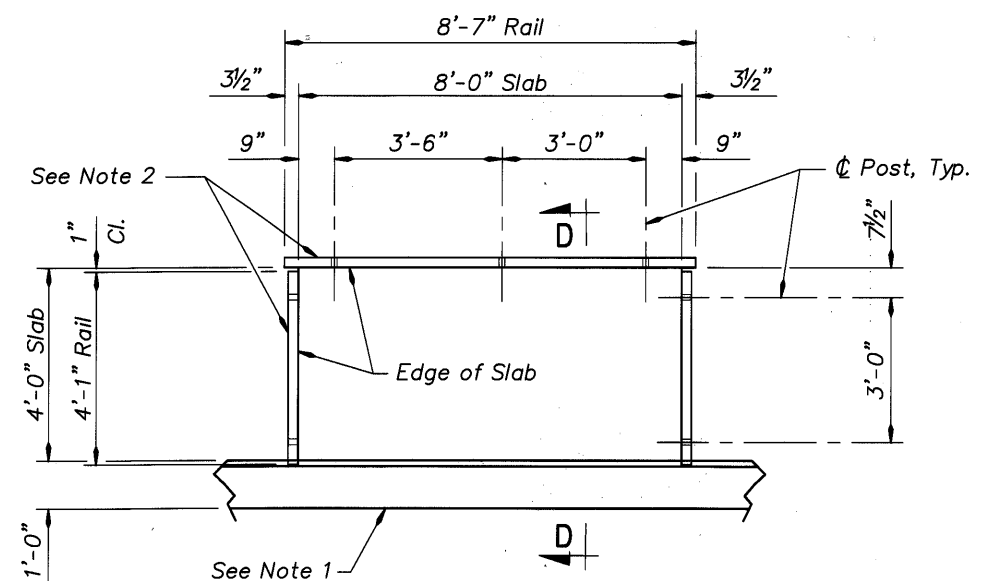

**SLAB PLAN**

Scale: 1/2"=1'-0"

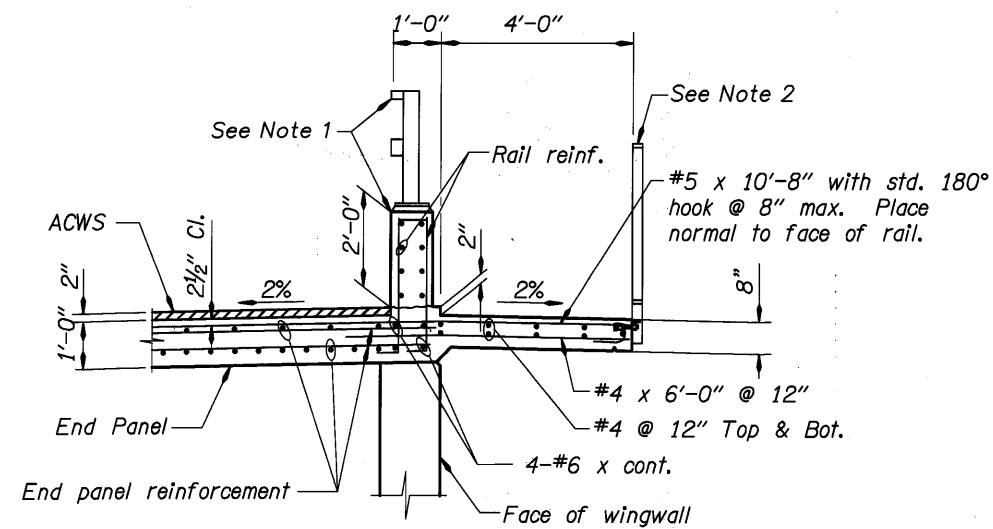

**SECTION D-D**

Scale: 1/2"=1'-0"

**Notes:**

1. Std. 4'-6" high Flush Mounted Combination Bridge Rail, see Std. Dwg. #BR220.
2. Std. Pedestrian Rail, see Std. Dwg. #BR246.
3. For wingwall reinforcement and dowels, see Dwg. #70302.

DO NOT SCALE THIS DRAWING. FOLLOW DIMENSIONS. INDICATED SCALES CORRECT ONLY FOR FULL SIZE SHEET (22"x34").

DATE	REVISION	BY	DRAFTED:
08/05	Added slab	KWC	Ken Johnson
10/08	Revised Rail Transition	KPB	Josh Hewes
03/09	As-Constructed	TD	Adrienne Dietrich


**DESIGNER**  
  
**DAVID EVANS AND ASSOCIATES, INC.**  
 530 Center Street N.E., Suite 605  
 Salem Oregon 97301  
 Phone: 503.361.8635

CONNECTING COMMERCE AND COMMUNITY  
  
 TRANSPORTATION DIVISION  
**OREGON DEPARTMENT OF TRANSPORTATION**  
**BRIDGE ENGINEERING SECTION**

<b>BRIDGE NO.</b>	20136
<b>DATE</b>	Sept. 2005
<b>CALC. BOOK</b>	

MULTNOMAH CHANNEL & PNWR ETC., SAUVIE ISLAND RD.  
**BENT 1 - LEFT SIDEWALK DETAILS**

<b>SHEET</b>	110
<b>OF</b>	173
<b>DRAWING NO.</b>	70297

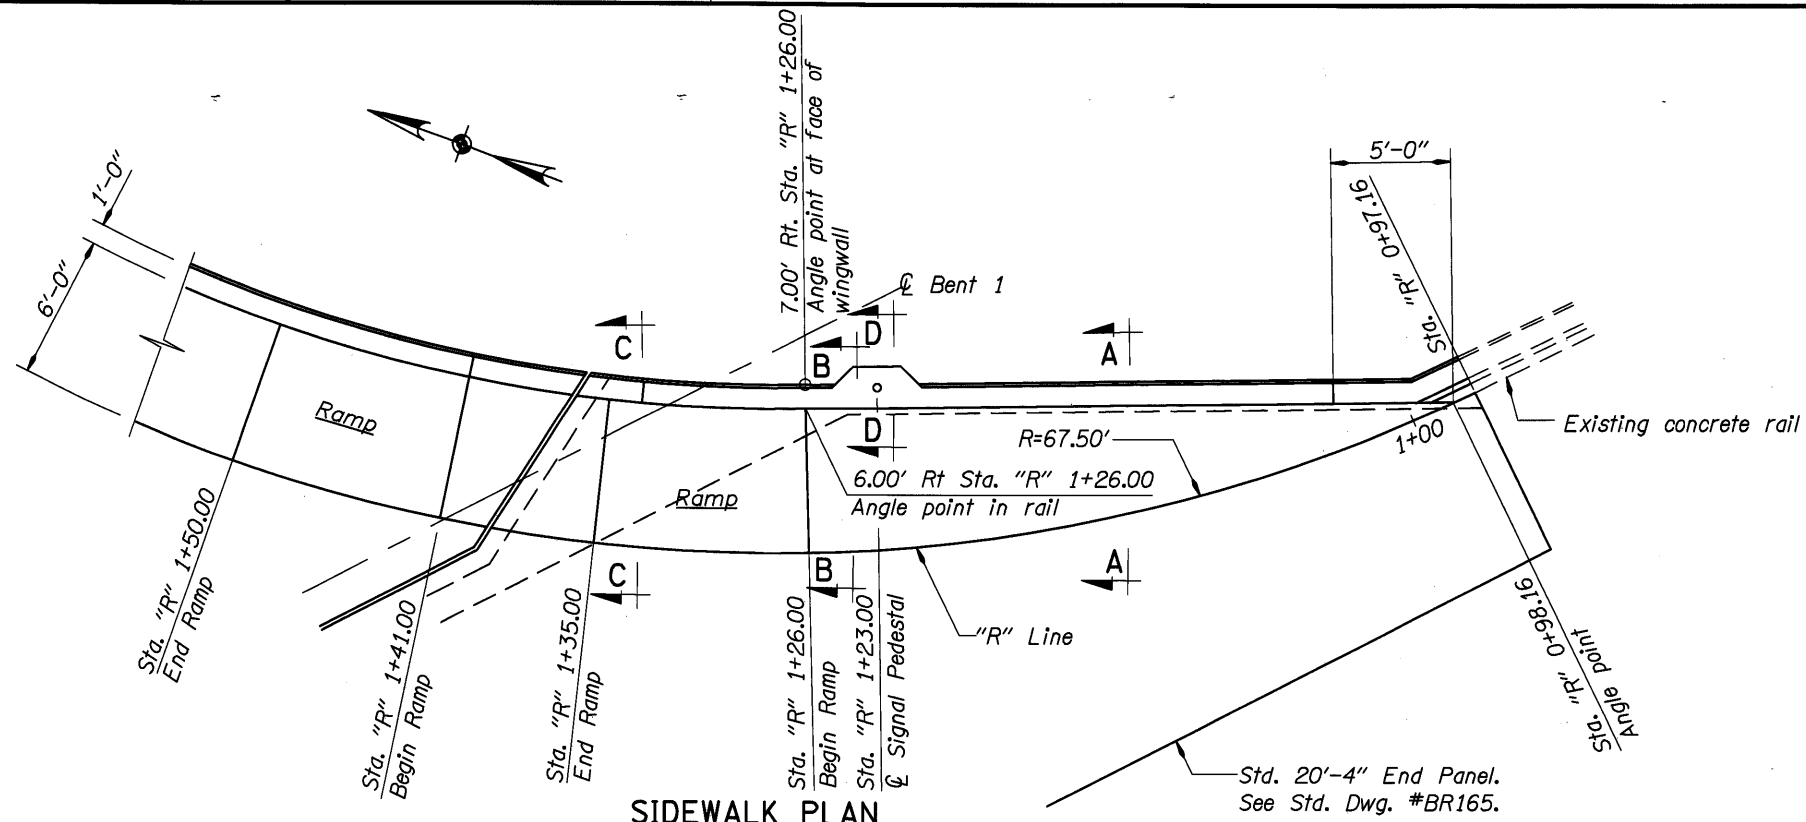


**SIDEWALK PLAN**

Scale: 1/4" = 1'-0"

For details see "Developed Elevation - Right Side" on Dwg. #70299. For details of Sections A-A, B-B and C-C, see Dwg. #70299.

Protective Fencing, see Dwg. #70328 and #70329.


Standard Sidewalk Mounted Bridge Rail, see Std. Dwg. #BR216.

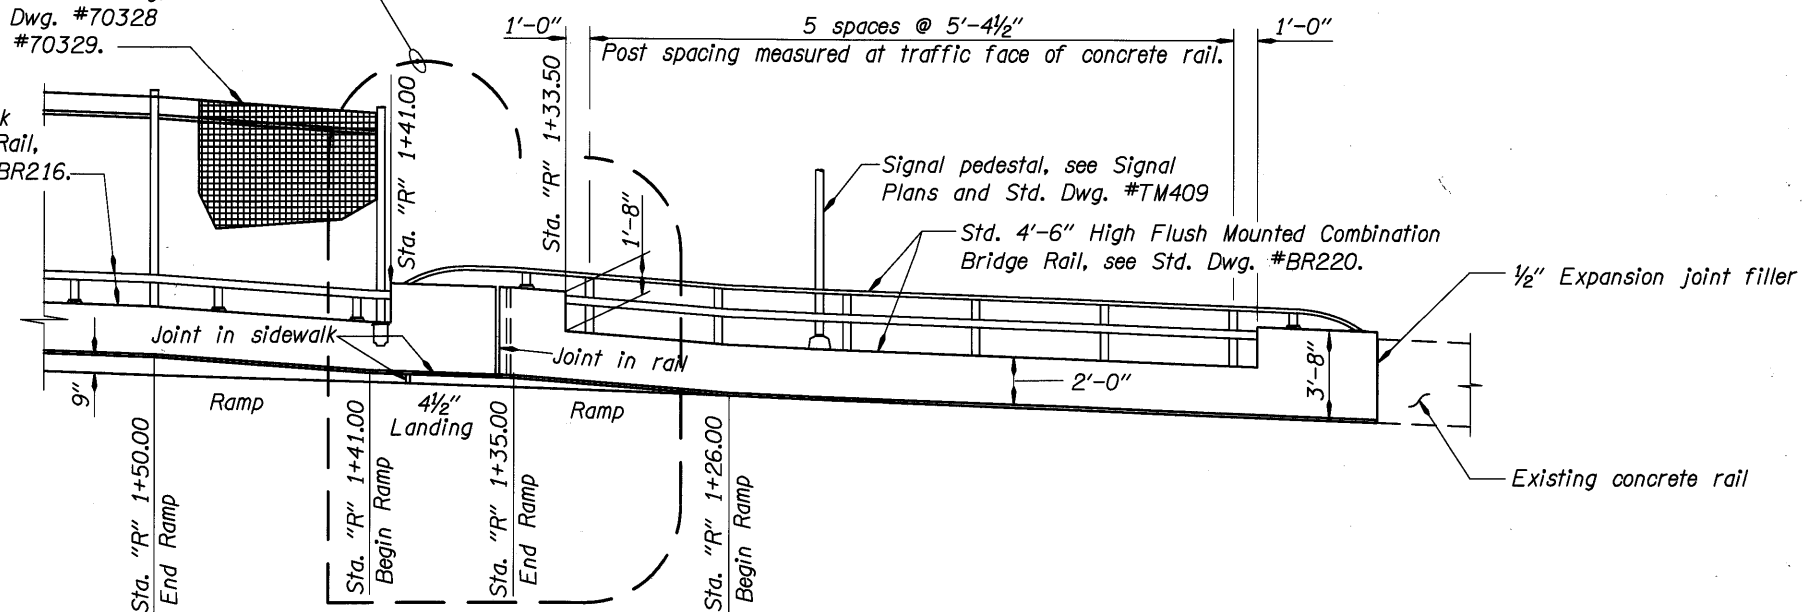

**DEVELOPED ELEVATION**

Scale: 1/4" = 1'-0"

DO NOT SCALE THIS DRAWING. FOLLOW DIMENSIONS. INDICATED SCALES CORRECT ONLY FOR FULL SIZE SHEET (22"x34").

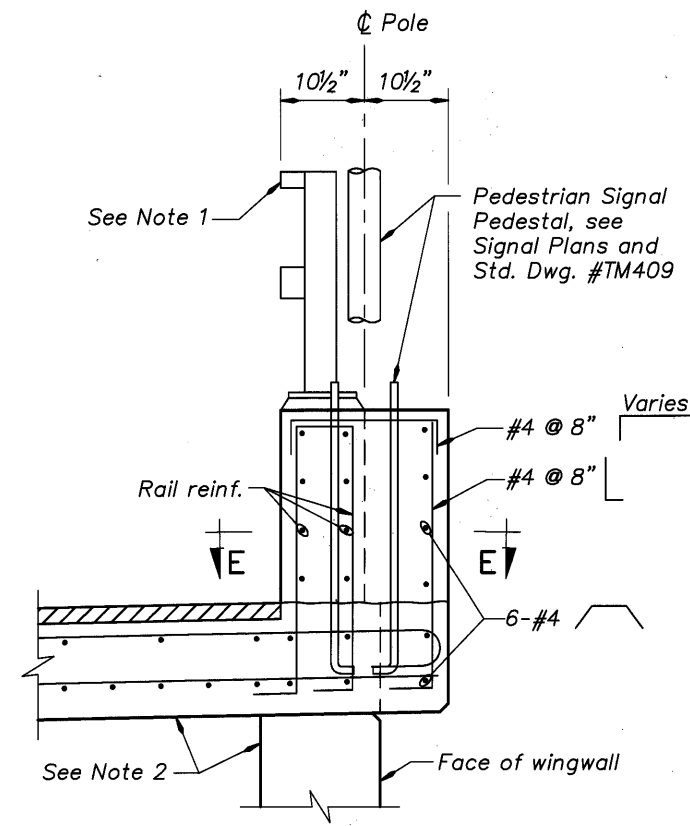


**SECTION D-D**

Scale: 1" = 1'-0"

**Notes:**

1. Std. 4'-6" high Flush Mounted Combination Bridge Rail, see Std. Dwg. #BR220.
2. For details not shown or noted, see Section A-A on Dwg. #70299.

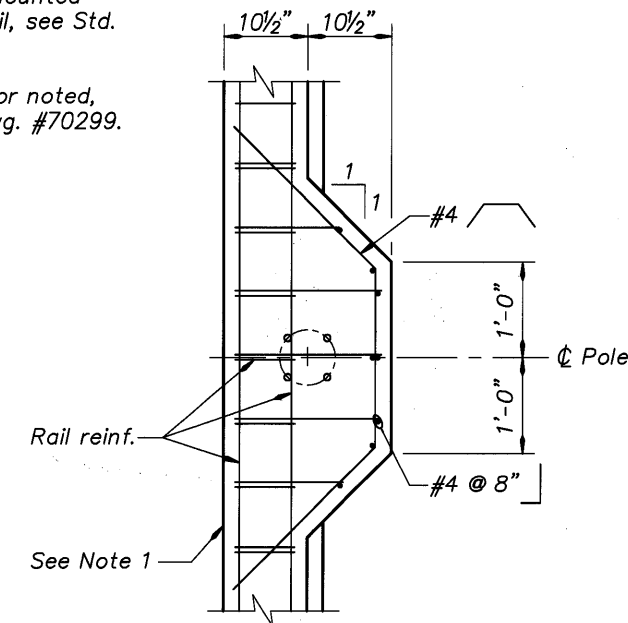


**SECTION E-E**

Scale: 1" = 1'-0"


DATE	03/09	REVISION	As-Constructed	BY	TDF	DESIGNER	Ken Johnson	BRIDGE NO.	20136	SHEET	111
											OF
CHECKED:		REVIEWED:				DAVID EVANS AND ASSOCIATES INC.	Josh Hewes	DATE	Sept. 2005	DRAWING NO.	70298
DO NOT SCALE THIS DRAWING. FOLLOW DIMENSIONS. INDICATED SCALES CORRECT ONLY FOR FULL SIZE SHEET (22"x34").							TRANSPORTATION DIVISION MULTNOMAH COUNTY BRIDGES		MULTNOMAH CHANNEL & PNWR ETC., SAUVIE ISLAND RD.		
REGISTERED PROFESSIONAL ENGINEER 74549 PE OREGON MARCH 09, 2004 WENT WILLIAM CORDT							OREGON DEPARTMENT OF TRANSPORTATION BRIDGE ENGINEERING SECTION		BENT 1 - RIGHT SIDEWALK DETAILS		
530 Center Street N.E., Suite 605 Salem Oregon 97301 Phone: 503.361.8635							BRIDGE NO. 20136 DATE Sept. 2005 CALC. BOOK		SHEET 111 OF 173 DRAWING NO. 70298		

DO NOT SCALE THIS DRAWING. FOLLOW DIMENSIONS. INDICATED SCALES CORRECT ONLY FOR FULL SIZE SHEET (22"x34").

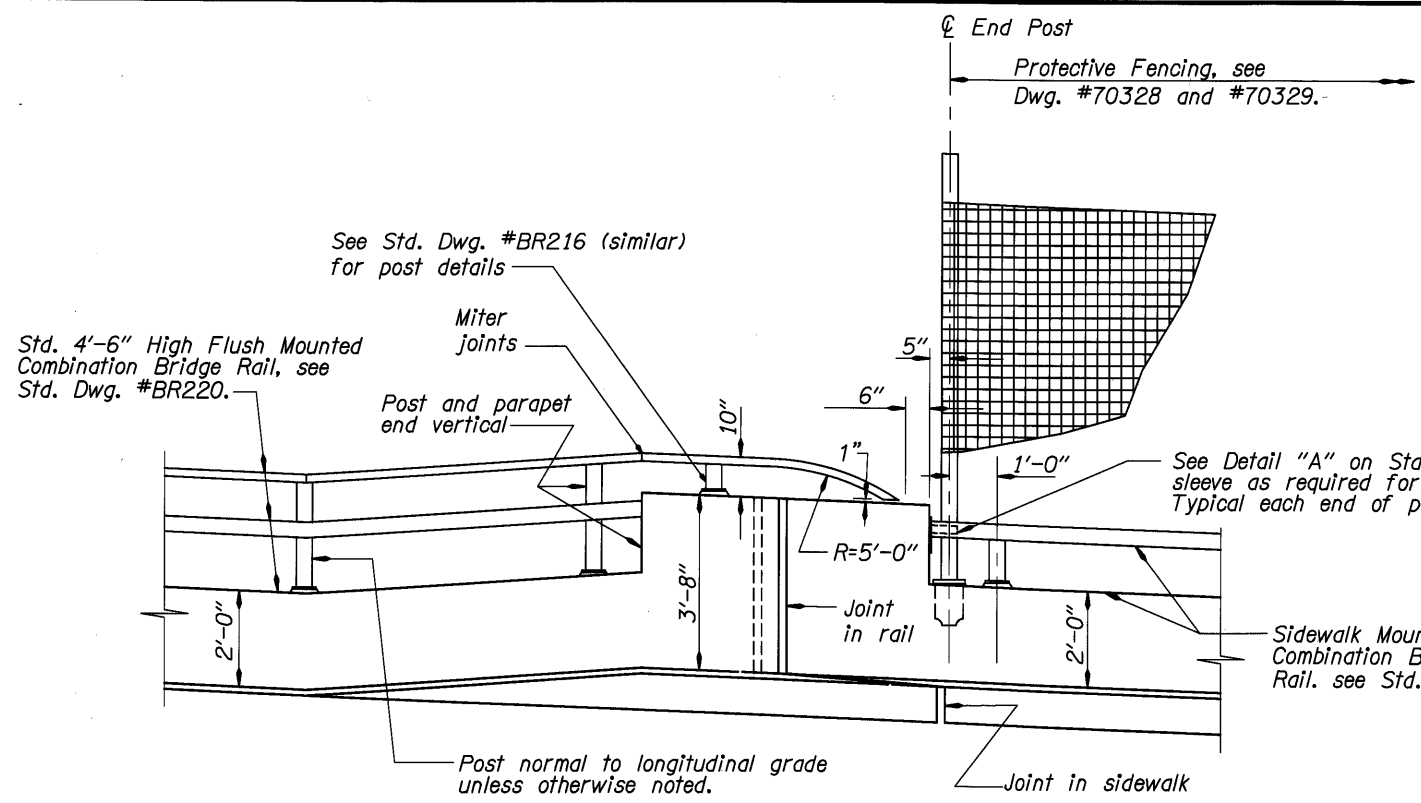


**DEVELOPED ELEVATION-LEFT SIDE**  
Scale: 1/2" = 1'-0"


- Notes:**
1. Std. 4'-6" high Flush Mounted Combination Bridge Rail, see Std. Dwg. #BR220.
  2. Std. 4'-6" high Flush Mounted Combination Bridge Rail (modified), see Std. Dwg. #BR220.
  3. For reinforcement see Section A-A on Std. Dwg. #BR220.
  4. TS3x2 Rail, see Std. Dwg. #BR220.
  5. For wingwall reinforcement and dowels, see Dwg. #70302.

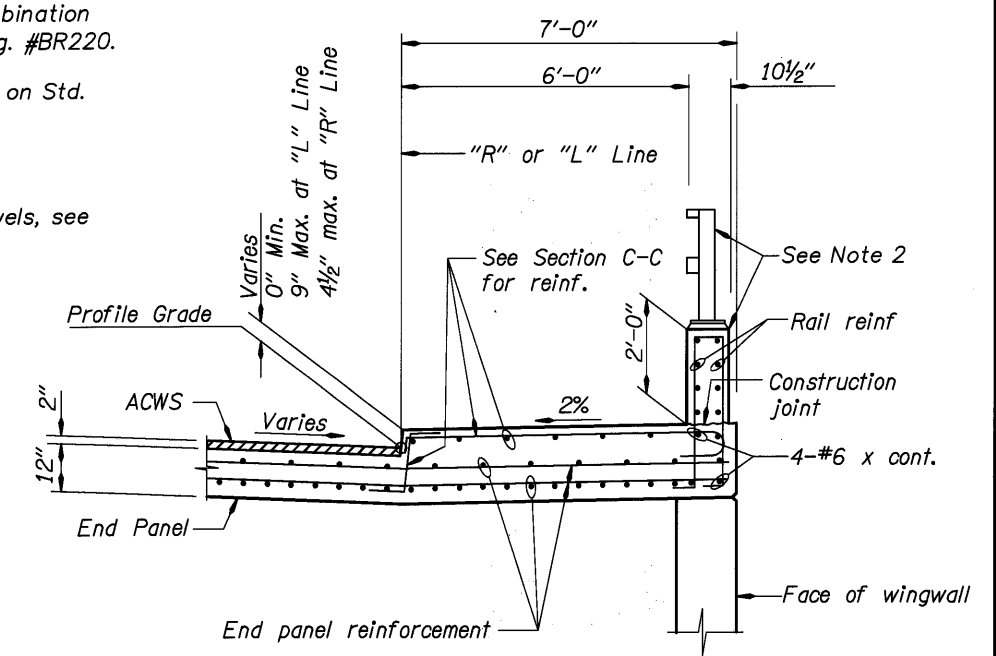


**SECTION B-B**  
Scale: 1/2" = 1'-0"

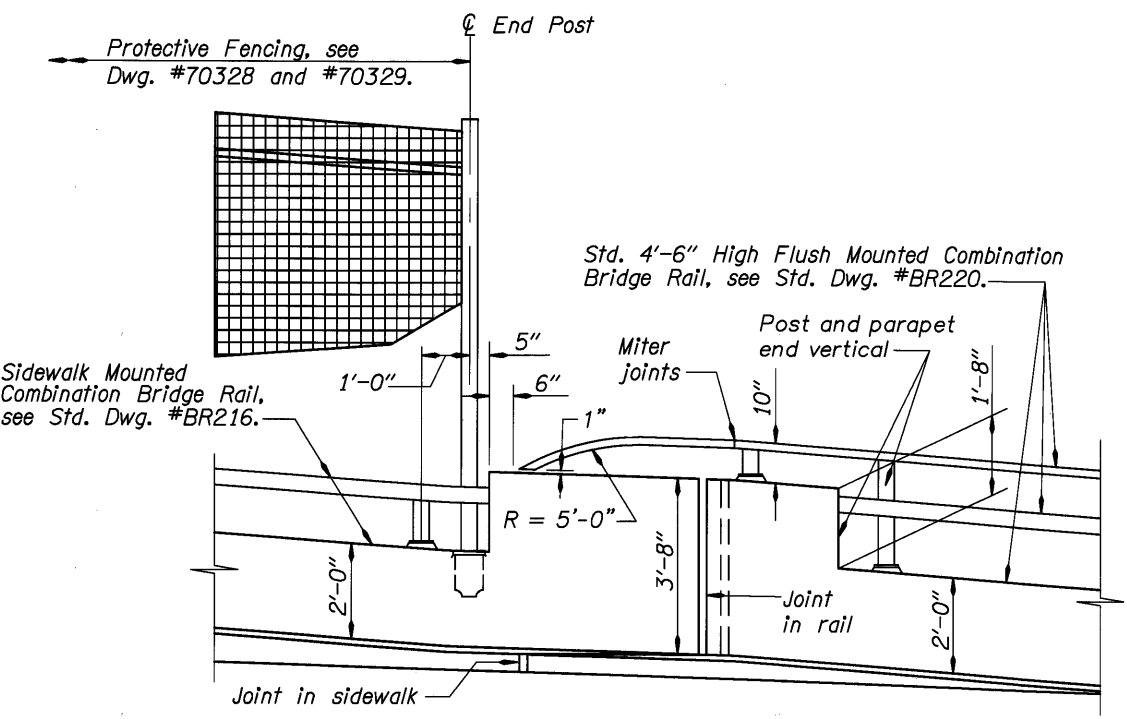

**DEVELOPED ELEVATION-RIGHT SIDE**  
Scale: 1/2" = 1'-0"

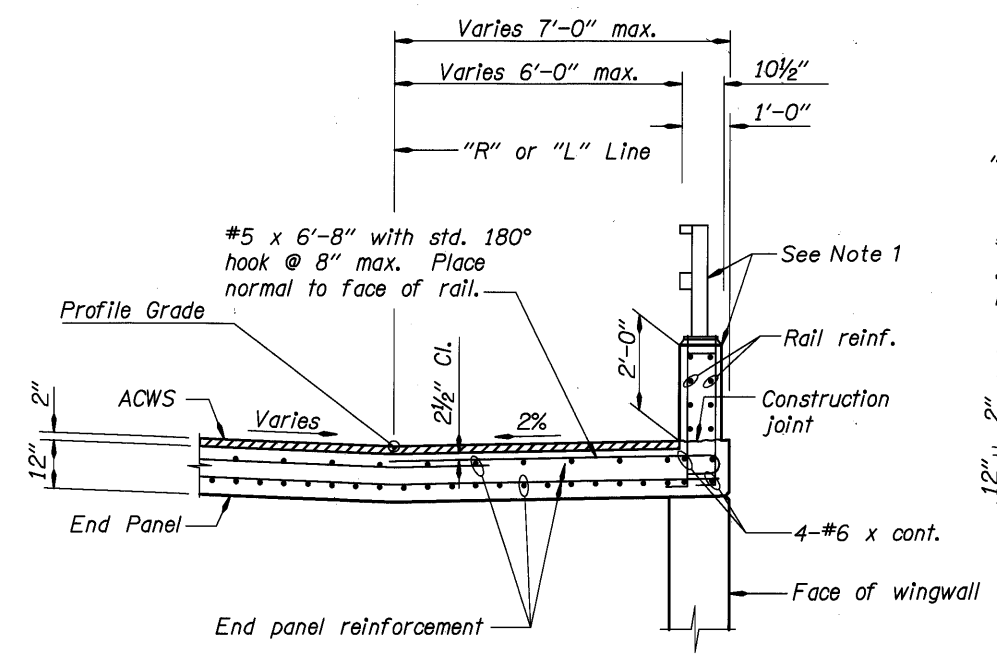


**SECTION A-A**  
Scale: 1/2" = 1'-0"

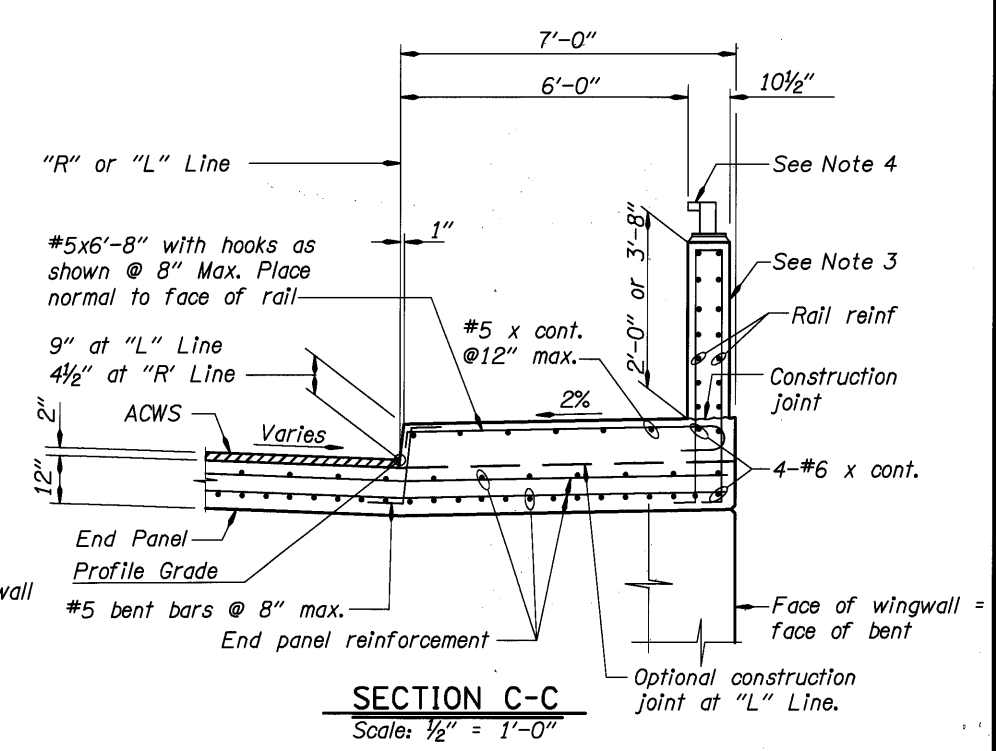

**SECTION C-C**  
Scale: 1/2" = 1'-0"

Note: For details not shown, see "Developed Elevation-Left Side".


DATE	03/09	REVISION	As-Constructed	BY	TDF	DESIGNER	Ken Johnson	BRIDGE NO.	20136	SHEET	112			
												MULTNOMAH CHANNEL & PNWR ETC., SAUVIE ISLAND RD.	OF	173.
													MULTNOMAH COUNTY BRIDGES	DRAWING NO.
						DAVID EVANS AND ASSOCIATES INC.	TRANSPORTATION DIVISION	DATE	Sept. 2005					
						530 Center Street N.E., Suite 605 Salem Oregon 97301 Phone: 503.361.8635	OREGON DEPARTMENT OF TRANSPORTATION BRIDGE ENGINEERING SECTION	CALC. BOOK						
						EXPIRES: 12-31-05								

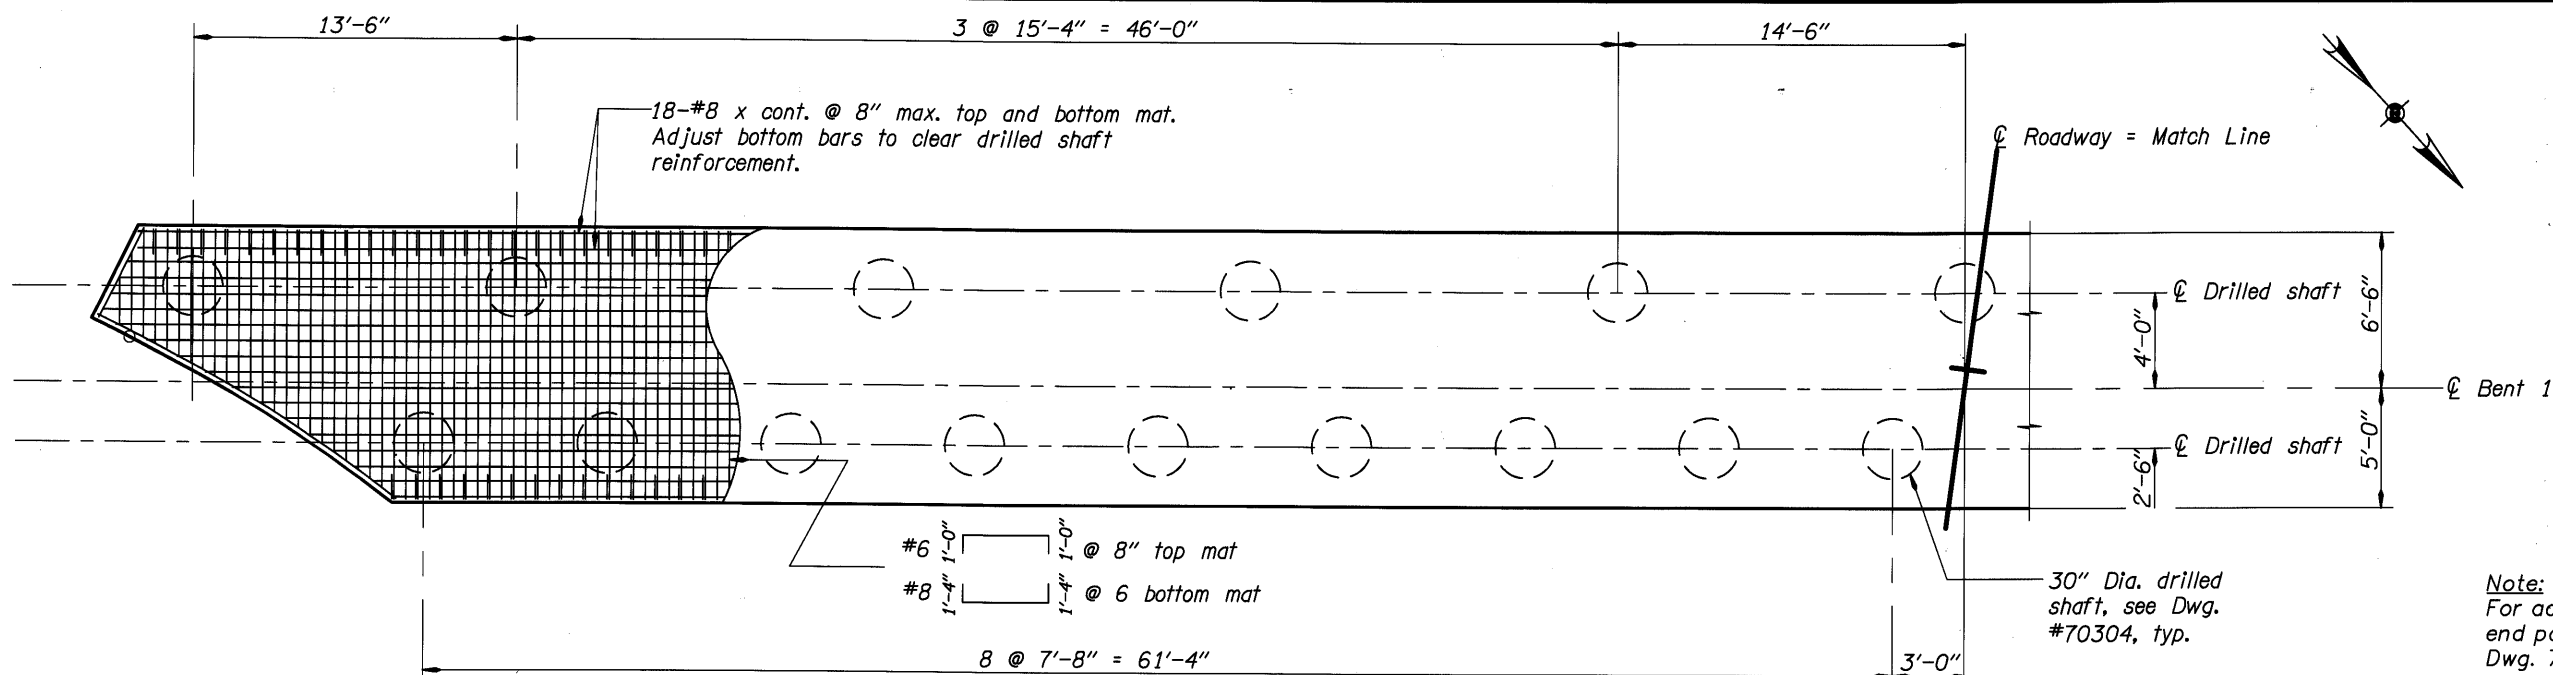

**PART PLAN- BENT 1 FOOTING**


Scale: 1/4"=1'-0"

*Note:*  
For additional bridge, concrete fill and end panel removal requirements, see Dwg. 70202.

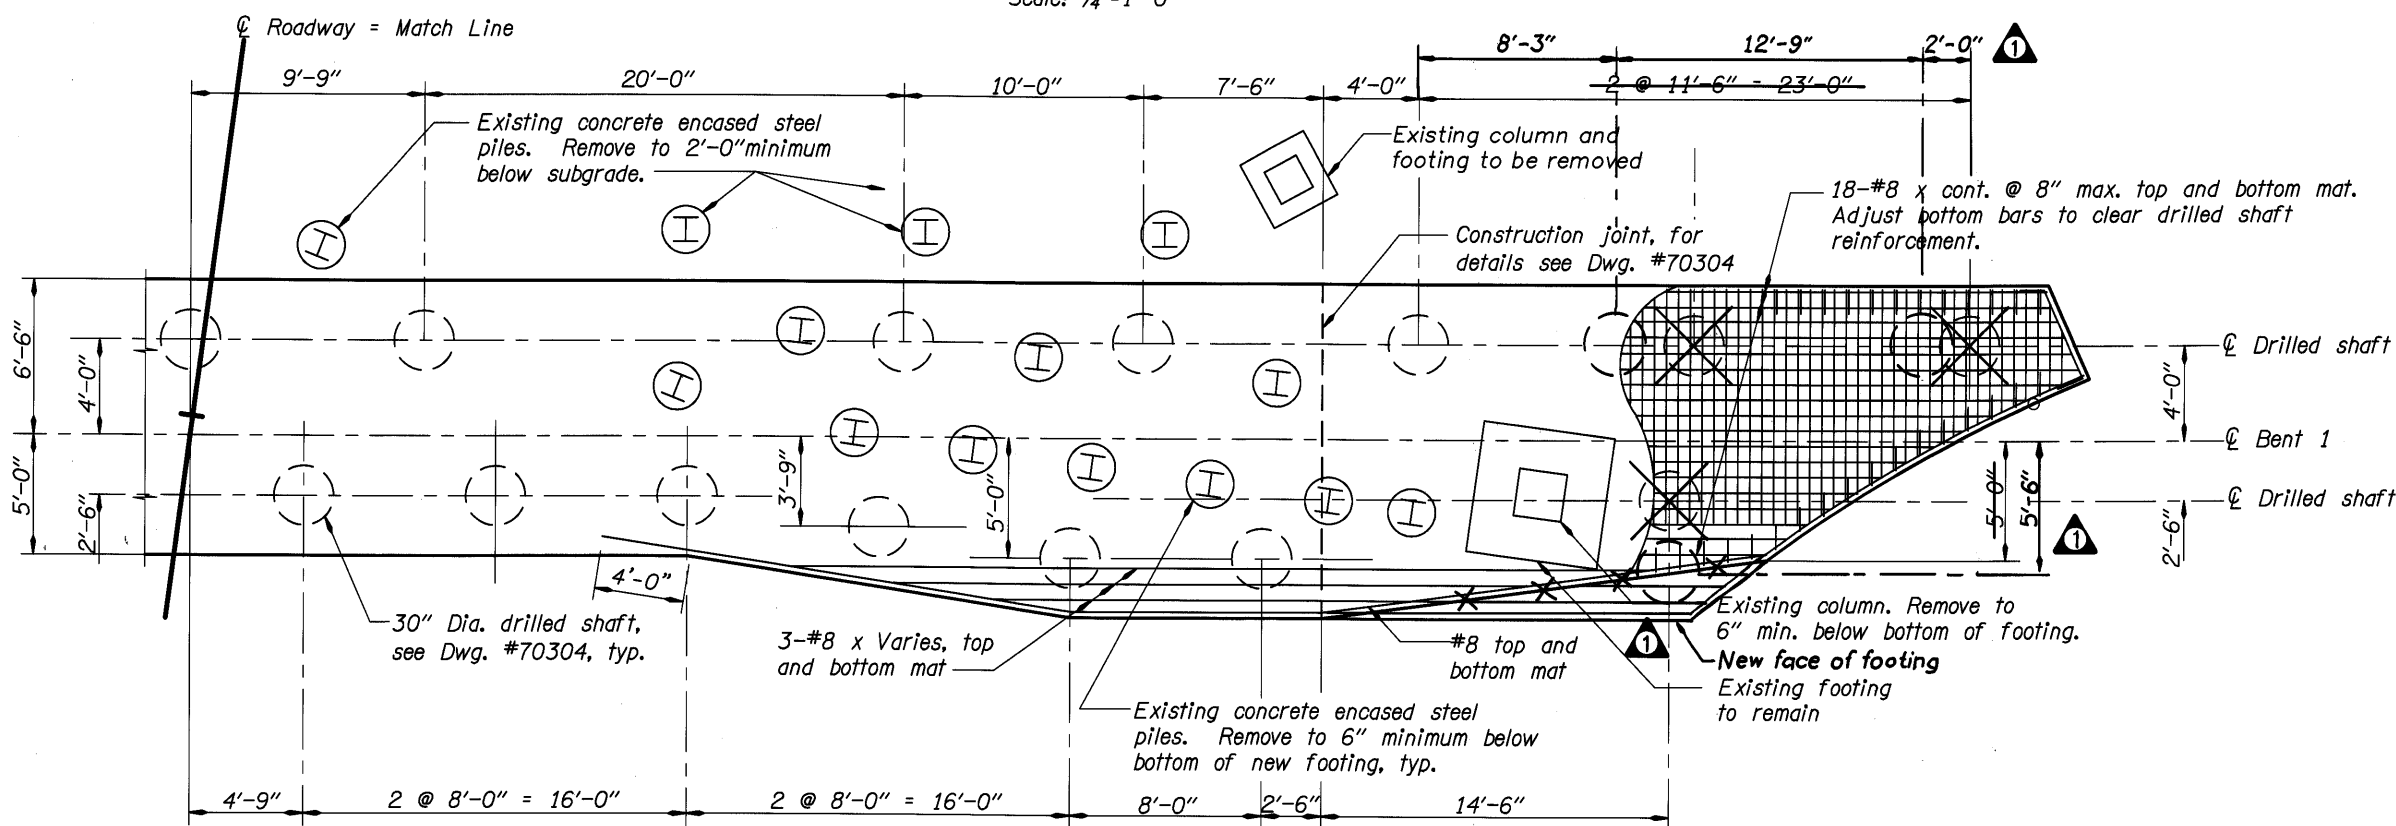

**PART PLAN- BENT 1 FOOTING**

Scale: 1/4"=1'-0"

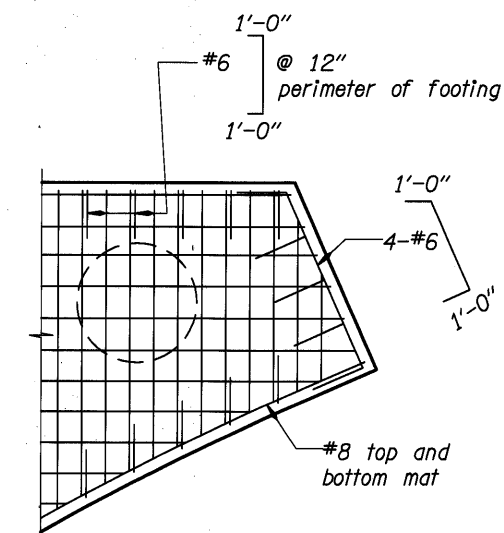


**FOOTING CORNER DETAIL**


Scale: 1/2"=1'-0"

DO NOT SCALE THIS DRAWING.  
FOLLOW DIMENSIONS. INDICATED  
SCALES CORRECT ONLY FOR  
FULL SIZE SHEET (22"x34").


DATE	REVISION	BY	DESIGNER	BRIDGE NO.	SHEET
03/09	As-Constructed	TDF	Ken Johnson	20136	113
			Josh Hewes	DATE Sept. 2005	OF 173
			Adrienne Dietrich	CALC. BOOK	DRAWING NO.
			DAVID EVANS AND ASSOCIATES INC. 530 Center Street N.E., Suite 605 Salem Oregon 97301 Phone: 503.361.8635	MULTNOMAH COUNTY BRIDGES TRANSPORTATION DIVISION	BENT 1 - FOOTING PLAN
			REGISTERED PROFESSIONAL ENGINEER 74549 PE MARCH 08, 2004 WILLIAM CORRELL	OREGON DEPARTMENT OF TRANSPORTATION BRIDGE ENGINEERING SECTION	70300

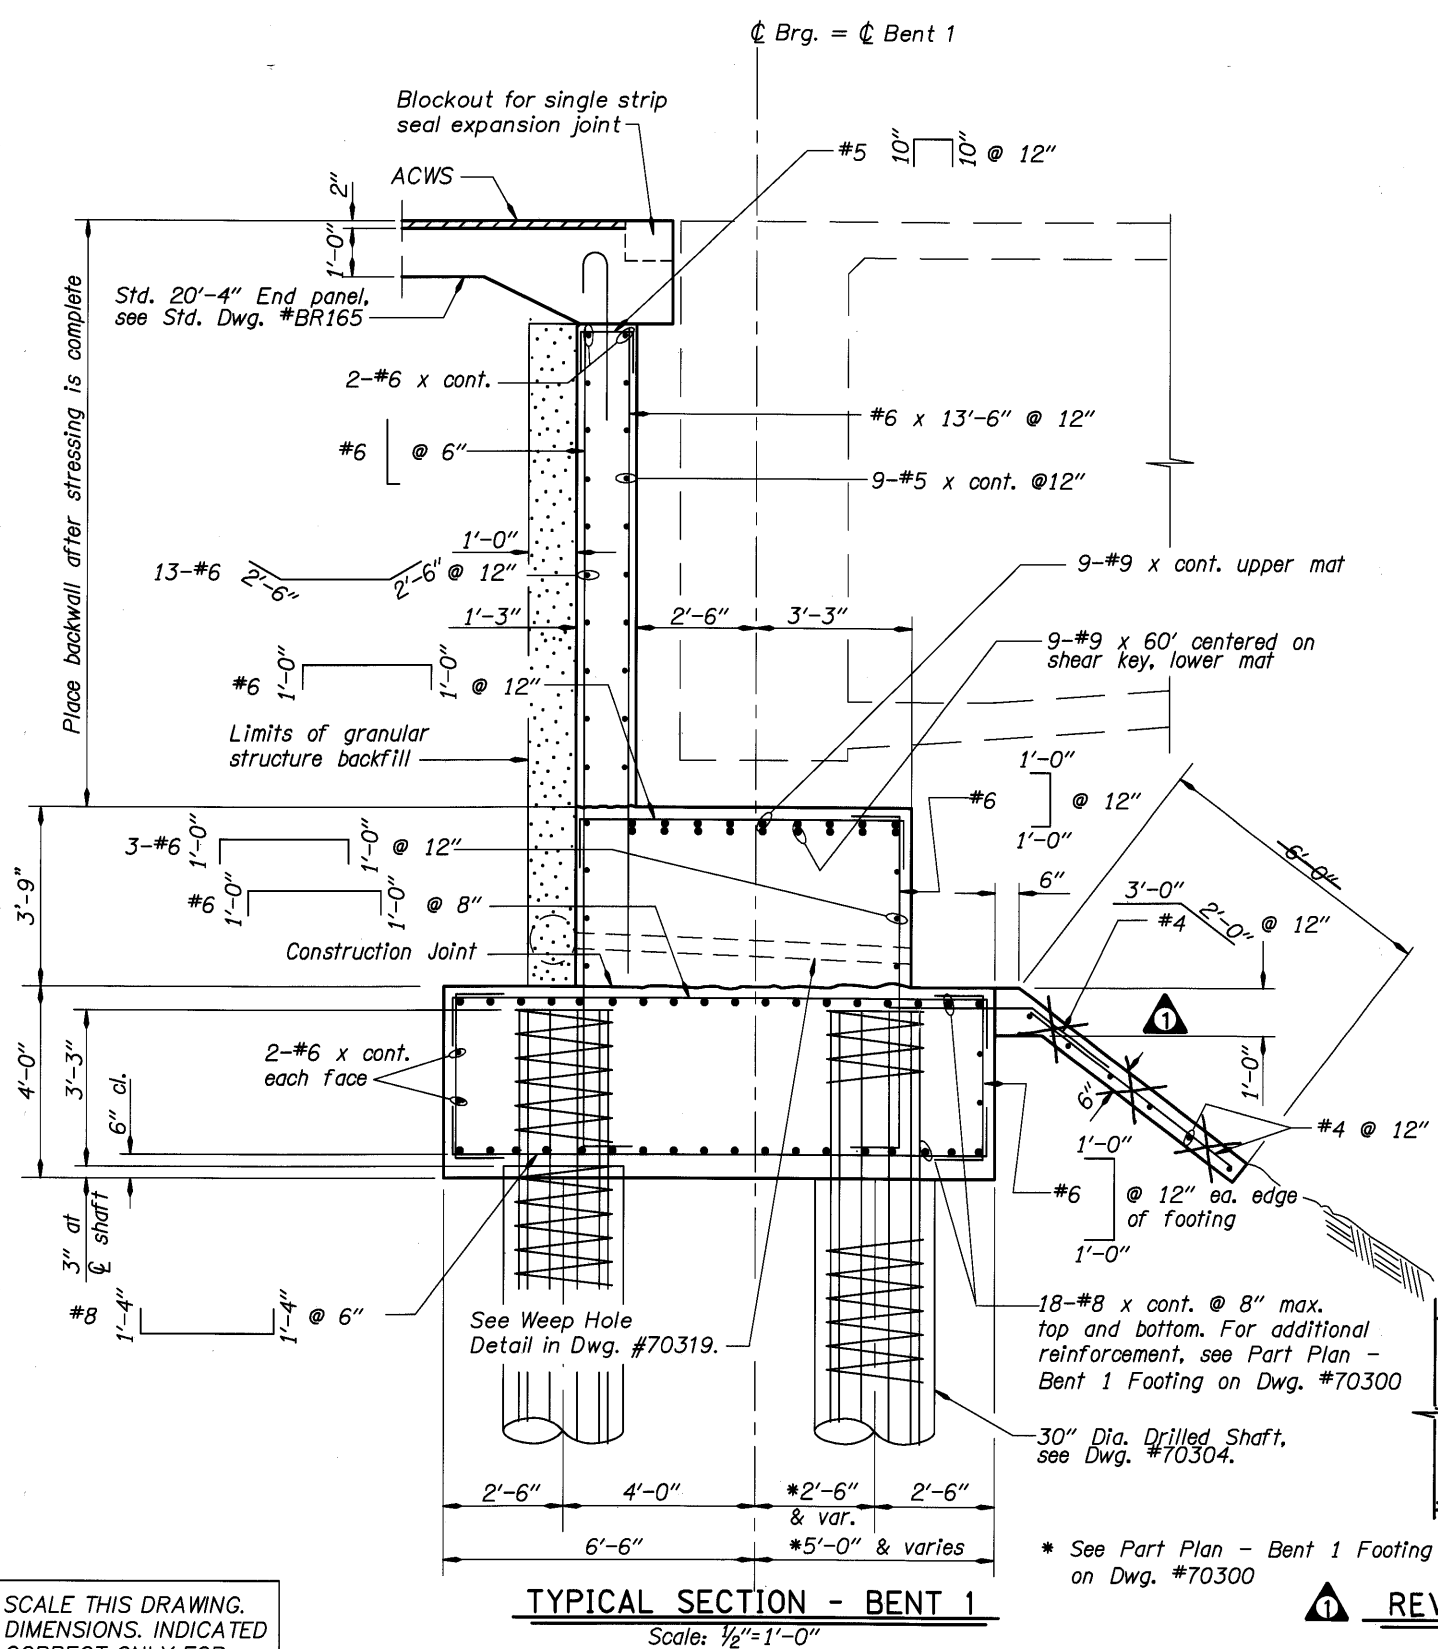

**TYPICAL SECTION - BENT 1**  
Scale: 1/2" = 1'-0"

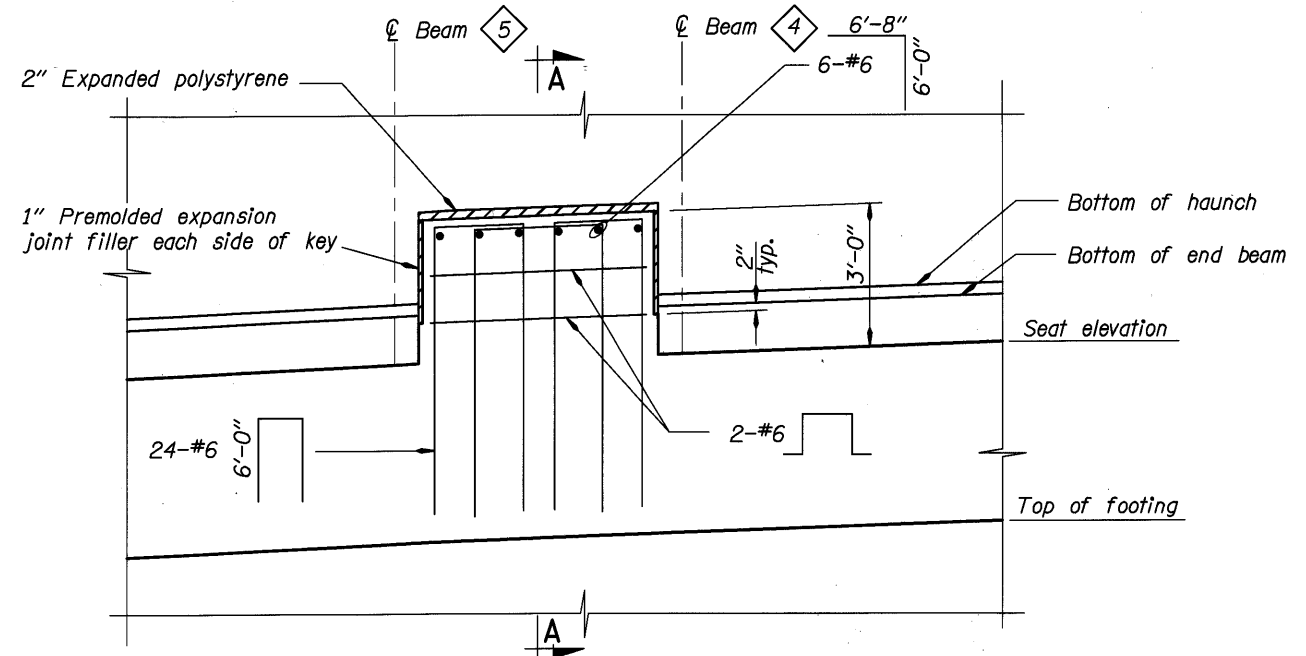

**BENT 1 SHEAR KEY DETAIL**  
Scale: 1/2" = 1'-0"

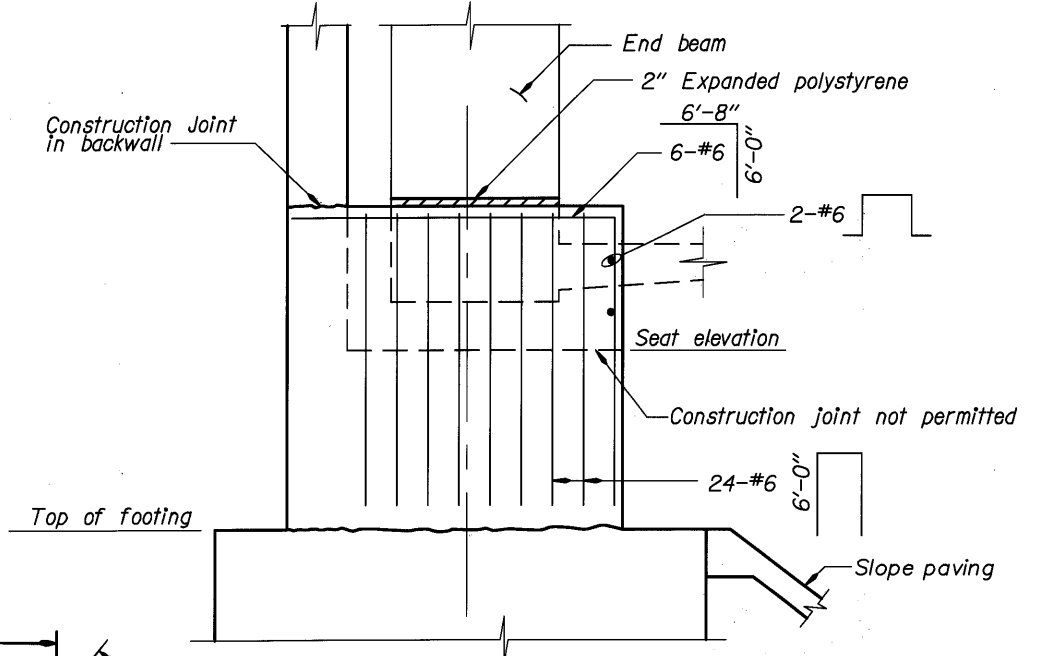


**SECTION A-A**  
Scale: 1/2" = 1'-0"

**REVISAS AS-CONSTRUCTED**  
Scale: 1/2" = 1'-0"

DO NOT SCALE THIS DRAWING. FOLLOW DIMENSIONS. INDICATED SCALES CORRECT ONLY FOR FULL SIZE SHEET (22"x34").

	DATE	REVISION	BY	DESIGNER	 <b>DAVID EVANS AND ASSOCIATES INC.</b> 530 Center Street N.E., Suite 805 Salem Oregon 97301 Phone: 503.361.8635	 <b>MULTNOMAH COUNTY BRIDGES</b> TRANSPORTATION DIVISION	BRIDGE NO. 20136	MULTNOMAH CHANNEL & PNWR ETC., SAUVIE ISLAND RD.	SHEET 114 OF 173.
	03/09	As-Constructed	TDF	Ken Johnson DRAFTED: Josh Hewes CHECKED: Adrienne Dietrich REVIEWED:					




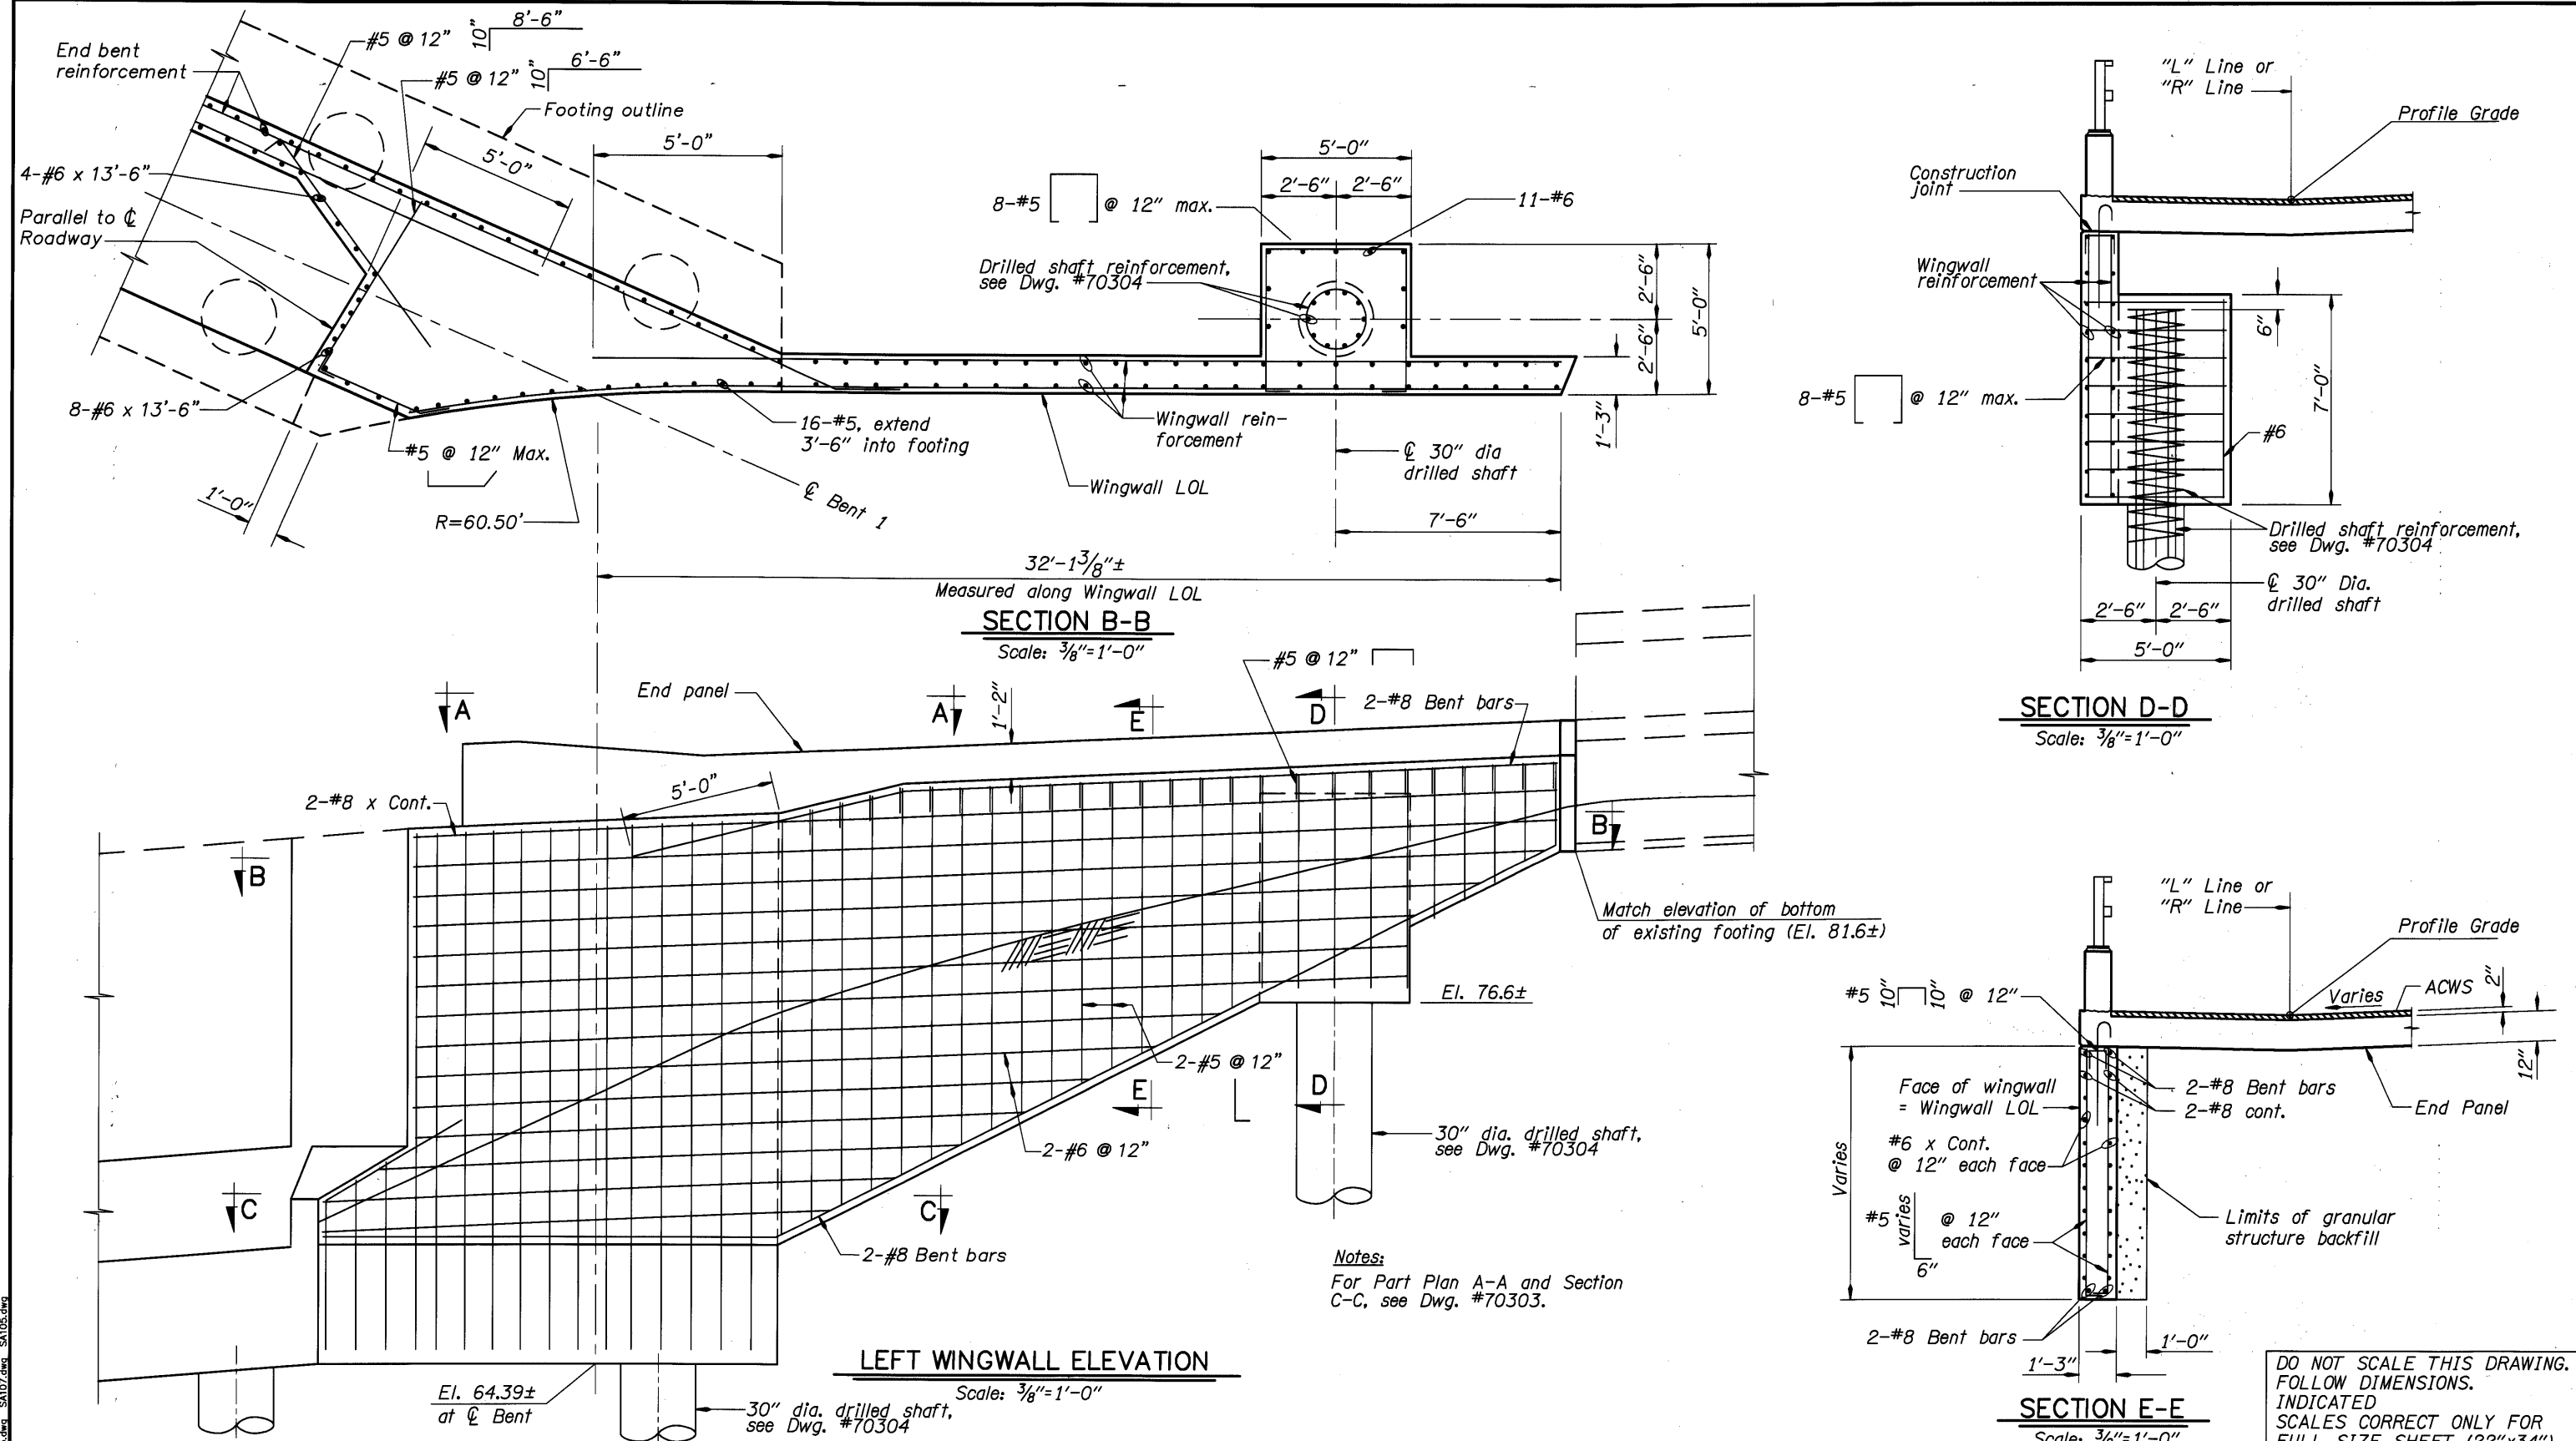

Notes:  
For Part Plan A-A and Section C-C, see Dwg. #70303.

DO NOT SCALE THIS DRAWING.  
FOLLOW DIMENSIONS.  
INDICATED  
SCALES CORRECT ONLY FOR  
FULL SIZE SHEET (22"x34").


	DATE	REVISION	BY	DESIGNER			BRIDGE NO. 20136	DATE Sept. 2005	MULTNOMAH CHANNEL & PNWR ETC., SAUVIE ISLAND RD.	SHEET 115 OF 173.				
	08/05	Revised Sections B-B & D-D	KWC	DRAFTED: Ken Johnson							TRANSPORTATION DIVISION	CALC. BOOK	BENT 1 - LEFT WINGWALL PLAN AND ELEVATION	DRAWING NO. 70302
	03/09	As-Constructed	TDF	CHECKED: Josh Hewes REVIEWED: Adrienne Dietrich										

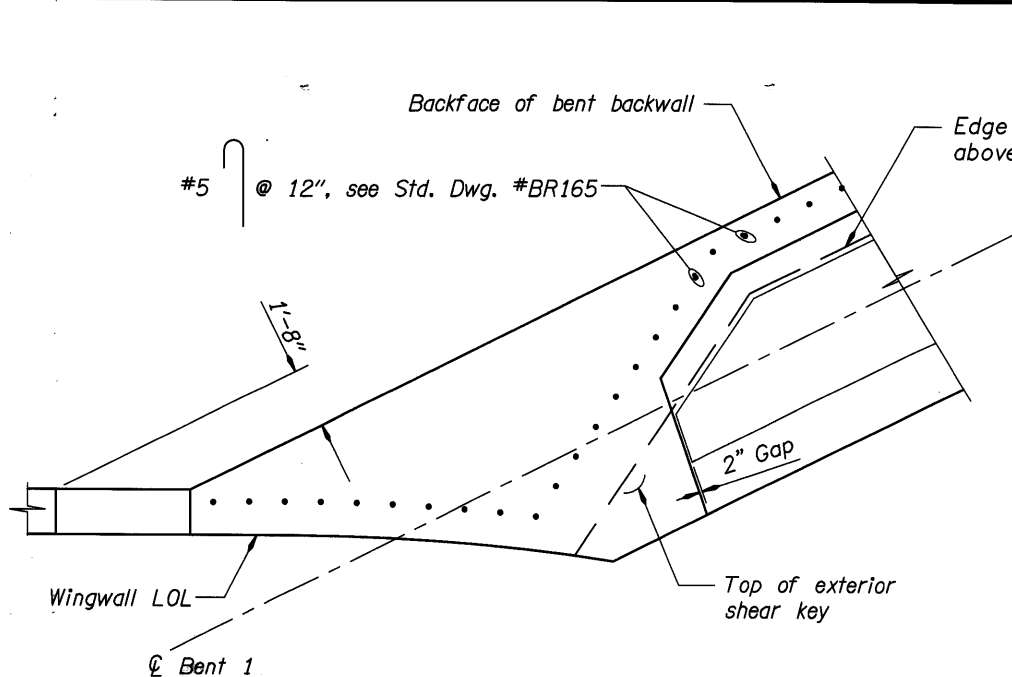

**PART PLAN A-A**


Scale: 3/8"=1'-0"

Note: View is shown with end panel not shown.

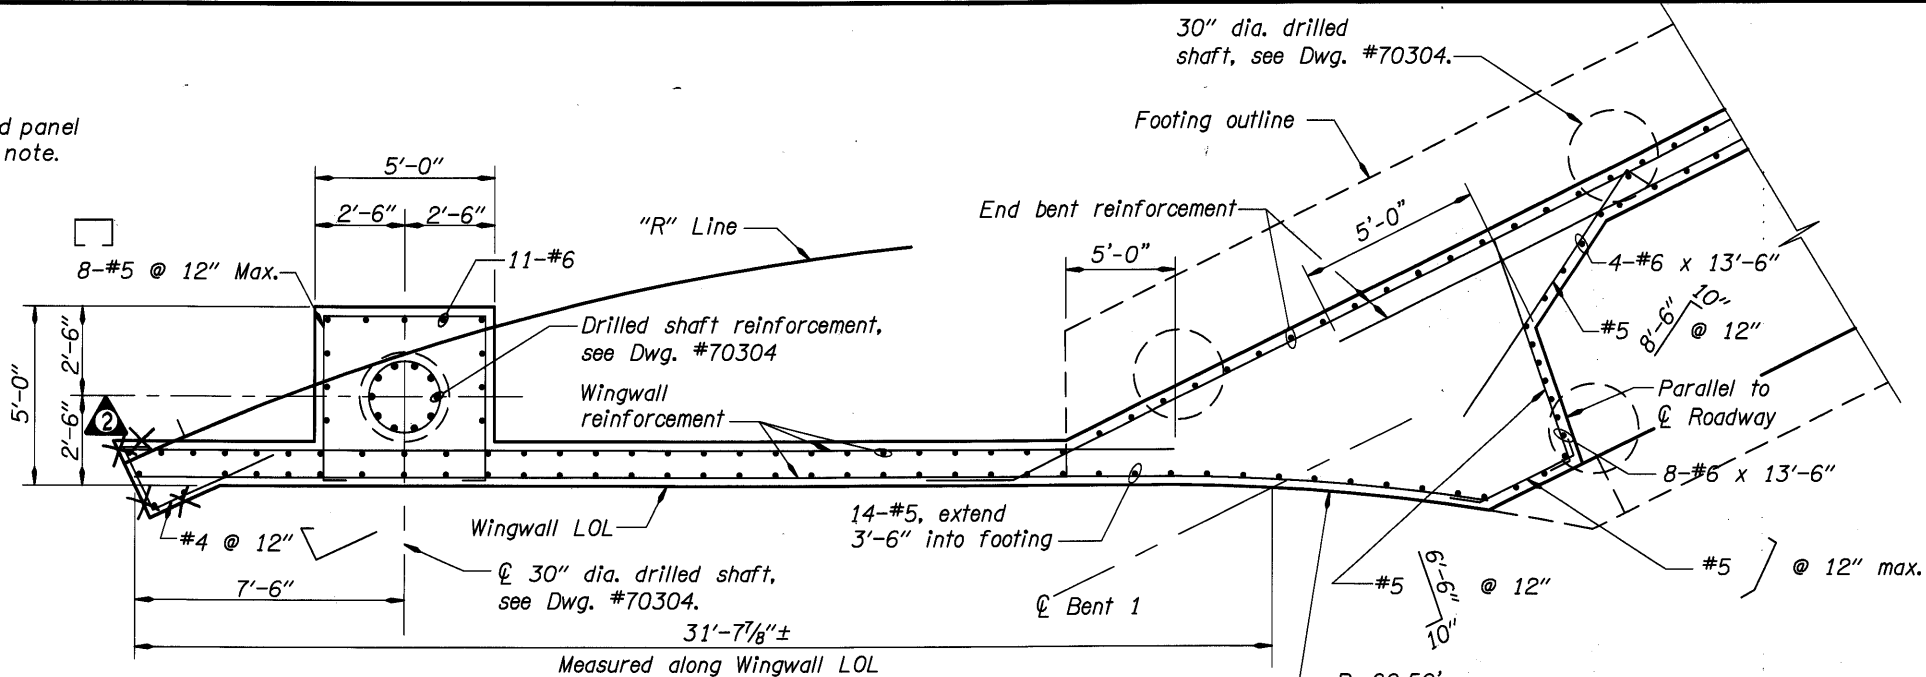


**SECTION B-B**

Scale: 3/8"=1'-0"

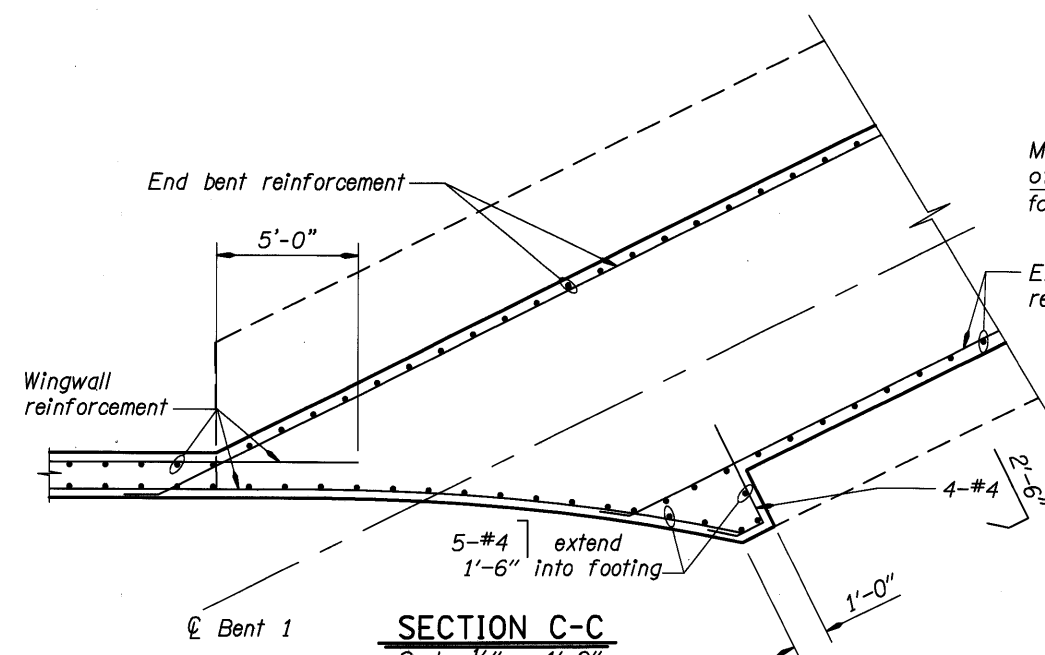

**SECTION C-C**

Scale: 1/2"=1'-0"

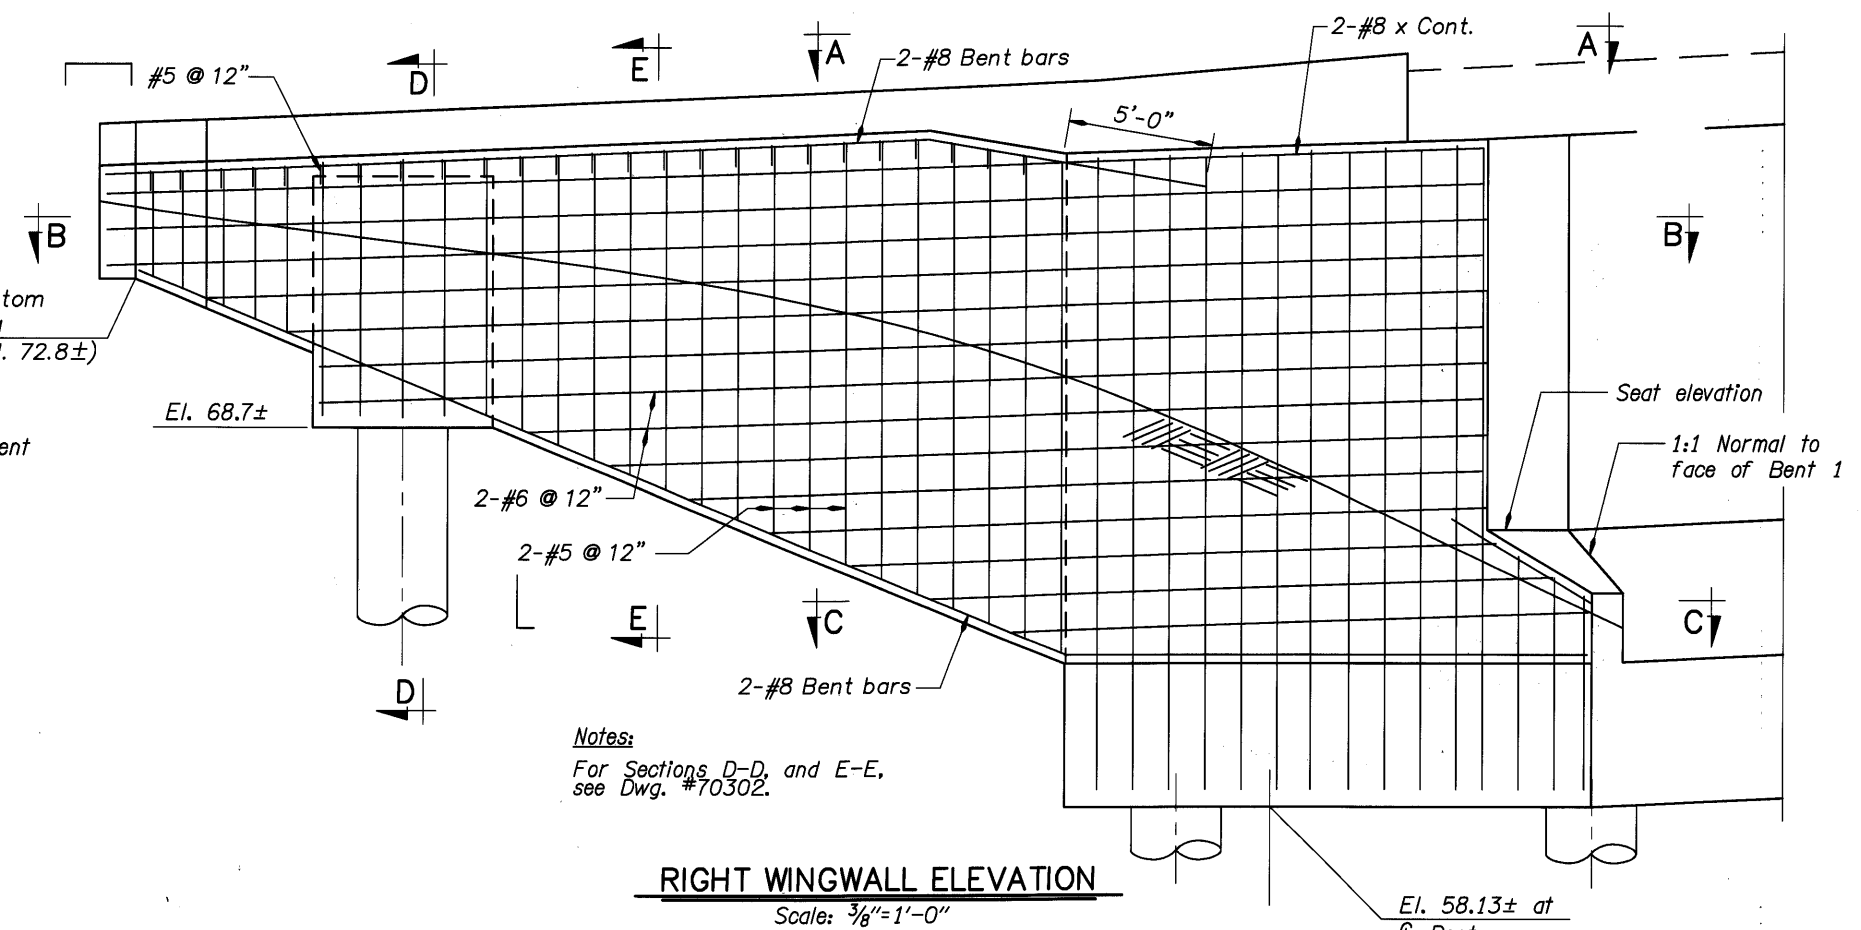


**RIGHT WINGWALL ELEVATION**

Scale: 3/8"=1'-0"

DO NOT SCALE THIS DRAWING. FOLLOW DIMENSIONS. INDICATED SCALES CORRECT ONLY FOR FULL SIZE SHEET (22"x34").

	DATE	REVISION	BY	DESIGNER				TRANSPORTATION DIVISION OREGON DEPARTMENT OF TRANSPORTATION BRIDGE ENGINEERING SECTION	BRIDGE NO.	MULTNOMAH CHANNEL & PNWR ETC., SAUVIE ISLAND RD.	SHEET
	08/05	Revised Sections B-B & C-C	KWC	DRAFTED: Ken Johnson					20136		116
	03/09	As-Constructed	TDF	CHECKED: Josh Hewes					DATE		OF
				REVIEWED: Adrienne Dietrich	EXPIRES: 12-31-05	530 Center Street N.E., Suite 605 Salem Oregon 97301 Phone: 503.361.8635		Sept. 2005 CALC. BOOK	BENT 1 - RIGHT WINGWALL PLAN & ELEVATION	173. DRAWING NO. 70303	



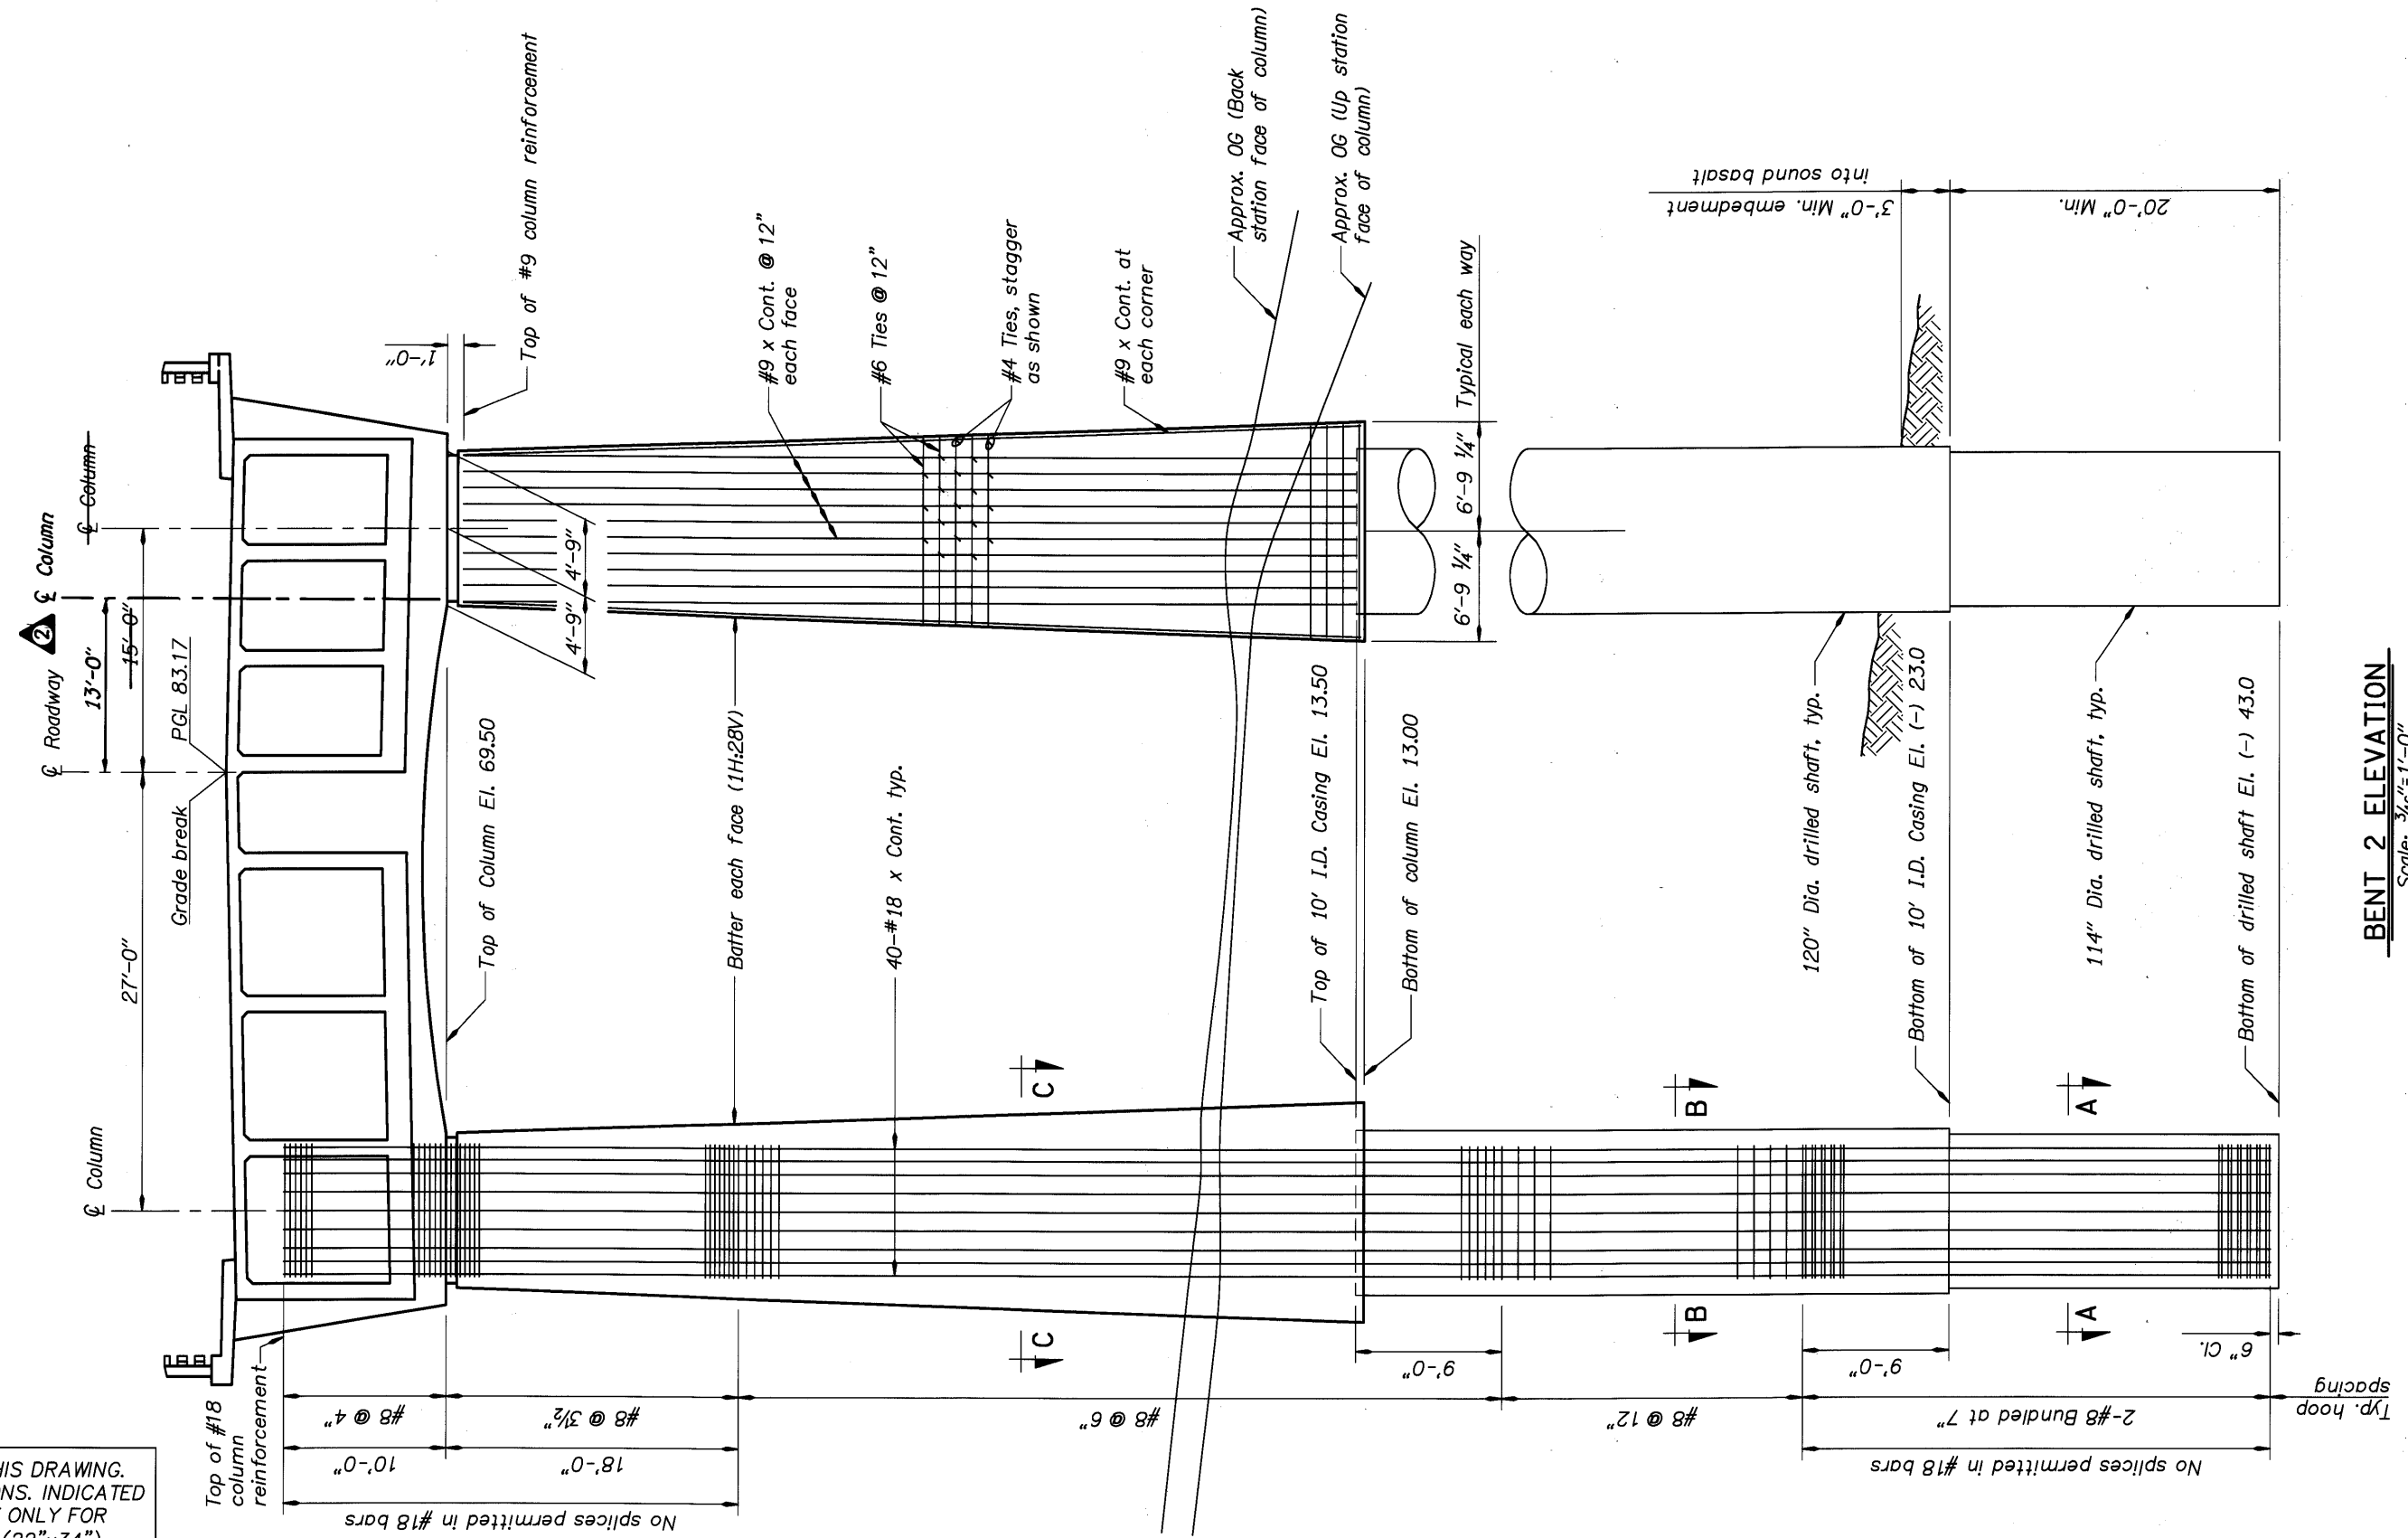


DO NOT SCALE THIS DRAWING. FOLLOW DIMENSIONS. INDICATED SCALES CORRECT ONLY FOR FULL SIZE SHEET (22"x34").


**BENT 2 ELEVATION**  
 Scale: 3/16"=1'-0"

Note: For Sections A-A, B-B, and C-C, see Dwg. #70317


	DATE	REVISION	BY	DESIGNER			TRANSPORTATION DIVISION BRIDGE NO. 20136 DATE Sept. 2005 CALC. BOOK	MULTNOMAH CHANNEL & PNWR ETC., SAUVIE ISLAND RD. BENT 2 - COLUMN AND DRILLED SHAFT	SHEET 118 OF 173 DRAWING NO. 70305
	08/05	Revised Columns	KWC	DRAFTED: Ken Johnson					
	03/09	As-Constructed	TDF	CHECKED: Josh Hewes REVIEWED: Steve Thoman					
DESIGNER:  DAVID EVANS AND ASSOCIATES INC. 530 Center Street N.E., Suite 605 Salem Oregon 97301 Phone: 503.361.8635									

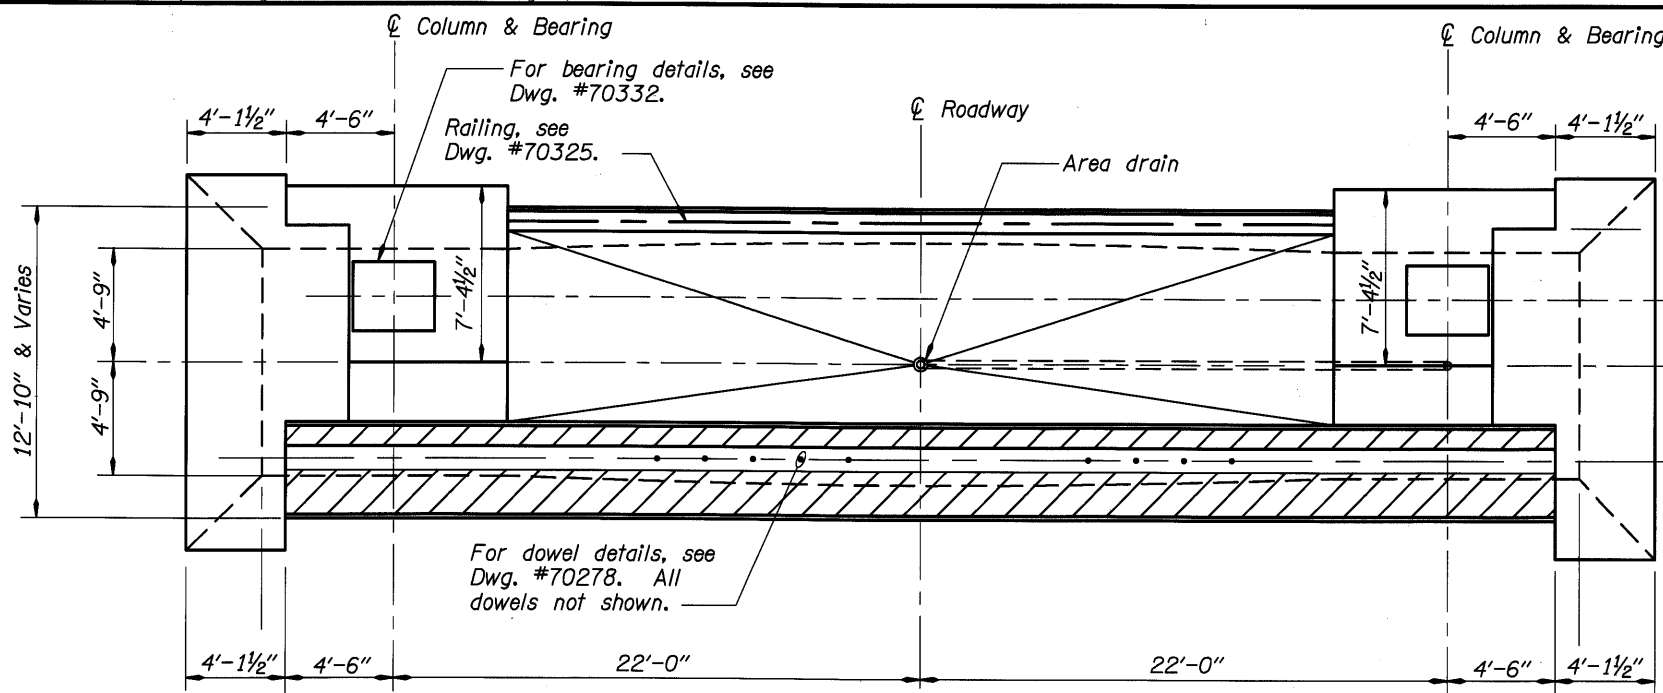

**PLAN**  
Scale: 1/4" = 1'-0"  
55'-0" Out to Out

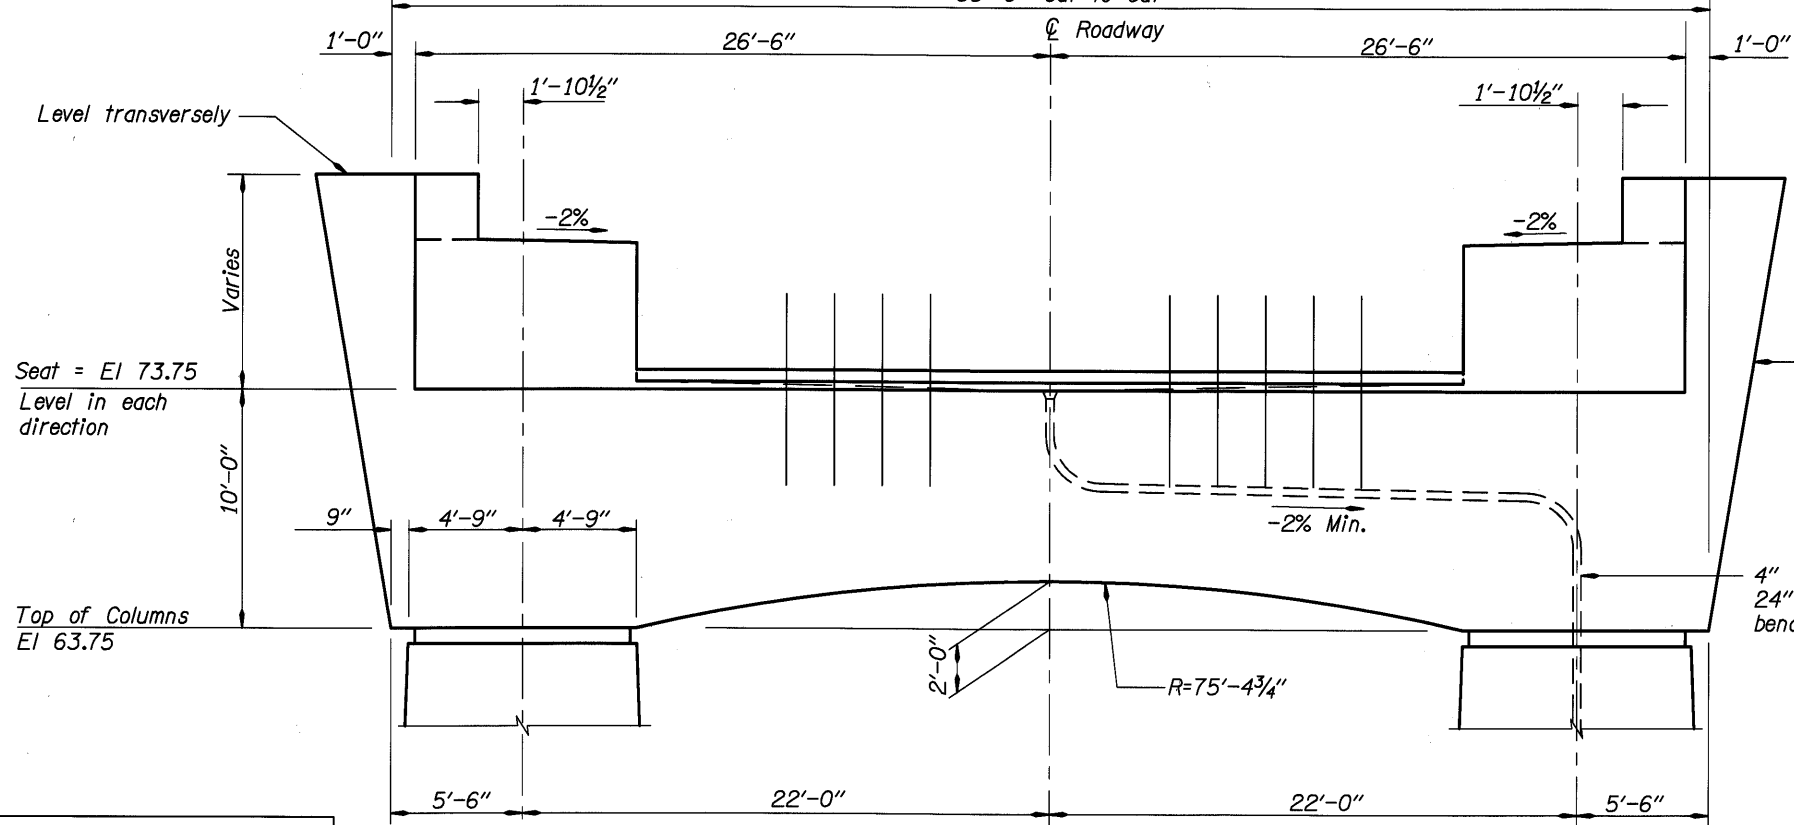

**ELEVATION**  
Scale: 1/4" = 1'-0"

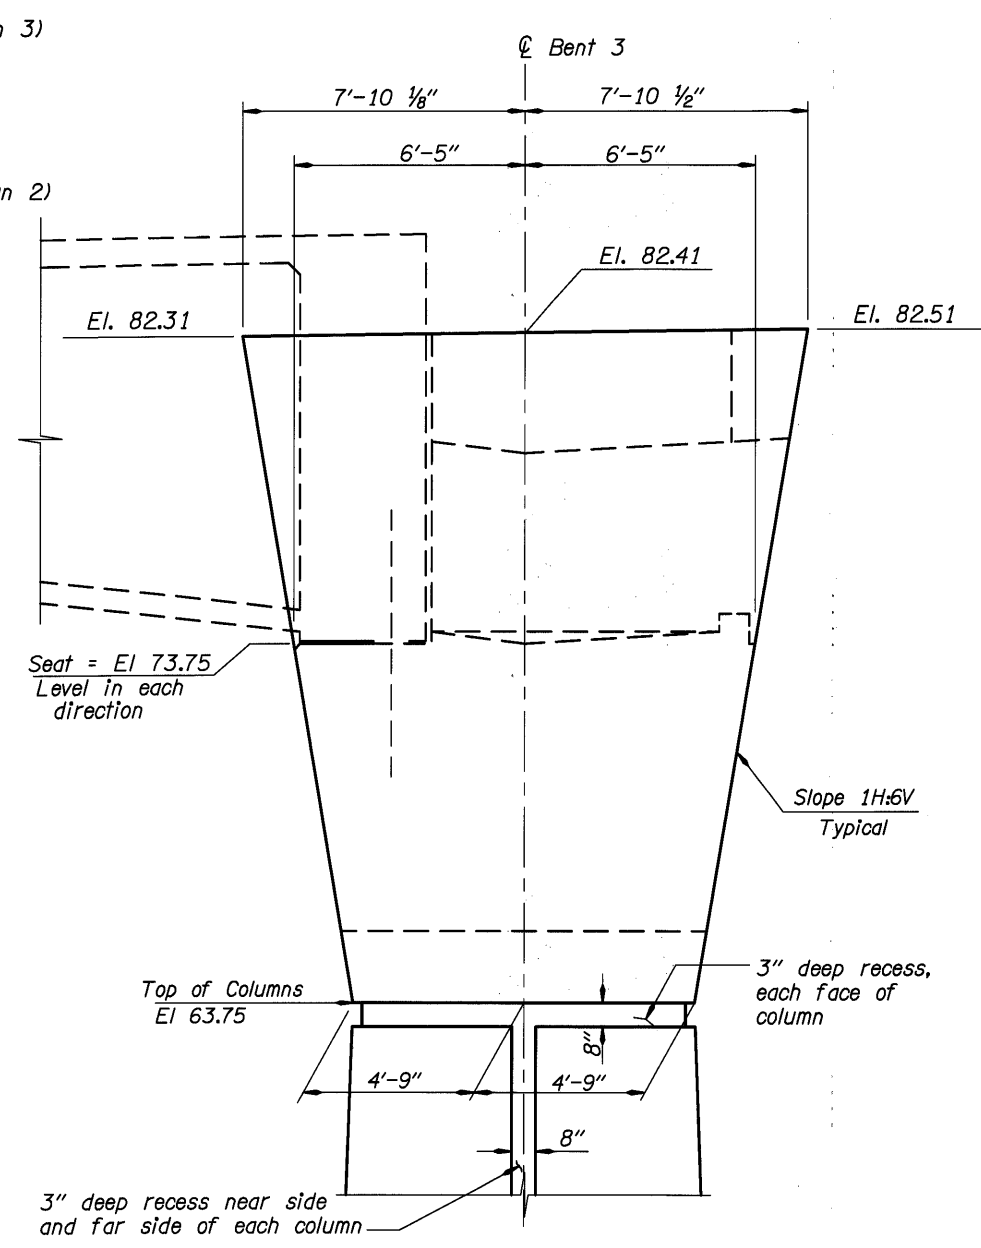

**RIGHT SIDE ELEVATION**  
Scale: 3/8" = 1'-0"

DO NOT SCALE THIS DRAWING. FOLLOW DIMENSIONS. INDICATED SCALES CORRECT ONLY FOR FULL SIZE SHEET (22"x34").

DATE	REVISION	BY
08/05	Revised Columns	KWC
03/09	As-Constructed	TDF


DESIGNED BY: Ken Johnson  
 DRAFTED BY: Josh Hewes  
 CHECKED BY: Adrienne Dietrich  
 REVIEWED BY:

**DESIGNER**  
 REGISTERED PROFESSIONAL ENGINEER  
 74549 PE  
 OREGON  
 MARCH 09, 2004  
 KENT WILLIAM CORRY  
 EXPIRES: 12-31-05

**DAVID EVANS AND ASSOCIATES INC.**  
 530 Center Street N.E., Suite 605  
 Salem Oregon 97301  
 Phone: 503.361.8635

CONNECTING COMMERCE AND COMMUNITY  
**MULTNOMAH COUNTY BRIDGES**  
 TRANSPORTATION DIVISION  
**OREGON DEPARTMENT OF TRANSPORTATION BRIDGE ENGINEERING SECTION**

<b>BRIDGE NO.</b> 20136	<b>MULTNOMAH CHANNEL &amp; PNWR ETC., SAUVIE ISLAND RD.</b>	<b>SHEET 119 OF 173</b>
<b>DATE</b> Sept. 2005		
<b>CALC. BOOK</b>		
<b>BENT 3 - X-BEAM PLAN AND ELEVATION</b>		<b>DRAWING NO. 70306</b>

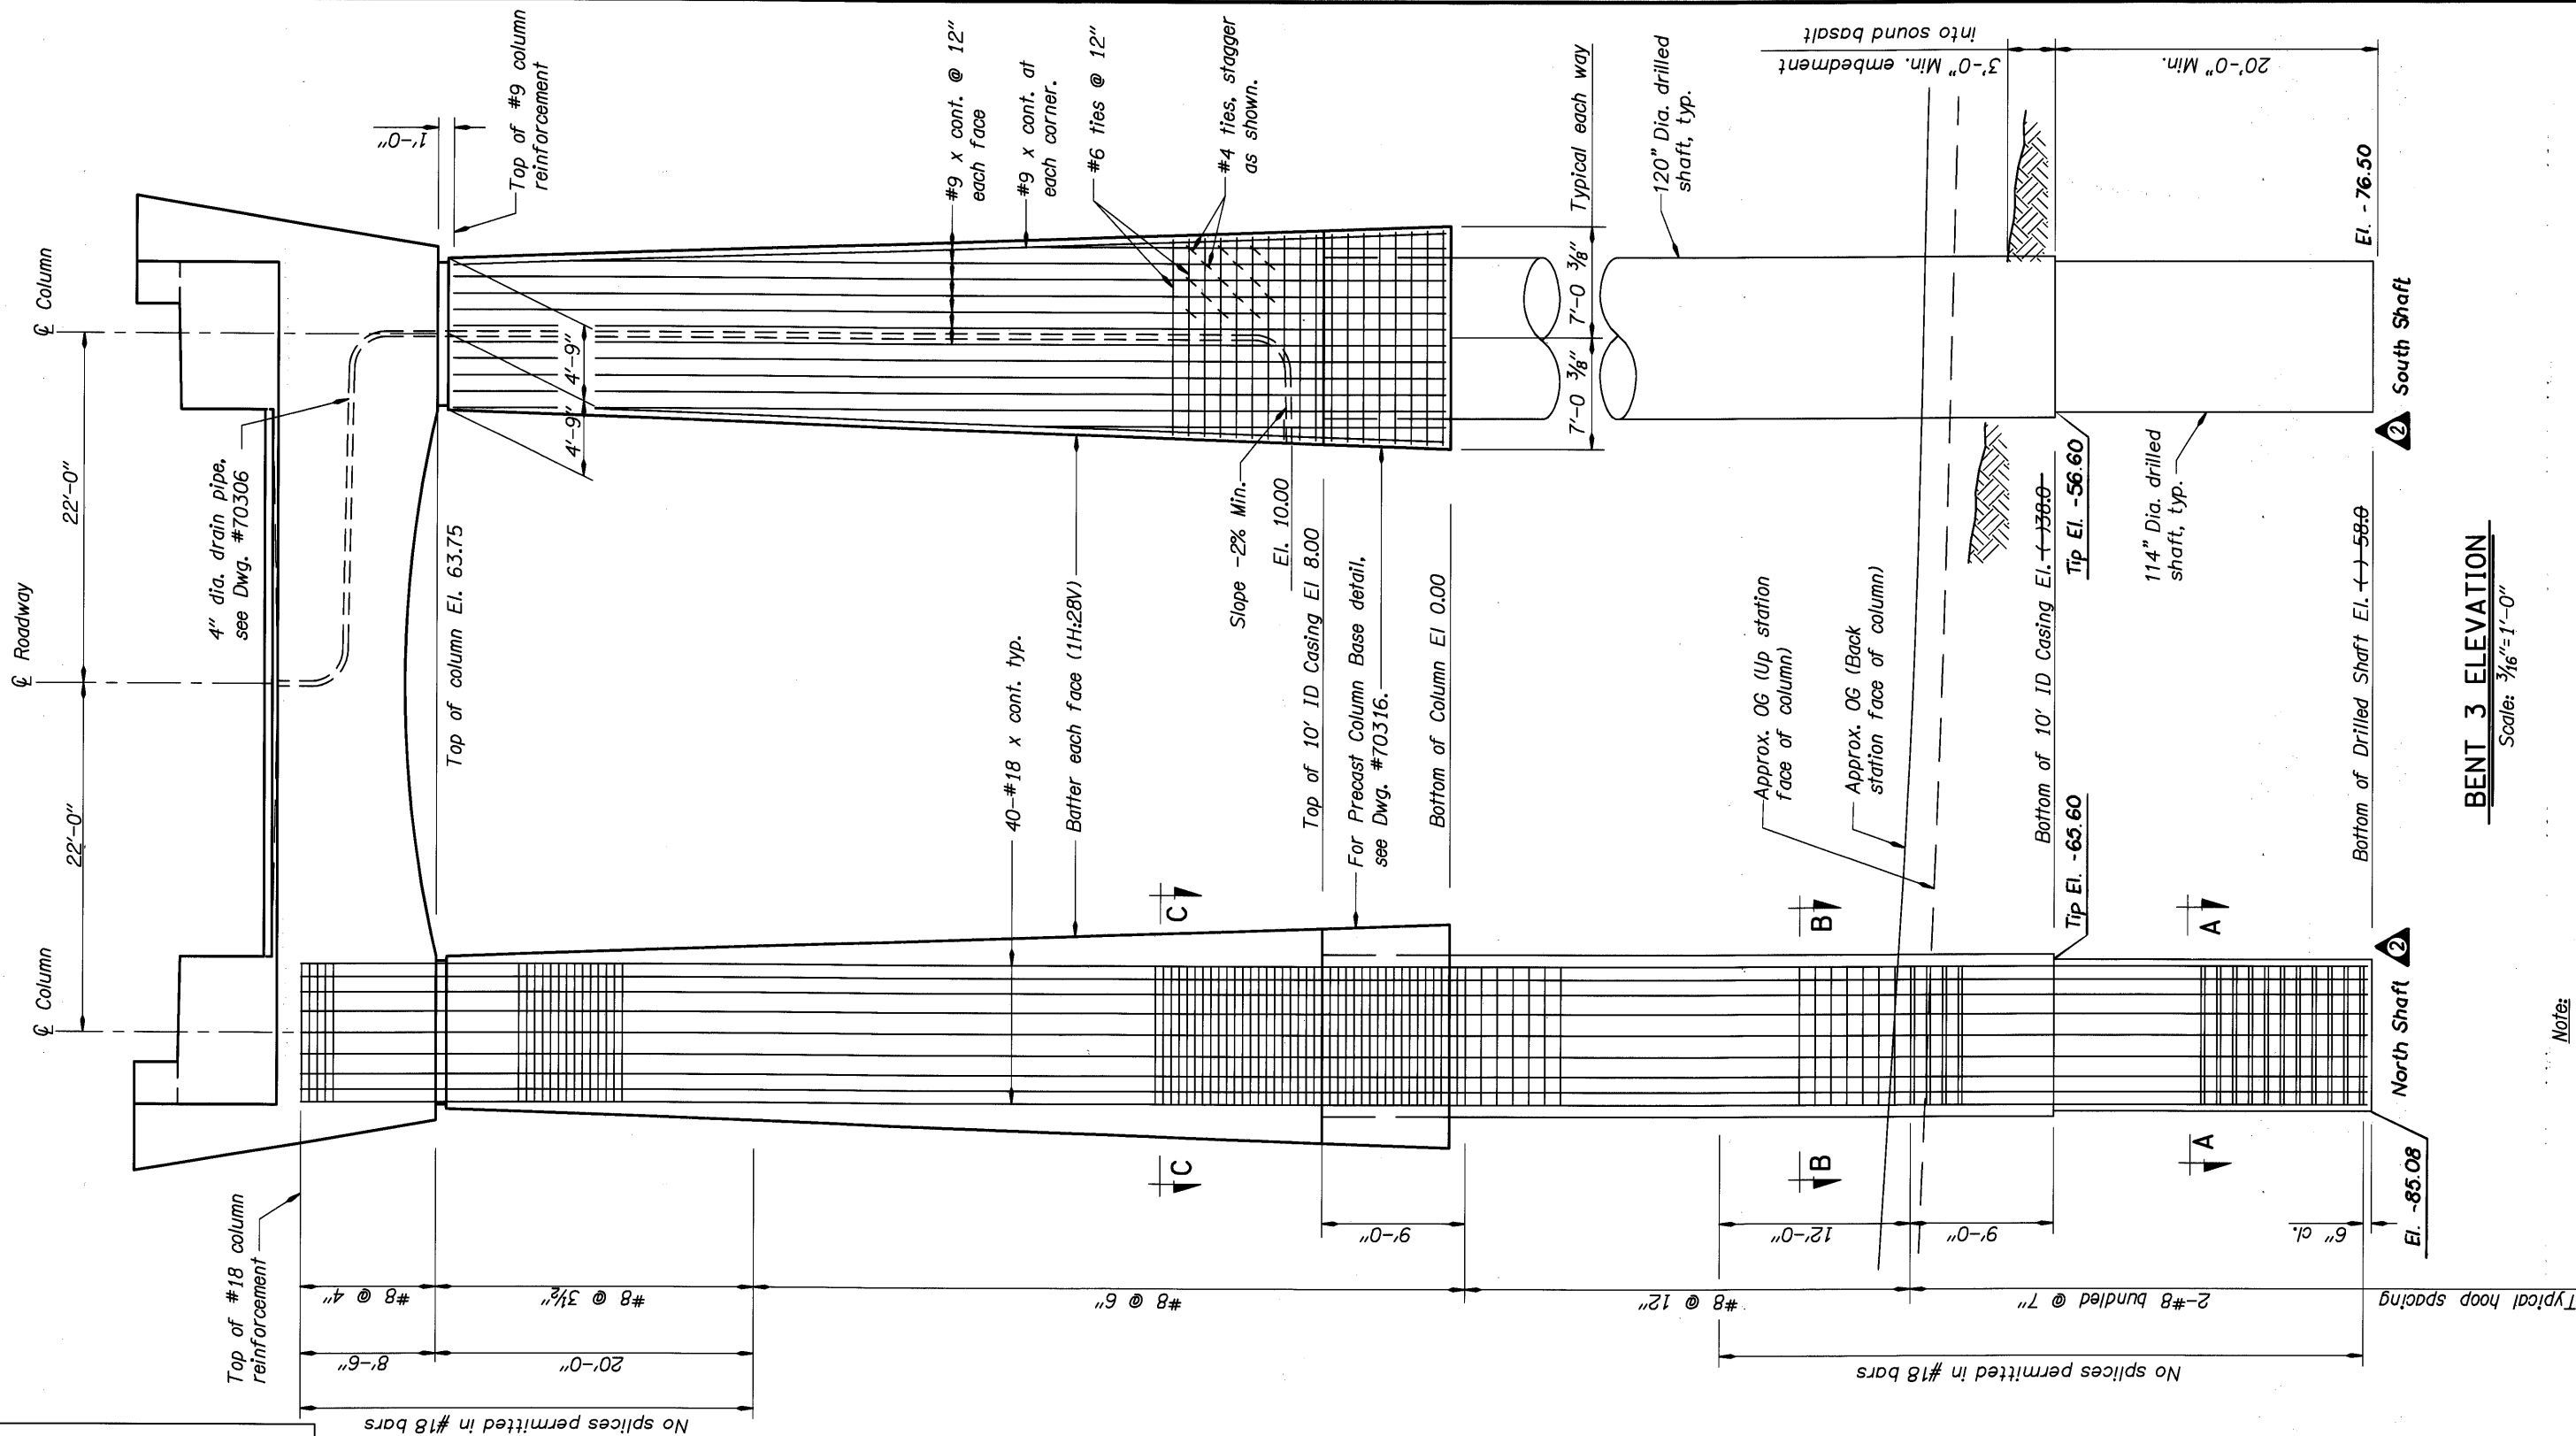


**BENT 3 ELEVATION**  
Scale: 3/16"=1'-0"

- Notes:
1. For Column and Drilled Shaft staging details see Dwg. #70315.
  2. For Sections A-A, B-B, and C-C, see Dwg. #70317.

DO NOT SCALE THIS DRAWING.  
FOLLOW DIMENSIONS. INDICATED  
SCALES CORRECT ONLY FOR  
FULL SIZE SHEET (22"x34").

DATE 08/05 03/09	REVISION Revised Columns As-Constructed	BY KWC TDF	DRAFTED: Ken Johnson	DESIGNER DAVID EVANS AND ASSOCIATES INC. 530 Center Street N.E., Suite 605 Salem Oregon 97301 Phone: 503.361.8635	BRIDGE NO. 20136	MULTNOMAH CHANNEL & PNWR ETC., SAUVIE ISLAND RD.	SHEET 120 OF 173		
			CHECKED: Josh Hewes					TRANSPORTATION DIVISION OREGON DEPARTMENT OF TRANSPORTATION BRIDGE ENGINEERING SECTION	DATE Sept. 2005
			REVIEWED: Steve Thoman						CALC. BOOK

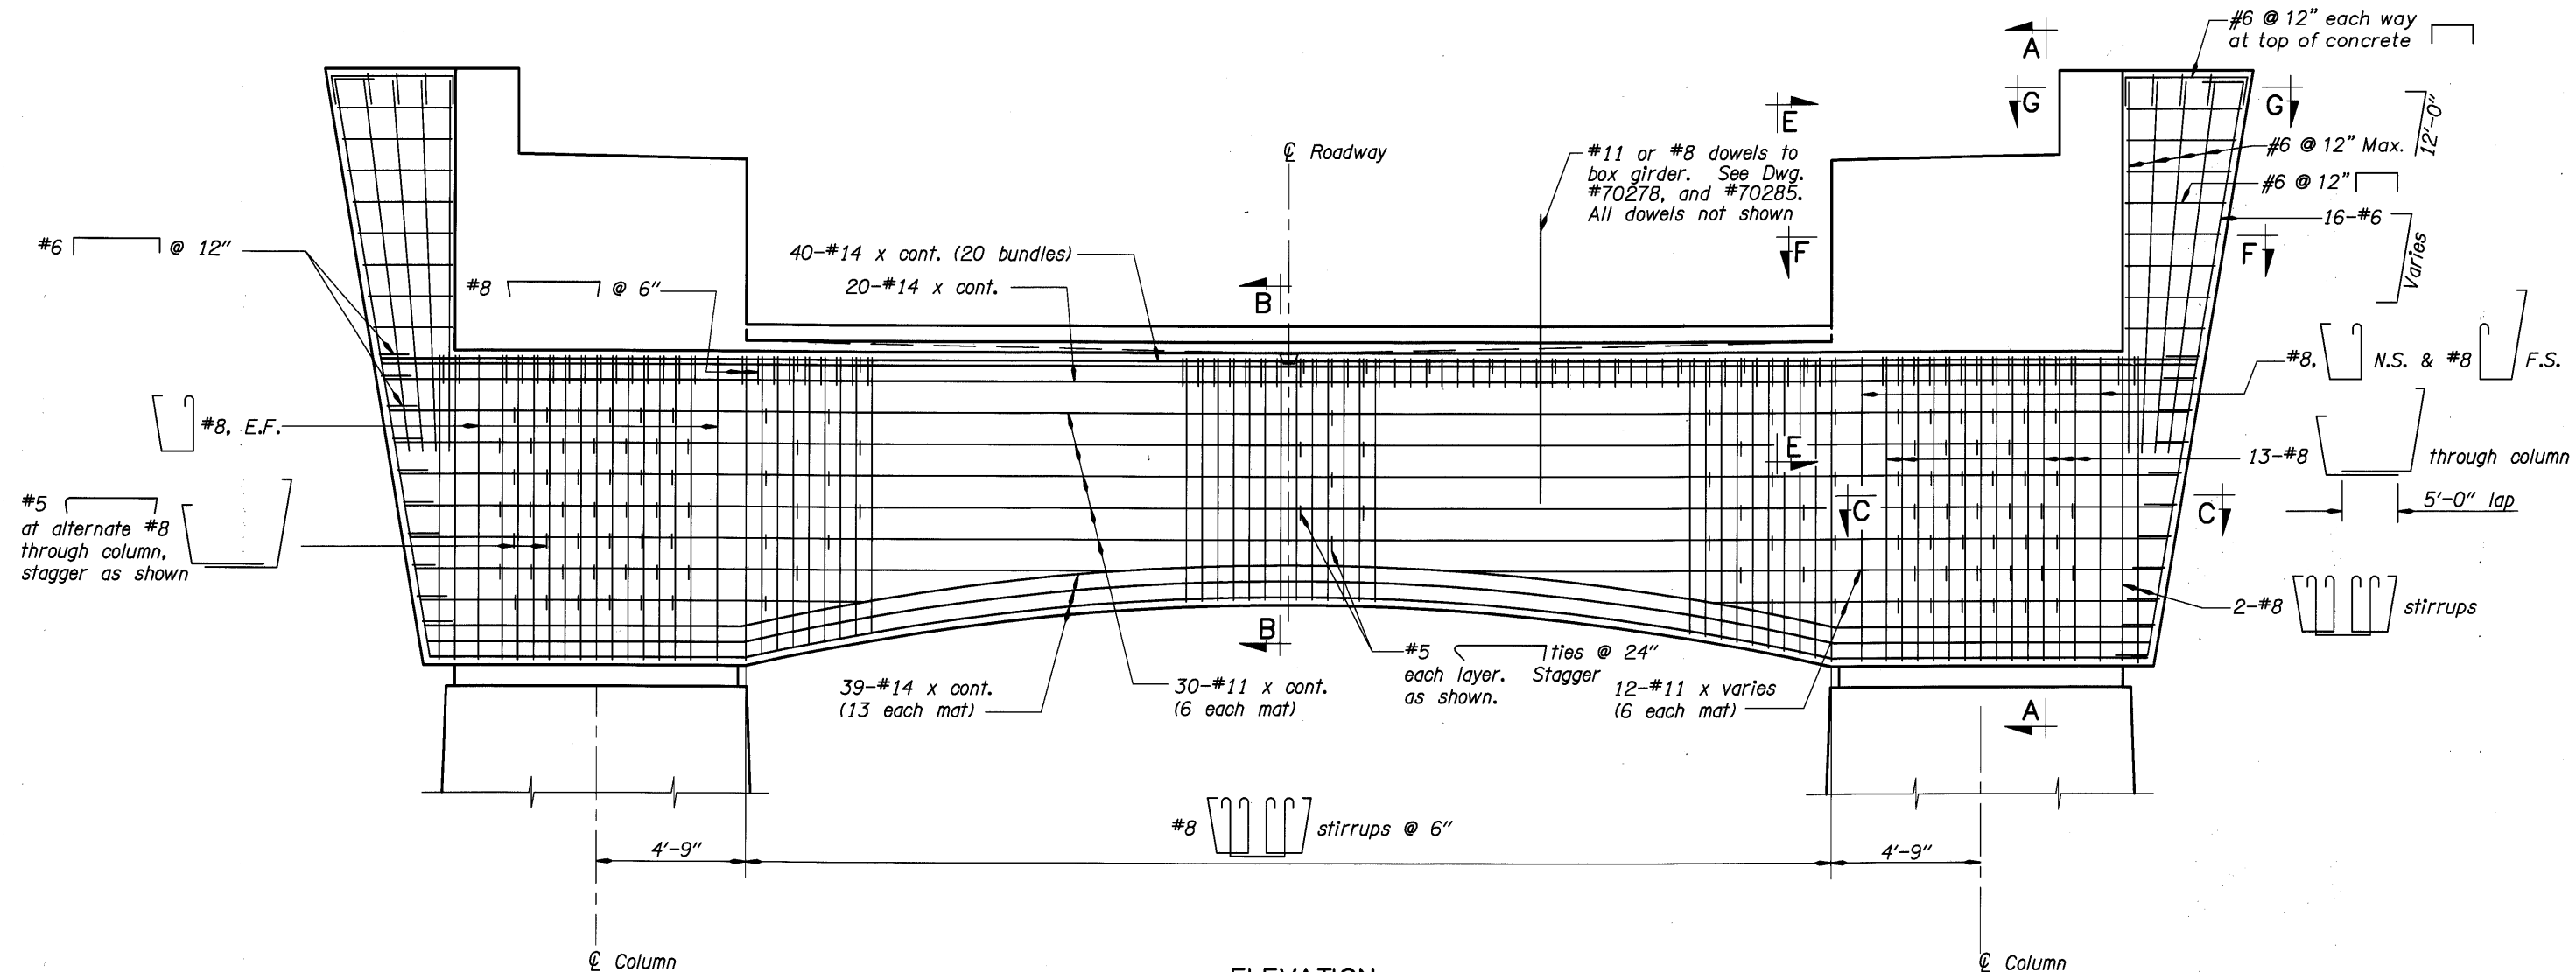

**ELEVATION**


Scale: 3/8" = 1'-0"

**Notes:**


For Sections A-A, B-B and C-C, see Dwg. #70309.  
 For Section E-E, see Dwg. #70310  
 For Sections F-F and G-G, see Dwg. #70311.  
 Bent 3 shown, Bent 4 similar

DO NOT SCALE THIS DRAWING.  
 FOLLOW DIMENSIONS. INDICATED  
 SCALES CORRECT ONLY FOR  
 FULL SIZE SHEET (22"x34").


Xref: Odobch.dwg SARB.dwg SA111.dwg	DATE	REVISION	BY	DESIGNER	REGISTERED PROFESSIONAL ENGINEER No. 74549 PE OREGON MARCH 09, 2004 WENT WILLIAM CORDY	 DAVID EVANS AND ASSOCIATES INC. 530 Center Street N.E., Suite 605 Salem Oregon 97301 Phone: 503.361.8635	CONNECTING COMMERCE AND COMMUNITY  MULTNOMAH COUNTY BRIDGES TRANSPORTATION DIVISION	BRIDGE NO.	MULTNOMAH CHANNEL & PNWR ETC., SAUVIE ISLAND RD.	SHEET
	08/05	Revised Columns	KWC	DRAFTED: Ken Johnson				20136		121
	03/09	As-Constructed	TDJ	CHECKED: Josh Hewes				DATE Sept. 2005		OF 173
			REVIEWED: Adrienne Dietrich	EXPIRES: 12-31-05			OREGON DEPARTMENT OF TRANSPORTATION BRIDGE ENGINEERING SECTION	CALC. BOOK	BENT 3 AND 4 - X-BEAM DETAILS (1 OF 4)	DRAWING NO. 70308

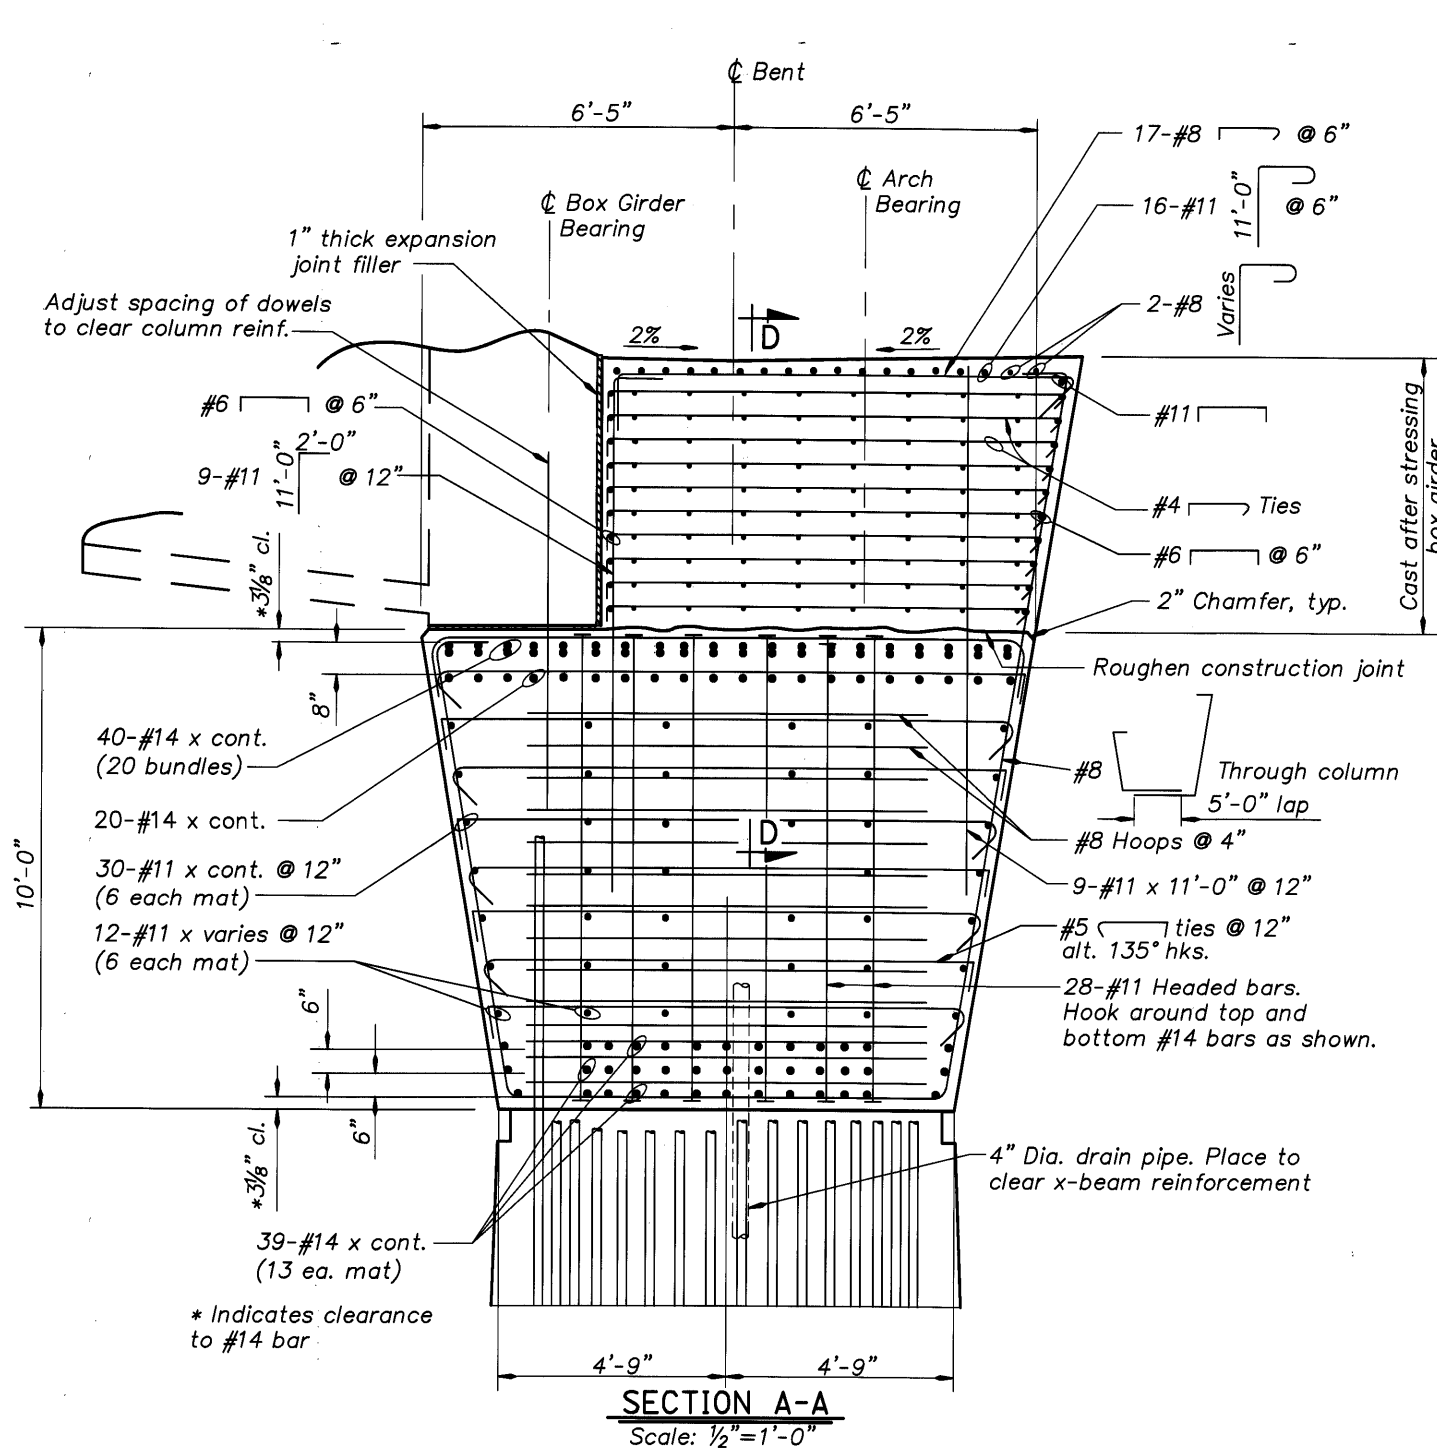

**SECTION A-A**  
Scale: 1/2" = 1'-0"

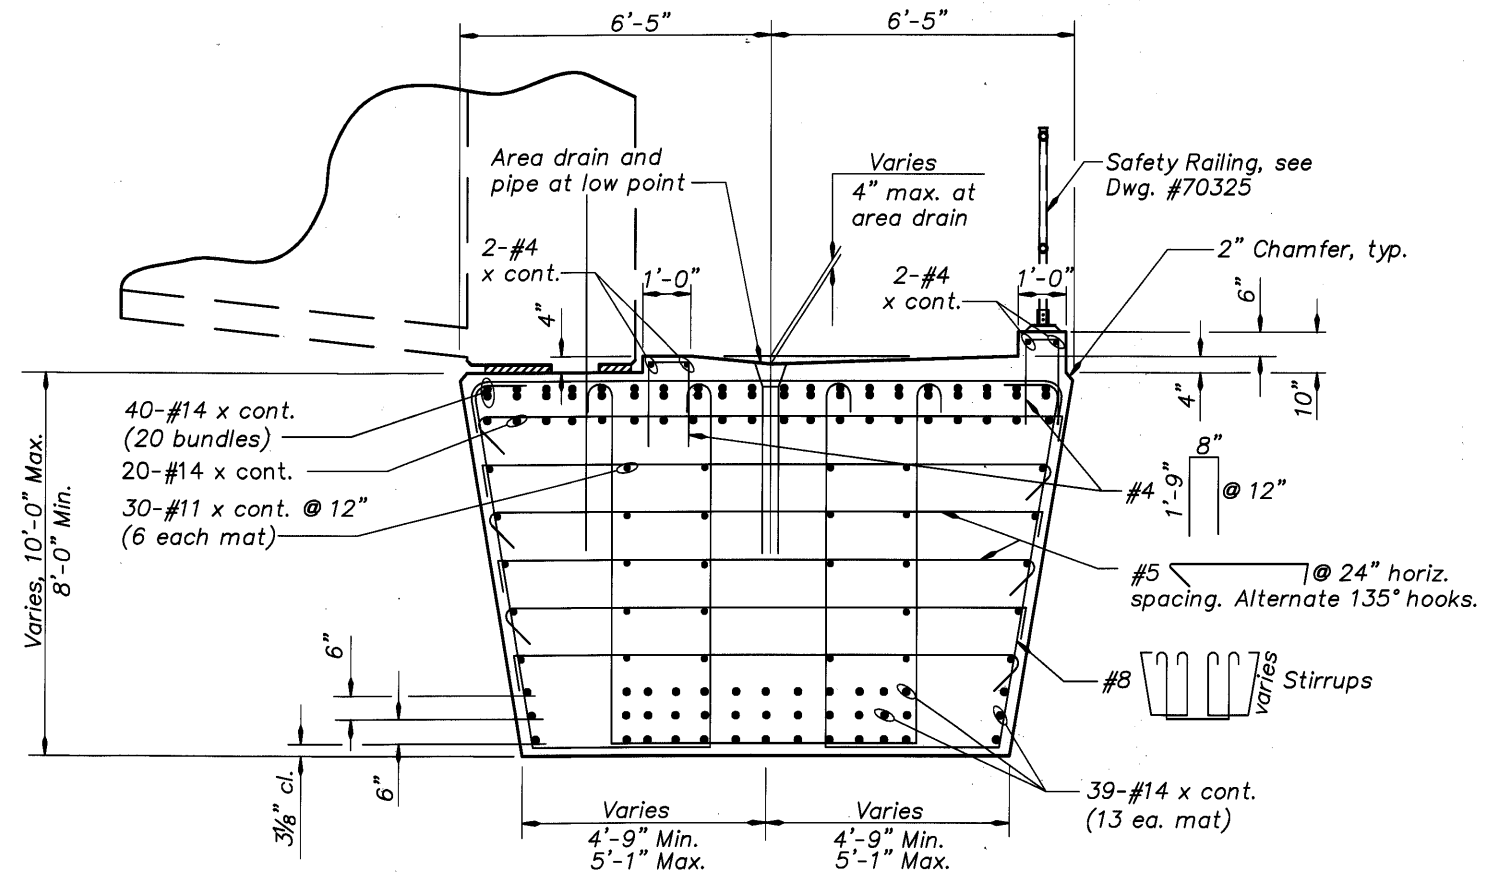

**SECTION B-B**  
Scale: 1/2" = 1'-0"

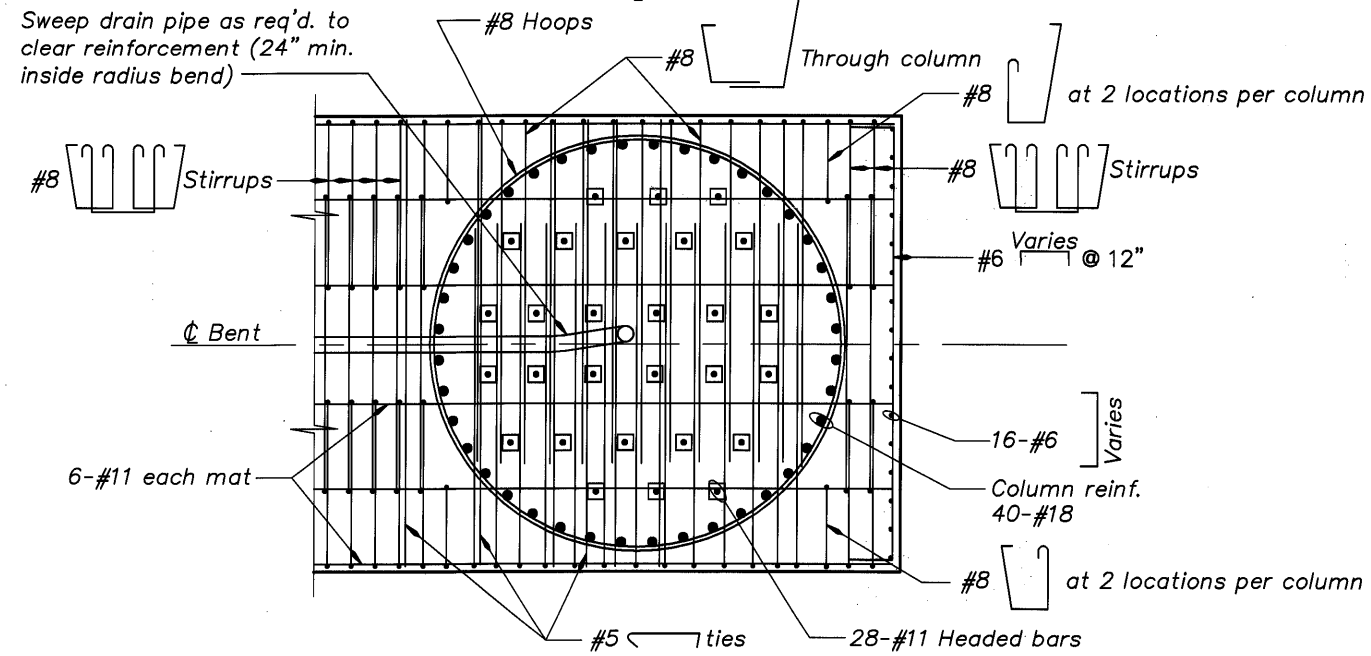

**SECTION C-C**  
Scale: 1/2" = 1'-0"

\* Indicates clearance to #14 bar

**Notes:**  
For location of Sections A-A, B-B, and C-C, See Dwg. #70308  
For Section D-D, See Dwg. #70310

**DO NOT SCALE THIS DRAWING. FOLLOW DIMENSIONS. INDICATED SCALES CORRECT ONLY FOR FULL SIZE SHEET (22"x34").**

DATE	REVISION	BY
08/05	Revised Columns	KWC
03/09	As-Constructed	TDF

DRAFTED: Ken Johnson  
CHECKED: Josh Hewes  
REVIEWED: Adrienne Dietrich

**DESIGNER**  
REGISTERED PROFESSIONAL ENGINEER  
DAVID EVANS AND ASSOCIATES INC.  
530 Center Street N.E., Suite 605  
Salem Oregon 97301  
Phone: 503.361.9635


CONNECTING COMMERCE AND COMMUNITY  
**MULTNOMAH COUNTY BRIDGES**  
TRANSPORTATION DIVISION  
**OREGON DEPARTMENT OF TRANSPORTATION BRIDGE ENGINEERING SECTION**

BRIDGE NO.	20136
DATE	Sept. 2005
CALC. BOOK	


MULTNOMAH CHANNEL & PNWR ETC., SAUVIE ISLAND RD.  
**BENT 3 AND 4 - X-BEAM DETAILS (2 OF 4)**

**SHEET 122 OF 173.**  
**DRAWING NO. 70309**



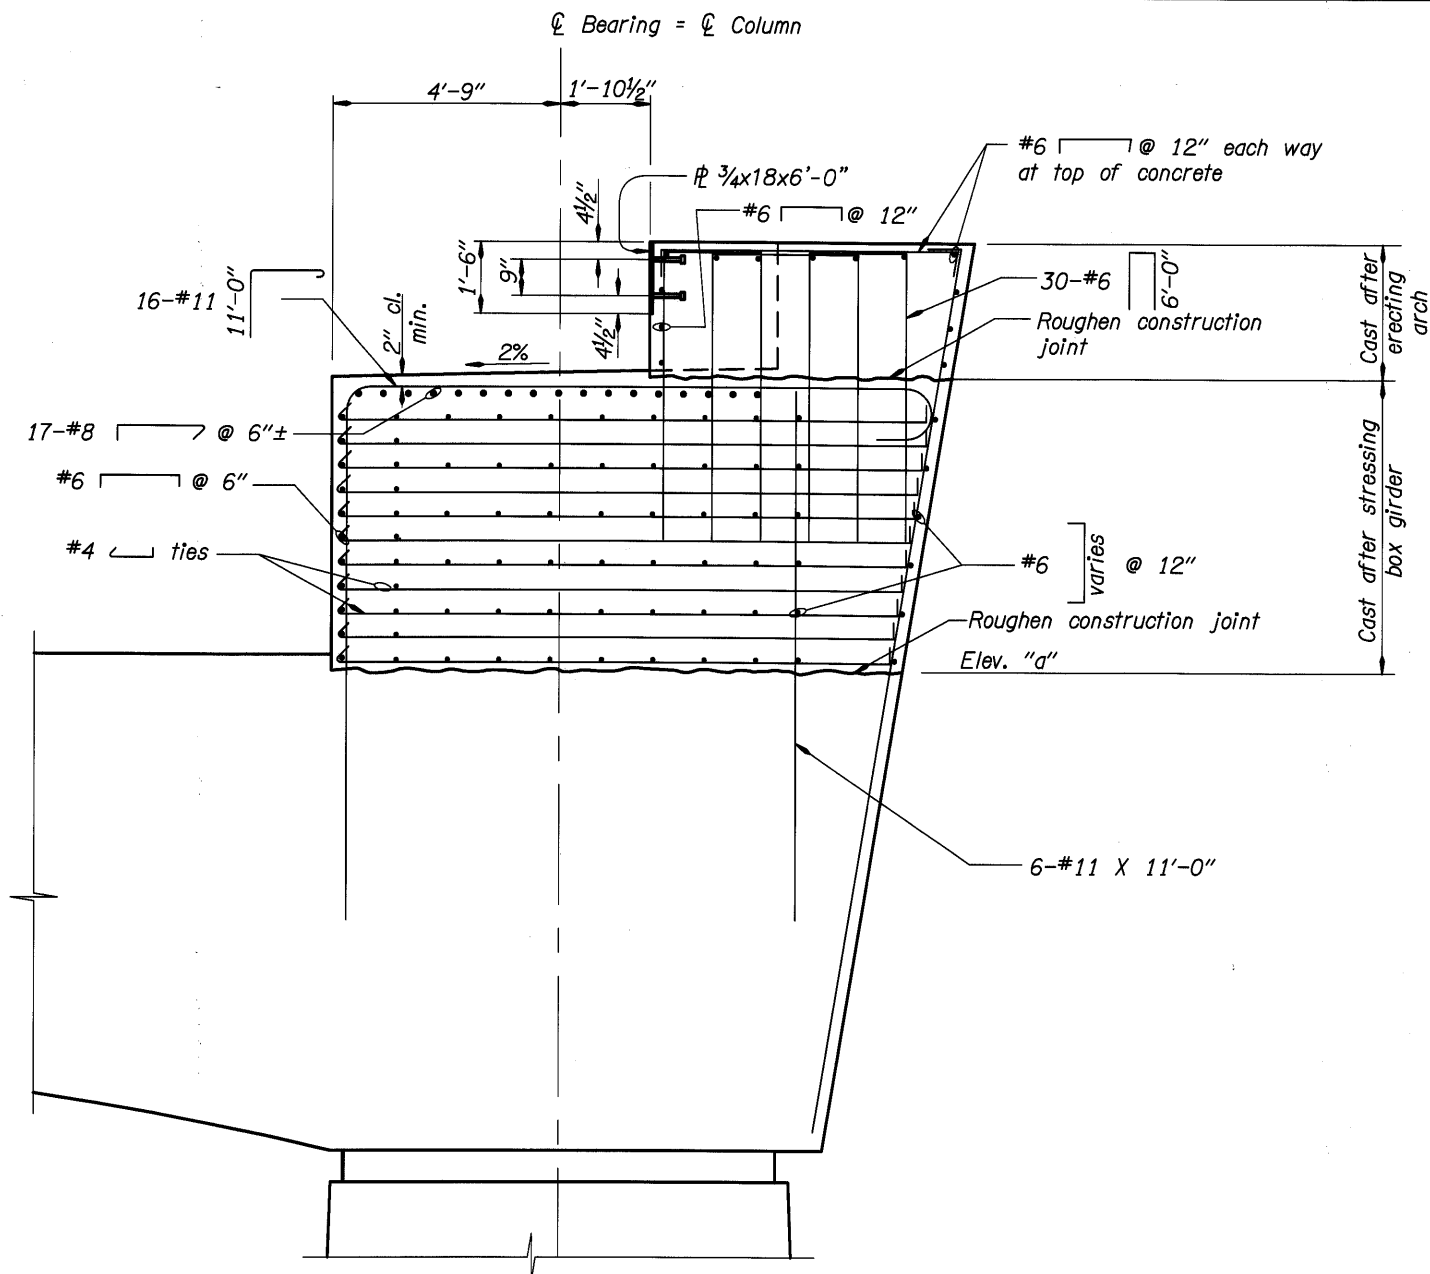

**SECTION D-D**  
Scale: 1/2" = 1'-0"

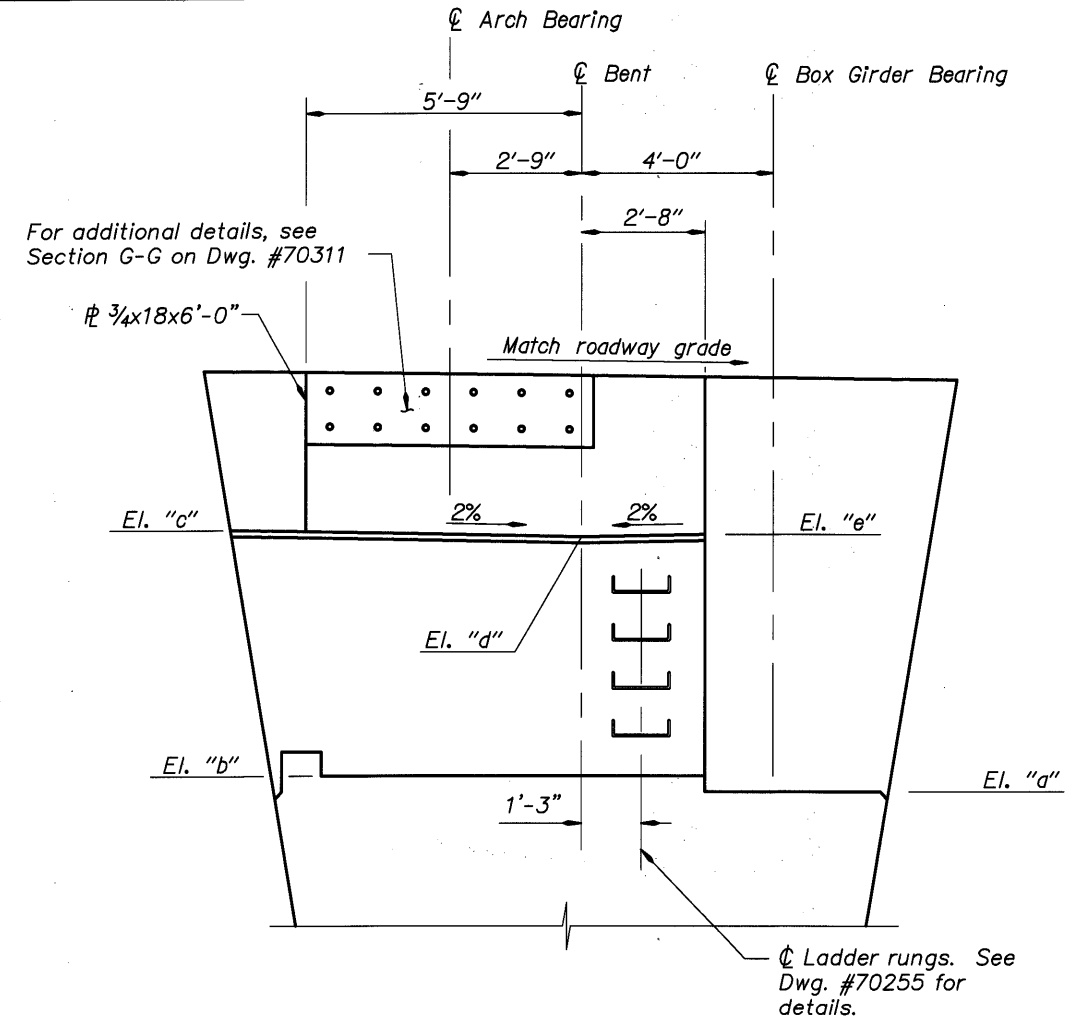

**SECTION E-E**  
Scale: 1/2" = 1'-0"

Bent No.	Elevation "a"	Elevation "b"	Elevation "c"	Elevation "d"	Elevation "e"
3	73.75	74.08	79.48	79.33	79.39
4	68.60	68.93	74.65	74.50	74.55

DO NOT SCALE THIS DRAWING.  
FOLLOW DIMENSIONS INDICATED  
SCALES CORRECT ONLY FOR  
FULL SIZE SHEET (22"x34").

Notes:  
For location of Section D-D, See Dwg. #70309  
For location of Section E-E, See Dwg. #70308

DATE	REVISION	BY	DESIGNER
08/05	Revised Columns	KWC	Ken Johnson
03/09	As-Constructed	TFP	Josh Hewes
			Adrienne Dietrich


**DESIGNER**  
REGISTERED PROFESSIONAL ENGINEER  
74848 P.E.  
MARCH 09, 2004  
KENT WILLIAM CORDT  
DAVID EVANS AND ASSOCIATES INC.  
530 Center Street N.E., Suite 605  
Salem Oregon 97301  
Phone: 503.361.8635  
EXPIRES: 12-31-05

CONNECTING COMMERCE AND COMMUNITY  
**MULTNOMAH COUNTY BRIDGES**  
TRANSPORTATION DIVISION  
OREGON DEPARTMENT OF TRANSPORTATION  
BRIDGE ENGINEERING SECTION


<b>BRIDGE NO.</b> 20136
<b>DATE</b> Sept. 2005
<b>CALC. BOOK</b>

MULTNOMAH CHANNEL & PNWR ETC., SAUVIE ISLAND RD.  
BENT 3 AND 4 - X-BEAM DETAILS (3 OF 4)

<b>SHEET</b> 123 OF 173
<b>DRAWING NO.</b> 70310

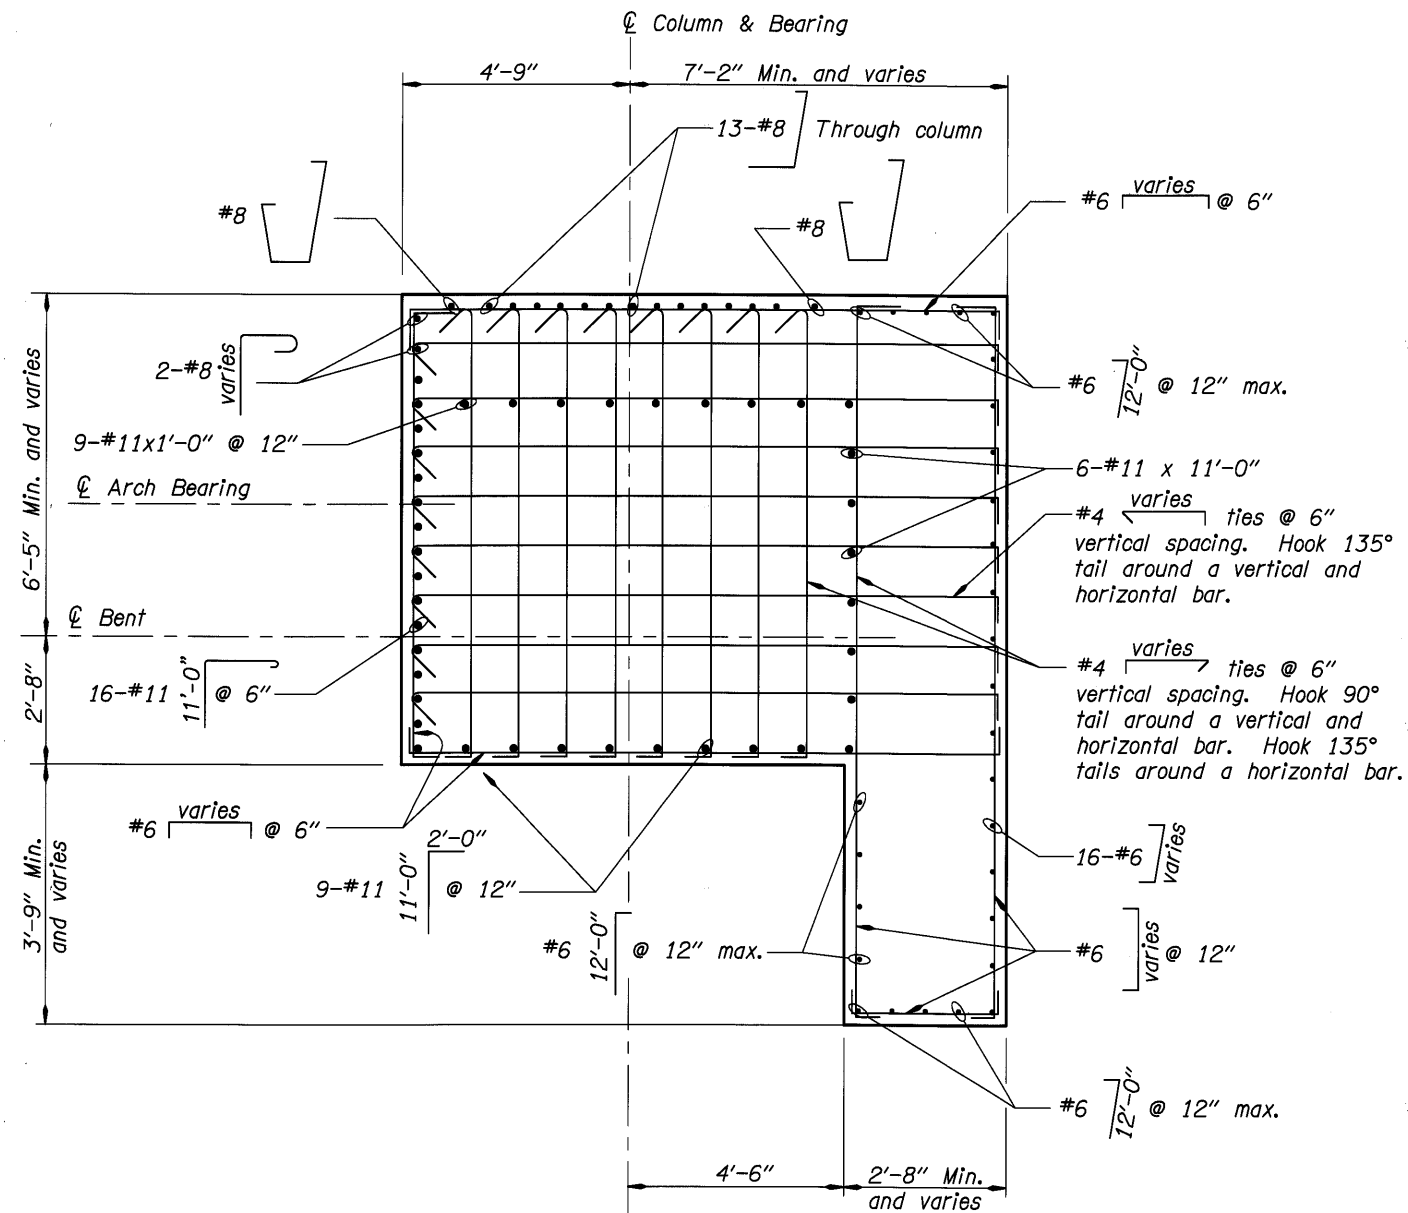



**SECTION F-F**  
Scale: 1/2"=1'-0"

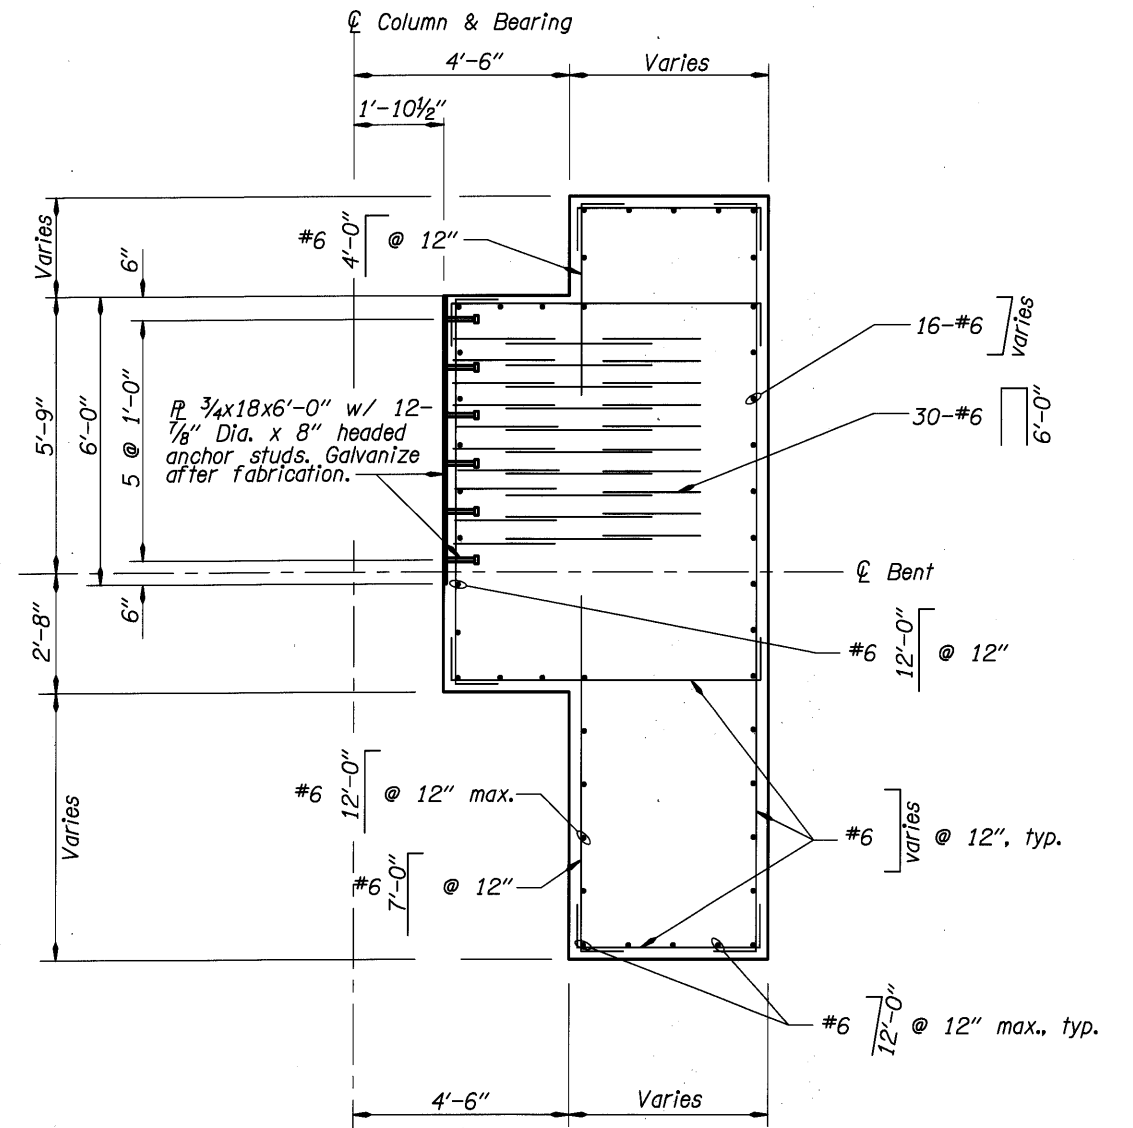

**SECTION G-G**  
Scale: 1/2"=1'-0"

DO NOT SCALE THIS DRAWING.  
FOLLOW DIMENSIONS. INDICATED  
SCALES CORRECT ONLY FOR  
FULL SIZE SHEET (22"x34").

	DATE	REVISION	BY	Ken Johnson DRAFTED: Josh Hewes CHECKED: Adrienne Dietrich REVIEWED:	<b>DESIGNER</b>  <b>DAVID EVANS AND ASSOCIATES INC.</b> 530 Center Street N.E., Suite 605 Salem Oregon 97301 Phone: 503.361.8635	 TRANSPORTATION DIVISION <b>OREGON DEPARTMENT OF TRANSPORTATION</b> BRIDGE ENGINEERING SECTION	BRIDGE NO.	MULTNOMAH CHANNEL & PNWR ETC., SAUVIE ISLAND RD.	SHEET
	03/09	As-Constructed	TDF				20136		124
							DATE		OF
							Sept. 2005		173.
					EXPIRES: 12-31-05		CALC. BOOK	DRAWING NO.	
								70311	
								BENT 3 - X-BEAM DETAILS (4 OF 4)	

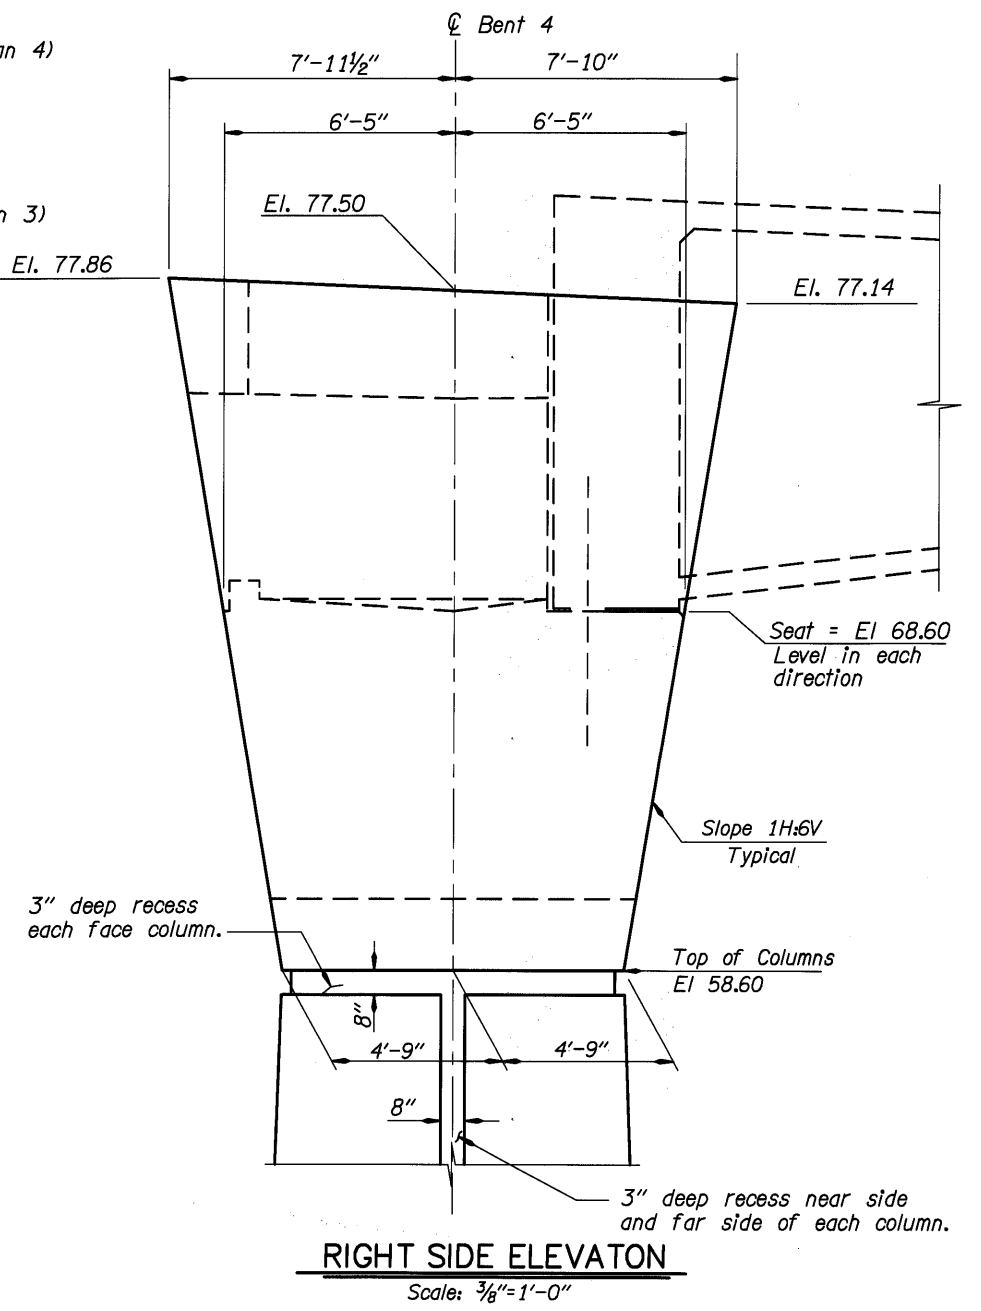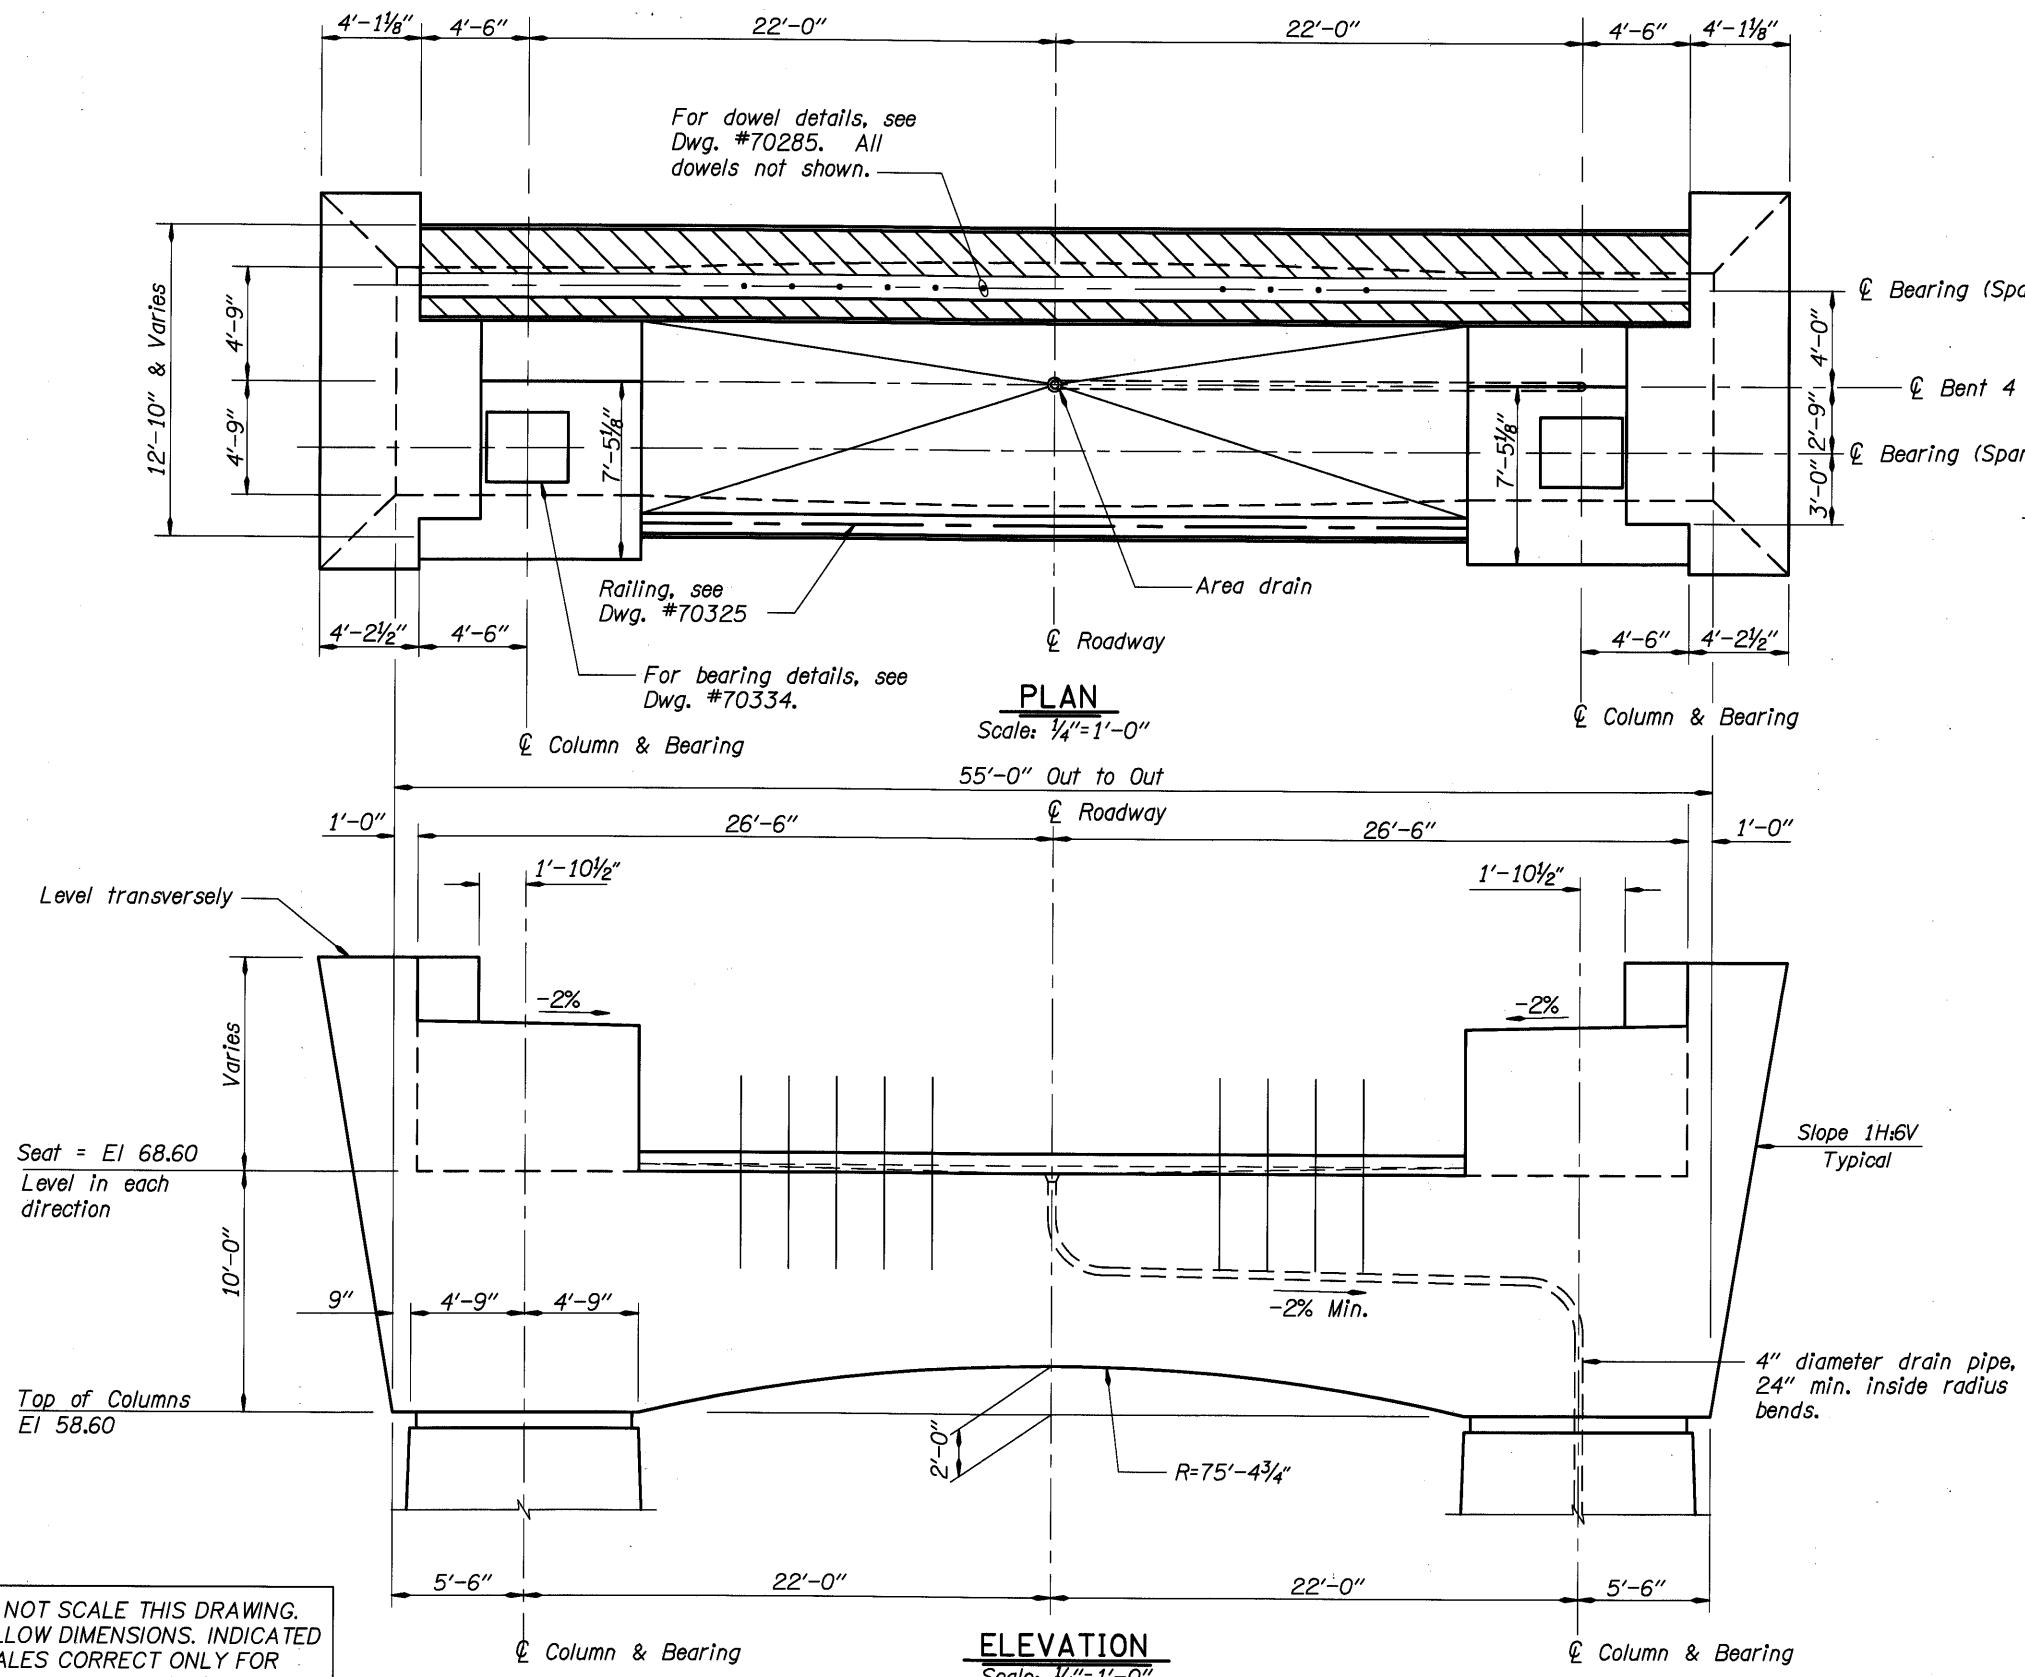

DO NOT SCALE THIS DRAWING. FOLLOW DIMENSIONS. INDICATED SCALES CORRECT ONLY FOR FULL SIZE SHEET (22"x34").

DATE	REVISION	BY	DESIGNER
08/05	Revised Columns	KWC	Ken Johnson
03/09	As-Constructed	TDF	Josh Hewes
			Adrienne Dietrich

**DESIGNER**  
DAVID EVANS AND ASSOCIATES INC.  
530 Center Street N.E., Suite 605  
Salem Oregon 97301  
Phone: 503.361.8635


REGISTERED PROFESSIONAL ENGINEER  
74548 PE  
EXPIRES: 12-31-05

CONNECTING COMMERCE AND COMMUNITY  
**MULTNOMAH COUNTY BRIDGES**  
TRANSPORTATION DIVISION  
OREGON DEPARTMENT OF TRANSPORTATION  
BRIDGE ENGINEERING SECTION

<b>BRIDGE NO.</b> 20136
<b>DATE</b> Sept. 2005
<b>CALC. BOOK</b>

MULTNOMAH CHANNEL & PNWR ETC., SAUVIE ISLAND RD.  
**BENT 4 - X-BEAM PLAN AND ELEVATION**

<b>SHEET</b> 125 OF 173.
<b>DRAWING NO.</b> 70312

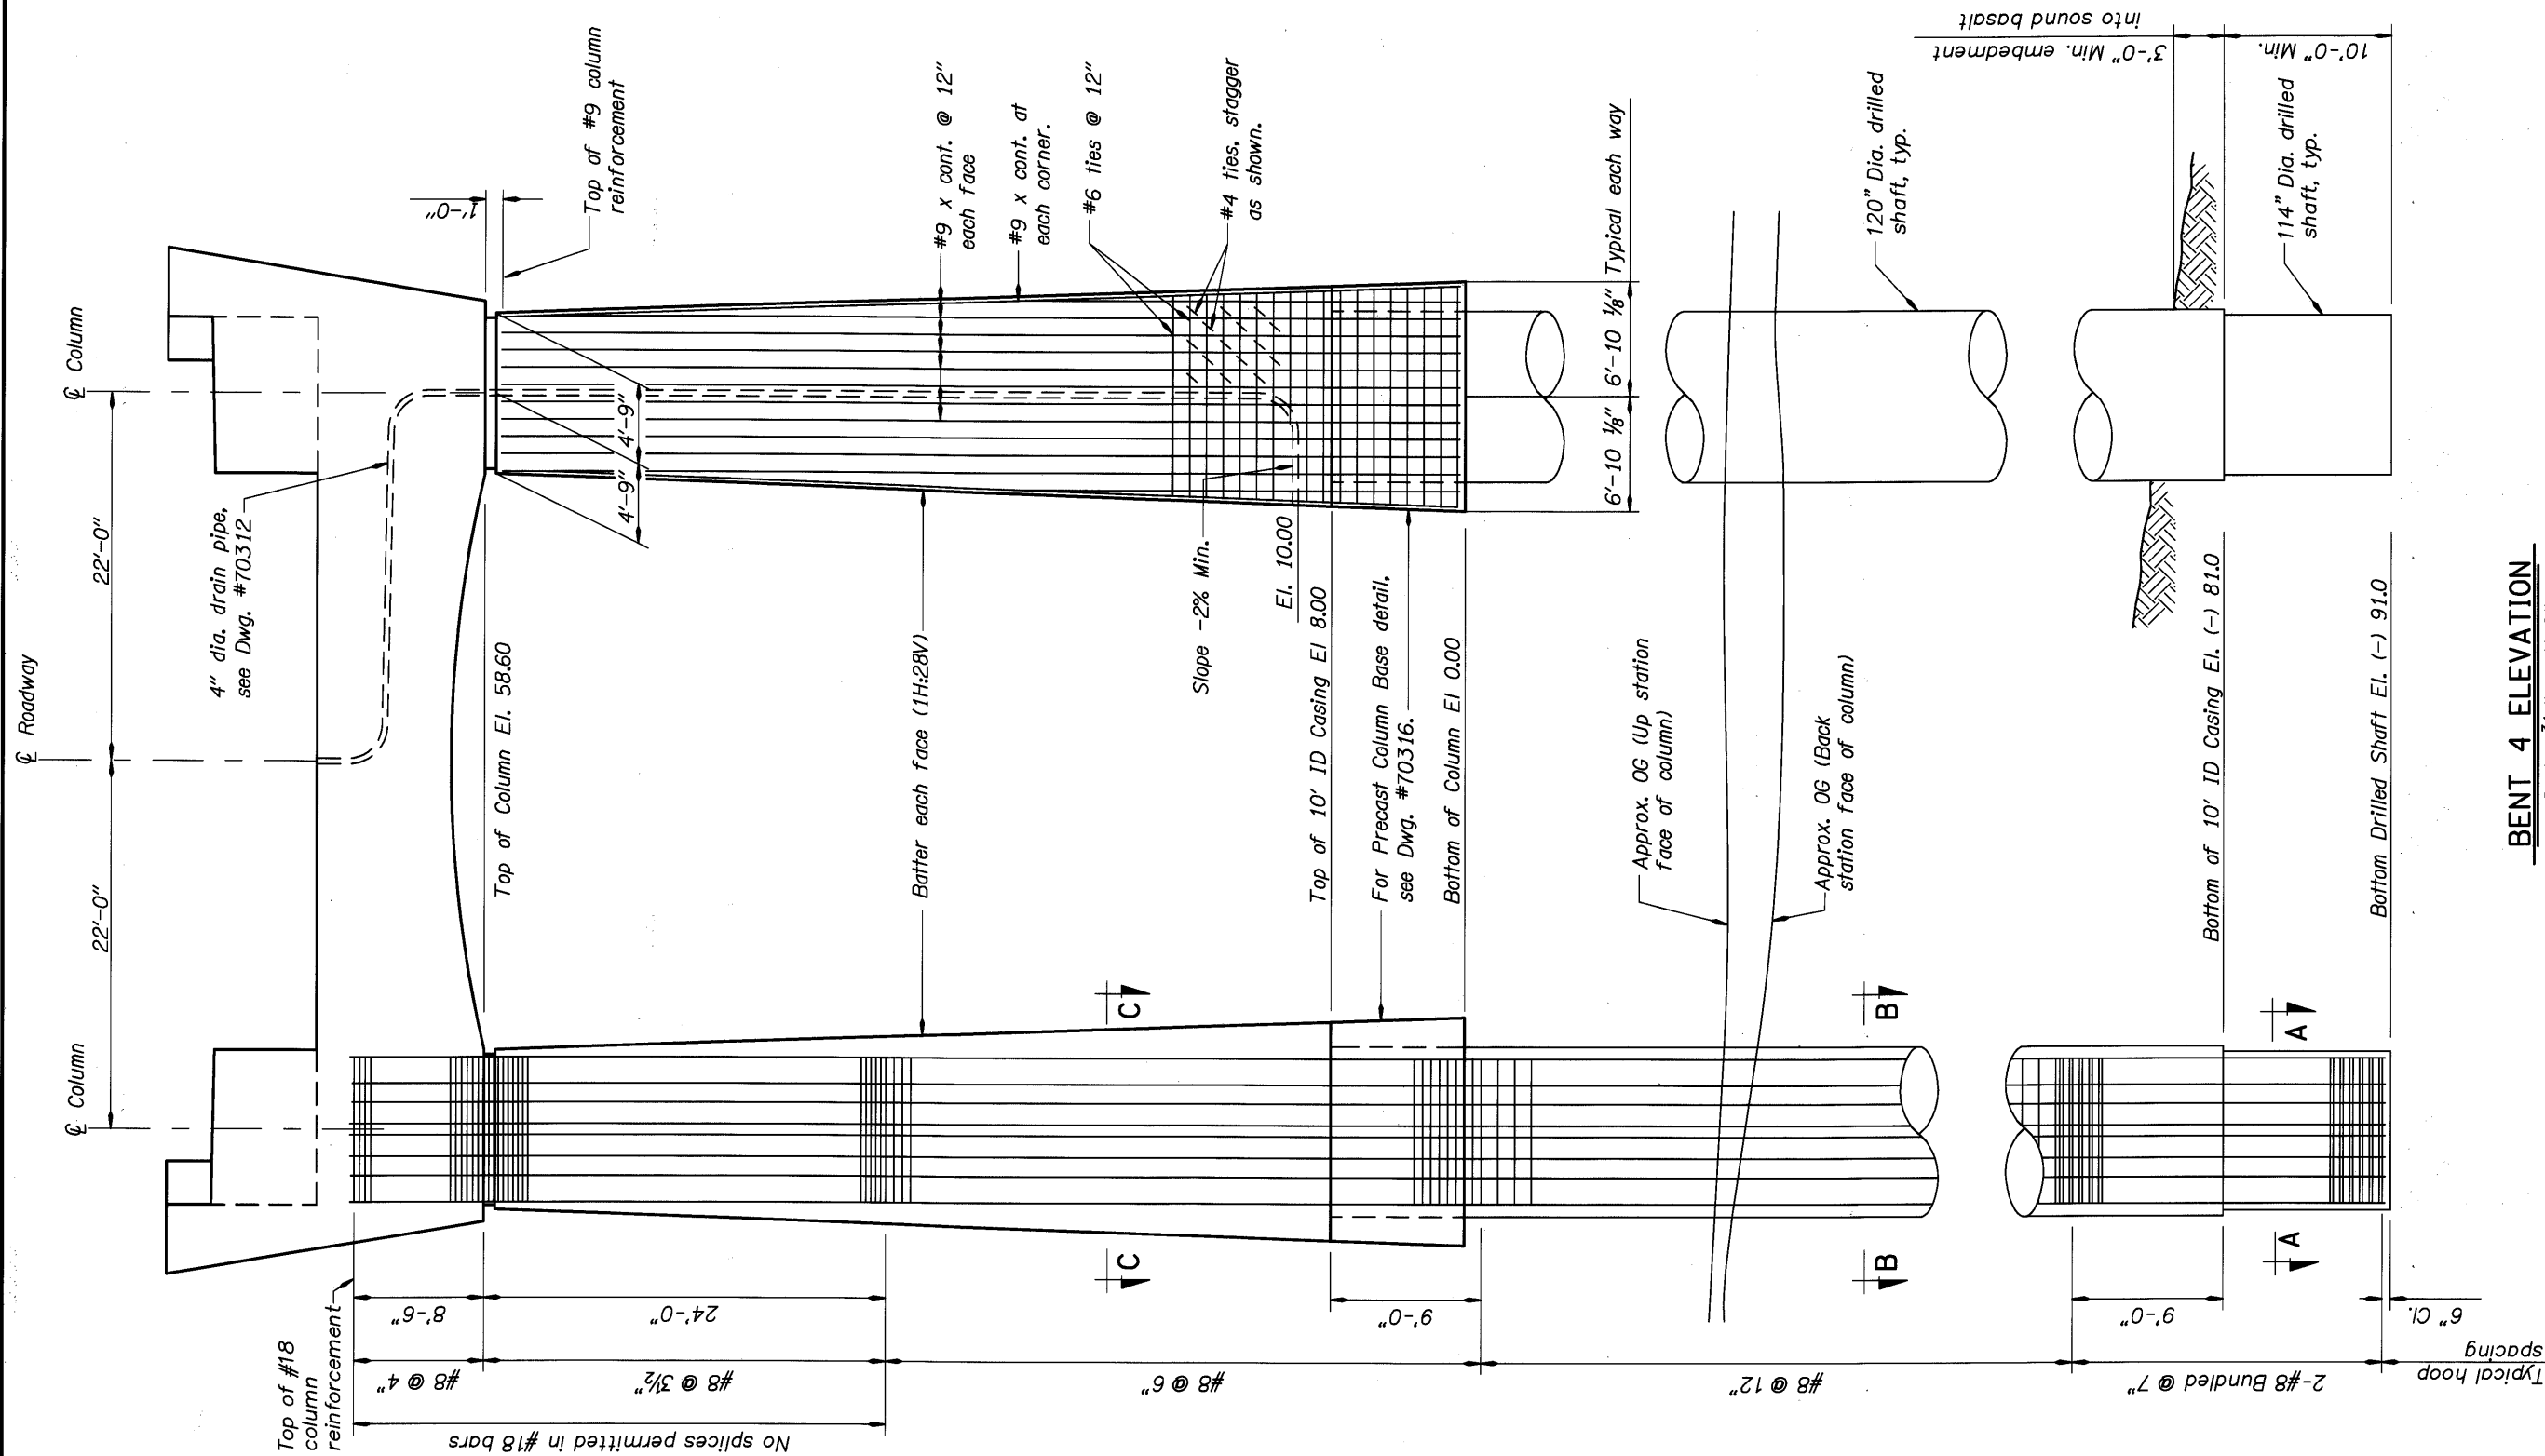

**BENT 4 ELEVATION**  
Scale: 3/16" = 1'-0"


- Notes:**
1. For Column and Drilled Shaft staging details see Dwg. #70315.
  2. For Sections A-A, B-B, and C-C, see Dwg. #70317

DO NOT SCALE THIS DRAWING. FOLLOW DIMENSIONS. INDICATED SCALES CORRECT ONLY FOR FULL SIZE SHEET (22"x34").


	DATE	REVISION	BY	DESIGNER  Ken Johnson	 DAVID EVANS AND ASSOCIATES INC. 530 Center Street N.E., Suite 605 Salem Oregon 97301 Phone: 503.361.8635	 MULTNOMAH COUNTY BRIDGES TRANSPORTATION DIVISION	BRIDGE NO.	MULTNOMAH CHANNEL & PNWR ETC., SAUVIE ISLAND RD.	SHEET
	08/05	Revised Columns	KWC				20136		126
	03/09	As-Constructed	TPF	CHECKED: Josh Hewes REVIEWED: Steve Thoman	 OREGON DEPARTMENT OF TRANSPORTATION BRIDGE ENGINEERING SECTION	DATE: Sept. 2005 CALC. BOOK	BENT 4 - COLUMN AND DRILLED SHAFT	OF 173	
								DRAWING NO. 70313	





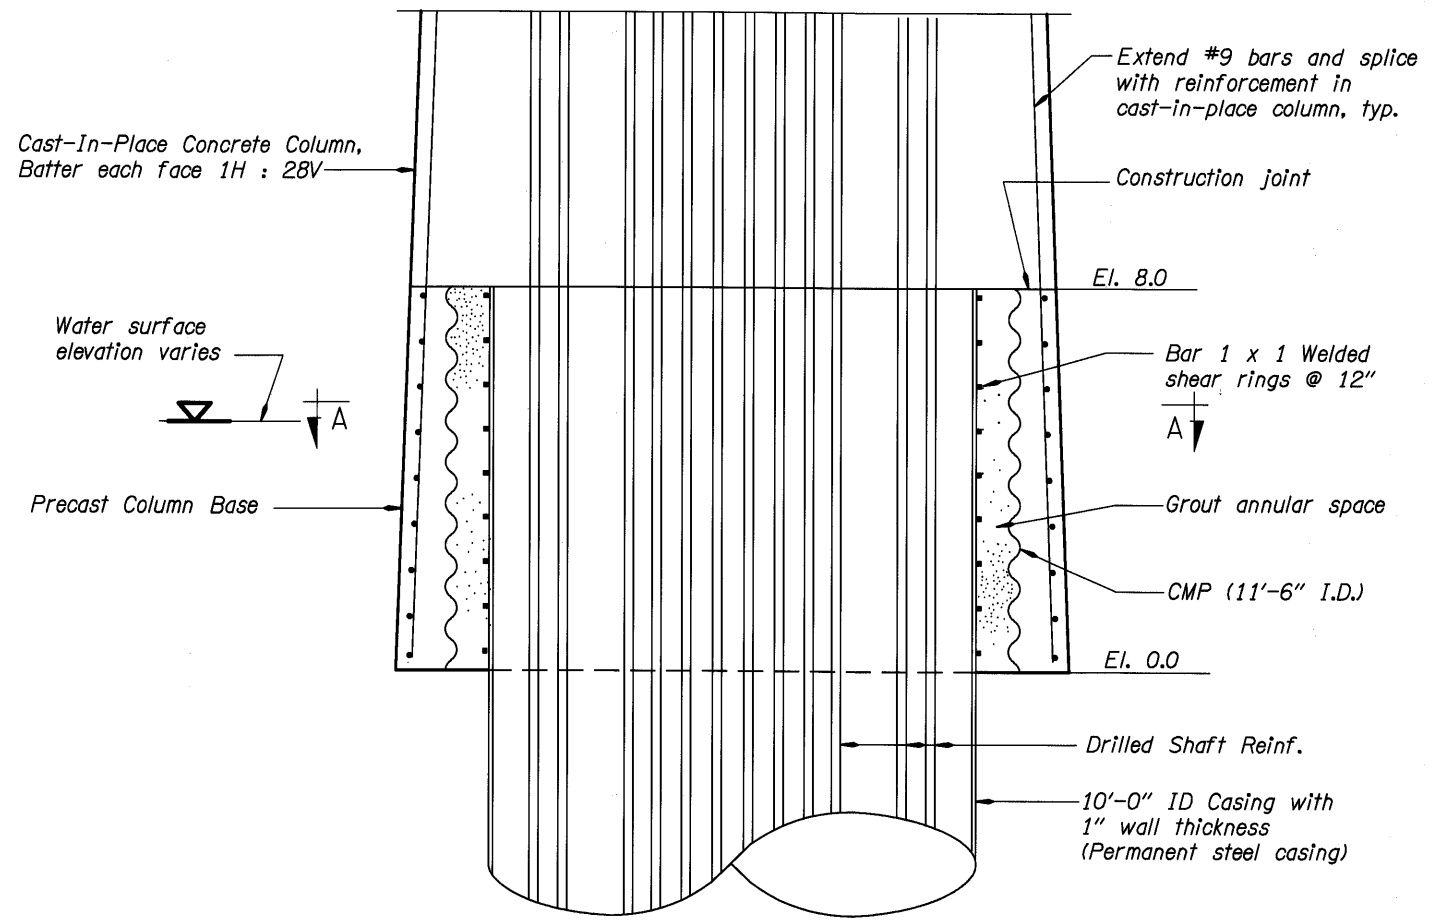


**PART SECTION  
PRECAST COLUMN BASE**  
Scale: 1/2" = 1'-0"

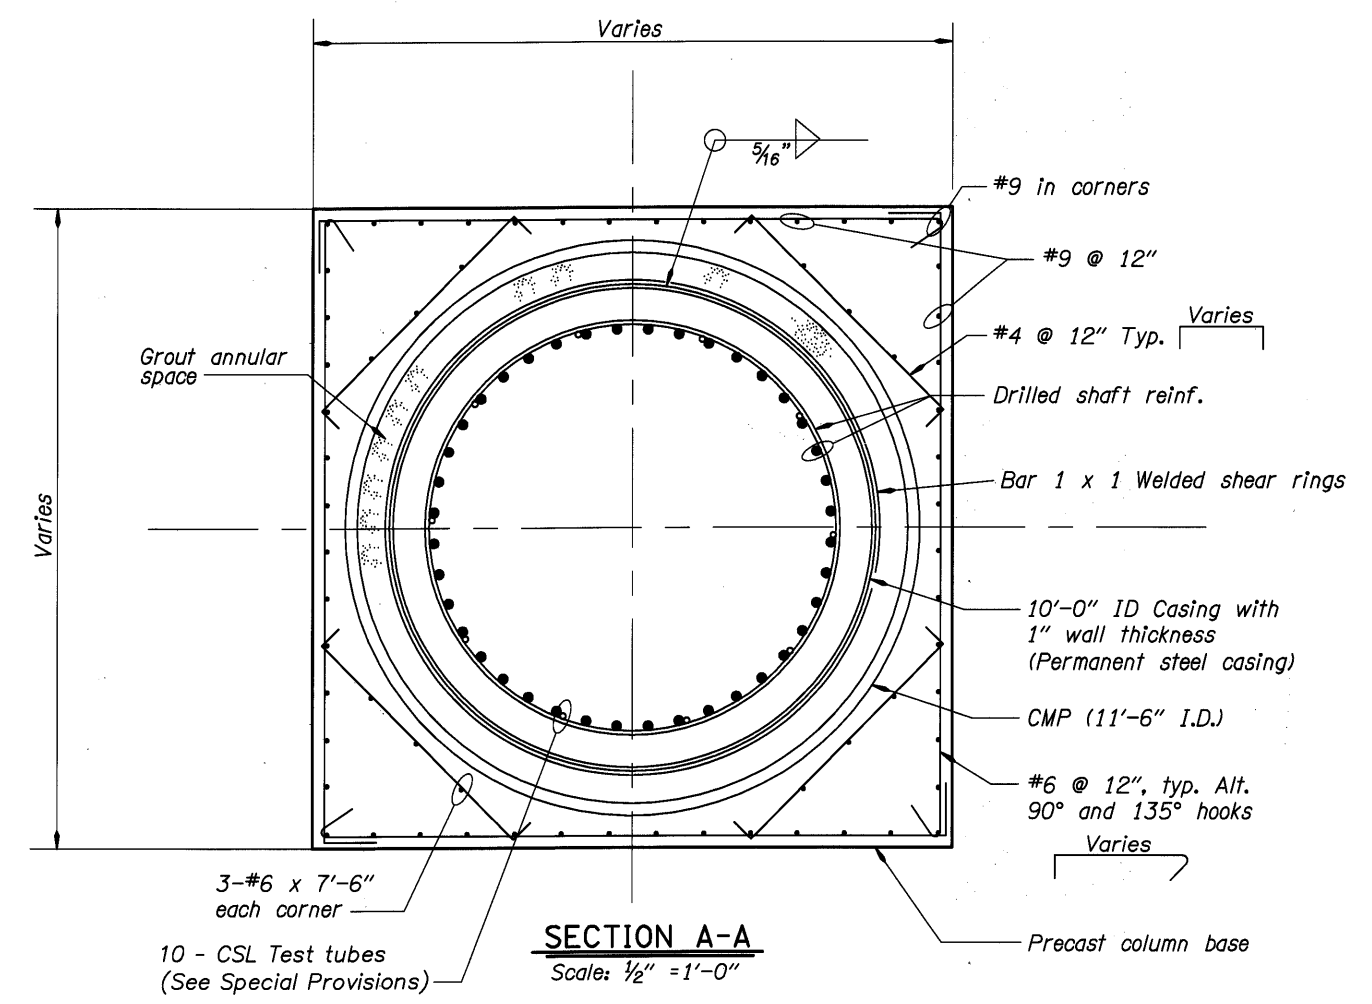


**SECTION A-A**  
Scale: 1/2" = 1'-0"

DO NOT SCALE THIS DRAWING.  
FOLLOW DIMENSIONS. INDICATED  
SCALES CORRECT ONLY FOR  
FULL SIZE SHEET (22"x34").


	DATE	REVISION	BY	DRAFTED: <i>Ken Johnson</i> CHECKED: <i>Josh Hewes</i> REVIEWED: <i>Steve Thoman</i>	<b>DESIGNER</b>  <b>DAVID EVANS AND ASSOCIATES INC.</b> 530 Center Street N.E., Suite 605 Salem Oregon 97301 Phone: 503.361.8635	 TRANSPORTATION DIVISION <b>OREGON DEPARTMENT OF TRANSPORTATION BRIDGE ENGINEERING SECTION</b>	BRIDGE NO.	MULTNOMAH CHANNEL & PNWR ETC., SAUVIE ISLAND RD.	SHEET
	08/05	Revised Columns	KWC				20136		128
	03/09	As-Constructed	TDF				DATE Sept. 2005		OF 173.
							CALC. BOOK	COLUMN AND DRILLED SHAFT DETAILS (1 OF 3)	DRAWING NO. 70316

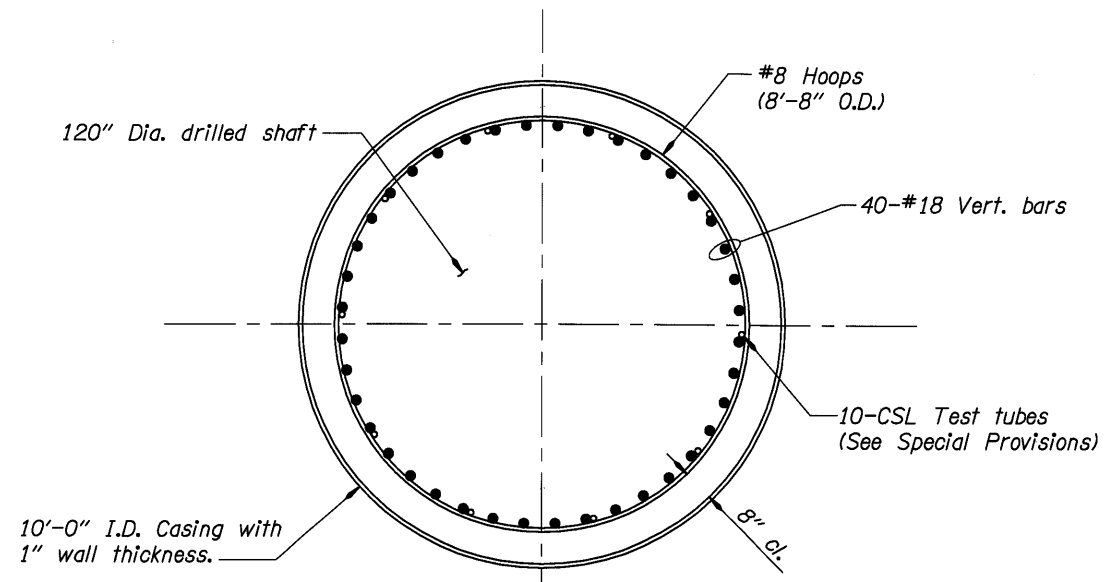

**SECTION B-B**  
Scale: 1/2" = 1'-0"

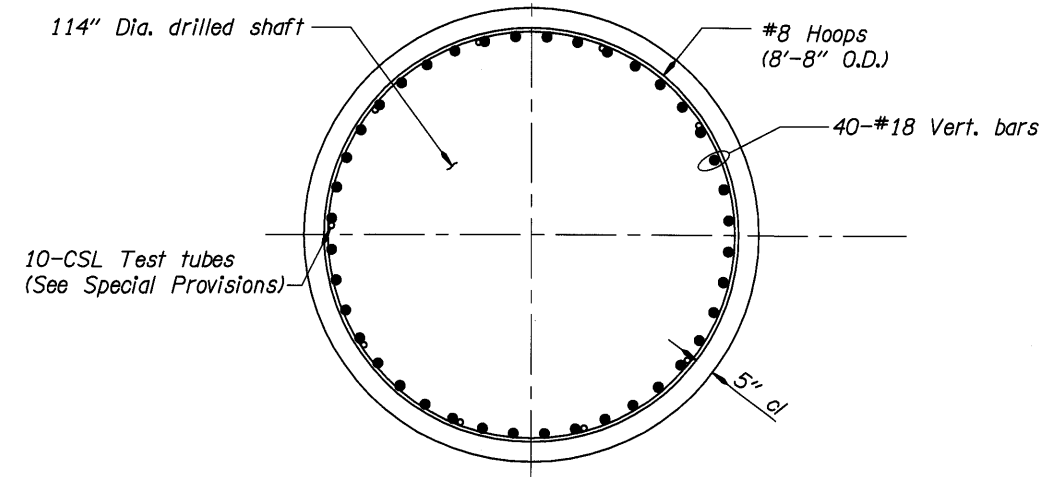

**SECTION A-A**  
Scale: 1/2" = 1'-0"

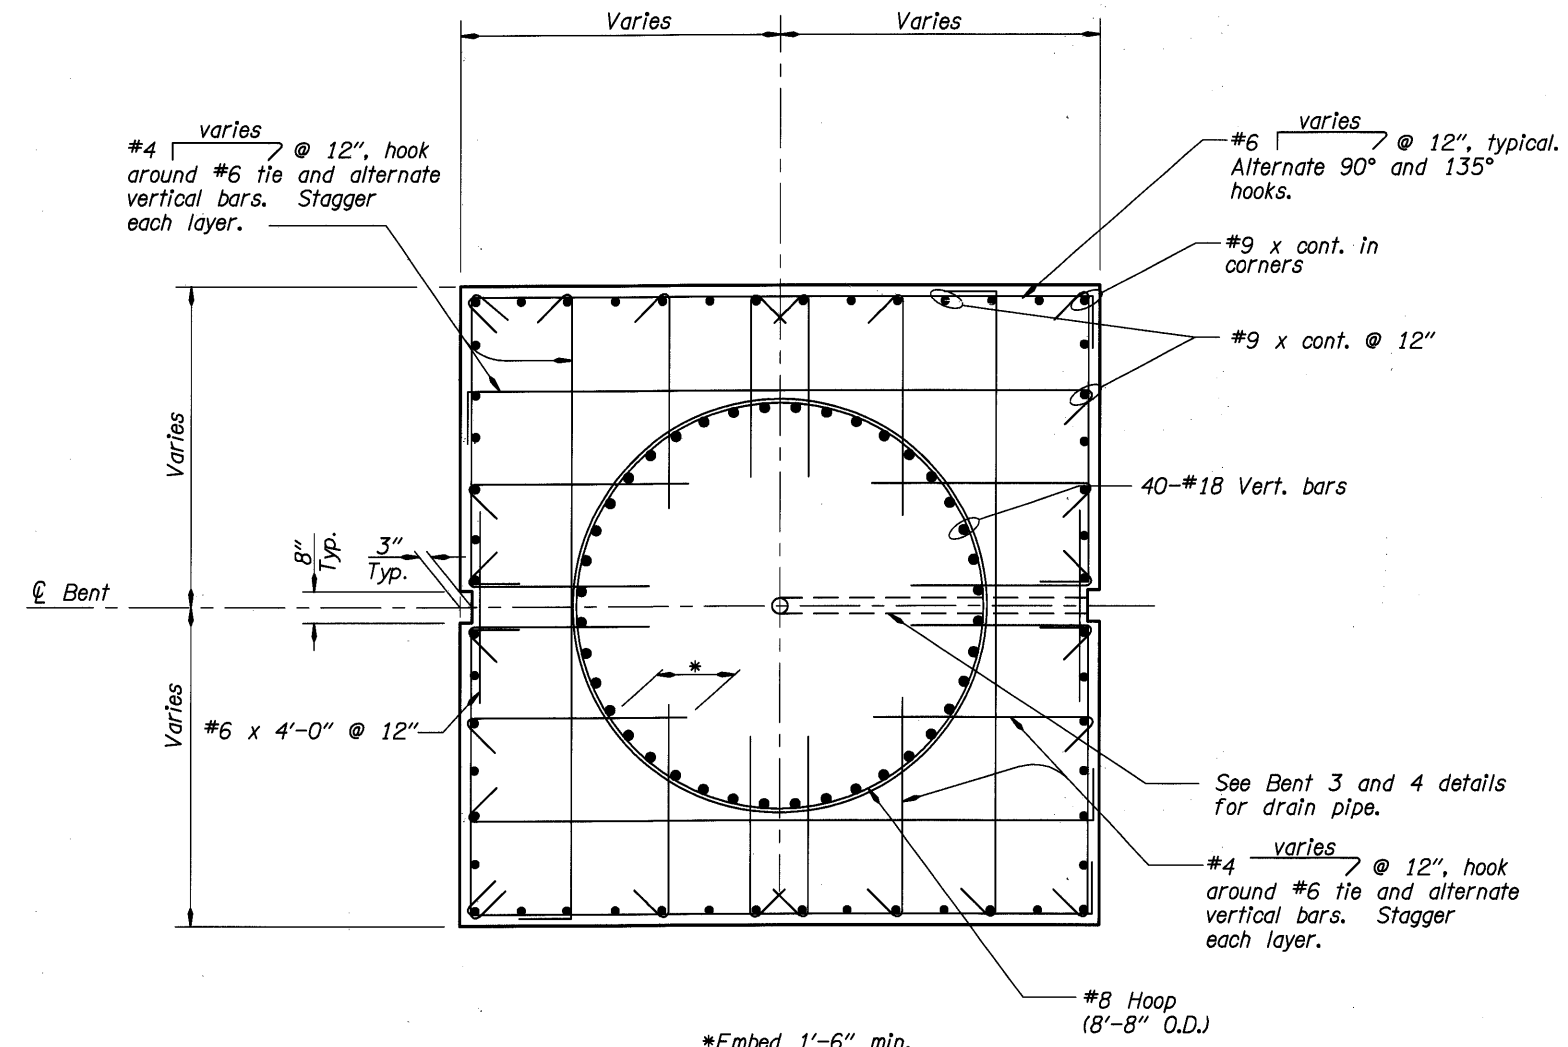

\*Embed 1'-6" min. past #8 hoop.

**SECTION C-C**  
Scale: 1/2" = 1'-0"


DO NOT SCALE THIS DRAWING. FOLLOW DIMENSIONS INDICATED. SCALES CORRECT ONLY FOR FULL SIZE SHEET (22"x34").

	DATE	REVISION	BY	Ken Johnson			BRIDGE NO. 20136	MULTNOMAH CHANNEL & PNWR ETC., SAUVIE ISLAND RD.	SHEET 129 OF 173
	08/05	Revised Columns	KWC	DRAFTED:					
	03/09	As-Constructed	TDF	Adrienne Dietrich		TRANSPORTATION DIVISION	DATE	COLUMN AND DRILLED SHAFT DETAILS (2 OF 3)	DRAWING NO. 70317
				Josh Hewes			OREGON DEPARTMENT OF TRANSPORTATION BRIDGE ENGINEERING SECTION		
				DESIGNED:	530 Center Street N.E., Suite 605 Salem Oregon 97301 Phone: 503.361.8635		CALC. BOOK		




**Note - A:**

ASTM A706 shall be used for all welded splices, except ASTM A615 Grade 60, ASTM A82 or ASTM A496 may be used if copies of the chemical composition analysis are submitted and approved as weldable by the Engineer. Spirals shall be anchored at each end or discontinuity with one extra turn and a splice to itself as shown. Where permitted on plans closed hoops shall conform to the requirements of this detail. Lapped splice is not allowed within 1/6 the column height or max. column cross sectional dimension or 18" from top of footing or bottom of cap beam, or in columns with spirals less than 3'-0" in diameter.

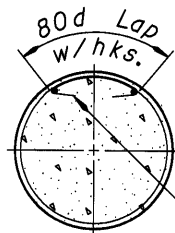


10", 135° Hks., (typ.), may be field bent.

**LAPPED SPLICE**  
See Note A

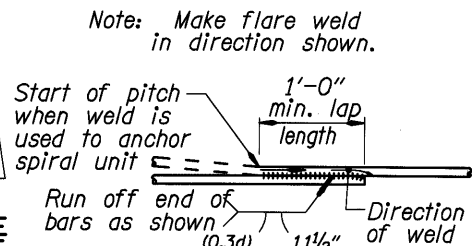

**WELDED SPLICE**  
See Note A


Start of pitch when mechanical splice is used to anchor spiral unit

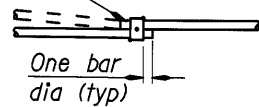

**MECHANICAL SPLICE**  
(Not allowed for ASTM A82 spirals)

**SPIRAL SPLICE / TERMINATION DETAIL**

No Scale

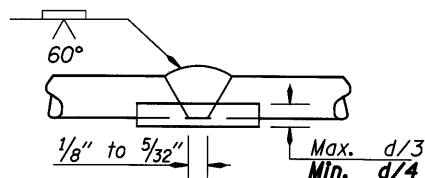

**ALTERNATE WELDED SPLICE**


(Except ASTM A82)

Welding of reinforcing steel splices shall be in accordance with ANSI/AWS D1.4-79. "Structural Welding Code Reinforcing Steel"

No Scale

**Note:**

Welded splice required for #8 hoops in columns and drilled shafts.

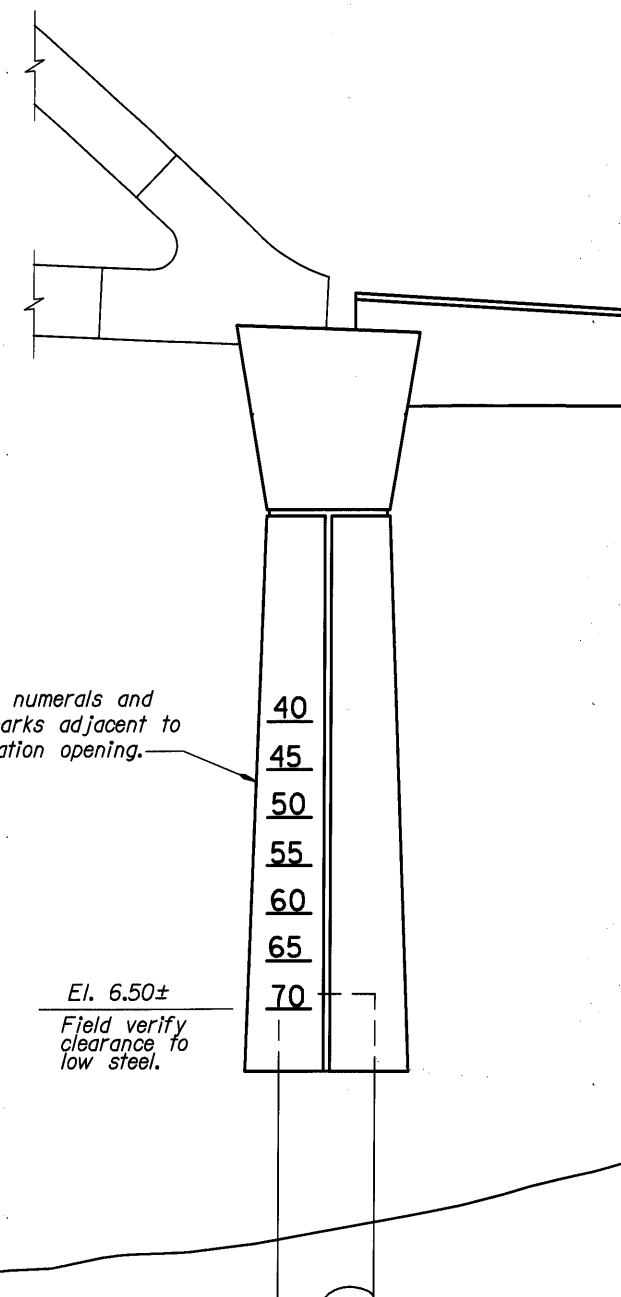

Paint numerals and footmarks adjacent to navigation opening.

El. 6.50±

Field verify clearance to low steel.

**CLEARANCE GAUGE DETAIL**


No Scale

**Clearance Gauge Notes:**


1. Clearance gauges are required at the downstream face of Bent 3 and the upstream face of Bent 4.
2. Clearance gauges shall conform to the U.S. Coast Guard Bridge Permit Application Guide.
3. The size and spacing of numerals and footmarks shall match the existing bridge unless otherwise directed by the Engineer.

DO NOT SCALE THIS DRAWING. FOLLOW DIMENSIONS. INDICATED SCALES CORRECT ONLY FOR FULL SIZE SHEET (22"x34").


	DATE	REVISION	BY	DESIGNER			BRIDGE NO.	MULTNOMAH CHANNEL & PNWR ETC., SAUVIE ISLAND RD.	SHEET 130 OF 173
	08/05	Revised Column	KWC	Ken Johnson			20136		
	03/09	As-Constructed	TDF	Josh Hewes			DATE	COLUMN AND DRILLED SHAFT DETAILS (3 OF 3)	DRAWING NO. 70318
				Adrienne Dietrich			Sept. 2005		
					530 Center Street N.E., Suite 605 Salem Oregon 97301 Phone: 503.361.8635	OREGON DEPARTMENT OF TRANSPORTATION BRIDGE ENGINEERING SECTION	CALC. BOOK		

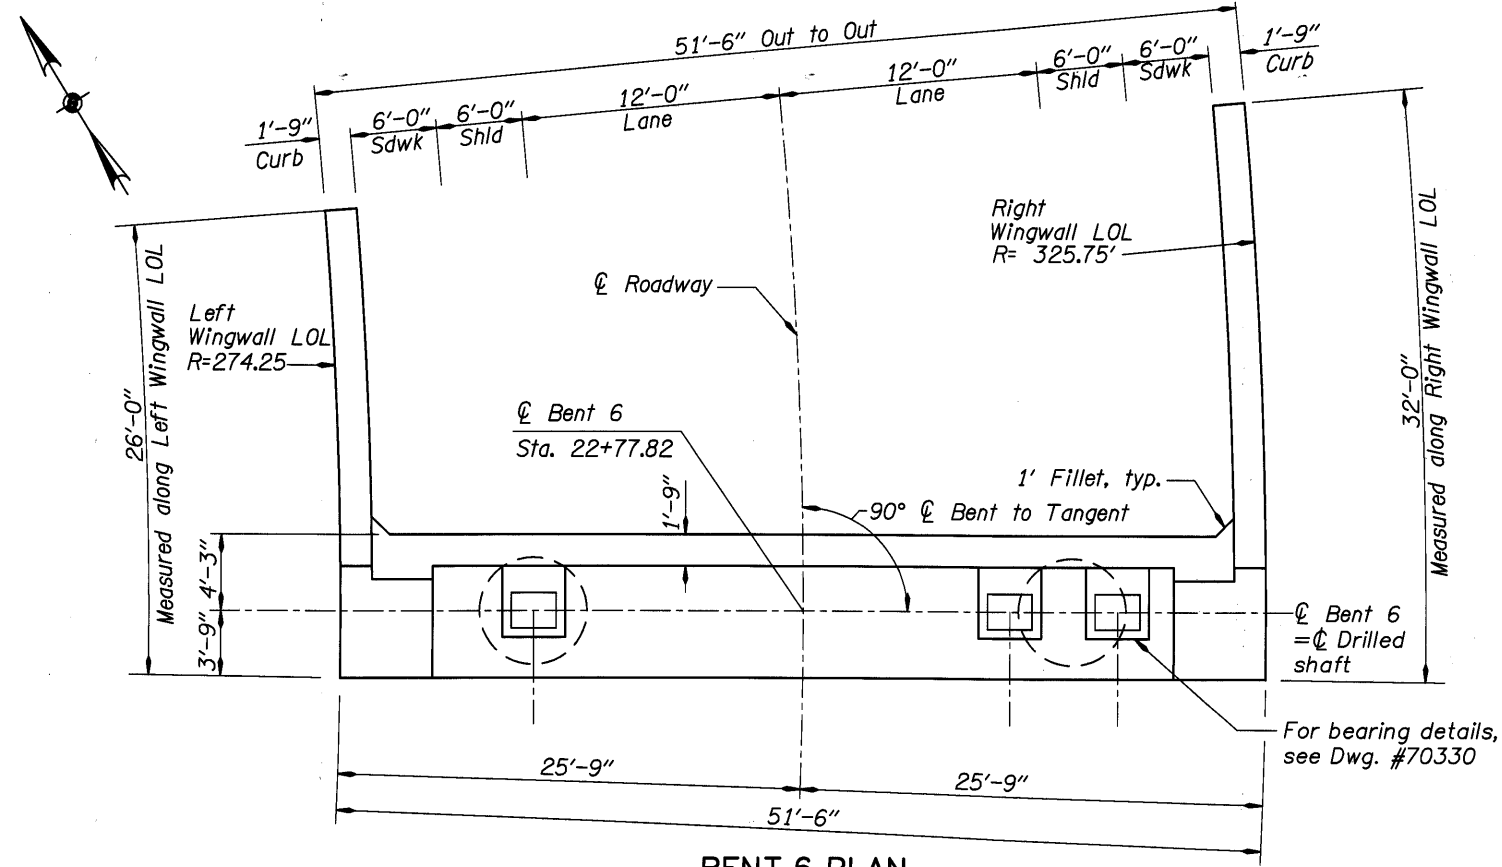

**BENT 6 PLAN**  
Scale: 3/16"=1'-0"

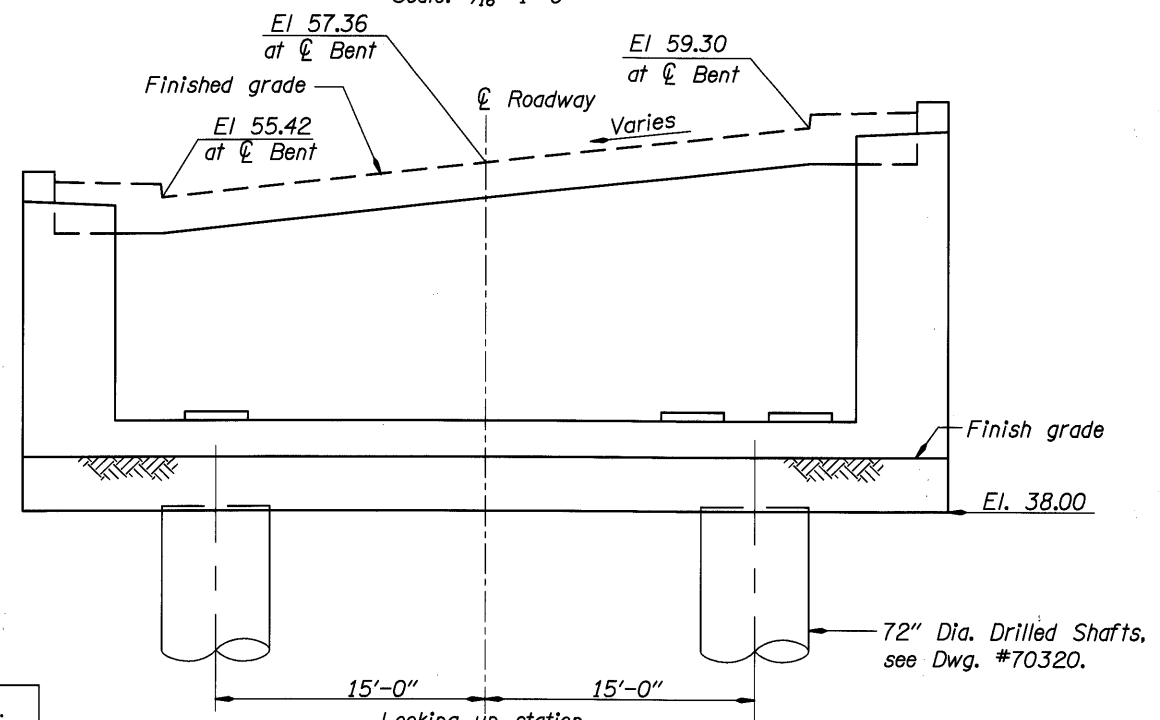

**BENT 6 ELEVATION**  
Scale: 3/16"=1'-0"

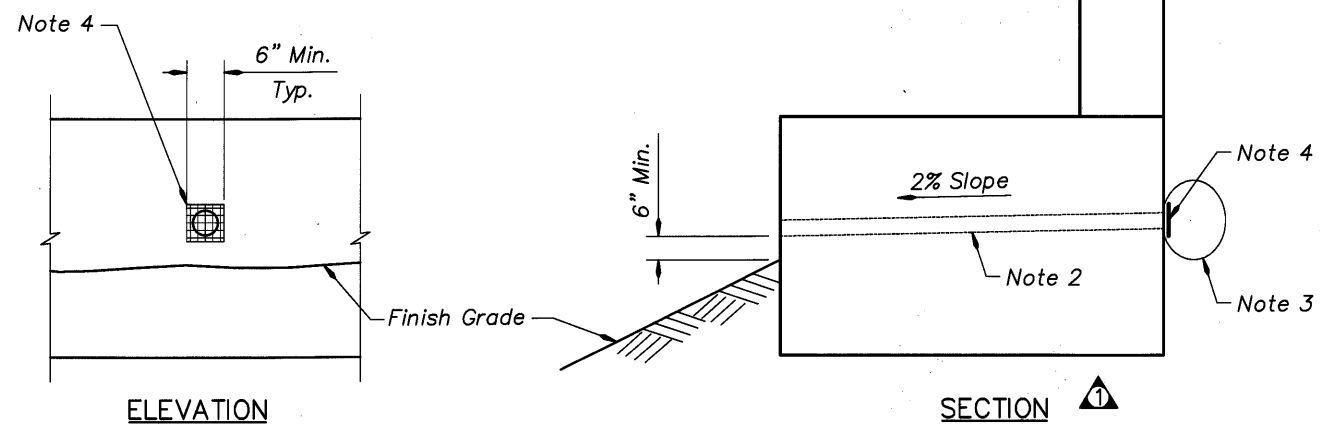


**WEEP HOLE DETAIL**  
No Scale

- Notes:**
1. Bent 6 shown, Bent 1 similar.
  2. 4" dia. weep holes at 20'-0" max.
  3. 2 cu. ft. of gravel drain material wrapped in drainage geotextile.
  4. 6" min. square aluminum or galvanized steel wire 1/4" hardware cloth (minimum wire dia. = 0.025"). Anchor firmly to backface.


- Note:**
- See Dwg. #70336 and #70337 for deck drainage details.
  - See Dwg. #70343 to #70355 for lighting details and conduit locations.
  - See Dwg. #70360 for utility conduit and hanger details.

DO NOT SCALE THIS DRAWING. FOLLOW DIMENSIONS. INDICATED SCALES CORRECT ONLY FOR FULL SIZE SHEET (22"x34").


	DATE	REVISION	BY	Ken Johnson DRAFTED:	REVIEWED DAVID EVANS ASSOCIATES INC. 530 Center Street N.E., Suite 605 Salem Oregon 97301 Phone: 503.361.8635	BRIDGE NO. 20136	MULTNOMAH COUNTY TRANSPORTATION DIVISION BRIDGES	SHEET 131 OF 173.
	08/05	Revised Weep Hole Detail view title	KWC					
	03/09	As-Constructed	TDF	Adrienne Dietrich DESIGNED:	EXPIRES: 12-31-05	CALC. BOOK	OREGON DEPARTMENT OF TRANSPORTATION BRIDGE ENGINEERING SECTION	DRAWING NO. 70319
BENT 6 - PLAN AND ELEVATION								

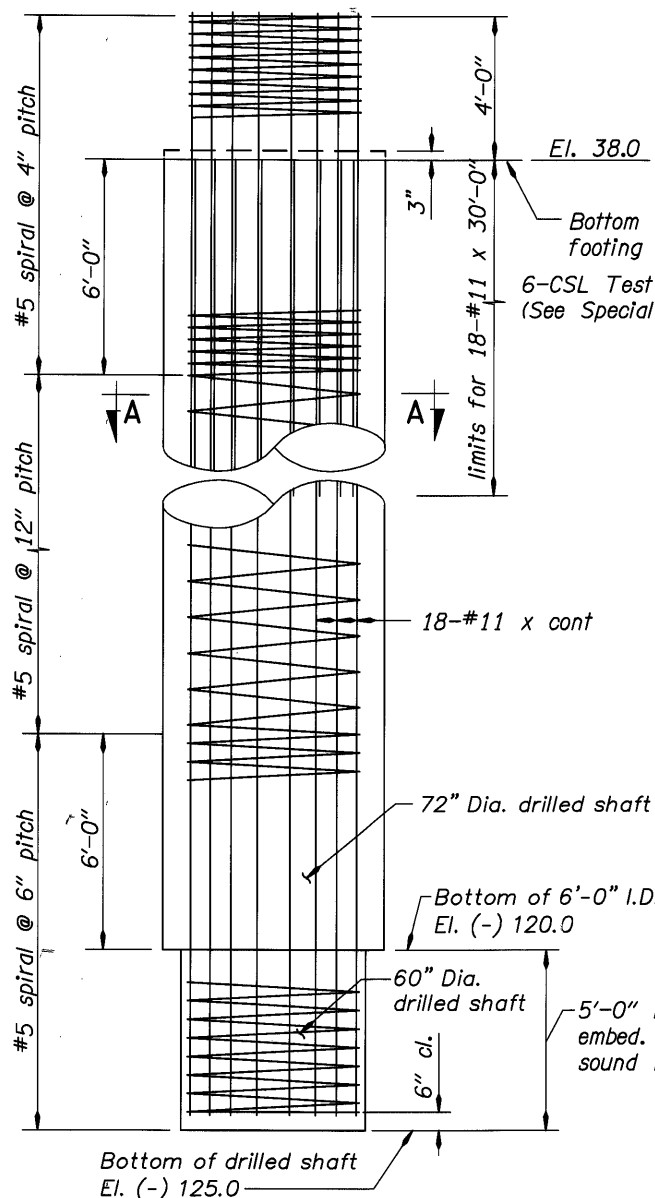

**BENT 6 - DRILLED SHAFT**  
Scale: 3/8"=1'-0"

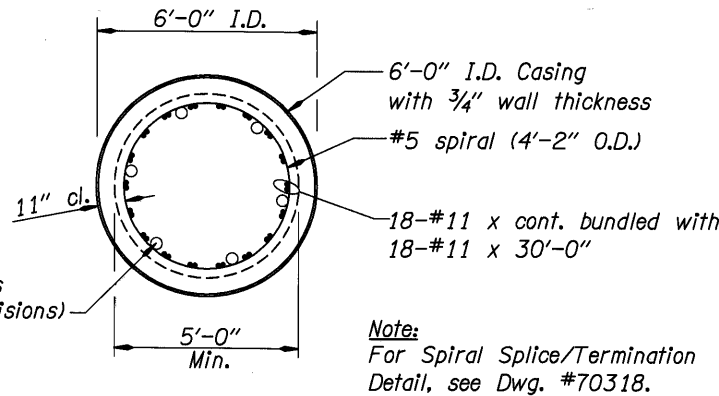


**SECTION A-A**  
Scale: 3/8"=1'-0"

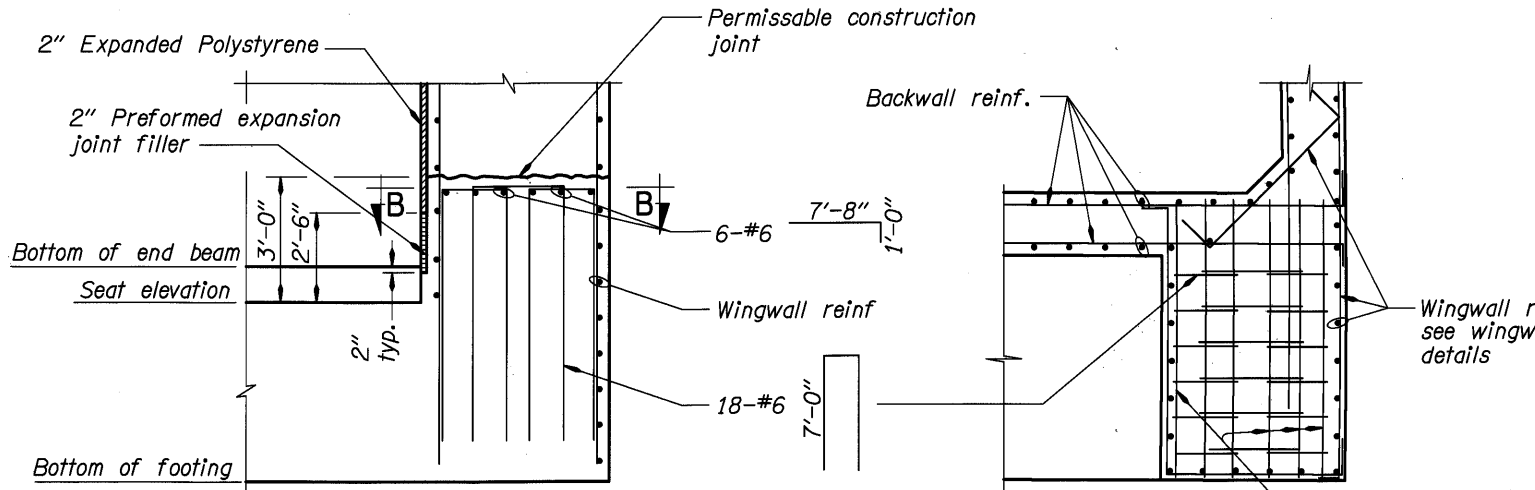

**BENT 6 SHEAR KEY**  
Scale: 3/8"=1'-0"

**SECTION B-B**  
Scale: 3/8"=1'-0"

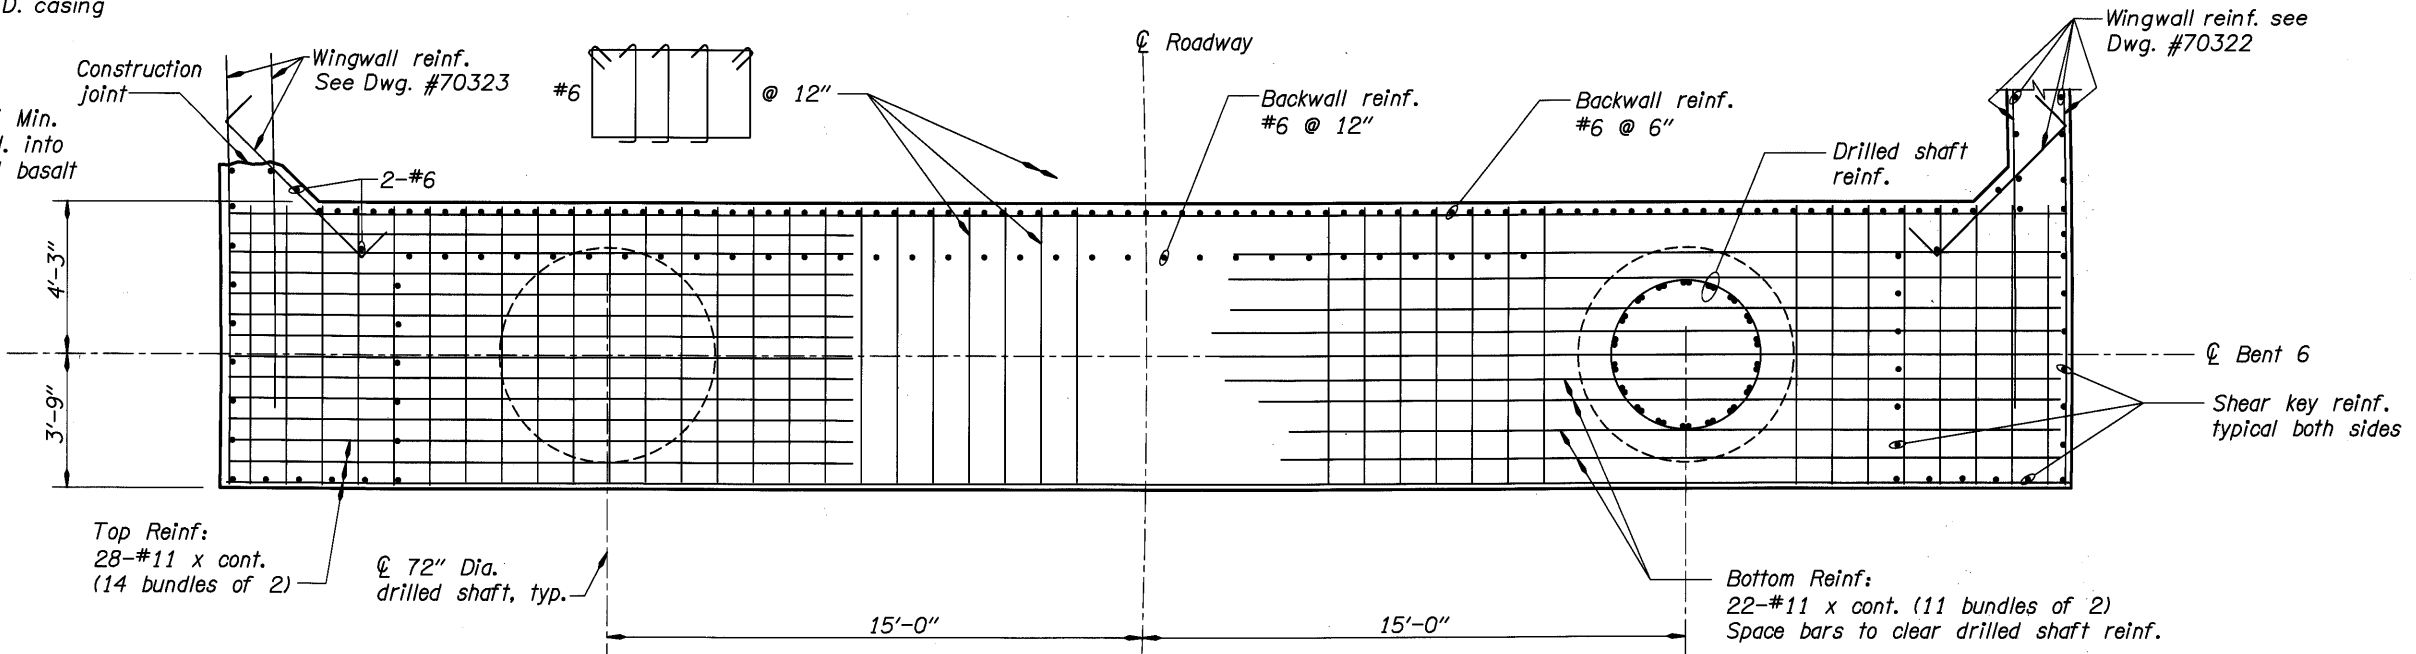


**BENT 6 FOOTING PLAN**  
Scale: 3/8"=1'-0"


DO NOT SCALE THIS DRAWING. FOLLOW DIMENSIONS. INDICATED SCALES CORRECT ONLY FOR FULL SIZE SHEET (22"x34").

DATE	03/09	REVISION	As-Constructed	BY	Ken Johnson	REVIEWED			TRANSPORTATION DIVISION	BRIDGE NO.	20136	SHEET	132	
					Josh Hewes					DATE	Sept. 2005			
					Adrienne Dietrich					CALC. BOOK				
										MULTNOMAH CHANNEL & PNWR ETC., SAUVIE ISLAND RD.		DRAWING NO.		70320
										<b>BENT 6 - FOOTING PLAN</b>				

Notes:  
1. See Dwg. #70195 and #70196 for Construction Sequence.

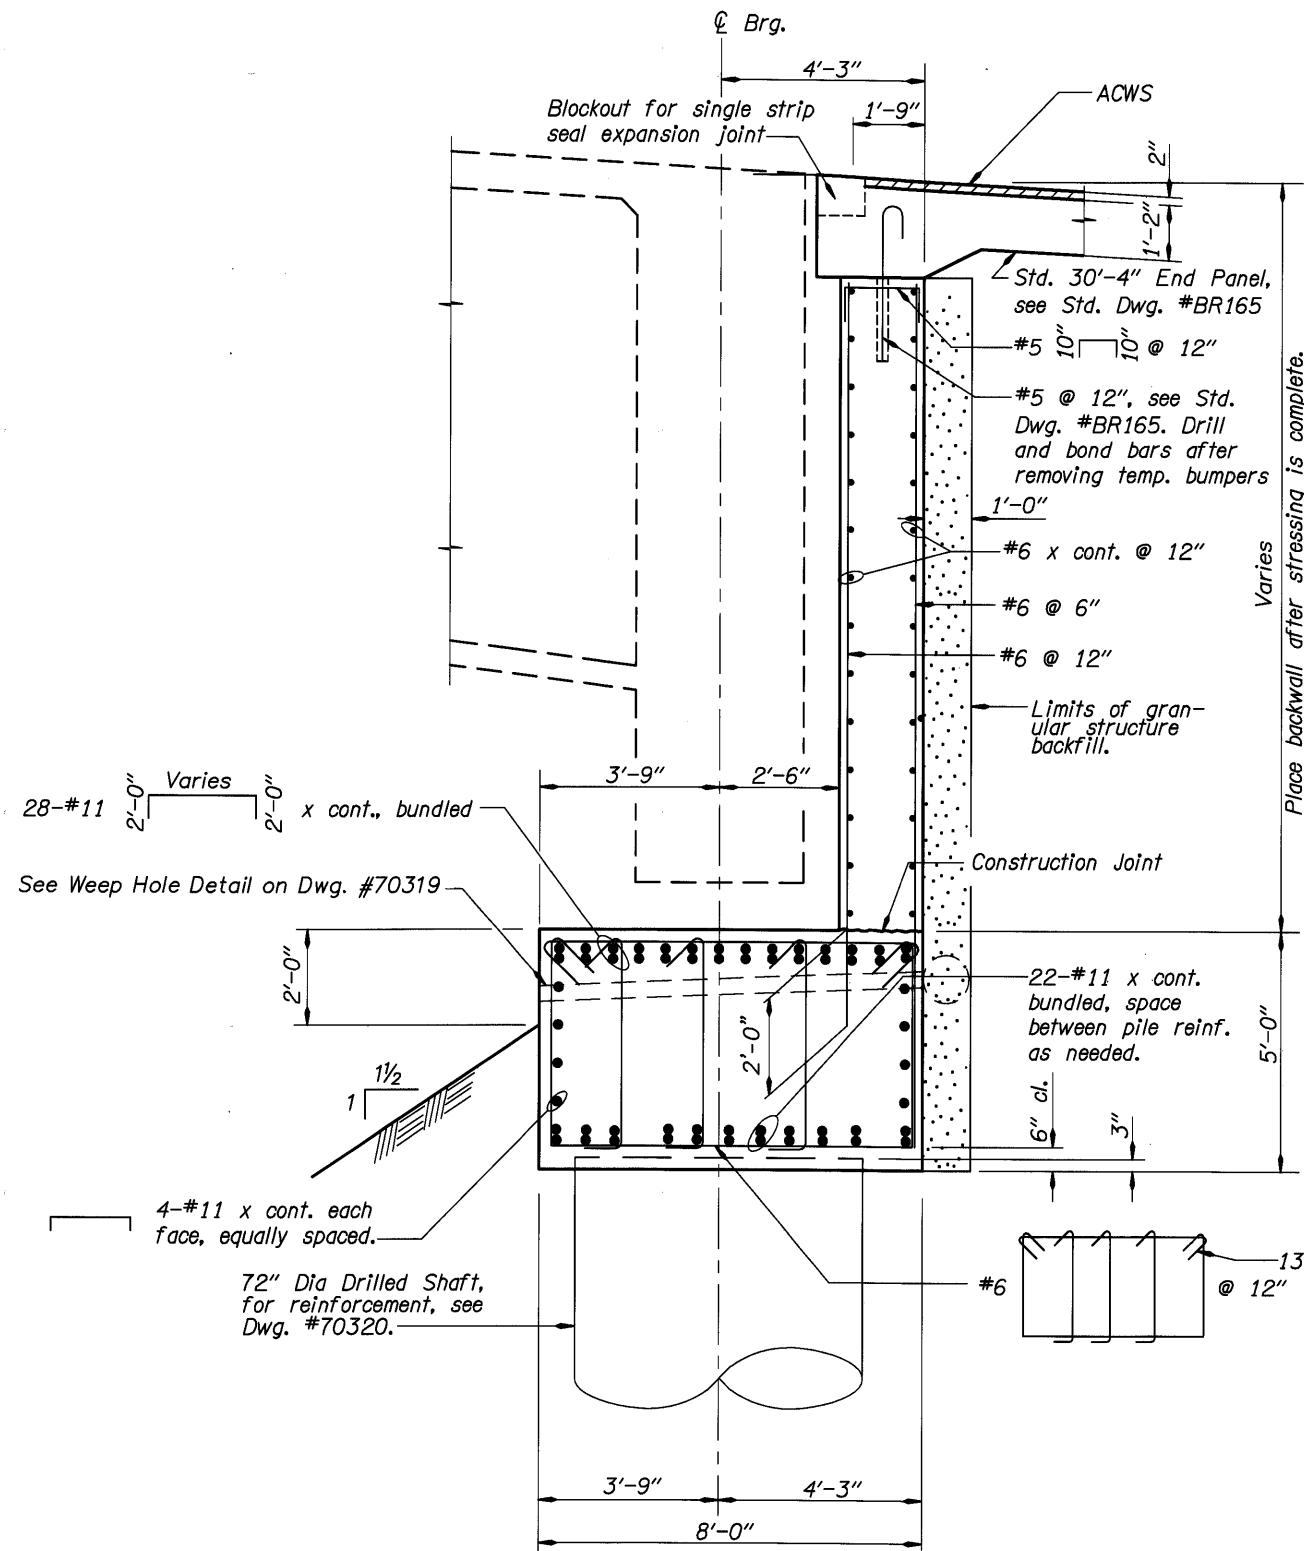

**TYPICAL SECTION - BENT 6**  
Scale: 1/2"=1'-0"

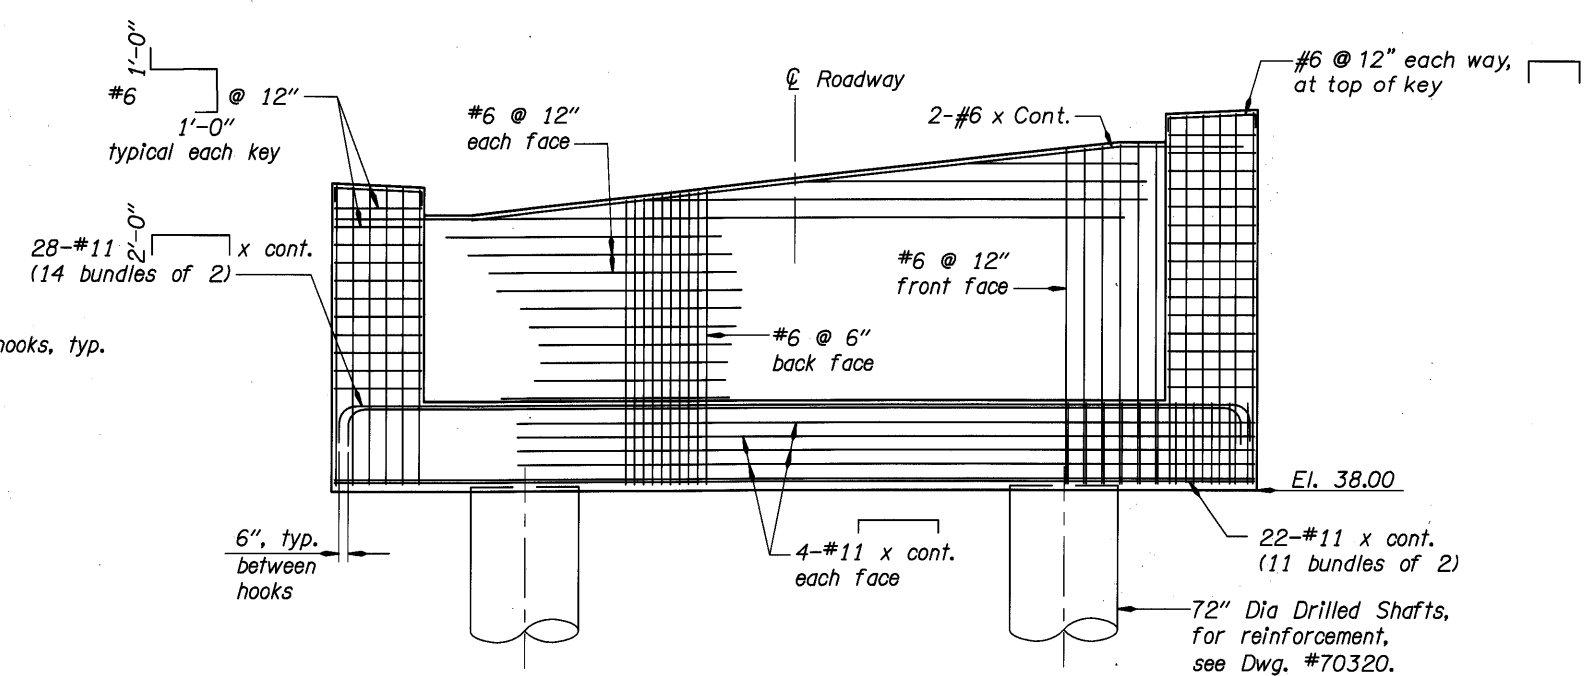


(Looking up station)  
**BENT 6 ELEVATION**  
Scale: 3/16"=1'-0"

DO NOT SCALE THIS DRAWING.  
FOLLOW DIMENSIONS. INDICATED  
SCALES CORRECT ONLY FOR  
FULL SIZE SHEET (22"x34").


	DATE	REVISION	BY	Ken Johnson	REVIEWED 		BRIDGE NO.	20136	SHEET 133 OF 173
	08/05	Revised Typical Section and deleted Temporary Bumper	KWC	DRAFTED:			Josh Hewes	TRANSPORTATION DIVISION	
	03/09	As-Constructed	TDF	CHECKED:	Adrienne Dietrich	OREGON DEPARTMENT OF TRANSPORTATION BRIDGE ENGINEERING SECTION	CALC. BOOK		DRAWING NO.
				DESIGNED:					BENT 6 - TYPICAL SECTION AND DETAILS
									70321

Xref: 0400cad.dwg

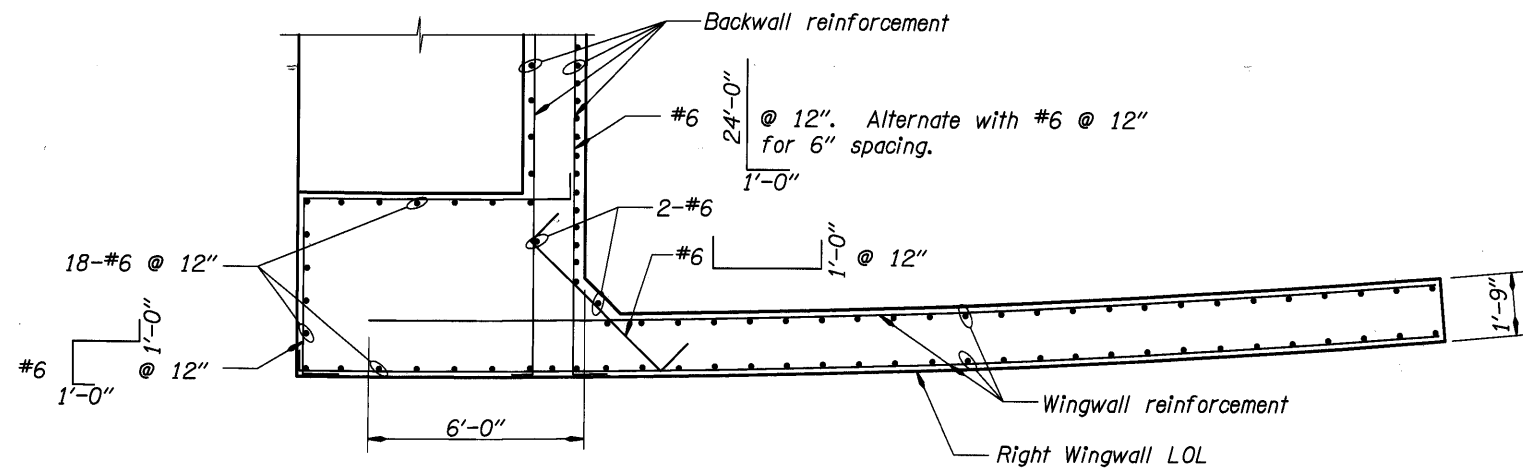


**WINGWALL PLAN**

Scale: 3/8" = 1'-0"

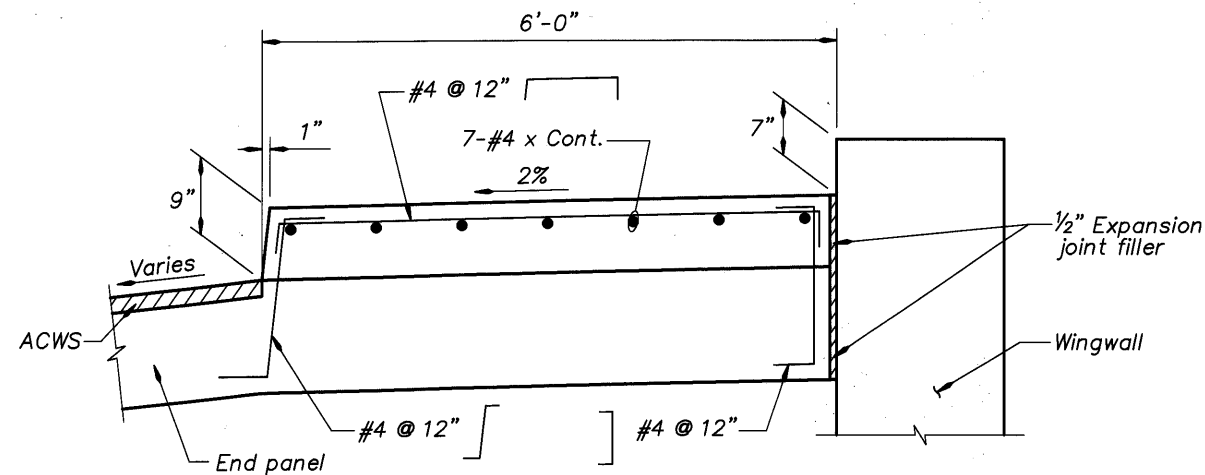


**SIDEWALK DETAIL**

Scale: 1" = 1'-0"

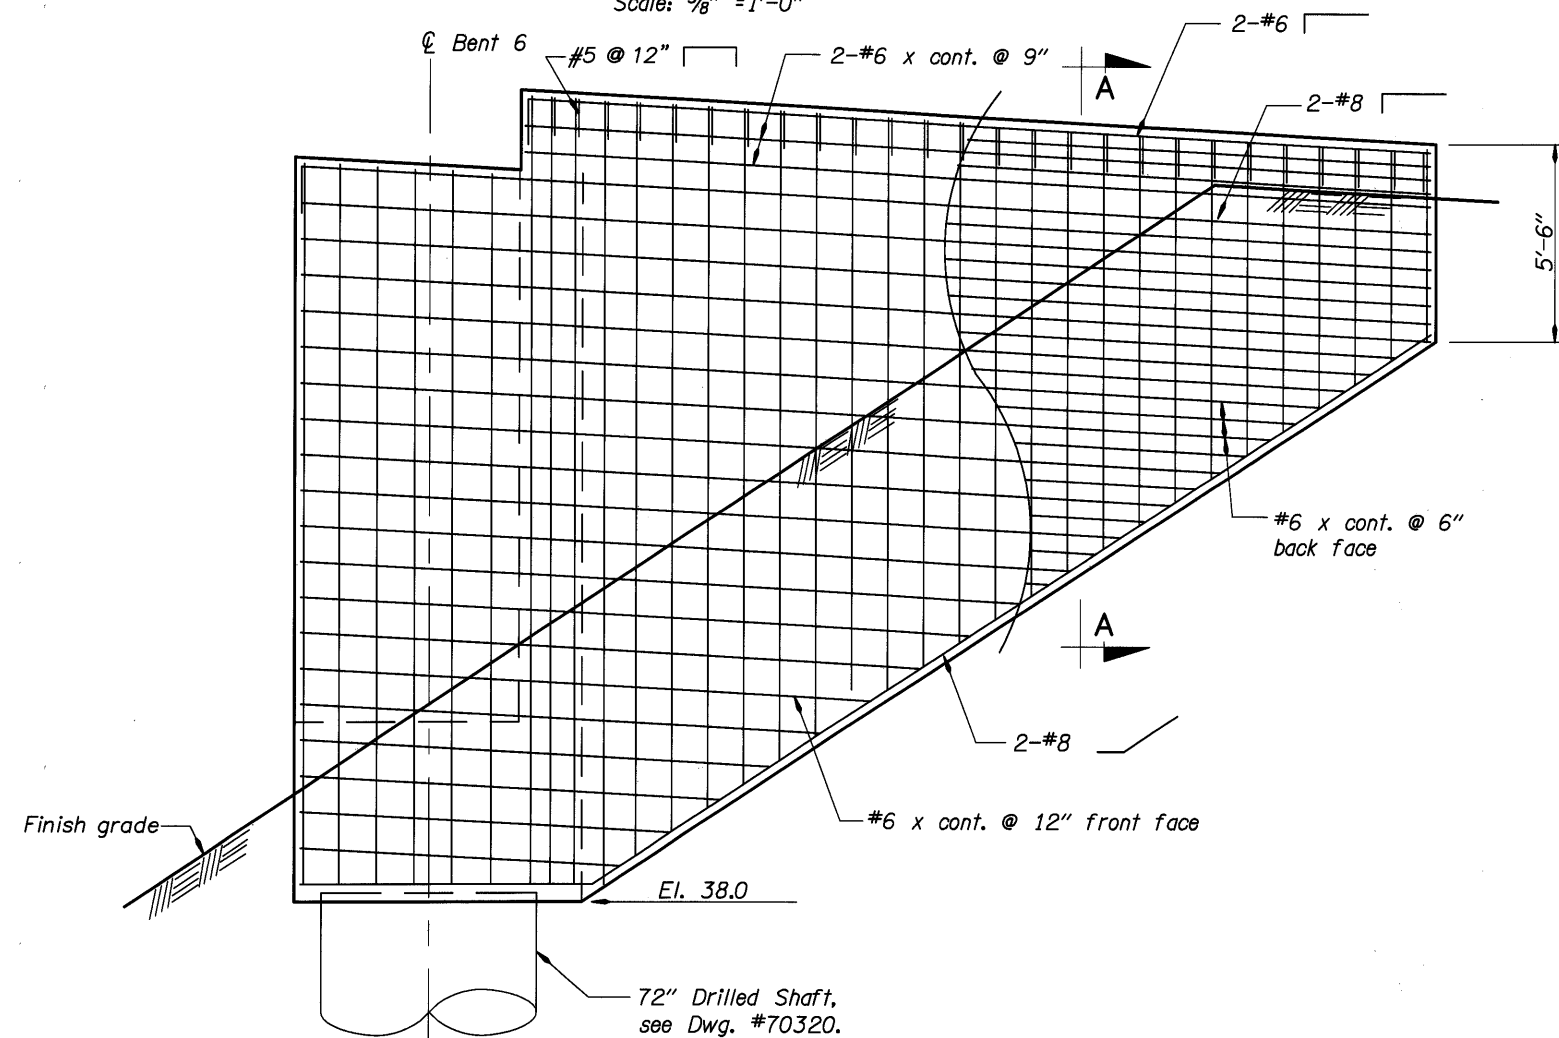

**RIGHT WINGWALL ELEVATION**

Scale: 3/8" = 1'-0"

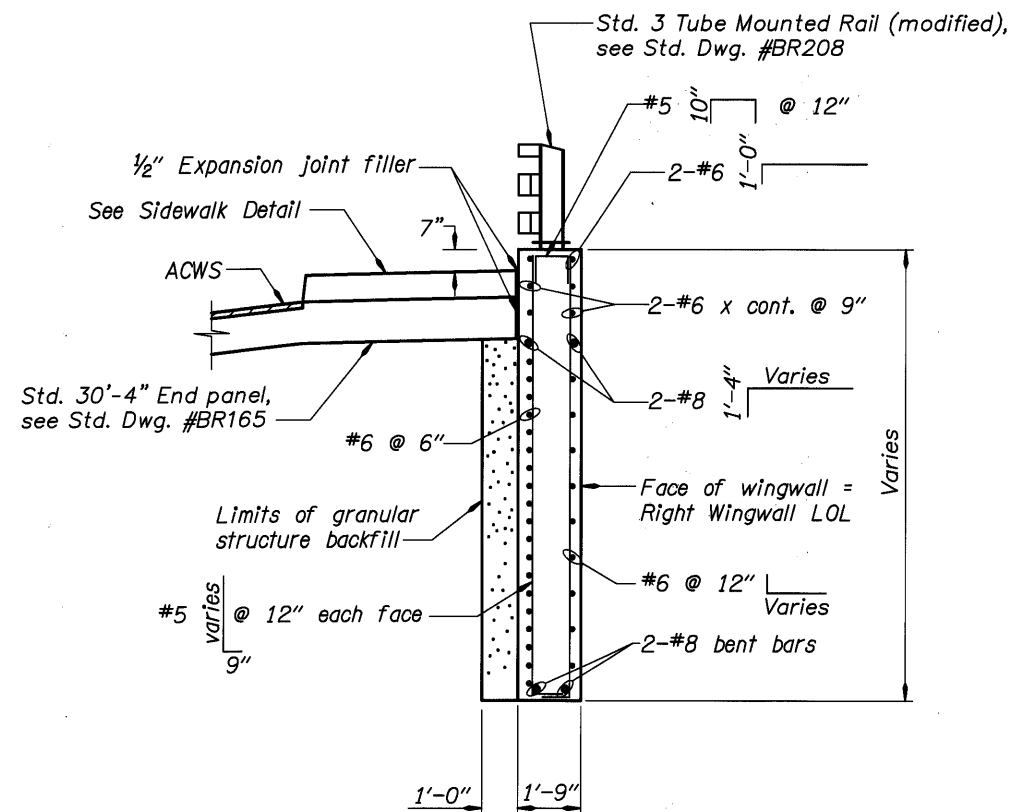


**SECTION A-A**

Scale: 3/8" = 1'-0"


DO NOT SCALE THIS DRAWING.  
FOLLOW DIMENSIONS. INDICATED  
SCALES CORRECT ONLY FOR  
FULL SIZE SHEET (22"x34").

	DATE	REVISION	BY	Ken Johnson DRAFTED:	REVIEWED 		TRANSPORTATION DIVISION BRIDGE NO. 20136	MULTNOMAH CHANNEL & PNWR ETC., SAUVIE ISLAND RD.	SHEET 134 OF 173.
	08/05	Revised Wingwall Plan	KWC						
	03/09	As-Constructed	TDF	Adrienne Dietrich DESIGNED:	DAVID EVANS AND ASSOCIATES INC. 530 Center Street N.E., Suite 605 Salem Oregon 97301 Phone: 503.361.8635		CALC. BOOK	DRAWING NO. 70322	

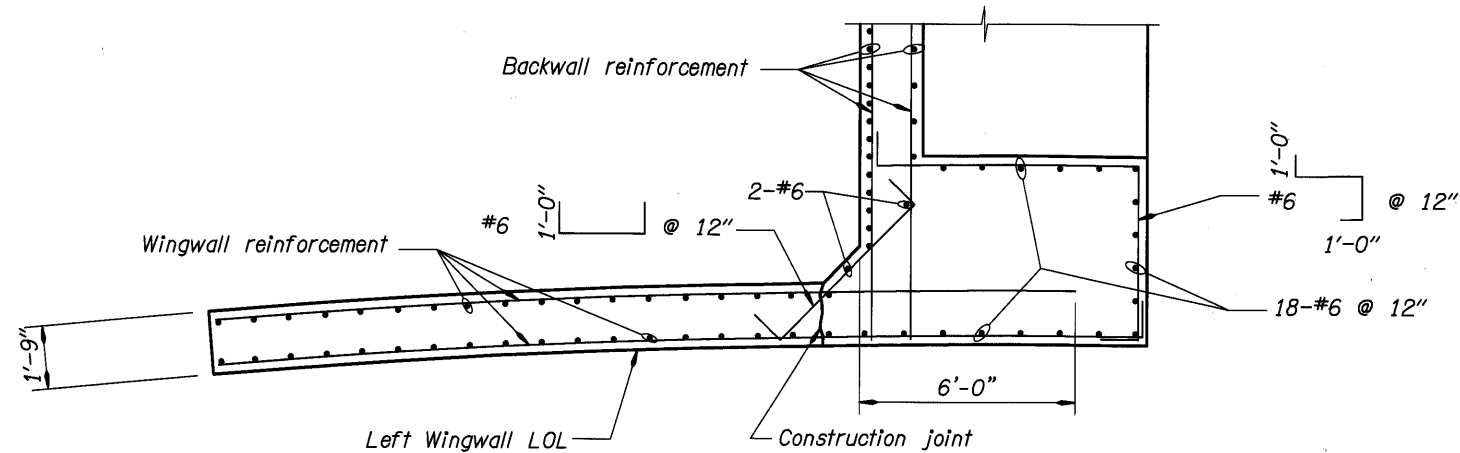


**WINGWALL PLAN**

Scale: 3/8"=1'-0"

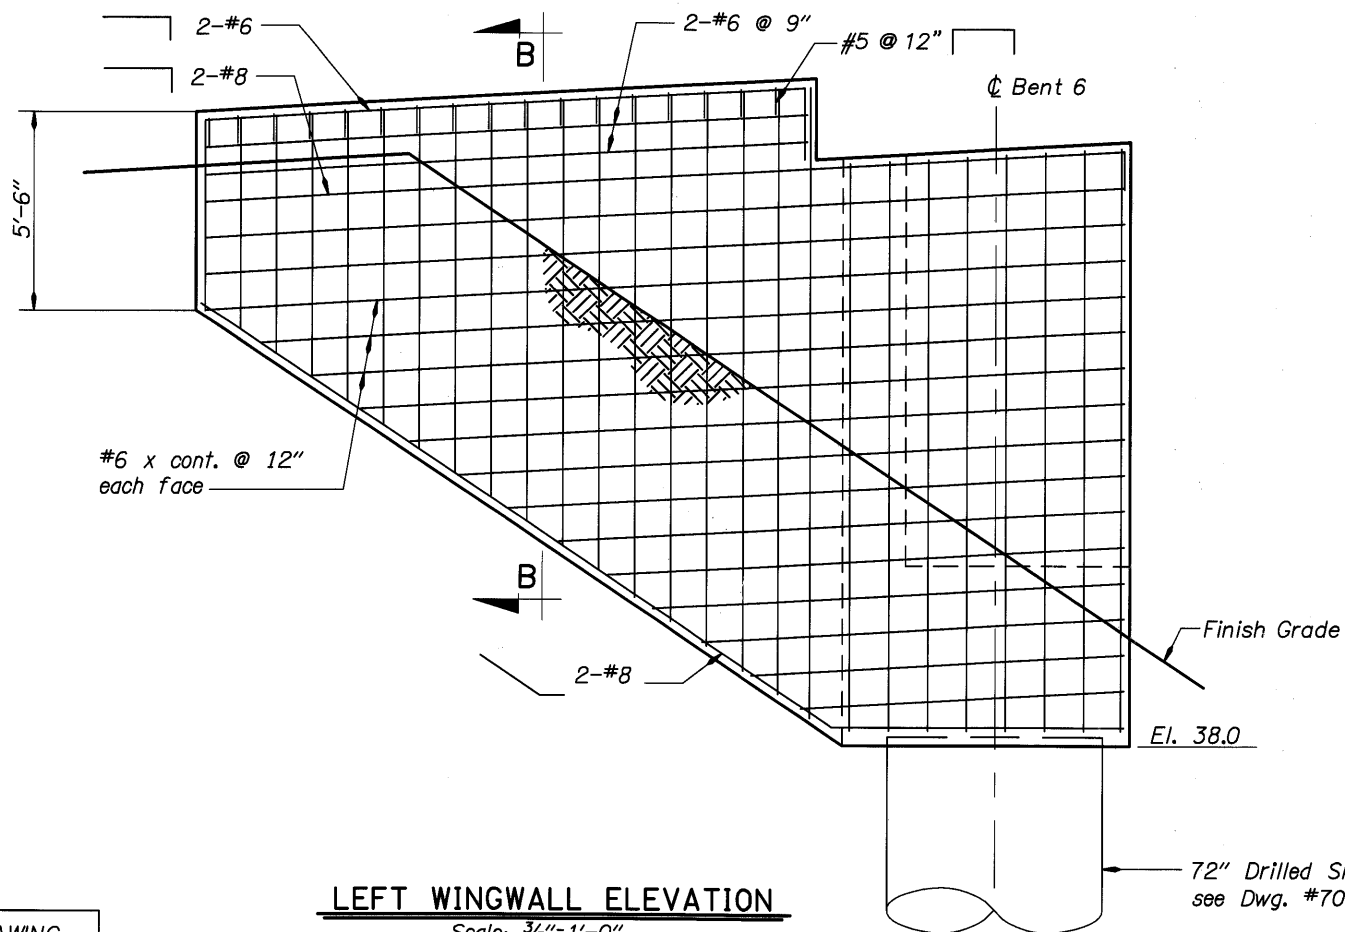

**LEFT WINGWALL ELEVATION**

Scale: 3/8"=1'-0"

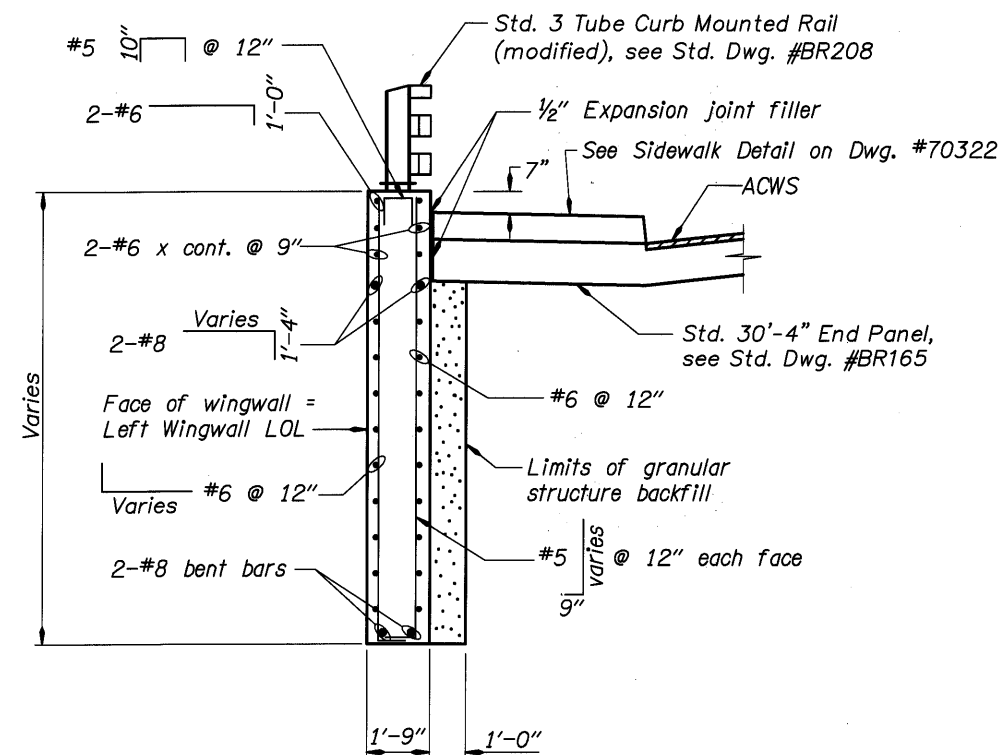


**SECTION B-B**

Scale: 3/8"=1'-0"


DO NOT SCALE THIS DRAWING. FOLLOW DIMENSIONS. INDICATED SCALES CORRECT ONLY FOR FULL SIZE SHEET (22"x34").

DATE	REVISION	BY	REVIEWED	BRIDGE NO.	SHEET
		Ken Johnson	DAVID EVANS AND ASSOCIATES INC.	20136	135
		Josh Hewes	530 Center Street N.E., Suite 605 Salem Oregon 97301 Phone: 503.361.8635	DATE Sept. 2005	OF 173
		Adrienne Dietrich	MULTNOMAH COUNTY BRIDGES	CALC. BOOK	DRAWING NO. 70323
TRANSPORTATION DIVISION OREGON DEPARTMENT OF TRANSPORTATION BRIDGE ENGINEERING SECTION				MULTNOMAH CHANNEL & PNWR ETC., SAUVIE ISLAND RD. BENT 6 - LEFT WINGWALL PLAN AND ELEVATION	

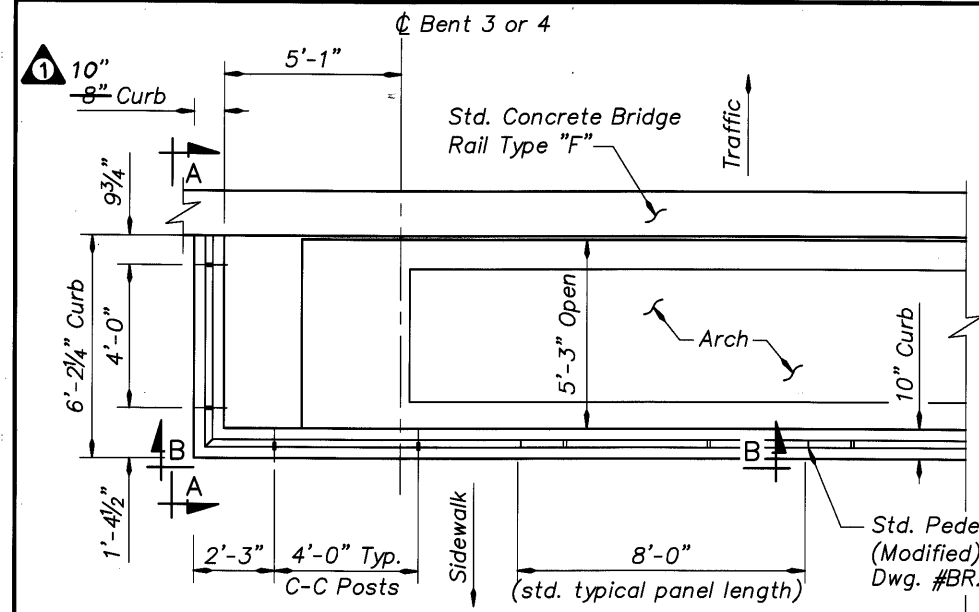


**PEDESTRIAN RAIL TERMINATION PLAN**

Scale:  $\frac{3}{8}'' = 1'-0''$   
(All corners similar)

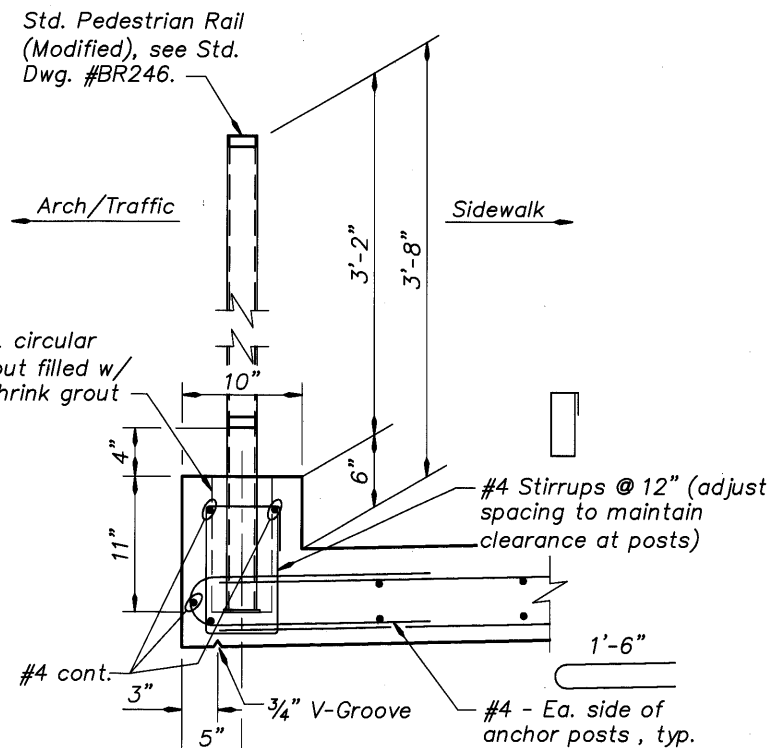


**ANCHOR POST SECTION**

Scale:  $\frac{1}{2}'' = 1'-0''$

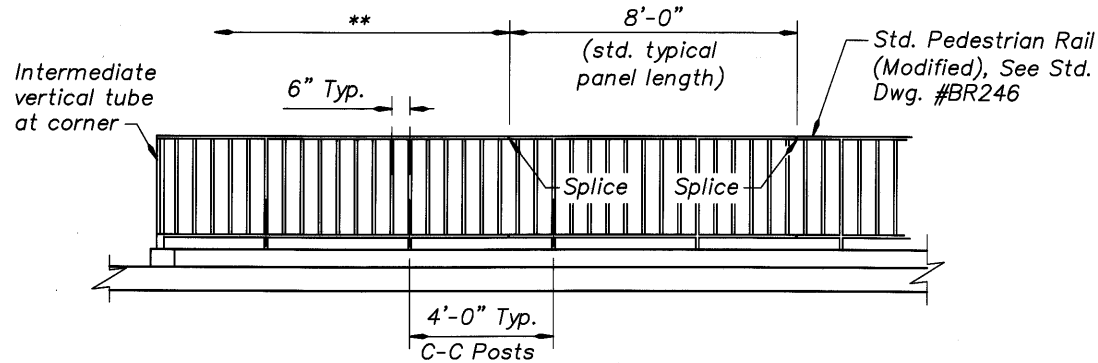

**VIEW B-B**

Scale:  $\frac{3}{8}'' = 1'-0''$

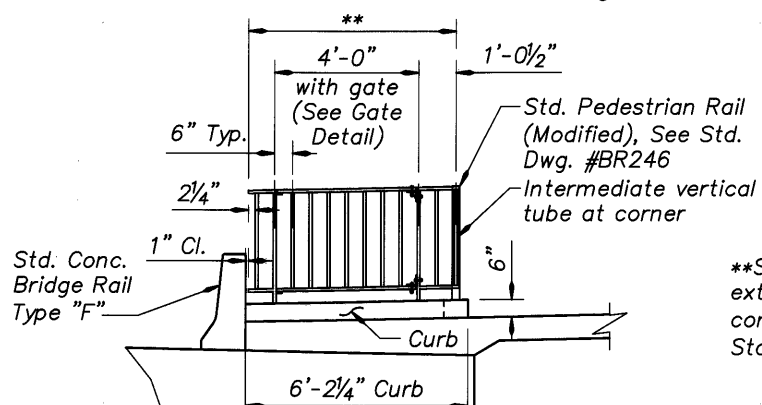


**VIEW A-A**

Scale:  $\frac{3}{8}'' = 1'-0''$

\*\*Special end panel with gate extends from splice around corner to within 1" clear of Std. Conc. Bridge Rail Type "F".


**MODIFICATIONS TO STANDARD PEDESTRIAN RAIL**

Notes:  
For Pedestrian Rail details not shown, see Std. Dwg. #BR246.  
For Sidewalk and curb details not shown, see "Typical Section" on Dwg. #70214 and "Deck Plan" on Dws. #70210 and #70211.

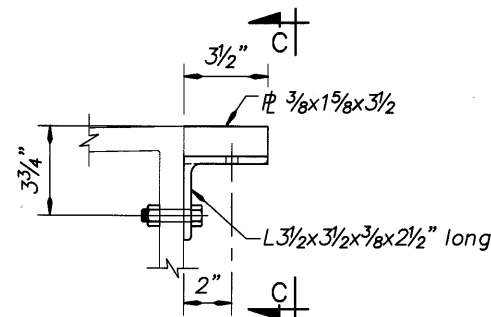


**DETAIL "A"**

Scale:  $\frac{3}{8}'' = 1'-0''$

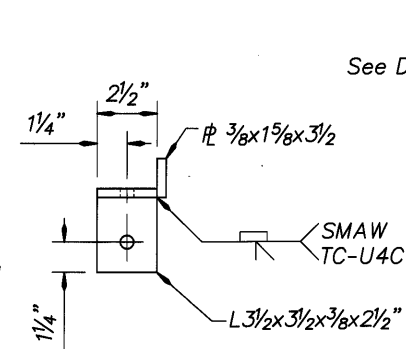


**VIEW C-C**

Scale:  $\frac{3}{8}'' = 1'-0''$

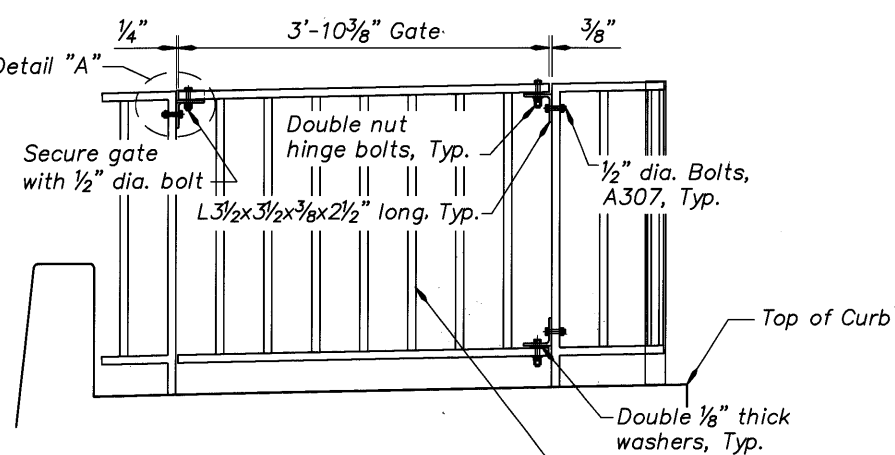

**GATE DETAIL**

Scale:  $1'' = 1'-0''$

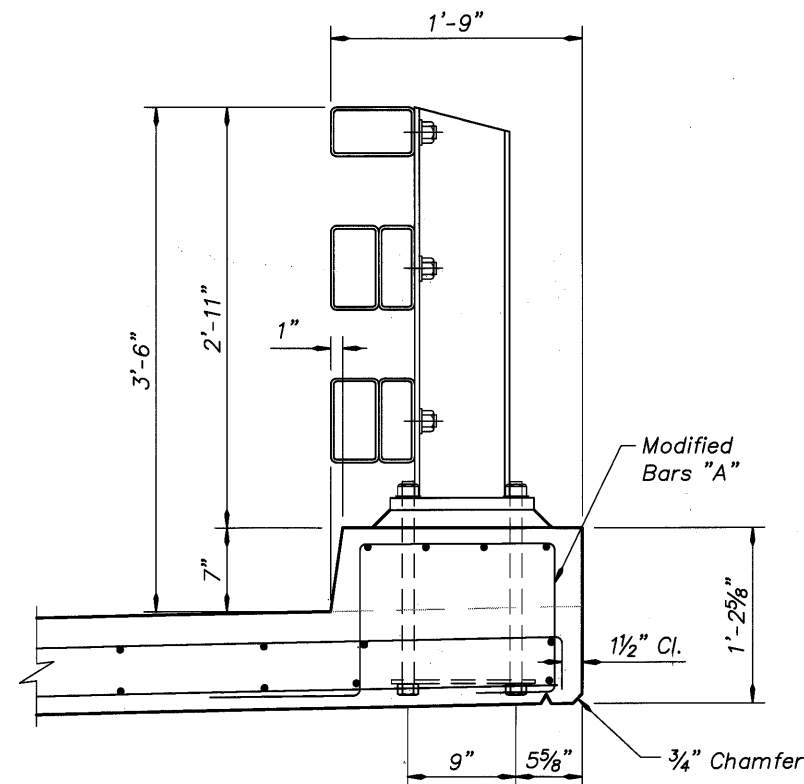


**MODIFICATIONS TO STANDARD 3 TUBE CURB MOUNTED RAIL**


Scale:  $\frac{1}{2}'' = 1'-0''$

Notes:  
For 3 Tube Curb Mounted Rail details not shown, see Std. Dwg. #BR208.  
For Sidewalk and curb details not shown, see "Typical Section" on Dwg. #70214 and "Deck Plan" on Dws. #70210 and #70211.  
For Modified Bars "A", see Sidewalk Detail - Spans 2, 4, and 5 on Dwg. #70327.





DATE	03/09	REVISION	As-Constructed	BY	J. Patton	DESIGNER	 DAVID EVANS AND ASSOCIATES INC. 530 Center Street N.E., Suite 605 Salem Oregon 97301 Phone: 503.361.8635	 MULTNOMAH COUNTY BRIDGES TRANSPORTATION DIVISION	BRIDGE NO.	20136	MULTNOMAH CHANNEL & PNWR ETC., SAUVIE ISLAND RD.	SHEET	136
	CHECKED:	Shonn Mills	REVIEWED:	Kent Cordtz	DATE				Sept. 2005	OF		173	
										CALC. BOOK		DRAWING NO.	70324
										RAILING DETAILS (1 OF 4)			

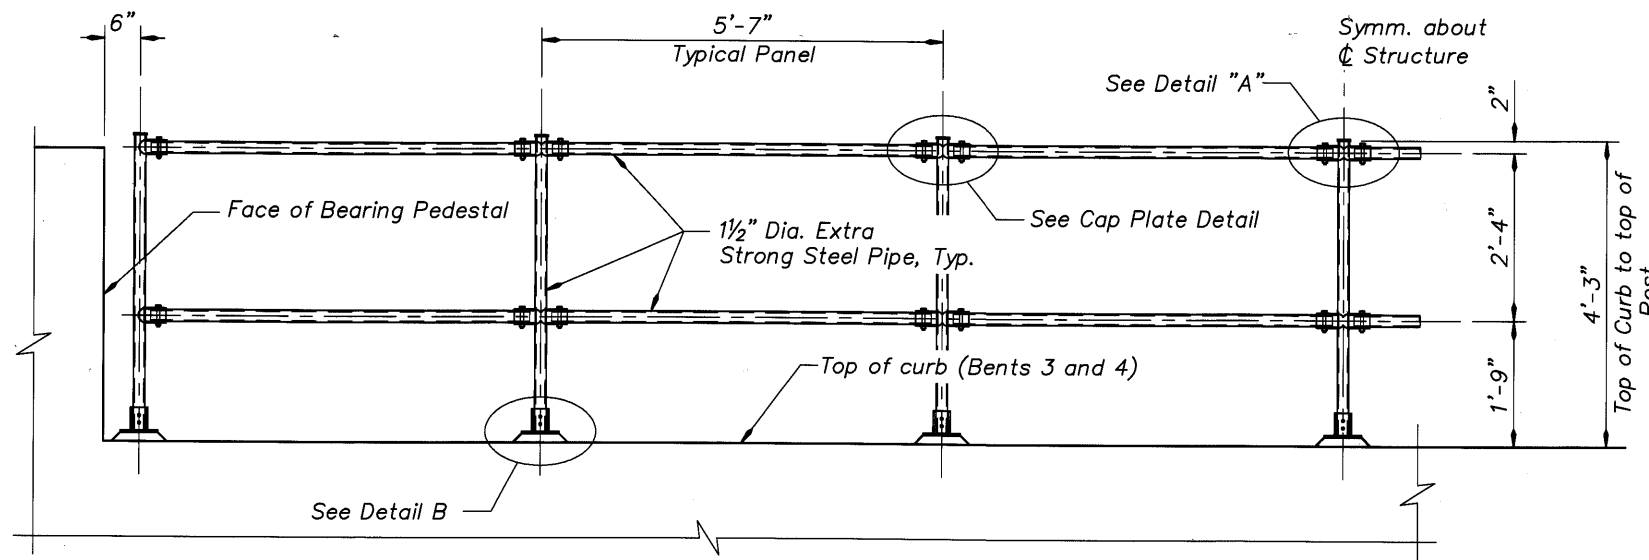


**ELEVATION**  
Scale: 3/4" = 1'-0"

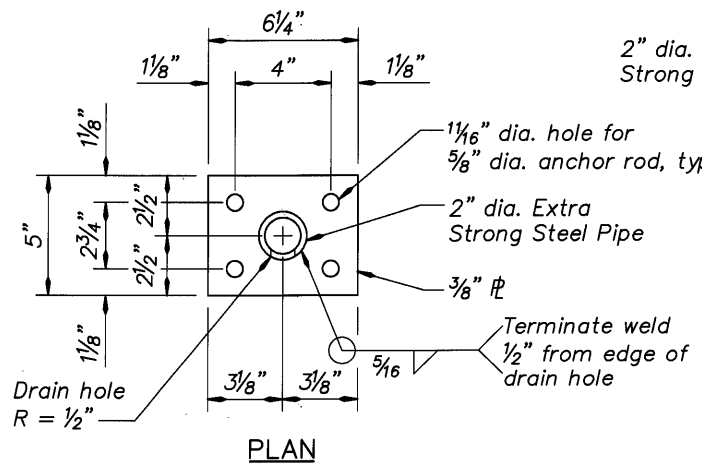

**BASE PLATE DETAILS**  
Scale: 3" = 1'-0"

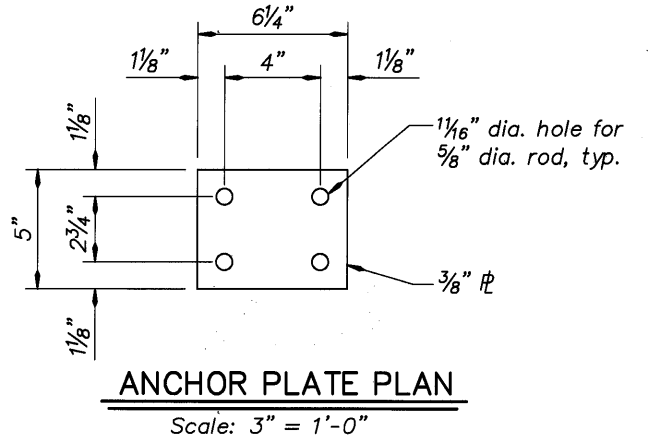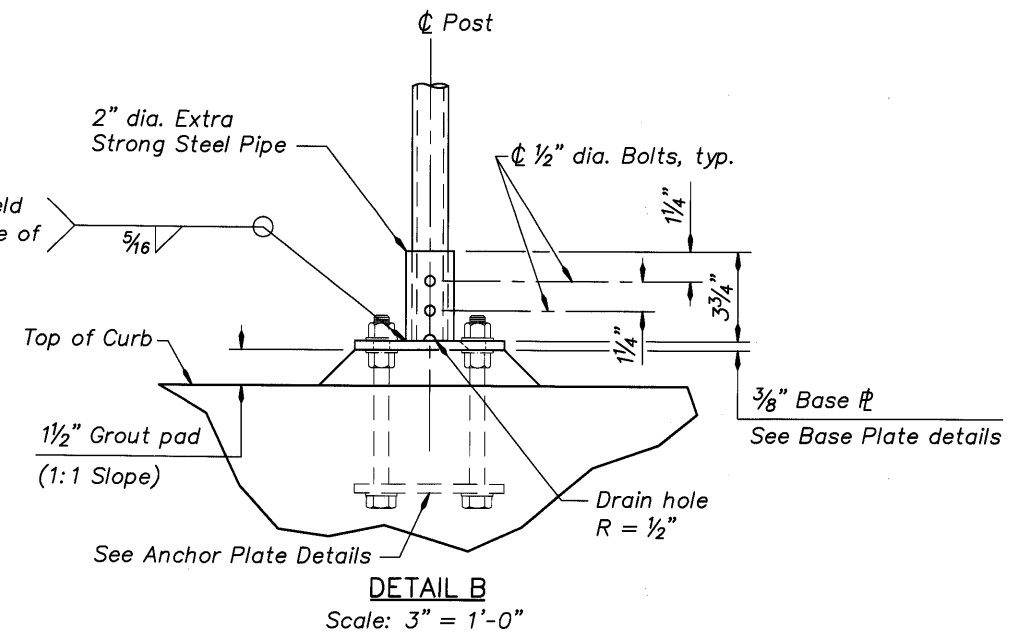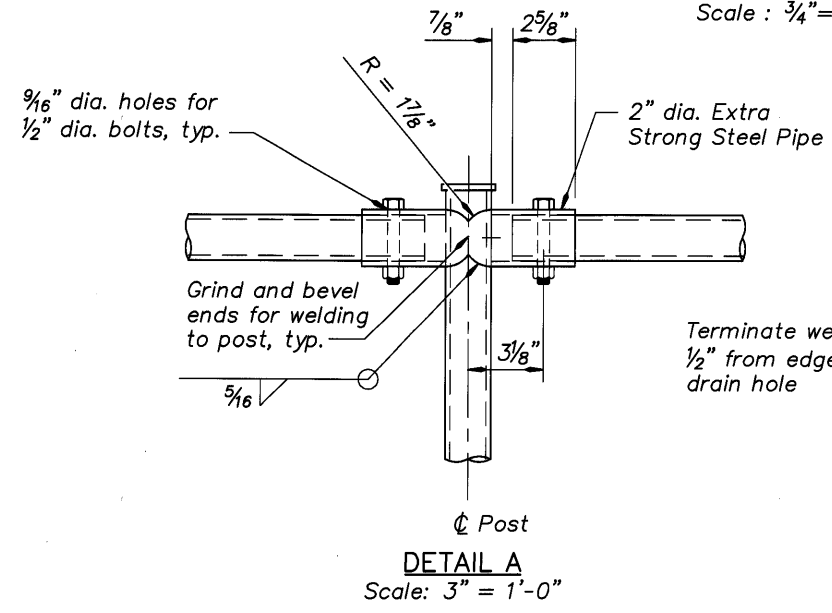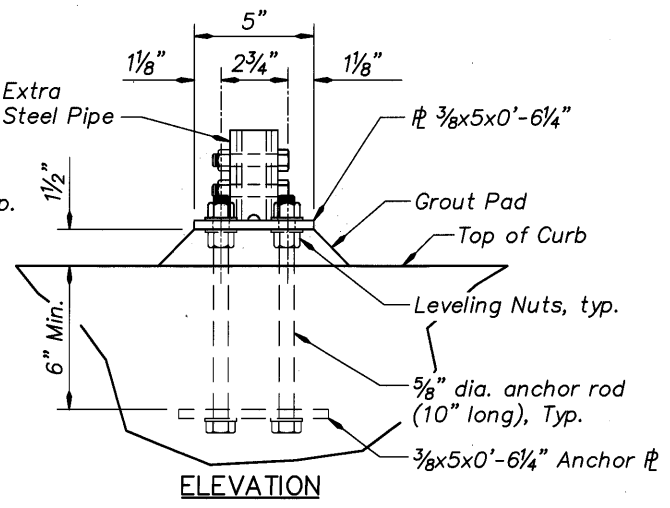

**BENTS 3 AND 4 SAFETY RAILING DETAILS**

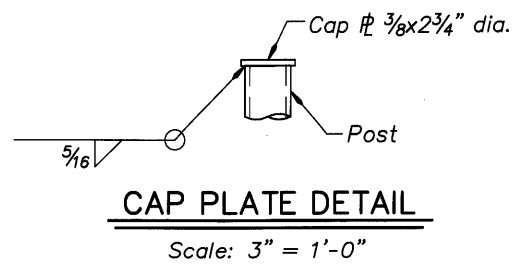


- Notes:**
1. See Dwg. #70306 and #70312 for rail location on Bents 3 and 4.
  2. Steel pipe rails and posts shall be horizontal and plumb, respectively.
  3. Anchor rods and bolts shall conform to AASHTO M314 (ASTM A307), Grade 36.
  4. Rail and post elements shall conform to ASTM A53, Grade B.
  5. Anchor plate and base plate shall conform to ASTM A36.
  6. Nuts for anchor bolts shall conform to ASTM A563, Grade DH.
  7. All structural steel including anchor rods, bolts, nuts, and washers shall be hot dip galvanized after fabrication. Provide galvanizing drain holes as required.

DO NOT SCALE THIS DRAWING. FOLLOW DIMENSIONS. INDICATED SCALES CORRECT ONLY FOR FULL SIZE SHEET (22"x34").


DATE 03/09	REVISION As-Constructed	BY TDF	DRAFTED: J. Patton	DESIGNER REGISTERED PROFESSIONAL ENGINEER 70783 Richard King JULY 9, 2002 RICHARD J. KING	CONNECTING COMMERCE AND COMMUNITY MULTNOMAH COUNTY BRIDGES	TRANSPORTATION DIVISION	BRIDGE NO. 20136	SHEET 137 OF 173.	
			CHECKED: Shonn Mills				DAVID EVANS AND ASSOCIATES INC. 530 Center Street N.E., Suite 605 Salem Oregon 97301 Phone: 503.361.8635		OREGON DEPARTMENT OF TRANSPORTATION BRIDGE ENGINEERING SECTION
			REVIEWED: Kent Cordtz	EXPIRES: 6-30-07			CALC. BOOK	DRAWING NO. 70325	
								RAILING DETAILS (2 OF 4)	



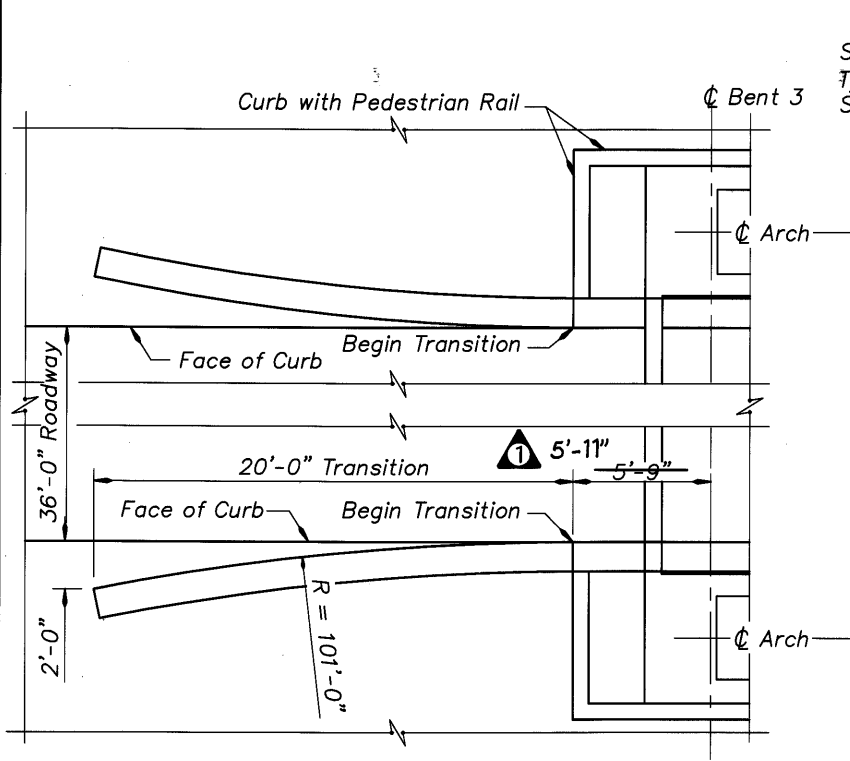

PLAN


**Notes:**  
 Sidewalk and deck reinforcement not shown for clarity.  
 Top longitudinal rail bars follow the vertical taper through the transition. All other longitudinal rail bars do not change in relative vertical location and are to be discontinued at appropriate locations to maintain 2" min. cover on ends.

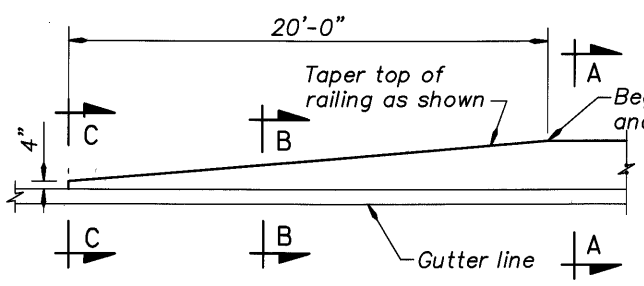

ELEVATION


**TYPE "F" RAIL TRANSITION**

Scale: 1/4" = 1'-0"  
 (Transition at Bent 3 shown - Bent 4 similar)

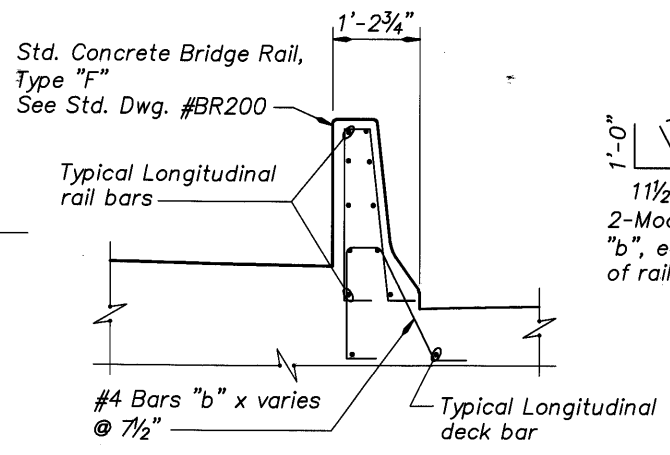


**SECTION A-A**

Scale: 3/4" = 1'-0"

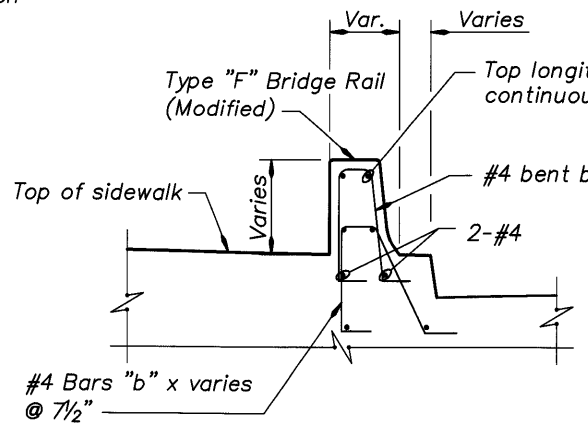


**SECTION B-B**

Scale: 3/4" = 1'-0"

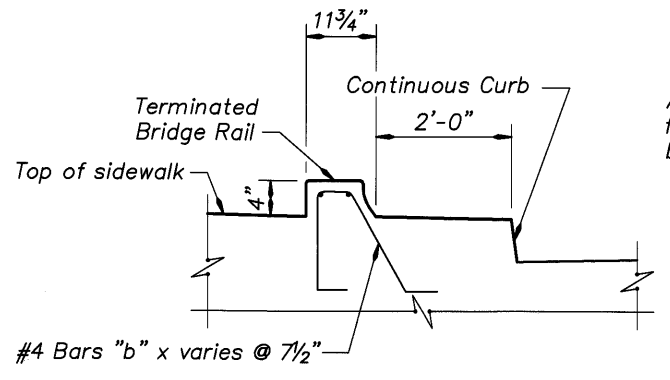


**SECTION C-C**

Scale: 3/4" = 1'-0"

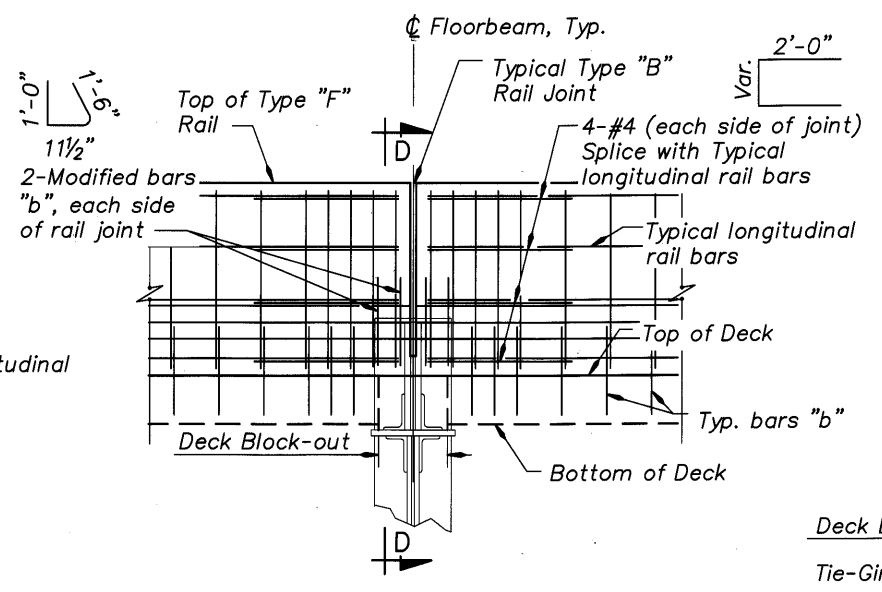


**RAIL ELEVATION**

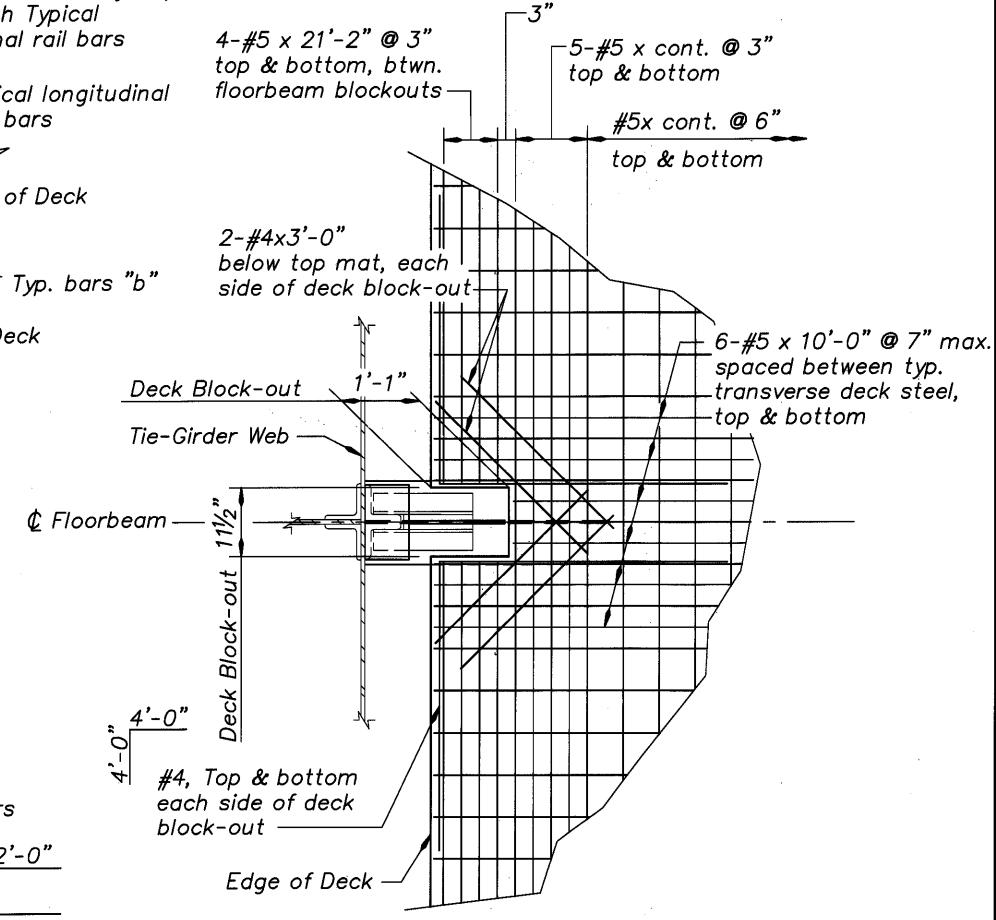

**PLAN**

**Note:**  
 See Dwg. #70210 and #70211 for locations and additional notes.

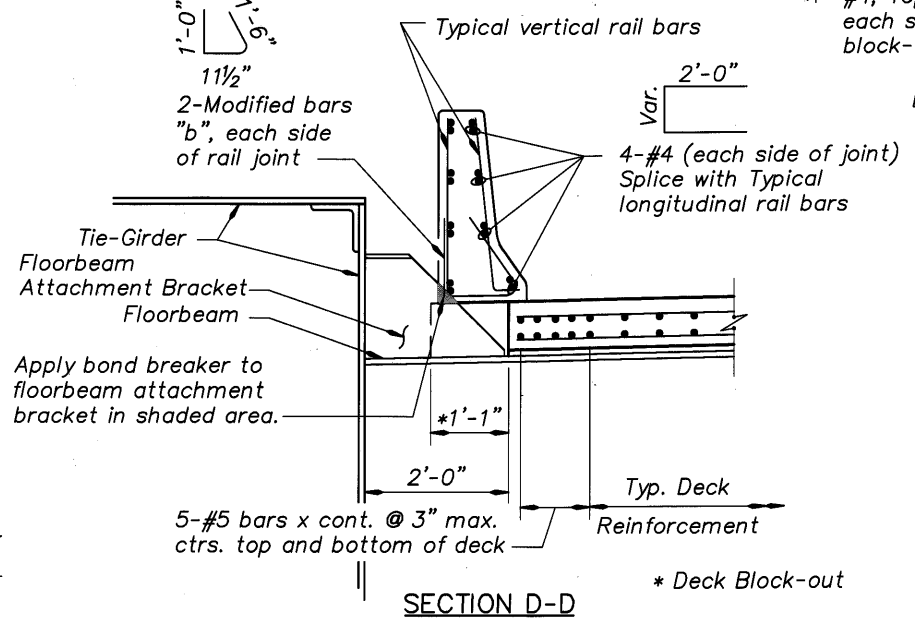

**SECTION D-D**

**RAIL MODIFICATION AND DECK BLOCK-OUT DETAILS**

Scale: 3/4" = 1'-0"

DO NOT SCALE THIS DRAWING. FOLLOW DIMENSIONS. INDICATED SCALES CORRECT ONLY FOR FULL SIZE SHEET (22"x34").

DATE	REVISION	BY
03/09	As-Constructed	TDF

**DESIGNER**  
 J. Patton  
**CHECKED:**  
 Shonn Mills  
**REVIEWED:**  
 Clifford Coulter


**DESIGNER**  
 REGISTERED PROFESSIONAL ENGINEER  
 OREGON  
 JULY 5, 2005  
 530 Center Street N.E., Suite 605  
 Salem Oregon 97301  
 Phone: 503.361.8635  
 EXPIRES: 6-30-06

CONNECTING COMMERCE AND COMMUNITY  
**MULTNOMAH COUNTY BRIDGES**  
 TRANSPORTATION DIVISION  
**OREGON DEPARTMENT OF TRANSPORTATION BRIDGE ENGINEERING SECTION**

**BRIDGE NO.**  
 20136  
**DATE**  
 Sept. 2005  
**CALC. BOOK**


MULTNOMAH CHANNEL & PNWR ETC., SAUVIE ISLAND RD.  
**RAILING DETAILS (3 OF 4)**

**SHEET**  
 138  
**OF**  
 173.  
**DRAWING NO.**  
 70326

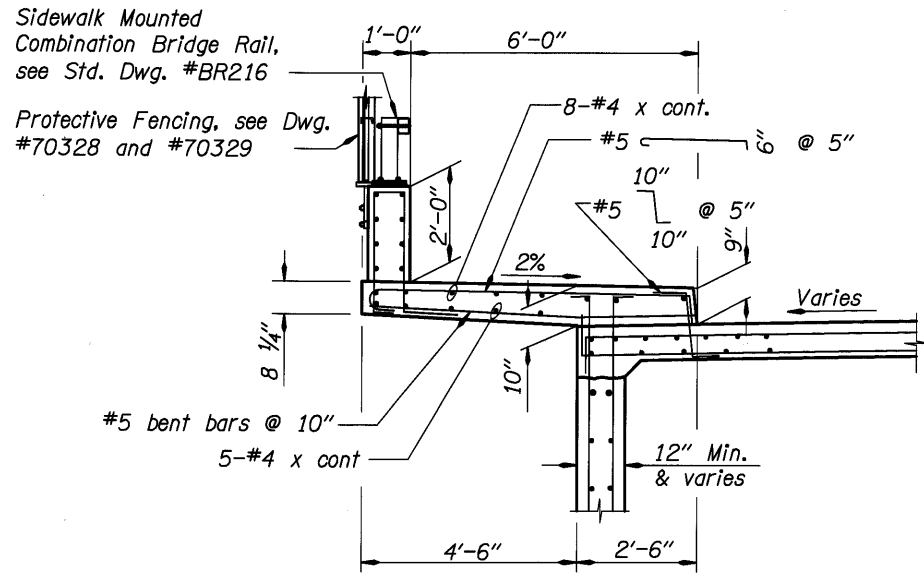


**SIDEWALK DETAIL - SPAN 1**

Scale: 1/2"=1'-0"

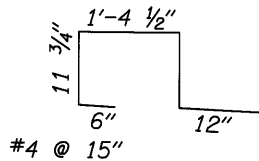


**MODIFIED BARS "A"**

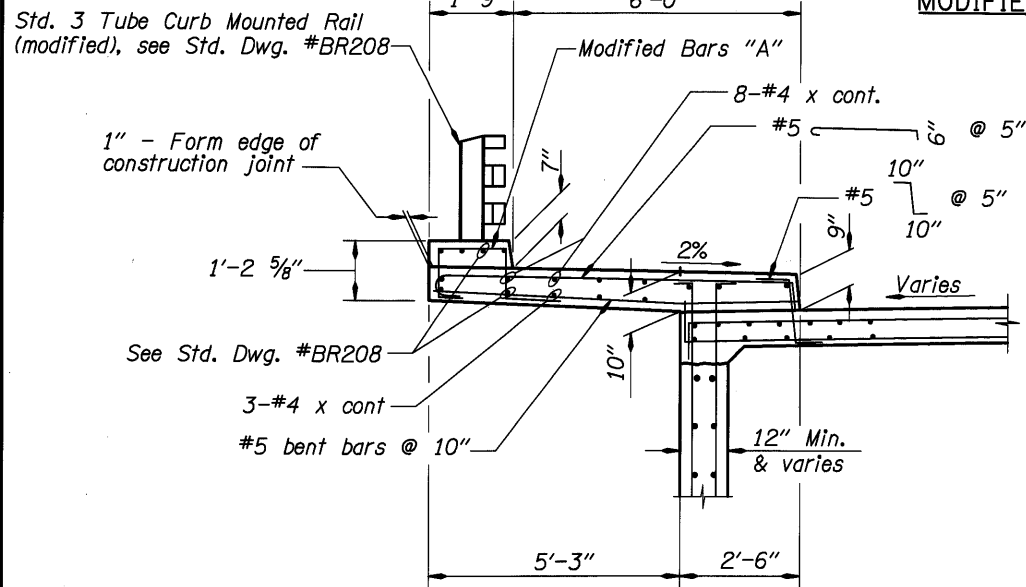

**SIDEWALK DETAIL - SPANS 2, 4, AND 5**


Scale: 1/2"=1'-0"

DO NOT SCALE THIS DRAWING. FOLLOW DIMENSIONS. INDICATED SCALES CORRECT ONLY FOR FULL SIZE SHEET (22"x34").

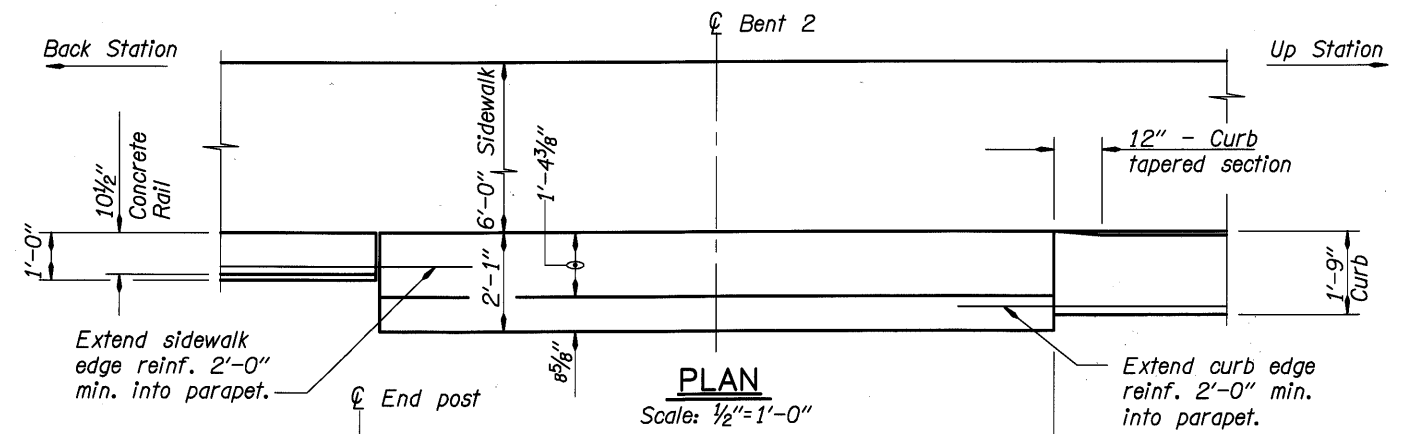


**PLAN**

Scale: 1/2"=1'-0"

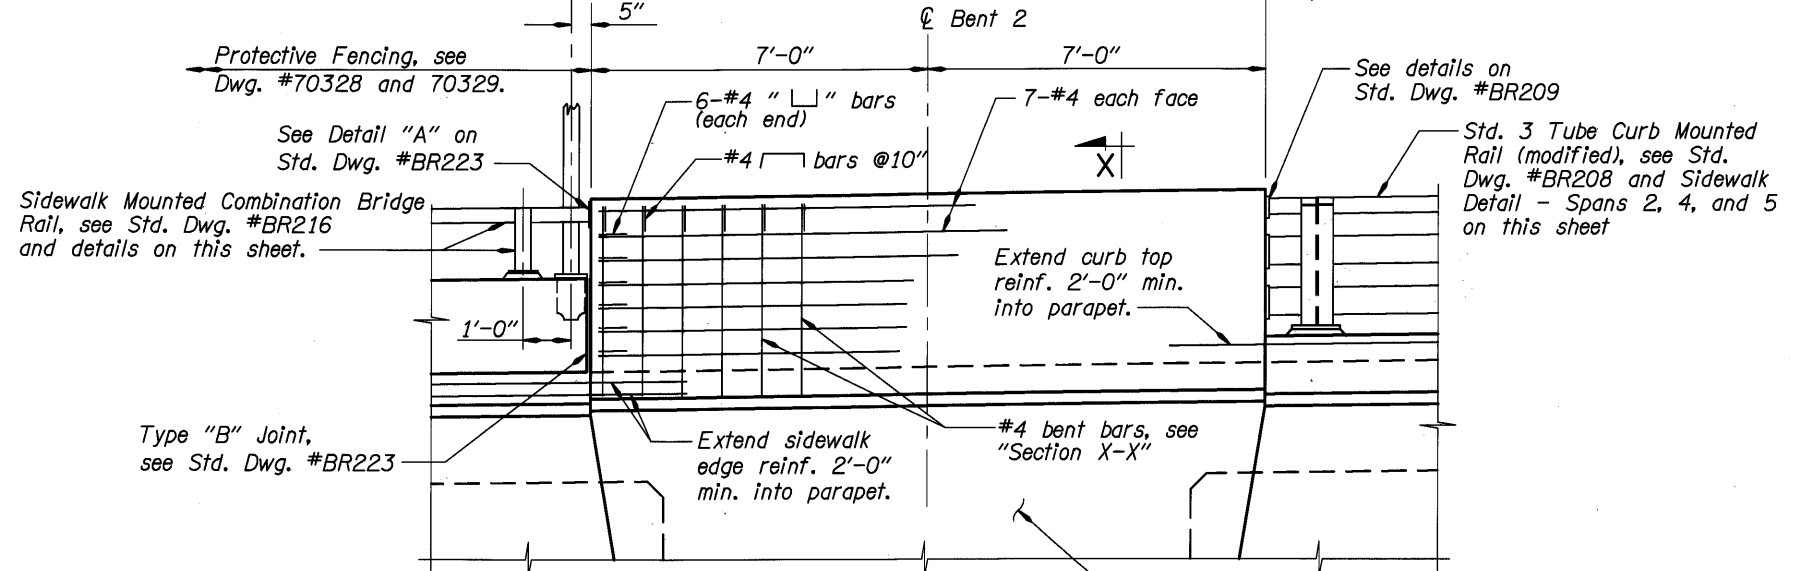

**ELEVATION**

Scale: 1/2"=1'-0"

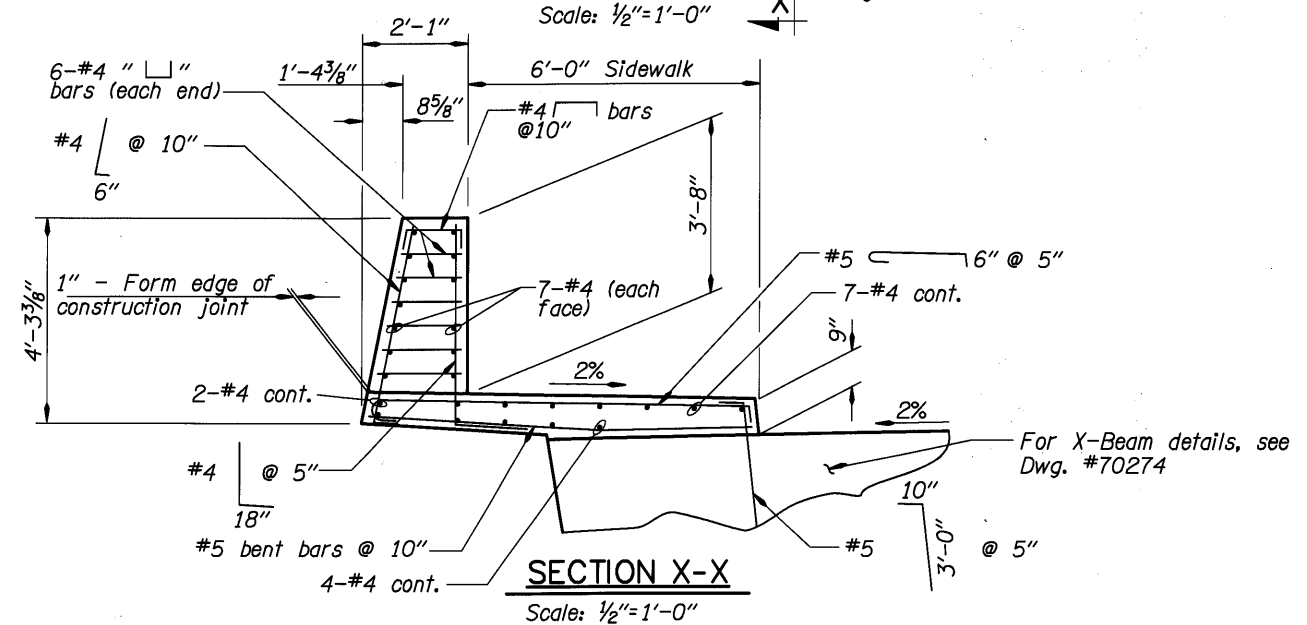

**SECTION X-X**

Scale: 1/2"=1'-0"

DATE	REVISION	BY	DESIGNED
03/09	As-Constructed	TDF	Ken Johnson
			Adrienne Dietrich
			Josh Hewes

**REVIEWED**

REGISTERED PROFESSIONAL ENGINEER  
 74548  
 OREGON  
 MARCH 09, 2005  
 WERT WILLIAM CORRELL

**DAVID EVANS AND ASSOCIATES INC.**  
 530 Center Street N.E., Suite 605  
 Salem Oregon 97301  
 Phone: 503.361.8635

EXPIRES: 12-31-05


CONNECTING COMMERCE AND COMMUNITY

**MULTNOMAH COUNTY BRIDGES**

TRANSPORTATION DIVISION


**OREGON DEPARTMENT OF TRANSPORTATION BRIDGE ENGINEERING SECTION**

BRIDGE NO.	DATE	CALC. BOOK	SHEET
20136	Sept. 2005		139 OF 173
MULTNOMAH CHANNEL & PNWR ETC., SAUVIE ISLAND RD.			<b>DRAWING NO.</b>
<b>RAILING DETAILS (4 OF 4)</b>			<b>70327</b>

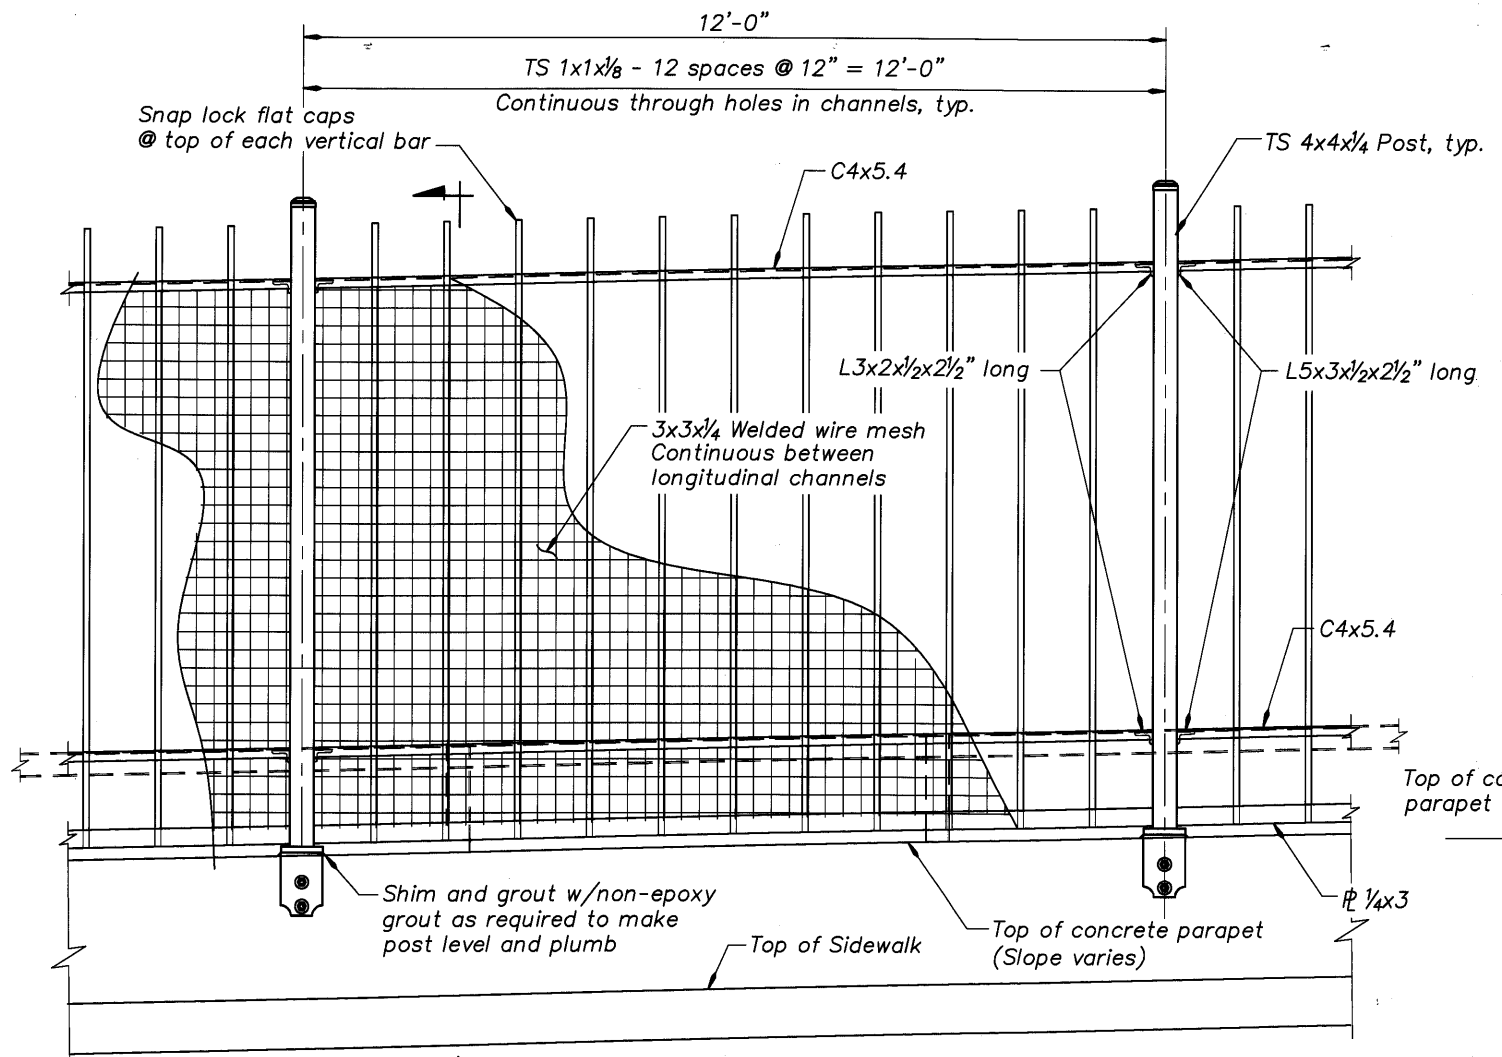


**TYPICAL FENCING PANEL**

Scale : 3/4" = 1'-0"

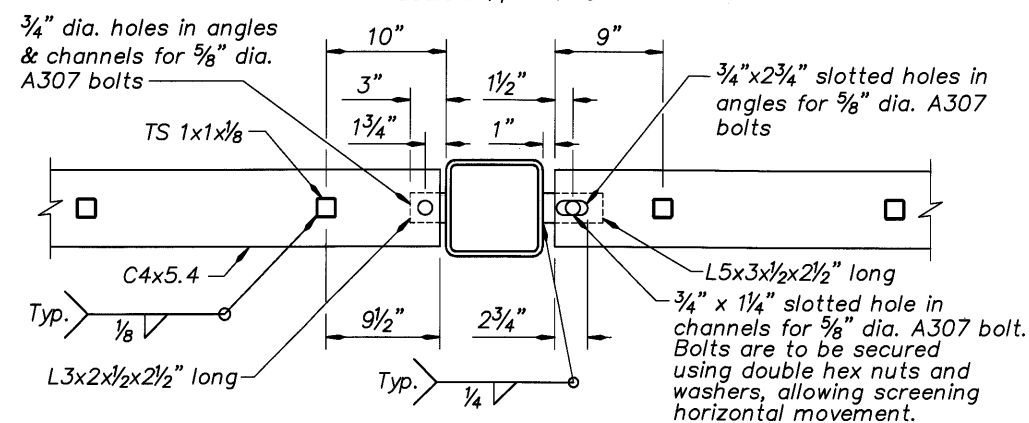


**TYPICAL POST CONNECTION DETAILS**

Scale : 1-1/2" = 1'-0"

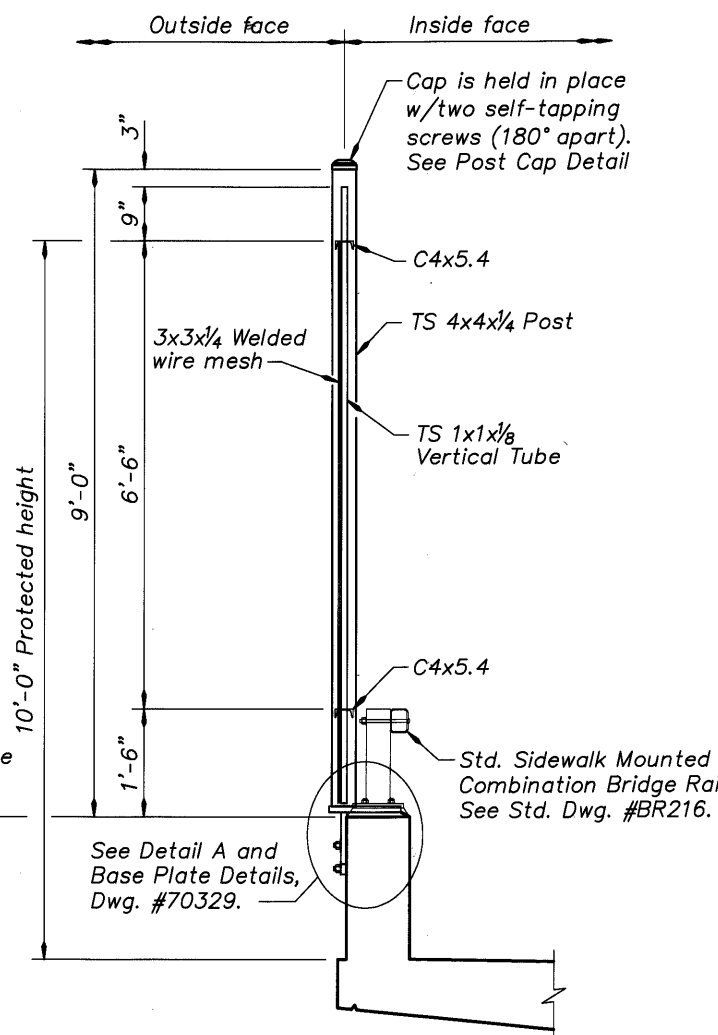

**SECTION**

Scale : 3/4" = 1'-0"

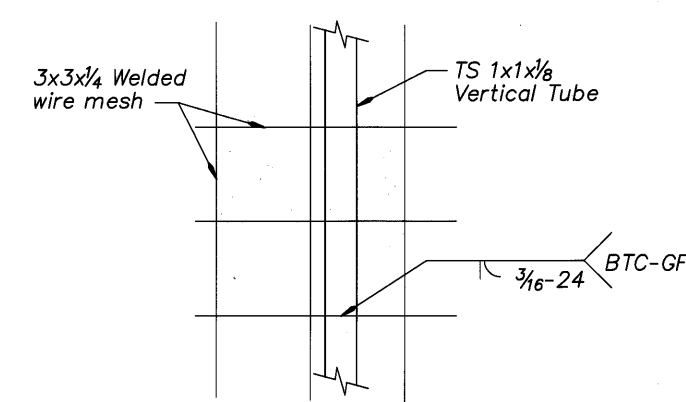


**WIRE MESH ATTACHMENT**

No Scale

**Wire Mesh Attachment Notes:**

- Wire mesh to be installed parallel to 1" sq. tubing (true vertical) on outside face of the Protective Fence Panel.
- Maximum gap between wire mesh and posts shall not exceed 1/2".
- Provide 3/16" long, flare bevel groove welds at 24" each way to 1" sq. vertical tubes.
- For Vertical tubes nearest edge of panel, provide welds at 6" vertically.
- Provide a minimum of 2 welds to each vertical tube on mesh below bottom channel.

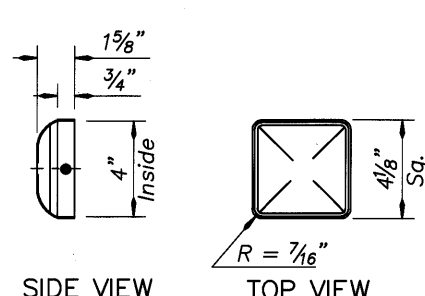

**SIDE VIEW**

**TOP VIEW**

**POST CAP DETAIL**




Scale : 3" = 1'-0"

**Notes:**

- For any given screening panel, the difference in slope between the longitudinal channels/plates and the bridge shall not exceed 0.01 ft./ft. Maintain the vertical alignment of wire mesh and 1" square tubing.
- Galvanize all components of protective fencing.




DO NOT SCALE THIS DRAWING. FOLLOW DIMENSIONS. INDICATED SCALES CORRECT ONLY FOR FULL SIZE SHEET (22"x34").

DATE	03/09	REVISION	As-Constructed	BY	J. Patton	DESIGNER	DAVID EVANS AND ASSOCIATES INC. 530 Center Street N.E., Suite 805 Salem Oregon 97301 Phone: 503.361.8635	BRIDGE NO.	20136	SHEET	140
	03/09		As-Constructed		TDF				DRAFTED: J. Patton CHECKED: Joel Tubbs REVIEWED: Kent Cordtz		MULTNOMAH COUNTY BRIDGES TRANSPORTATION DIVISION OREGON DEPARTMENT OF TRANSPORTATION BRIDGE ENGINEERING SECTION

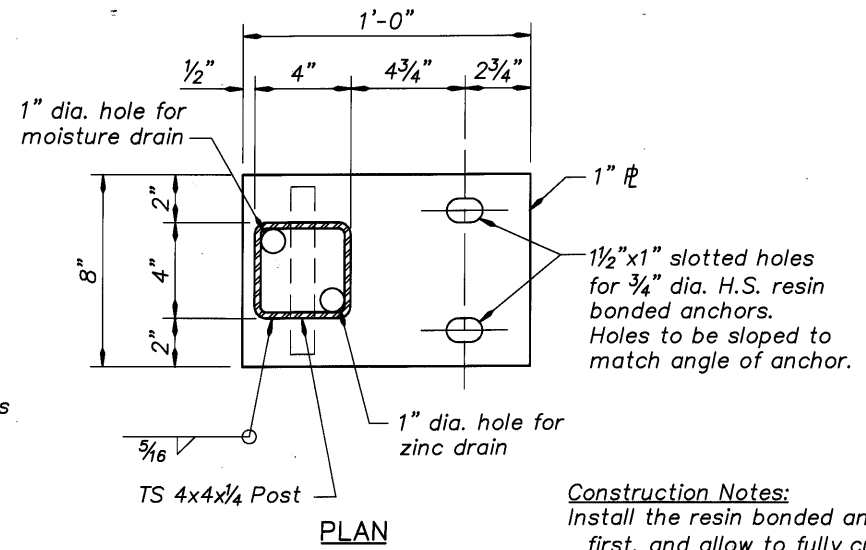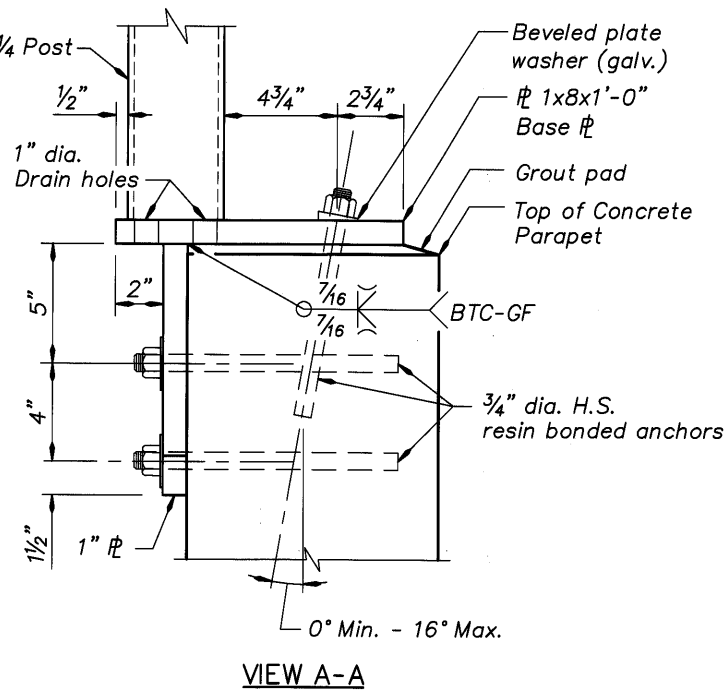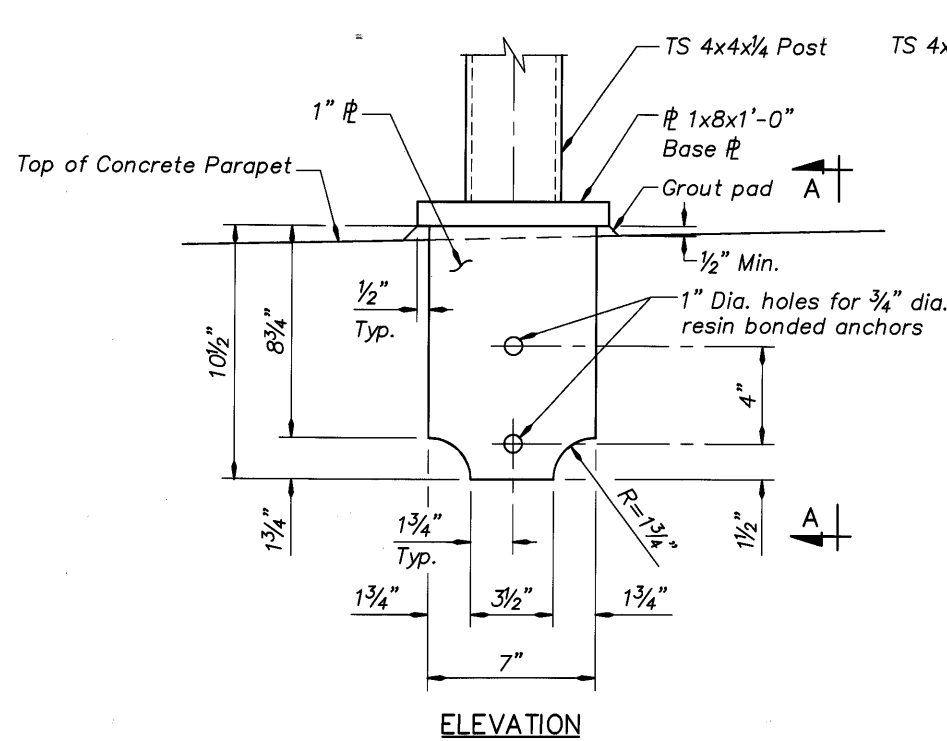

**Construction Notes:**  
 Install the resin bonded anchors into the side of the concrete barrier first, and allow to fully cure. Install post and tighten the nuts 1/3 turn past snug tight. Drill holes for remaining anchors through holes in base plate and install anchors. After the final anchors are fully cured, install and tighten nuts 1/3 turn past snug tight. All welding shall conform to AWS D1.1 Structural Welding Code. Posts shall be in place and all resin bonded anchors fully cured before installation of screening panels.


**BASE PLATE DETAILS**  
 Scale: 3" = 1'-0"

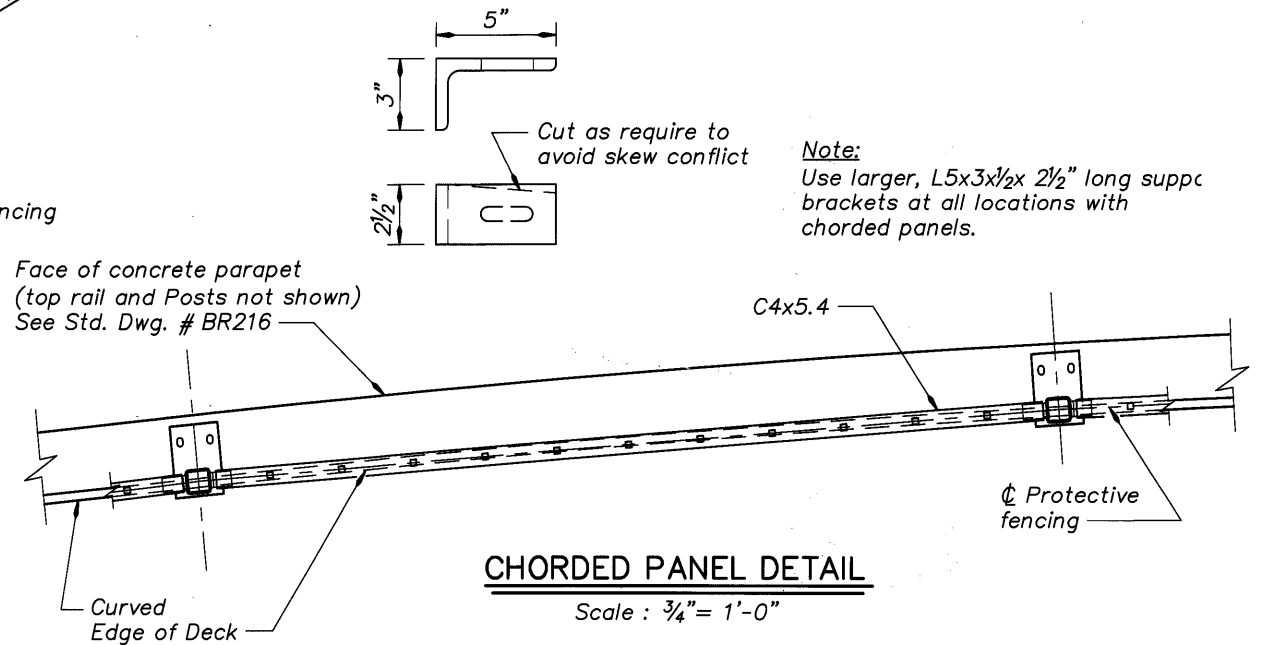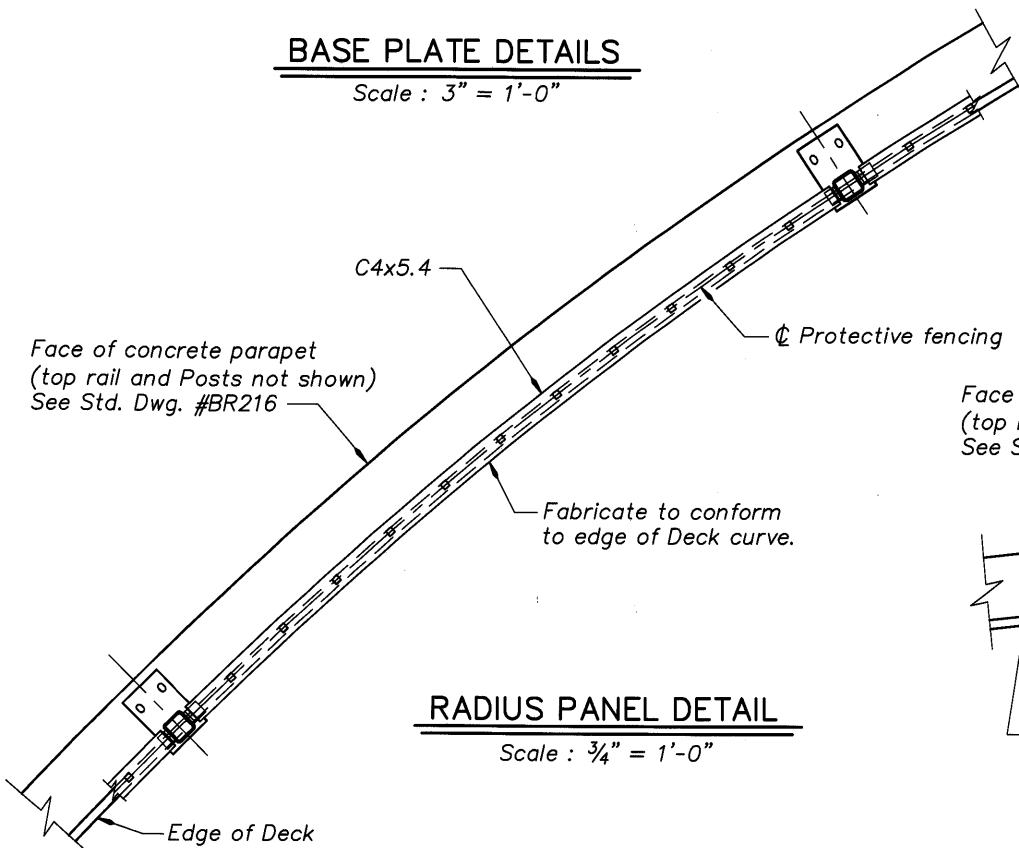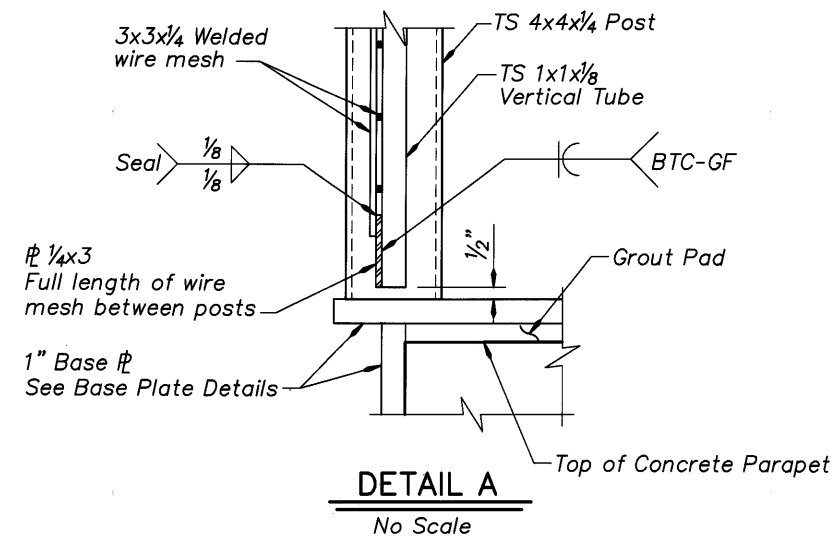

**Note:**  
 Curved panels are required between Sta. "R" 1+41.46 and "R" 2+00.00, "L" 0+62.46 and "L" 1+03.86. Chorded panels may be used for the remainder of the Protective Fencing. See Dwg. #70207 and #70208 for post locations.

DO NOT SCALE THIS DRAWING. FOLLOW DIMENSIONS. INDICATED SCALES CORRECT ONLY FOR FULL SIZE SHEET (22"x34").


	DATE	REVISION	BY	J. Patton	<b>DESIGNER</b>  REGISTERED PROFESSIONAL ENGINEER 70783 DAVID EVANS AND ASSOCIATES INC. 530 Center Street N.E., Suite 605 Salem Oregon 97301 Phone: 503.361.8635 EXPIRES: 6-30-07	 TRANSPORTATION DIVISION OREGON DEPARTMENT OF TRANSPORTATION BRIDGE ENGINEERING SECTION	BRIDGE NO.	20136	MULTNOMAH CHANNEL & PNWR ETC., SAUVIE ISLAND RD.	SHEET	141
	03/09	As-Constructed	TDF	Joel Tubbs			DATE	Sept. 2005		OF	173.
				Kent Cordtz			CALC. BOOK		DRAWING NO.	70329	
								<b>PROTECTIVE FENCING DETAILS (2 OF 2)</b>			

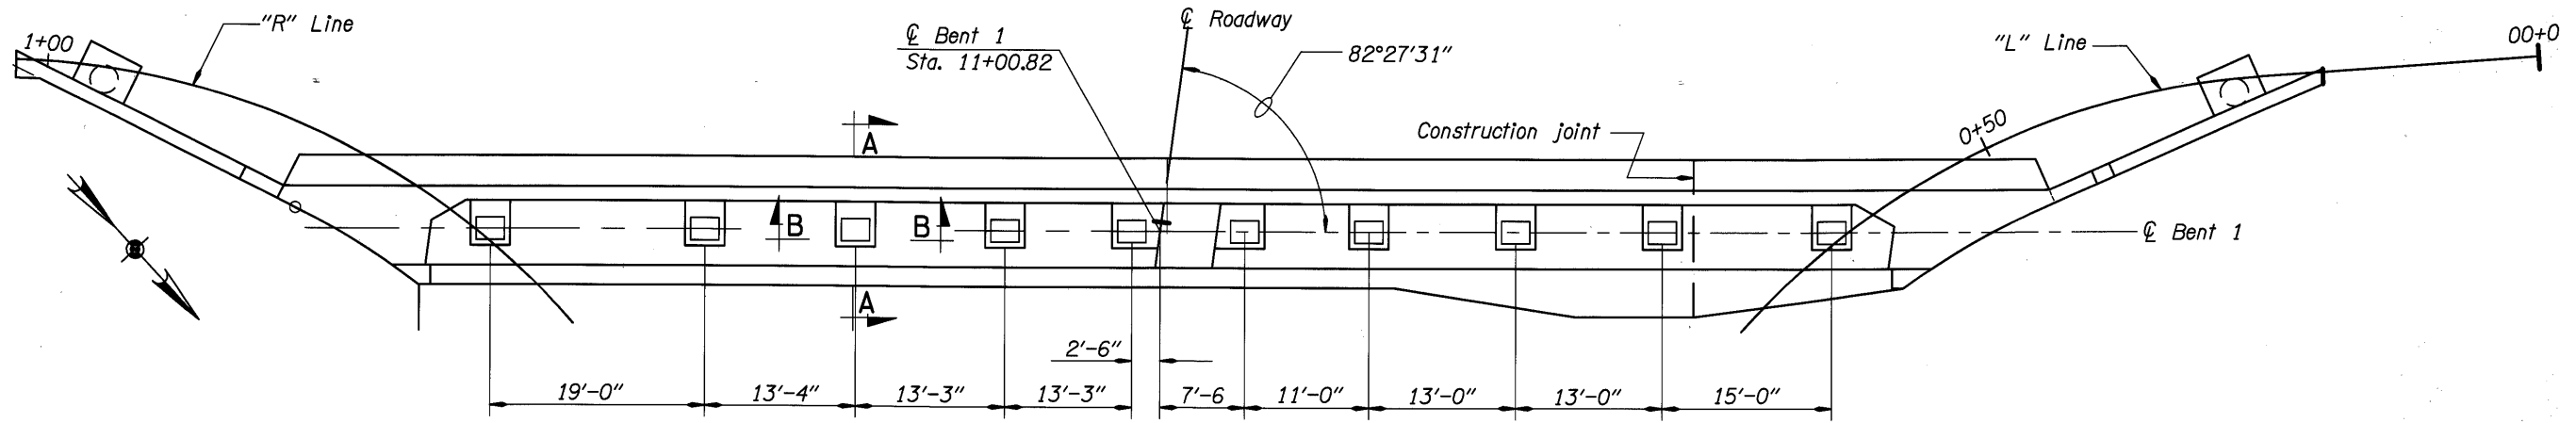

**BENT 1 BEARING PLAN**

Scale: 1/8"=1'-0"



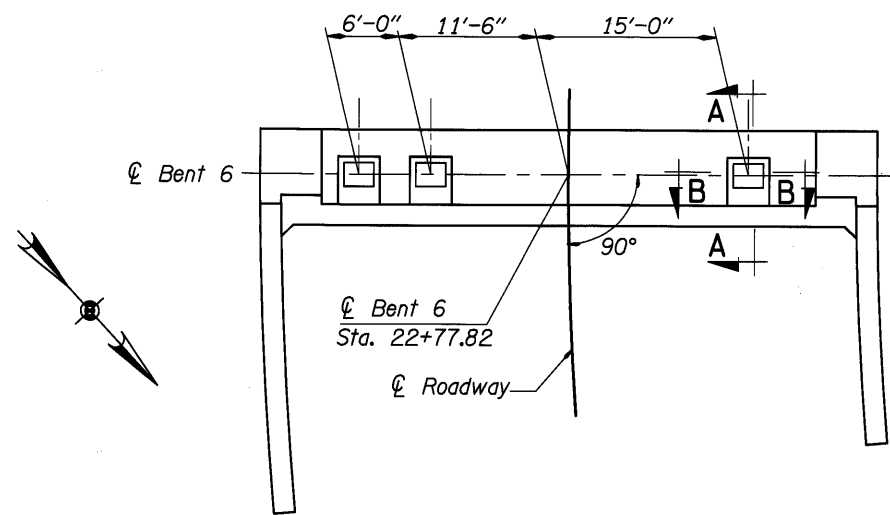


*Note:*  
For bearing details and notes, see Dwg. #70331



**BENT 6 BEARING PLAN**

Scale: 1/8"=1'-0"

DO NOT SCALE THIS DRAWING.  
FOLLOW DIMENSIONS. INDICATED  
SCALES CORRECT ONLY FOR  
FULL SIZE SHEET (22"x34").

	DATE	REVISION	BY	Ken Johnson DRAFTED:	 DESIGNER REGISTERED PROFESSIONAL ENGINEER 74540 DE OREGON MARCH 09, 2004 WENT WILLIAM CONDOT EXPIRES: 12-31-05	 DAVID EVANS AND ASSOCIATES INC. 530 Center Street N.E., Suite 605 Salem Oregon 97301 Phone: 503.361.8635	 CONNECTING COMMERCE AND COMMUNITY MULTNOMAH COUNTY BRIDGES	TRANSPORTATION DIVISION  OREGON DEPARTMENT OF TRANSPORTATION BRIDGE ENGINEERING SECTION	BRIDGE NO.	MULTNOMAH CHANNEL & PNWR ETC., SAUVIE ISLAND RD.	SHEET
	03/09	As-Constructed	TDF						Adrianne Dietrich CHECKED:		20136
			Rich King REVIEWED:					DATE	BEARING DETAILS - BENTS 1 AND 6 (1 OF 2)	DRAWING NO.	
								Sept. 2005 CALC. BOOK		70330	

**BRIDGE BEARING TABLE**

Bent	No. req'd.	Type	Design Load Capacity Kip/bearing				* Movement Estimates in inches				
			Vertical		Horizontal		Calculated				
			Dead	Total	Transv.	Longit.	ES	CR + SH	TF	TR	EQ
1	10	Non-Guided	475	625	---	---	1/16	2/8	1/16	-1/2	7/2, -7/2
6	3	Non-Guided	525	650	---	---	-1	-1/8	-5/8	1/2	7/2, -7/2

Bent	Reqd. Movement Capacity			** Initial Offset (inches)	Movement per 10°F (inches)
	EQ	1.5 (ES + CR + SH + TF)	1.5 (TR)		
1	7/2, -7/2	5/8	-13/16	-3/4	3/16
6	7/2, -7/2	-5 3/16	3/4	2/8	3/16

**EXPANSION BEARING DESIGN NOTES:**

Maximum allowable concrete bearing stress is 2.16 ksi.

Maximum allowable steel bending stress is 19.8 ksi.

Minimum rotational capacity is 0.015 radians.

Both upper and lower components of the bearing shall be secured to the steel plates with bolts or equivalent.

Bearing shall have load and movement capacity as shown in the chart. Movement capacity for EQ need not include other effects.

Bearings shall be either disc bearing, pot bearings or spherical bearings and shall be from ODOT Qualified Products List (July 2005).

All exposed metal bearing surfaces, except contact surface, shall be paint coated per ODOT Standard Specifications.

Bearing shall be level in full loaded conditions.

Bearing unit supplied must fit within the limits of the specified sole plate and base plate without conflicting with the cap screws. All additional plates required to limit the bearing stress on the concrete, or bending in the distribution plate and masonry plate, shall be designed, detailed and supplied by the bearing supplier.

Assumed installation temperature is 52 degrees fahrenheit. Adjust the bearing offset in accordance with the Bearing Data Table for variance from the assumed temperature.

Faces of adjacent steel plates shall be machined finished to match.

\*\* Positive value indicates upper assembly offset ahead on station relative to lower assembly

\* Positive value indicates upper assembly moves ahead on station.

ES = Elastic shortening


CR = Creep shortening

SH = Shrinkage shortening

TF = Temperature Fall Shortening (40°F)


TR = Temperature Rise Lengthening (30°F)

EQ = Earthquake

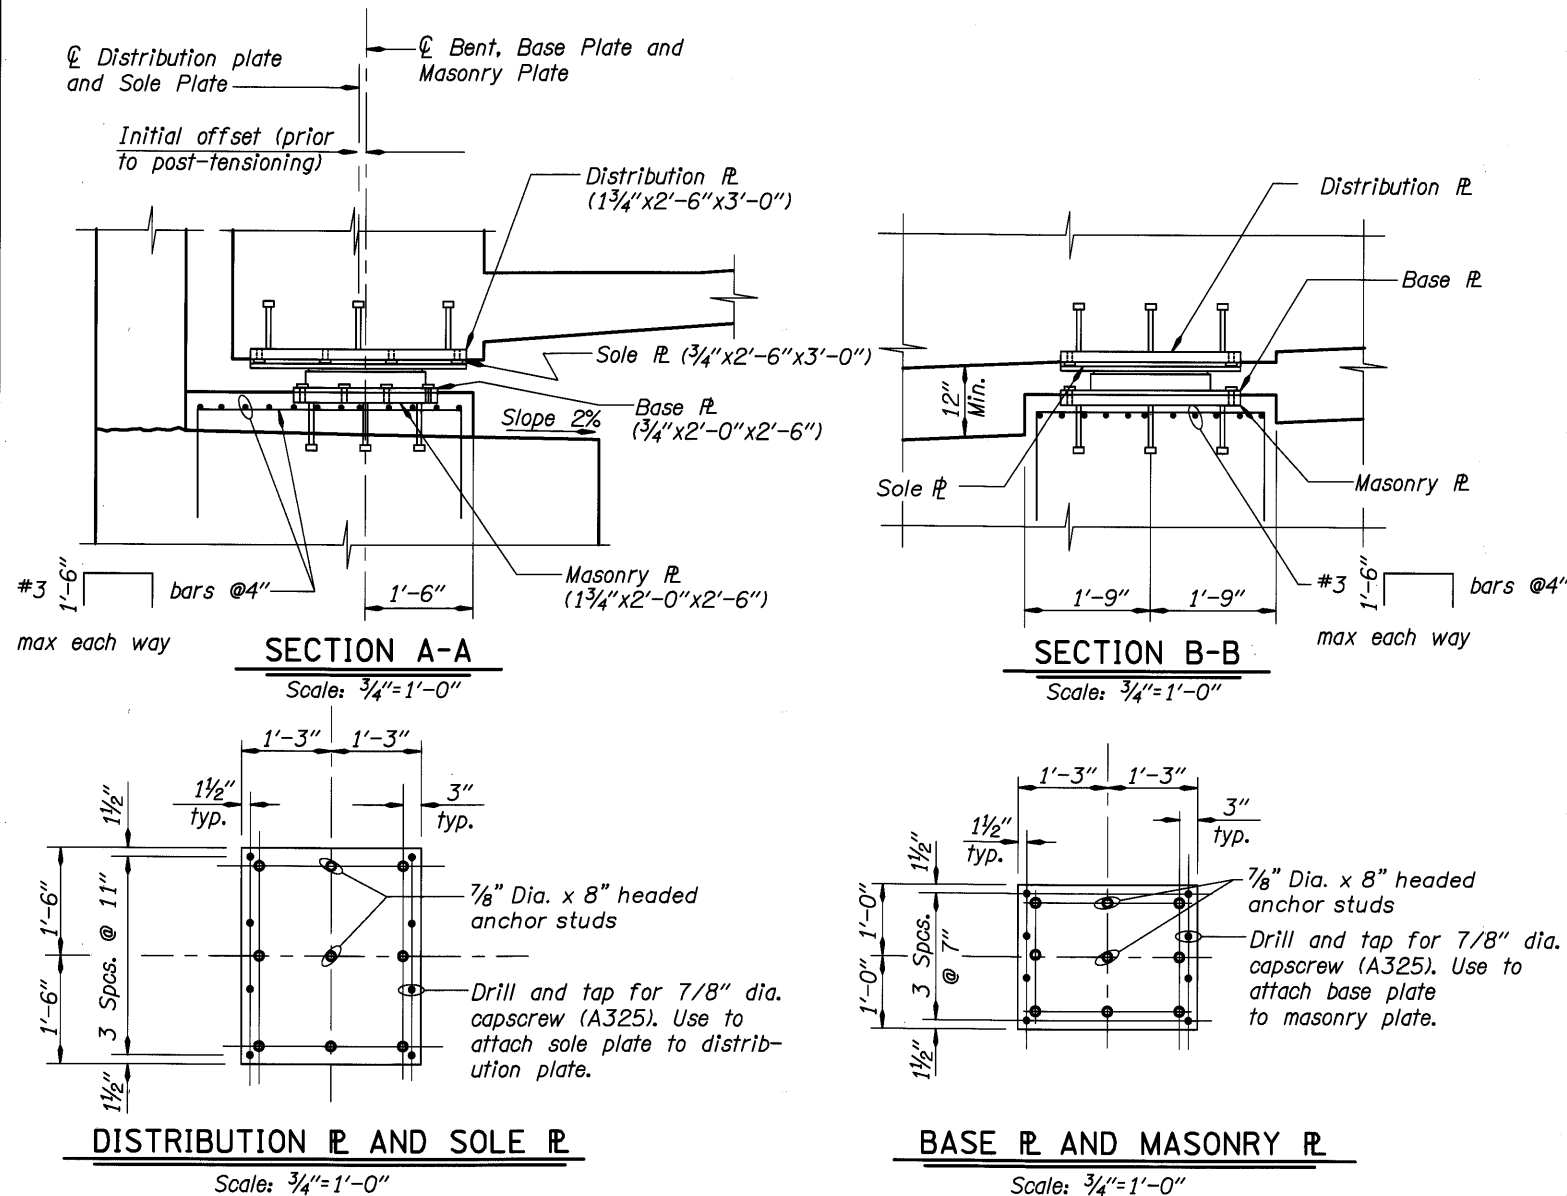


DO NOT SCALE THIS DRAWING. FOLLOW DIMENSIONS. INDICATED SCALES CORRECT ONLY FOR FULL SIZE SHEET (22"x34").

DATE	03/09	REVISION	As-Constructed	BY	Ken Johnson	DESIGNER	 DAVID EVANS AND ASSOCIATES INC. 530 Center Street N.E., Suite 605 Salem Oregon 97301 Phone: 503.361.8635	 MULTNOMAH COUNTY BRIDGES TRANSPORTATION DIVISION OREGON DEPARTMENT OF TRANSPORTATION BRIDGE ENGINEERING SECTION	BRIDGE NO.	20136	SHEET	143
	DATE		Sept. 2005		OF				173			
DATE		REVISION		BY	Adrienne Dietrich	DESIGNER		DATE			DRAWING NO.	70331
DATE		REVISION		BY	Rich King	DESIGNER		CALC. BOOK				
									MULTNOMAH CHANNEL & PNWR ETC., SAUVIE ISLAND RD.			
									BEARING DETAILS - BENTS 1 AND 6 (2 OF 2)			

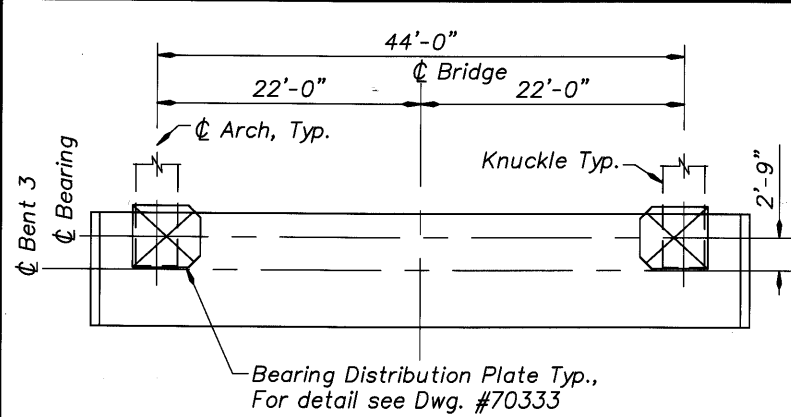


**BEARING PLAN AT BENT 3**

Scale : 1/8" = 1'-0"

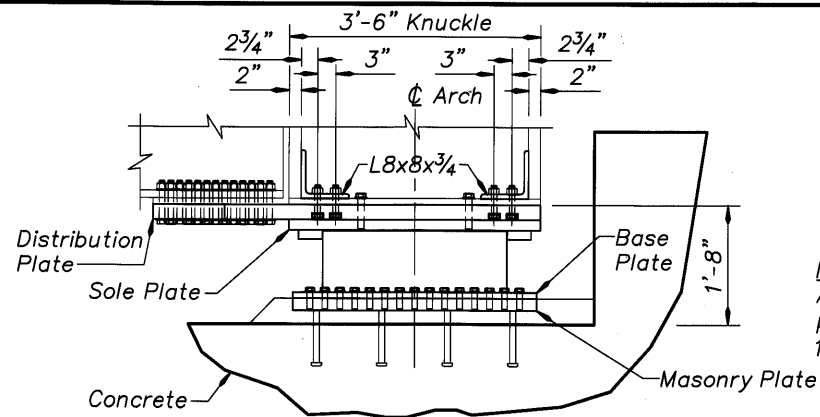

**ELEVATION AT BENT 3**

Scale : 3/4" = 1'-0"

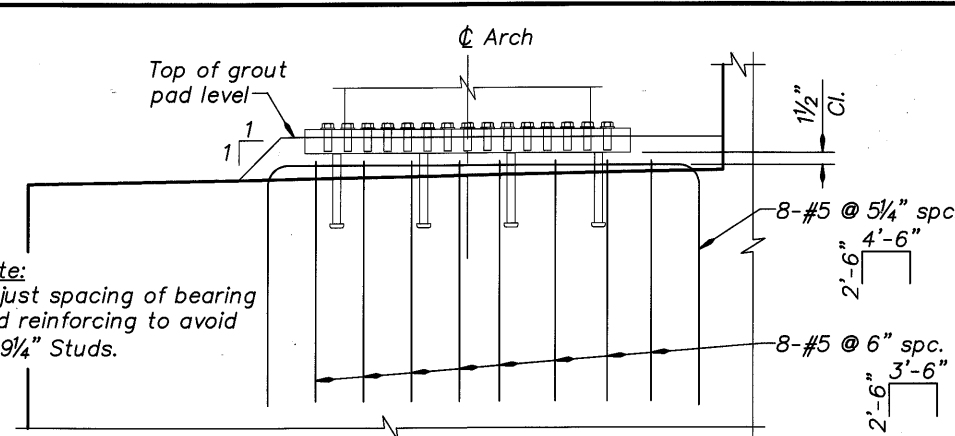

**BEARING PAD REINFORCING DETAIL**

Scale : 1" = 1'-0"

**LEGEND**

- ◆ 15/16" Hole for 7/8" dia. bolt
- 15/16" Drill and tap 1 3/4" deep for 7/8" dia. bolts.
- ✱ 1" x 9/4" Weld stud

**Note:**  
Legends for Bearings at Bent 3 and for Bearings at Bent 4 are not the same.

Bent	No. Req'd.	Type	Design Load Capacities in Kips/bearing				* Movement Estimates in inches			
			Vertical		Horizontal		Calculated			
			Dead	Total	Transv.	Longit.	CR+SH	TF	TR	EQ
3	2	Guided	1345	1757	540	----	3 7/16	2 3/4	2 1/16	±16
4	2	Fixed	1345	1757	540	1500	----	----	----	----

Req'd. Movement Capacity	** Initial Offset (inches)	Movement per 10° F (inches)
1.5 (CR+SH+TF)	1.5 (TR)	
Bent 3 9 5/16	4	-3 7/16
Bent 4 ----	---	---

\* Positive value indicates upper assembly moves ahead on station.  
CR = Creep  
SH = Shrinkage Shortening  
TF = Temperature Fall (Concrete) (40°F)  
Temperature Fall (Steel) (62°F)  
TR = Temperature Rise (Concrete) (30°F)  
Temperature Rise (Steel) (68°F)

\*\* Positive value indicates upper assembly offset ahead on station relative to lower assembly.

**BEARING DATA TABLE**

**BEARING DESIGN NOTES:**

Maximum allowable concrete bearing stress is 2.16 ksi.

Maximum allowable steel bending stress is 19.80 ksi.

Minimum rotational capacity is 0.015 radians.

Both upper and lower components of the bearing shall be secured to the steel plates with bolts or equivalent.

Bearing shall have load and movement capacity as shown in the chart (Expansion bearing only).

Bearings shall be either disc bearings, pot bearings or spherical bearings and shall be from the ODOT Qualified Products List (July 2005).

All exposed metal bearing surfaces, except contact surfaces, shall be paint coated per ODOT Standard Specifications.

Bearing shall be level in the fully loaded position.

Bearing unit supplied must fit within the limits of the specified sole plate and base plate without conflicting with the cap screws. All additional plates required to limit the bearing stress on the concrete, or bending in the distribution plate and masonry plate shall be designed, detailed and supplied by the bearing supplier.


Assumed installation temperature is 52 degrees Fahrenheit. Adjust the bearing offset in accordance with the Bearing Data Table for variances from the assumed temperature.

Faces of adjacent steel plates shall be machine finished to match.

**Note:**  
Initial offset dimensions are dependent upon time difference between completion of post-tensioning of approach spans and placement of main arch structure. Offset dimension should be verified with Engineer prior to setting the lower bearing assembly locations at Bent 3.


**INITIAL BOTTOM BEARING ASSEMBLY OFFSET DIAGRAM**

Scale : 3/4" = 1'-0"

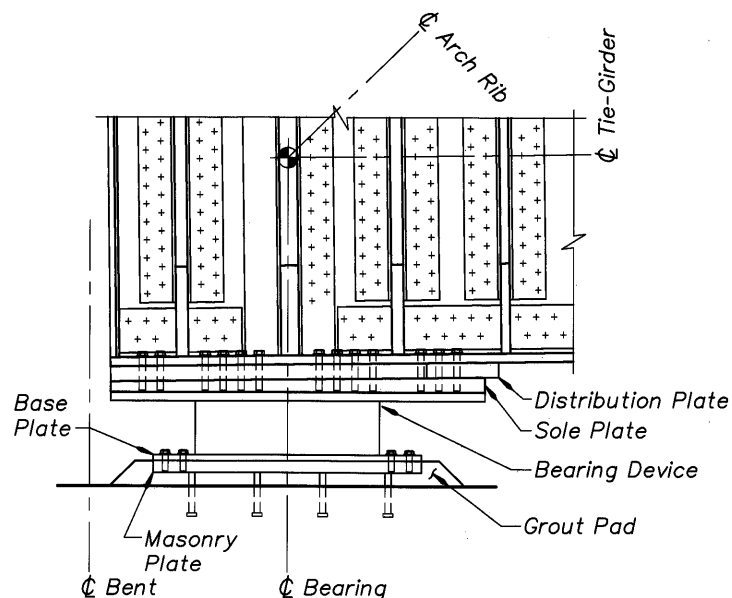


**CROSS SECTION AT BENT 3**

Scale : 3/4" = 1'-0"

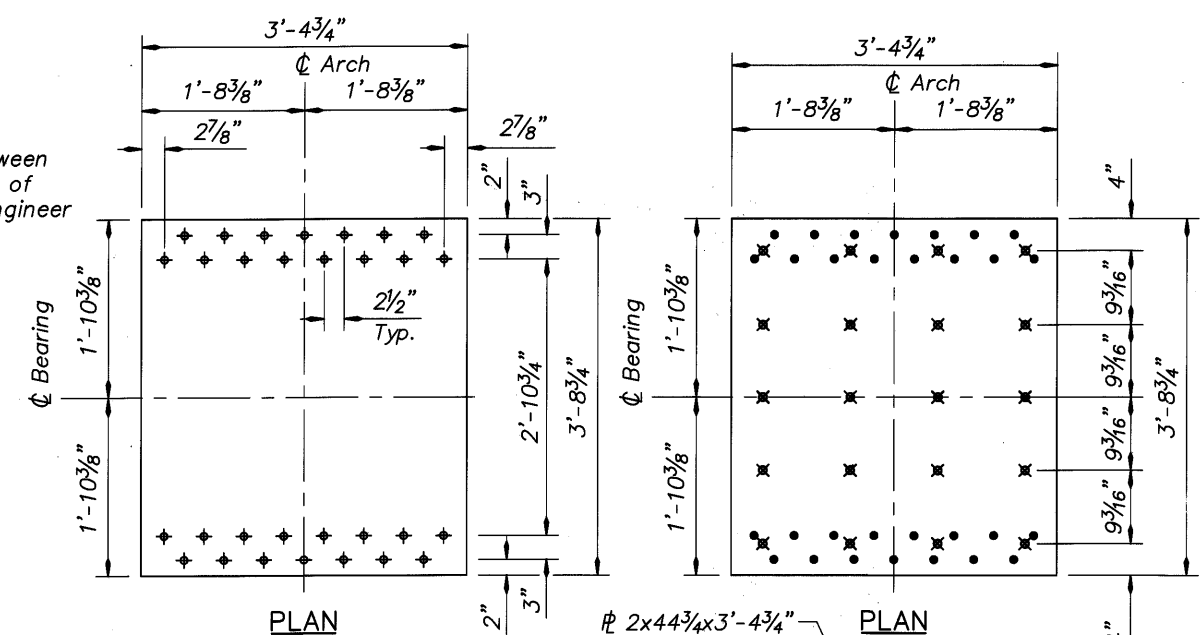


**PLAN**

**PLAN**

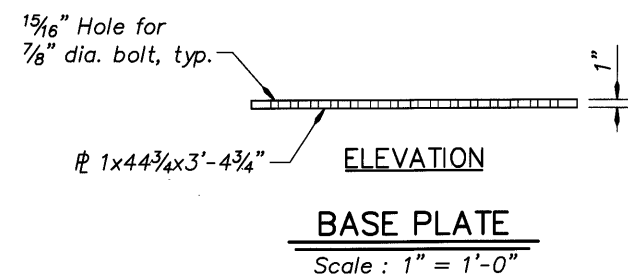

**BASE PLATE**

Scale : 1" = 1'-0"

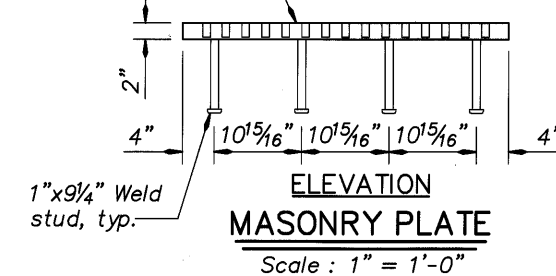

**MASONRY PLATE**

Scale : 1" = 1'-0"

DO NOT SCALE THIS DRAWING. FOLLOW DIMENSIONS. INDICATED SCALES CORRECT ONLY FOR FULL SIZE SHEET (22"x34").

DATE	REVISION	BY	DRAWN
03/09	As-Constructed	R. Stone	TDF
		Shonn Mills	
		Clifford Coulter	


**DESIGNER**  
REGISTERED PROFESSIONAL ENGINEER  
70763  
**DAVID EVANS AND ASSOCIATES INC.**  
530 Center Street N.E., Suite 605  
Salem Oregon 97301  
Phone: 503.361.8635  
EXPIRES: 6-30-07

CONNECTING COMMERCE AND COMMUNITY  
**MULTNOMAH COUNTY BRIDGES**  
TRANSPORTATION DIVISION  
**OREGON DEPARTMENT OF TRANSPORTATION BRIDGE ENGINEERING SECTION**


<b>BRIDGE NO.</b>	20136
<b>DATE</b>	Sept. 2005
<b>CALC. BOOK</b>	

MULTNOMAH CHANNEL & PNWR ETC., SAUVIE ISLAND RD.	
<b>BEARING DETAILS - BENT 3 (1 OF 2)</b>	

<b>SHEET</b>	144
<b>OF</b>	173
<b>DRAWING NO.</b>	70332

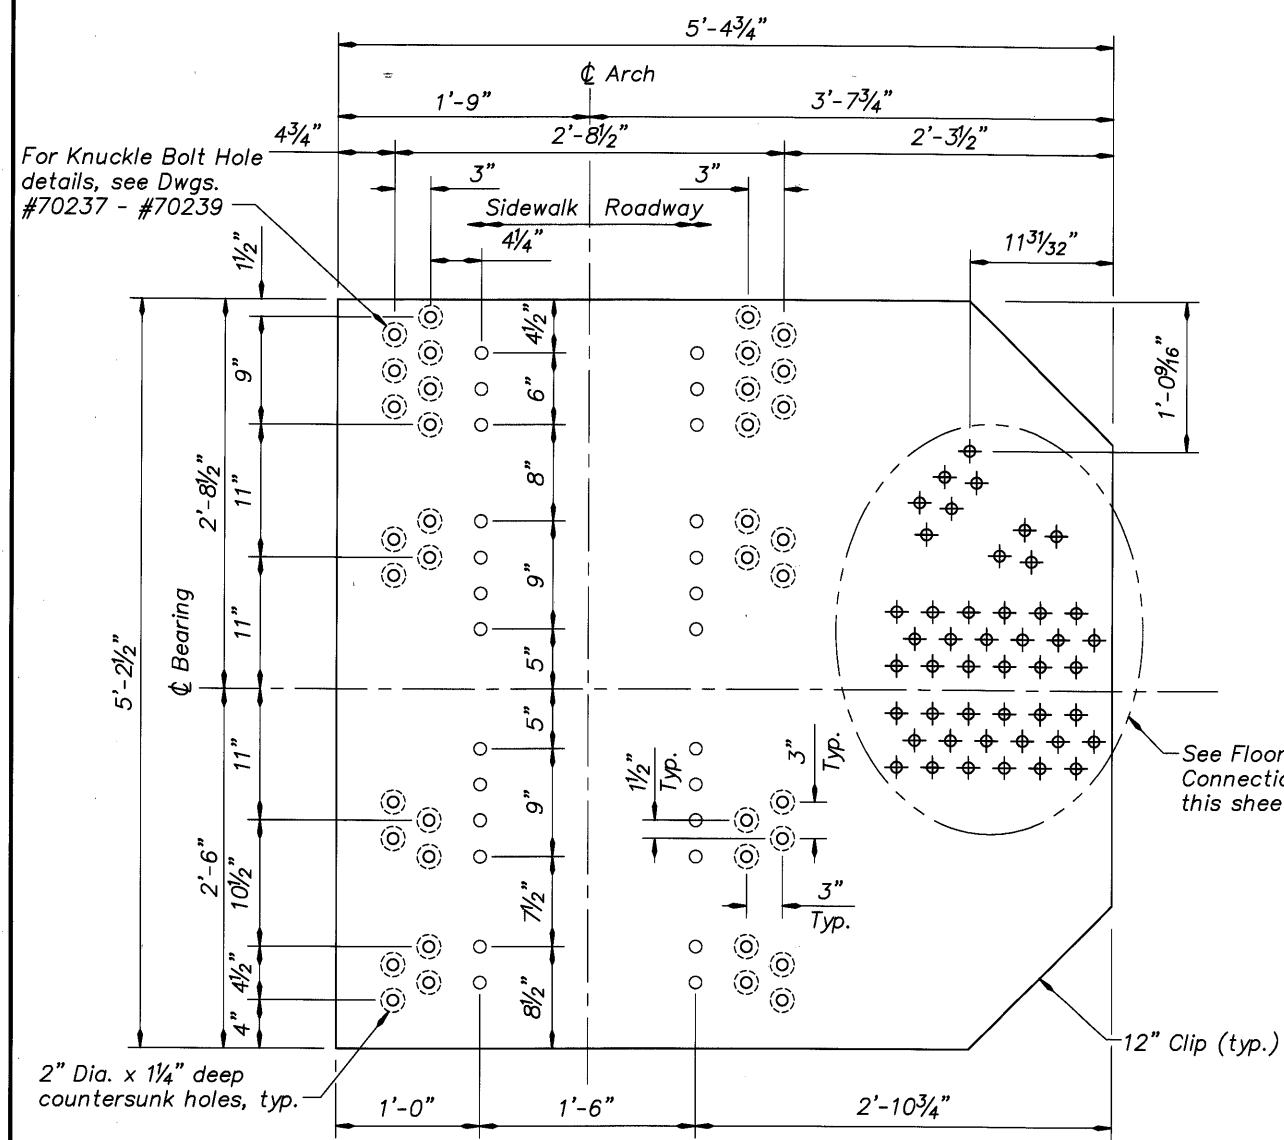


PLAN

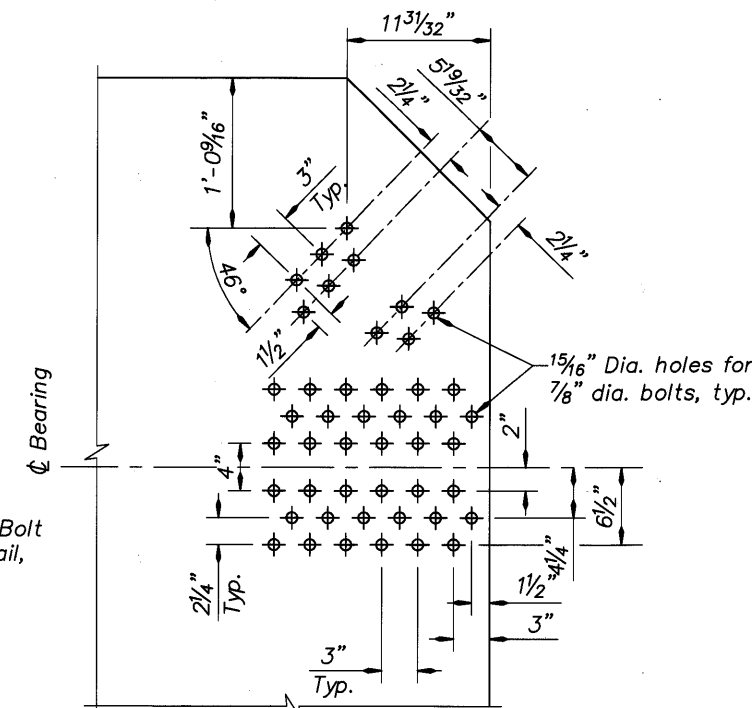


FLOORBEAM BOLT CONNECTION DETAIL

Scale : 1 1/2" = 1'-0"

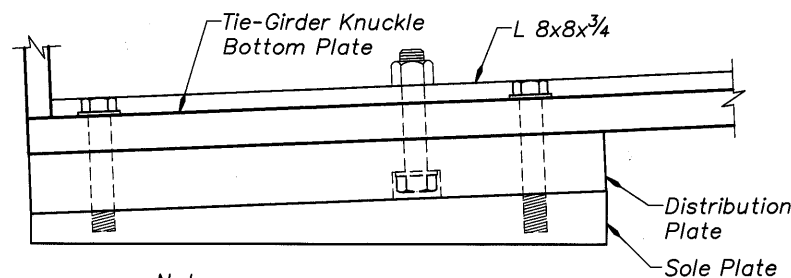


BOLT ALIGNMENT DETAIL

No Scale

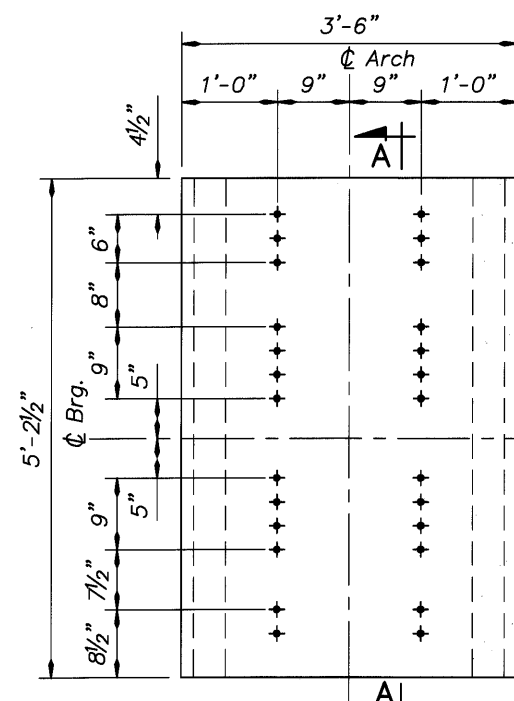

SECTION "A-A"

Scale : 1" = 1'-0"

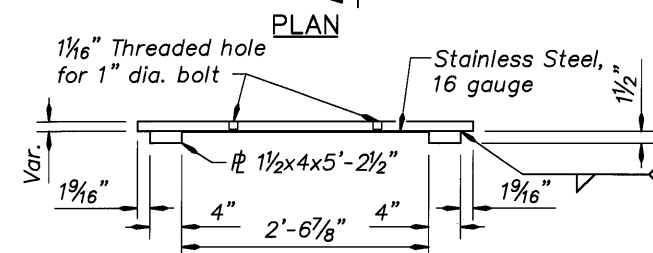

ELEVATION SOLE PLATE

Scale : 1" = 1'-0"

**LEGEND**

- ⊙ 15/16" Counterbore hole for 7/8" Dia. bolt
- 1/16" Hole for 1" dia. bolt
- ⊕ 15/16" Hole for 7/8" dia. bolt
- ⊕ 1" Threaded hole for 1" dia. bolt

**Note:**  
Legends for Bearings at Bent 3 and for Bearings at Bent 4 are not the same.

DO NOT SCALE THIS DRAWING. FOLLOW DIMENSIONS. INDICATED SCALES CORRECT ONLY FOR FULL SIZE SHEET (22"x34").

DISTRIBUTION PLATE, BENT 3

Scale : 1 1/2" = 1'-0"

DATE	REVISION	BY
03/09	As-Constructed	TDF

DESIGNER: R. Stone  
 DRAFTED: Shonn Mills  
 CHECKED: Clifford Coulter  
 REVIEWED:

**DESIGNER**  
 REGISTERED PROFESSIONAL ENGINEER  
 70783  
 RICHARD J. KING  
 JULY 9, 2002  
 EXPIRES: 6-30-07

**DAVID EVANS AND ASSOCIATES INC.**  
 530 Center Street N.E., Suite 605  
 Salem Oregon 97301  
 Phone: 503.361.8635


CONNECTING COMMERCE AND COMMUNITY  
**MULTNOMAH COUNTY BRIDGES**  
 TRANSPORTATION DIVISION  
**OREGON DEPARTMENT OF TRANSPORTATION BRIDGE ENGINEERING SECTION**

BRIDGE NO. 20136  
 DATE Sept. 2005  
 CALC. BOOK

MULTNOMAH CHANNEL & PNWR ETC., SAUVIE ISLAND RD.  
 BEARING DETAILS - BENT 3 (2 OF 2)


SHEET 145 OF 173  
 DRAWING NO. 70333



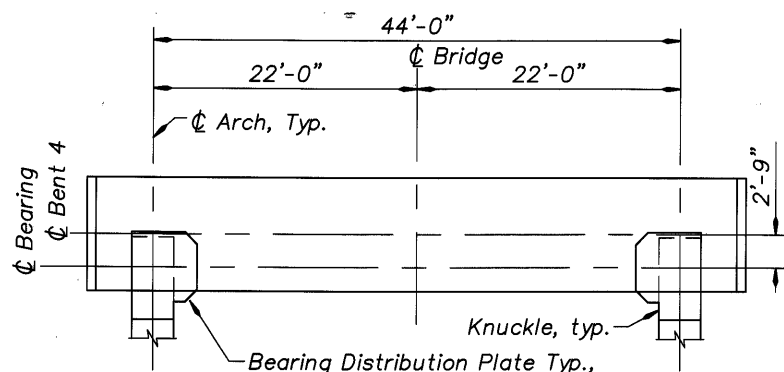

**BEARING PLAN AT BENT 4**

Scale: 1/8" = 1'-0"

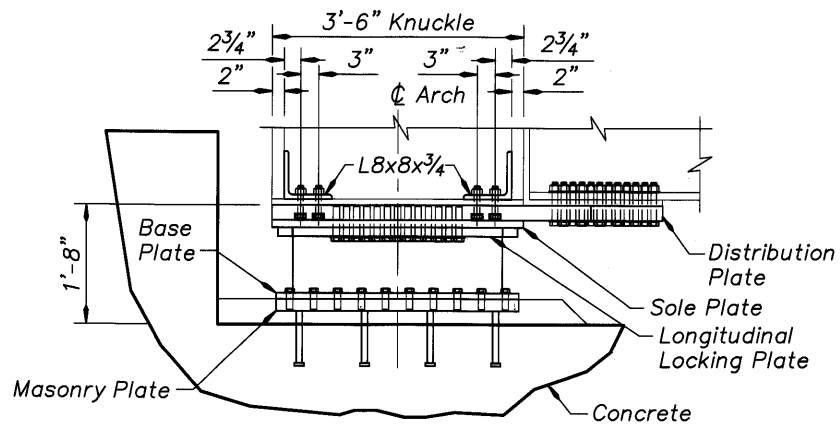


**ELEVATION AT BENT 4**

Scale: 3/4" = 1'-0"

**LEGEND**


- ◆ 1/16" Hole for 1" dia. bolt
- 1" Drill and tap 1 3/4" deep for 1" dia. bolts.
- ✱ 1" x 9/4" Weld stud

**Note:**  
Legends for Bearings at Bent 3 and for Bearings at Bent 4 are not the same.

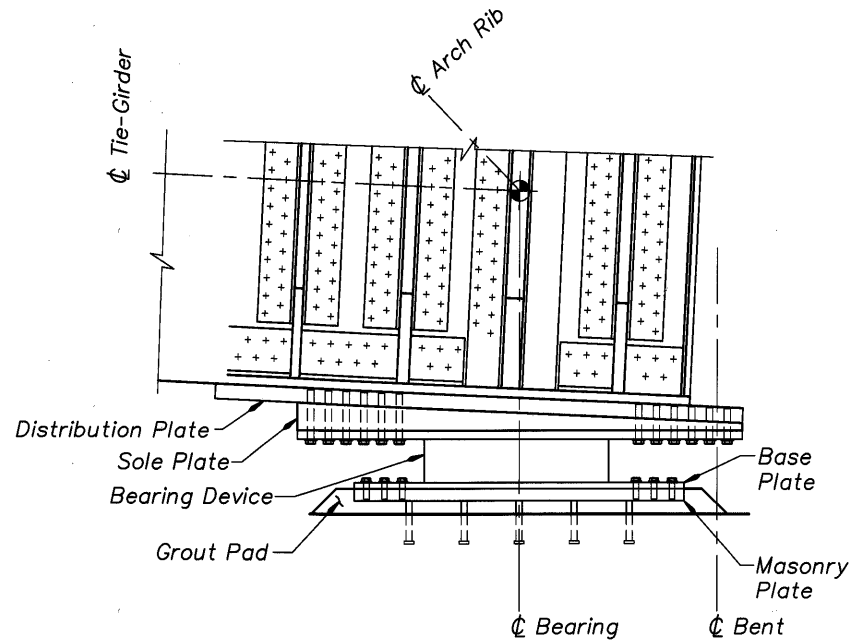


**CROSS SECTION AT BENT 4**

Scale: 3/4" = 1'-0"

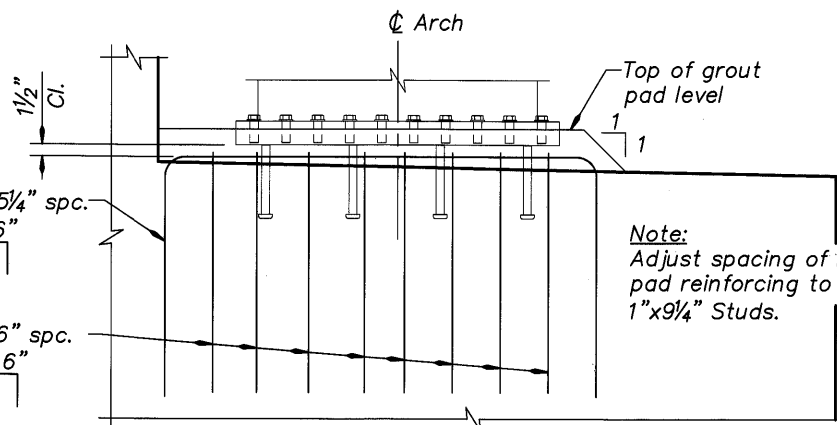

**BEARING PAD REINFORCING DETAIL**

Scale: 1" = 1'-0"

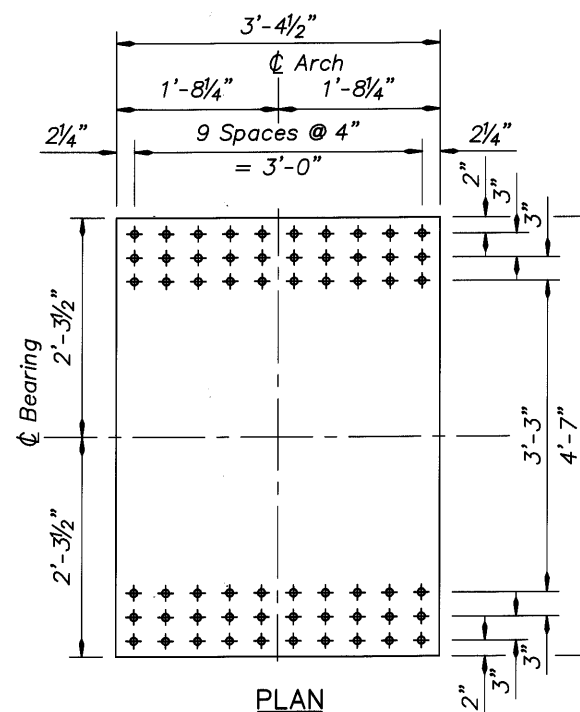


**PLAN**

**ELEVATION**

**BASE PLATE**

Scale: 1" = 1'-0"

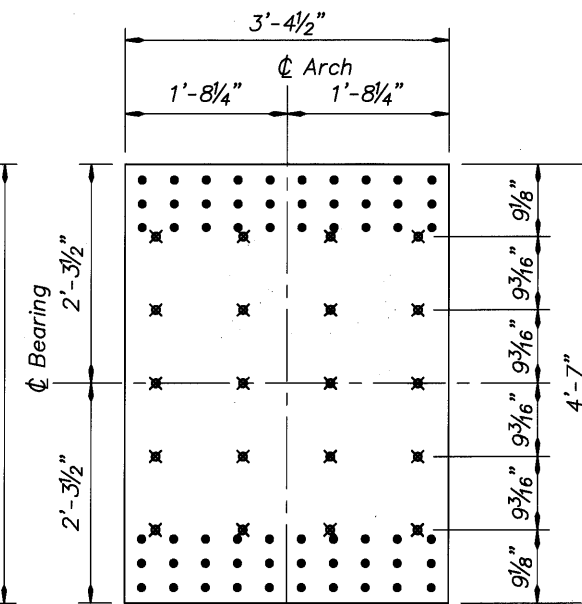

**PLAN**

**ELEVATION**

**MASONRY PLATE**

Scale: 1" = 1'-0"

**Note:**  
For Bearing Data Table and Expansion Bearing Notes, see Dwg. #70332.

**DO NOT SCALE THIS DRAWING.**  
FOLLOW DIMENSIONS. INDICATED SCALES CORRECT ONLY FOR FULL SIZE SHEET (22"x34").

DATE	REVISION	BY
03/09	As-Constructed	TDF

**DESIGNER**  
R. Stone

**CHECKED:**  
Shonn Mills

**REVIEWED:**  
Clifford Coulter

**REGISTERED PROFESSIONAL ENGINEER**  
70763  
RICHARD J. KING  
EXPIRES: 6-30-07

**DAVID EVANS AND ASSOCIATES INC.**  
530 Center Street N.E., Suite 605  
Salem Oregon 97301  
Phone: 503.361.8635

CONNECTING COMMERCE AND COMMUNITY  
**MULTNOMAH COUNTY BRIDGES**

TRANSPORTATION DIVISION  
**OREGON DEPARTMENT OF TRANSPORTATION BRIDGE ENGINEERING SECTION**

**BRIDGE NO.**  
20136

**DATE**  
Sept. 2005



**CALC. BOOK**

MULTNOMAH CHANNEL & PNWR ETC., SAUVIE ISLAND RD.


**BEARING DETAILS - BENT 4 (1 OF 2)**

**SHEET**  
146  
OF  
173


**DRAWING NO.**  
70334

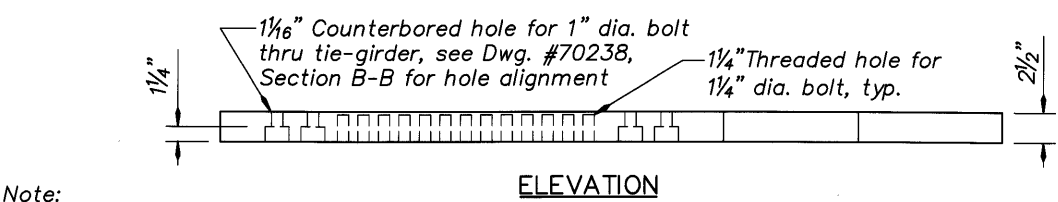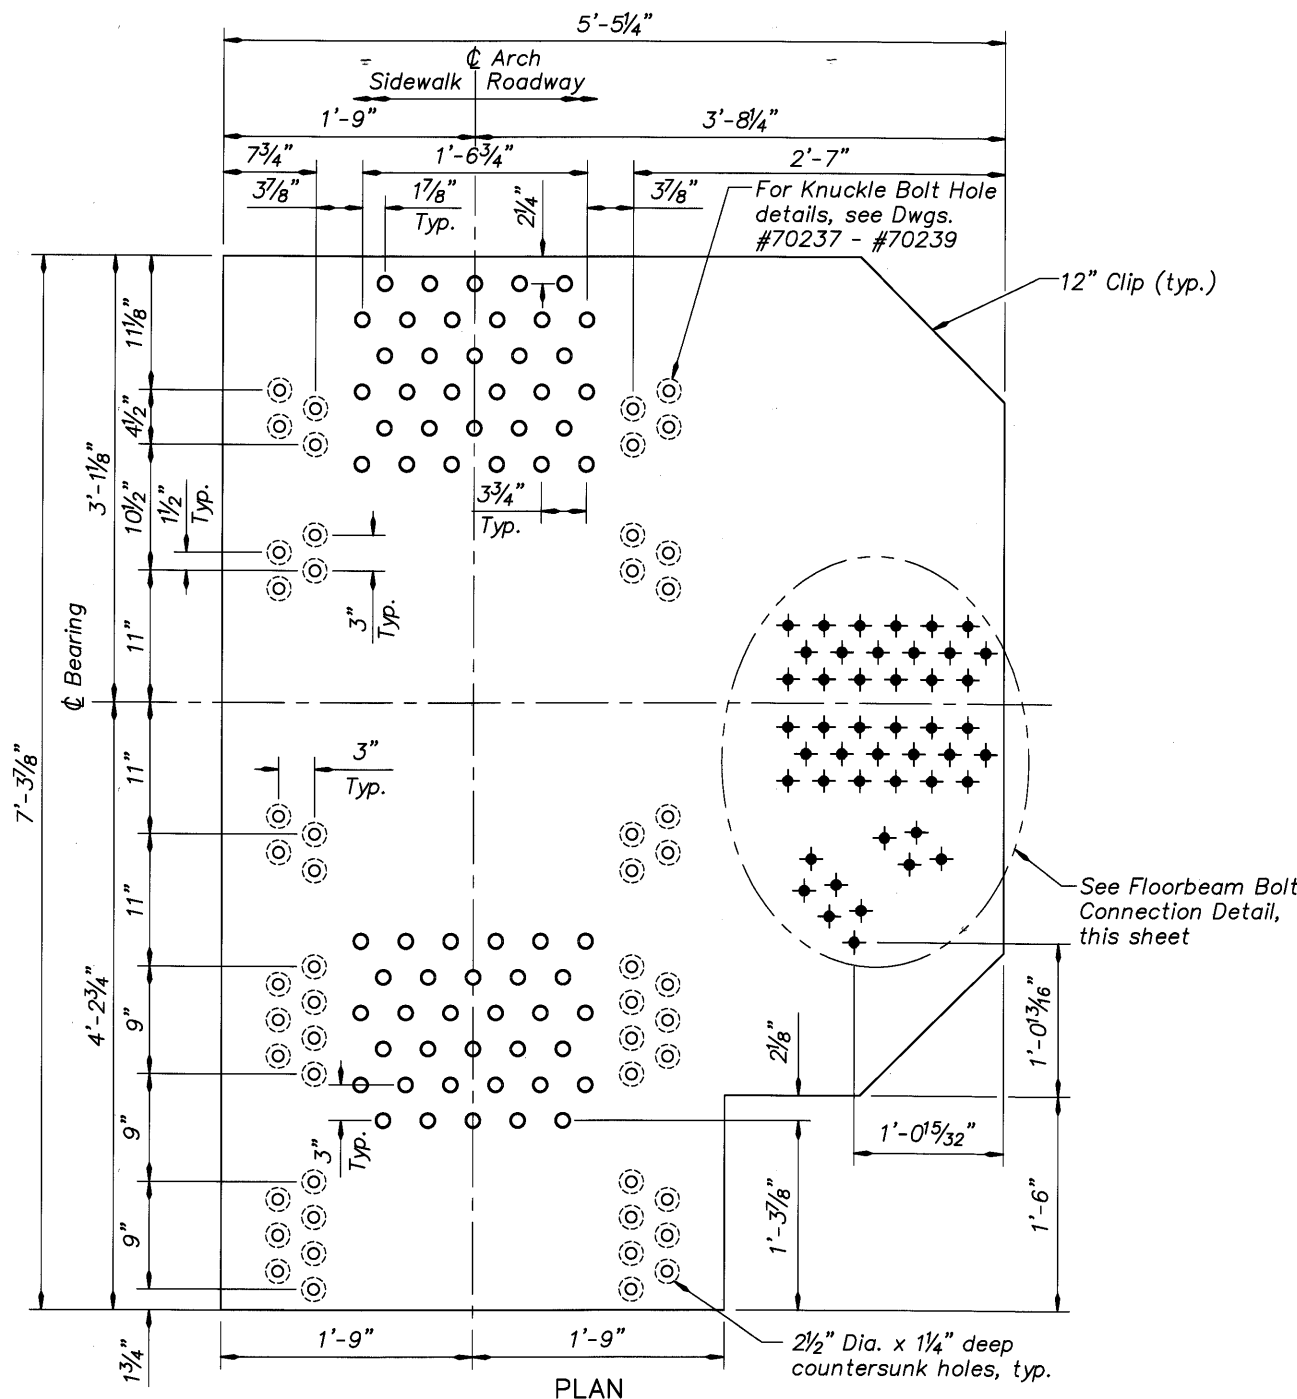


**DISTRIBUTION PLATE, BENT 4**  
Scale: 1 1/2" = 1'-0"

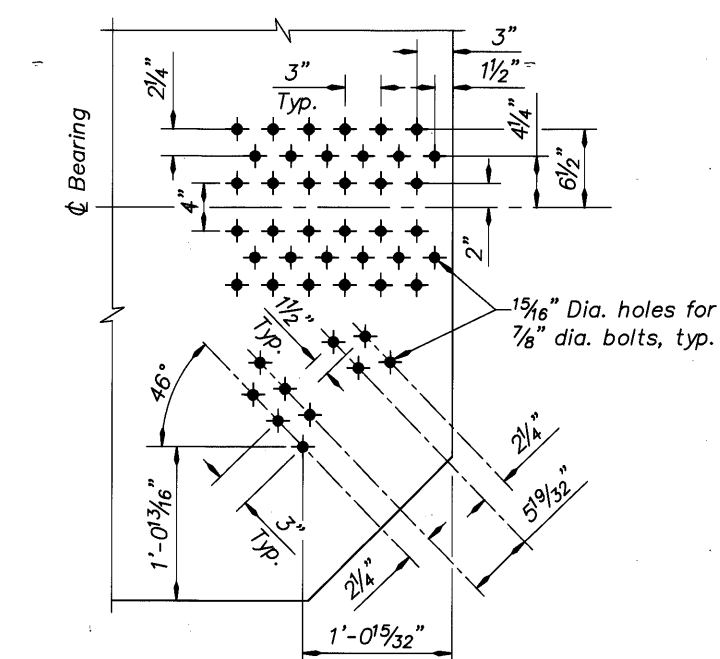



**FLOORBEAM BOLT CONNECTION DETAIL**  
Scale: 1 1/2" = 1'-0"

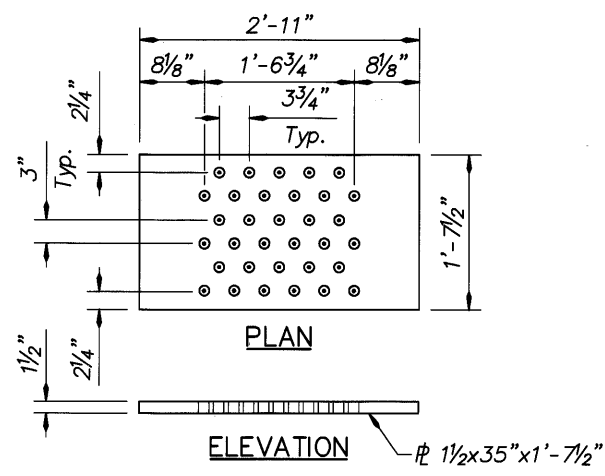


**LONGITUDINAL LOCKING PLATE**  
Scale: 1" = 1'-0"

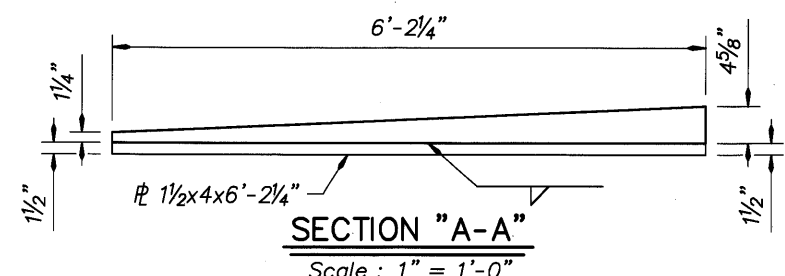

**SECTION "A-A"**  
Scale: 1" = 1'-0"

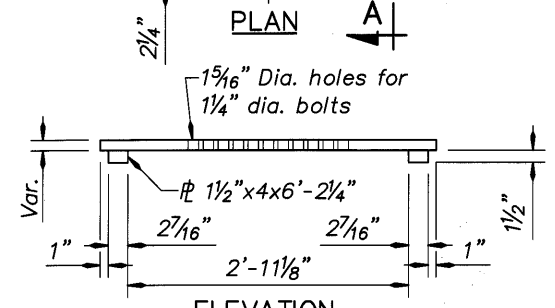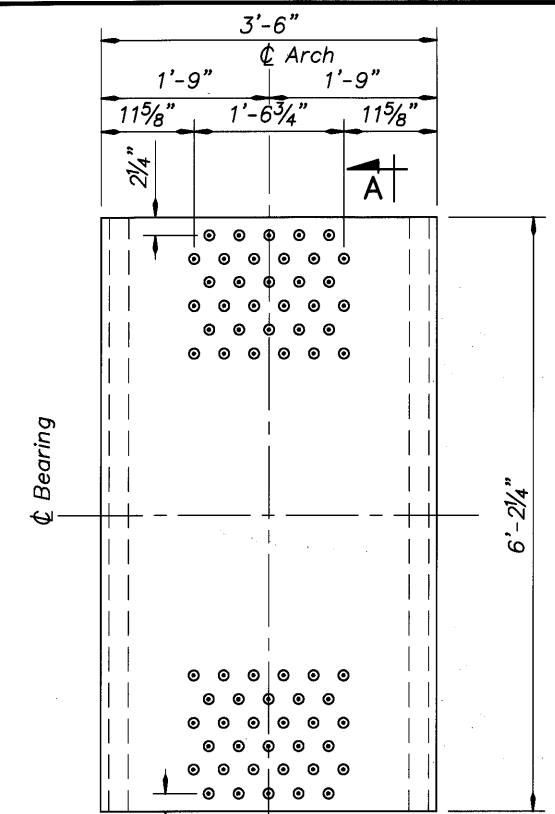

**SOLE PLATE**  
Scale: 1" = 1'-0"

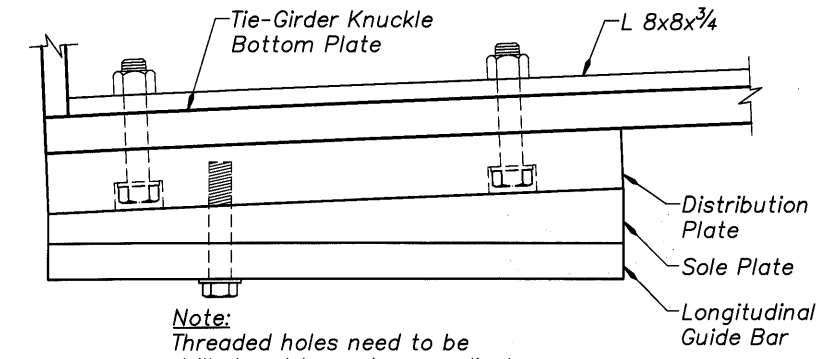

**BOLT ALIGNMENT DETAIL**  
No Scale

**LEGEND**

- ⊙ 1 1/16" Counterbore hole for 1" Dia. bolt
- 1/4" Threaded hole for 1/4" Dia. bolt
- ⊙ 1 5/16" Dia. hole for 1/4" dia. bolt
- + 1 5/16" Dia. holes for 7/8" dia. bolts, typ.

**Note:**  
Legends for Bearings at Bent 3 and for Bearings at Bent 4 are not the same.

**Note:**  
For Bearing Data Table and Expansion Bearing Notes, see Dwg. #70332.

DATE	REVISION	BY	REVIEWED
03/09	As-Constructed	TDF	
			R. Stone
			Shonn Mills
			Clifford Coulter

**DESIGNER**  
REGISTERED PROFESSIONAL ENGINEER  
70785  
DAVID EVANS AND ASSOCIATES INC.  
530 Center Street N.E., Suite 605  
Salem Oregon 97301  
Phone: 503.361.8635


CONNECTING COMMERCE AND COMMUNITY  
**MULTNOMAH COUNTY BRIDGES**  
TRANSPORTATION DIVISION  
**OREGON DEPARTMENT OF TRANSPORTATION BRIDGE ENGINEERING SECTION**

<b>BRIDGE NO.</b>	20136
<b>DATE</b>	Sept. 2005
<b>CALC. BOOK</b>	

MULTNOMAH CHANNEL & PNWR ETC., SAUVIE ISLAND RD.  
**BEARING DETAILS - BENT 4 (2 OF 2)**

<b>SHEET</b>	147
<b>OF</b>	173
<b>DRAWING NO.</b>	70335


**DO NOT SCALE THIS DRAWING.**  
FOLLOW DIMENSIONS. INDICATED SCALES CORRECT ONLY FOR FULL SIZE SHEET (22"x34").

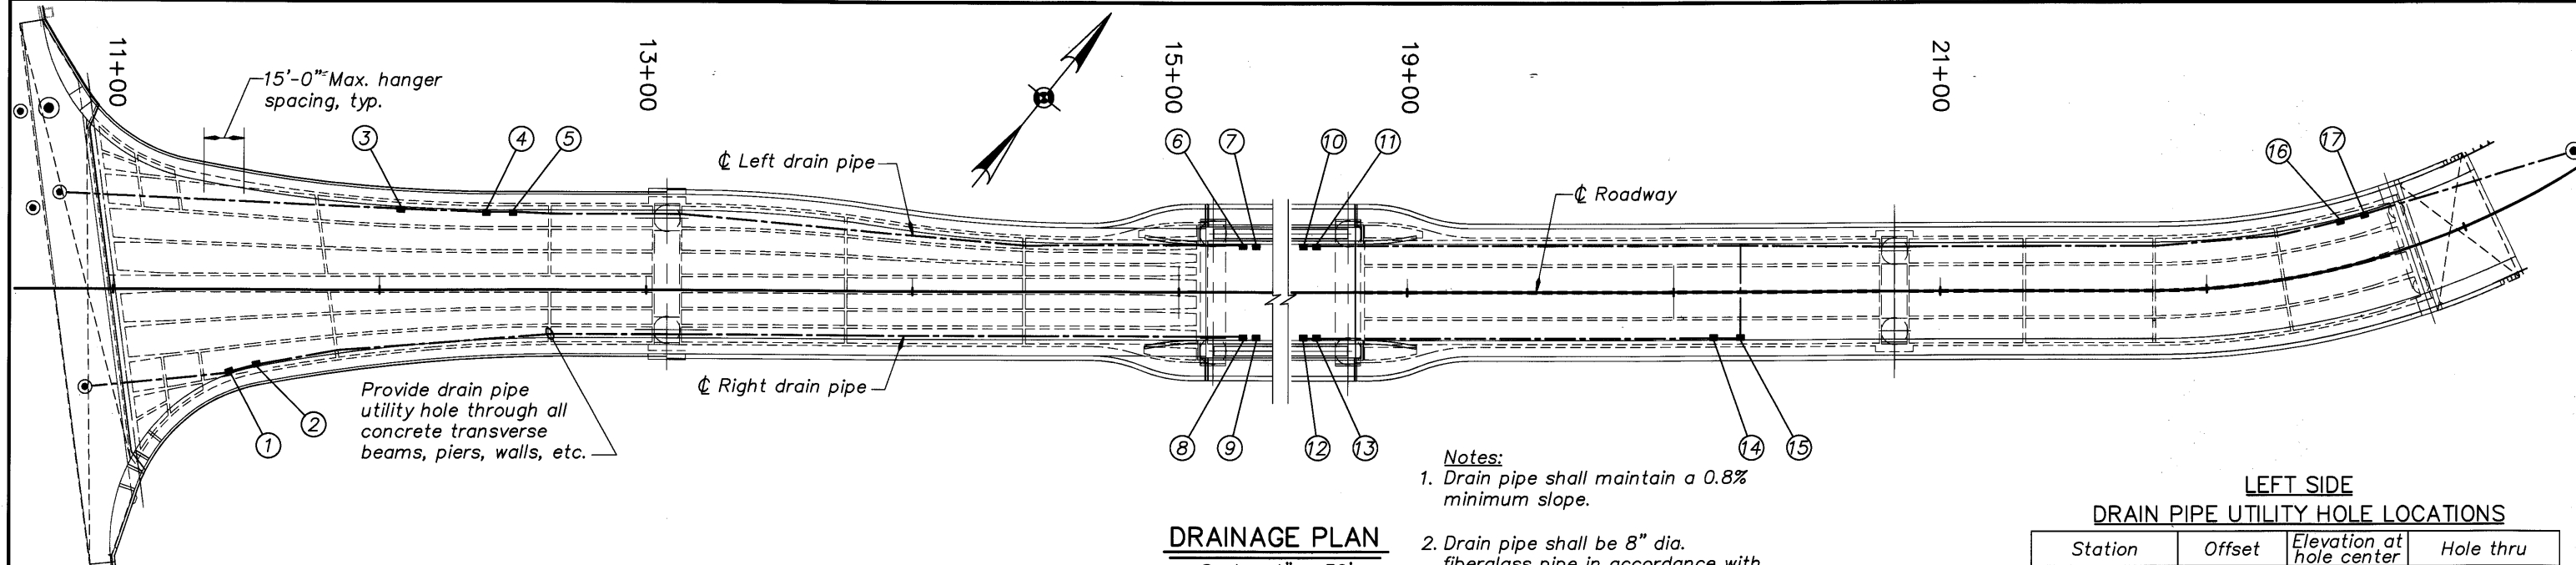

**STORMWATER DRAIN LOCATIONS**

Drain no.	Station	Offset	Top of grate elevation	Pipe I.E.	"D"*
1	11+44.00	31.17' Rt.	80.24	77.09	3'-1 3/4"
2	11+54.00	28.25' Rt.	80.49	77.23	3'-3"
3	12+08.00	30.75' Lt.	81.58	77.95	3'-7 1/2"
4	12+40.00	29.50' Lt.	81.67	78.38	3'-3 1/2"
5	12+50.00	29.42' Lt.	81.85	78.51	3'-4"
6	15+24.00	17.42' Lt.	85.52	82.18	3'-4"
7	15+29.00	17.42' Lt.	85.58	82.25	3'-4"
8	15+24.00	17.42' Rt.	85.52	82.18	3'-4"
9	15+29.00	17.42' Rt.	85.58	82.25	3'-4"
10	18+61.00	17.42' Lt.	81.23	77.90	3'-4"
11	18+66.00	17.42' Lt.	81.01	77.63	3'-4 1/2"
12	18+61.00	17.42' Rt.	81.23	77.90	3'-4"
13	18+66.00	17.42' Rt.	81.01	77.63	3'-4 1/2"
14	20+15.00	17.42' Rt.	72.85	69.51	3'-4"
15	20+25.00	17.42' Rt.	72.29	68.96	3'-4"
16	22+55.00	17.42' Lt.	56.96	51.34	5'-7 1/2"
17	22+65.00	17.42' Lt.	56.28	50.77	5'-6"

\*See Catch Basin Details on Dwg. #70337 for location of "D"

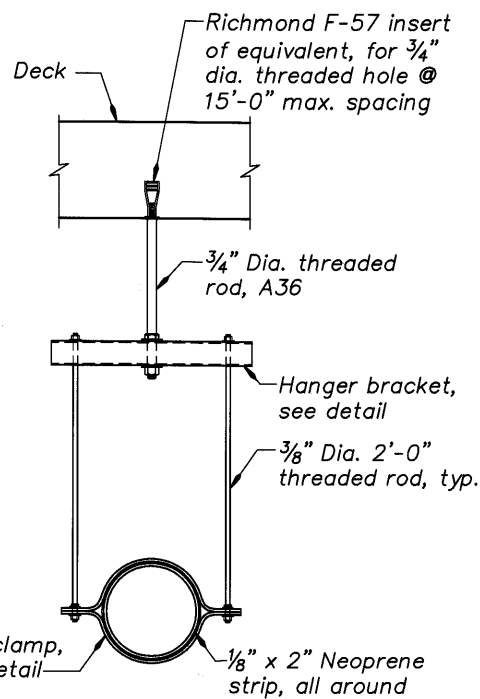


- Notes:**
1. Provide nuts and washers for carbon steel fasteners per section 00560 of the Standard Specifications.
  2. All components and hardware are to be hot-dipped galvanized.
  3. Use hanger system shown or approved equal.
  4. Drain pipe hangers need to maintain a minimum of 2'-0" from the face of the utility hole opening and shall be spaced a maximum of 15'-0"

**DRAINAGE PLAN**


Scale: 1" = 30'

- Notes:**
1. Drain pipe shall maintain a 0.8% minimum slope.
  2. Drain pipe shall be 8" dia. fiberglass pipe in accordance with Special Provision 00581.
  3. Install expansion devices and flexible couplings in drain pipe per Special Provision 00581.

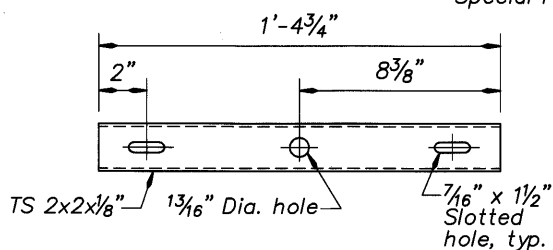


**HANGER BRACKET DETAIL**

Scale: 3" = 1'-0"

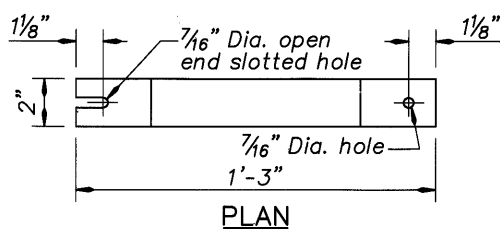

**PLAN**

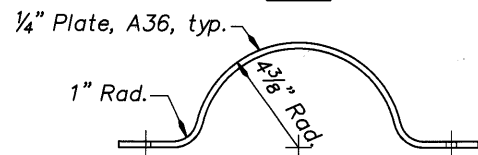

**ELEVATION**

**PIPE CLAMP DETAIL**


Scale: 3" = 1'-0"

**LEFT SIDE DRAIN PIPE UTILITY HOLE LOCATIONS**

Station	Offset	Elevation at hole center	Hole thru
10+97.61	37.58' Lt.	77.06	Bent 1
11+10.79	36.75' Lt.	77.18	Span 1 Diaph.
11+25.16	35.83' Lt.	77.31	Span 1 Diaph.
11+77.24	32.67' Lt.	77.79	Span 1 Diaph.
12+63.32	29.42' Lt.	78.59	Span 1 Diaph.
13+02.32	29.42' Lt.	78.95	Bent 2
13+13.32	29.42' Lt.	79.05	Bent 2
13+75.40	24.83' Lt.	80.12	Span 2 Diaph.
14+42.40	17.42' Lt.	81.23	Span 2 Diaph.
15+06.66	17.42' Lt.	82.30	Bent 3
15+15.57	17.42' Lt.	82.41	Span 3 Flr. Bm.
18+75.07	17.42' Lt.	77.46	Span 3 Flr. Bm.
18+84.07	17.42' Lt.	76.96	Bent 4
20+77.32	17.42' Lt.	65.33	Bent 5
20+88.30	17.42' Lt.	64.66	Bent 5
21+32.08	17.42' Lt.	61.96	Span 5 Diaph.
21+79.73	17.42' Lt.	58.08	Span 5 Diaph.
22+29.60	17.42' Lt.	54.01	Span 5 Diaph.
22+75.97	17.42' Lt.	50.22	Bent 6

**RIGHT SIDE DRAIN PIPE UTILITY HOLE LOCATIONS**

Station	Offset	Elevation at hole center	Hole thru
11+06.98	33.25' Rt.	76.93	Bent 1
11+19.98	32.67' Rt.	77.10	Span 1 Diaph.
11+34.11	31.83' Rt.	77.29	Span 1 Diaph.
11+84.47	23.25' Rt.	77.97	Span 1 Diaph.
12+63.32	17.42' Rt.	79.02	Span 1 Diaph.
13+02.32	17.42' Rt.	79.31	Bent 2
13+13.32	17.42' Rt.	79.45	Bent 2
13+75.40	17.42' Rt.	80.53	Span 2 Diaph.
14+42.40	17.42' Rt.	81.42	Span 2 Diaph.
15+06.65	17.42' Rt.	82.28	Bent 3
15+15.57	17.42' Rt.	82.40	Span 3 Flr. Bm.
18+75.07	17.42' Rt.	77.47	Span 3 Flr. Bm.
18+84.07	17.42' Rt.	76.98	Bent 4

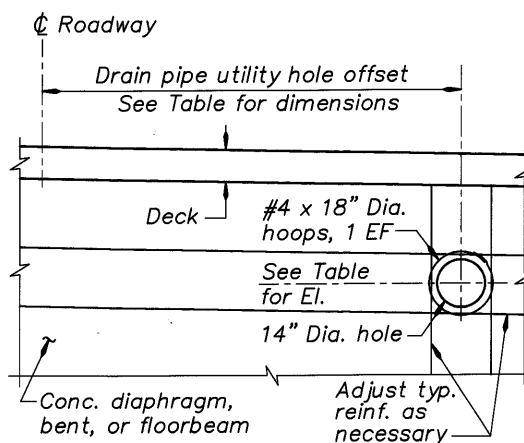


**DRAIN PIPE UTILITY HOLE DETAIL**


No Scale

DO NOT SCALE THIS DRAWING. FOLLOW DIMENSIONS. INDICATED SCALES CORRECT ONLY FOR FULL SIZE SHEET (22"x34").



	DATE: 03/09 REVISION: As-Constructed BY: R. Elwood TDF:	DESIGNER: R. Elwood CHECKED: Shonn Mills REVIEWED: Kent Cordtz	REGISTERED PROFESSIONAL ENGINEER DAVID EVANS AND ASSOCIATES INC. 530 Center Street N.E., Suite 605 Salem Oregon 97301 Phone: 503.361.8635	MULTNOMAH COUNTY BRIDGES TRANSPORTATION DIVISION OREGON DEPARTMENT OF TRANSPORTATION BRIDGE ENGINEERING SECTION	BRIDGE NO.: 20136 DATE: Sept. 2005 CALC. BOOK:	MULTNOMAH CHANNEL & PNWR ETC., SAUVIE ISLAND RD. DECK DRAINAGE (1 OF 2)	SHEET 148 OF 173 DRAWING NO. 70336
	EXPIRES: 6-30-07						

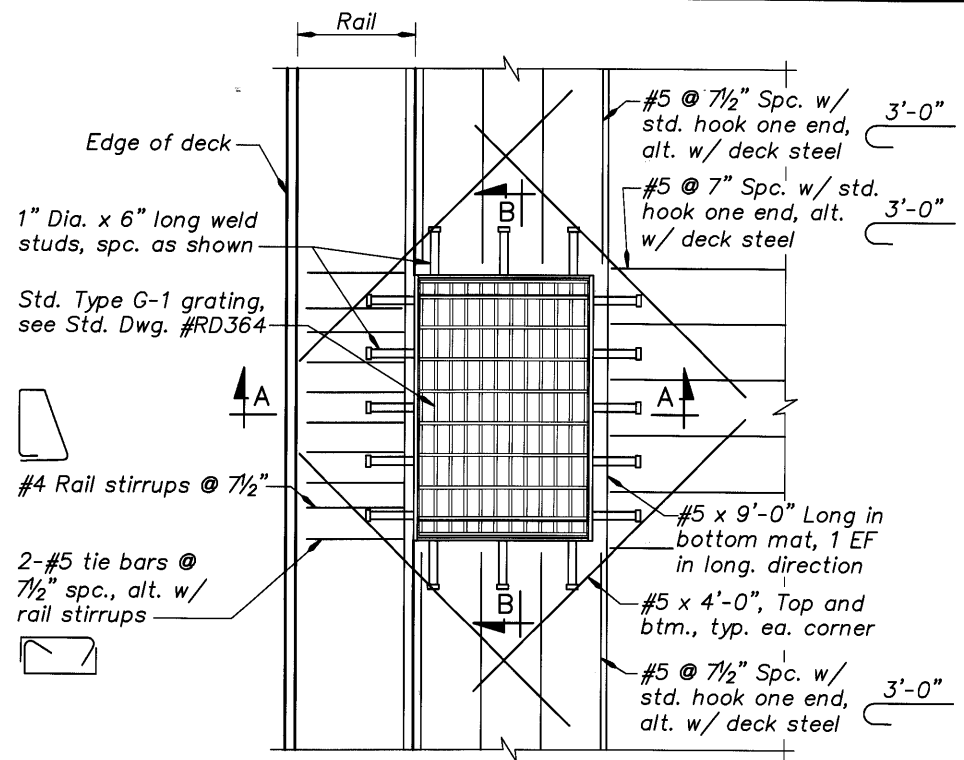


**TYPICAL SPAN 3 DRAIN PLAN**  
Scale: 1" = 1'-0"

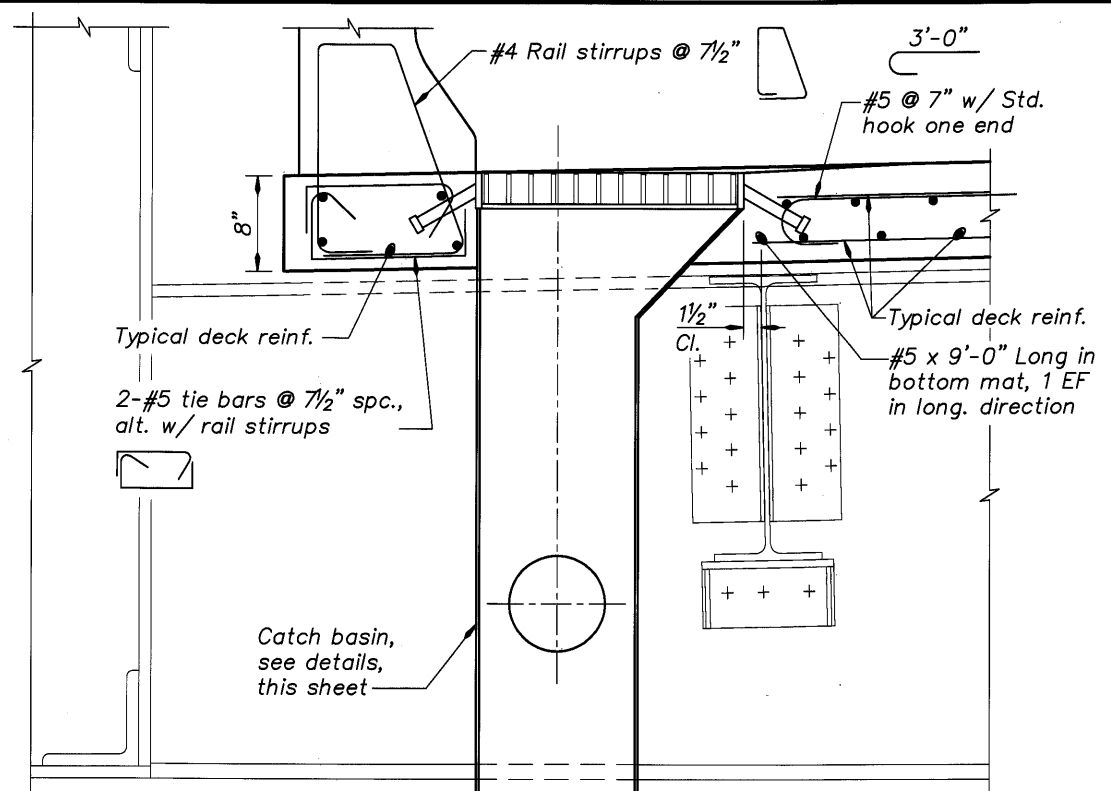


**SECTION A-A**  
Scale: 1 1/2" = 1'-0"

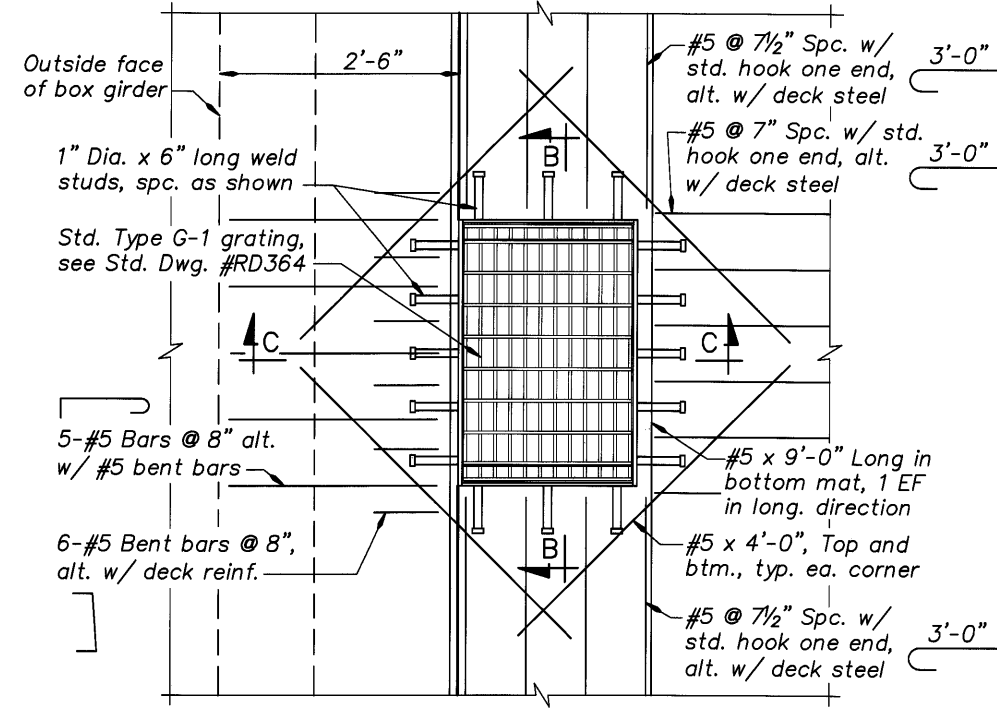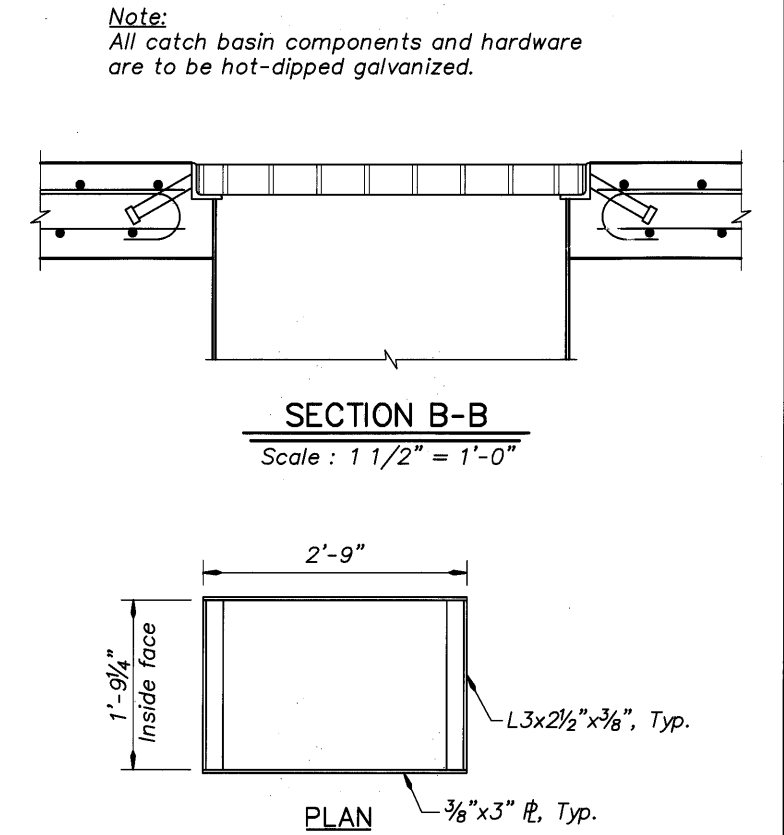

**TYPICAL SPAN 4 DRAIN PLAN**  
(Spans 1, 2, & 5 similar)  
Scale: 1" = 1'-0"

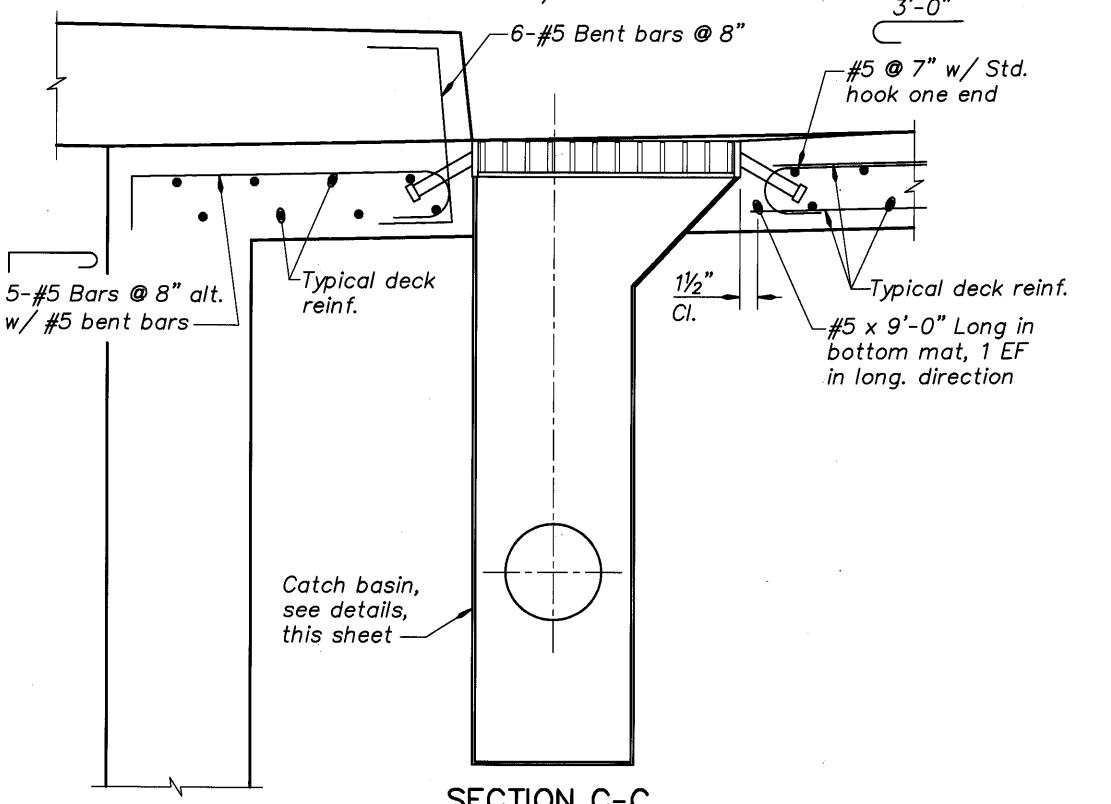

**SECTION C-C**  
Scale: 1 1/2" = 1'-0"

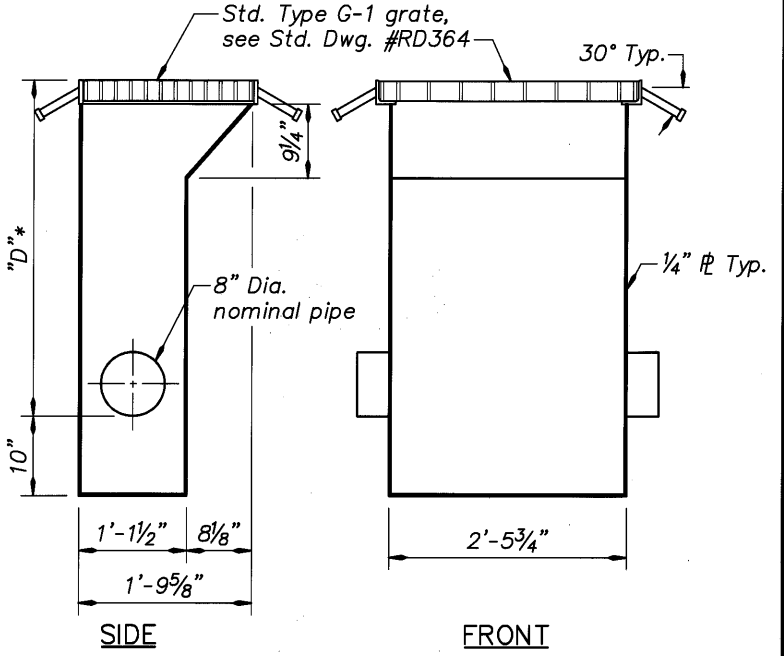

**CATCH BASIN DETAILS**  
Scale: 1" = 1'-0"


DO NOT SCALE THIS DRAWING. FOLLOW DIMENSIONS. INDICATED SCALES CORRECT ONLY FOR FULL SIZE SHEET (22"x34").

DATE	REVISION	BY	DESIGNER
03/09	As-Constructed	TDF	R. Elwood
			Shonn Mills
			Kent Cortz

**DESIGNER**  
REGISTERED PROFESSIONAL ENGINEER  
70783  
DAVID EVANS AND ASSOCIATES INC.  
530 Center Street N.E., Suite 605  
Salem Oregon 97301  
Phone: 503.361.8635

CONNECTING COMMERCE AND COMMUNITY  
**MULTNOMAH COUNTY BRIDGES**  
TRANSPORTATION DIVISION  
OREGON DEPARTMENT OF TRANSPORTATION  
BRIDGE ENGINEERING SECTION


BRIDGE NO.	DATE	CALC. BOOK	SHEET
20136	Sept. 2005		149 OF 173
MULTNOMAH CHANNEL & PNWR ETC., SAUVIE ISLAND RD.			DRAWING NO. 70337
DECK DRAINAGE (2 OF 2)			

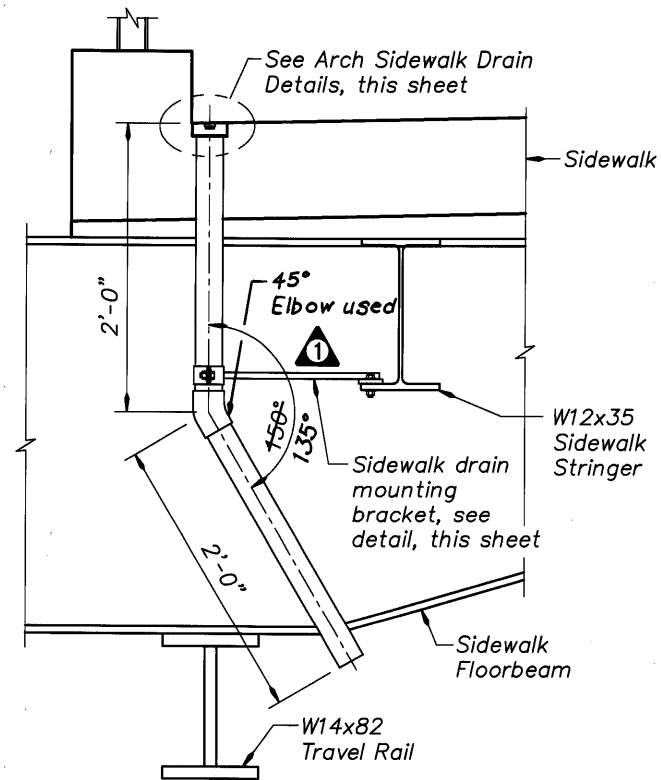

**SIDEWALK DRAIN PIPE ELEVATION**

Scale : 1 1/2" = 1'-0"




**Note:**  
Adjust typical sidewalk reinforcing steel spacing as necessary to provide 1/2" clearance to drain pipe.

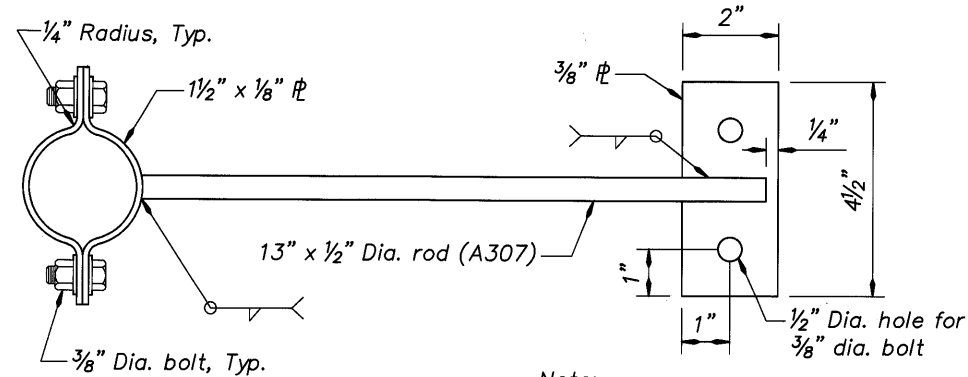

**SIDEWALK DRAIN MOUNTING BRACKET**

Scale : 6" = 1'-0"

**Note:**  
Field drill holes in bottom flange at sidewalk stringers after sidewalk drain is in place.

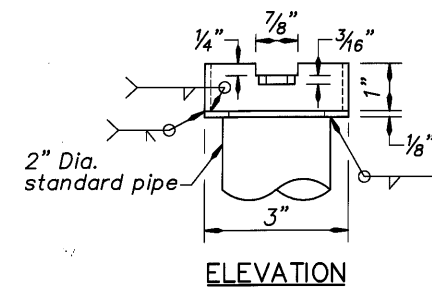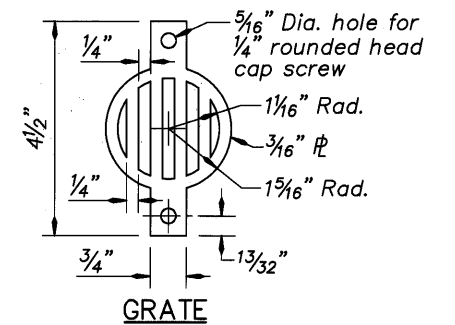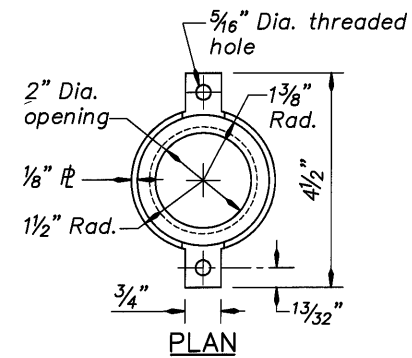

**ARCH SIDEWALK DRAIN DETAILS**


Scale : 6" = 1'-0"

**Notes:**  
Drain grate shall be brass ASTM B36 material.  
Drain frame shall be A36 steel. All frame components and hardware shall be hot-dipped galvanized.  
Drains shall be as shown or may be substituted with an approved equivalent upon approval of the Engineer.

See Dwg. #70210 and 70211 for drain layout and locations

DO NOT SCALE THIS DRAWING. FOLLOW DIMENSIONS. INDICATED SCALES CORRECT ONLY FOR FULL SIZE SHEET (22"x34").

	DATE	REVISION	BY	R. Elwood Shonn Mills Clifford Coulter			BRIDGE NO. 20136  DATE Sept. 2005  CALC. BOOK	MULTNOMAH CHANNEL & PNWR ETC., SAUVIE ISLAND RD.	SHEET 150 OF 173.
	03/09	As-Constructed	TDF						

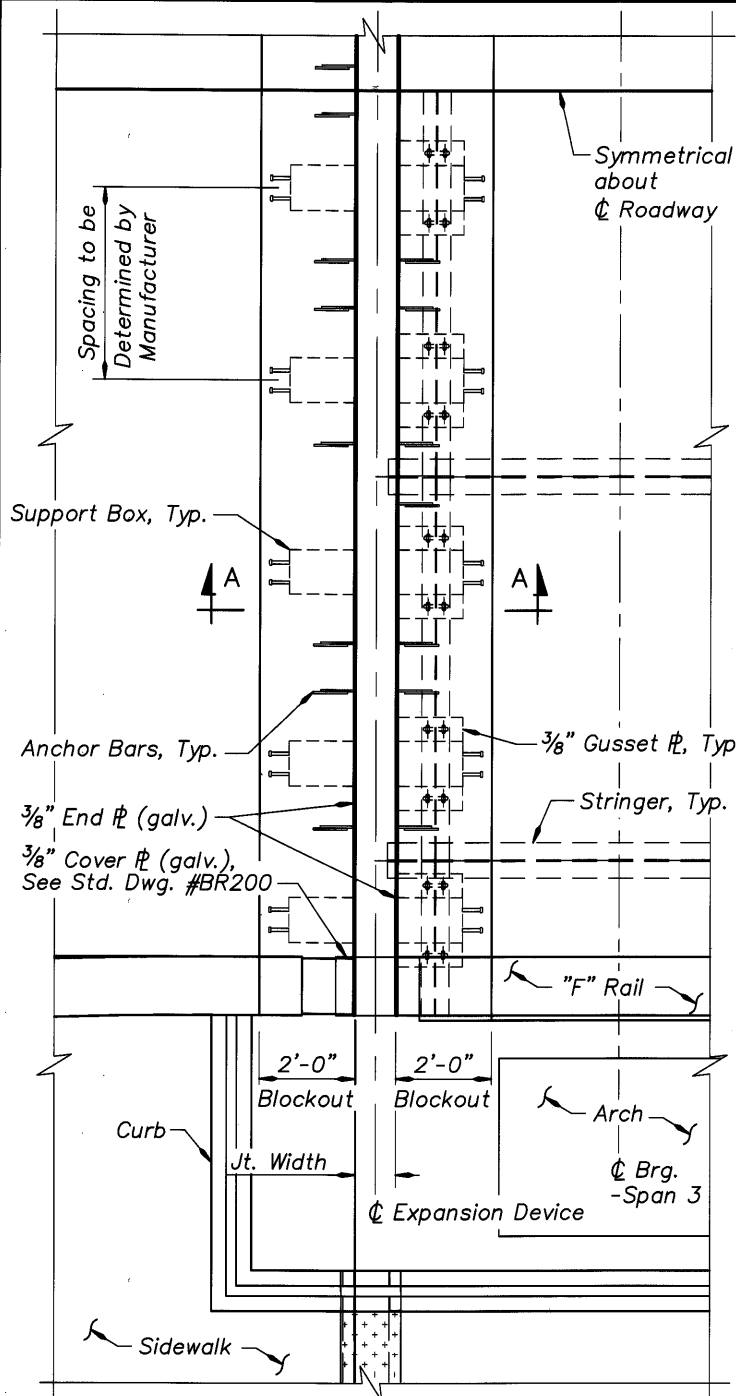


**PART-PLAN AT BENT 3**

Scale: 1/2" = 1'-0"

7/8" x 2 1/4" Slotted hole, typ. in top flange of end diaph.


End Diaph. W12x35

3/8" Gusset Pl. welded to bottom of support box

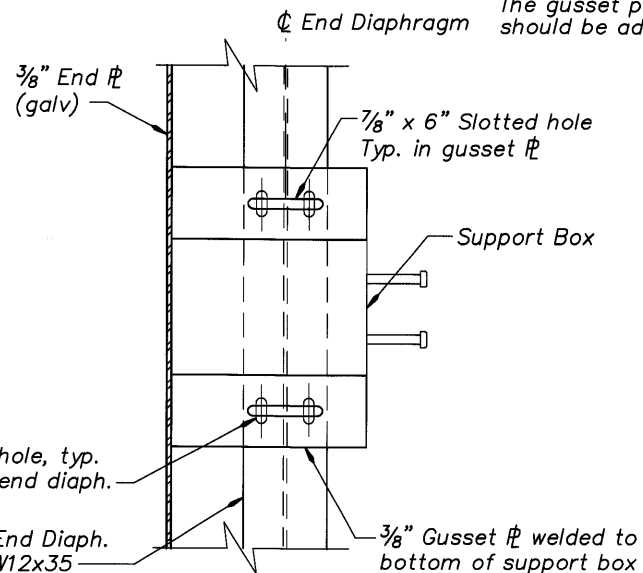

**SECTION C-C**


Scale: 1 1/2" = 1'-0"

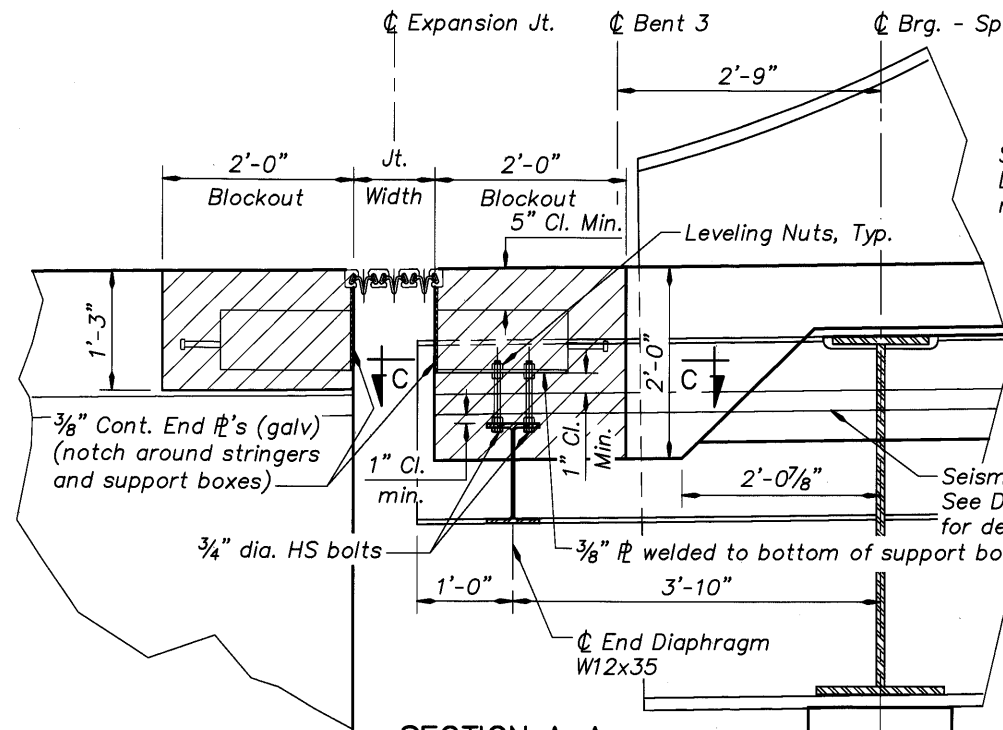

**SECTION A-A**

Scale: 1" = 1'-0"

(Reinforcement omitted for clarity)

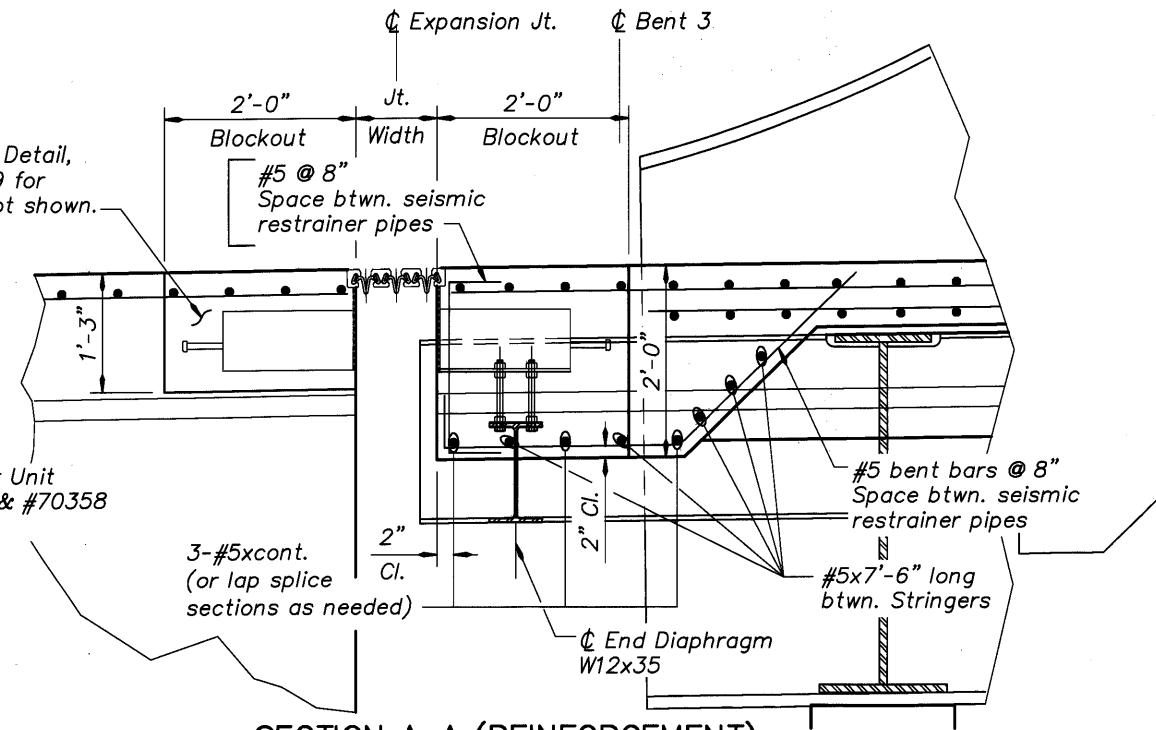

**SECTION A-A (REINFORCEMENT)**

Scale: 1" = 1'-0"

(Showing additional reinforcement at expansion joint.)

**MODULAR EXPANSION DEVICE NOTES:**

The acceptable Manufacturers and models of expansion device shall be as described in the Special Provisions.

Device shown is schematic only. Total number of support bars to be used as per Manufacturer's requirements.


The gusset plate shown is a schematic support system and should be adjusted to meet manufacturer's requirements.

Show the position of the support boxes and modification of anchorages due to the location of the steel girders and support diaphragm in the shop drawings.

Coordinate the location of support boxes to avoid interference with the steel member shear studs.

Install the expansion device on grade parallel to the slope and grade of the deck.

See Dwg. #70341 for Sidewalk Expansion Cover Plate details.

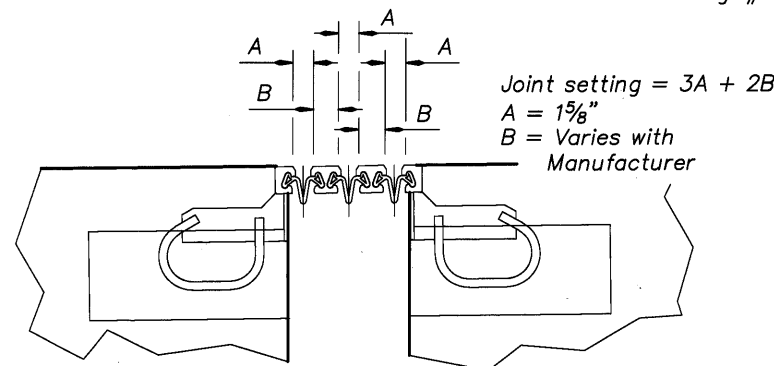


Decrease Joint setting 1/2 inch for every 10°F of structure temperature above 52°F.

Increase Joint setting 1/2 inch for every 10°F of structure temperature below 52°F.

**JOINT SETTING DETAIL**

No Scale

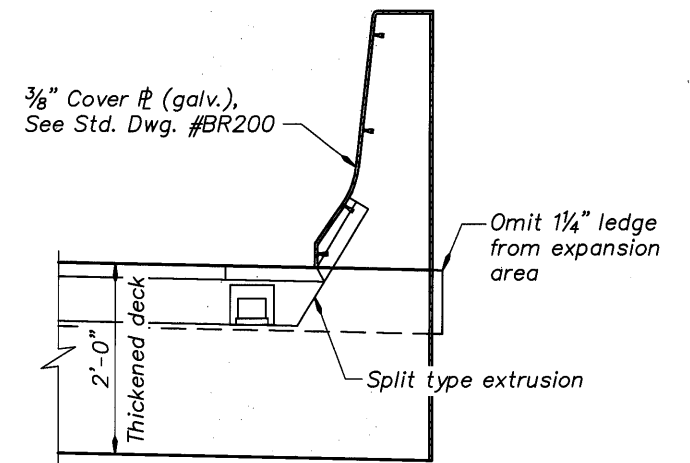


**SECTION AT "F" RAIL EXPANSION JOINT**

Scale: 1" = 1'-0"


DO NOT SCALE THIS DRAWING. FOLLOW DIMENSIONS. INDICATED SCALES CORRECT ONLY FOR FULL SIZE SHEET (22"x34").

DATE	03/09	REVISION	As-Constructed	BY	J. Patton	DESIGNER	DAVID EVANS AND ASSOCIATES INC. 530 Center Street N.E., Suite 605 Salem Oregon 97301 Phone: 503.361.8635	MULTNOMAH COUNTY BRIDGES	TRANSPORTATION DIVISION OREGON DEPARTMENT OF TRANSPORTATION BRIDGE ENGINEERING SECTION	BRIDGE NO.	20136	SHEET	151
	DRAFTED:		TDF		Checked:						Oliver Mueller		DATE
				REVIEWED:	Clifford Coulter	EXPIRES:	6-30-07			CALC. BOOK		DRAWING NO.	70339
											EXPANSION JOINT DETAILS (1 OF 4)		

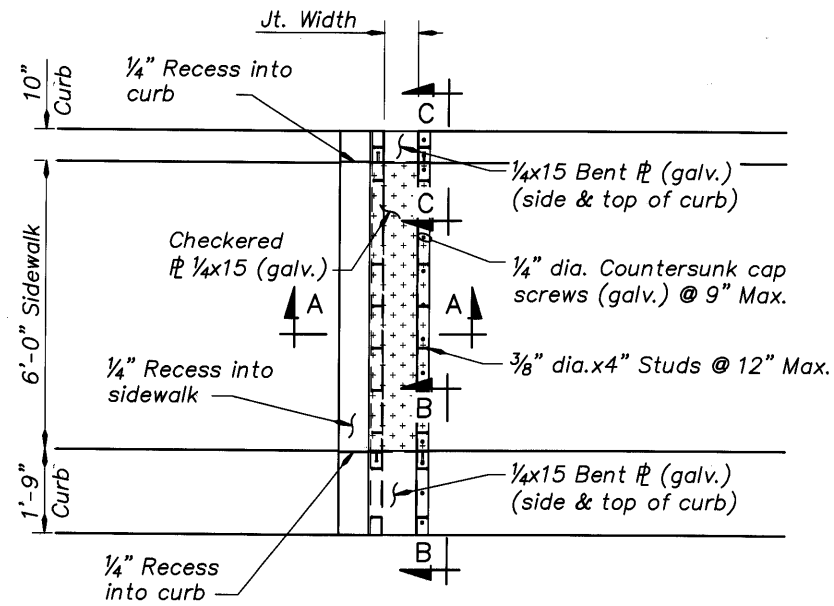


**SIDEWALK COVER PLATES AT BENT 3 EXPANSION JOINT**

Scale : 1/2" = 1'-0"

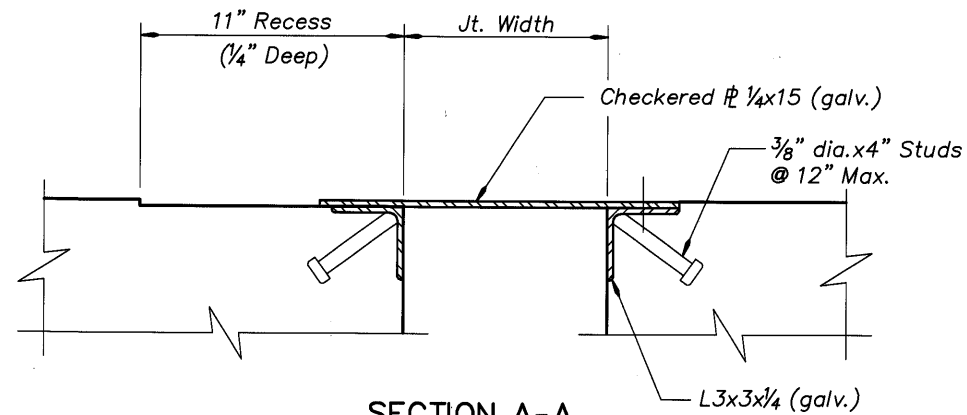


**SECTION A-A**

Scale : 3" = 1'-0"

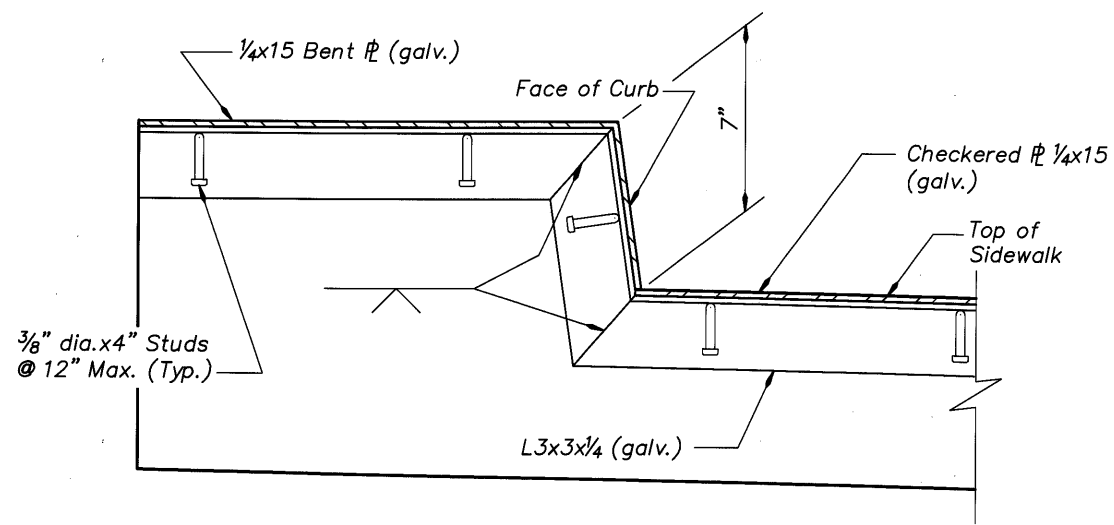

**SECTION B-B**

Scale : 3" = 1'-0"

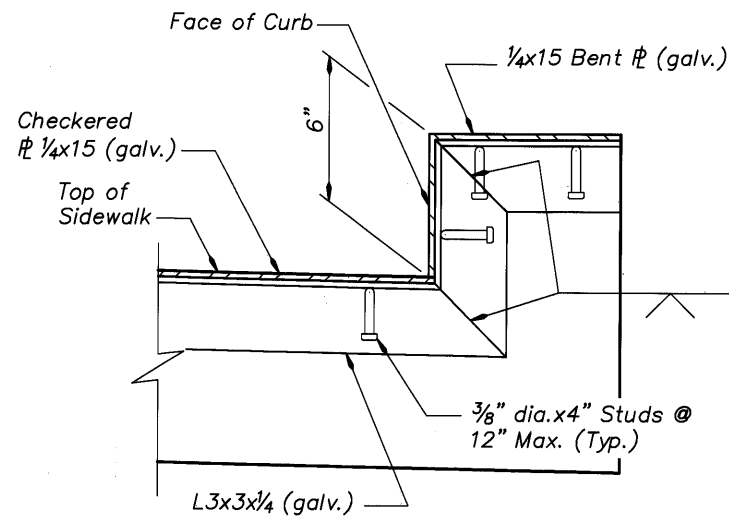


**SECTION C-C**

Scale : 3" = 1'-0"


DO NOT SCALE THIS DRAWING.  
FOLLOW DIMENSIONS. INDICATED  
SCALES CORRECT ONLY FOR  
FULL SIZE SHEET (22"x34").

	DATE	REVISION	BY	J. Patton	<b>DESIGNER</b>  <b>DAVID EVANS AND ASSOCIATES INC.</b> 530 Center Street N.E., Suite 605 Salem Oregon 97301 Phone: 503.361.8635	 TRANSPORTATION DIVISION <b>OREGON DEPARTMENT OF TRANSPORTATION BRIDGE ENGINEERING SECTION</b>	BRIDGE NO.	20136	MULTNOMAH CHANNEL & PNWR ETC., SAUVIE ISLAND RD.	SHEET	152
	03/09	As-Constructed	TDF	Oliver Mueller			DATE	Sept. 2005		OF	173.
				Clifford Coulter			CALC. BOOK		EXPANSION JOINT DETAILS (2 OF 4)	DRAWING NO.	70340

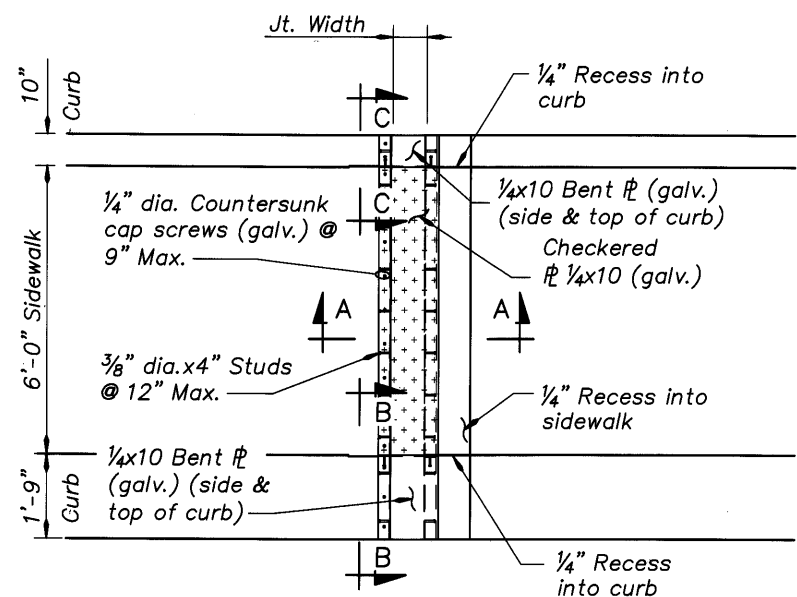


**SIDEWALK COVER PLATES AT BENT 4 EXPANSION JOINT**

Scale : 1/2" = 1'-0"

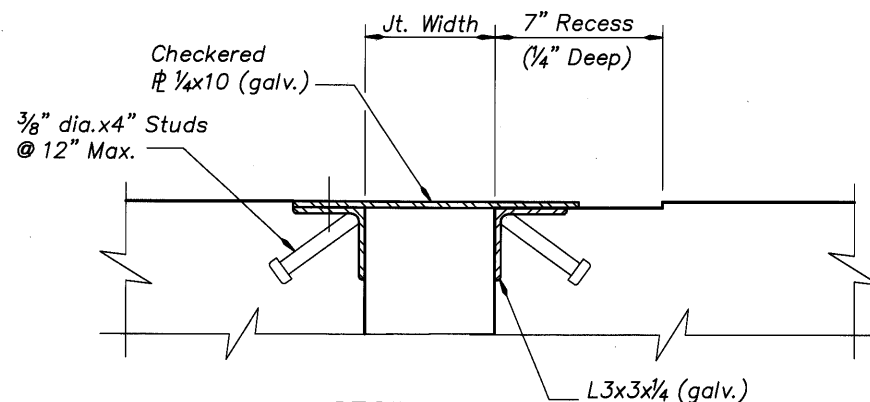

**SECTION A-A**


Scale : 3" = 1'-0"

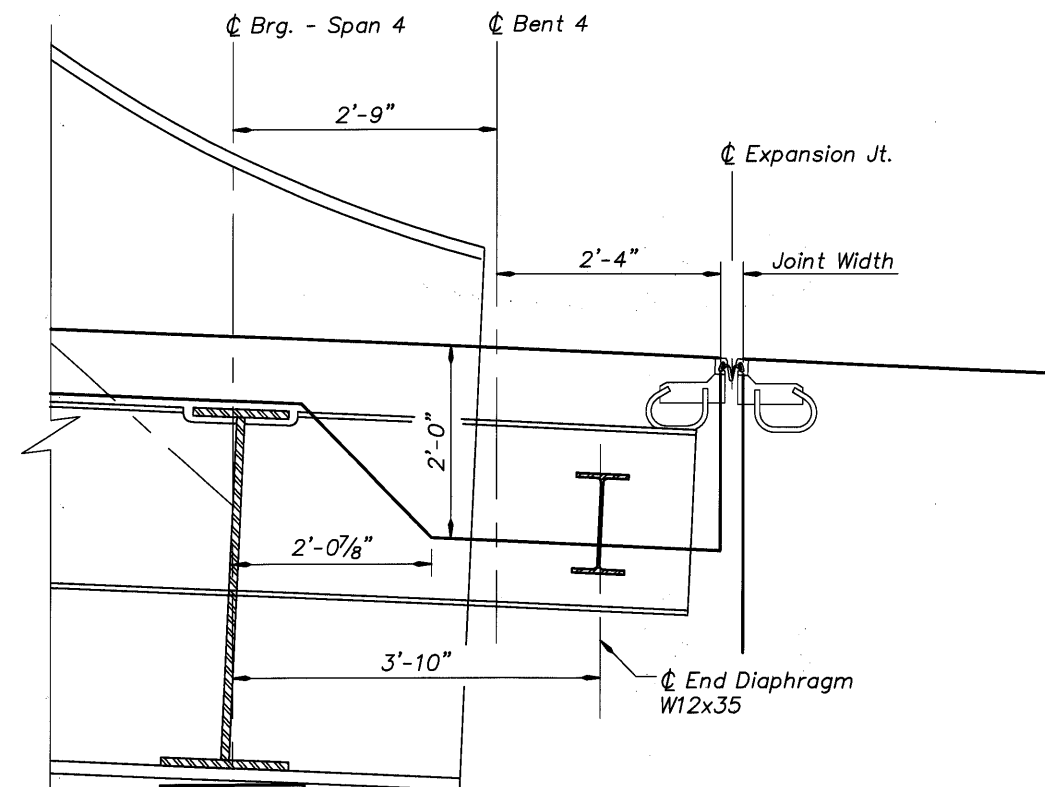

**SECTION AT DECK**


Scale : 1" = 1'-0"

For thickened deck reinforcement, see Section A-A, Dwg. #70339.

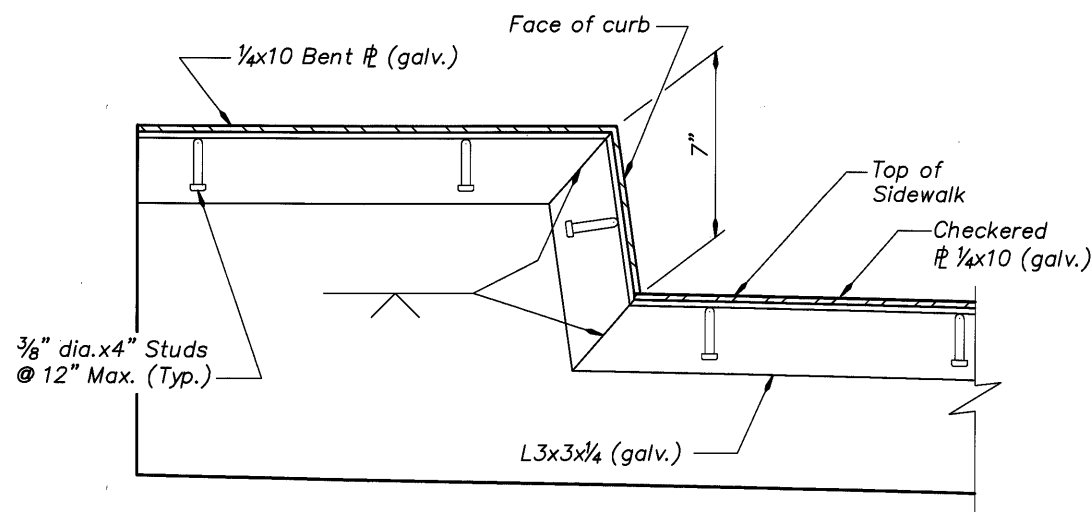

**SECTION B-B**

Scale : 3" = 1'-0"

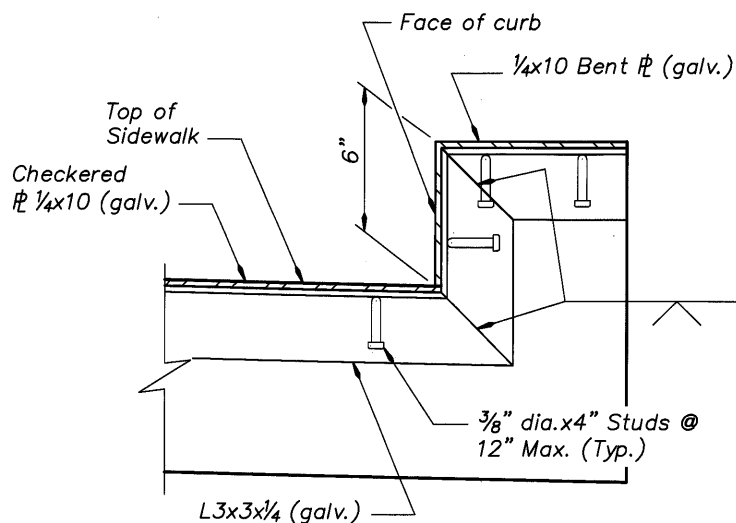

**SECTION C-C**

Scale : 3" = 1'-0"

**MODULAR EXPANSION DEVICE NOTES:**

Device shown is schematic only.

Install the expansion device on grade parallel to the slope and grade of the deck.


DO NOT SCALE THIS DRAWING. FOLLOW DIMENSIONS. INDICATED SCALES CORRECT ONLY FOR FULL SIZE SHEET (22"x34").

DATE	03/09	REVISION	As-Constructed	BY	D. Gatshall	DESIGNER			TRANSPORTATION DIVISION BRIDGE NO. 20136	MULTNOMAH CHANNEL & PNWR ETC., SAUVIE ISLAND RD.	SHEET 153 OF 173
	DATE		Sept. 2005		Oliver Mueller						
REVIEWED:			Clifford Coulter			EXPIRES: 6-30-07				EXPANSION JOINT DETAILS (3 OF 4)	



Single Strip Seal  
Expansion Joint, see  
Std. Dwg. #BR145  
and Joint Setting  
Detail on this sheet

Field splice required in expansion  
joint assembly for stage construction.  
Splice not permitted in Strip Seal Gland

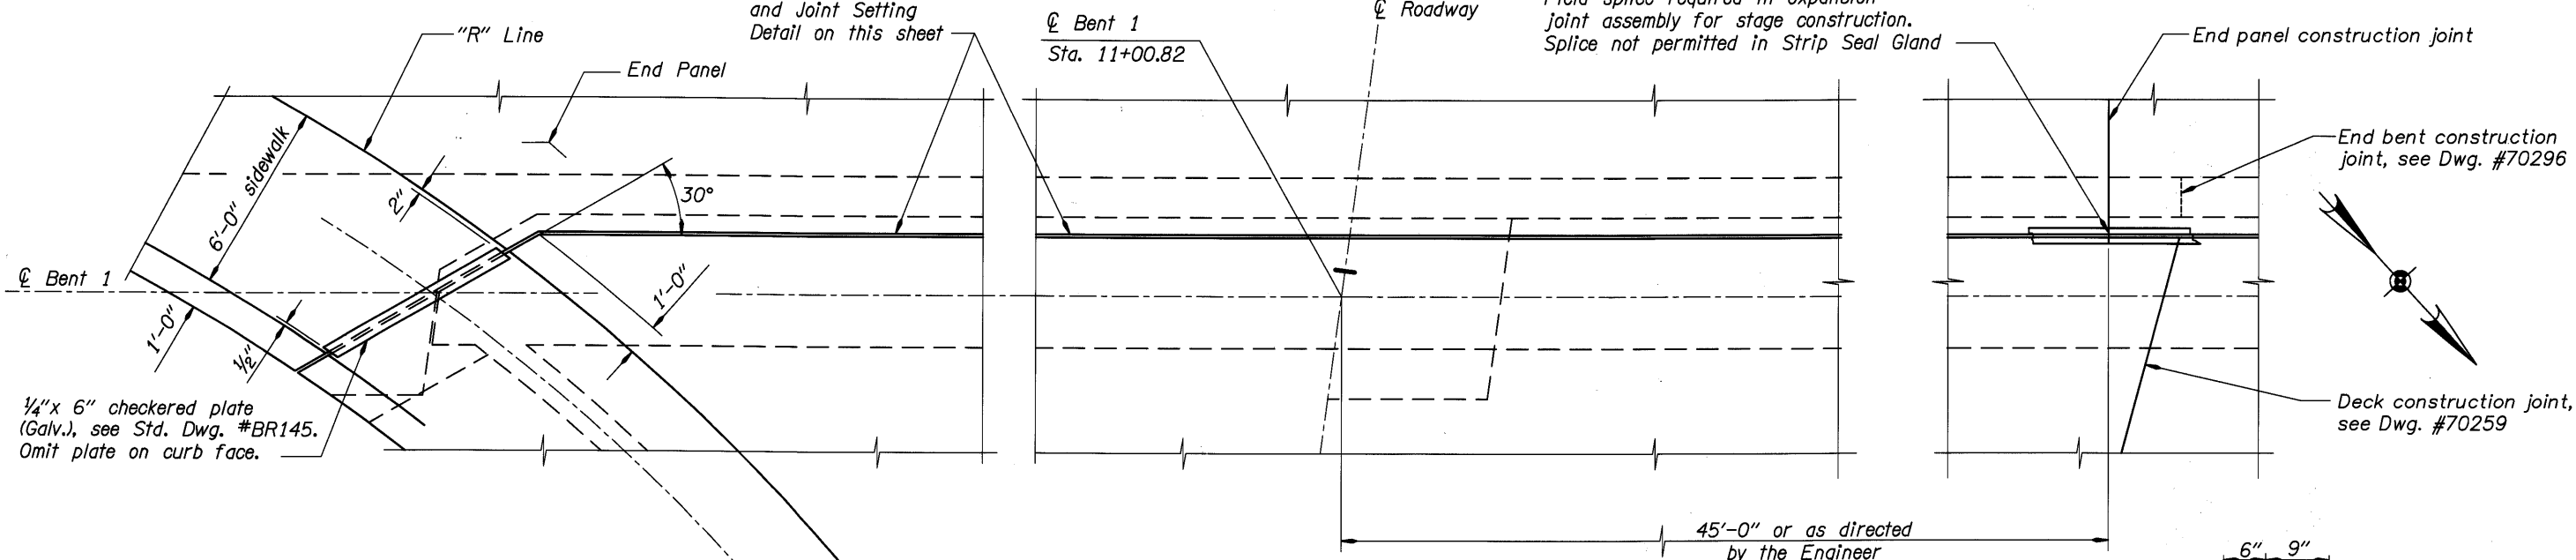


RIGHT SIDEWALK  
(Left sidewalk similar)

PART PLAN - BENT 1


Scale: 3/8"=1'-0"

MANDATORY SPLICE (EXPANSION JOINT ASSEMBLY)

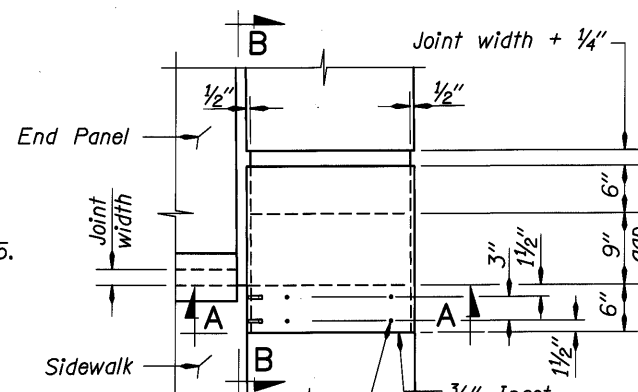

CURB PLAN


Scale: 1"=1'-0"

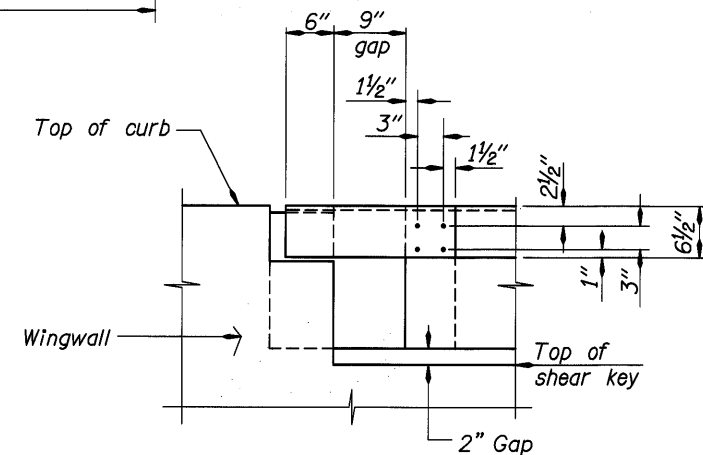

SECTION B-B

Scale: 1"=1'-0"

Field splice required in expansion  
joint assembly for stage construction.  
Splice not permitted in Strip Seal Gland

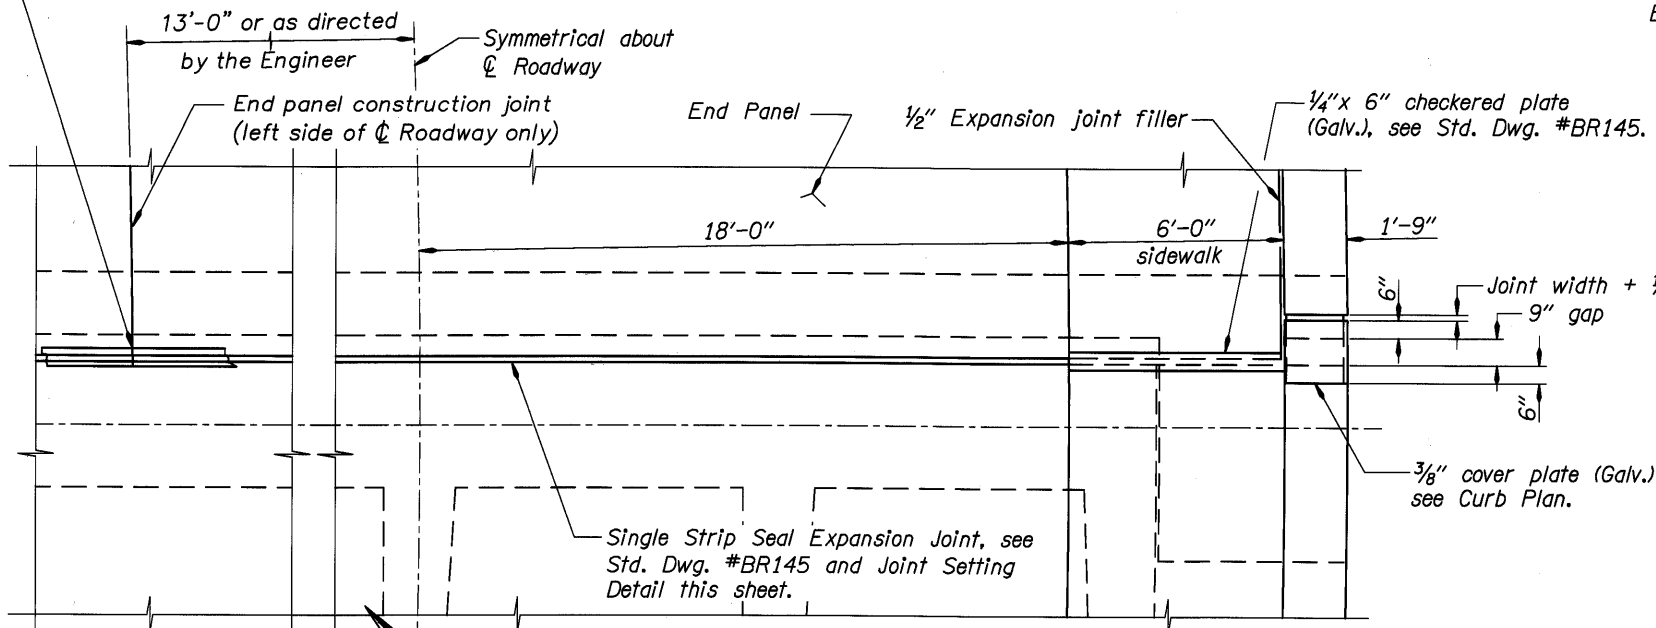


RIGHT SIDEWALK  
(Left sidewalk similar)

PART PLAN - BENT 6

Scale: 3/8"=1'-0"

Thickened overhang as  
required for expansion joint.


3/8" Inset  
3/8" dia. countersunk bolts to  
fasten all plates to parapet.  
Galvanize hardware above  
the deck or sidewalk level  
as noted.

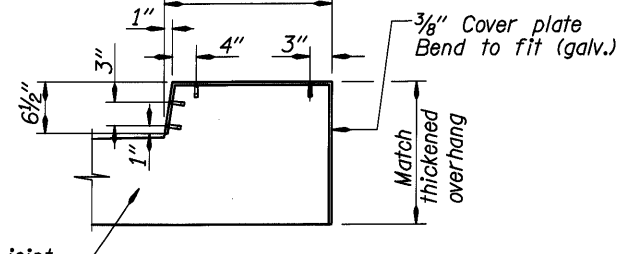

SECTION A-A

Scale: 1"=1'-0"

\*Joint setting

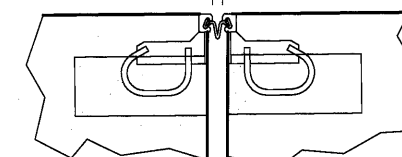

\*Joint setting is 1/4" at Bent 1 and 1 3/8" at Bent 6. Decrease joint setting 3/16" for every 10°F of structure temperature above 52°F. Increase joint setting 3/16" for every 10°F of structure temperature below 52°F.

JOINT SETTING DETAIL


No Scale

DO NOT SCALE THIS DRAWING.  
FOLLOW DIMENSIONS. INDICATED  
SCALES CORRECT ONLY FOR  
FULL SIZE SHEET (22"x34").

	DATE	REVISION	BY	DESIGNER			BRIDGE NO. 20136	DATE Sept. 2005	CALC. BOOK	MULTNOMAH CHANNEL & PNWR ETC., SAUVIE ISLAND RD.	SHEET 154 OF 173.
	08/05	Bent 6 end panel const. jt.	KWC	Ken Johnson							
	03/09	As-Constructed	TDF	Adrienne Dietrich							
				Rich King							



2005\_20136\_SUAVIE ISLAND REPLACEMENT\_002\_SPAN 1 LEFT SIDE

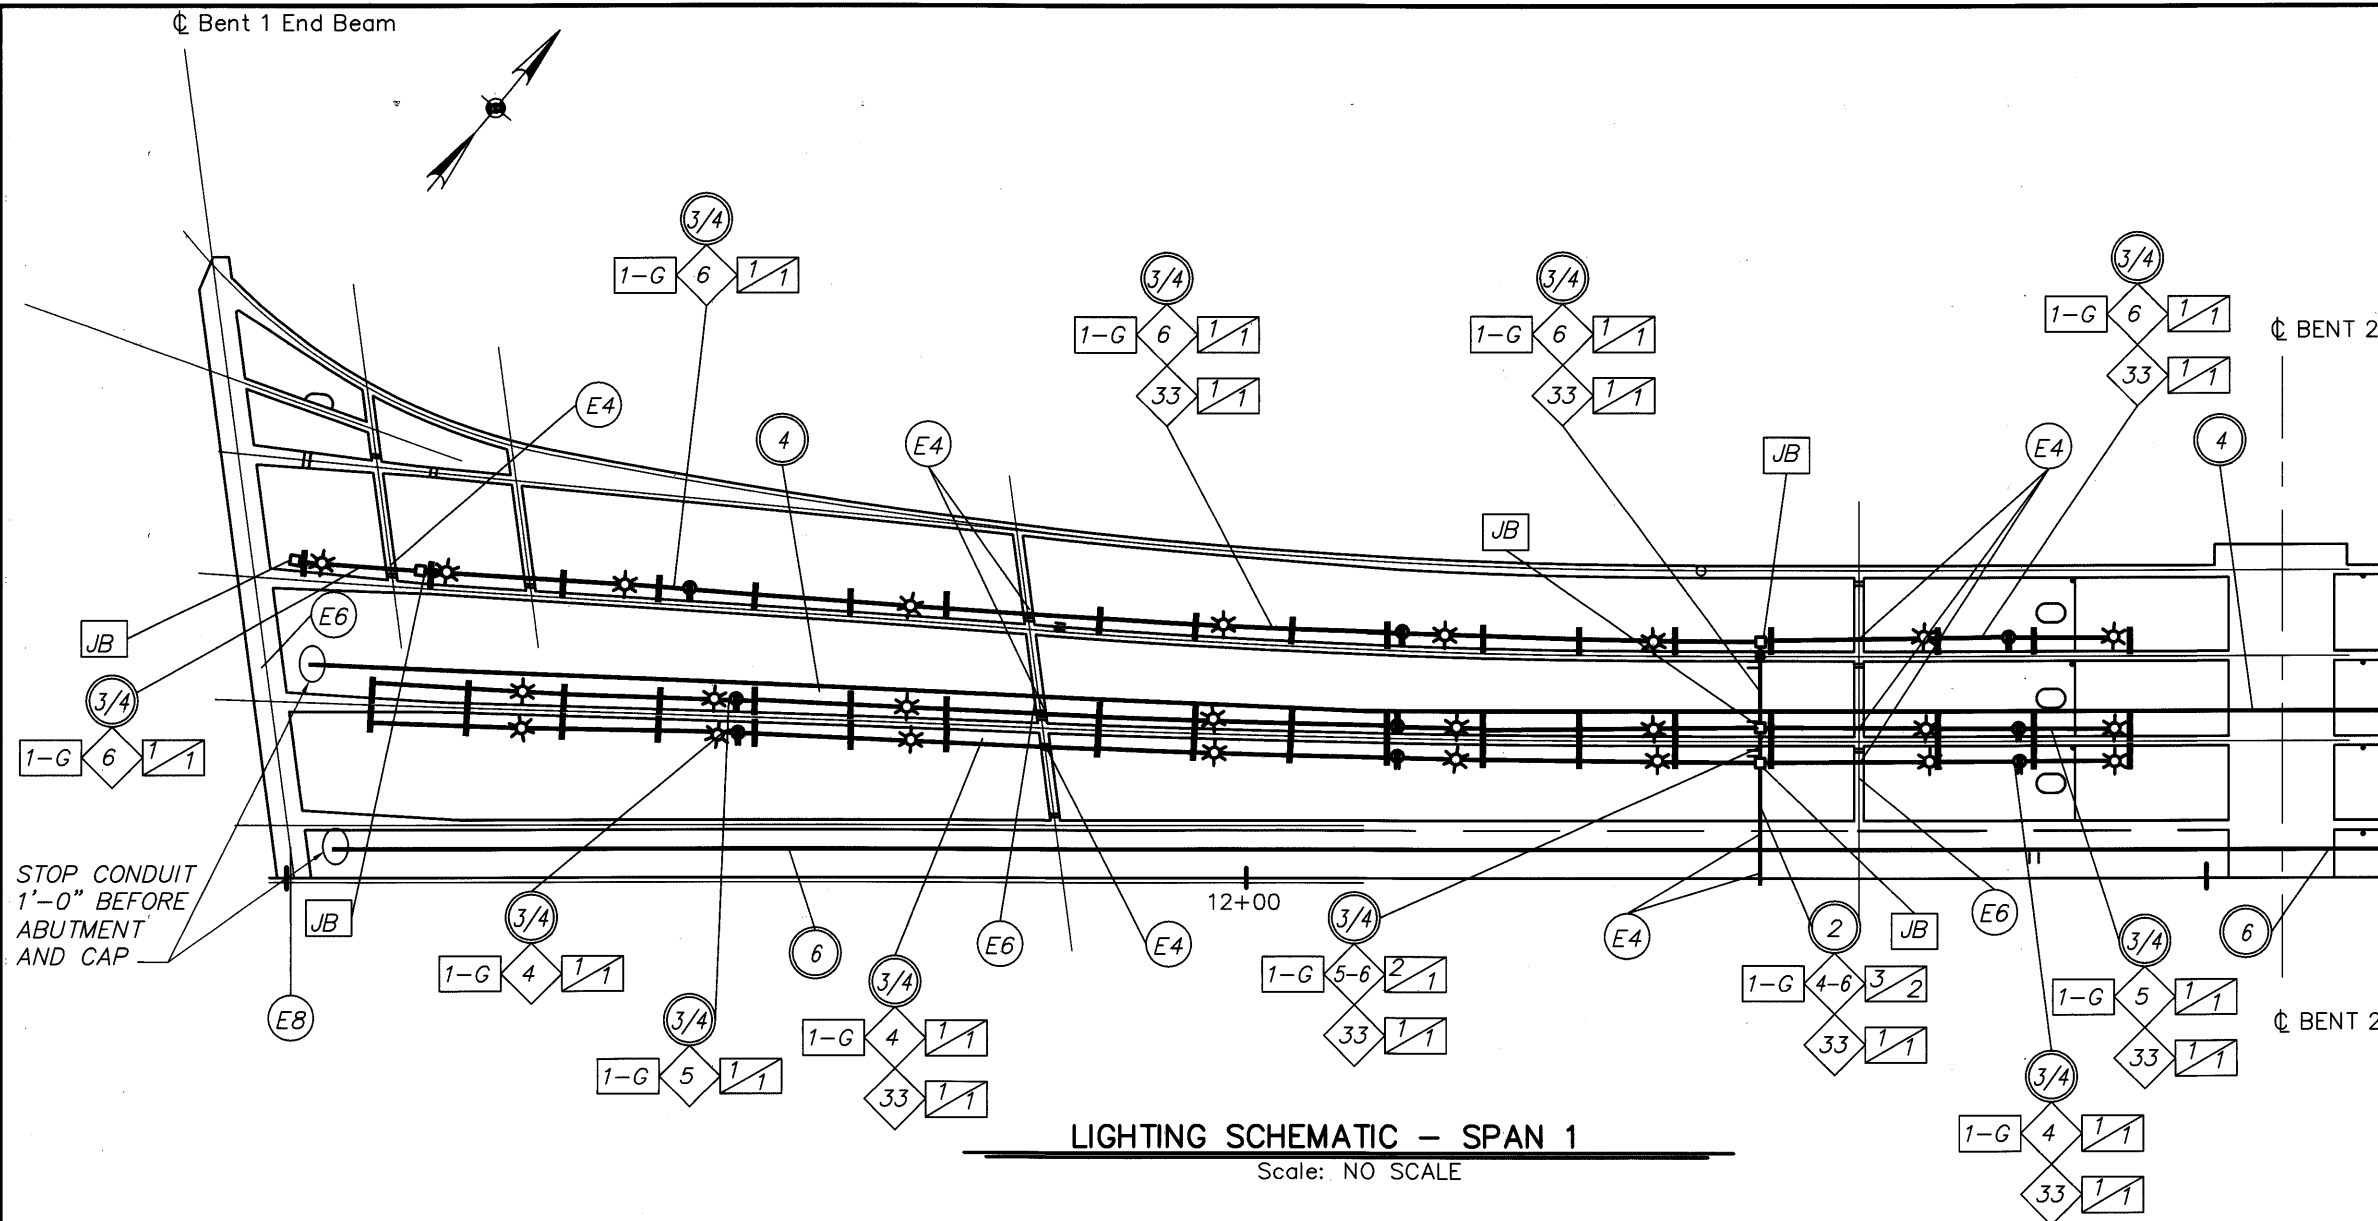

- NOTES:**
1. LIGHT AND OUTLET LOCATIONS AND SPACING ARE APPROXIMATE. CONTRACTOR TO COORDINATE WITH CONCRETE WORK TO DETERMINE BEST FIT AND THEN VERIFY LOCATIONS WITH ENGINEER BEFORE INSTALLATION.
  2. ALL INTERIOR ELECTRICAL CONDUIT SHALL BE EMT EXCEPT IN AREAS SET FORTH IN SECTION 00583.00 OF STANDARD SPECIFICATIONS FOR CONSTRUCTION.
  3. PROVIDE CONDUIT SUPPORTS SPACED A MAXIMUM OF 10'-0" O.C. AND WITHIN 3'-0" OF ALL JUNCTION BOXES AND TERMINAL POINTS. SEE DRAWING #70354 FOR DETAILS.


- LEGEND:**
- (EN) (N) INCH PVC SLEEVE. INSTALL A MINIMUM OF 1'-0" FROM POST TENSIONING DUCTS WHEN GOING THROUGH STEM WALLS.
  - ☼ INSTALL LIGHT
  - (S) INSTALL (S) INCH ELECTRICAL CONDUIT
  - $\frac{N}{X}$  INSTALL (N) NO. (8) THWN WIRES AND (X) NO. (8) NEUTRAL
  - N-G INSTALL (N) NO. 8 THWN GROUND WIRE
  - JB INSTALL JUNCTION BOX
  - SC INSTALL SERVICE CABINET
  - SP INSTALL SUB-PANEL
  - N (DIAMOND) CIRCUIT (N) NUMBER
  - $\frac{N}{G}$  INSTALL (N) NO. (4/0) WIRES AND 1 NO. (X) GROUND
  - ⊖ INSTALL OUTLET
  - ▬ LIGHT SUPPORT

DO NOT SCALE THIS DRAWING. FOLLOW DIMENSIONS. INDICATED SCALES CORRECT ONLY FOR FULL SIZE SHEET (22"x34").

Co. Br. No. 2641

DATE 03/09	REVISION As-Constructed	BY TDF	DRAFTED: BRENDA STROMBO			BRIDGE NO. 20136 DATE SEPT. 2005 CALC. BOOK	MULTNOMAH CHANNEL & PNWR ETC., SAUVIE ISLAND RD.	SHEET 156 OF 173
			CHECKED: JON HENRICHSEN					
			REVIEWED: IAN CANNON				LIGHTING LAYOUT-SPAN 1 LEFT SIDE	

DO NOT SCALE THIS DRAWING.  
FOLLOW DIMENSIONS. INDICATED  
SCALES CORRECT ONLY FOR  
FULL SIZE SHEET (22"x34").

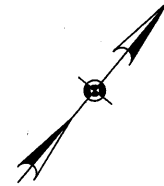


**NOTES:**

1. LIGHT AND OUTLET LOCATIONS AND SPACING ARE APPROXIMATE. CONTRACTOR TO COORDINATE WITH CONCRETE WORK TO DETERMINE BEST FIT AND THEN VERIFY LOCATIONS WITH ENGINEER BEFORE INSTALLATION.
2. ALL INTERIOR ELECTRICAL CONDUIT SHALL BE EMT EXCEPT IN AREAS SET FORTH IN SECTION 00583.00 OF STANDARD SPECIFICATIONS FOR CONSTRUCTION.
3. PROVIDE SUPPORTS SPACED A MAXIMUM OF 10'-0" O.C. AND WITHIN 3'-0" OF ALL JUNCTION BOXES AND TERMINAL POINTS. SEE DRAWING #70354 FOR DETAILS.

**LEGEND:**

- (EX) (X) INCH PVC SLEEVE. INSTALL A MINIMUM OF 1'-0" FROM POST TENSIONING DUCTS WHEN GOING THROUGH STEM WALLS
- ☀ INSTALL LIGHT
- (S) INSTALL (S) INCH ELECTRICAL CONDUIT
- (S) INSTALL (S) INCH LIQUIDTIGHT FLEXIBLE METAL CONDUIT
- N/X INSTALL (N) NO. (8) THWN WIRES AND (X) NO. (8) NEUTRAL
- N-G INSTALL (N) NO. 8 THWN GROUND WIRE

- JB INSTALL JUNCTION BOX
- WJB INSTALL NEMA TYPE R12 20X20X8" SINGLE DOOR JUNCTION BOX
- SC INSTALL SERVICE CABINET
- SP INSTALL SUB-PANEL
- N CIRCUIT (N) NUMBER
- NL NAVIGATION LIGHT CIRCUIT SEE DRAWING SA147L.
- N/G INSTALL (N) NO. (4/0) WIRES AND 1 NO. (X) GROUND
- INSTALL OUTLET
- LIGHT SUPPORT

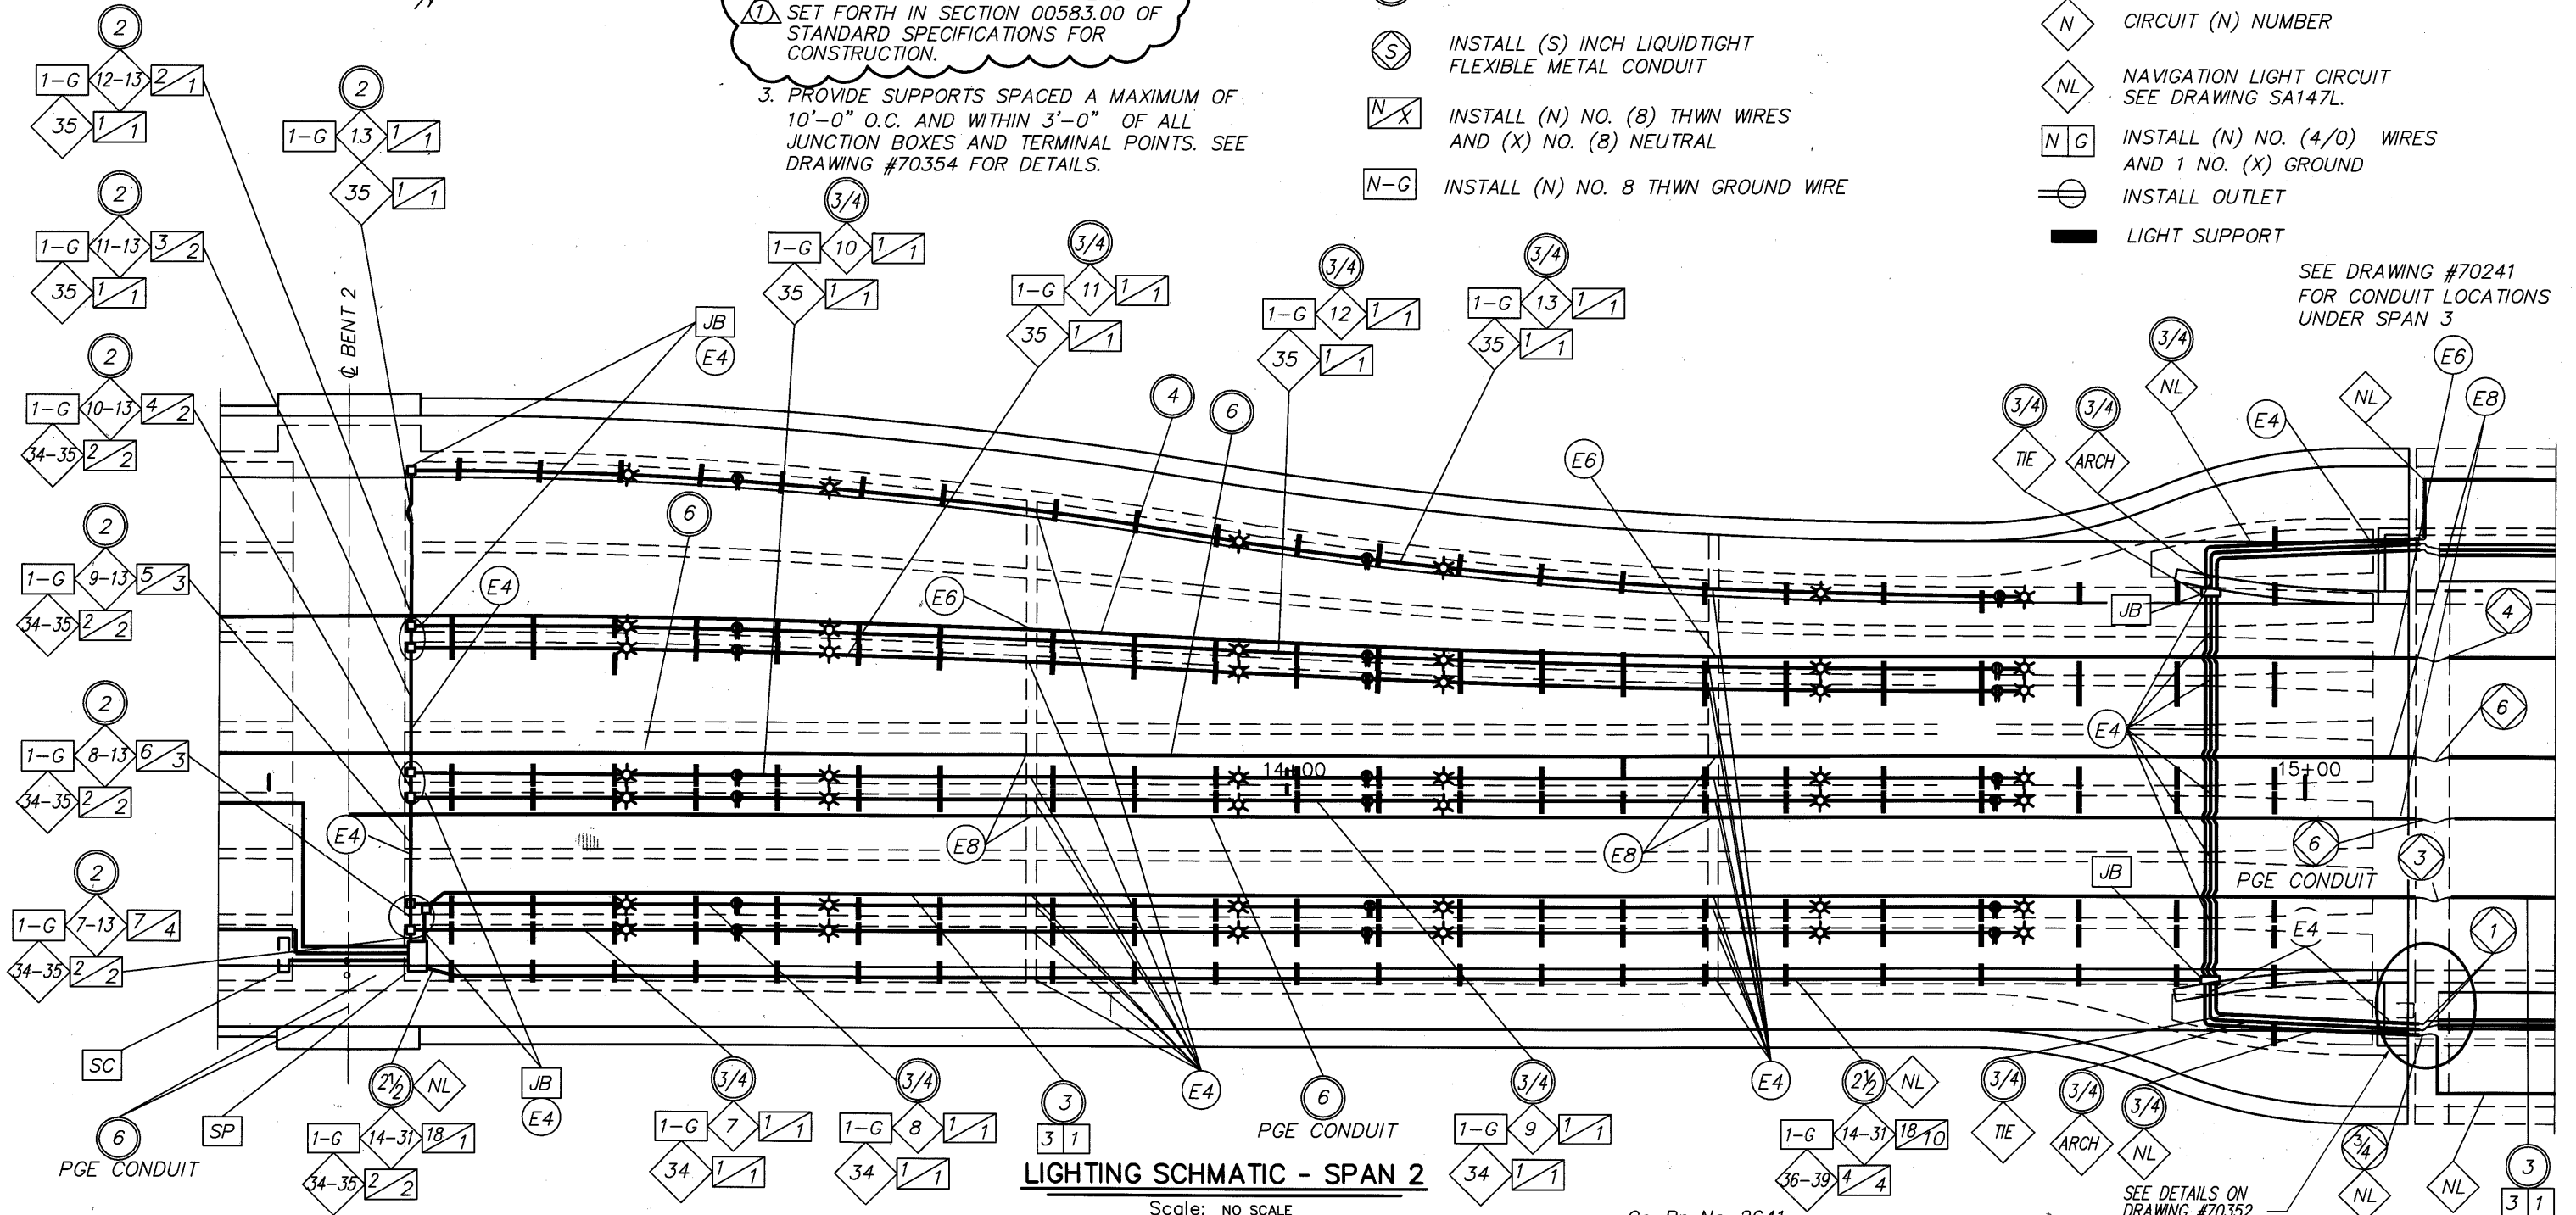

**LIGHTING SCHMATIC - SPAN 2**

Scale: NO SCALE

Co. Br. No. 2641














SEE DETAILS ON DRAWING #70352

2005\_20136\_SUAVIE ISLAND REPLACEMENT\_003\_SPAN 2 LIGHTING

1 DATE 9/14/05 03/09	REVISION NOTE 2 CORRECTED: FROM PVC TO EMT CONDUIT As-Constructed	BY JPH TDF	DRAFTED: BRENDA STROMBO	DESIGNER 	CONNECTING COMMERCE AND COMMUNITY <b>MULTNOMAH COUNTY</b> BRIDGES 	BRIDGE NO. 20136	MULTNOMAH CHANNEL & PNWR ETC., SAUVIE ISLAND RD.	SHEET 157 OF 173
	CHECKED: JON HENRICHSEN IAN CANNON	REVIEWED: IAN CANNON	OREGON DEPARTMENT OF TRANSPORTATION BRIDGE ENGINEERING SECTION			DATE SEPT. 2005		CALC. BOOK

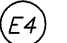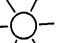
LIGHTING LAYOUT - SPAN 2

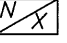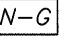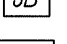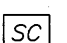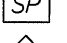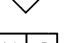**LEGEND:**

-  4" PVC SLEEVE FOR ELECTRICAL CONDUIT
-  INSTALL LIGHT
-  INSTALL (S) INCH ELECTRICAL CONDUIT
-  INSTALL (S) INCH LIQUIDTIGHT FLEXIBLE METAL CONDUIT
-  INSTALL (N) NO. (8) THWN WIRES AND (X) NO. (8) NEUTRAL
-  INSTALL (N) NO. 8 THWN GROUND WIRE
-  INSTALL JUNCTION BOX
-  INSTALL NEMA TYPE R12 20X20X8" SINGLE DOOR JUNCTION BOX
-  INSTALL SERVICE CABINET
-  INSTALL SUB-PANEL
-  CIRCUIT (N) NUMBER
-  INSTALL (N) NO. (4/0) WIRES AND 1 NO. (X) GROUND
-  INSTALL OUTLET

**NOTES:**

1. LIGHT AND OUTLET LOCATIONS AND SPACING ARE APPROXIMATE. CONTRACTOR TO VERIFY LOCATIONS WITH ENGINEER BEFORE INSTALLATION.
2. ALL INTERIOR ELECTRICAL CONDUIT SHALL BE EMT EXCEPT IN AREAS SET FORTH IN SECTION 00583.00 OF STANDARD SPECIFICATIONS FOR CONSTRUCTION.
3. PROVIDE SUPPORT ANGLES IN ARCH RIB, KNUCKLE SECTION AND TIE GIRDERS. ANGLES TO BE CENTERED BETWEEN INTERMEDIATE DIAPHRAGMS, WITH ADDITIONAL SUPPORTS SPACED A MAXIMUM OF 10'-0" O.C. AND WITHIN 3'-0" OF ALL JUNCTION BOXES AND TERMINAL POINTS. SEE DRAWING #70353 FOR DETAILS.

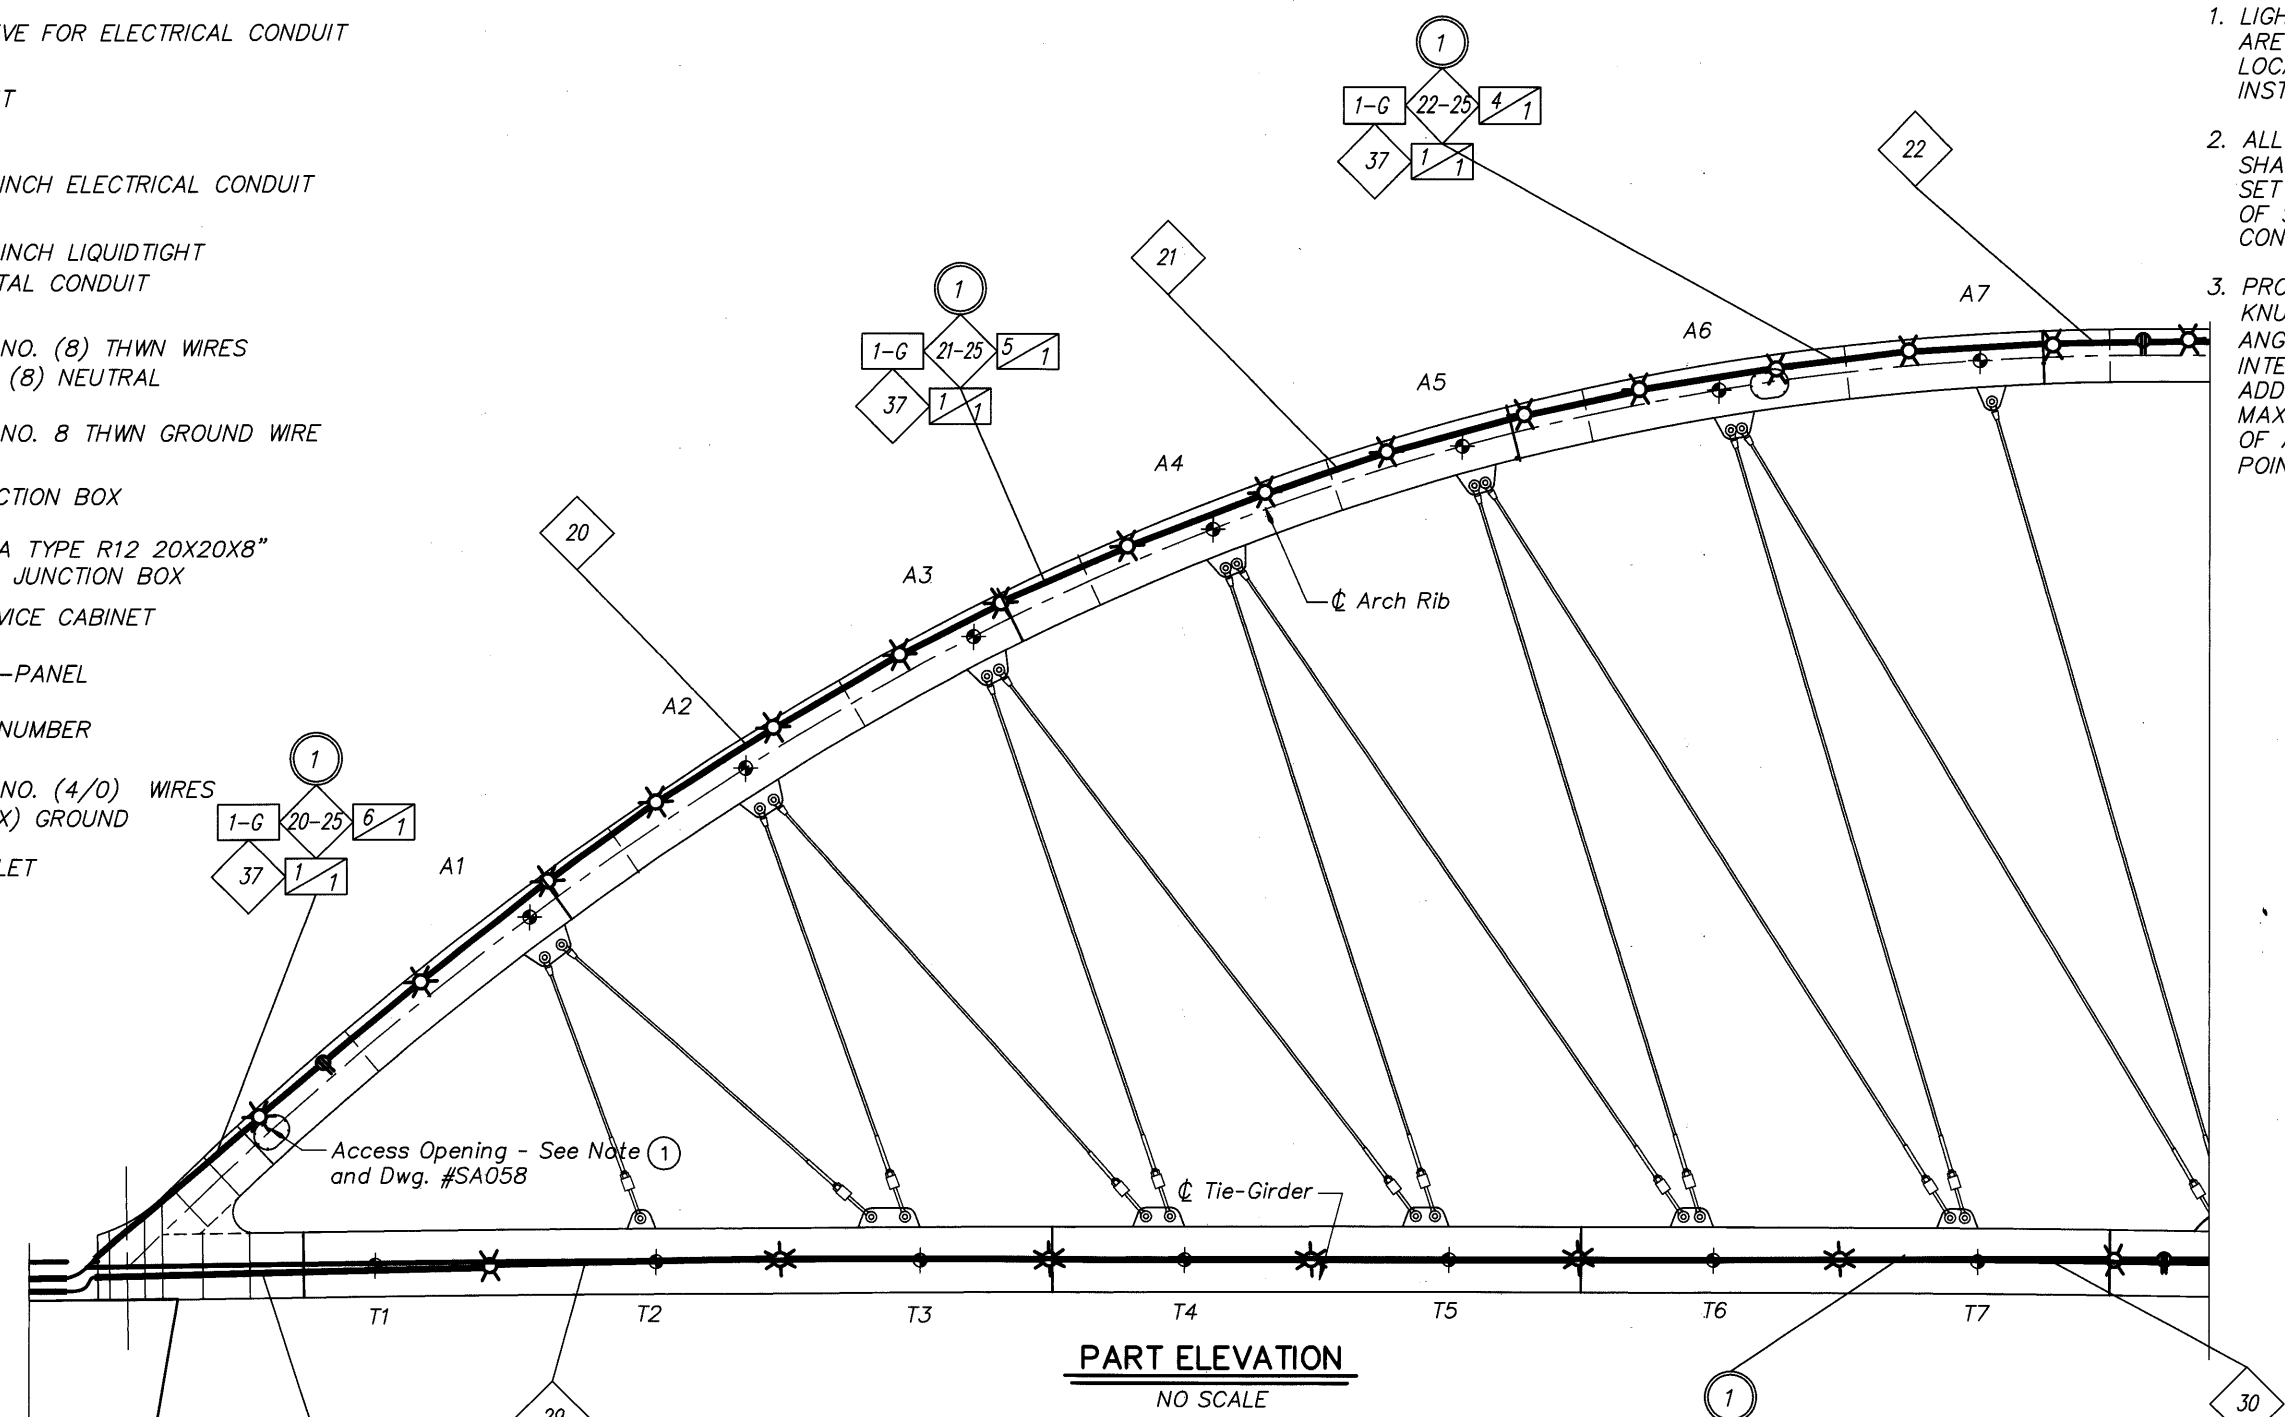

**PART ELEVATION**  
NO SCALE

SEE DRAWING #70214 FOR CONDUIT LOCATIONS UNDER SPAN 3

NAVIGATION CONDUIT INSTALLED IN SIDEWALK. SEE DRAWING #70355

Co. Br. No. 2641


2005\_20136\_SUAUIE ISLAND REPLACEMENT\_004\_ARCH MEMBER RIGHT SIDE LIGHTING 1

▲	DATE 03/09	REVISION As-Constructed	BY TDF	DESIGNER BRENDA STROMBO DRAFTED: 		 TRANSPORTATION DIVISION 	BRIDGE NO. 20136	MULTNOMAH CHANNEL & PNWR ETC., SAUVIE ISLAND RD.  LIGHTING LAYOUT-SPAN 3 RIGHT SIDE-1	SHEET 158 OF 173	
				 CHECKED: JON HENRICHSEN		OREGON DEPARTMENT OF TRANSPORTATION BRIDGE ENGINEERING SECTION	DATE SEPT 2005			
				 REVIEWED: IAN CANNON			CALC. BOOK		DRAWING NO. 70346	

2005\_20136\_SUAUIE ISLAND REPLACEMENT\_005\_ARCH MEMBER RIGHT SIDE LIGHTING 2

- NOTES:**
1. LIGHT AND OUTLET LOCATIONS AND SPACING ARE APPROXIMATE. CONTRACTOR TO VERIFY LOCATIONS WITH ENGINEER BEFORE INSTALLATION.
  2. ALL INTERIOR ELECTRICAL CONDUIT SHALL BE EMT EXCEPT IN AREAS SET FORTH IN SECTION 00583.00 OF STANDARD SPECIFICATIONS FOR CONSTRUCTION.
  3. PROVIDE SUPPORT ANGLES IN ARCH RIB, KNUCKLE SECTION AND TIE GIRDERS. ANGLES TO BE CENTERED BETWEEN INTERMEDIATE DIAPHRAGMS, WITH ADDITIONAL SUPPORTS SPACED A MAXIMUM OF 10'-0" O.C. AND WITHIN 3'-0" OF ALL JUNCTION BOXES AND TERMINAL POINTS. SEE DRAWING #70353 FOR DETAILS.

- LEGEND:**
- (E4) 4" PVC SLEEVE FOR ELECTRICAL CONDUIT
  - ☼ INSTALL LIGHT
  - (S) INSTALL (S) INCH ELECTRICAL CONDUIT
  - $\frac{N}{X}$  INSTALL (N) NO. (8) THWN WIRES AND (X) NO. (8) NEUTRAL
  - $\frac{N-G}{}$  INSTALL (N) NO. 8 THWN GROUND WIRE
  - JB INSTALL JUNCTION BOX
  - SC INSTALL SERVICE CABINET
  - SP INSTALL SUB-PANEL
  - $\diamond$  (N) CIRCUIT (N) NUMBER
  - $\frac{N}{G}$  INSTALL (N) NO. (4/0) WIRES AND 1 NO. (X) GROUND
  - ⊙ INSTALL OUTLET

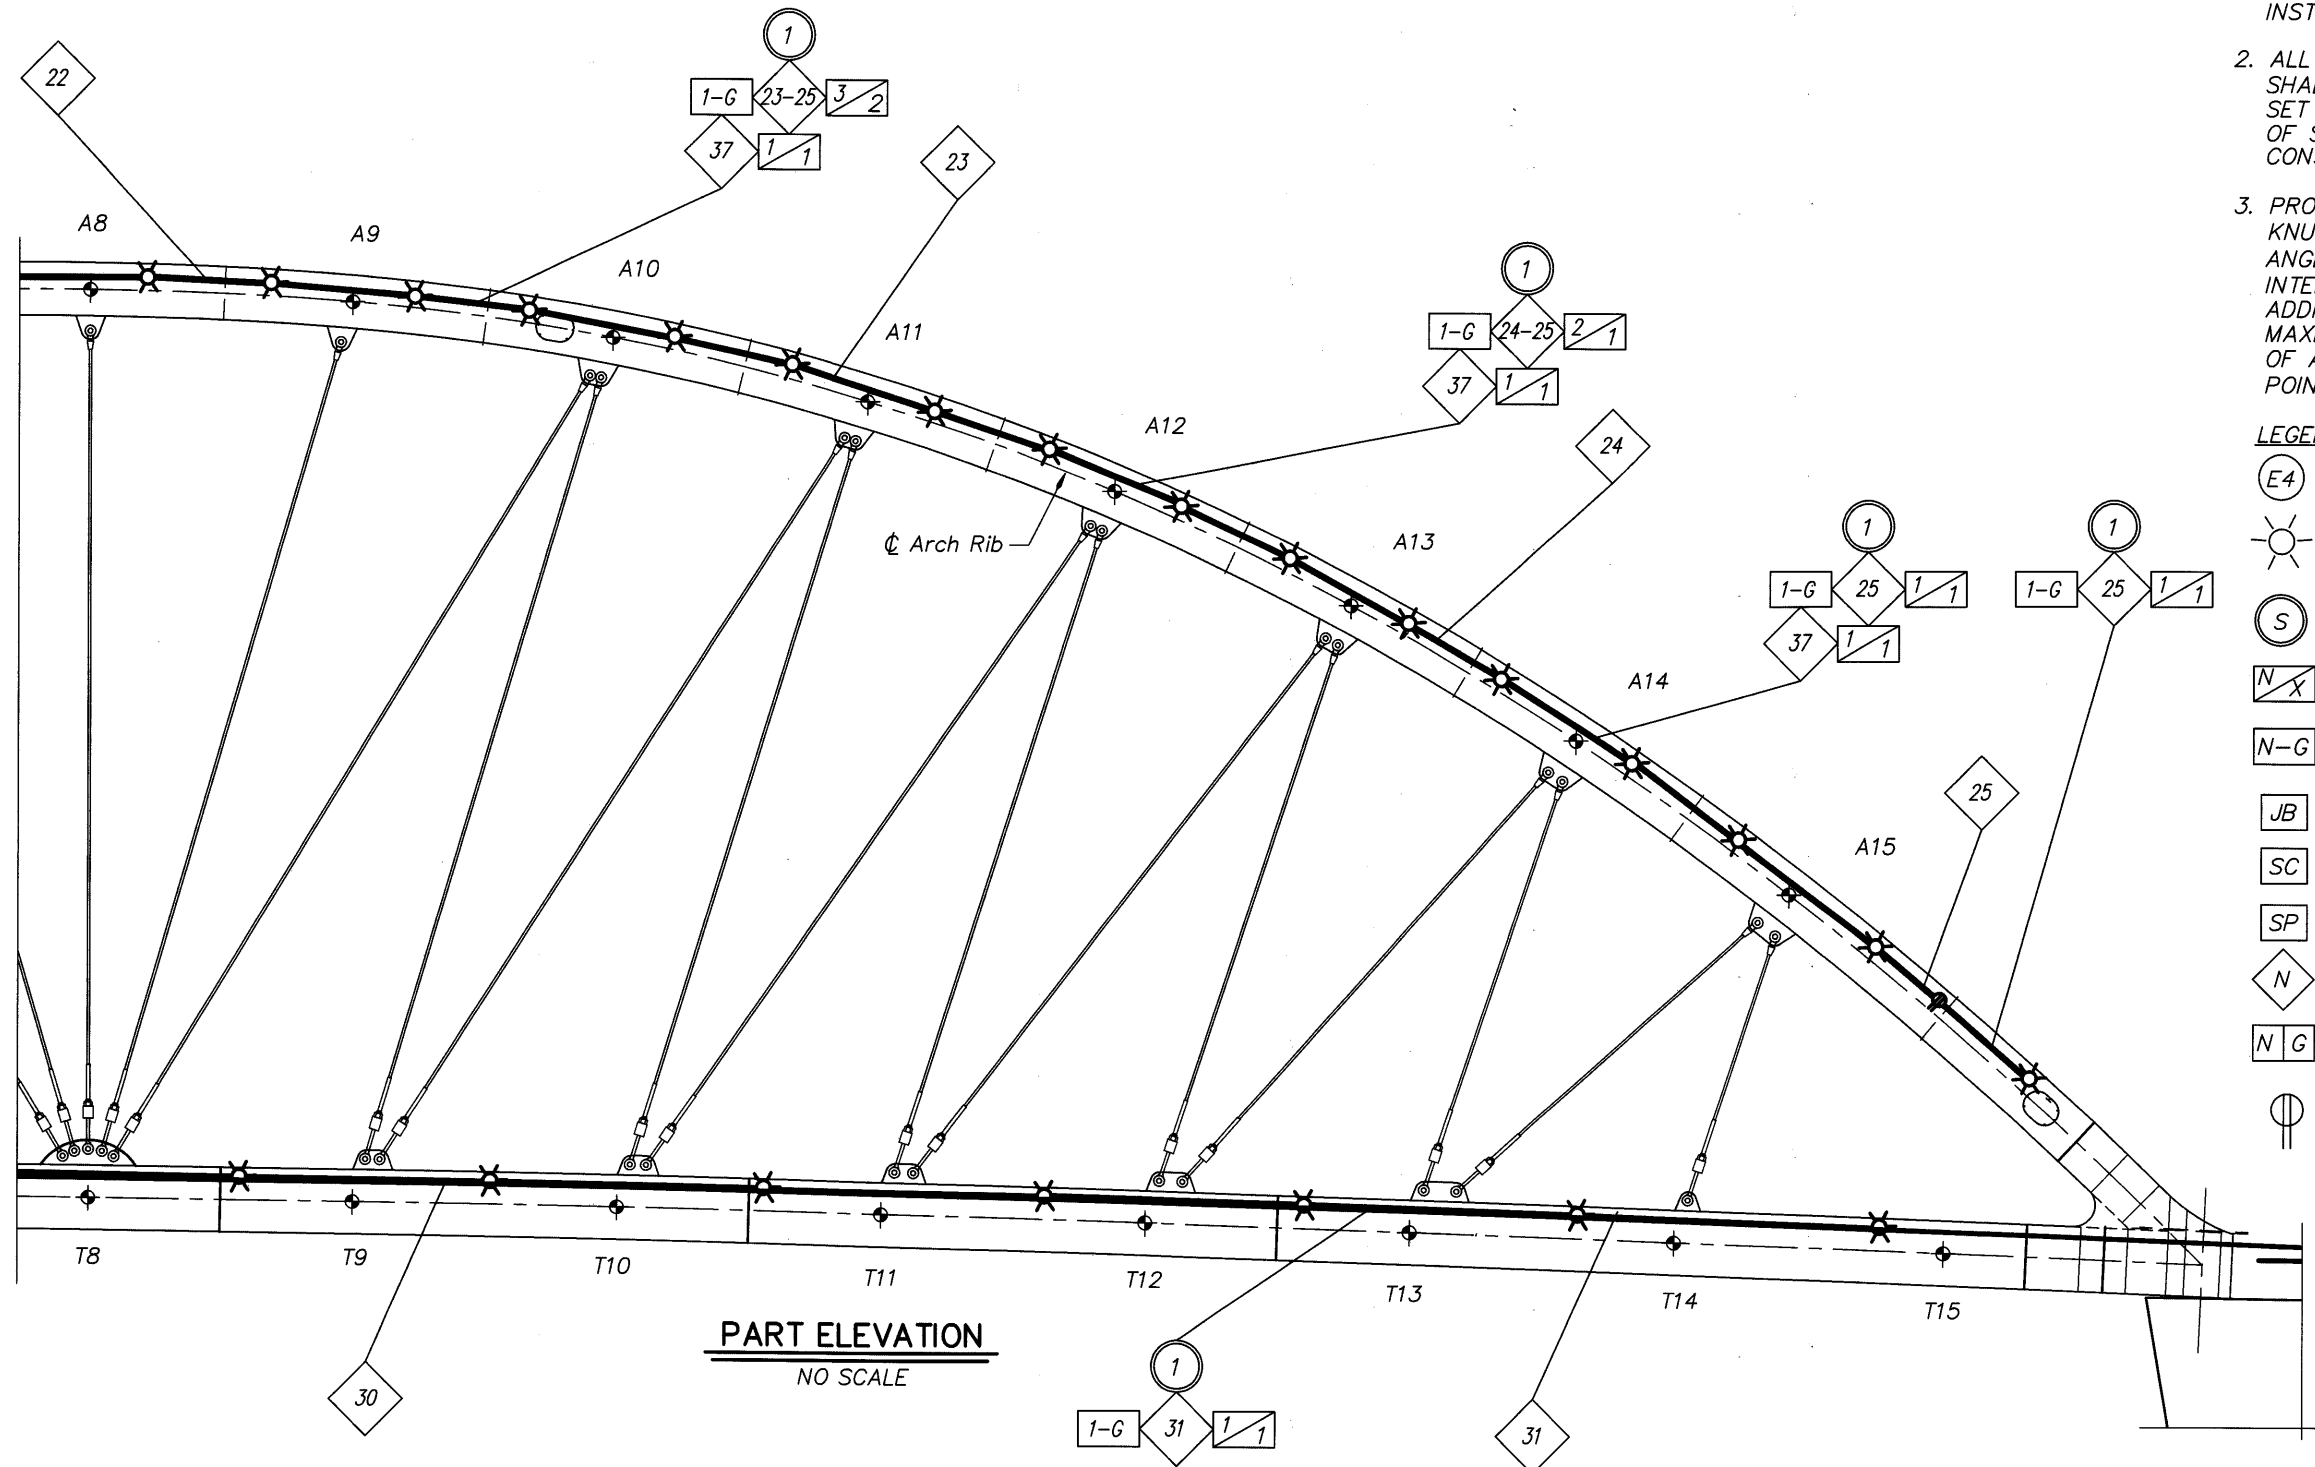


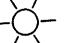







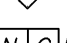



SEE DRAWING #70214 FOR CONDUIT LOCATIONS UNDER SPAN 3

NAVIGATION CONDUIT INSTALLED IN SIDEWALK. SEE DRAWING #70355.

Co. Br. No. 2641


DATE	03/09	REVISION	As-Constructed	BY	TDF	DESIGNER	BRENDA STROMBO	BRIDGE NO.	20136	SHEET	159
CHECKED:	JON HENRICHSEN	DESIGNER		TRANSPORTATION DIVISION	DATE	SEPT 2005	MULTNOMAH CHANNEL & PNWR ETC., SAUVIE ISLAND RD.	CALC. BOOK	DRAWING NO.	70347	
REVIEWED:	IAN CANNON	REGISTERED PROFESSIONAL ENGINEER		OREGON DEPARTMENT OF TRANSPORTATION BRIDGE ENGINEERING SECTION							LIGHTING LAYOUT-SPAN 3 RIGHT SIDE-2

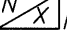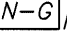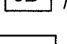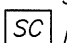**LEGEND:**

-  4" PVC SLEEVE FOR ELECTRICAL CONDUIT
-  INSTALL LIGHT
-  INSTALL (S) INCH ELECTRICAL CONDUIT
-  INSTALL (S) INCH LIQUIDTIGHT FLEXIBLE METAL CONDUIT
-  INSTALL (N) NO. (8) THWN WIRES AND (X) NO. (8) NEUTRAL
-  INSTALL (N) NO. 8 THWN GROUND WIRE
-  INSTALL JUNCTION BOX
-  INSTALL NEMA TYPE R12 20X20X8" SINGLE DOOR JUNCTION BOX
-  INSTALL SERVICE CABINET
-  INSTALL SUB-PANEL
-  CIRCUIT (N) NUMBER
-  INSTALL (N) NO. (4/0) WIRES AND 1 NO. (X) GROUND
-  INSTALL OUTLET

**NOTES:**

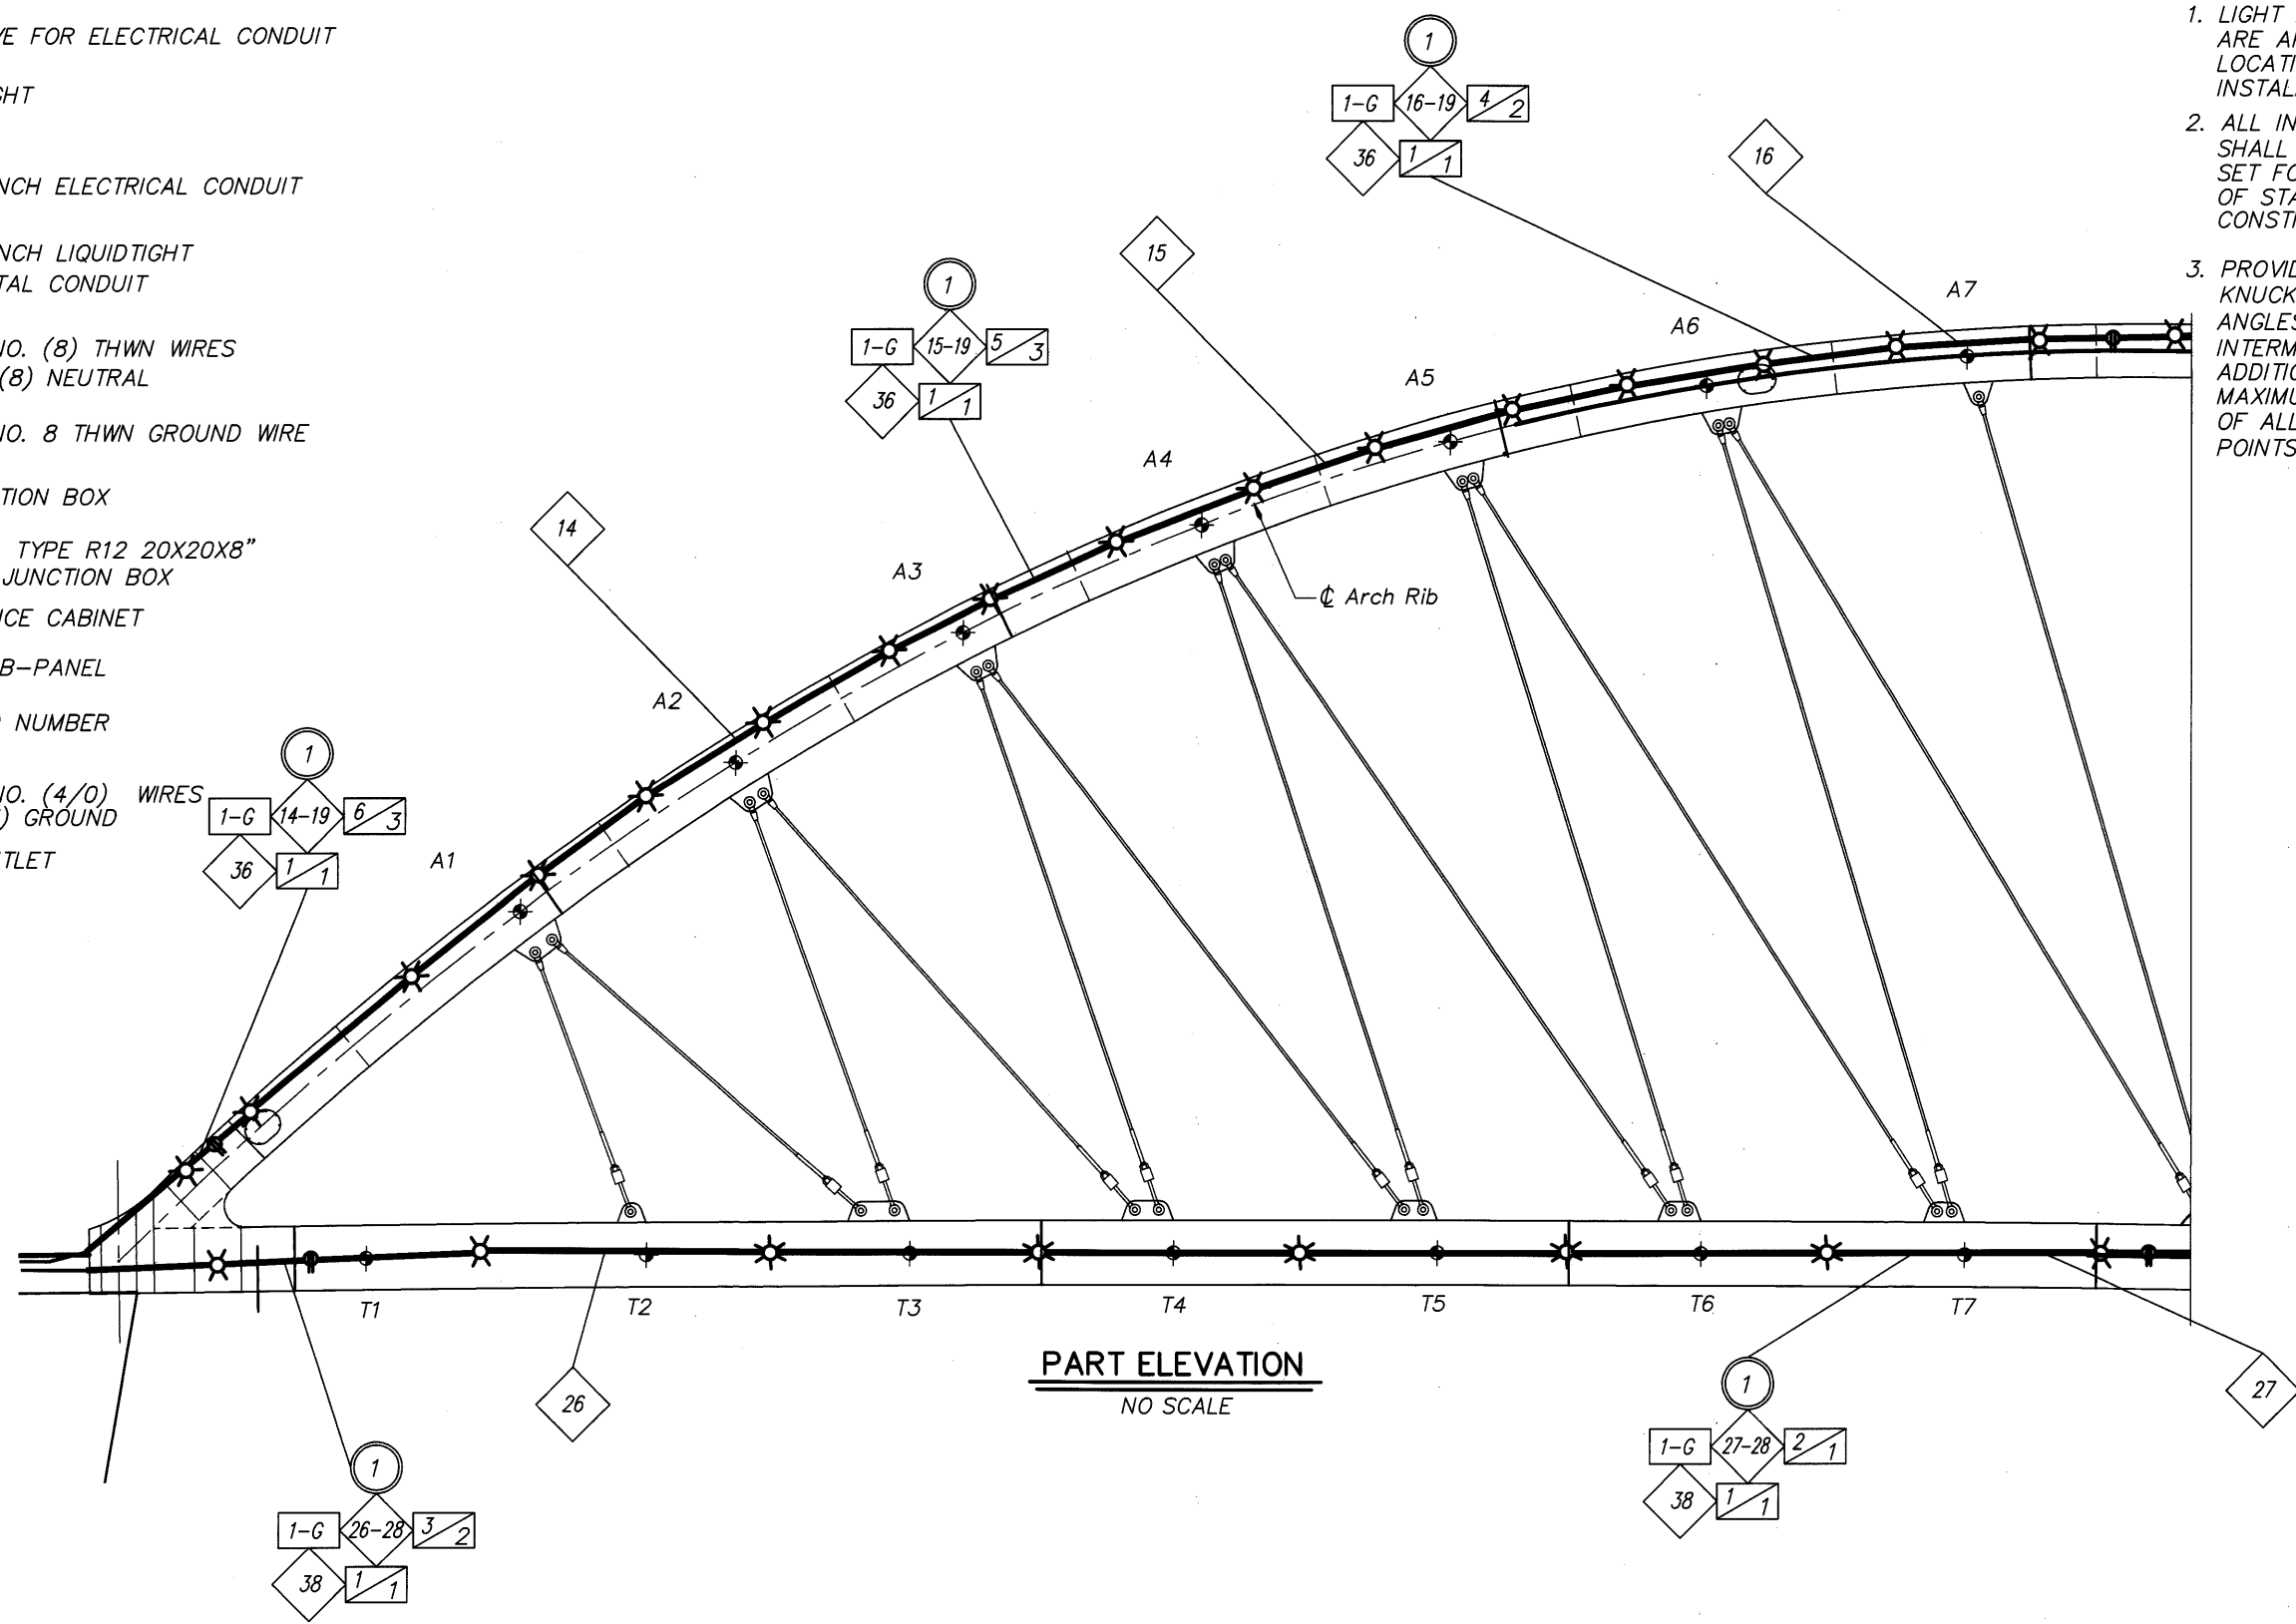


1. LIGHT AND OUTLET LOCATIONS AND SPACING ARE APPROXIMATE. CONTRACTOR TO VERIFY LOCATIONS WITH ENGINEER BEFORE INSTALLATION.
2. ALL INTERIOR ELECTRICAL CONDUIT SHALL BE EMT EXCEPT IN AREAS SET FORTH IN SECTION 00583.00 OF STANDARD SPECIFICATIONS FOR CONSTRUCTION.
3. PROVIDE SUPPORT ANGLES IN ARCH RIB, KNUCKLE SECTION AND TIE GIRDERS. ANGLES TO BE CENTERED BETWEEN INTERMEDIATE DIAPHRAGMS, WITH ADDITIONAL SUPPORTS SPACED A MAXIMUM OF 10'-0" O.C. AND WITHIN 3'-0" OF ALL JUNCTION BOXES AND TERMINAL POINTS. SEE DRAWING #70353 FOR DETAILS.



SEE DRAWING #70214 FOR CONDUIT LOCATIONS UNDER SPAN 3

NAVIGATION CONDUIT INSTALLED IN SIDEWALK. SEE DRAWING #70355

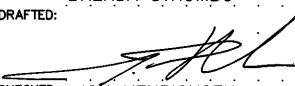
Co. Br. No. 2641

▲	DATE 03/09	REVISION As-Constructed	BY TDF	DESIGNER BRENDA STROMBO DRAFTED:  CHECKED: JON HENRICHSEN REVIEWED: IAN CANNON	 REGISTERED PROFESSIONAL ENGINEER JON P. HENRICHSEN EXPIRES 6/30/07	 MULTNOMAH COUNTY BRIDGES TRANSPORTATION DIVISION OREGON DEPARTMENT OF TRANSPORTATION BRIDGE ENGINEERING SECTION	BRIDGE NO. 20136 DATE SEPT 2005 CALC. BOOK	MULTNOMAH CHANNEL & PNWR ETC., SAUVIE ISLAND RD.  LIGHTING LAYOUT-SPAN 3 LEFT SIDE-1	SHEET 160 OF 173  DRAWING NO. 70348
---	---------------	----------------------------	-----------	---	---	---	--	--	---

2005\_20136\_SUAUIE ISLAND REPLACEMENT\_006\_ARCH MEMBER LEFT SIDE LIGHTING 1



2005\_20136\_SUAIVE ISLAND REPLACEMENT\_007\_ARCH MEMBER LEFT SIDE LIGHTING 2

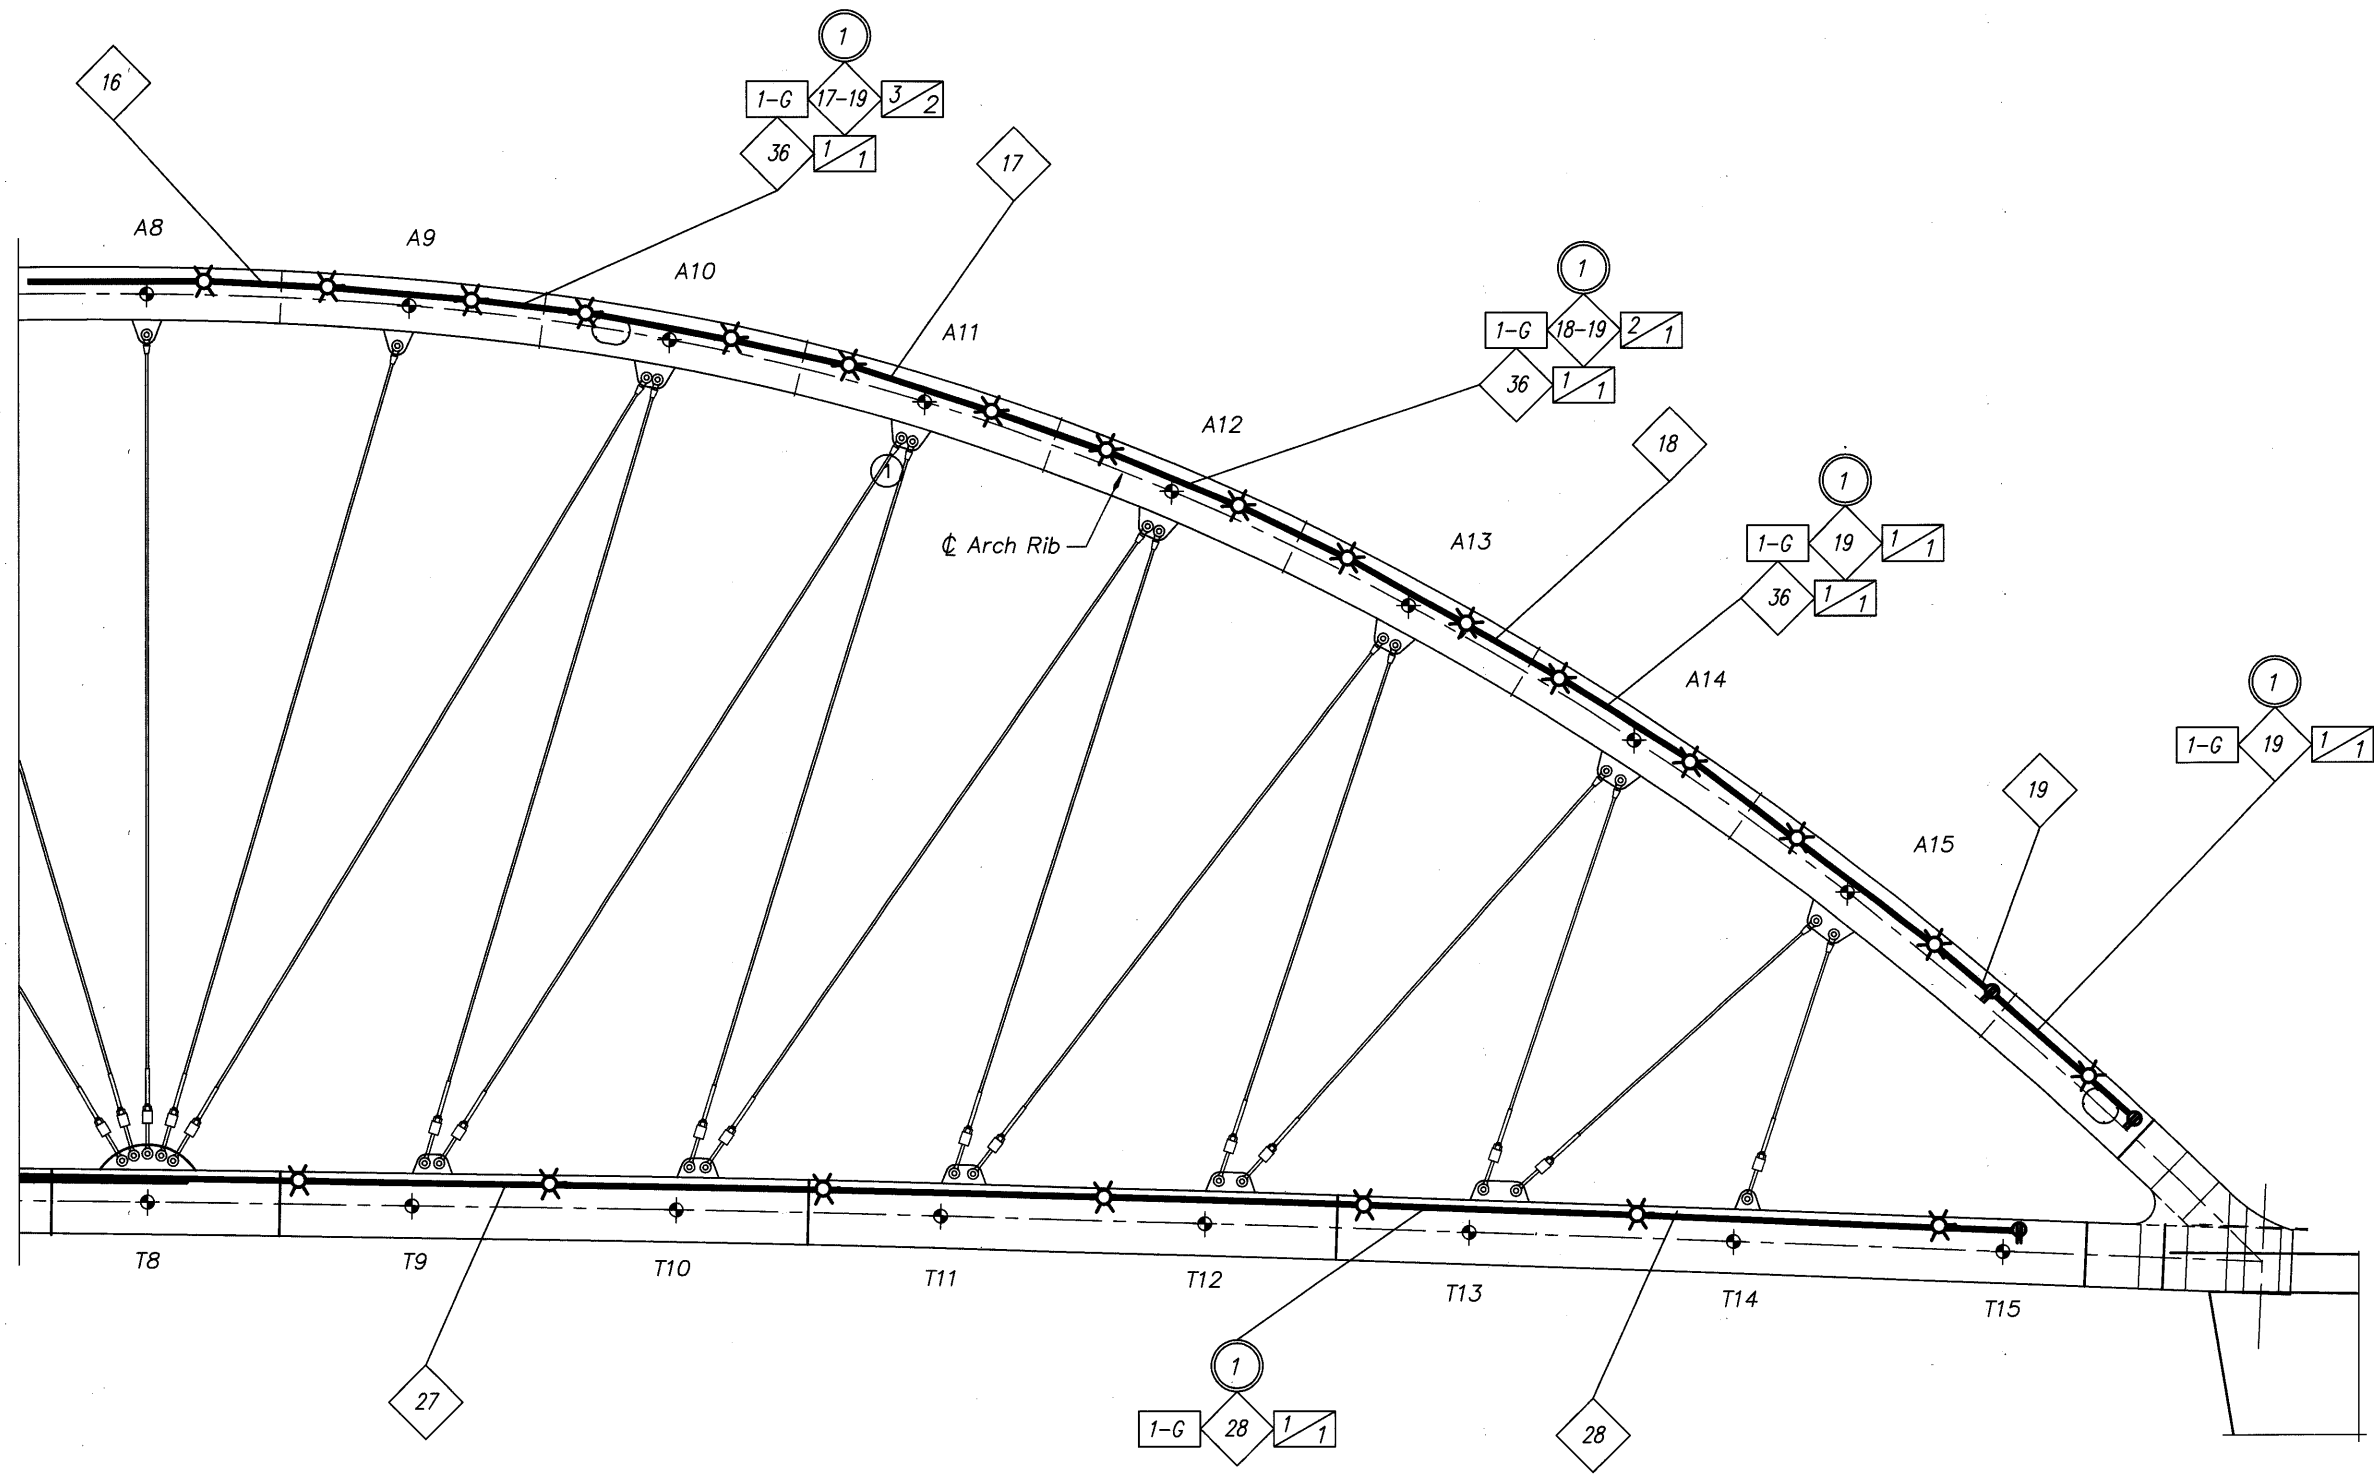

- NOTES:**
1. LIGHT AND OUTLET LOCATIONS AND SPACING ARE APPROXIMATE. CONTRACTOR TO VERIFY LOCATIONS WITH ENGINEER BEFORE INSTALLATION.
  2. ALL INTERIOR ELECTRICAL CONDUIT SHALL BE EMT EXCEPT IN AREAS SET FORTH IN SECTION 00583.00 OF STANDARD SPECIFICATIONS FOR CONSTRUCTION.
  3. PROVIDE SUPPORT ANGLES IN ARCH RIB, KNUCKLE SECTION AND TIE GIRDERS. ANGLES TO BE CENTERED BETWEEN INTERMEDIATE DIAPHRAGMS, WITH ADDITIONAL SUPPORTS SPACED A MAXIMUM OF 10'-0" O.C. AND WITHIN 3'-0" OF ALL JUNCTION BOXES AND TERMINAL POINTS. SEE DRAWING #70353 FOR DETAILS.

- LEGEND:**
- (E4) 4" PVC SLEEVE FOR ELECTRICAL CONDUIT
  - ☼ INSTALL LIGHT
  - (S) INSTALL (S) INCH ELECTRICAL CONDUIT
  - (S) INSTALL (S) INCH LIQUIDTIGHT FLEXIBLE METAL CONDUIT
  - N X INSTALL (N) NO. (8) THWN WIRES AND (X) NO. (8) NEUTRAL
  - N-G INSTALL (N) NO. 8 THWN GROUND WIRE
  - JB INSTALL JUNCTION BOX
  - WJB INSTALL NEMA TYPE R12 20X20X8" SINGLE DOOR JUNCTION BOX
  - SC INSTALL SERVICE CABINET
  - SP INSTALL SUB-PANEL
  - N CIRCUIT (N) NUMBER
  - N G INSTALL (N) NO. (4/0) WIRES AND 1 NO. (X) GROUND
  - ⊖ INSTALL OUTLET

SEE DRAWING #70214 FOR CONDUIT LOCATIONS UNDER SPAN 3


NAVIGATION CONDUIT INSTALLED IN SIDEWALK. SEE DRAWING #70355.

Co. Br. No. 2641

DATE	03/09	REVISION	As-Constructed	BY	TDF	DESIGNER	BRENDA STROMBO	BRIDGE NO.	20136	SHEET	161
								DATE	SEPT 2005	DRAWING NO.	70349
								CALC. BOOK			



2005\_20136\_SUAUIE ISLAND REPLACEMENT\_008\_SPAN 4 LIGHTING

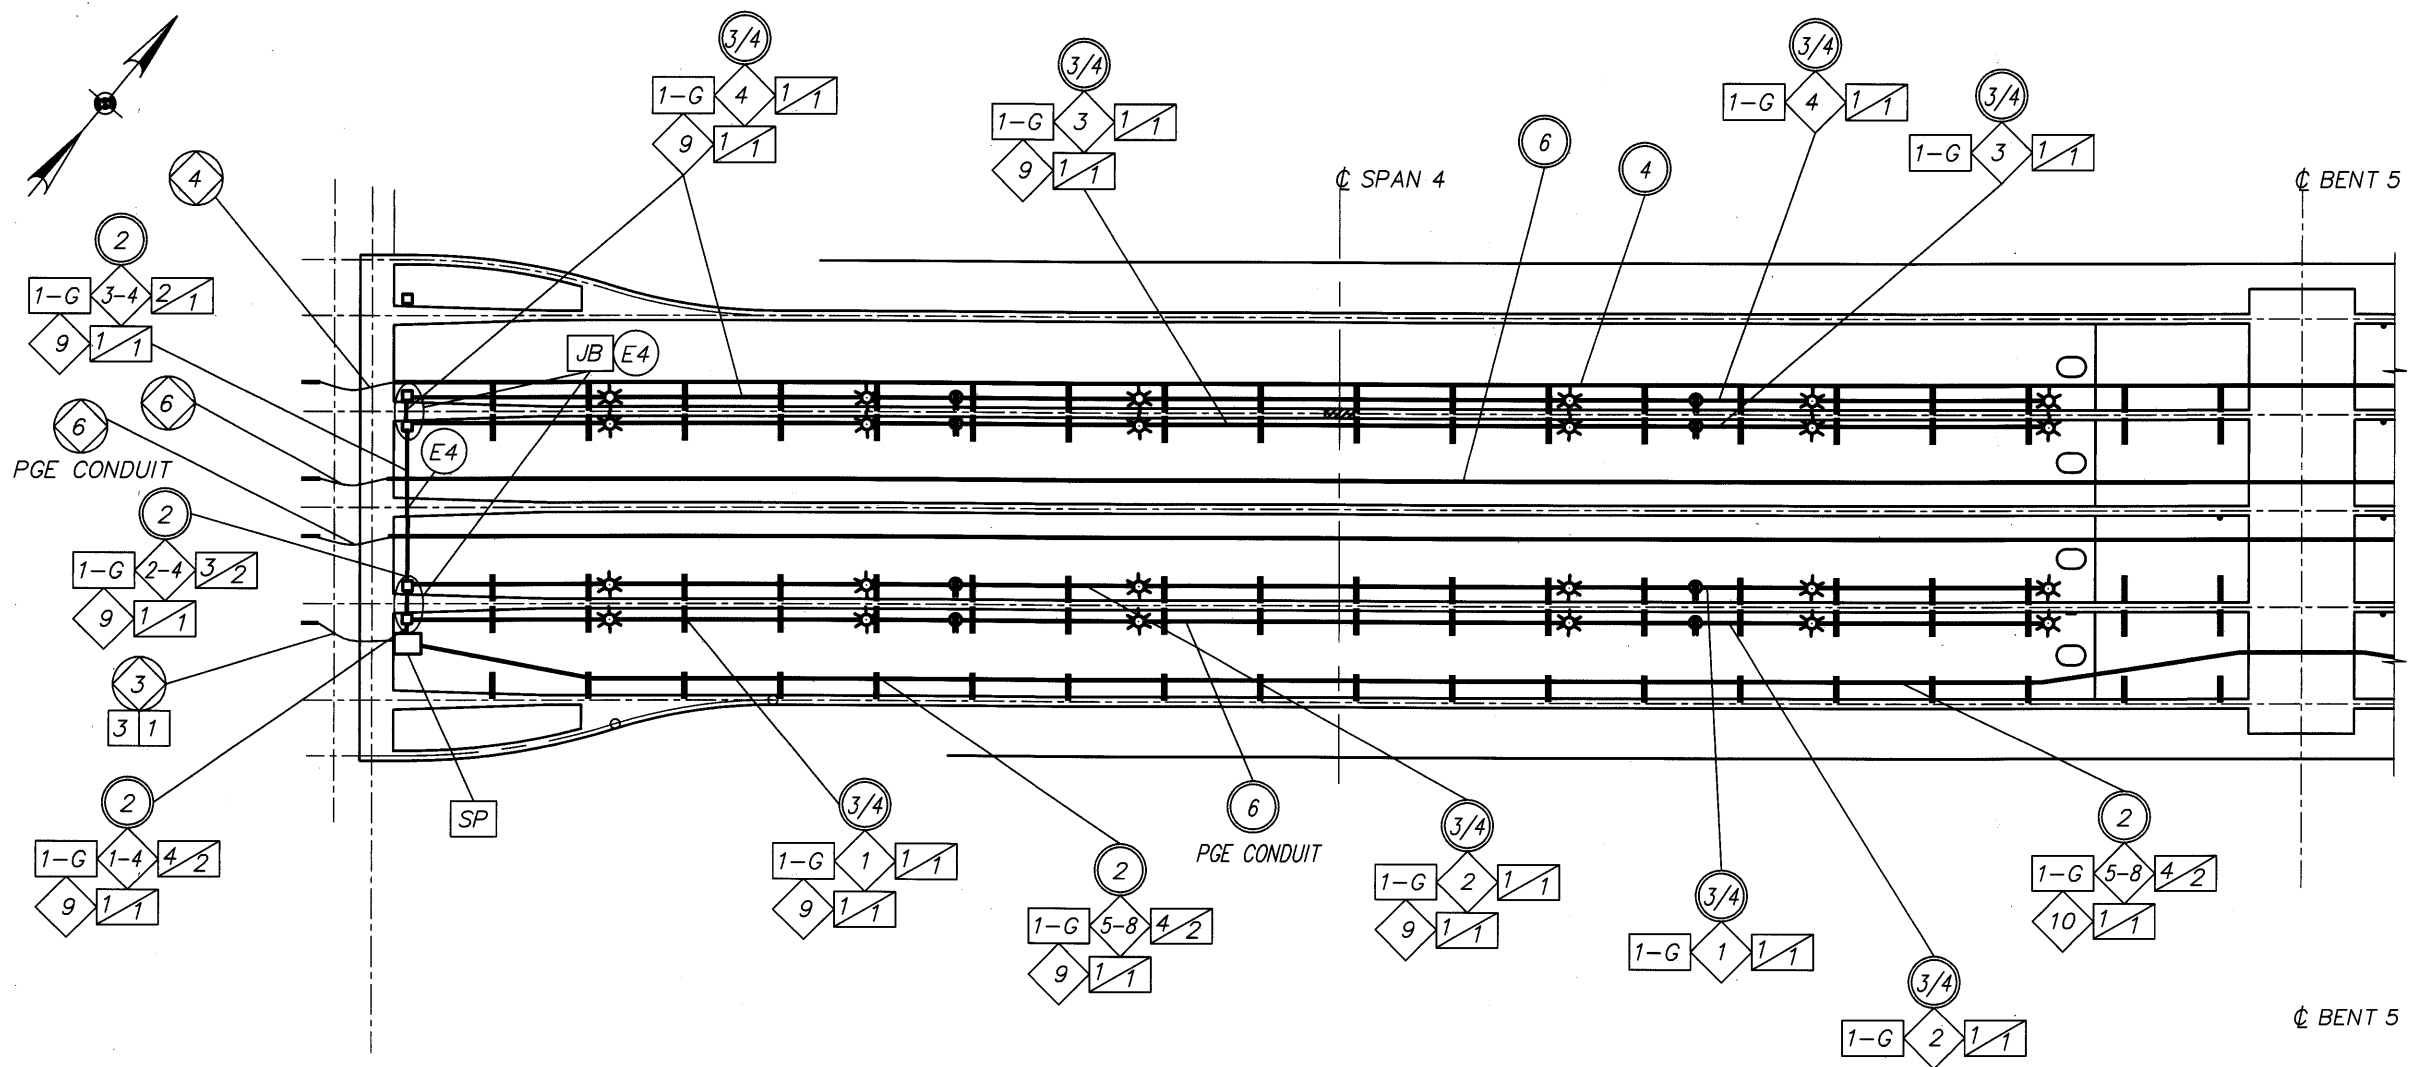

- NOTES:**
1. LIGHT AND OUTLET LOCATIONS AND SPACING ARE APPROXIMATE. CONTRACTOR TO COORDINATE WITH CONCRETE WORK TO DETERMINE THE BEST FIT AND THEN VERIFY LOCATIONS WITH ENGINEER BEFORE INSTALLATION.
  2. ALL INTERIOR ELECTRICAL CONDUIT SHALL BE EMT EXCEPT IN AREAS SET FORTH IN SECTION 00583.00 OF STANDARD SPECIFICATIONS FOR CONSTRUCTION.
  3. PROVIDE SUPPORTS SPACED A MAXIMUM OF 10'-0" O.C. AND WITHIN 3'-0" OF ALL JUNCTION BOXES AND TERMINAL POINTS. SEE DRAWING #70354 FOR DETAILS.

- LEGEND:**
- (EN) (N) INCH PVC SLEEVE. INSTALL A MINIMUM OF 1'-0" FROM POST TENSIONING DUCTS WHEN GOING THROUGH STEM WALLS.
  - ☼ INSTALL LIGHT
  - (S) INSTALL (S) INCH ELECTRICAL CONDUIT
  - (S) INSTALL (S) INCH LIQUIDTIGHT FLEXIBLE METAL CONDUIT
  - N/X INSTALL (N) NO. (8) THWN WIRES AND (X) NO. (8) NEUTRAL
  - N-G INSTALL (N) NO. 8 THWN GROUND WIRE
  - JB INSTALL JUNCTION BOX
  - SC INSTALL SERVICE CABINET
  - SP INSTALL SUB-PANEL
  - ◇ (N) CIRCUI (N) NUMBER
  - N/G INSTALL (N) NO. (4/0) WIRES AND 1 NO. (X) GROUND
  - INSTALL OUTLET
  - LIGHT SUPPORT


SEE DRAWING #70241 FOR CONDUIT LOCATIONS UNDER SPAN 3

**LIGHTING SCHEMATIC - SPAN 4**  
Scale : NO SCALE

Co. Br. No. 2641

DATE 03/09	REVISION As-Constructed	BY TDF	DRAFTED: BRENDA STROMBO			TRANSPORTATION DIVISION OREGON DEPARTMENT OF TRANSPORTATION BRIDGE ENGINEERING SECTION	BRIDGE NO. 20136	MULTNOMAH CHANNEL & PNWR ETC., SAUVIE ISLAND RD.	SHEET 162 OF 173
			CHECKED: JON HENRICHSEN				REVIEWED: IAN CANNON		

LIGHTING LAYOUT - SPAN 4

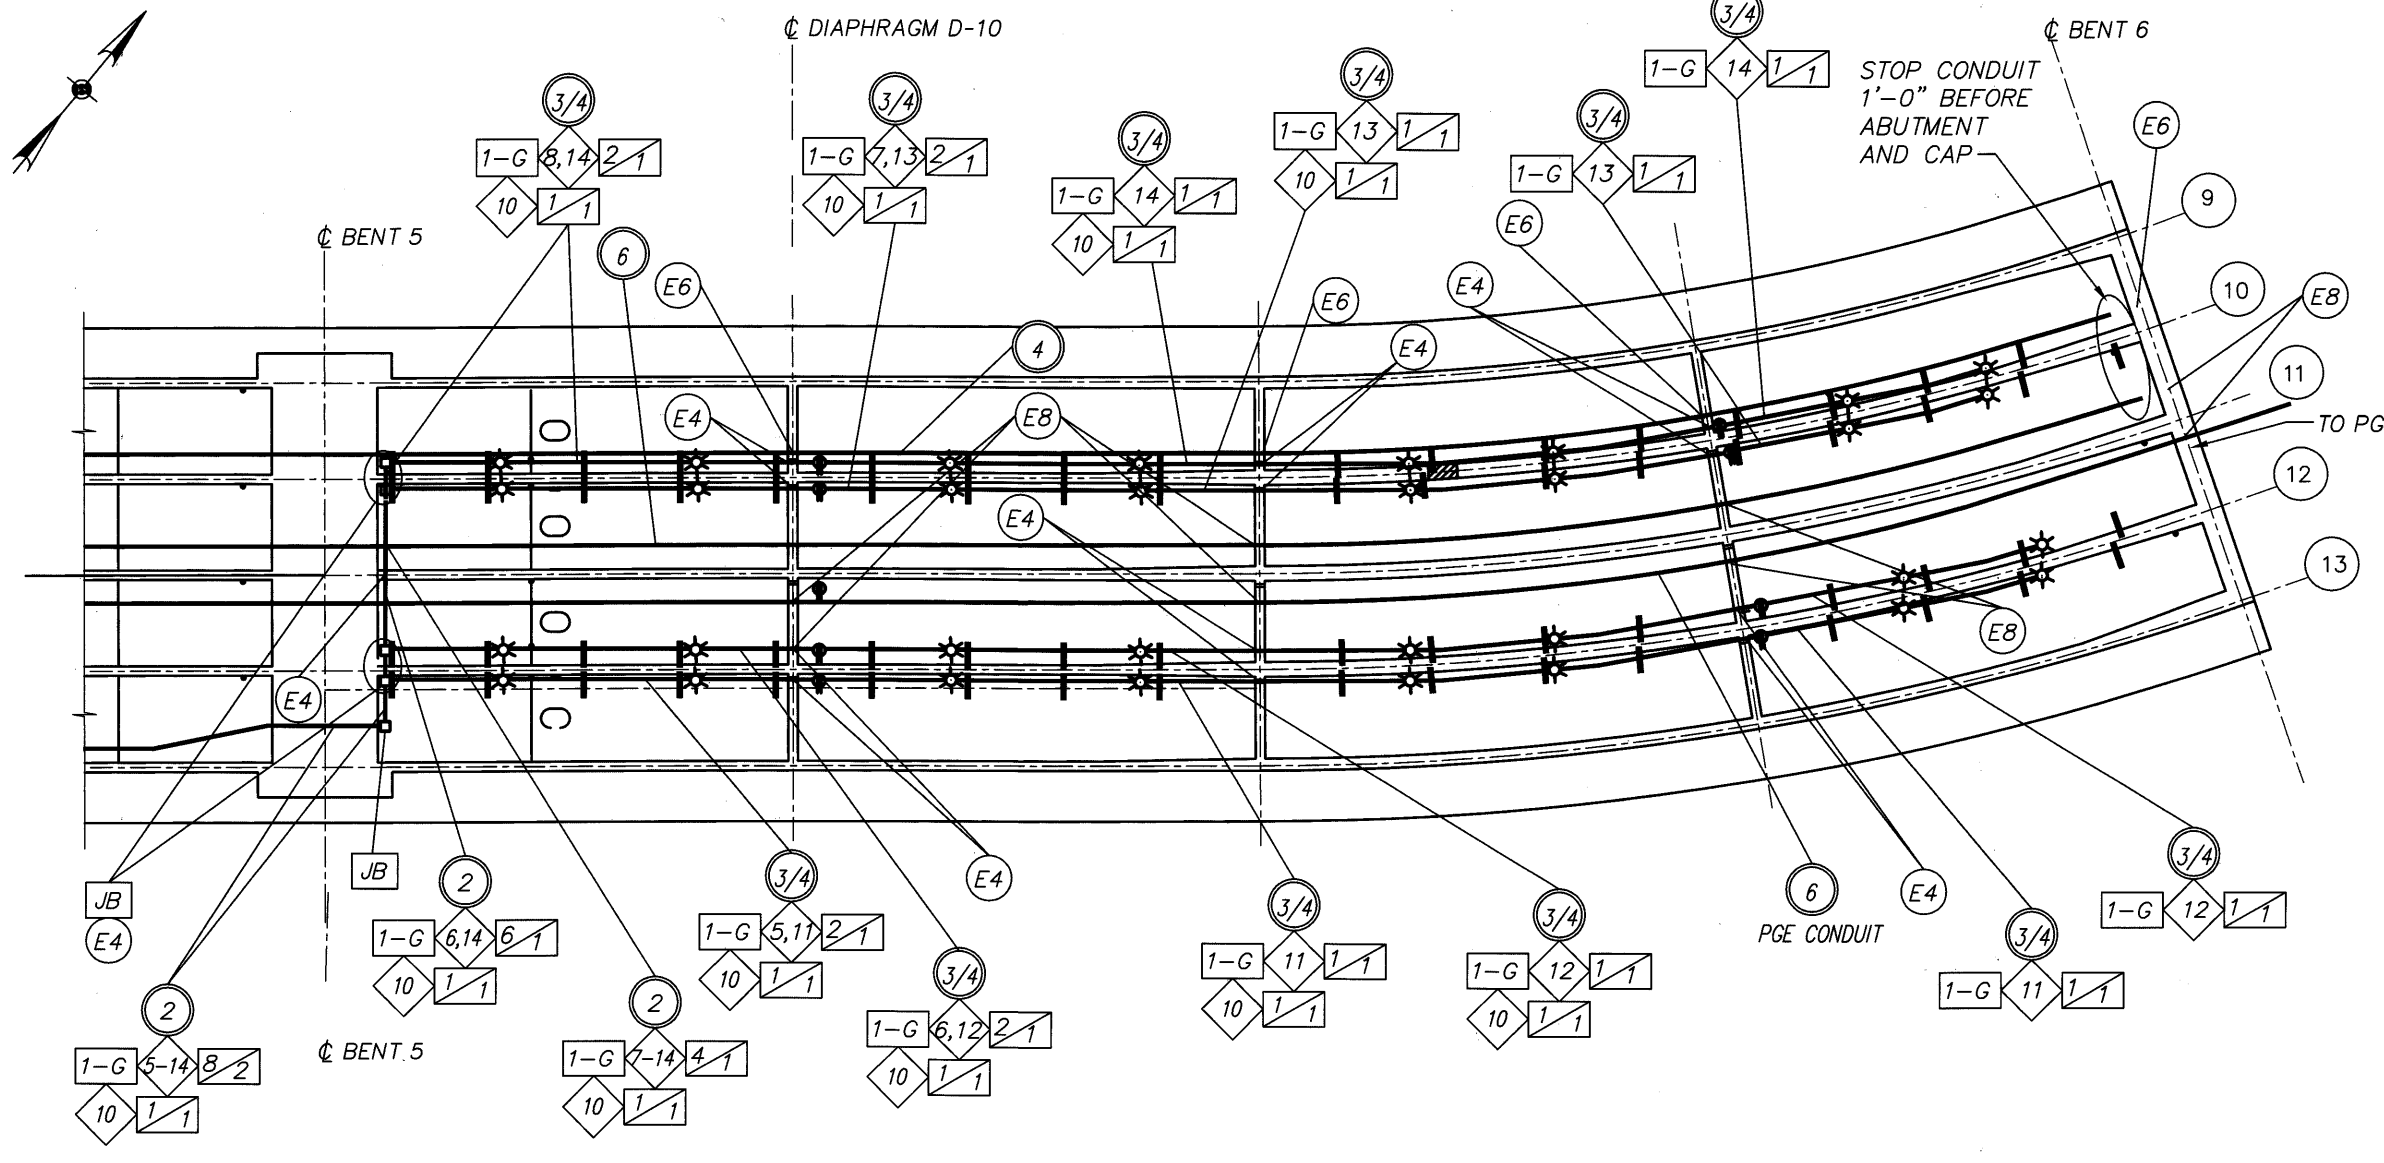

- NOTES:**
1. LIGHT AND OUTLET LOCATIONS AND SPACING ARE APPROXIMATE. CONTRACTOR TO COORDINATE WITH CONCRETE WORK TO DETERMINE THE BEST FIT FOR ALL ELEMENTS AND THEN VERIFY LOCATIONS WITH ENGINEER BEFORE INSTALLATION.
  2. ALL INTERIOR ELECTRICAL CONDUIT SHALL BE EMT EXCEPT IN AREAS SET FORTH IN SECTION 00583.00 OF STANDARD SPECIFICATIONS FOR CONSTRUCTION.
  3. PROVIDE SUPPORTS SPACED A MAXIMUM OF 10'-0" O.C. AND WITHIN 3'-0" OF ALL JUNCTION BOXES AND TERMINAL POINTS. SEE DRAWING #70354 FOR DETAILS.

- LEGEND:**
- (EN) (N) INCH PVC SLEEVE. INSTALL A MINIMUM OF 1'-0" FROM POST TENSIONING DUCTS WHEN GOING THROUGH STEM WALLS
  - ☼ INSTALL LIGHT
  - (S) INSTALL (S) INCH ELECTRICAL CONDUIT
  - (S) INSTALL (S) INCH LIQUIDTIGHT FLEXIBLE METAL CONDUIT
  - N/X INSTALL (N) NO. (8) THWN WIRES AND (X) NO. (8) NEUTRAL
  - N-G INSTALL (N) NO. 8 THWN GROUND WIRE
  - JB INSTALL JUNCTION BOX
  - SC INSTALL SERVICE CABINET
  - SP INSTALL SUB-PANEL
  - N CIRCUIT (N) NUMBER
  - N/G INSTALL (N) NO. (4/0) WIRES AND 1 NO. (X) GROUND
  - INSTALL OUTLET
  - LIGHT SUPPORT


**LIGHTING SCHEMATIC - SPAN 5**  
Scale : NO SCALE

2005\_20136\_SAUVIE ISLAND REPLACEMENT\_009\_SPAN 5 LIGHTING

DATE 03/09	REVISION As-Constructed	BY TDF	DRAFTED: BRENDA STROMBO			TRANSPORTATION DIVISION OREGON DEPARTMENT OF TRANSPORTATION BRIDGE ENGINEERING SECTION	BRIDGE NO. 2641	MULTNOMAH CHANNEL & PNWR ETC., SAUVIE ISLAND RD.	SHEET 163 OF 173
			CHECKED: JON HENRICHSEN				DATE SEPT 2005		
			REVIEWED: IAN CANNON	EXPIRES 6/30/07			CALC. BOOK	LIGHTING LAYOUT - SPAN 5	

Co. Br. No. 2641

(2) 1-1/2" HOLES FOR 1" LIQUIDTIGHT FLEXIBLE METAL CONDUIT. WESTENDS ONLY. SEAL AFTER INSTALLATION.

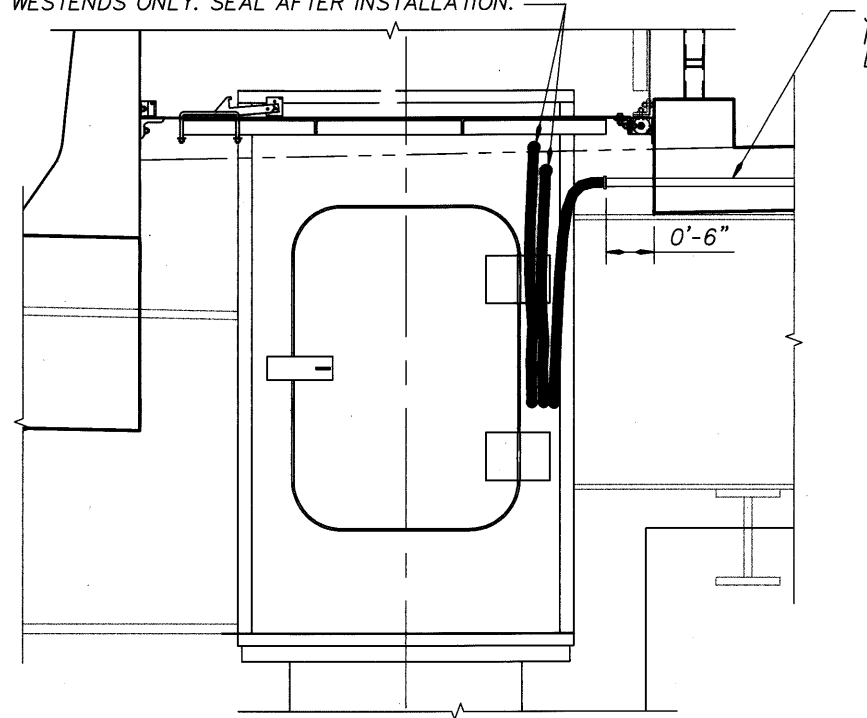

**ACCESS DOOR**

Scale: 1" = 1'-0" RIGHT SIDE SHOWN-LEFT SIDE IDENTICAL EXCEPT OPPOSITE HAND

3/4" GRC CAST IN SIDEWALK FOR NAVIGATION LIGHTS SEE DRAWING #70355

3/4" LIQUIDTIGHT FLEXIBLE METAL CONDUIT TO NAVIGATION LIGHTS

TOP OF "F" RAIL  
TOP OF SIDEWALK @ C ARCH

CURB

4" PVC SLEEVE CAST IN PLACE

SEAL PVC SLEEVE W/ APPROVED SEALANT

1" LIQUIDTIGHT FLEXIBLE METAL CONDUIT

\* 1" LIGHTING CONDUIT SHOWN THROUGH DIAPHRAGMS C-D-E-F ON WESTEND ONLY. EAST SIDE CONDUIT DOES NOT ENTER KNUCKLE SECTION


ANGLE SUPPORT

**KNUCKLE SECTION ELEVATION**

Scale: 3/4" = 1'-0" RIGHT SIDE SHOWN-LEFT SIDE IDENTICAL EXCEPT OPPOSITE HAND

NOTE:  
LEAVE ENOUGH SLACK IN FLEXIBLE LIQUIDTIGHT METAL CONDUIT TO ACCOMMODATE 9" MOVEMENT OF ARCH EXPANSION JOINT.

SEE DRAWING #70353 FOR SECTIONS AND DETAILS FOR KNUCKLE SECTION, ARCH AND TIE GIRDER

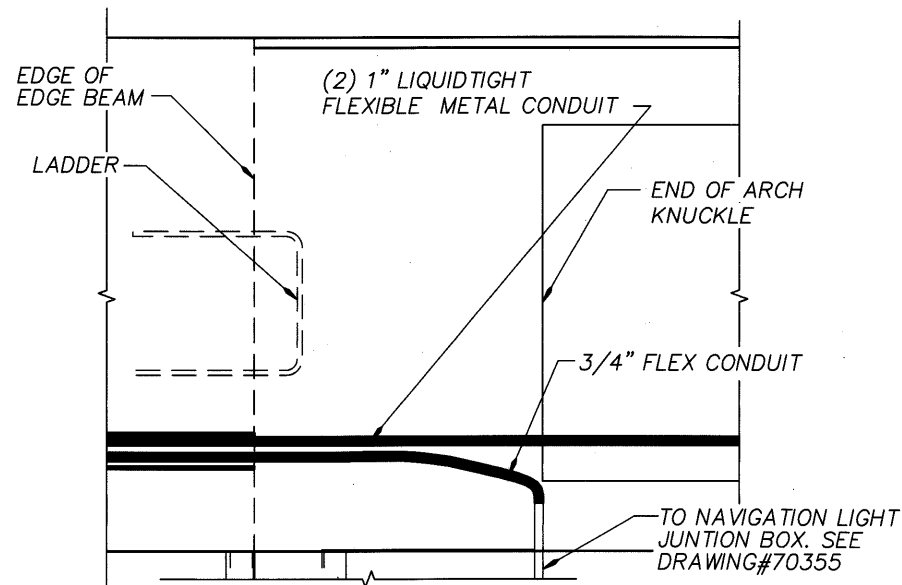

**ACCESS AREA PLAN**

Scale: 1" = 1'-0" RIGHT SIDE SHOWN-LEFT SIDE IDENTICAL EXCEPT OPPOSITE HAND

2005\_20136\_SAUIVE ISLAND REPLACEMENT\_010\_DETAILS 1

Co. Br. No. 2641

DATE	REVISION	BY
03/09	As-Constructed	TDF

DRAFTED: BRENDA STROMBO  
 CHECKED: JON HENRICHSEN  
 REVIEWED: IAN CANNON


**DESIGNER**

CONNECTING COMMERCE AND COMMUNITY  
**MULTNOMAH COUNTY BRIDGES**  
 TRANSPORTATION DIVISION  
 OREGON DEPARTMENT OF TRANSPORTATION  
 BRIDGE ENGINEERING SECTION


BRIDGE NO.	20136
DATE	SEPT. 2005
CALC. BOOK	

MULTNOMAH CHANNEL & PNWR ETC., SAUVIE ISLAND RD.	
LIGHTING DETAILS - 1	


SHEET	164
OF	173
DRAWING NO.	70352

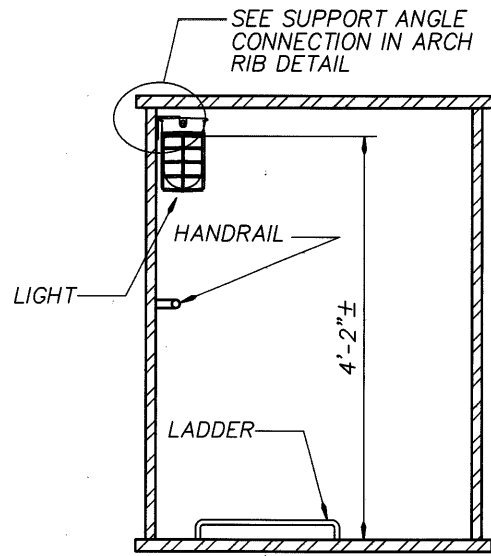



**TYPICAL ARCH RIB SECTION**  
Scale: 1" = 1'-0"

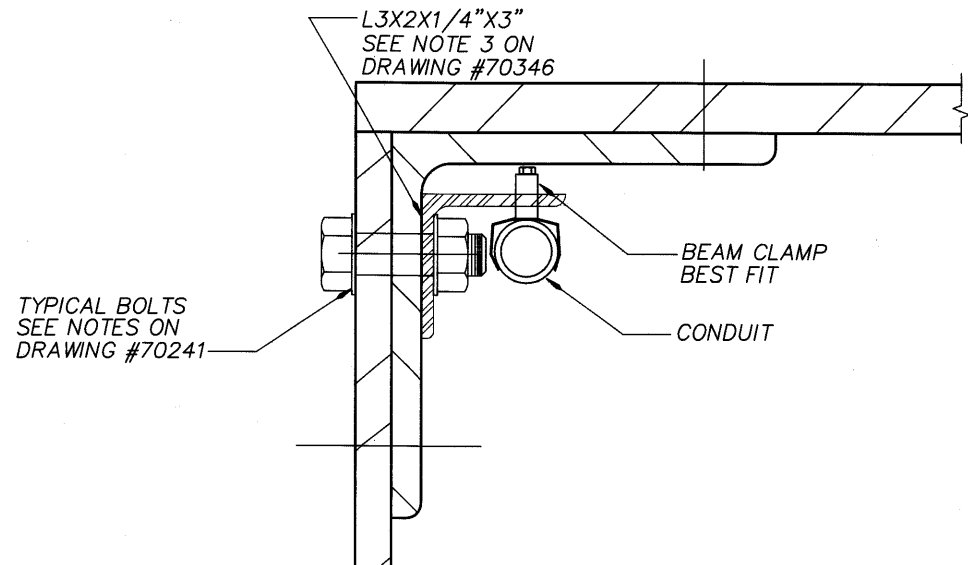

**TYPICAL SUPPORT ANGLE CONNECTION IN TIE GIRDER AND KNUCKLE SECTION**  
Scale: 6" = 1'-0"

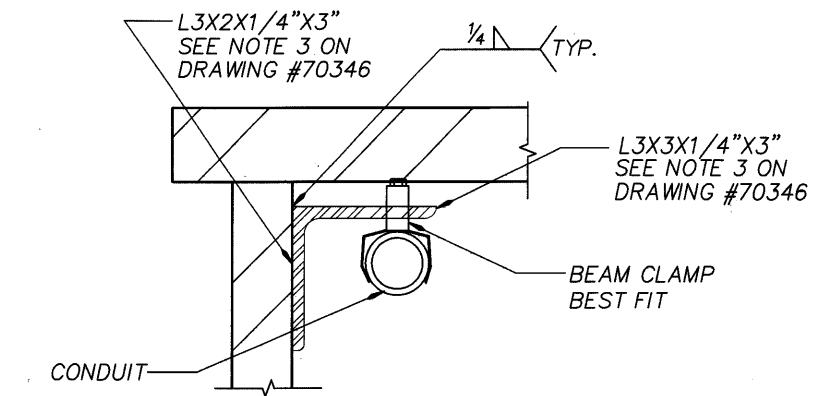


**TYPICAL SUPPORT ANGLE CONNECTION IN ARCH RIB SECTION**  
Scale: 6" = 1'-0"

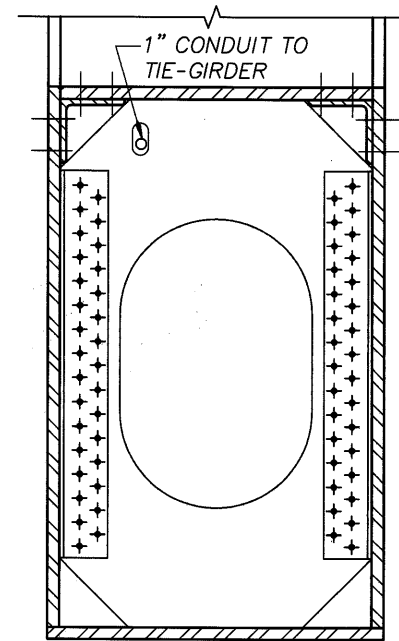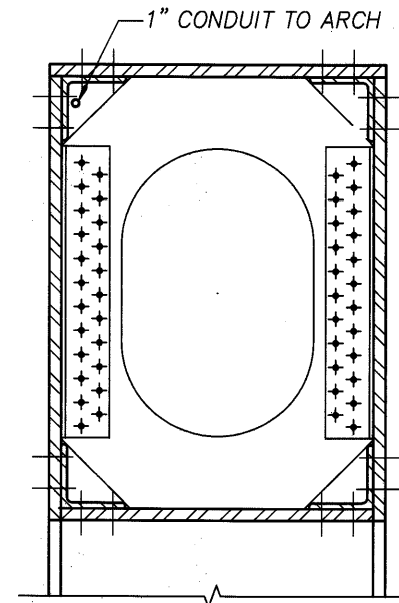


**SECTION A-A**  
Scale: 1" = 1'-0"


- NOTES:**
- ANGLE CONFIGURATION FOR INFORMATION ONLY. FABRICATOR TO DETERMINE BEST FIT.
  - SEE ADDITIONAL SUPPORT NOTES ON DRAWING #70346.
  - DIAPHRAGMS SHOWN LOOKING TOWARDS STATION 0+00 ON THE RIGHT SIDE. LEFT SIDE IDENTICAL EXPECT OPPOSITE HAND.

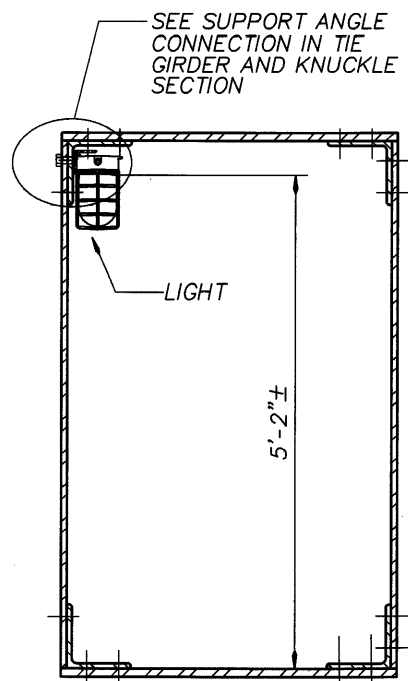


**TYPICAL TIE GIRDER SECTION**  
Scale: 1" = 1'-0"

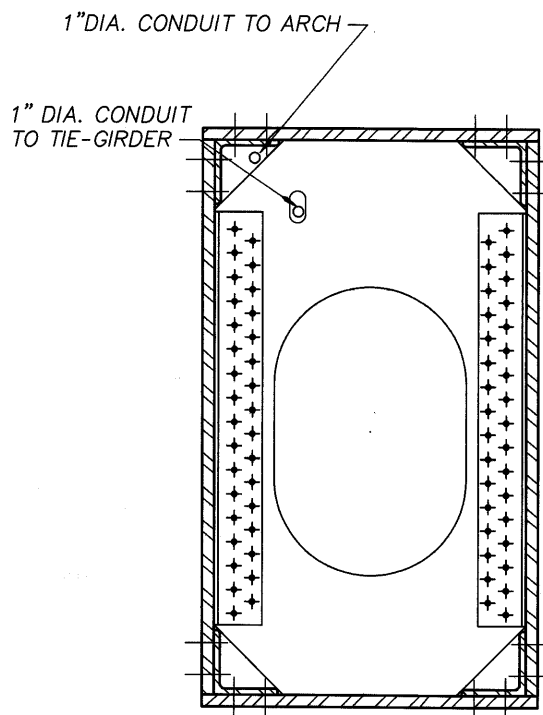

**DIAPHRAGM C**  
Scale: 1" = 1'-0"

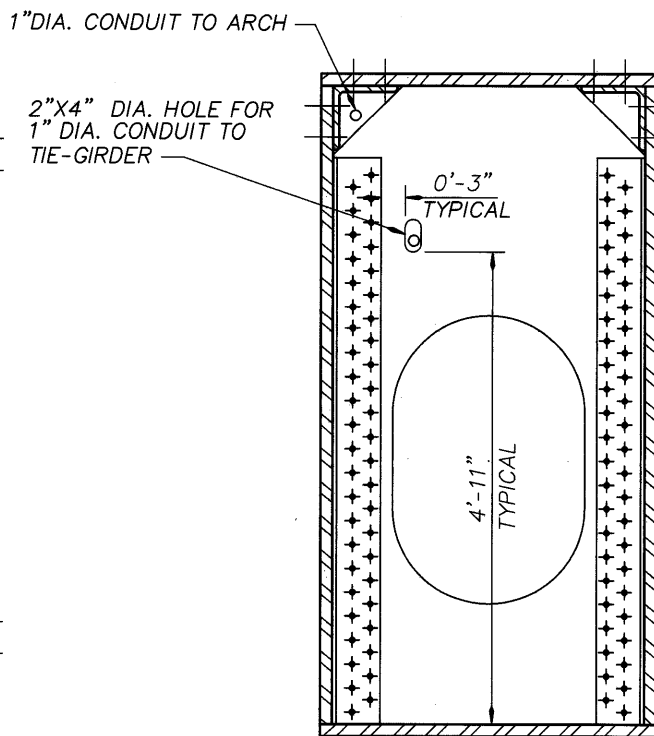

**DIAPHRAGM D**  
Scale: 1" = 1'-0"  
DIAPHRAGM E SIMILAR

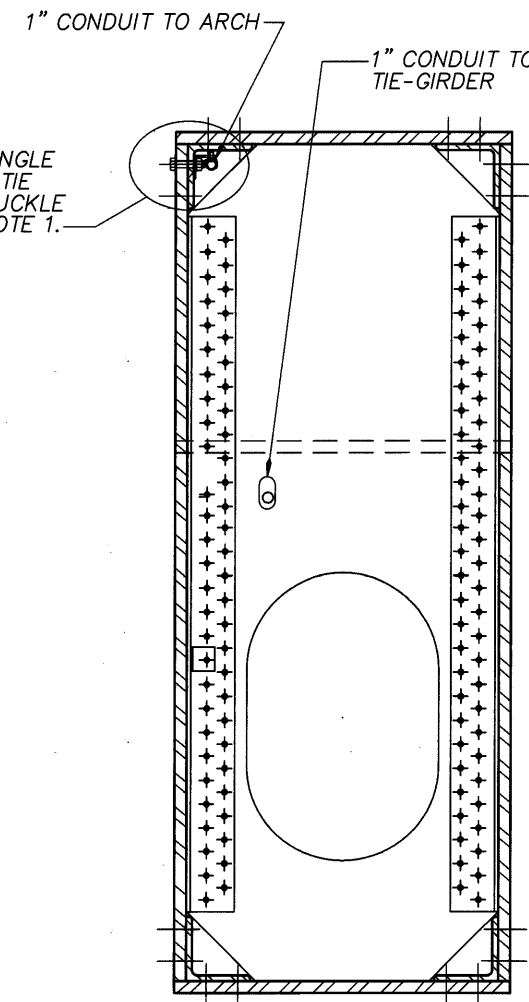


**DIAPHRAGM F**  
Scale: 1" = 1'-0"

Co. Br. No. 2641

DATE	03/09	REVISION	As-Constructed	BY	TD	DESIGNER	BRENDA STROMBO	CONNECTING COMMERCE AND COMMUNITY	MULTNOMAH COUNTY BRIDGES	TRANSPORTATION DIVISION	BRIDGE NO.	2641	SHEET	165
CHECKED:	JON HENRICHSEN	DESIGNER	JON P. HENRICHSEN	REGISTERED PROFESSIONAL ENGINEER	EXPIRES 6/30/07	OREGON DEPARTMENT OF TRANSPORTATION	BRIDGE ENGINEERING SECTION	DATE	SEPT 2005	MULTNOMAH CHANNEL & PNWR ETC., SAUVIE ISLAND RD.	DRAWING NO.	70353		
REVIEWED:	IAN CANNON							CALC. BOOK		LIGHTING DETAILS - 2				


2005\_20136\_SAUVIE ISLAND REPLACEMENT\_011\_DETAIL 2

2005\_20136\_SUAUIE ISLAND REPLACEMENT\_012\_DETAIL 3

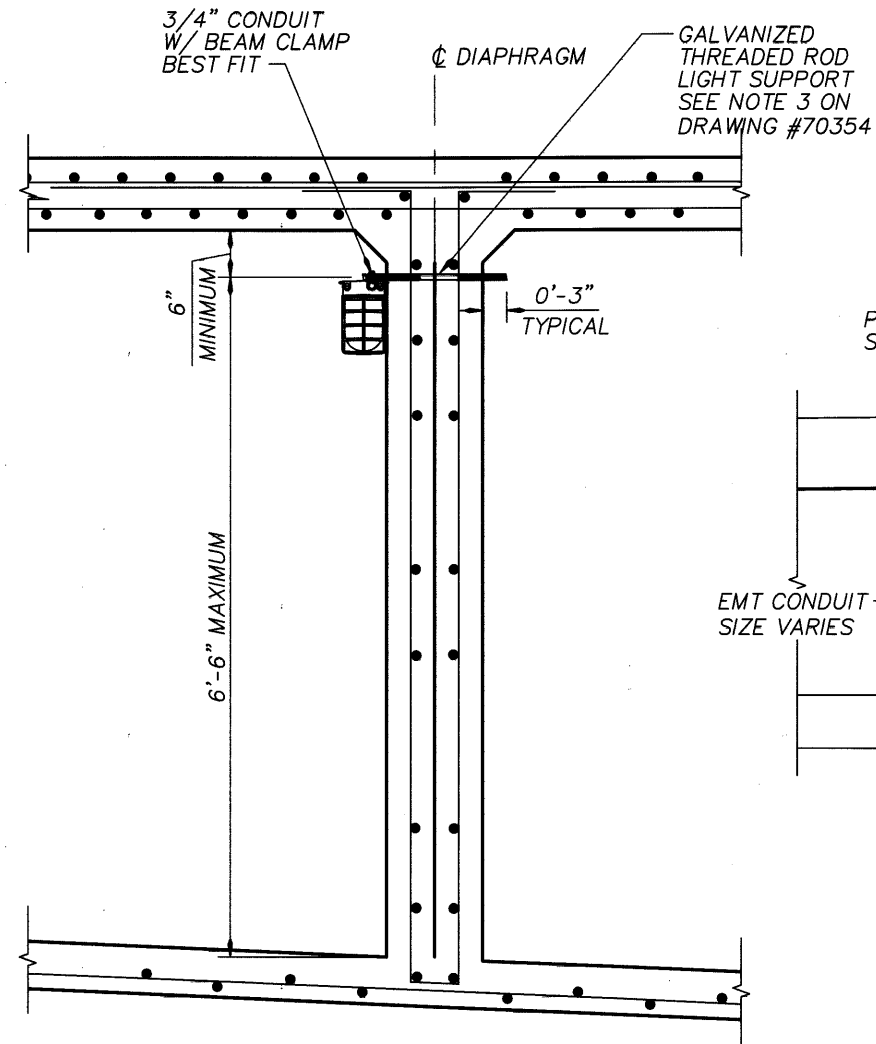


**TYPICAL DIAPHRAGM SECTION LIGHTING**

SCALE: 1"=1'-0"

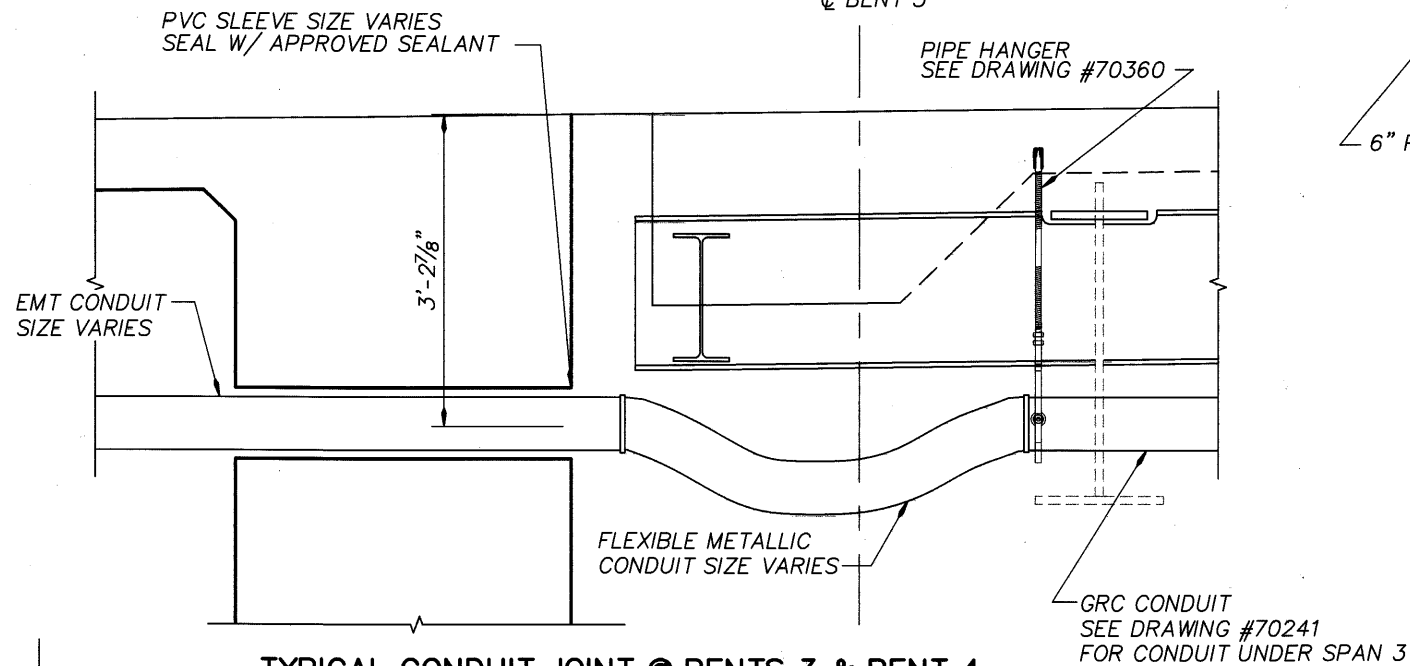

**TYPICAL CONDUIT JOINT @ BENTS 3 & BENT 4**

SCALE: 1"=1'-0" BENT 3 SHOWN-BENT 4 IDENTICAL EXPECT OPPOSITE HAND

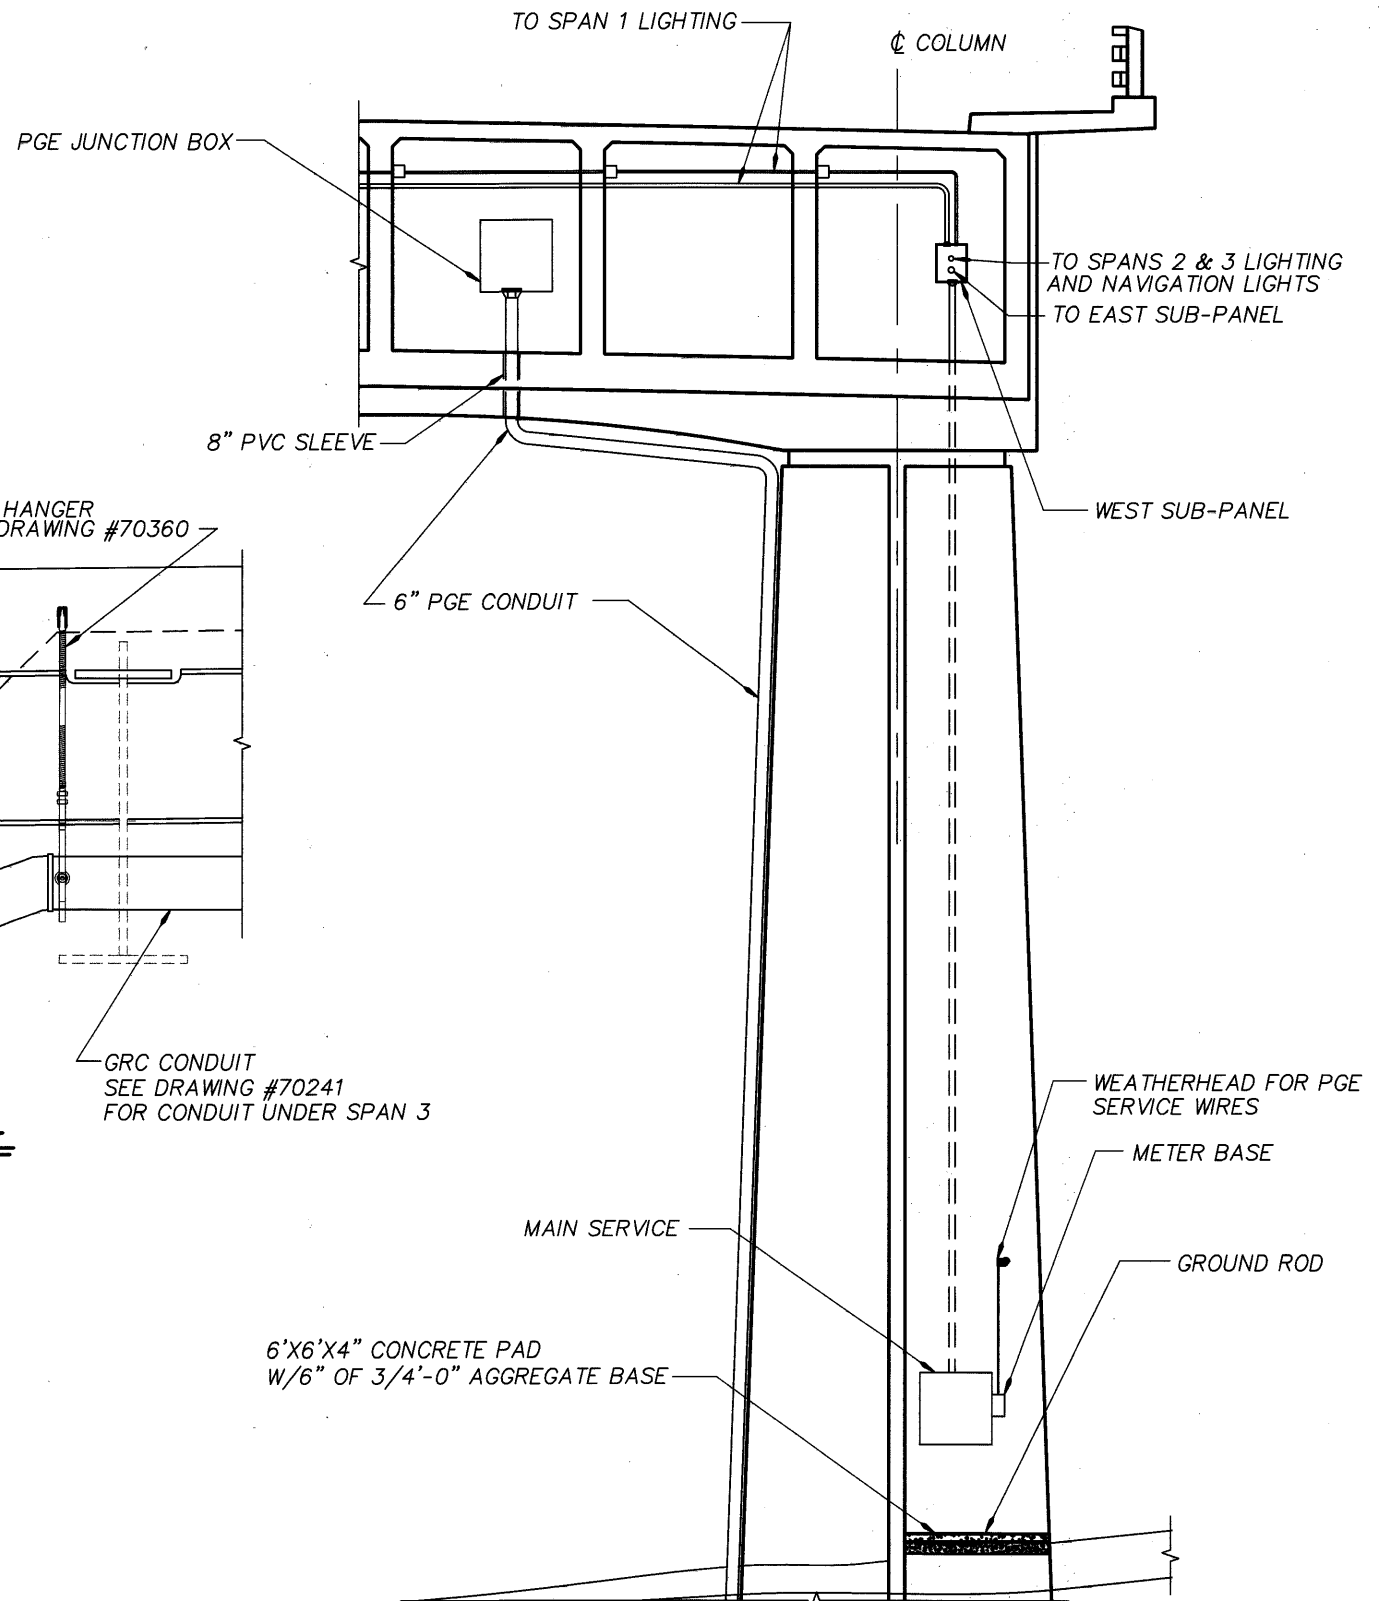


**BENT 2 SERVICE**

SCALE: 1/4"=1'-0"


	DATE	REVISION	BY	DRAFTED: BRENDA STROMBO CHECKED: JON HENRICHSEN REVIEWED: IAN CANNON		TRANSPORTATION DIVISION OREGON DEPARTMENT OF TRANSPORTATION BRIDGE ENGINEERING SECTION	BRIDGE NO.	MULTNOMAH CHANNEL & PNWR ETC., SAUVIE ISLAND RD.	SHEET 166 OF 173 DRAWING NO. 70354
	03/09	As-Constructed	TDF				2641		
							Co. Br. No. 2641		LIGHTING DETAILS-3

**NOTES:**  
 1. LIGHT AND OUTLET LOCATIONS AND SPACING ARE APPROXIMATE. CONTRACTOR TO VERIFY LOCATIONS WITH ENGINEER BEFORE INSTALLATION.  
 2. ALL INTERIOR ELECTRICAL CONDUIT SHALL BE EMT EXCEPT IN AREAS SET FORTH IN SECTION 00583.00 OF STANDARD SPECIFICATIONS FOR CONSTRUCTION.


- LEGEND:**
- INSTALL WALL MOUNTED LIGHT
  - INSTALL (S) INCH ELECTRICAL CONDUIT
  - INSTALL (N) NO. (8) THWN WIRES AND NO. (8) NEUTRAL
  - INSTALL (N) NO. 8 THWN GROUND WIRE
  - INSTALL JUNCTION BOX
  - INSTALL SERVICE CABINET
  - INSTALL SUB-PANEL
  - CIRCUIT (N) NUMBER
  - INSTALL (N) NO. (4/0) WIRES AND 1 NO. (X) GROUND
  - INSTALL NAVIGATION LIGHT

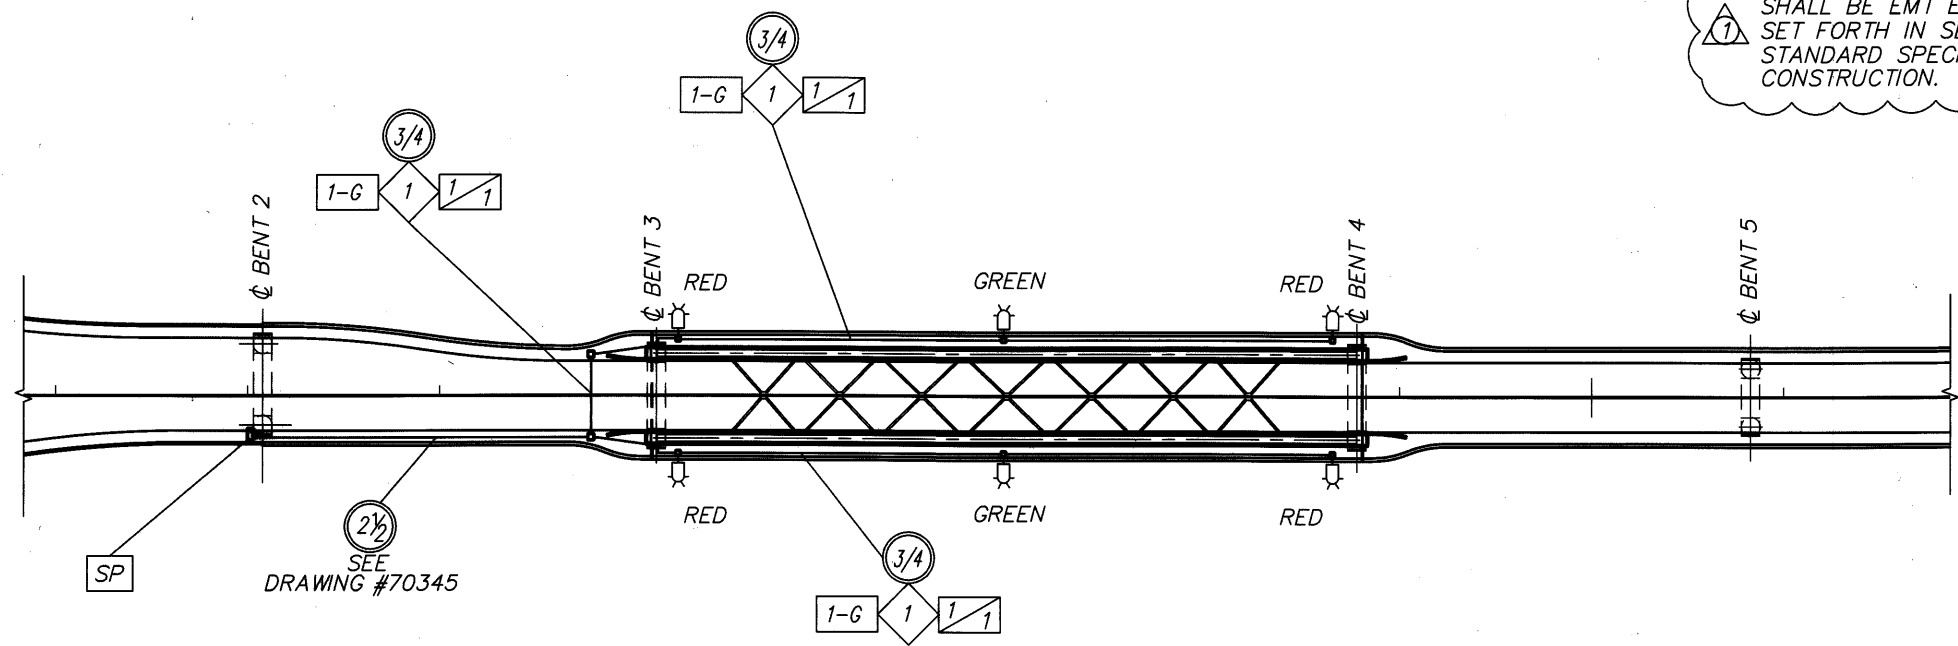

**PLAN**  
 Scale: 1" = 50'

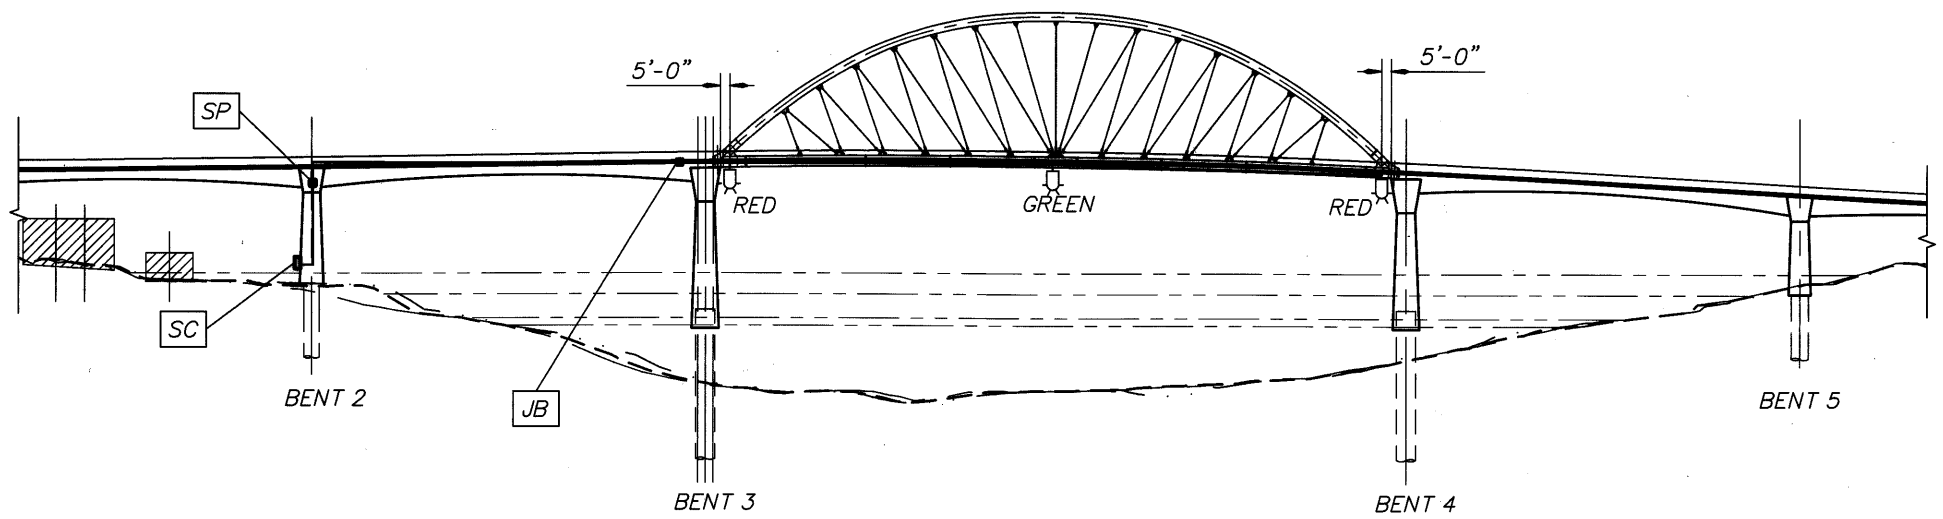

**ELEVATION**  
 Scale: 1" = 50'

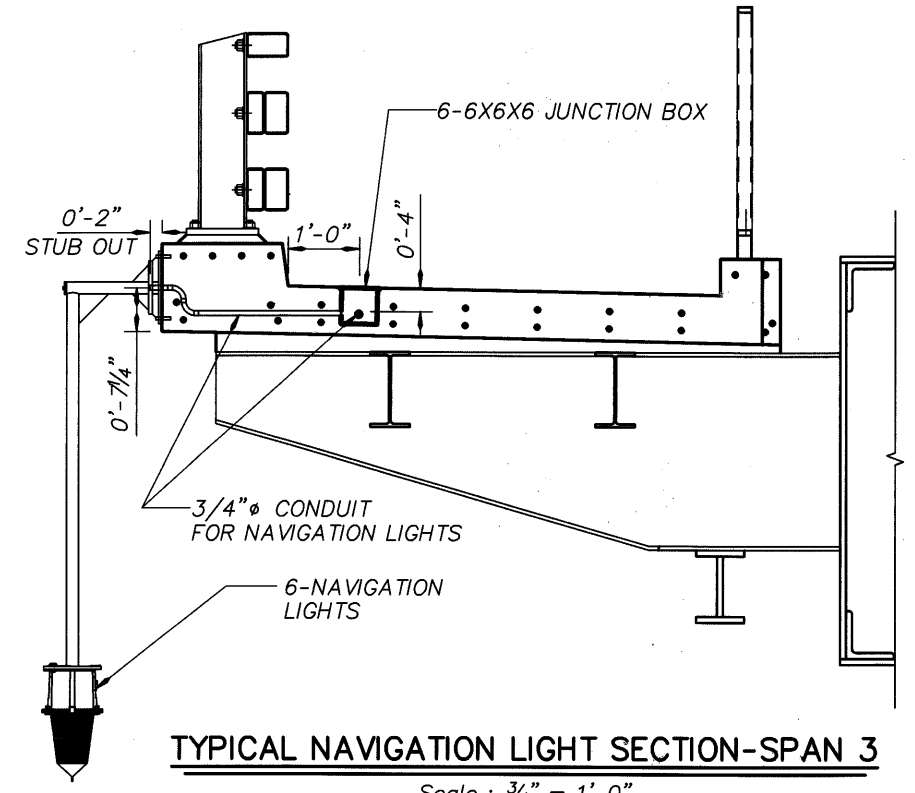

**TYPICAL NAVIGATION LIGHT SECTION-SPAN 3**  
 Scale: 3/4" = 1'-0"

2005\_20136\_SUAIVE ISLAND REPLACEMENT\_013\_NAVIGATIONAL LIGHTS

REVISION	DATE	BY
1	9/14/05	JPH
03/09	As-Constructed	TDF

DESIGNER: BRENDA STROMBO  
 DRAFTED: [Signature]  
 CHECKED: JON HENRICHSEN  
 REVIEWED: IAN CANNON

REGISTERED PROFESSIONAL ENGINEER  
 1852  
 OREGON  
 JULY 19, 1998  
 JON P. HENRICHSEN  
 EXPIRES 6/30/07

CONNECTING COMMERCE AND COMMUNITY  
**MULTNOMAH COUNTY BRIDGES**  
 TRANSPORTATION DIVISION  
 OREGON DEPARTMENT OF TRANSPORTATION  
 BRIDGE ENGINEERING SECTION

BRIDGE NO. 20136  
 DATE SEPT 2005  
 CALC. BOOK

MULTNOMAH CHANNEL & PNWR ETC., SAUVIE ISLAND RD.  
 NAVIGATIONAL LIGHTS

SHEET 167 OF 173  
 DRAWING NO. 70355

## SUB PANEL WEST FEED CIRCUIT SCHEDULE

SERVICE VOLTAGE 120/240 BUS RATING 200 AMP LOCATION INSIDE BENT 2  
 BUS CONNECTION 1 P W DRAWING No. \_\_\_\_\_

DESCRIPTION	VOLTAMPS		BREAKER		CKT No	BUS CONNECTION	CKT No	BREAKER		VOLTAMPS		DESCRIPTION
	A	B	AMP	POLE				AMP	POLE	A	B	
SPAN 1 LIGHTING	621		20	1	1	●	2	20	1	621		SPAN 1 LIGHTING
SPAN 1 LIGHTING		621	20	1	3	●	4	20	1		552	SPAN 1 LIGHTING
SPAN 1 LIGHTING	552		20	1	5	●	6	20	1	552		SPAN 1 LIGHTING
SPAN 2 LIGHTING		414	20	1	7	●	8	20	1		414	SPAN 2 LIGHTING
SPAN 2 LIGHTING	414		20	1	9	●	10	20	1	414		SPAN 2 LIGHTING
SPAN 2 LIGHTING		414	20	1	11	●	12	20	1		414	SPAN 2 LIGHTING
SPAN 2 LIGHTING	345		20	1	13	●	14	20	1	483		ARCH NORTH LIGHTING
ARCH NORTH LIGHTING		276	20	1	15	●	16	20	1		414	ARCH NORTH LIGHTING
ARCH NORTH LIGHTING	345		20	1	17	●	18	20	1	276		ARCH NORTH LIGHTING
ARCH NORTH LIGHTING		276	20	1	19	●	20	20	1		483	ARCH SOUTH LIGHTING
ARCH SOUTH LIGHTING	414		20	1	21	●	22	20	1	414		ARCH SOUTH LIGHTING
ARCH SOUTH LIGHTING		345	20	1	23	●	24	20	1		276	ARCH SOUTH LIGHTING
ARCH SOUTH LIGHTING	276		20	1	25	●	26	20	1	414		TIE NORTH LIGHTING
TIE NORTH LIGHTING		345	20	1	27	●	28	20	1		276	TIE NORTH LIGHTING
TIE SOUTH LIGHTING	414		20	1	29	●	30	20	1	345		TIE SOUTH LIGHTING
TIE SOUTH LIGHTING		276	20	1	31	●	32	20	1		1500	SPAN 1 OUTLETS
SPAN 1 OUTLETS	1500		20	1	33	●	34	20	1	1500		SPAN 2 OUTLETS
SPAN 2 OUTLETS		1500	20	1	35	●	36	20	1		1500	TIE OUTLETS (LS)
ARCH OUTLETS (RS)	1500		20	1	37	●	38	20	1	1500		ARCH OUTLETS (LS)
TIE OUTLETS (RS)		1500	20	1	39	●	40	60			14,400	SUB-PANEL E
					41	●	42	60			14,400	SUB-PANEL E
<b>TOTALS</b>	6450	6110				S/N				20929	20229	

BUS A 27.3 3 KVA MAIN (LUGS) 200 AMP LINE AMPS 164  
 BUS B 26.3 KVA PHASING 1 120/240 VOLTS  
 FEEDER SIZE 4/0  
 SOURCE MAIN SERVICE

## SUB PANEL EAST FEED CIRCUIT SCHEDULE

SERVICE VOLTAGE 120/240 BUS RATING 60 AMP LOCATION BENT 3 INSIDE GIRDER  
 BUS CONNECTION P W DRAWING No. \_\_\_\_\_

DESCRIPTION	VOLTAMPS		BREAKER		CKT No	BUS CONNECTION	CKT No	BREAKER		VOLTAMPS		DESCRIPTION
	A	B	AMP	POLE				AMP	POLE	A	B	
SPAN 4 LIGHTING	414		20	1	1	●	2	20	1	414		SPAN 4 LIGHTING
SPAN 4 LIGHTING		414	20	1	3	●	4	20	1		414	SPAN 4 LIGHTING
SPAN 5 LIGHTING	276		20	1	5	●	6	20	1	276		SPAN 5 LIGHTING
SPAN 5 LIGHTING		276	20	1	7	●	8	20	1		276	SPAN 5 LIGHTING
SPAN 4 OUTLETS	1500		20	1	9	●	10	20	1	1500		SPAN 5 OUTLETS
SPAN 5 LIGHTING		276	20	1	11	●	12	20	1		276	SPAN 5 OUTLETS
SPAN 5 LIGHTING	276		20	1	13	●	14	20	1	276		SPAN 5 OUTLETS
					15	●	16					
					17	●	18					
					19	●	20					
<b>TOTALS</b>	2466	966				S/N				966	2416	

BUS A 3.4 KVA MAIN (LUGS) 60 AMP LINE AMPS 29  
 BUS B 3.4 KVA PHASING 1 120/240 VOLTS  
 FEEDER SIZE 1 4/0  
 SOURCE SUB-PANEL WEST

## MAIN SERVICE


SERVICE VOLTAGE 120/240 BUS RATING 400 AMP LOCATION BASE OF BENT 2  
 MOUNTING \_\_\_\_\_ BUS CONNECTION 1 P W DRAWING No. \_\_\_\_\_


DESCRIPTION	VOLTAMPS		BREAKER		CKT No	BUS CONNECTION	CKT No	BREAKER		VOLTAMPS		DESCRIPTION
	A	B	AMP	POLE				AMP	POLE	A	B	
NAVIGATIONAL LIGHTS	2400		20	1	1	●	2	20	1	60K		SUB-PANEL WEST
					3	●	4	20	1		60K	SUB-PANEL WEST
					5	●	6					
					7	●	8					
					9	●	10					
					11	●	12					
<b>TOTALS</b>	2400					S/N				60K	60K	

BUS A 62.4K MAIN (LUGS) 400 AMP LINE AMPS 220  
 BUS B 60K PHASING 1 120/240 VOLTS  
 FEEDER SIZE 250 MCM  
 SOURCE PGE

Co. Br. No. 2641


2005\_20136\_SUA VIE ISLAND REPLACEMENT\_014\_CIRCUIT PANELS

	DATE <b>03/09</b>	REVISION <b>As-Constructed</b>	BY <b>TDF</b>	DRAFTED: <b>BRENDA STROMBO</b> CHECKED: <b>JON HENRICHSEN</b> REVIEWED: <b>IAN CANNON</b>	 DESIGNER EXPIRES 6/30/07	 TRANSPORTATION DIVISION OREGON DEPARTMENT OF TRANSPORTATION BRIDGE ENGINEERING SECTION	BRIDGE NO. <b>20136</b> DATE <b>SEPT 2005</b> CALC. BOOK	MULTNOMAH CHANNEL & PNWR ETC., SAUVIE ISLAND RD. LIGHTING CIRCUIT SCHEDULE	SHEET <b>168</b> OF <b>173</b> DRAWING NO. <b>70356</b>
--	----------------------	-----------------------------------	------------------	---	---	--	--	---	--

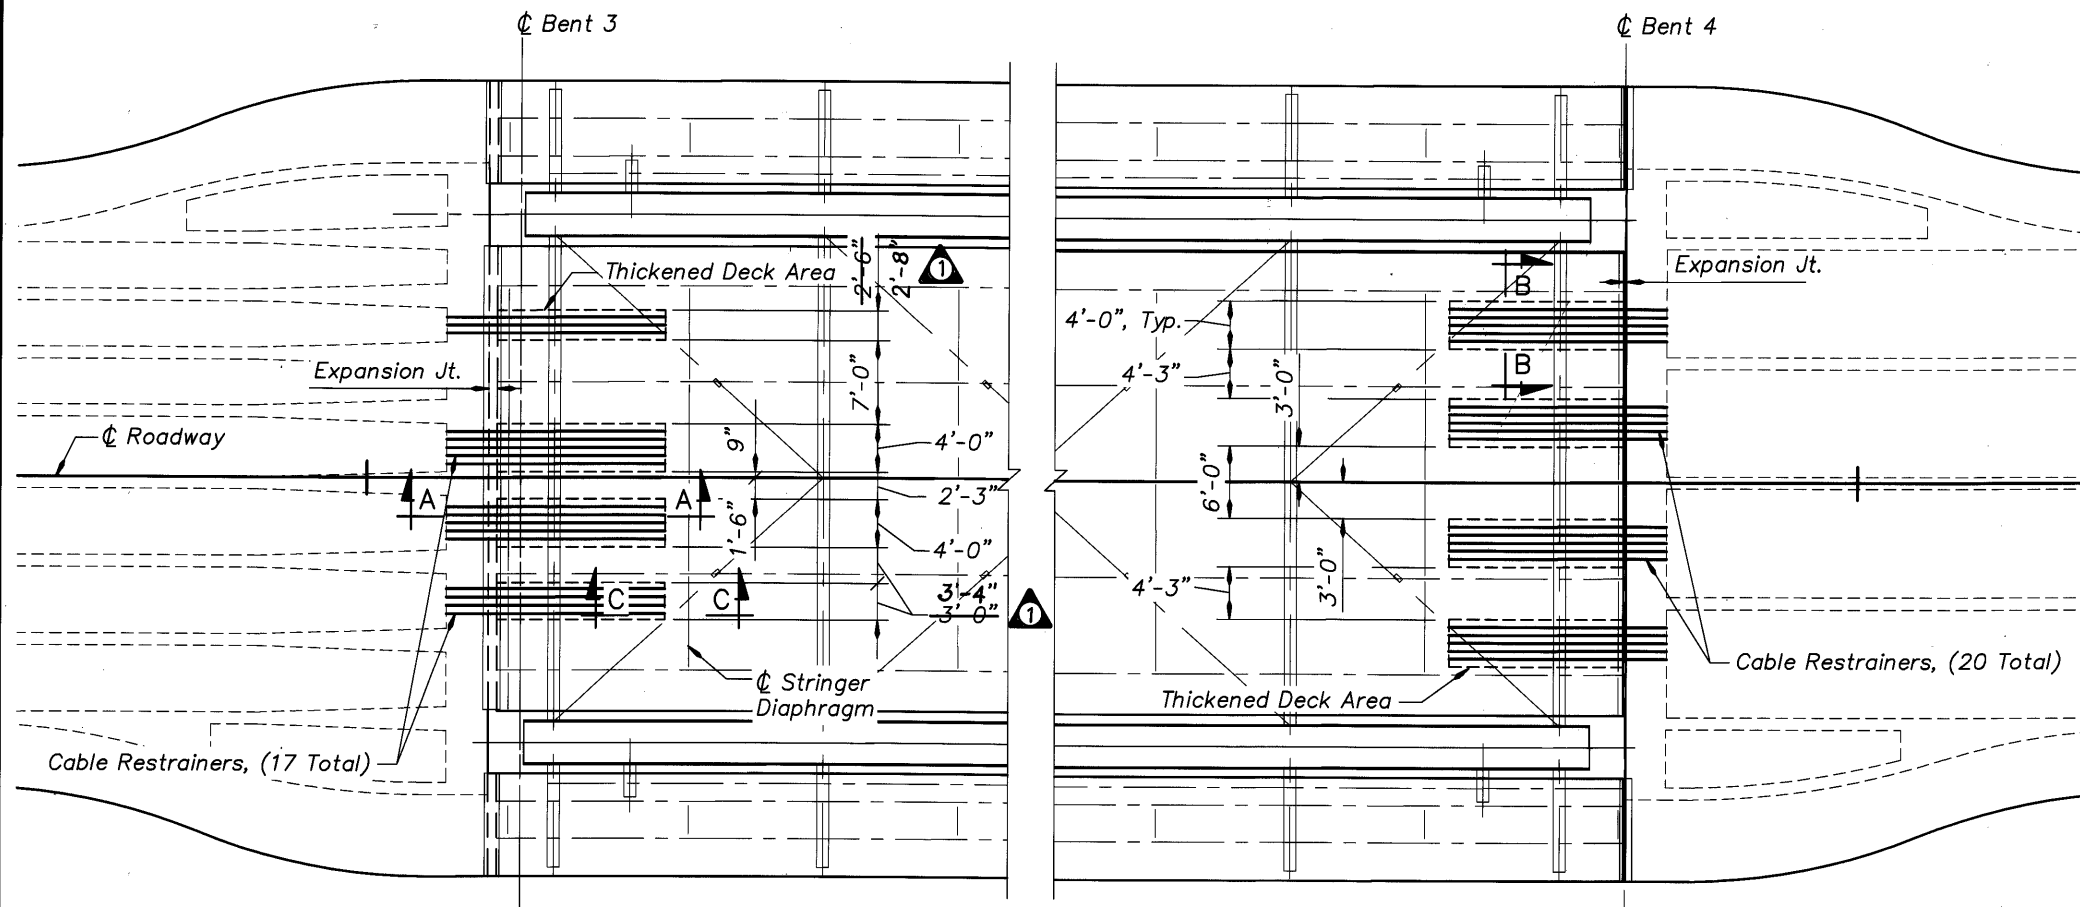


**PLAN - BENT 3**  
Scale: 1/8" = 1'-0"


**PLAN - BENT 4**  
Scale: 1/8" = 1'-0"

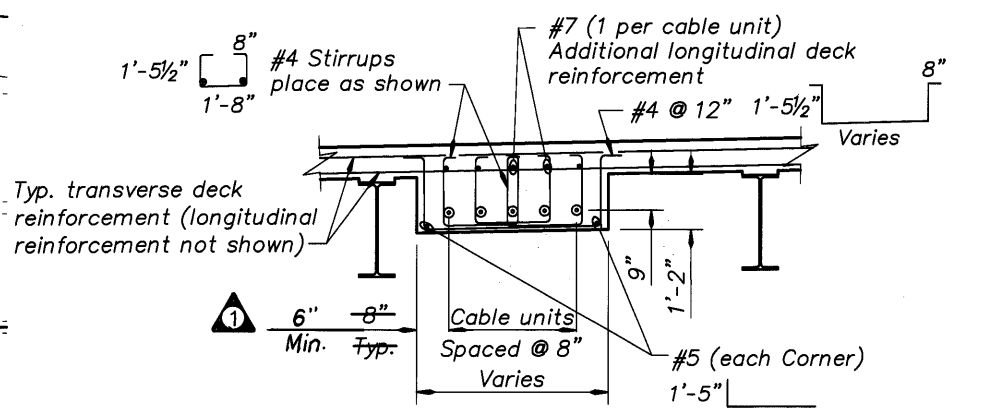

**SECTION B-B**  
Scale: 1/2" = 1'-0"  
Note: See Plan views for number of cable units per location.

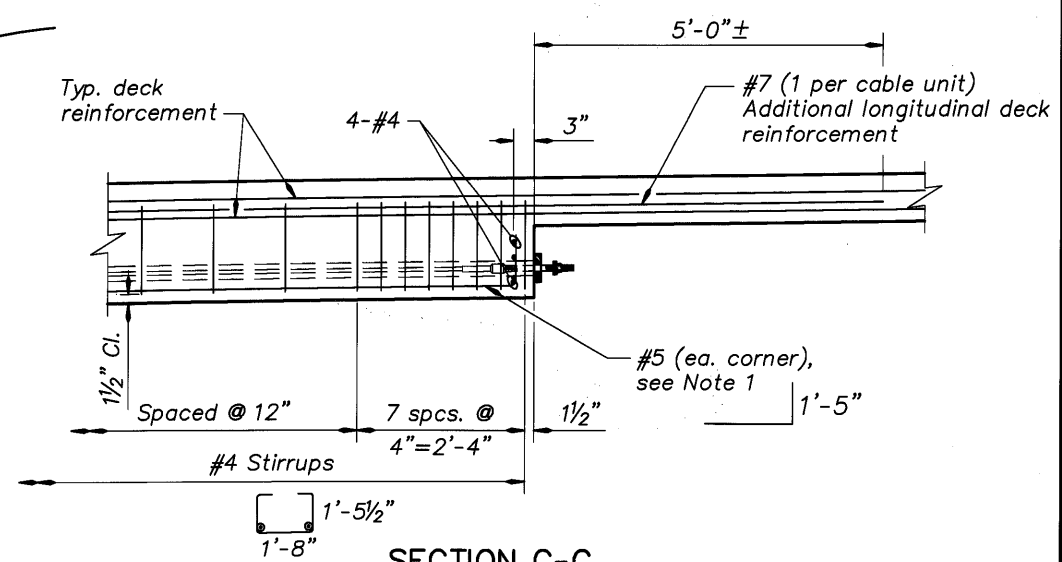

**SECTION C-C**  
Scale: 3/4" = 1'-0"

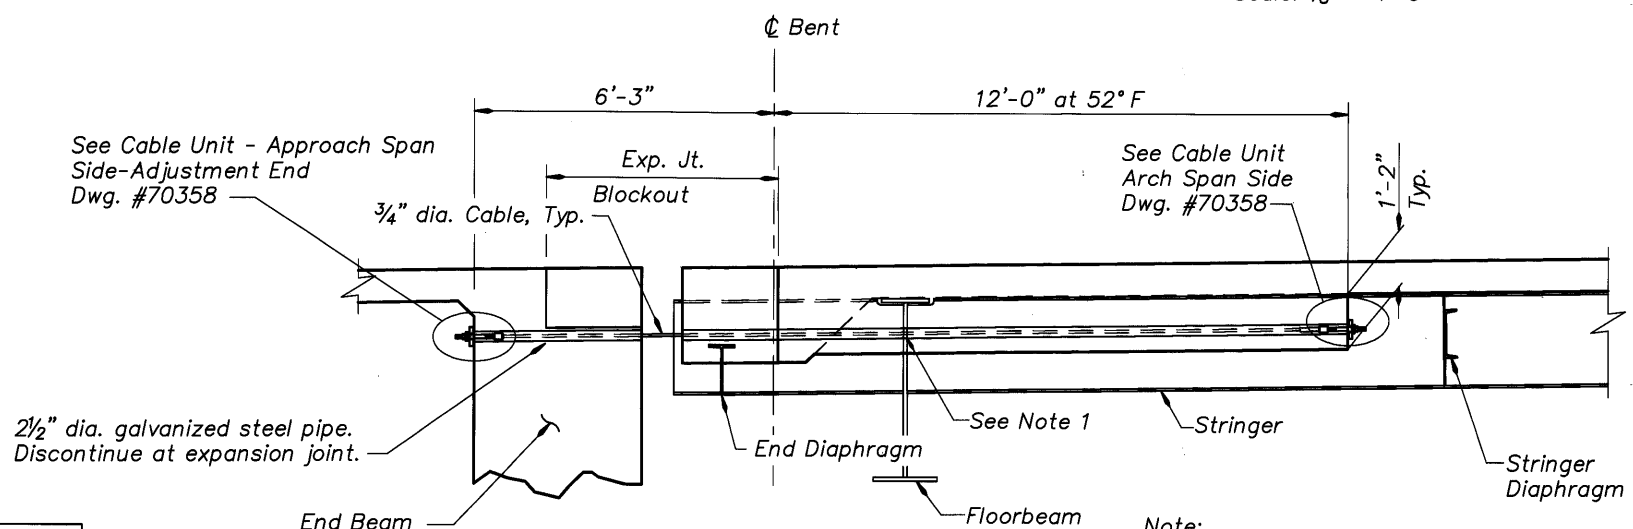





**SECTION A-A**  
Scale: 1/2" = 1'-0"  
Note: Bent 3 shown, Bent 4 similar.

Note:  
1. Cut circular opening in floorbeam web for restrainer pipes and longitudinal reinforcement. Opening may exceed diameter by 1/2" maximum.

DO NOT SCALE THIS DRAWING. FOLLOW DIMENSIONS. INDICATED SCALES CORRECT ONLY FOR FULL SIZE SHEET (22"x34").

	DATE	REVISION	BY	J. Patton	DESIGNER  <b>DAVID EVANS AND ASSOCIATES INC.</b> 530 Center Street N.E., Suite 605 Salem Oregon 97301 Phone: 503.361.8635	BRIDGE NO. 20136	MULTNOMAH COUNTY TRANSPORTATION DIVISION	SHEET 169 OF 173
	03/09	As-Constructed	TDF	DRAFTED: Shonn Mills CHECKED: Paul Greco REVIEWED:				
SEISMIC RESTRAINER DETAILS (1 OF 2)							DRAWING NO. 70357	



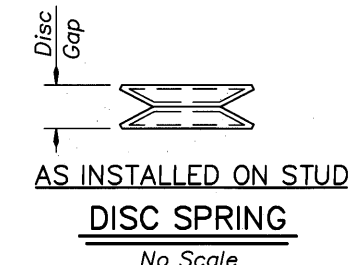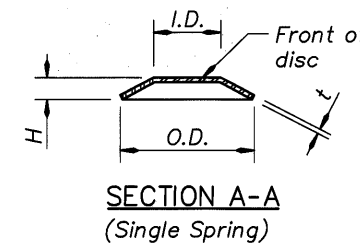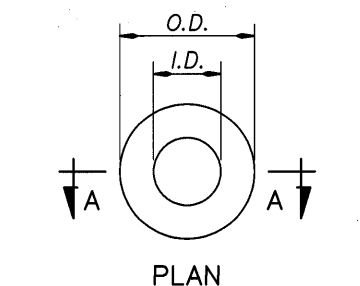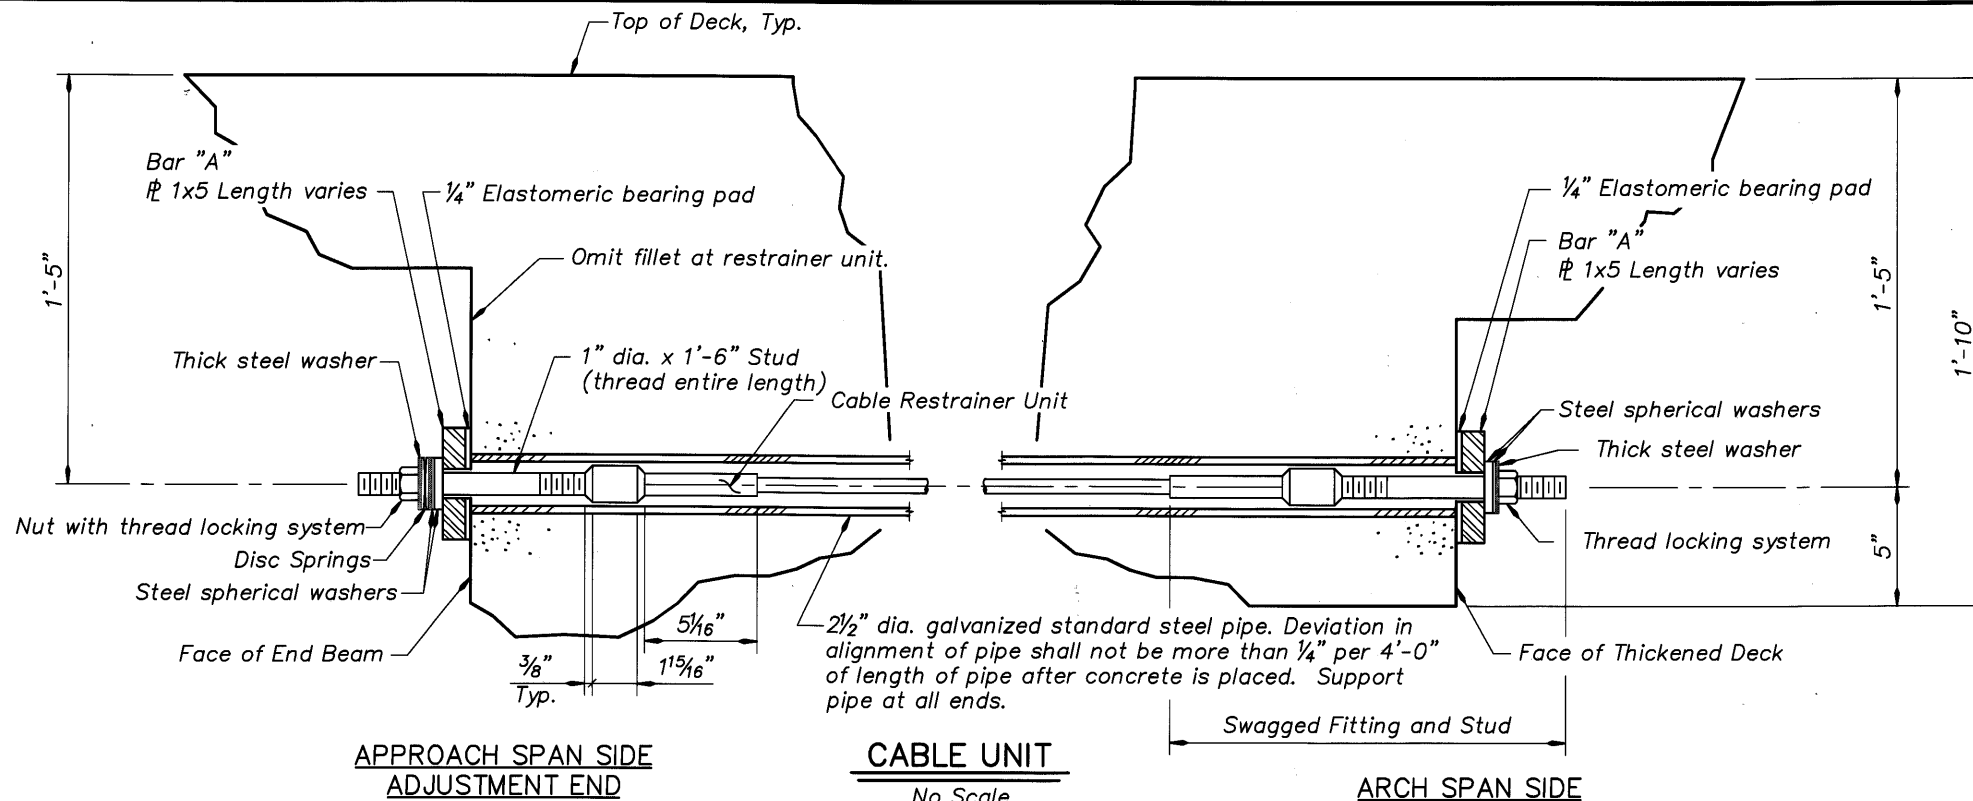


**RESTRAINER UNIT INSTALLATION PROCEDURE**

1. Install sperical washers, disc springs, nut, washers on the Approach Span side of restrainers as shown in the Adjustment End Detail above. Disc springs shall be installed front to front as shown in Disc Spring Detail.
2. Place only nut and washer on Arch Span side of restrainers. Place thread locking system on Main Span side stud prior to installing nut and washers, and prior to setting the cable.
3. Tighten nut on the cable from the adjustment end of restrainer until the disc springs collapse and there is no disc gap remaining between the discs. The cable should be approximately straight with no sag.
4. Place thread locking system on Approach Span stud after tightening the cable, but before backing off the nut. Back off the nut at the approach span side a distance equal to the maximum amount the expansion joint is expected to open relative to the existing ambient conditions, as shown on the plans for movement rating.

- Notes:**
1. The ends of pipe shall be covered or capped to prevent concrete and debris from entering the pipe until concrete is in place.
  2. Care should be taken to align the pipes on each side of expansion joint.
  3. All ends of pipes must be flush with or slightly recessed from the concrete. The inside edges of the pipes must be smooth to prevent fraying cables.
  4. If the cable needs to be secured from turning while tightening, use double nut locking technique on the stud to protect the threads.

DO NOT SCALE THIS DRAWING. FOLLOW DIMENSIONS. INDICATED SCALES CORRECT ONLY FOR FULL SIZE SHEET (22"x34").

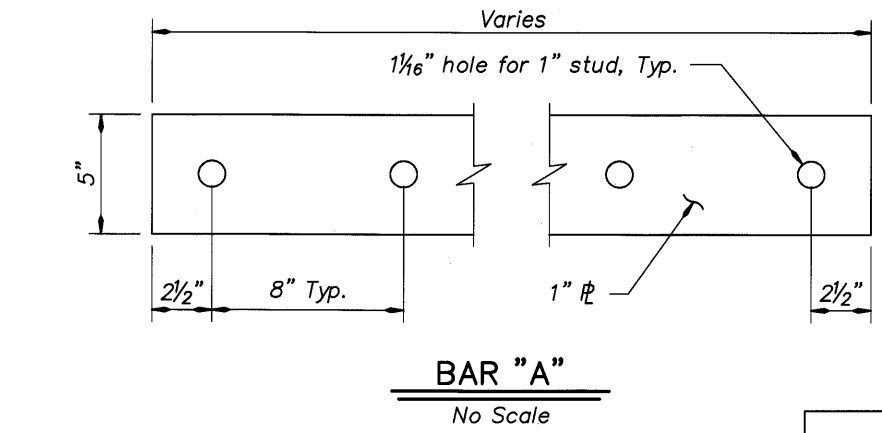

**DISC SPRINGS AND WASHERS**

All dimensions in inches except as noted.



*L (ft.)	DISC SPRING				STEEL SPHERICAL WASHER			THICK WASHER		
	I.D.	O.D.	t	H	I.D.	O.D.	Nom. Thickness	I.D.	O.D.	t**
0 - 25	1	2	1/16	1/8	1.125	2.25	1/2	1	2	1/4

\* For length L (ft.), see Cable Restrainer Unit Details Dwg. #SA151.  
 \*\* Minimum value

Note: All OD and ID dimensions for washers and disc springs shall meet the dimensional tolerances for harden steel washers, ASTM F436.



	DATE	03/09	REVISION	As-Constructed	BY	J. Patton			TRANSPORTATION DIVISION OREGON DEPARTMENT OF TRANSPORTATION BRIDGE ENGINEERING SECTION	BRIDGE NO.	20136	MULTNOMAH CHANNEL & PNWR ETC., SAUVIE ISLAND RD.	SHEET	170
	CHECKED:	Shonn Mills	DATE	Sept. 2005	OF	173								
	REVIEWED:	Paul Greco	CALC. BOOK		DRAWING NO.	70358								
	EXPIRES:	12-31-05												



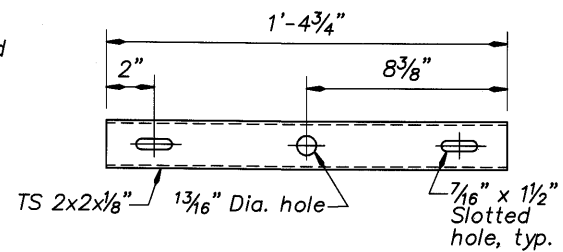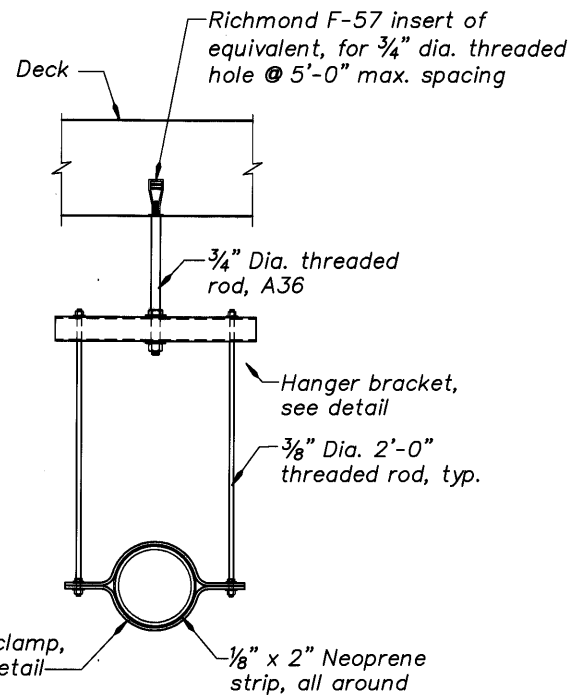

**HANGER BRACKET DETAIL**

Scale : 3" = 1'-0"

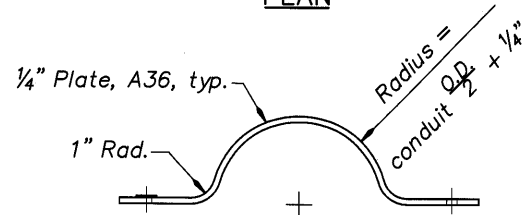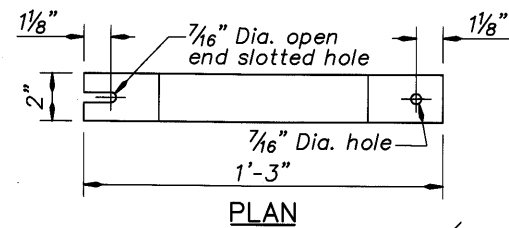


**PIPE CLAMP DETAIL**

Scale : 3" = 1'-0"

- Notes:**
1. Provide nuts and washers for carbon steel fasteners per section 00560 of the Standard Specifications.
  2. All components and hardware are to be hot-dipped galvanized.
  3. Use hanger system shown or approved equal.
  4. Conduit hangers need to maintain a minimum of 3'-0" from the face of the utility hole opening and shall be spaced a maximum of 5'-0"

**CONDUIT HANGER**

Scale : 1 1/2" = 1'-0"

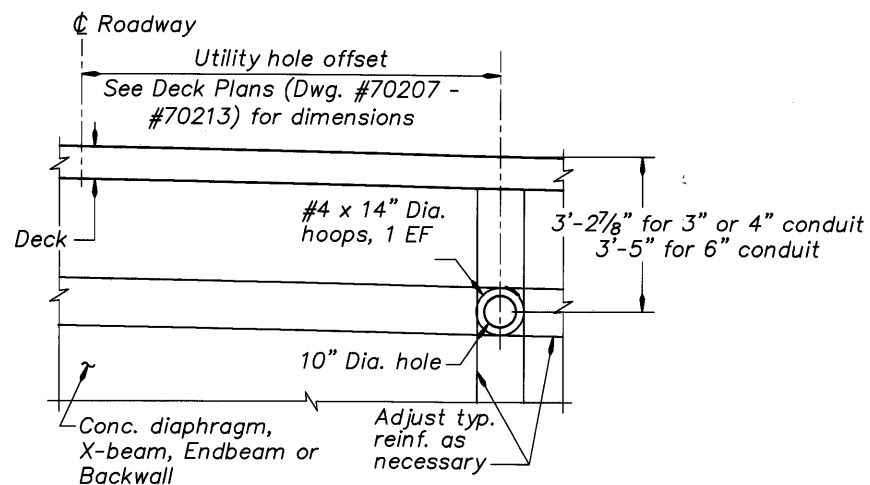


**CONDUIT UTILITY HOLE DETAIL**

No Scale


DO NOT SCALE THIS DRAWING. FOLLOW DIMENSIONS. INDICATED SCALES CORRECT ONLY FOR FULL SIZE SHEET (22"x34").

	DATE	REVISION	BY	J. Patton/R. Elwood DRAFTED: Joel Tubbs CHECKED: Eric Rau REVIEWED:		DAVID EVANS AND ASSOCIATES INC. 530 Center Street N.E., Suite 605 Salem Oregon 97301 Phone: 503.361.8635	MULTNOMAH COUNTY BRIDGES TRANSPORTATION DIVISION	BRIDGE NO.	MULTNOMAH CHANNEL & PNWR ETC., SAUVIE ISLAND RD.	SHEET
	03/09	As-Constructed	TDF					20136		172 OF 173
								DATE		DRAWING NO.
							OREGON DEPARTMENT OF TRANSPORTATION BRIDGE ENGINEERING SECTION	Sept. 2005 CALC. BOOK	MISCELLANEOUS DETAILS (1 OF 2) 70360	

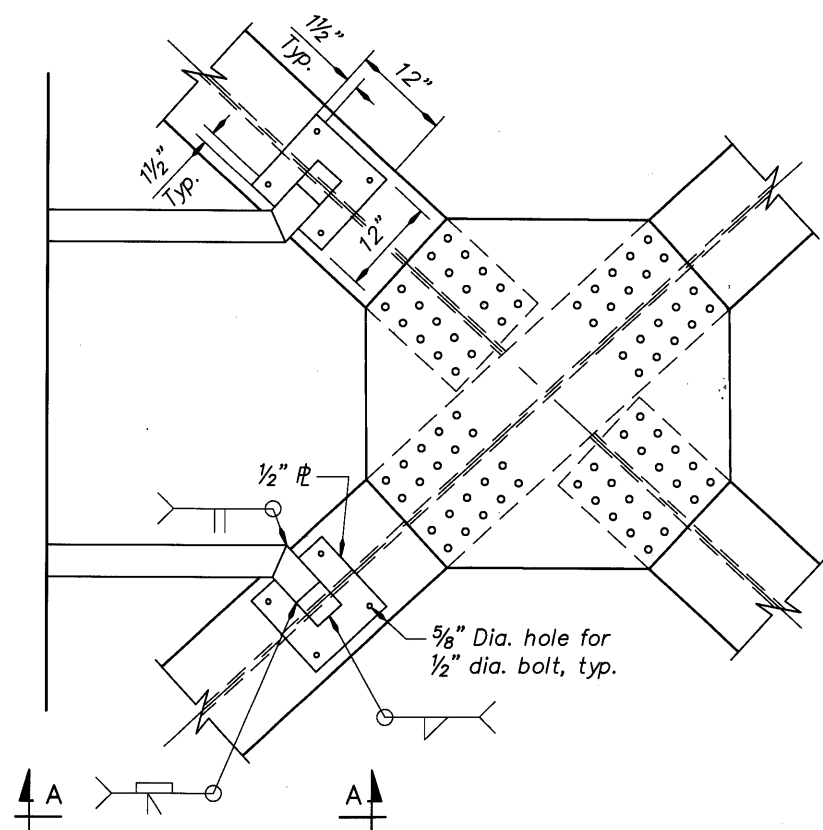

**SIGN #14 MOUNTING BRACKET**

Scale : 1" = 1'-0"

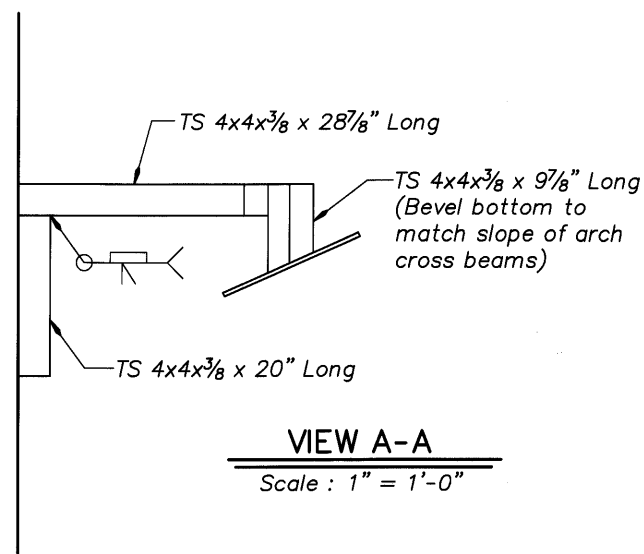

**VIEW A-A**

Scale : 1" = 1'-0"

DO NOT SCALE THIS DRAWING.  
FOLLOW DIMENSIONS. INDICATED  
SCALES CORRECT ONLY FOR  
FULL SIZE SHEET (22"x34").

DATE	REVISION	BY
03/09	As-Constructed	TDF

DESIGNED BY	J. Patton / R. Elwood
DRAFTED BY	Joel Tubbs
CHECKED BY	Eric Rau
REVIEWED BY	

**DESIGNER**

REGISTERED PROFESSIONAL ENGINEER  
70783  
RICHARD J. KING  
JULY 8, 2003  
EXPIRES: 6-30-07

**DAVID EVANS AND ASSOCIATES INC.**  
530 Center Street N.E., Suite 605  
Salem Oregon 97301  
Phone: 503.361.8635

CONNECTING COMMERCE AND COMMUNITY

**MULTNOMAH COUNTY BRIDGES**


TRANSPORTATION DIVISION

**OREGON DEPARTMENT OF TRANSPORTATION BRIDGE ENGINEERING SECTION**

BRIDGE NO.	20136
DATE	Sept. 2005
CALC. BOOK	

MULTNOMAH CHANNEL & PNWR ETC., SAUVIE ISLAND RD.
MISCELLANEOUS DETAILS (2 OF 2)


SHEET	173
OF	173
DRAWING NO.	70361

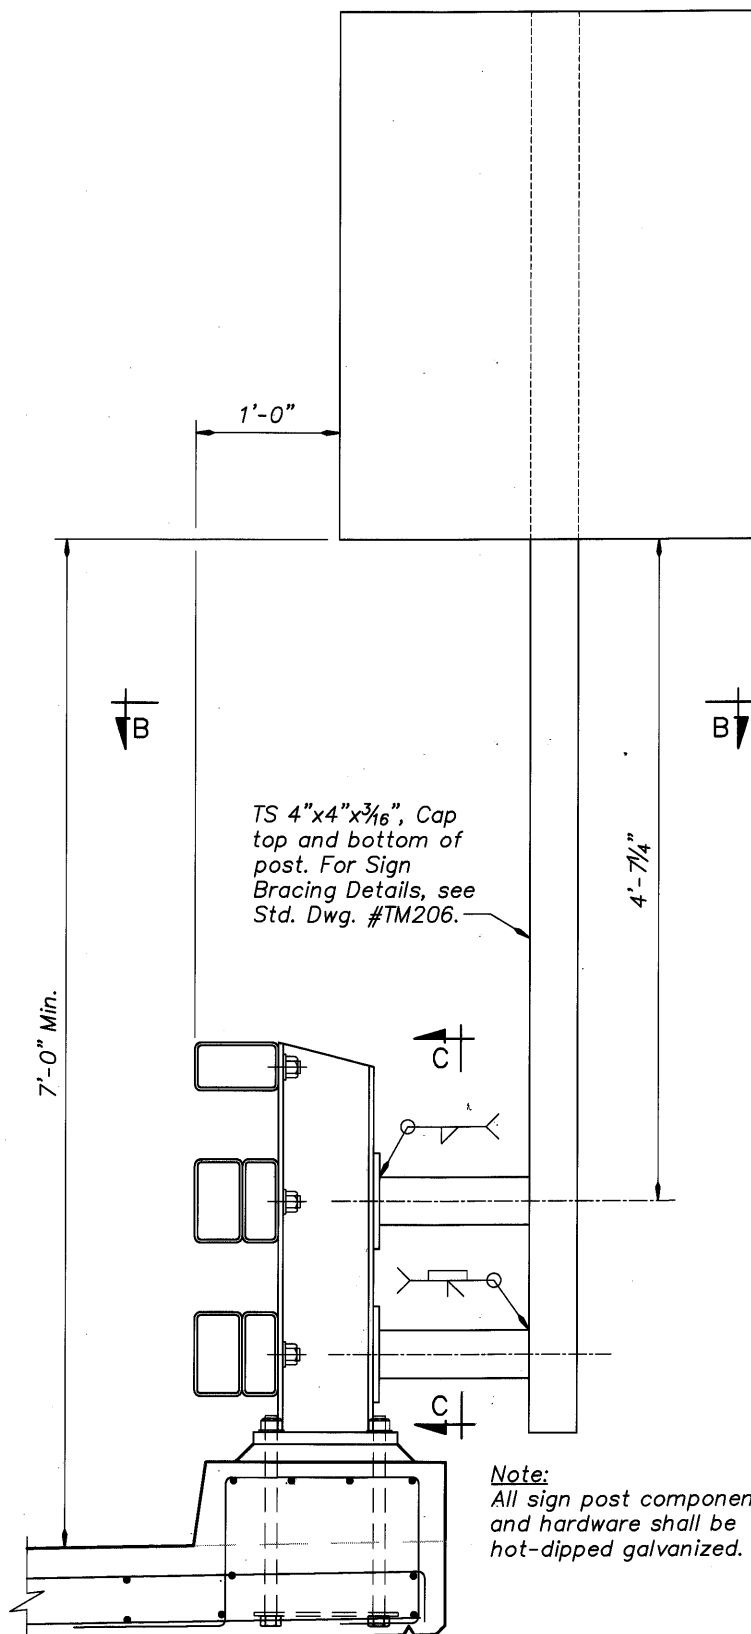

**SIGN #10, #18, #22, #25, #40, and #41 MOUNTING BRACKET**


Scale : 1/2" = 1'-0"

Note:  
All sign post components and hardware shall be hot-dipped galvanized.

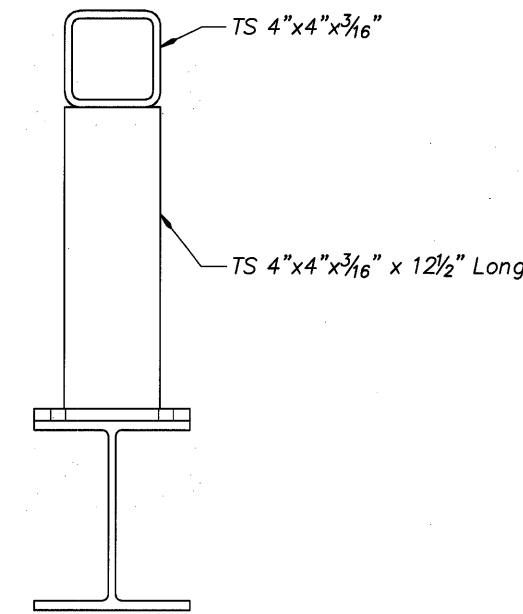









**SECTION B-B**

Scale : 3" = 1'-0"

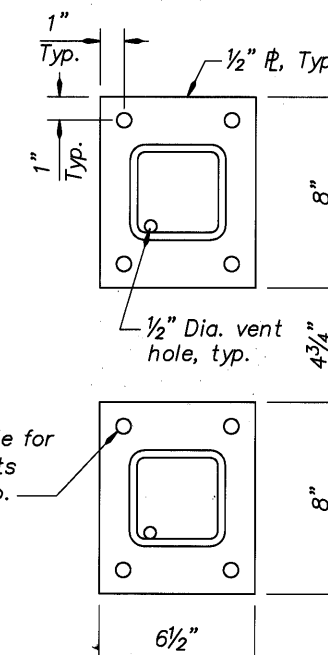

**SECTION C-C**

Scale : 3" = 1'-0"

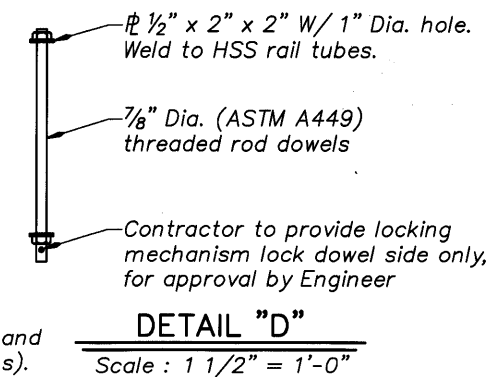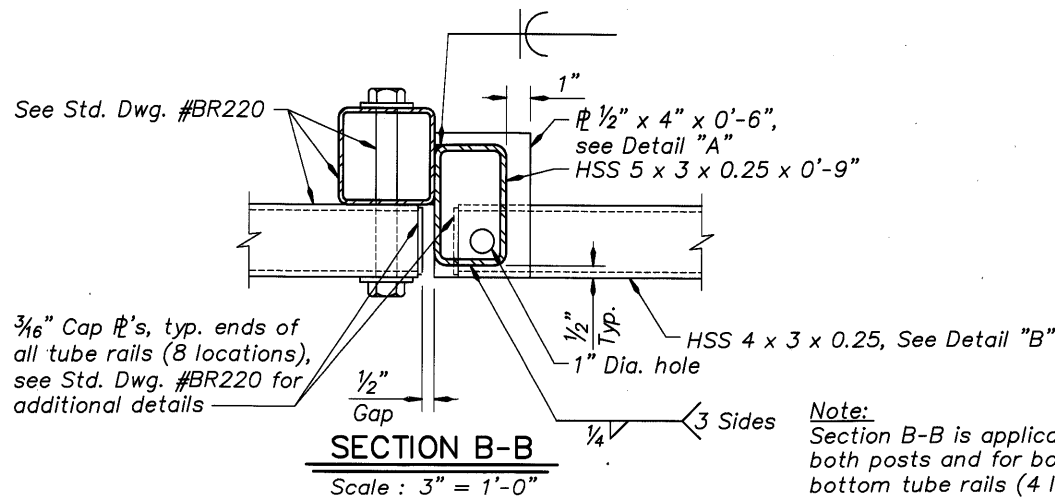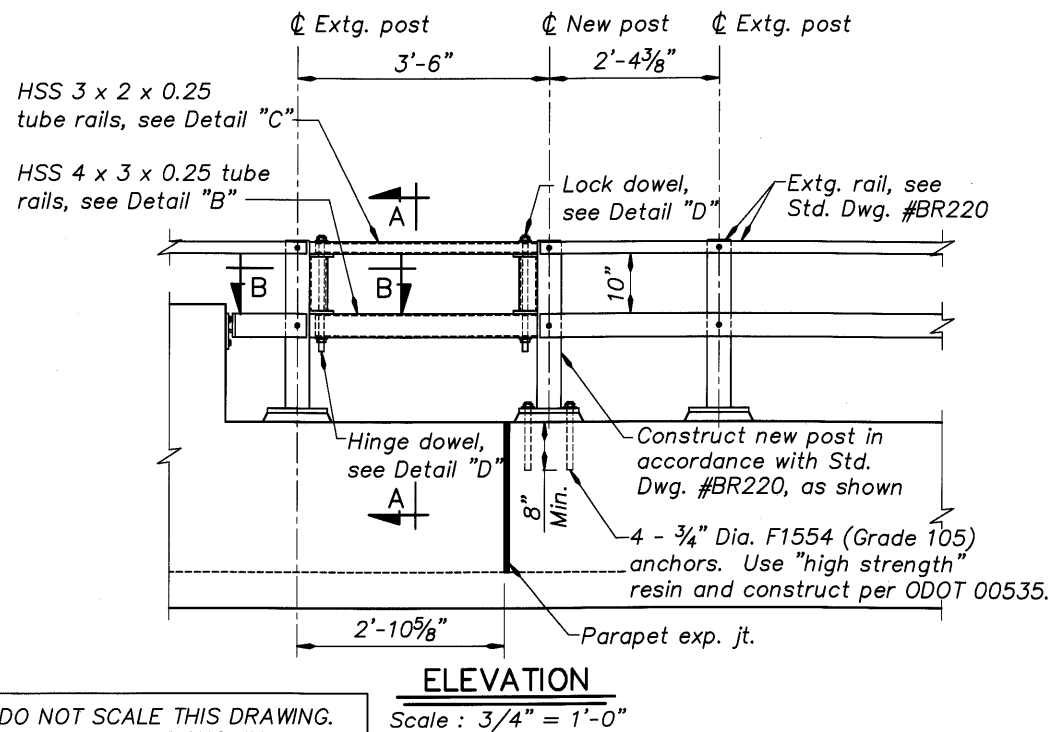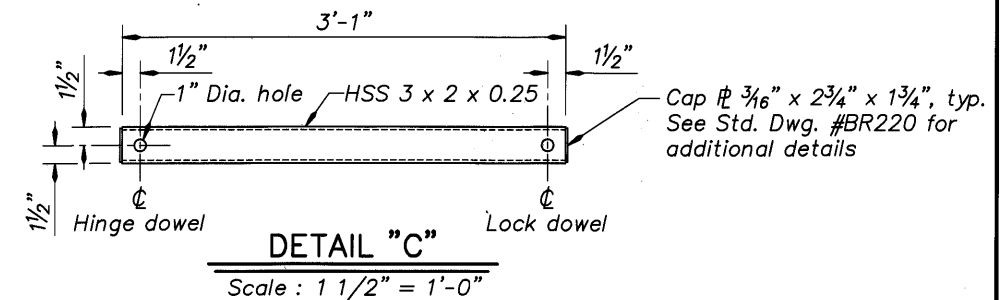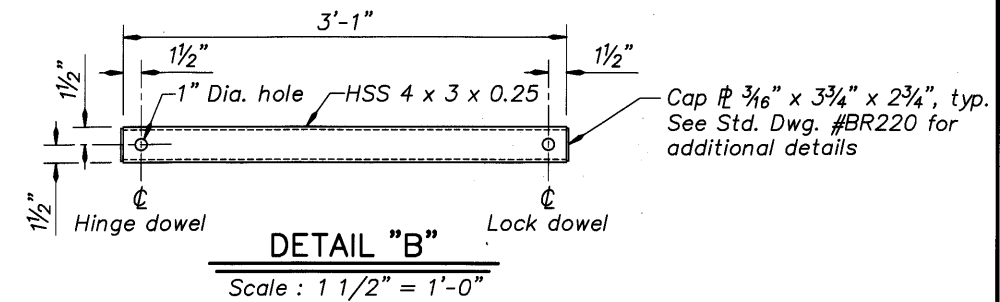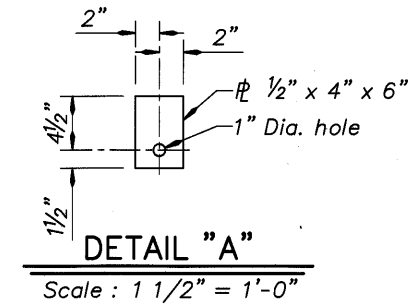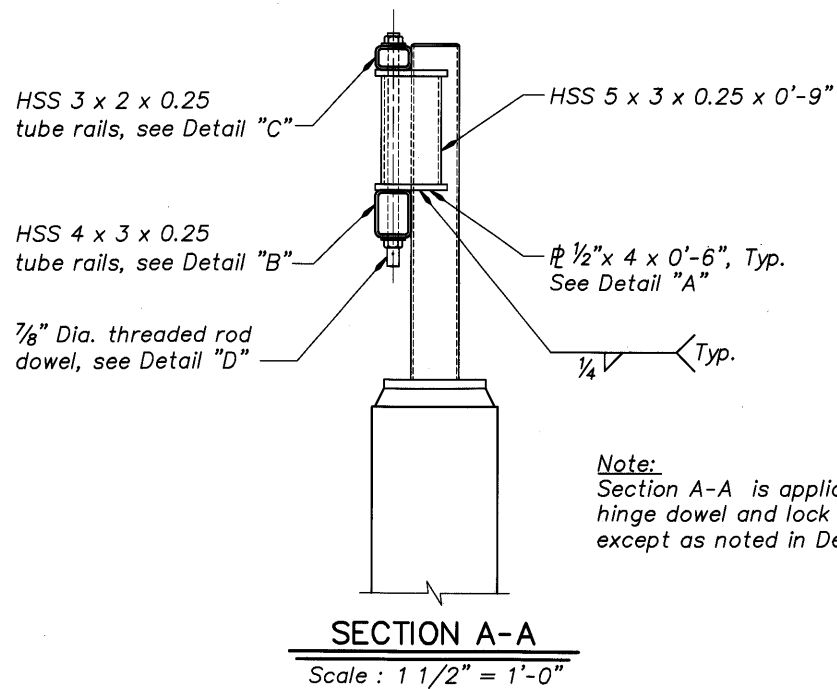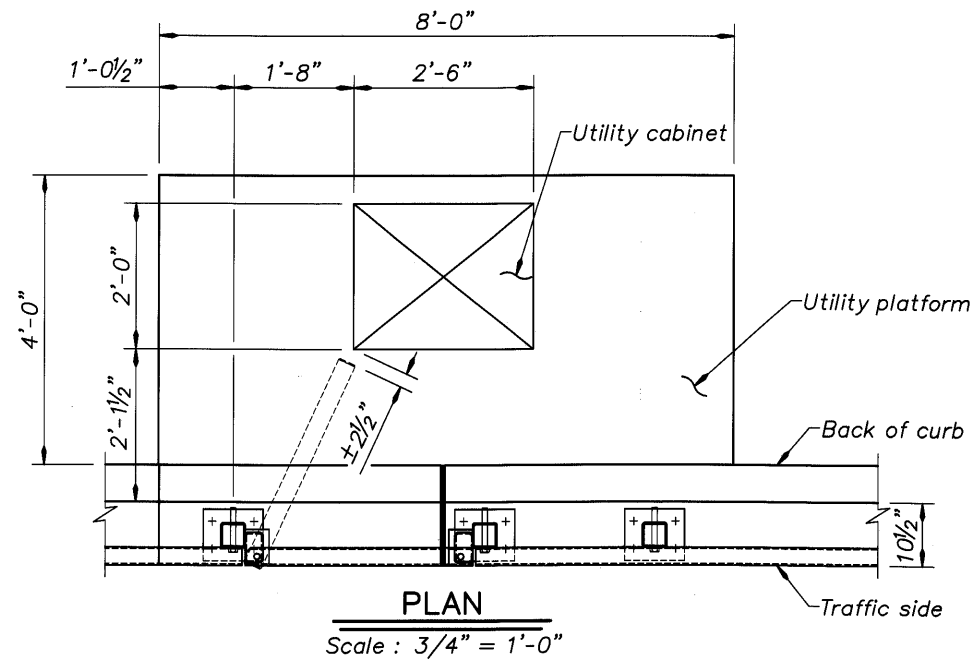

**Notes:**  
Contractor to field verify as constructed geometry prior to fabrication.  
See Std. Dwg. #BR220 for additional details not shown.  
Conform to the General Notes on Std. Dwg. #BR220.  
See Dwg. #70297 for location of Utility Access Gate.

**Note:**  
Section A-A is applicable to both hinge dowel and lock dowel posts, except as noted in Detail "D".

Cap  $\phi \frac{3}{16}$ " x  $2\frac{3}{4}$ " x  $2\frac{3}{4}$ ", typ. See Std. Dwg. #BR220 for additional details

Cap  $\phi \frac{3}{16}$ " x  $2\frac{3}{4}$ " x  $1\frac{3}{4}$ ", typ. See Std. Dwg. #BR220 for additional details

See Std. Dwg. #BR220  
 $\frac{3}{16}$ " Cap  $\phi$ 's, typ. ends of all tube rails (8 locations), see Std. Dwg. #BR220 for additional details

**Note:**  
Section B-B is applicable to both posts and for both top and bottom tube rails (4 locations).

Contractor to provide locking mechanism lock dowel side only, for approval by Engineer

DO NOT SCALE THIS DRAWING. FOLLOW DIMENSIONS. INDICATED SCALES CORRECT ONLY FOR FULL SIZE SHEET (22"x34").

DATE	03/09	REVISION	As-Constructed	BY	R. Stone	DESIGNER	 DAVID EVANS AND ASSOCIATES INC. 530 Center Street N.E., Suite 605 Salem Oregon 97301 Phone: 503.361.8635	BRIDGE NO.	20136	SHEET	1
					CHECKER: Eric Rau	 MULTNOMAH COUNTY BRIDGES	TRANSPORTATION DIVISION  OREGON DEPARTMENT OF TRANSPORTATION BRIDGE ENGINEERING SECTION	DATE	Mar. 2009	DRAWING NO.	81927
				CHECKER: Ken Stoneman	REVIEWER: Ken Stoneman			EXPIRES: 6/30/2010	CALC. BOOK		MULTNOMAH CHANNEL & PNWR ETC., SAUVIE ISLAND RD.