


| | | | | |
|--------|---------------------|------|-----------|--------------|
| STATE | PROJECT DESIGNATION | YEAR | SHEET NO. | TOTAL SHEETS |
| ALASKA | B-0003 (21) | 1991 | 2 | 9 |

HORIZONTAL AND VERTICAL CONTROL


The basis of bearing is S26°04'29"E between control points P5 (a PK nail & washer @ E of Rdwy @ Abutment No. 1 to the existing bridge) and P10, OLD Station 3+00 (a PK nail @ E Rdwy @ South abutment of the existing bridge.) The basis of vertical control is located at P5, OLD Station 1+32 with an elevation of 16.815' M.L.L.W.

SUPPLIER INCREASES DOUBLE TEE DEPTH ON ENDS BY 2" - WASN'T DISCOVERED PRIOR TO PILE CUTOFF AND BRACKETS BEING WELDED ON PILES - ROAD AND WALKWAY ADJUSTED TO CHANGE

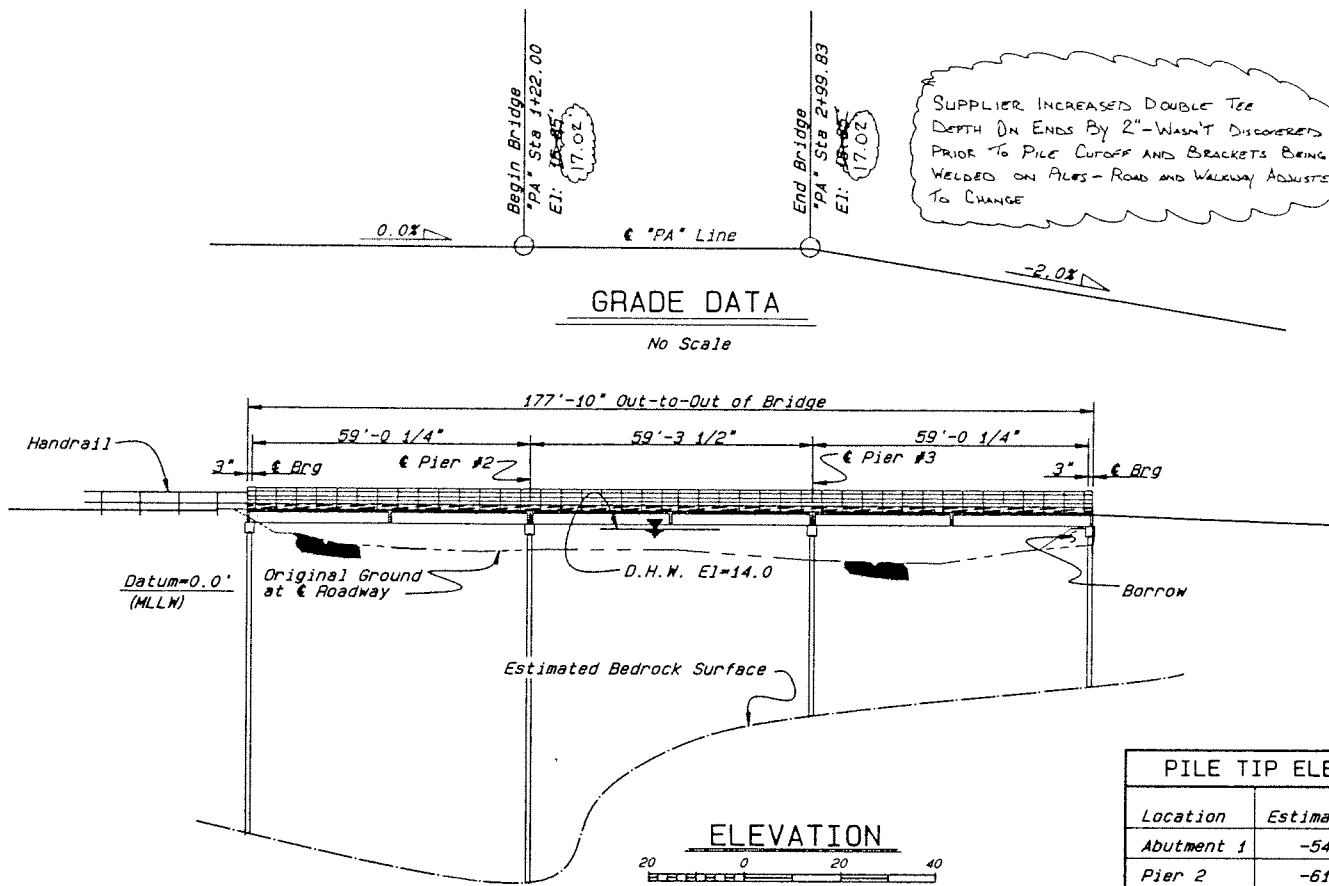


PILE TIP ELEVATIONS

| Location | Estimated | Minimum Desirable |
|------------|-----------|-------------------|
| Abutment 1 | -54 | -10 |
| Pier 2 | -61 | -15 |
| Pier 3 | -24 | -15 |
| Abutment 4 | -23 | -10 |

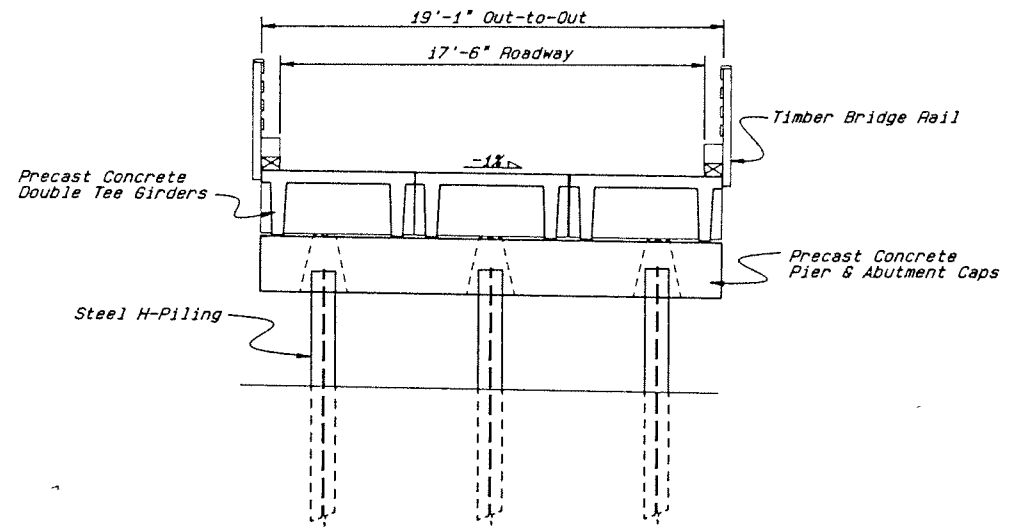

Bedrock profile is extremely variable. Elevations dip East to West (Upstream to Downstream). See test holes and penetrometer logs.
AS BUILT: SEE PILE DRIVING LOGS

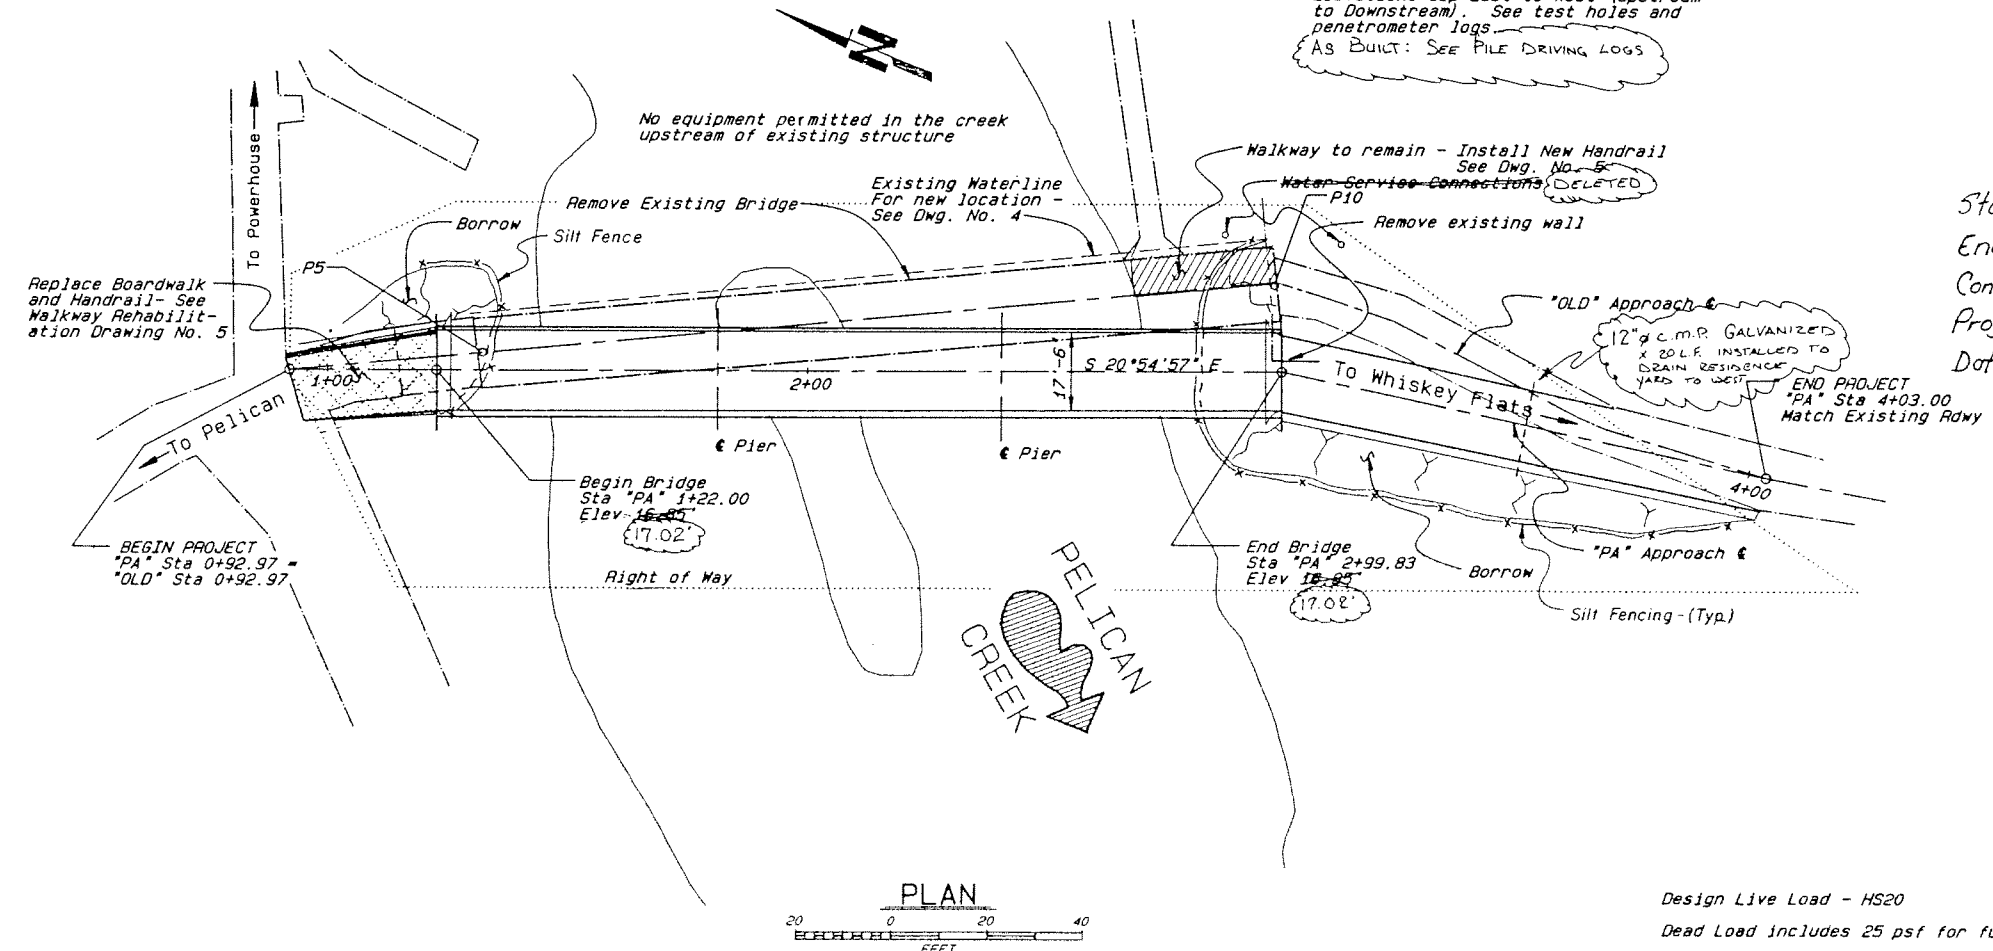

Start: July 7, 1992
End: August 21, 1992
Contractor: Trucano Construction Co.
Project Engineer: Mark Halverson
Date: September, 1992

AS BUILT PLANS

| | |
|-------------------------|-----------------|
| MARK HALVORSEN | Date SEPT. 1992 |
| Project Engineer | |
| CORRECTIONS TRANSFERRED | |
| Tracings S.H. SOLLE JR. | Date 9/16/92 |
| Checked G.J.W. | Date 12/11/92 |

DRAWING INDEX

| TITLE | Dwg No |
|-----------------------------|--------|
| GENERAL LAYOUT | 1 |
| SITE PLAN | 2 |
| PIER AND ABUTMENT CAP | 3 |
| SUPERSTRUCTURE DETAILS | 4 |
| WALKWAY REHABILITATION | 5 |
| TEST HOLE LOGS AND LOCATION | 6-7 |

Plans prepared under my direct supervision.



Design Live Load - HS20
Dead Load includes 25 psf for future paving

10/30/91
Lush/mkhn/1491/01
9/20/91 Rev. 10/25/91
Scale = 25
Drawn By: MCH

STATE OF ALASKA
DEPARTMENT OF TRANSPORTATION
and PUBLIC FACILITIES
Juneau, Alaska

PELICAN CREEK
SALMON WAY, PELICAN ALASKA
GENERAL LAYOUT

BRIDGE NO. 1491
DWG. NO. 1

GENERAL NOTES

SPECIFICATIONS

Design: AASHTO Standard Specifications for Highway Bridges, 1989 Edition, with the latest Interim Specifications.

Construction: State of Alaska Standard Specifications for Highway Construction, 1988, with Standard Modifications and the Special Provisions.

Live Load: HS 20

Dead Load: Includes 25 psf for future paving.

DESIGN UNIT STRESSES

Prestressed Concrete: See Girder Details

Structural Steel: A36: F_y = 36,000 psi
F_s = 20,000 psi

Reinforced Concrete: Class A: f'_c = 4,000 psi
f_c = 1,600 psi
F_y = 60,000 psi

STRUCTURAL MATERIALS

Concrete: All cast-in-place concrete shall be Class AA.



Reinforcing Steel: All reinforcing steel shall conform to ASTM 615 Grade 60.

Structural Steel: All structural steel shall be ASTM A36 unless otherwise noted. All railing fasteners shall be galvanized.

Piling: All structural steel piles shall be HP12x74 (ASTM A572). Pile tip reinforcing shall be as shown.

Timber: See special provisions.

Design Capacity: 50 Tons - Piers
35 Tons - Abutments

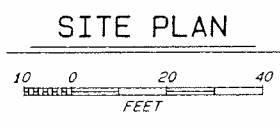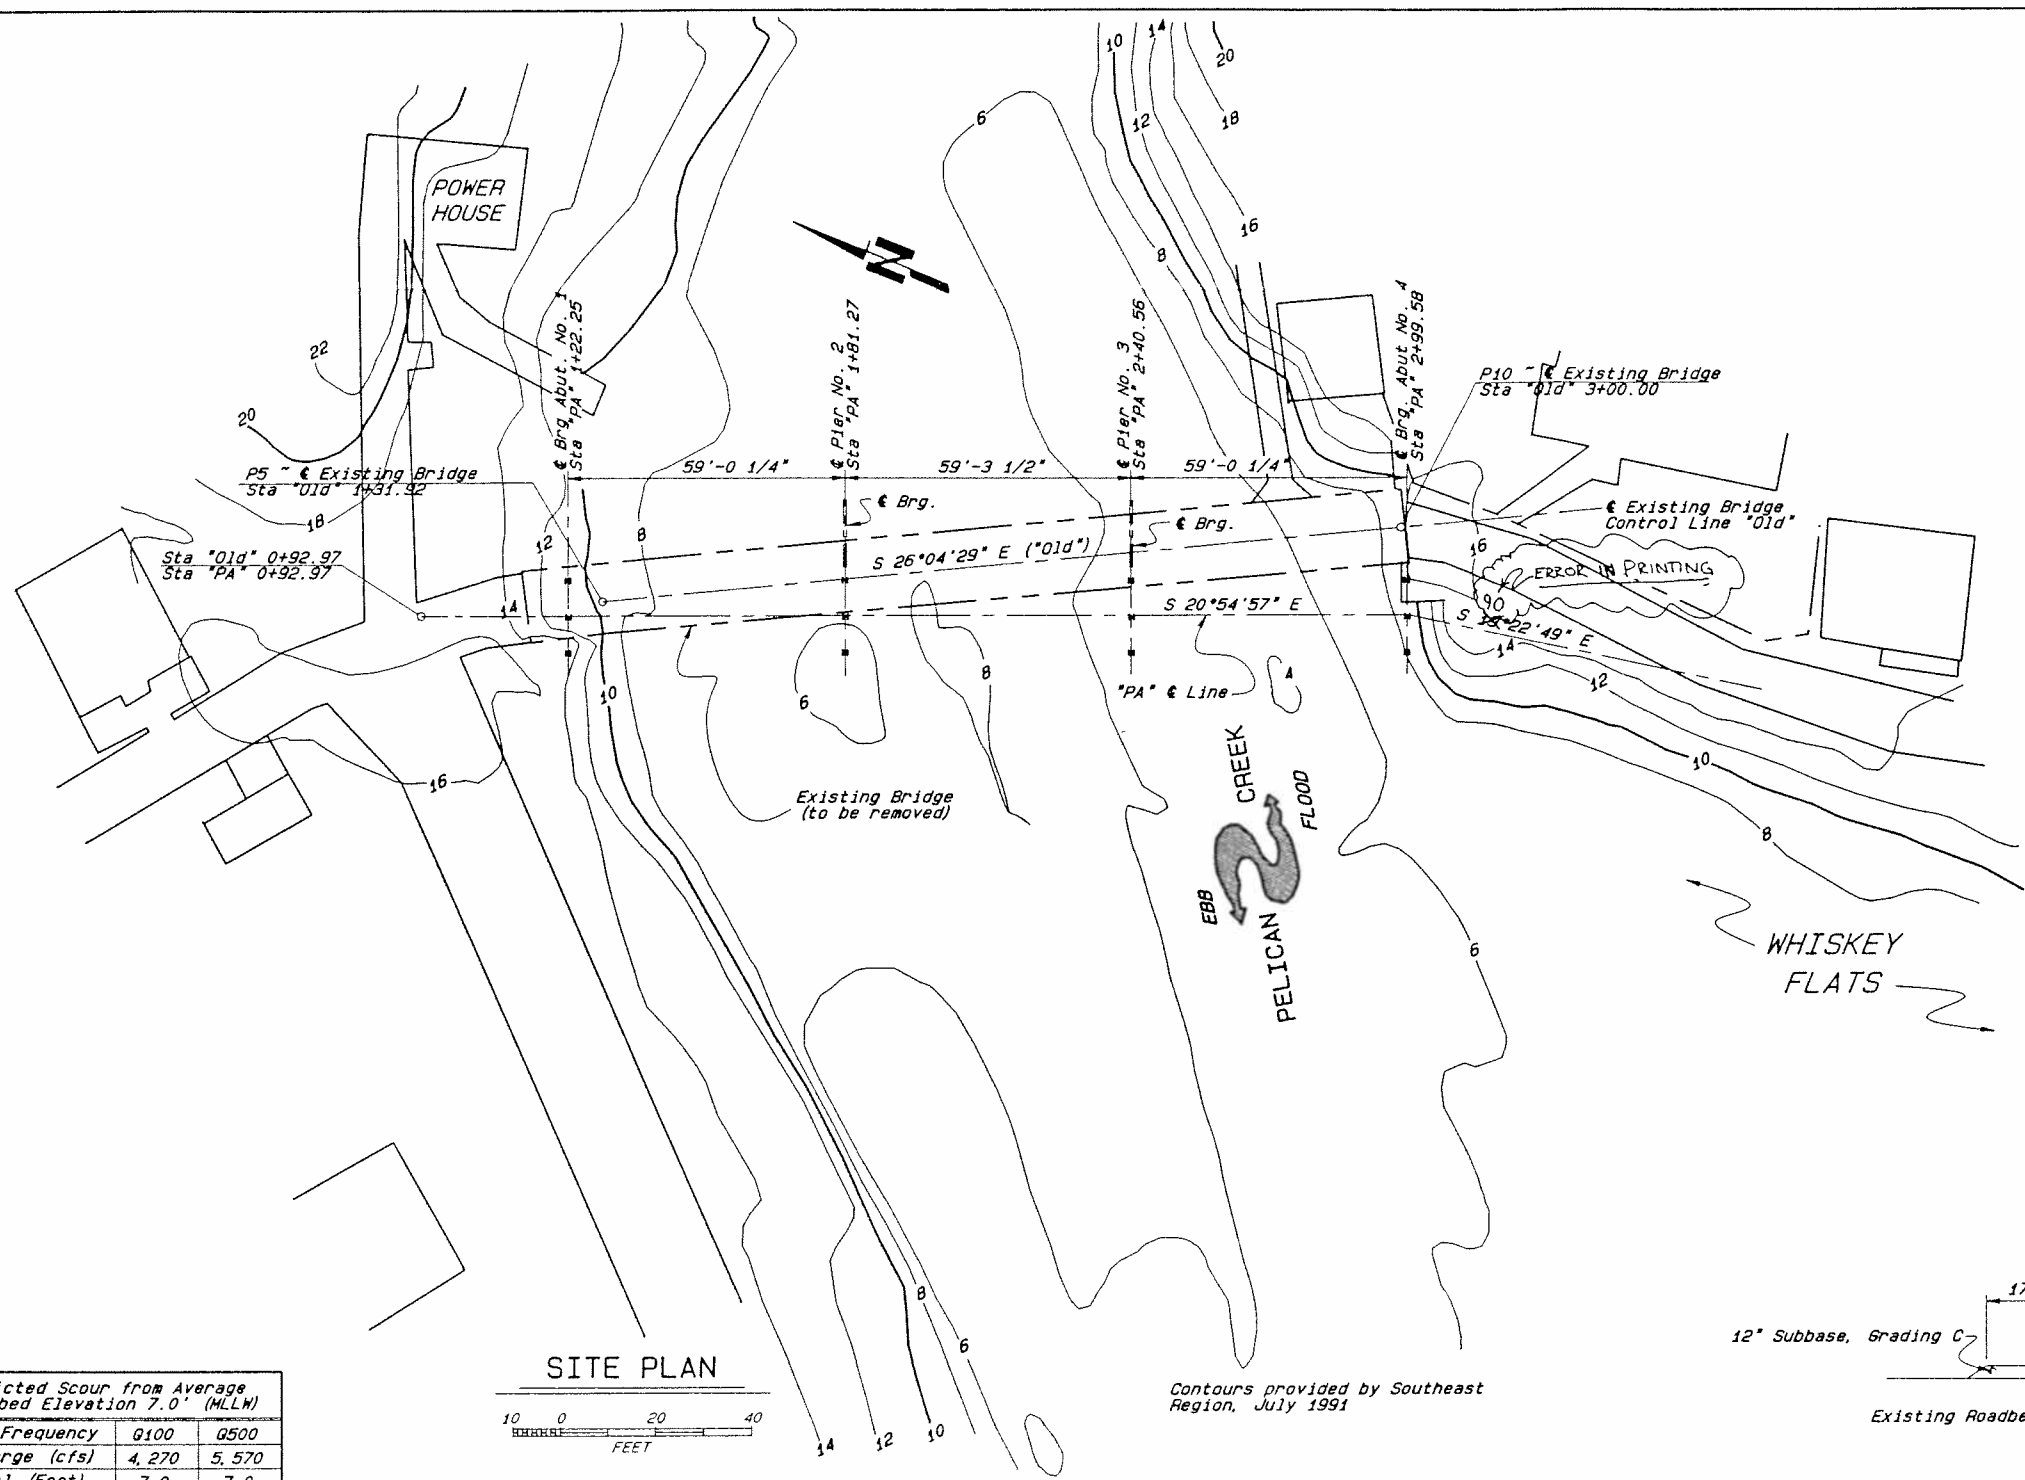

Contours provided by Southeast Region, July 1991

| Flood Frequency | Q100 | Q500 |
|-----------------|-------|-------|
| Discharge (cfs) | 4,270 | 5,570 |
| General (Feet) | 7.0 | 7.0 |
| Pier (Feet) | 0.0 | -1.0 |
| Abutment (Feet) | 5.0 | 5.0 |


tum = Mean Lower Low Water (MLLW) = 0 Feet = 5.5 Feet Mean Sea Level (MSL)

| Design Flood Frequency | Q50 | Q100 | Design Flood* |
|-----------------------------|-------|-------|---------------|
| Exceedance Probability | 1% | .2% | N/A |
| Drainage Area (Sq. Mi.) | 13.2 | 13.2 | 13.2 |
| Design Discharge (cfs) | 3,870 | 4,270 | 5,570 |
| Design Highwater Elev. (ft) | 9.9 | 10.1 | 14.5 |
| Added Anticipated Backwater | 0 | 0 | 0 |

hydraulic Capacity: 16,300 cfs at Elevation 14.0 which has an exceedance probability equal to or less than .2% (Q500).


Bridge is sized to accommodate an anticipated storm of El: 14.5 ft. (MLLW) which has exceedance probability equal to or less than 1% (Q100) and to accommodate a Pelican Creek Hydro Dam failure event of 5,570 cfs which has an exceedance probability of approximately .2% (Q500).

| Item No. | Item | Unit | Substruct. | Superstr. | Total |
|----------|--|----------|------------|-----------|-----------|
| 120 (1) | DBE Adjustment | C.S. | | | All Req'd |
| 202 (1) | Removal of Structures and Obstructions | L.S. | | | All Req'd |
| 203 (7) | Borrow, Type "D" | C.Y.V.M. | | | 240360 |
| 304 (3) | Subbase, Grading C | C.Y.V.M. | | | 80198 |
| 502 (1) | Prestressed Concrete Structural Member (58'-9" Double-Tee) | EACH | | 9 | 9 |
| 502 (2) | Precast Concrete Caps | EACH | | 4 | 4 |
| 505 (5) | Structural Steel Piling Furnished | L.F. | | 555 | 555 |
| 505 (6) | Structural Steel Piling Driven | EACH | | 12 | 12 |
| 507 (3) | Timber Bridge Railing | L.F. | | 356 | 356 |
| 618 (1) | Hand Seeding | S.F. | | 3000 | 3670 |
| 627 (8) | Water Service Connection | EACH | | | 02 |
| 627 (11) | Waterline Relocation | L.S. | | | All Req'd |
| 640 (1) | Mobilization and Demobilization | L.S. | | | All Req'd |
| 641 (1) | Temporary Erosion and Pollution Control | C.S. | | | All Req'd |
| 641 (2) | Silt Fence | L.F. | | | 280 |
| 642 (1) | Construction Surveying | L.S. | | | All Req'd |
| 644 (1) | Field Office | L.S. | | | All Req'd |

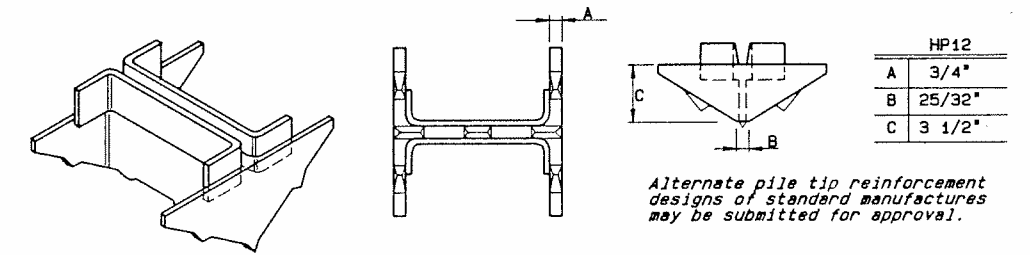

PILE TIP REINFORCEMENT


No Scale

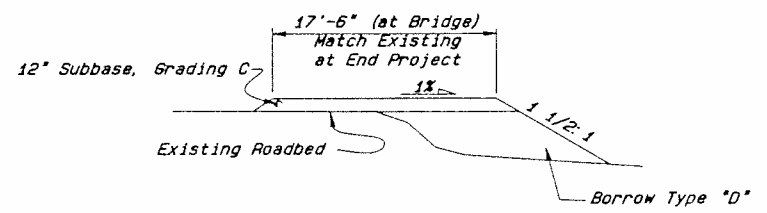

WHISKEY FLATS TYPICAL SECTION

Sta. "PA" 2+93.30 (+)



Plans prepared under my direct supervision.

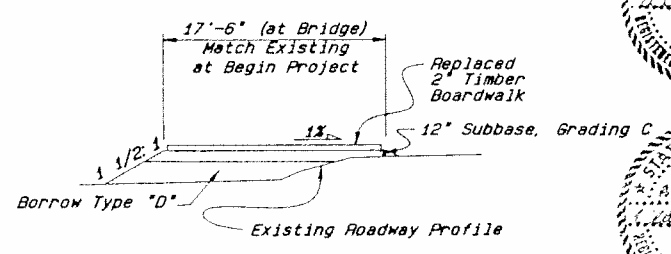

BOARDWALK TYPICAL SECTION

Sta. "PA" 1+15.47 (-)

| AS BUILT PLANS | |
|-------------------------|----------------|
| MARK HALVORSEN | Date SEPT 1992 |
| Project Engineer | |
| CORRECTIONS TRANSFERRED | |
| Tracings S.H. SOLLIE JR | Date 9/1/92 |
| Checked G.J.W. | Date 12/1/92 |

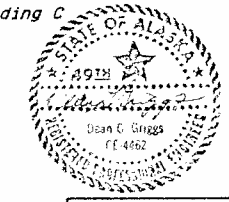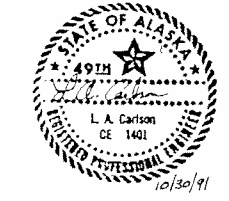

PELICAN CREEK
SALMON WAY, PELICAN ALASKA



SITE PLAN

State of Alaska
DEPARTMENT OF TRANSPORTATION
and PUBLIC FACILITIES
Juneau, Alaska



BRIDGE NO. 1491
DWG. NO. 2

/s/ Mark Halvorson
9/26/91 Rev. 1/3/92
Scale = 25
Drawn By: MCH

| | | | | |
|--------|---------------------|------|-----------|--------------|
| STATE | PROJECT DESIGNATION | YEAR | SHEET NO. | TOTAL SHEETS |
| ALASKA | B-0003 (21) | 1991 | 4 | 9 |


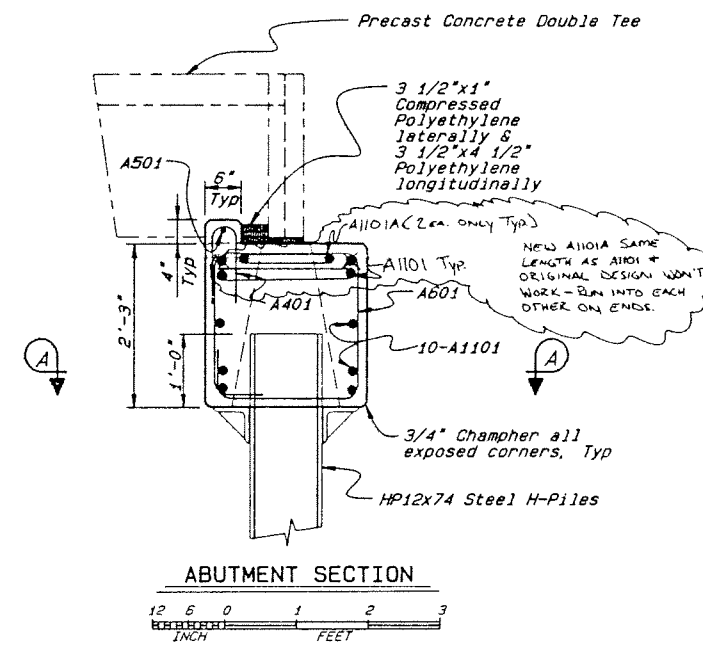
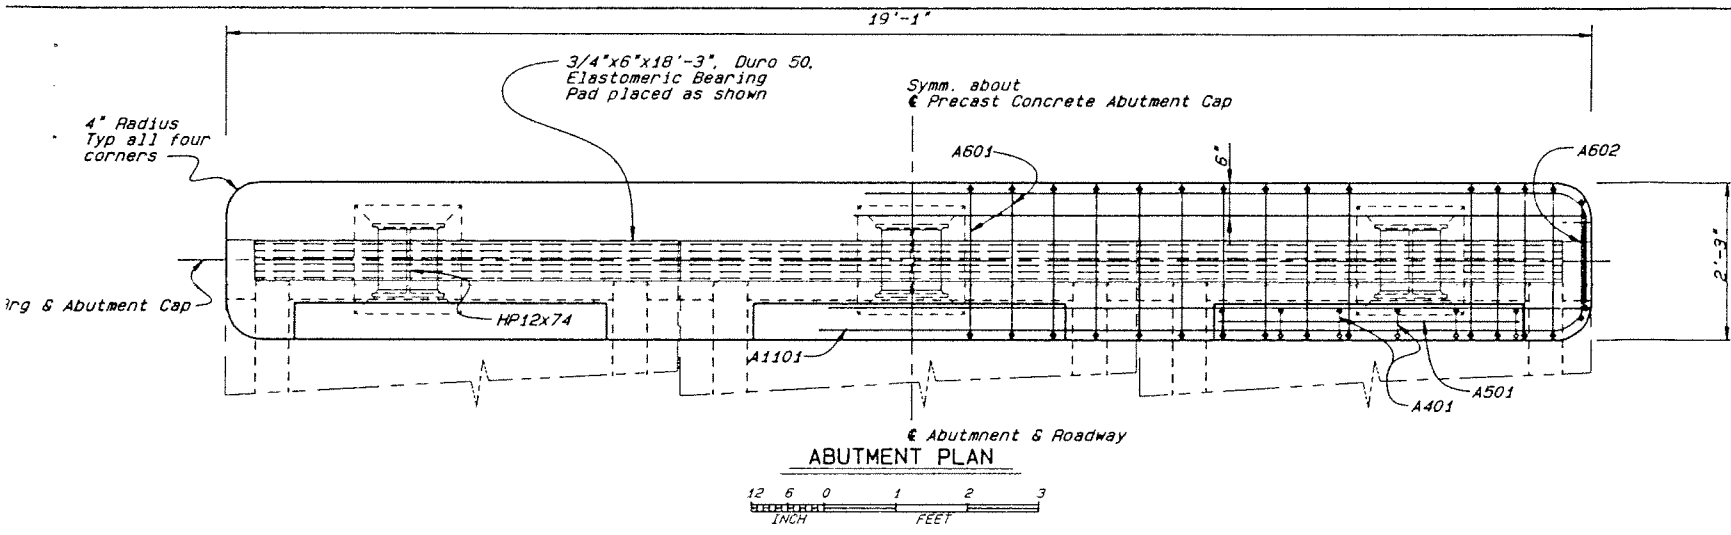


| REINFORCING STEEL (One Abutment) | | | | | |
|----------------------------------|------|-----|--------|------|------------------|
| MARK | SIZE | NO. | LENGTH | TYPE | BENDING DIAGRAMS |
| A401 | 4 | 18 | 2'-2" | Bent | |
| A501 | 5 | 3 | 3'-11" | --- | |
| A601 | 6 | 28 | 9'-1" | Bent | |
| A602 | 6 | 2 | 8'-1" | Bent | |
| A1101 | 11 | 10 | 21'-9" | Bent | |
| | | | | | |

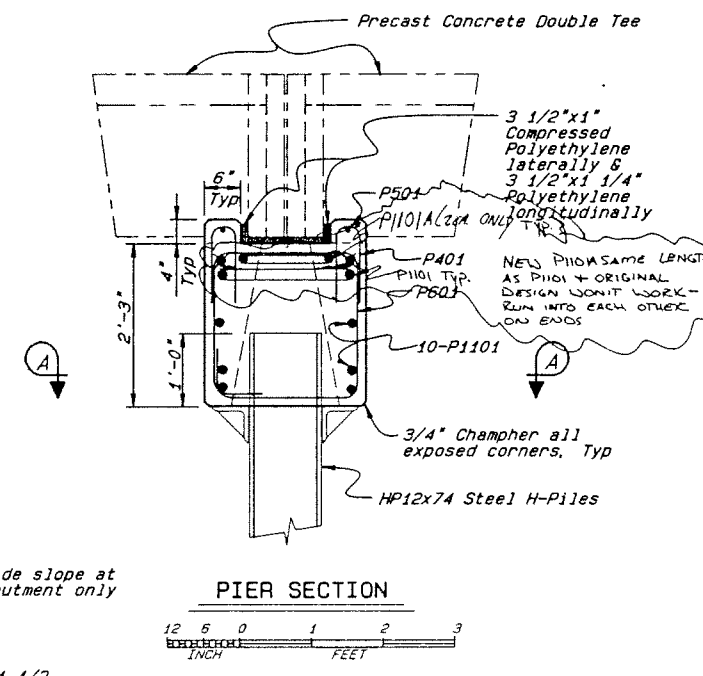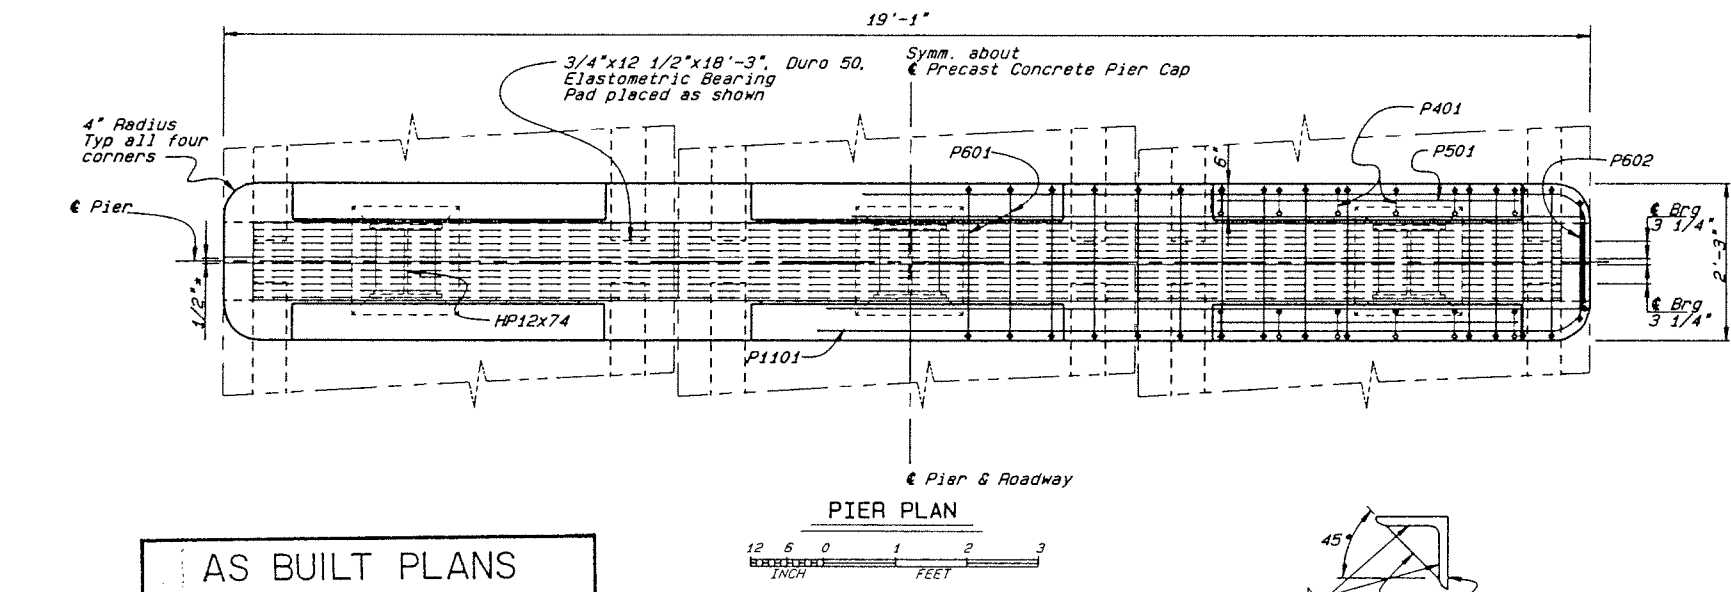


| REINFORCING STEEL (One Pier) | | | | | |
|------------------------------|------|-----|--------|------|------------------|
| MARK | SIZE | NO. | LENGTH | TYPE | BENDING DIAGRAMS |
| P401 | 4 | 36 | 2'-2" | Bent | |
| P501 | 5 | 6 | 3'-11" | --- | |
| P601 | 6 | 28 | 9'-1" | Bent | |
| P602 | 6 | 2 | 8'-1" | Bent | |
| P1101 | 11 | 10 | 21'-9" | Bent | |
| | | | | | |

AS BUILT PLANS
 MARK HALVORSEN Date SEPT 1992
 Project Engineer
 CORRECTIONS TRANSFERRED
 Tracings S.H. SOLUS JR Date 9/16/92
 Checked G.J.W. Date 12/11/92

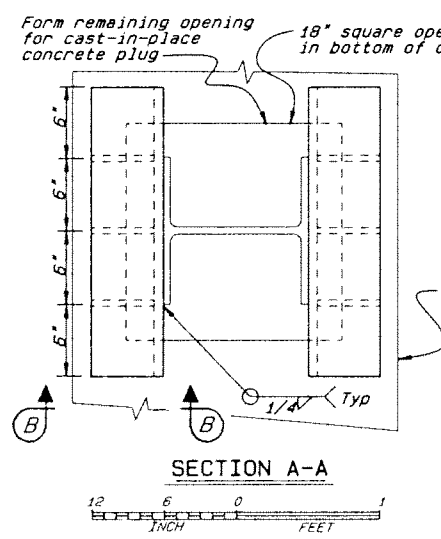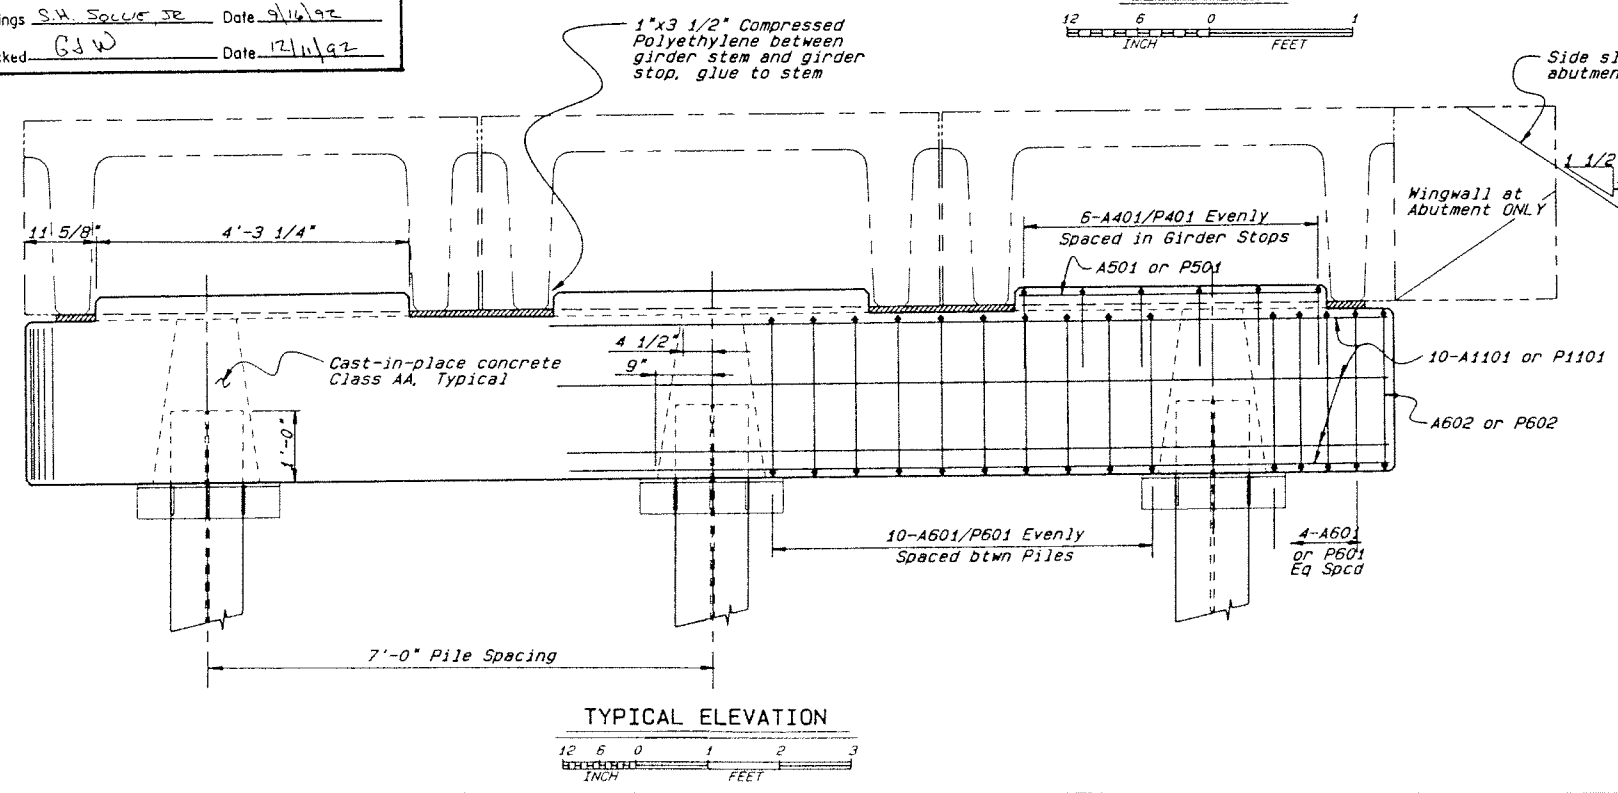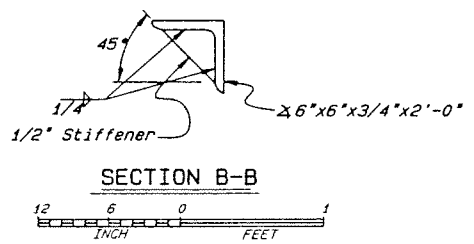

NOTE: Epoxy coat all reinforcing steel.

Plans prepared under my direct supervision.

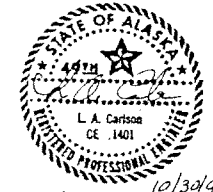

PELICAN CREEK BRIDGE
 SALMON WAY, PELICAN ALASKA
 PIER AND ABUTMENT CAP



State of Alaska
 DEPARTMENT OF TRANSPORTATION
 and PUBLIC FACILITIES
 Juneau, Alaska



BRIDGE NO. 1491
 DWG. NO. 3

10/30/91
 Scale = 25
 Drawn By: MCH

| | | | | |
|--------|---------------------|------|-----------|--------------|
| STATE | PROJECT DESIGNATION | YEAR | SHEET NO. | TOTAL SHEETS |
| ALASKA | B-0003 (21) | 1991 | 5 | 9 |

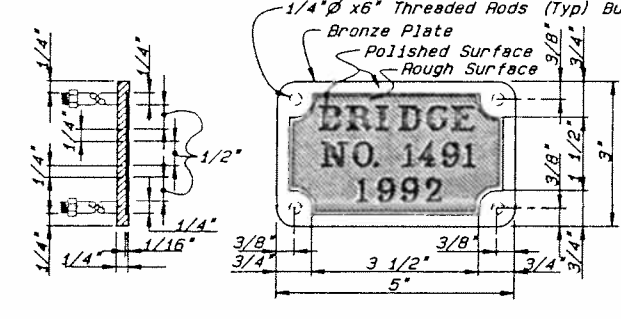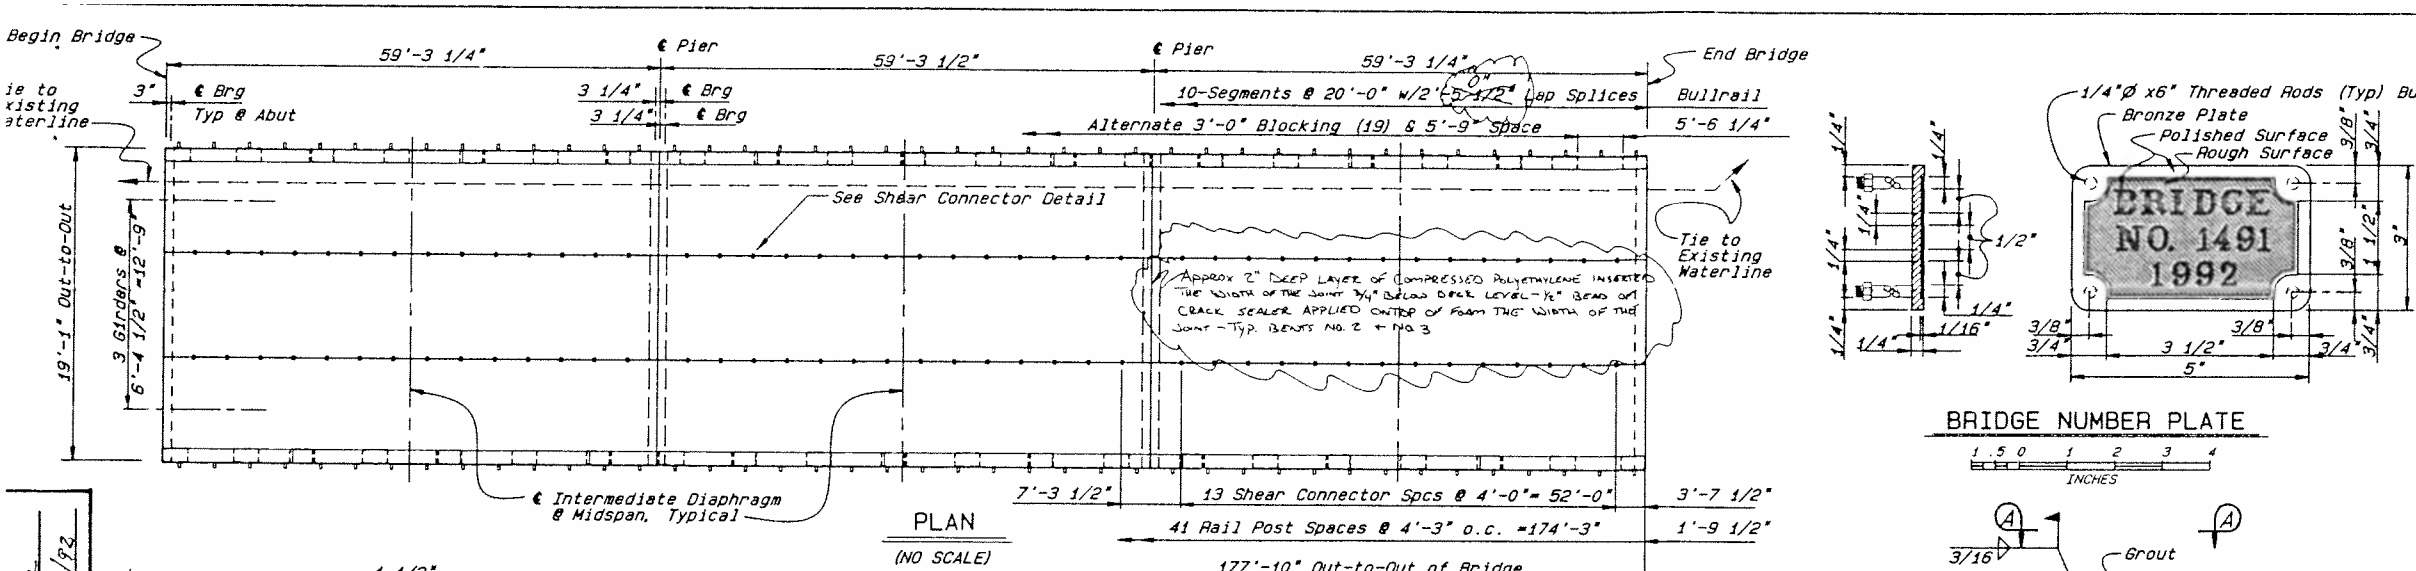




| MARK | SIZE | NO. | LENGTH | TYPE |
|--------|------|-----|--------|------|
| 6301 | 3 | 136 | 5'-11" | Bent |
| 6401 | 4 | 71 | 5'-11" | — |
| 6501 | 5 | 6 | 61'-0" | Bent |
| a 6502 | 5 | 141 | 5'-11" | — |
| 6503 | 5 | 14 | 58'-8" | — |
| b 6504 | 5 | 168 | 2'-1" | Bent |
| D501 | 5 | 48 | 3'-4" | Bent |
| b D502 | 5 | 48 | 3'-0" | Bent |
| D601 | 6 | 12 | 9'-0" | Bent |
| b D602 | 6 | 36 | 2'-0" | — |
| D603 | 6 | 11 | 4'-2" | — |
| D604 | 6 | 6 | 4'-10" | Bent |

6" 6" 30" 1 1/8" Threaded 4" 1'-9" 6504 6401 59'-0" 6501 1'-0" 6'-0" D601 1'-0" D602 D603 D604 3'-7" 1'-6" (D501) 1'-2" (D502) 1'-3" D501 D502

a - No allowances for splices included. Lap Splice Length: 6503= 6504= 19"

b - The total number of bars required per bridge.

NOTE: Epoxy coat all reinforcing.

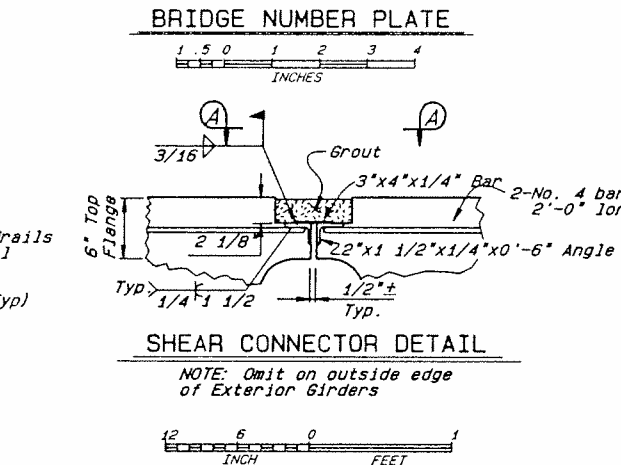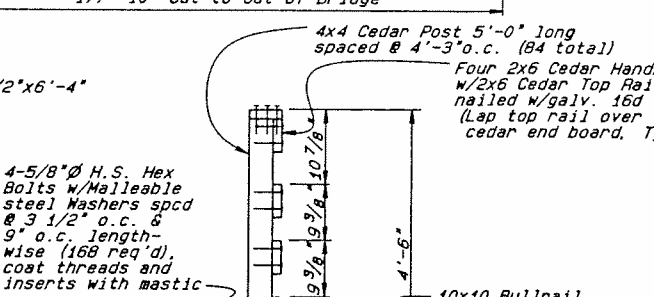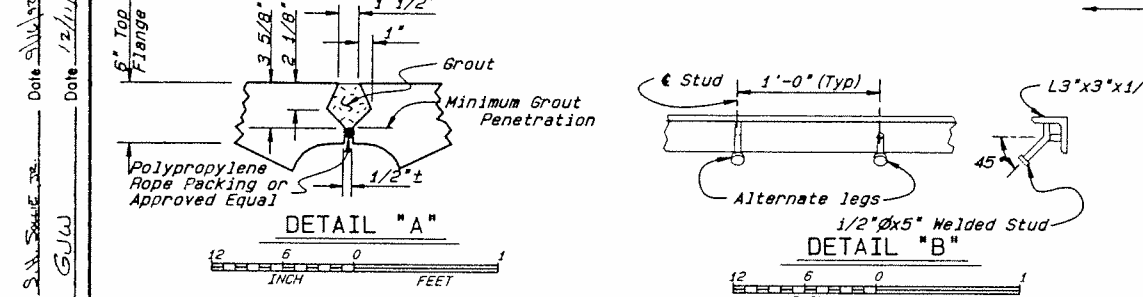

GENERAL NOTES:

Alternate designs are allowed per Section 502 of the Specifications.

Concrete for girders shall be normal weight have the following strengths:
At Stress Transfer $f_c = 5,500$ psi
At 28 days $f_c = 6,500$ psi

All prestressing shall be with 1/2" round strands having an ultimate strength of 270 ksi, and an area of 0.153 sq. in. (strand shall be low relaxation.)

Design is based on the following Steel Stresses (Low Relaxation Strand):
Pretensioning - Jacking Stress 189 ksi
After Losses 149 ksi

One inch clear on all reinforcing except as noted.

All structural steel embedded in girders shall be A36. All structural steel except shear connectors shall be galvanized after fabrication. After installation of shear connector bars, field coat all exposed surfaces of structural steel with epoxy coated patching material (see AASHTO M284).

Approximate girder weight = 55 Kips.








Deflect forms to compensate for camber - see Specifications.

The top surface of precast members shall have a broomed finish.

Girder pay items shall include all epoxy coated reinforcing steel and structural steel as required.

Bridge Number Plate to be furnished by the Contractor. Bronze shall conform to A.S.T.M. B58-90 Alloy "A" or "B". Lettering shall conform to the "Century" type style. Studs and nuts shall conform to UNS C65100 or C65500. Stud to be bronze 1/4" threaded rod brazed to back of plate with bronze nut, burr threads, 4 studs req'd.

Bridge Number Plates shall be paid for incidental to the precast concrete girders.

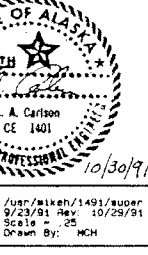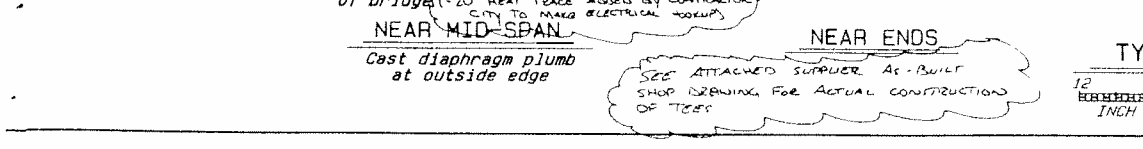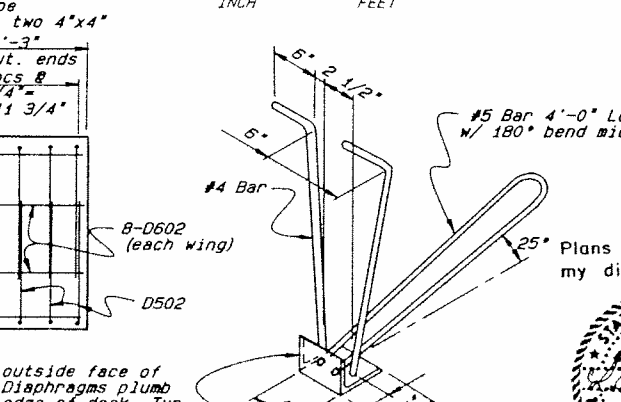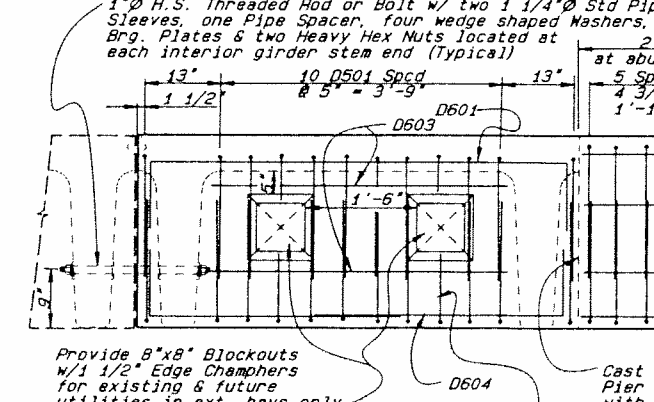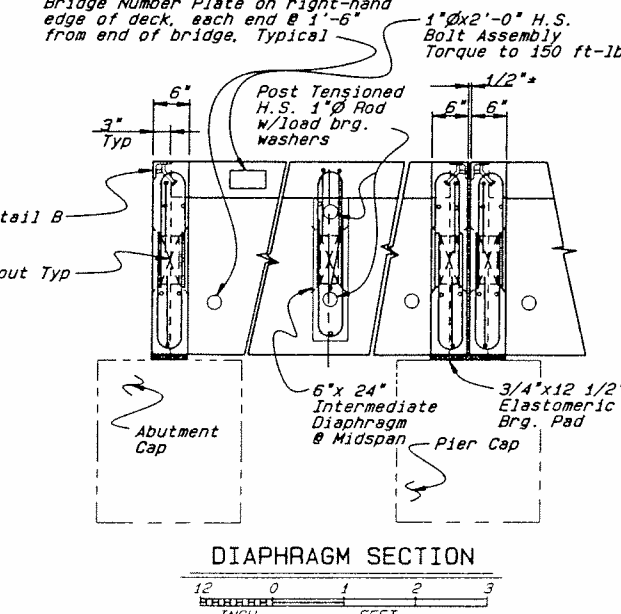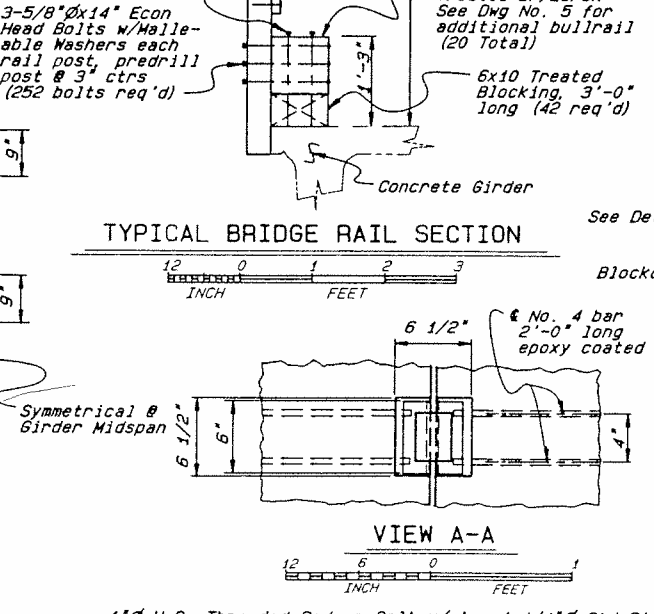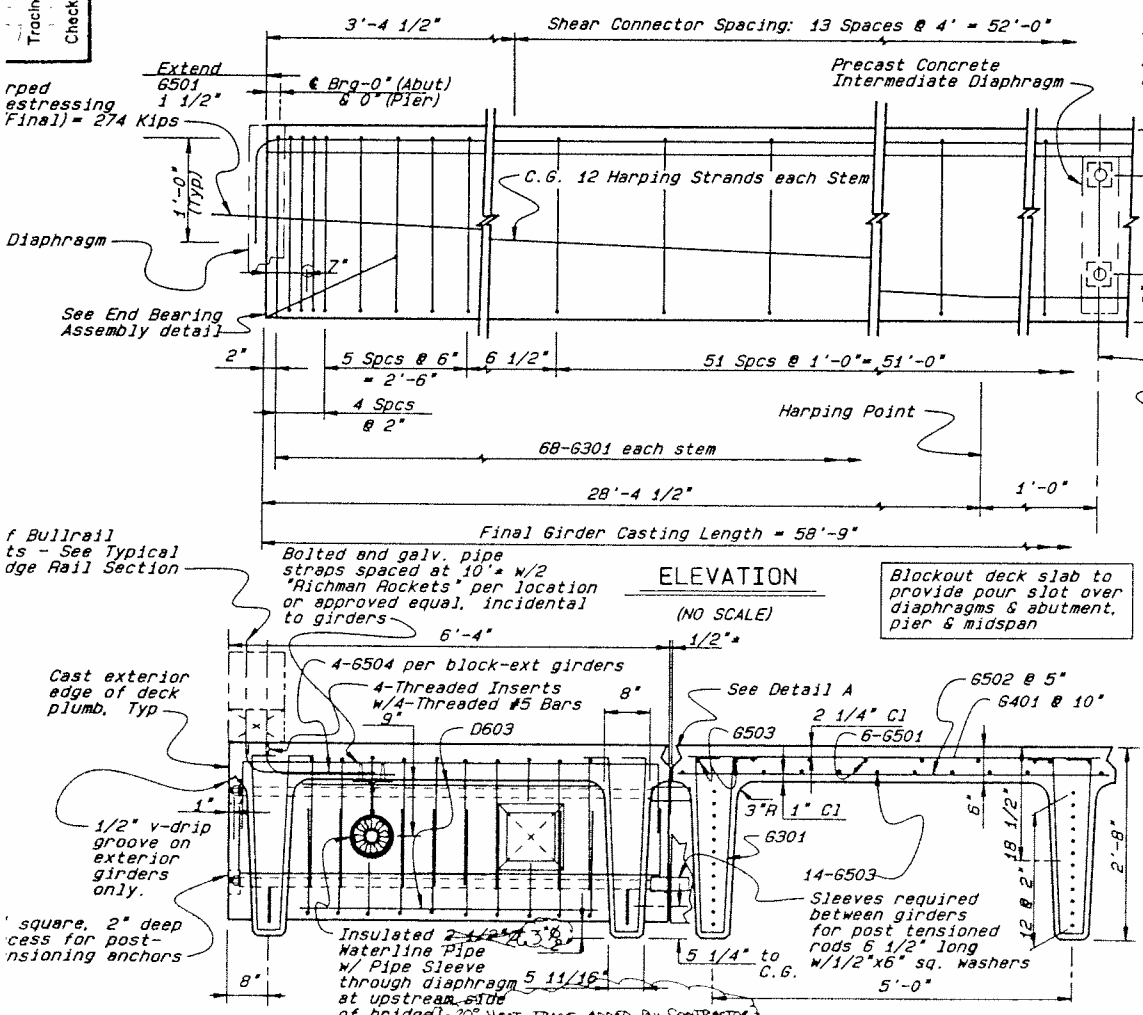

PELICAN CREEK BRIDGE

SALMON WAY, PELICAN ALASKA

SUPERSTRUCTURE DETAILS

State of Alaska
DEPARTMENT OF TRANSPORTATION and PUBLIC FACILITIES
Juneau, Alaska

BRIDGE NO. 1491
OWNS. NO. 4

10/30/91
/usr/mkh/1491/BOUP
9/23/91 Rev. 10/29/91
Scale - as shown
Drawn by: MCH

| STATE | PROJECT DESIGNATION | YEAR | SHEET NO. | TOTAL SHEETS |
|--------|---------------------|------|-----------|--------------|
| ALASKA | B-0003 (21) | 1991 | 6 | 9 |







AS BUILT PLANS

MARK HALVORSEN Date SEPT. 1992
Project Engineer

CORRECTIONS TRANSFERRED

Tracings S.M. SOLIE JR. Date 9/18/92

Checked G.J.W. Date 12/1/92

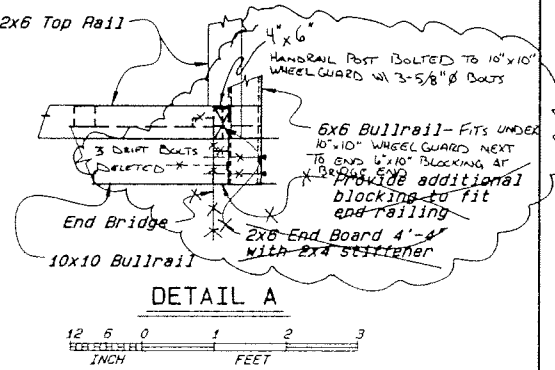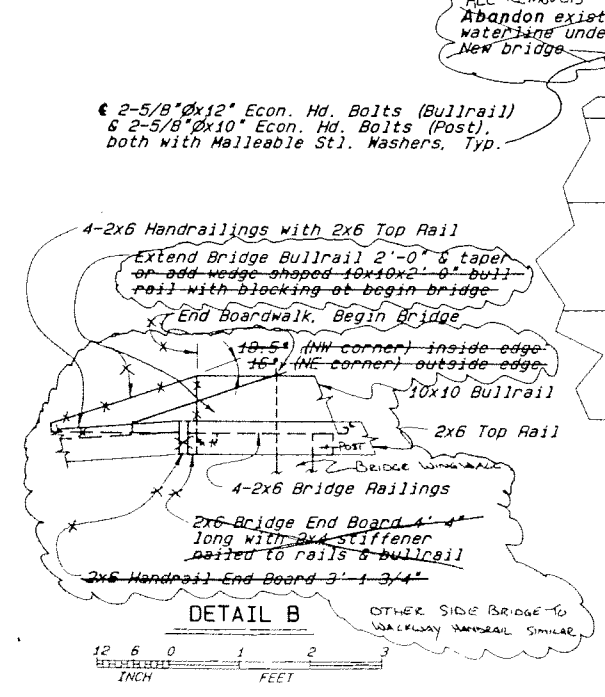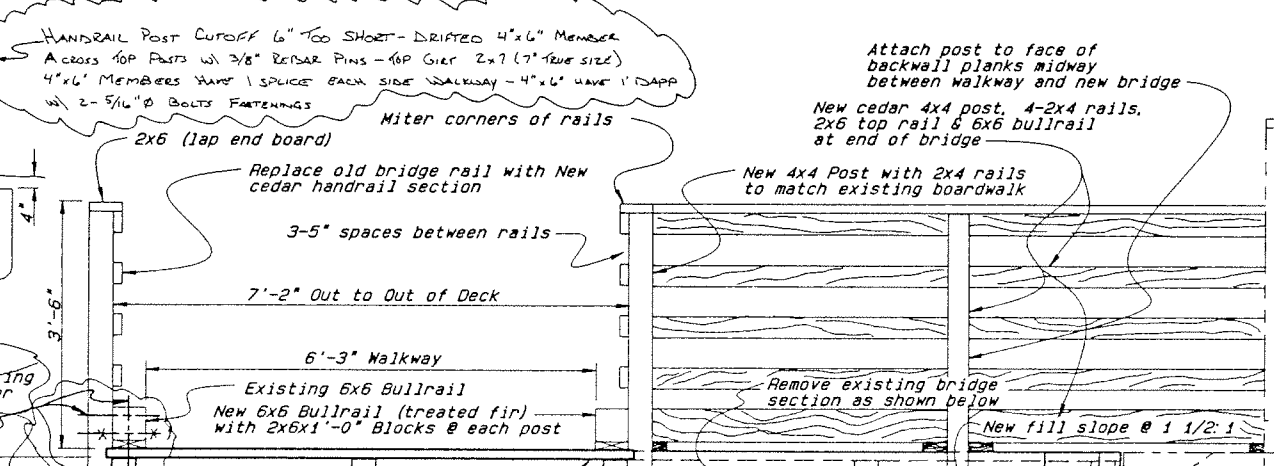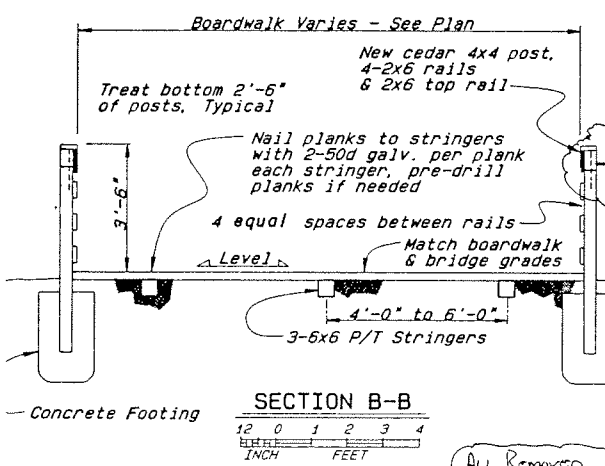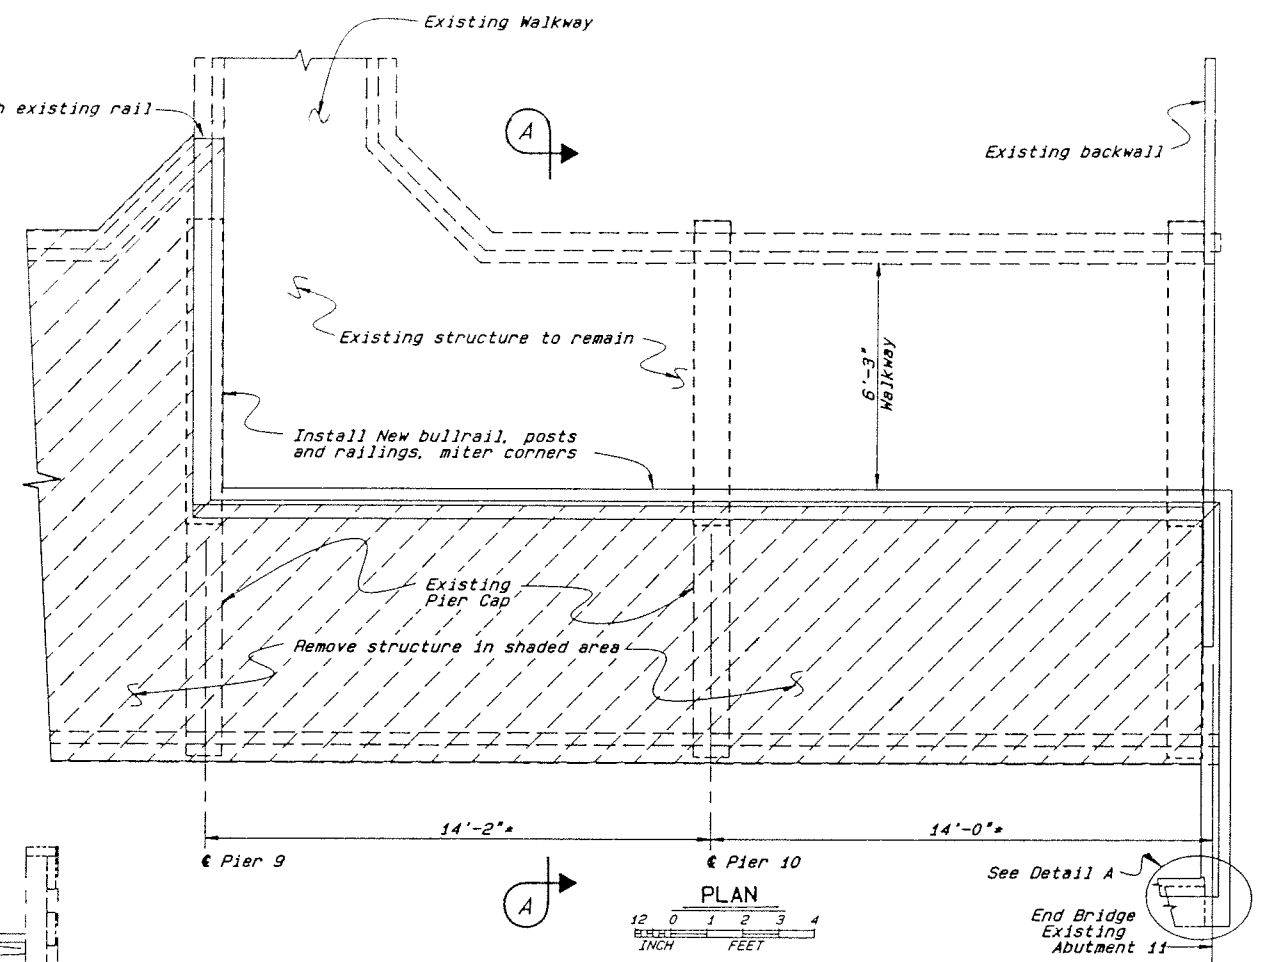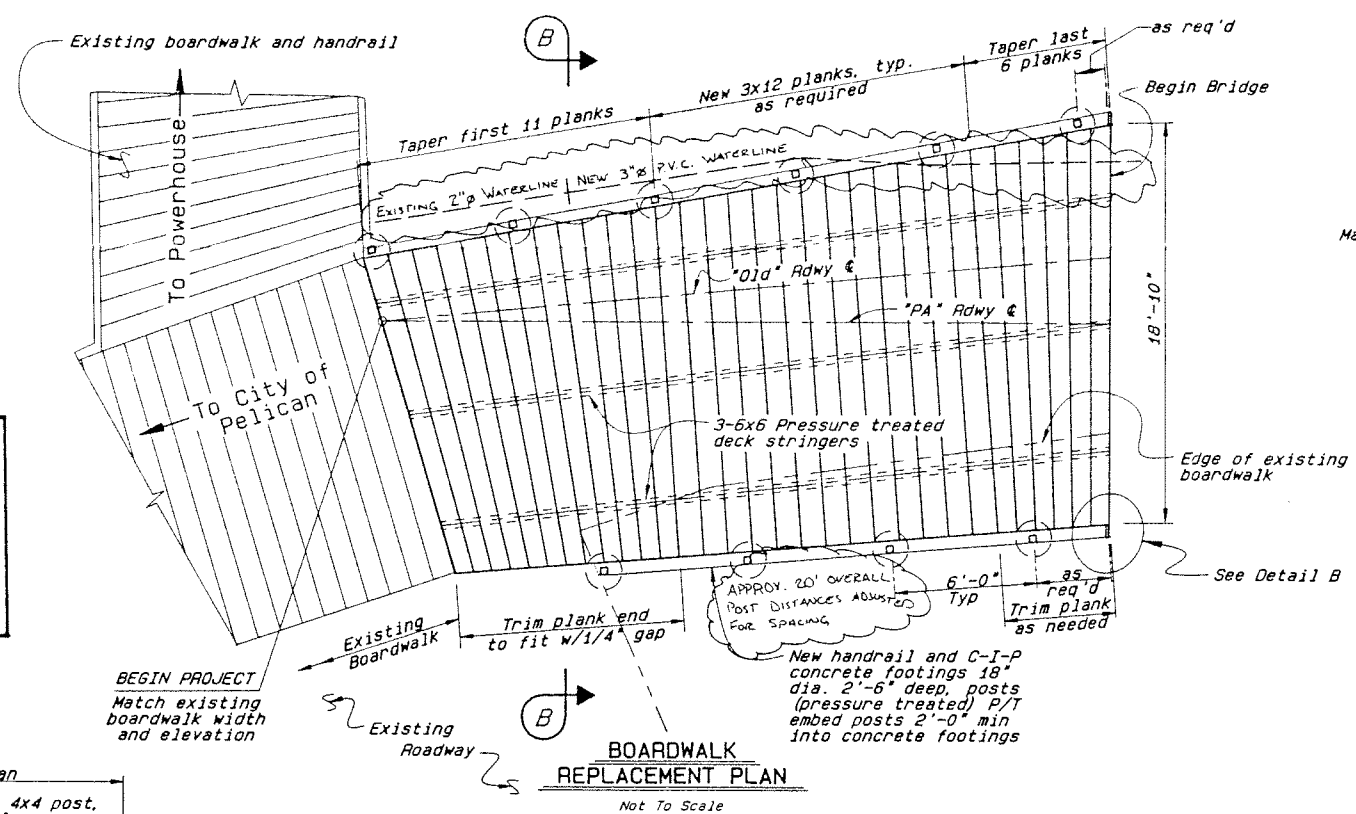



PELICAN CREEK BRIDGE
SALMON WAY, PELICAN ALASKA
WALKWAY REHABILITATION

Plans prepared under my direct supervision.

State of Alaska
DEPARTMENT OF TRANSPORTATION
and PUBLIC FACILITIES
Juneau, Alaska

BRIDGE NO. 1491
OWNS NO. 5

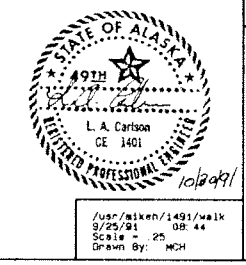

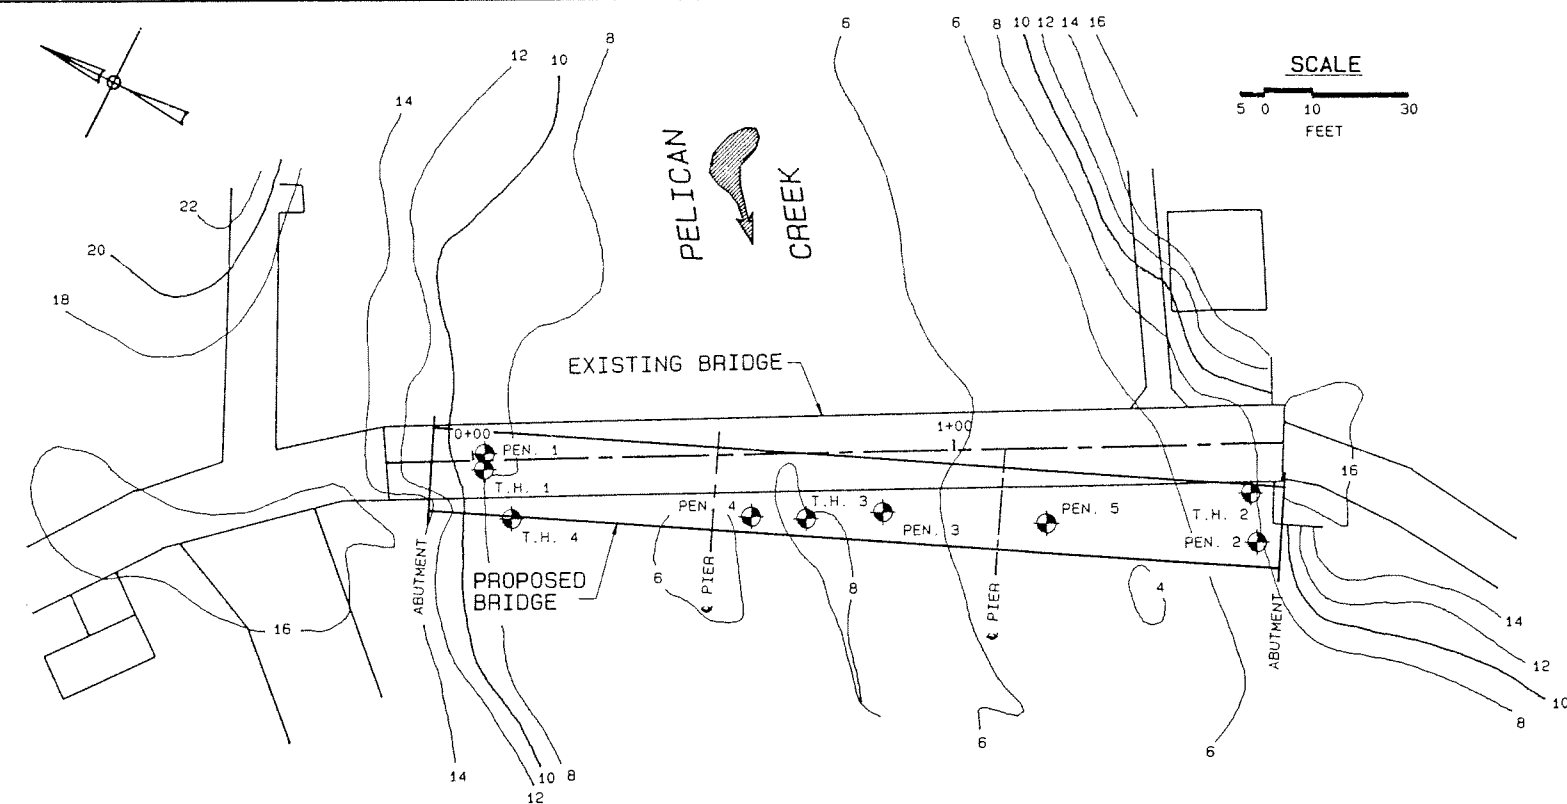

BASIC MATERIALS SYMBOLS

| | | | |
|--|-------------------|--|------|
| | Organic | | Silt |
| | Cobbles: Boulders | | Clay |
| | Gravel | | |
| | Sand | | |

NOTE: Significant soil mixtures are shown by combining soil symbols

TYPICAL TEST HOLE SYMBOLS







Location of any hole:

Section View: Rotary, Auger, Diamond Core, Penetrometer

RELATIVE DENSITY AND CONSISTENCY CLASSIFICATION

Based on Standard Penetration Test

| GRANULAR | | COHESIVE | |
|----------|---------------|----------|-------------|
| Blows/ft | Rel. Density | Blows/ft | Consistency |
| 0-5 | Very Loose | 2 | Very Soft |
| 6-10 | Loose | 2-4 | Soft |
| 11-20 | Firm | 5-8 | Medium |
| 21-35 | Compact | 9-15 | Stiff |
| 36-50 | Dense | 16-30 | Very Stiff |
| 51-70 | Very Dense | 31-60 | Hard |
| 71+ | V. Very Dense | 61+ | Very Hard |

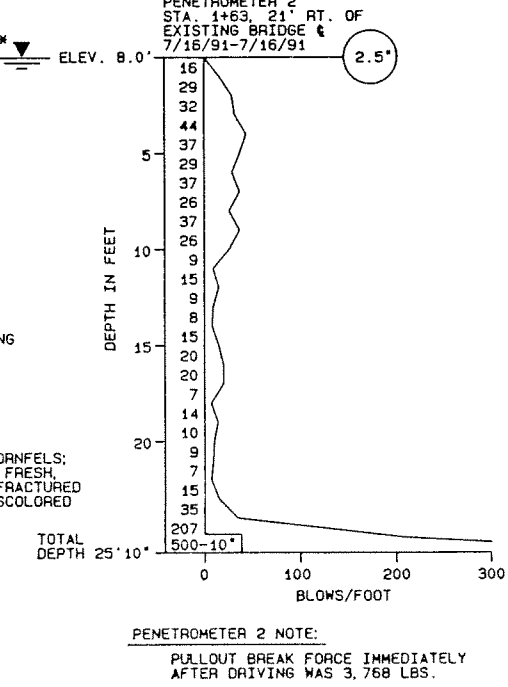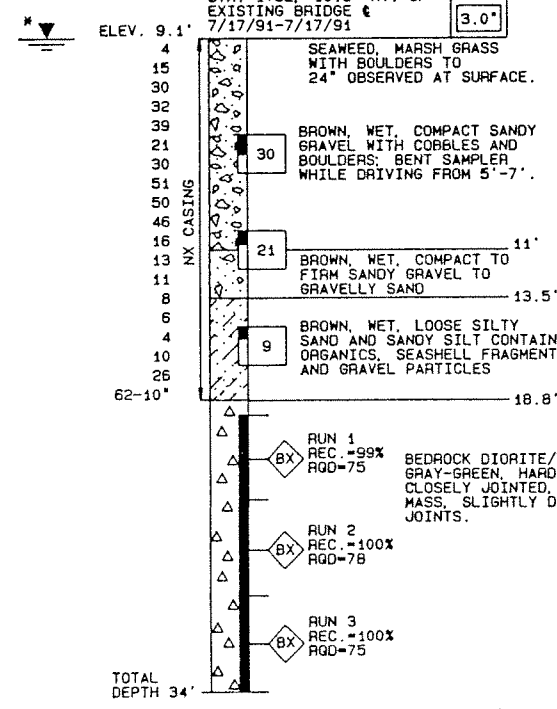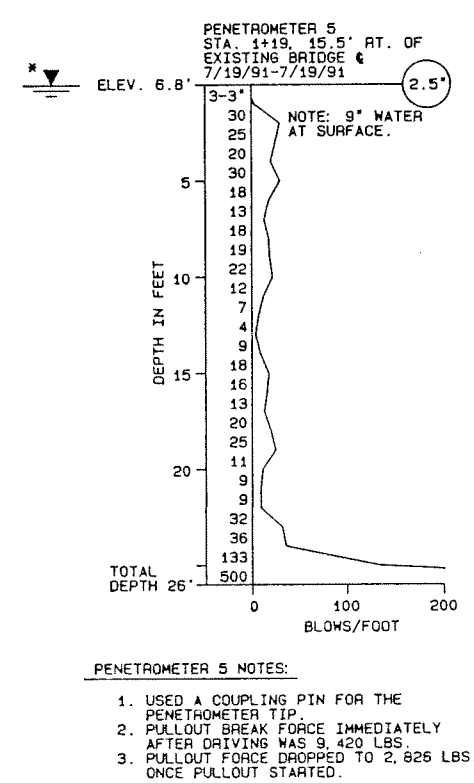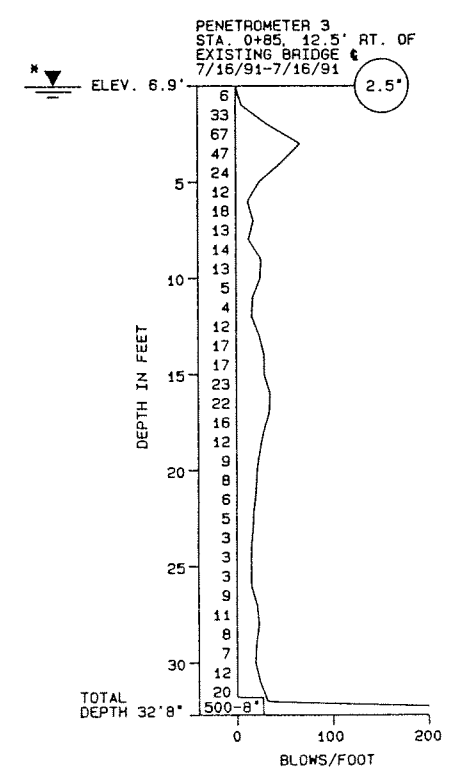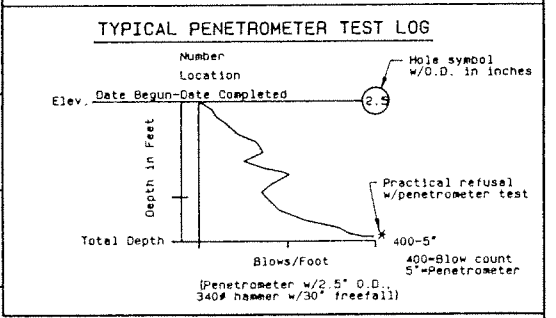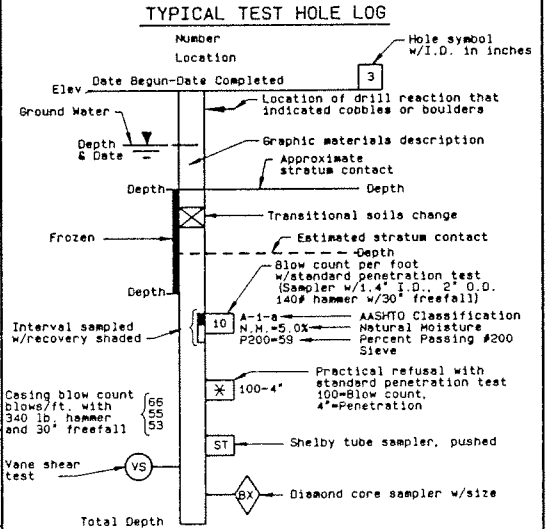

AS BUILT PLANS

MARK HALVORSEN, Project Engineer, Date: SEPT 1992

CORRECTIONS TRANSFERRED

Tracings: S.H. SAUER, JR., Date: 1/1/92

Checked: G.J.W., Date: 12/1/92



TEST HOLE LOGS AND LOCATIONS

PELICAN CREEK BRIDGE REPLACEMENT

State of Alaska
DEPARTMENT OF TRANSPORTATION & PUBLIC FACILITIES
Juneau, Alaska

Date: 8-27-91
Approved: [Signature]

BRIDGE NO. 1491
DWNG. NO. 6

GENERAL NOTES:

1. TEST HOLE(S) DEPICTED ARE A COMBINATION OF THE ORIGINAL FIELD LOG(S), AND AN OFFICE EXAMINATION OF THE FIELD LOG(S), SOIL SAMPLE(S) & ROCK CORE(S).

2. STRATIFICATION LINES REPRESENT THE APPROXIMATE BOUNDARY BETWEEN TYPES OR RELATIVE DENSITIES. THE TRANSITION MAY BE GRADUAL.

3. CASING IS INDICATED. THE NEED WAS PREDICATED BY THE POSITION OF GROUNDWATER TABLE OR BY CAVING GROUND CONDITIONS. THE CASING IS INSTALLED TO PROVIDE TEMPORARY SOIL SUPPORT AND/OR PROVIDE FOR FLUID CIRCULATION.

4. FIELD MOISTURE DESCRIPTIONS (DRY, MOIST, AND WET) ARE BASED ON THE FOLLOWING FIELD OBSERVATIONS:

- DRY - A SOIL WITH NO VISIBLE MOISTURE, FEELS DRY WHEN HELD IN THE HAND, WILL NOT FORM A CAST.
- MOIST - A SOIL WITH VISIBLE MOISTURE, FEELS MOIST IN THE HAND, WILL FORM A CAST.
- WET - A SOIL WITH VISIBLE WATER, WETS THE HAND WHEN HELD, HAS FREE WATER WHEN SHAKEN.

A COMBINATION OF THESE TERMS MAY BE USED TO DESCRIBE THE SOIL MOISTURE CONDITION.


5. ALL TEST HOLES AND PENETROMETERS WERE PLACED IN AN INTERTIDAL AREA AND THE WATER TABLE WILL VARY WITH THE TIDE.

SOIL GRAIN SIZE DEFINITIONS

| | |
|-----------------------------------|-------------------|
| Boulder | >10" Diameter |
| Cobble | 3" - 10" Diameter |
| Broken rock (angular) | >3" Diameter |
| Gravel (rounded): Stone (angular) | #10 Sieve-3" Dia. |
| Sand | #200 Sieve- #10 |
| Silt/Clay | <#200 Sieve |


NOTE: Soil classifications are visual only unless AASHTO soil class is shown on the log.

IONS:


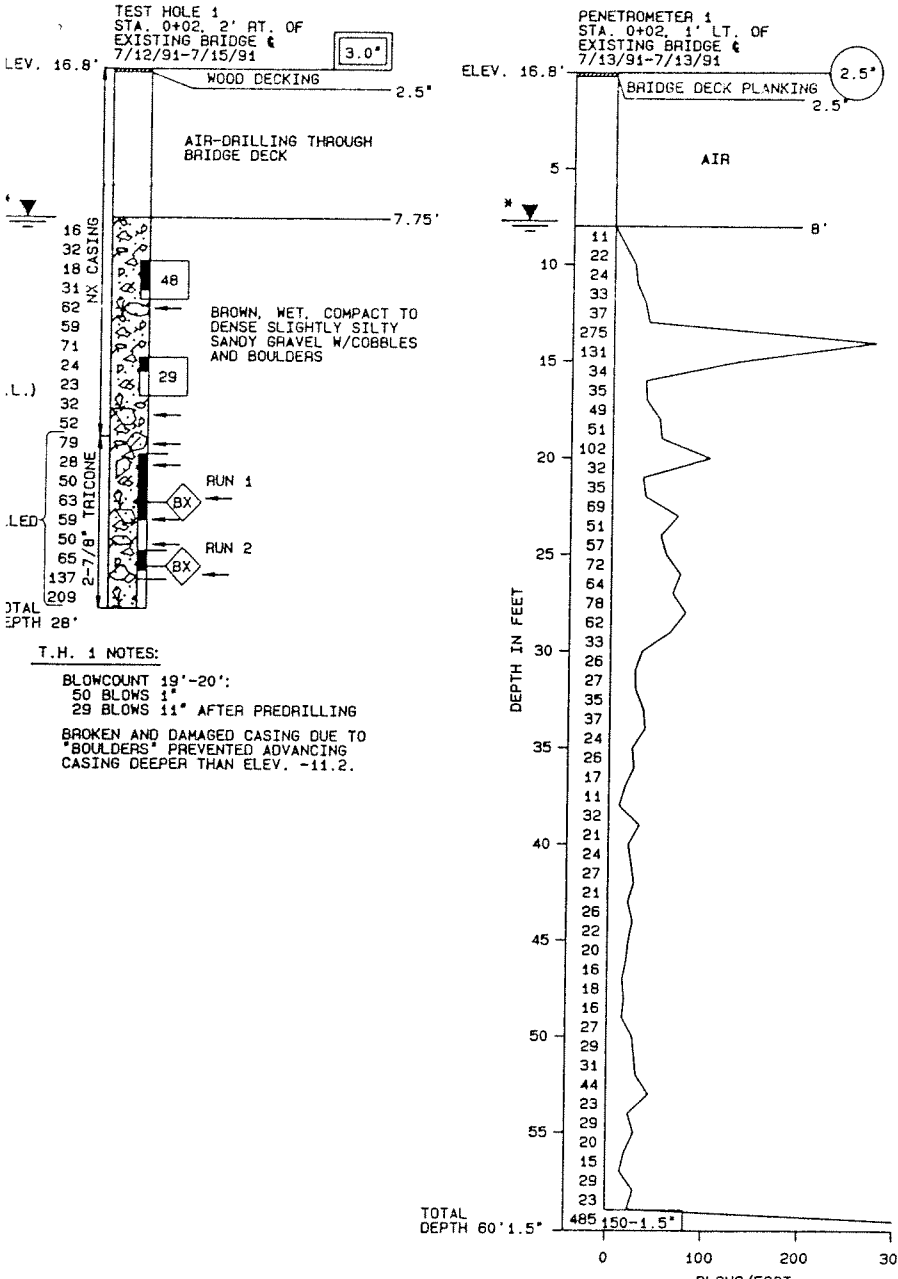


AS BUILT PLANS
 MARK HALVORSEN, Project Engineer, Date SEPT. 1992
 CORRECTIONS TRANSFERRED
 Tracings SH SOLUE JR, Date 9/18/92
 Checked G.W., Date 11/1/92

PENETROMETER 1 NOTES:
 PENETROMETER PULLOUT BREAK FORCE IMMEDIATELY AFTER DRIVING WAS 5,024 LBS.
 20' OF PENETROMETER ROD WAS BENT AND DAMAGED WHILE DRIVING P-1.

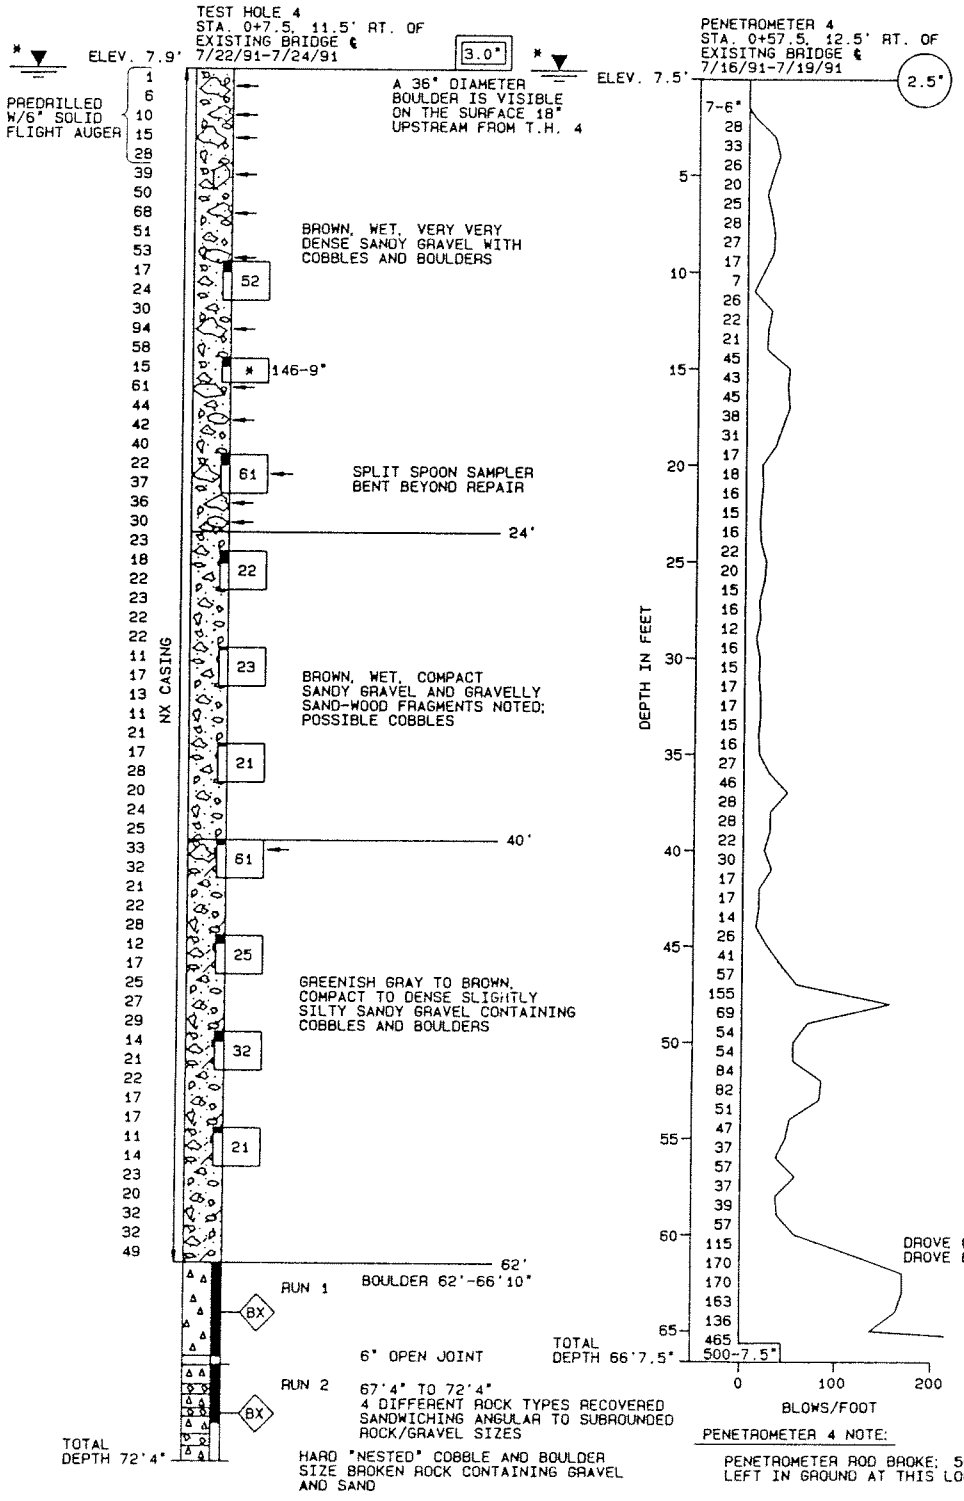

PENETROMETER 4 NOTE:
 PENETROMETER ROD BROKE; 50' LEFT IN GROUND AT THIS LOCATION.

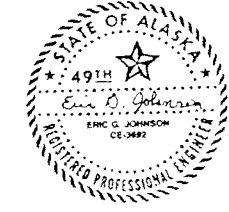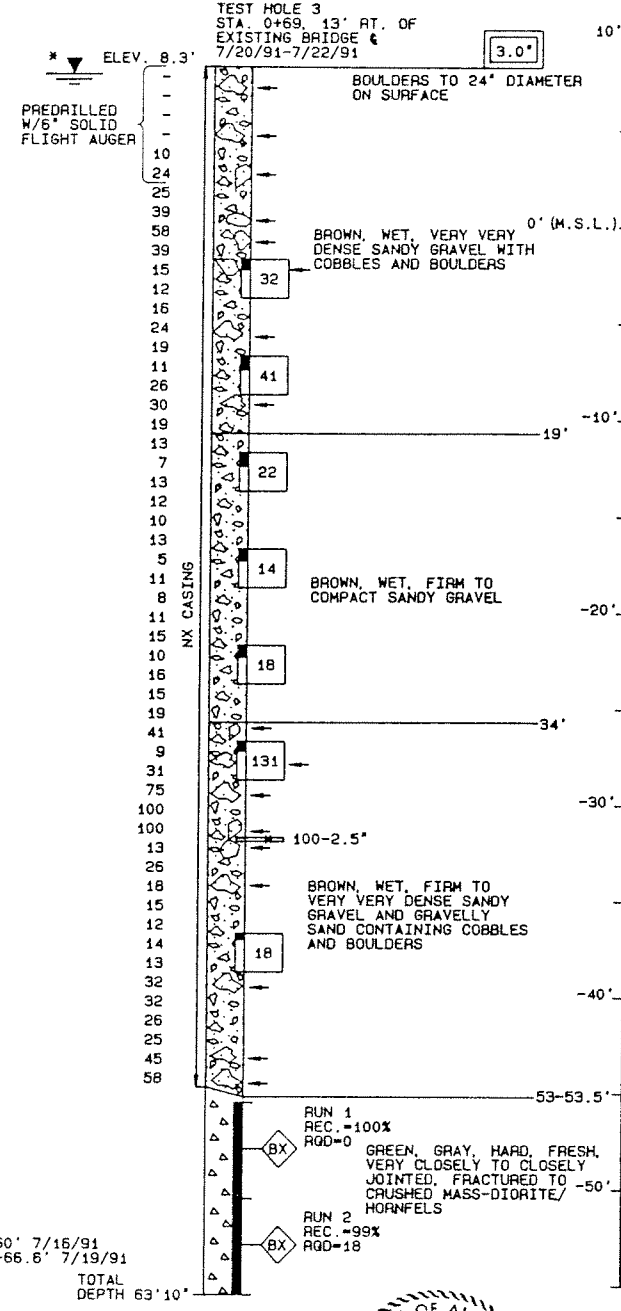



BASIC MATERIALS SYMBOLS

| | | | |
|----------|-------------------|----------|------|
| [Symbol] | Organic | [Symbol] | Silt |
| [Symbol] | Cobbles: Boulders | [Symbol] | Clay |
| [Symbol] | Gravel | [Symbol] | |
| [Symbol] | Sand | [Symbol] | |

NOTE: Significant soil mixtures are shown by combining soil symbols

TYPICAL TEST HOLE SYMBOLS

| Plan View | RELATIVE DENSITY AND CONSISTENCY CLASSIFICATION | | | | |
|-----------|---|----------|------------------------------------|----------|-------------|
| | Based on Standard Penetration Test | | Based on Standard Penetration Test | | |
| [Symbol] | Location of any hole | Blows/ft | Rel. Density | Blows/ft | Consistency |
| [Symbol] | Rotary | 0-5 | Very Loose | 2 | Very Soft |
| [Symbol] | Auger | 6-10 | Loose | 2-4 | Soft |
| [Symbol] | Diamond Core | 11-20 | Firm | 5-8 | Medium |
| [Symbol] | Penetrometer | 21-35 | Compact | 9-15 | Stiff |
| | | 36-50 | Dense | 16-30 | Very Stiff |
| | | 51-70 | Very Dense | 31-60 | Hard |
| | | 71+ | V. Very Dense | 61+ | Very Hard |

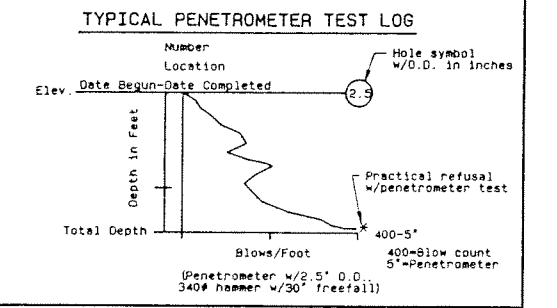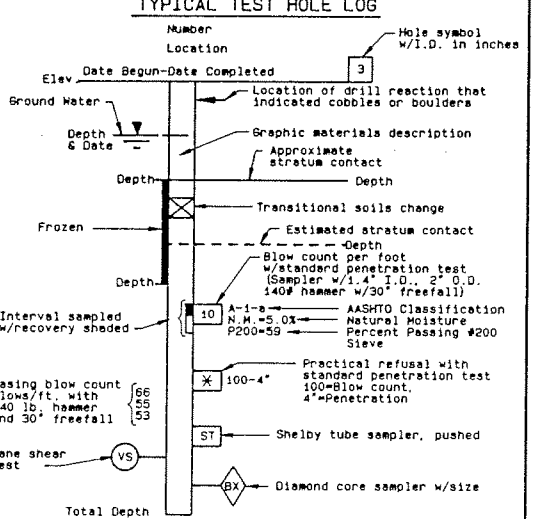

TEST HOLE LOGS
PELICAN CREEK BRIDGE REPLACEMENT

State of Alaska
 DEPARTMENT OF TRANSPORTATION & PUBLIC FACILITIES
 Juneau, Alaska
 Date: 8-27-91
 Approved: [Signature]
 BRIDGE NO. 1491
 DWNG. NO. 7

GENERAL NOTES:
 TEST HOLE(S) DEPICTED ARE A COMBINATION OF THE ORIGINAL FIELD LOG(S) AND AN OFFICE EXAMINATION OF THE FIELD LOG(S), SOIL SAMPLE(S) & ROCK CORE(S).
 RATIFICATION LINES REPRESENT THE APPROXIMATE BOUNDARY BETWEEN TYPES OR RELATIVE DENSITIES. THE TRANSITION MAY BE GRADUAL.
 CASING IS INDICATED. THE NEED WAS PREDICATED BY THE POSITION OF GROUNDWATER TABLE OR BY CAVING GROUND CONDITIONS. THE CASING IS STALLED TO PROVIDE TEMPORARY SOIL SUPPORT AND/OR PROVIDE FOR FLUID CIRCULATION.

- FIELD MOISTURE DESCRIPTIONS (DRY, MOIST, AND WET) ARE BASED ON THE FOLLOWING FIELD OBSERVATIONS:
 - DRY - A SOIL WITH NO VISIBLE MOISTURE. FEELS DRY WHEN HELD IN THE HAND, WILL NOT FORM A CAST.
 - MOIST - A SOIL WITH VISIBLE MOISTURE. FEELS MOIST IN THE HAND, WILL FORM A CAST.
 - WET - A SOIL WITH VISIBLE WATER, WETS THE HAND WHEN HELD, HAS FREE WATER WHEN SHAKEN.
 A COMBINATION OF THESE TERMS MAY BE USED TO DESCRIBE THE SOIL MOISTURE CONDITION.
- ALL TEST HOLES AND PENETROMETERS WERE PLACED IN AN INTERTIDAL AREA AND THE WATER TABLE WILL VARY WITH THE TIDE.

SOIL GRAIN SIZE DEFINITIONS

| | |
|-----------------------------------|---------------------------|
| Boulder | >10" Diameter |
| Cobble | 3"- 10" Diameter |
| Broken rock (angular) | >3" Diameter |
| Gravel (rounded); Stone (angular) | #10 Sieve-3" Dia. |
| Sand | #200 Sieve- #10 Silt/Clay |
| Silt/Clay | <#200 Sieve |

NOTE: Soil classifications are visual only unless AASHTO soil class is shown on the log.