


LOCATION MAP  
SCALE: 1"=8000'

INDEX

FILE NO.	DESCRIPTION
0-10-591	LOCATION SHEET
0-10-592 TO 0-10-595	OMITTED
0-10-596	PLAN AND PROFILE STA. 24+00 TO STA. 48+00
0-10-597	PLAN AND PROFILE STA. 48+00 TO STA. 84+00
0-10-598 TO 0-10-601	OMITTED
0-10-602	PROF. SECT. STA. 42+00 TO STA. 47+40
0-10-603 TO 0-10-610	OMITTED
0-10-611	PLAN, ELEVATION, AND FOUNDINGS
0-10-612	BILL OF REINFORCING STEEL
0-10-613	DETAILS OF END BENTS 1 AND 20
0-10-614	DETAILS OF INTERMEDIATE BENTS 2, 18, 19
0-10-615	DETAILS OF INTERMEDIATE BENTS 3 THRU 17
0-10-616	DETAILS OF INTERMEDIATE BENTS 3 THRU 17
0-10-617	PLAN OF STRUCTURAL STEEL
0-10-618	PLAN OF SLAB REINFORCING STEEL
0-10-619	DETAILS OF STRUCTURAL STEEL
0-10-620	DETAILS OF HANDRAIL

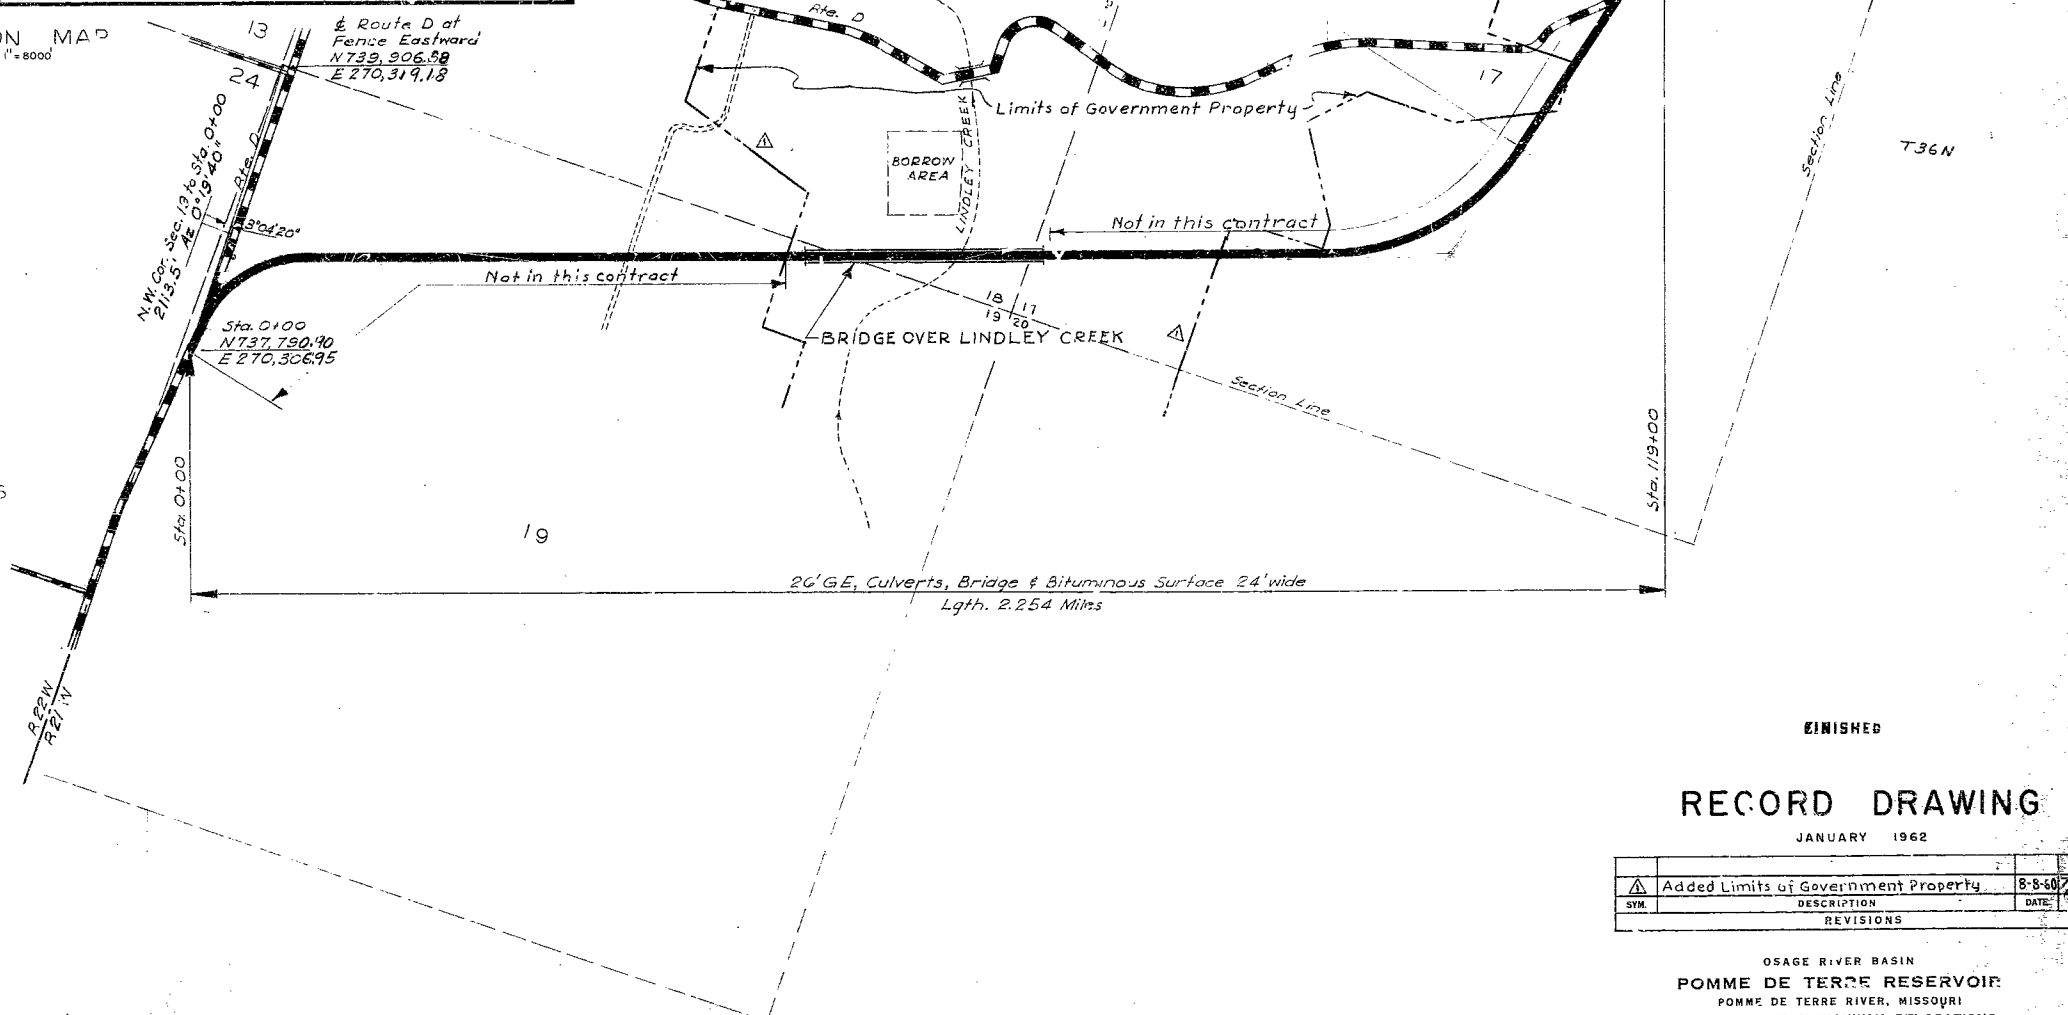

220

FINISHED  
RECORD DRAWING  
JANUARY 1962

SYMBOL	DESCRIPTION	DATE
△	Added Limits of Government Property	8-8-60

OSAGE RIVER BASIN  
POMME DE TERRE RESERVOIR  
POMME DE TERRE RIVER, MISSOURI  
MISSOURI STATE HIGHWAY RELOCATIONS  
BRIDGE OVER LINDLEY CREEK  
ROUTE D

LOCATION SHEET  
IN 30 SHEETS SHEET NO. 1 SCALE AS SHOWN  
U. S. ARMY ENGINEER DISTRICT KANSAS CITY, MO. MAY 1960  
KANSAS CITY, MO. MAY 1960

APPROVED: *L. E. Laurin*  
COL. C.E. DISTRICT ENG.


RECOMMENDED: *W. B. Beck*  
CHIEF, ENGINEERING DIV.

SUBMITTED: *H. S. ...*  
CHIEF, PROJECTS DIVISION BRANCH

DRAWN BY: CLO  
CHECKED BY: CLO  
BY: JJW HICKORY


1 of 14

PRICHARD COMPANY, INC. INDEPENDENCE, MISSOURI

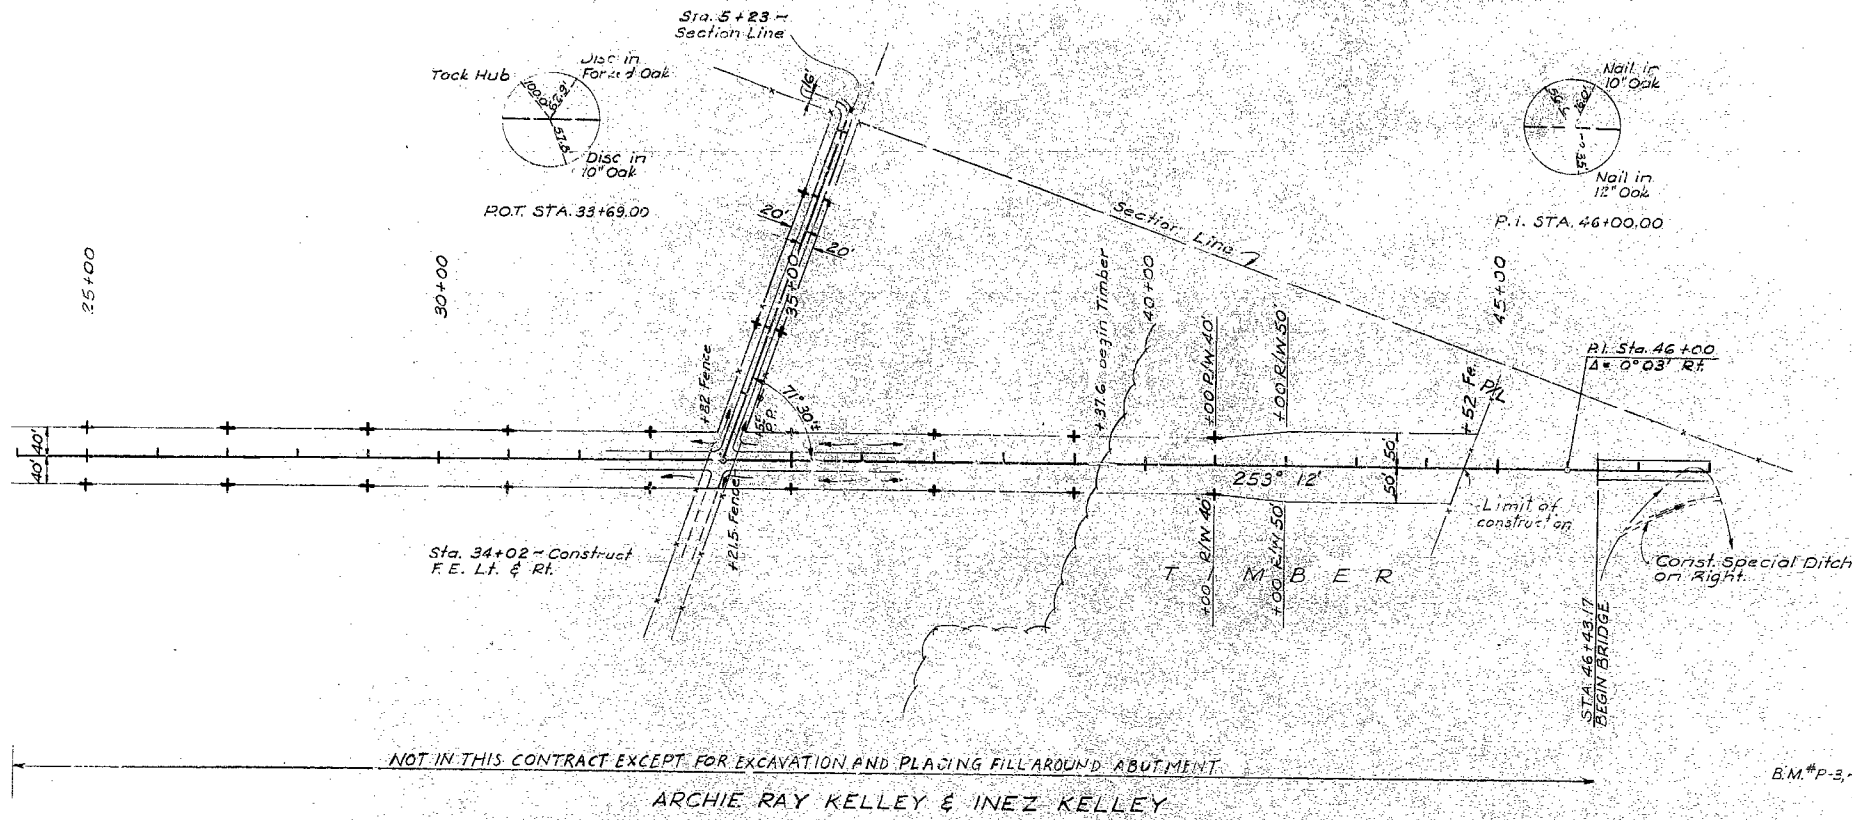

B.M.#P-3,-2 Braced Nails in South Side Power Pole, 90' Lt. Sta. 34+55 - 3/9.64.

B.M.#P-4,-2 Braced Nails in West Side 30" Oak Tree, 36' Lt. Sta. 44+76 - 8/9.17

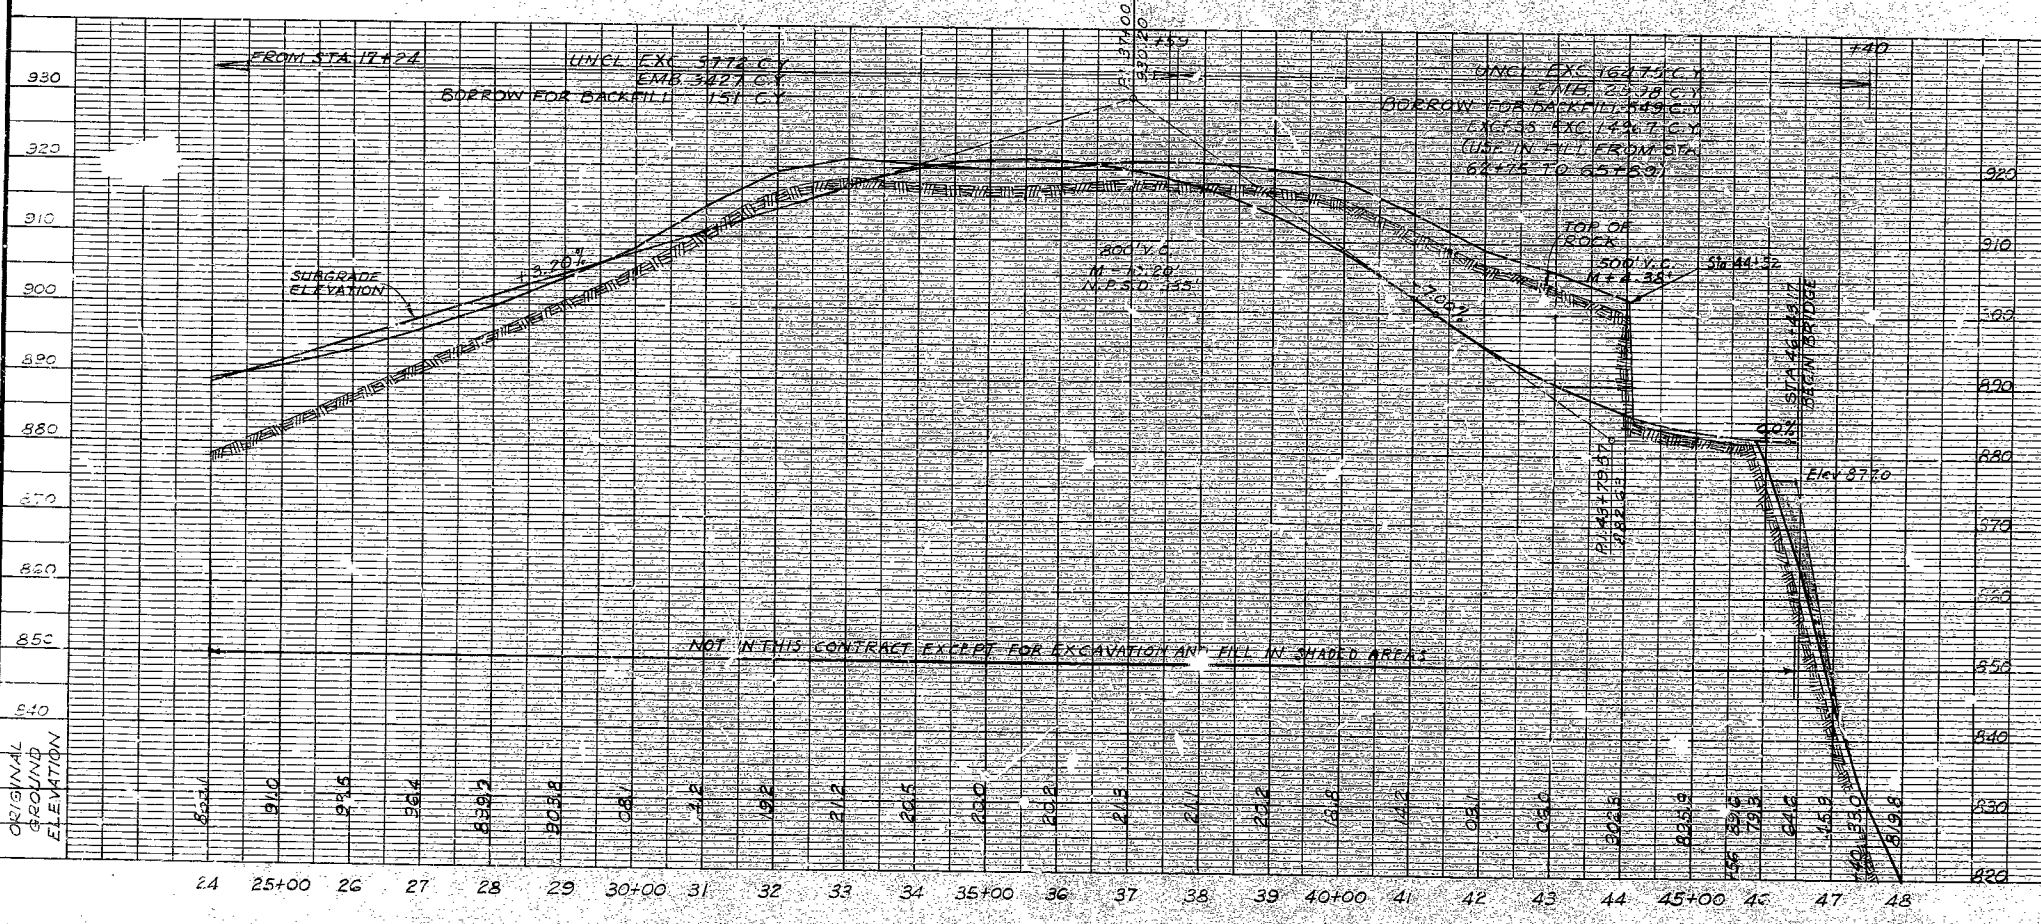

**RECORD DRAWING**

JANUARY 1962

Revised for As Built conditions		1-13-62	JEB
SIM.	DESCRIPTION	DATE	APP'D.
REVISIONS			

FINISHED

OSAGE RIVER BASIN  
**POMME DE TERRE RESERVOIR**  
 POMME DE TERRE RIVER, MISSOURI  
 MISSOURI STATE HIGHWAY RELOCATIONS  
 ROUTE D  
 PLAN & PROFILE  
 STA. 24+00 - STA. 48+00

FINISHED



IN 30 SHEETS SHEET NO. 6 SCALE: AS SHOWN  
 U. S. ARMY ENGINEER DISTRICT KANSAS CITY, MO. KANSAS CITY, MO. MAY 1960  
 SUBMITTED: [Signature] RECOMMENDED: [Signature] APPROVED: [Signature]  
 CHIEF, PROJECTS DESIGN BRANCH CHIEF, ENGINEERING DIV. COL. C. C. DISTRICT ENG.  
 DRAWN BY: J.W. JSW CHECKED BY: GLO HICKORY  
 FILE NO. 1-592 0-10-596



FINISHED 2 of 14

PRICHARD COMPANY, INC. INDEPENDENCE, MISSOURI

122

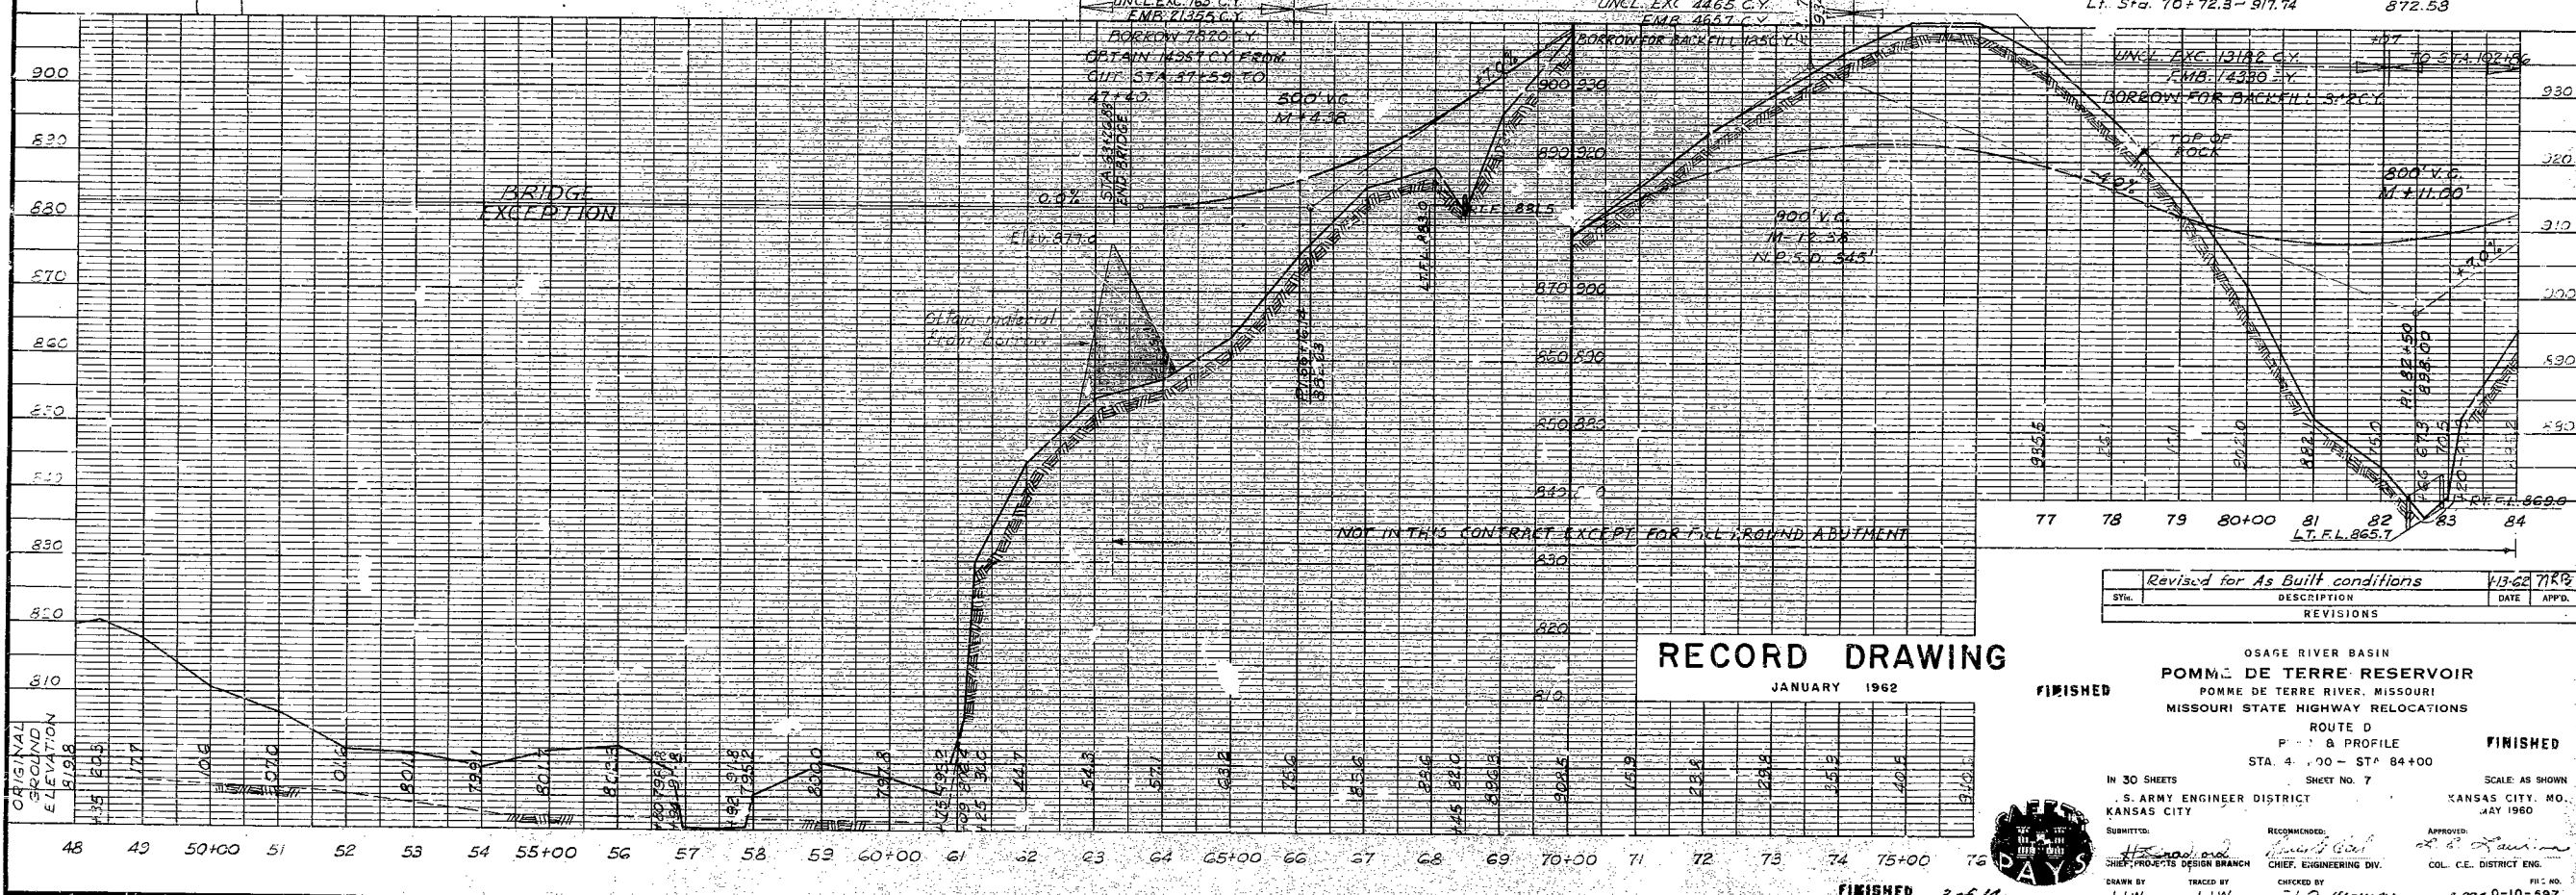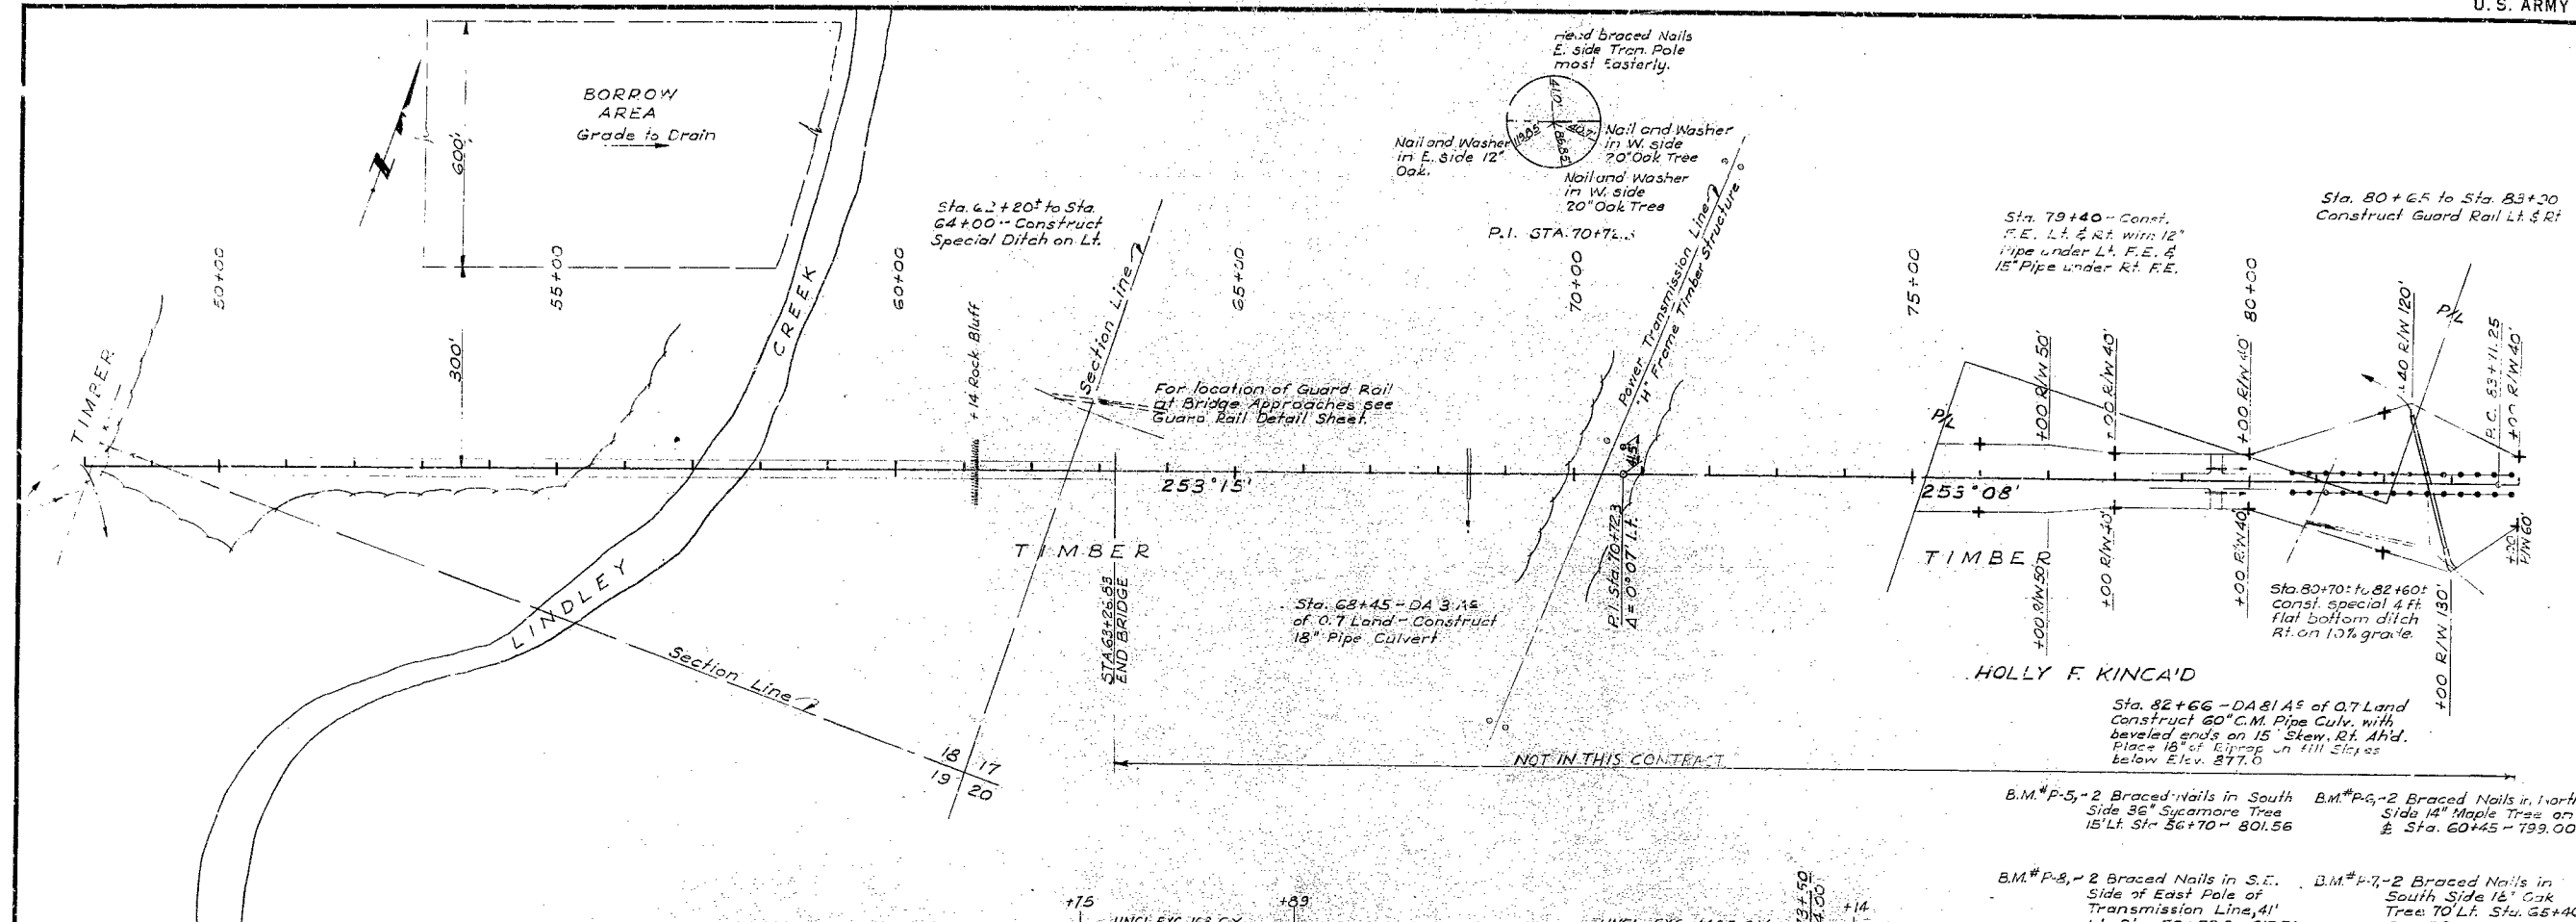

222

### RECORD DRAWING

JANUARY 1962

SYMBOL	DESCRIPTION	DATE	APPROVED
	Revised for As Built conditions	1/13/62	TRK
REVISIONS			

OSAGE RIVER BASIN  
**POMME DE TERRE RESERVOIR**  
 POMME DE TERRE RIVER, MISSOURI  
 MISSOURI STATE HIGHWAY RELOCATIONS  
 ROUTE D  
 P & PROFILE  
 STA. 4,000 - STA. 84+00  
 SHEET NO. 7

IN 30 SHEETS  
 S. ARMY ENGINEER DISTRICT  
 KANSAS CITY


SCALE: AS SHOWN  
 KANSAS CITY, MO.  
 JAY 1960

APPROVED: [Signature]  
 COL. C.E. DISTRICT ENG.

DESIGNED BY: [Signature]  
 TRACED BY: JWW  
 CHECKED BY: GLO HICKORY  
 1-10-59



PRICHARD COMPANY, INC. INDEPENDENCE, MISSOURI

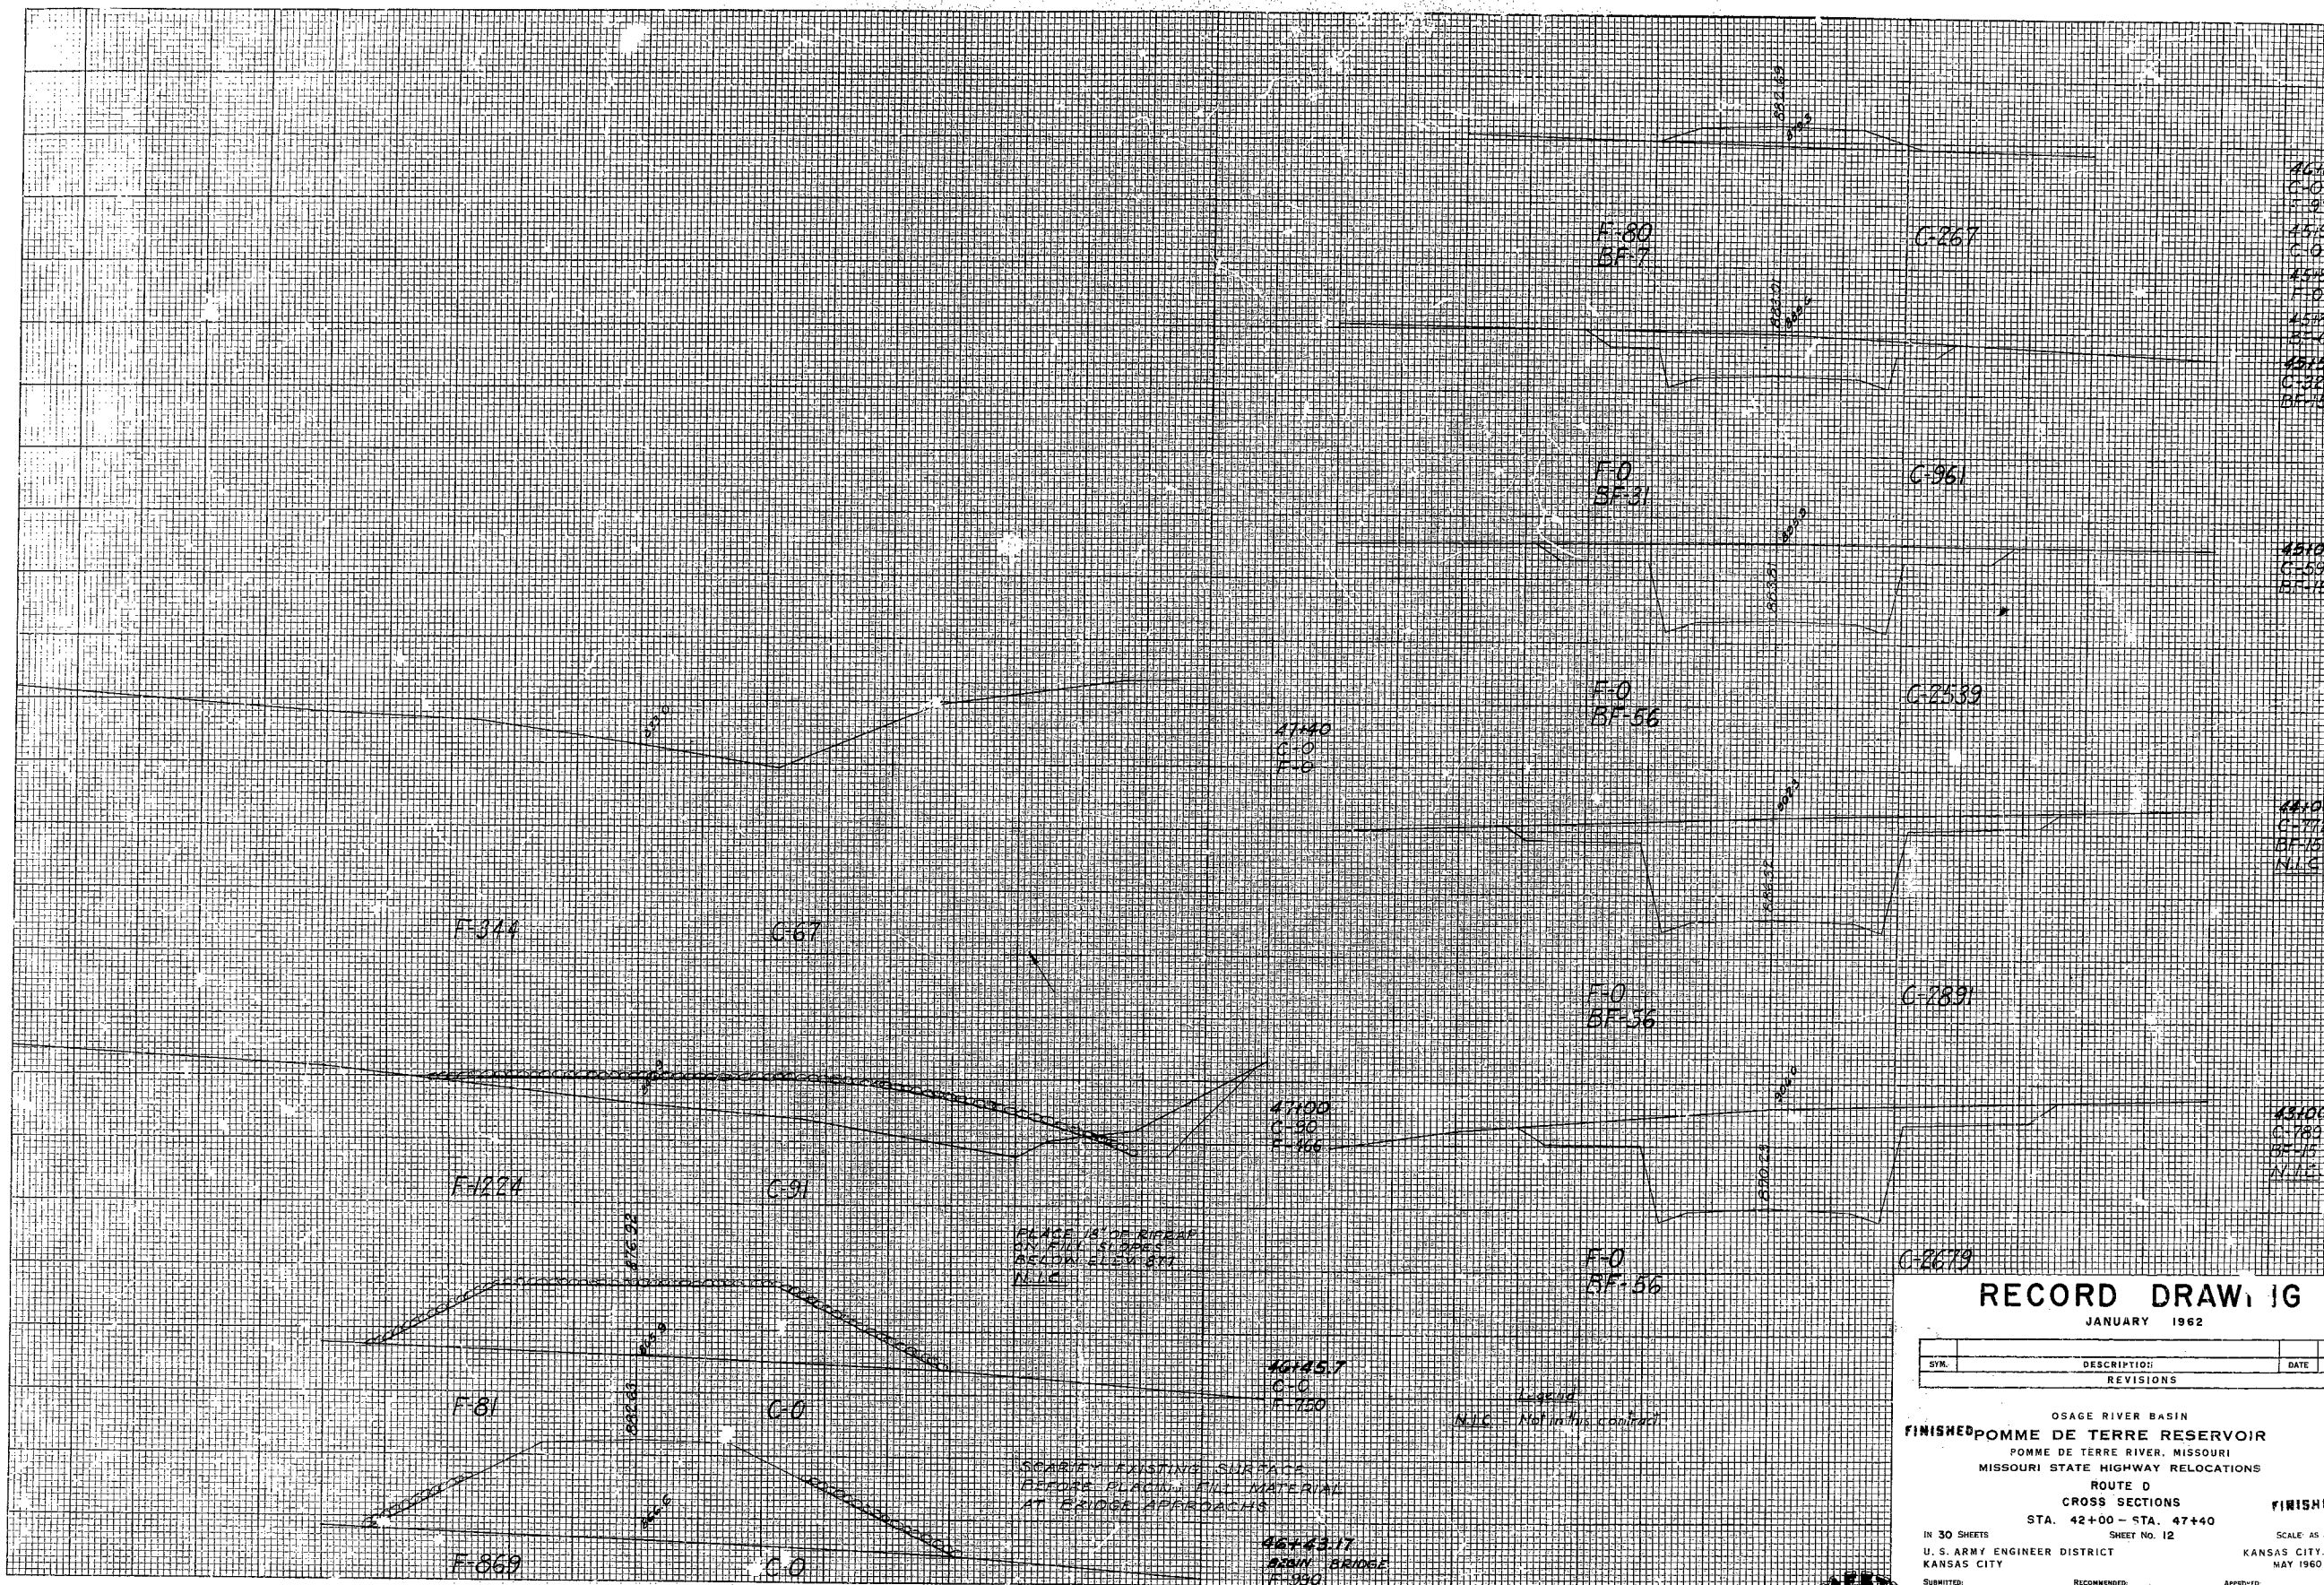

223

PLACE 1/2" OF RIBBON ON FULL SLOPES BELOW ELEV 372 N.I.C.

SCABBY EXISTING SURFACE BEFORE PLACING FINE MATERIAL AT BRIDGE APPROACHS

N.I.C. Not in this contract

**RECORD DRAWING**  
JANUARY 1962

SYN.	DESCRIPTION	DATE	APPD.
REVISIONS			

OSAGE RIVER BASIN  
**FINISHED POMME DE TERRE RESERVOIR**  
POMME DE TERRE RIVER, MISSOURI  
MISSOURI STATE HIGHWAY RELOCATIONS  
ROUTE D  
CROSS SECTIONS **FINISHED**  
STA. 42+00 - STA. 47+40  
SHEET NO. 12  
SCALE: AS SHOWN

IN 30 SHEETS  
U. S. ARMY ENGINEER DISTRICT  
KANSAS CITY

KANSAS CITY, MO.  
MAY 1960

APPROVED: *[Signature]*  
COL. C.E. DISTRICT ENG.

RECOMMENDED: *[Signature]*  
CHIEF, ENGINEERING DIV.


CHIEF, PROJECTS DESIGN BRANCH  
DRAWN BY: *[Signature]*  
CHECKED BY: *[Signature]*  
FILE NO. 0-10-602

PRICHARD COMPANY, INC. INDEPENDENCE, MISSOURI

FINISHED 4 of 14



651

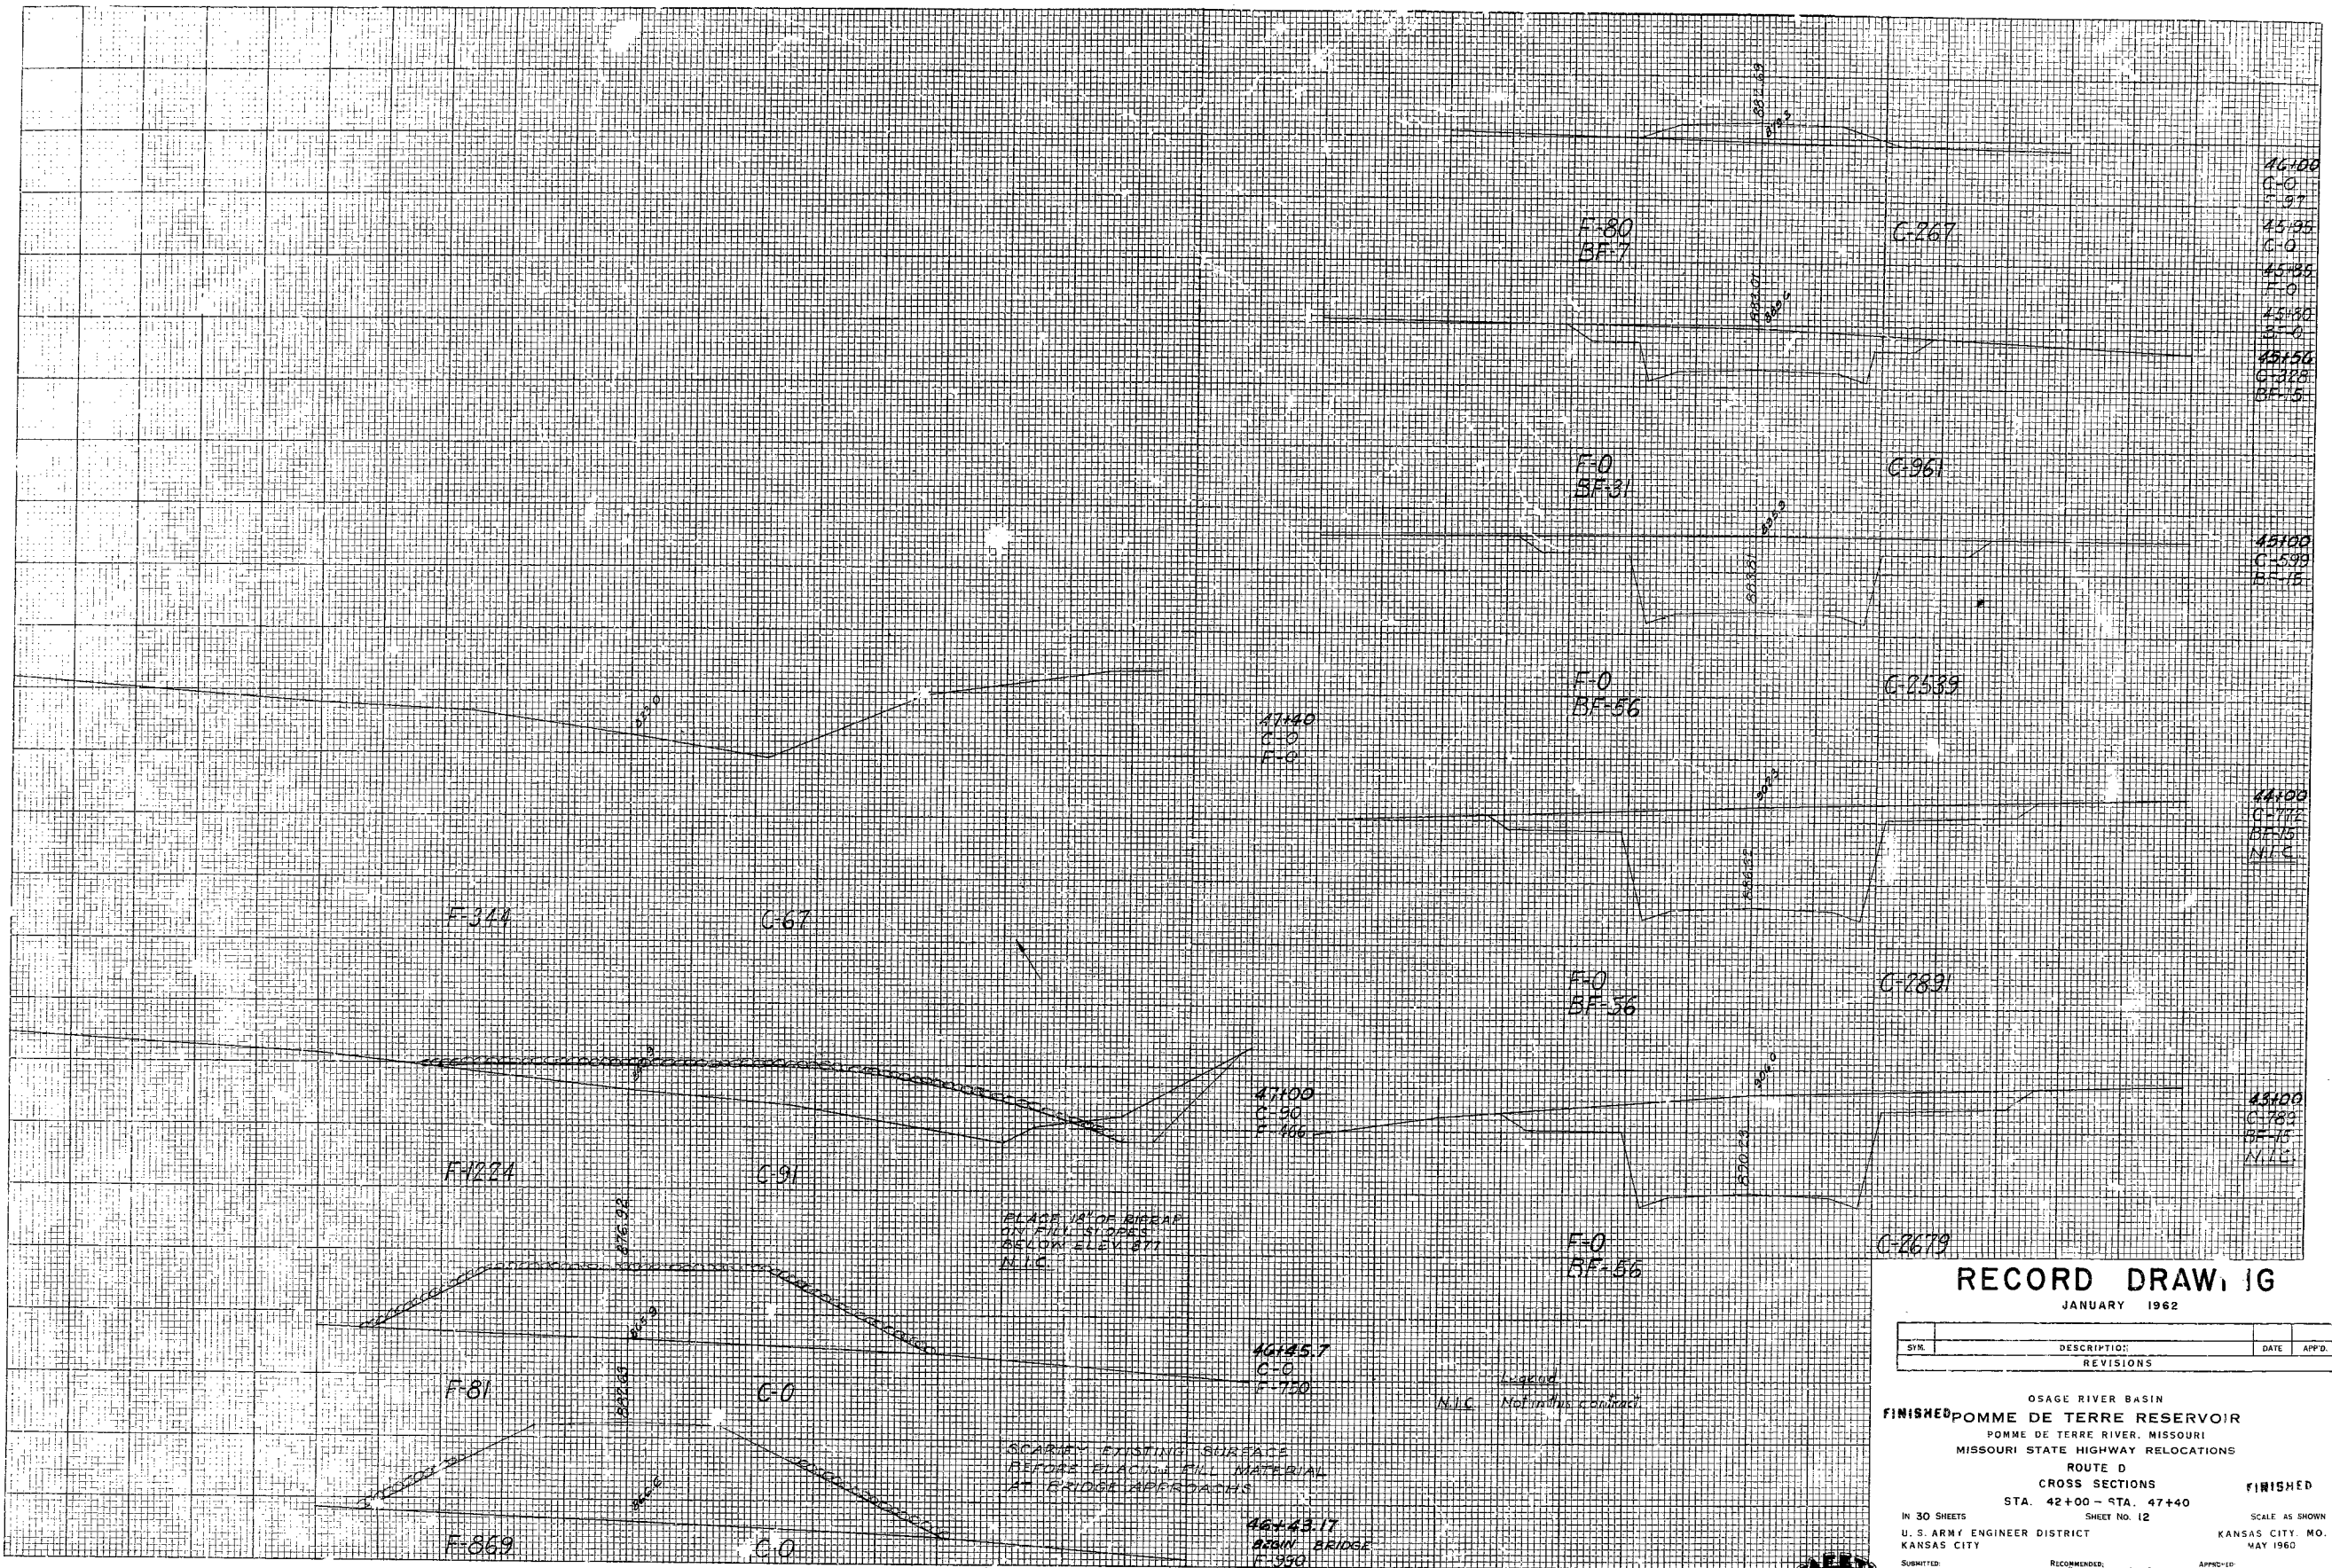

223

### RECORD DRAW, 1G

JANUARY 1962



SYN.	DESCRIPTION	DATE	APPD.
REVISIONS			

OSAGE RIVER BASIN  
**FINISHED** POMME DE TERRE RESERVOIR  
 POMME DE TERRE RIVER, MISSOURI  
 MISSOURI STATE HIGHWAY RELOCATIONS  
 ROUTE D  
 CROSS SECTIONS **FINISHED**  
 STA. 42+00 - STA. 47+40  
 SHEET NO. 12  
 SCALE AS SHOWN  
 U. S. ARMY ENGINEER DISTRICT KANSAS CITY, MO.  
 KANSAS CITY MAY 1960

SUBMITTED: *H.S. ...* RECOMMENDED: *H.S. ...* APPROVED: *H.S. ...*  
 CHIEF, PROJECTS DESIGN SPANCH CHIEF, ENGINEERING DIV. COL. CE. DISTRICT ENG.  
 DRAWN BY: *ECH* CHECKED BY: *J.W. HICKORY* FILE NO. 0-10-602

FINISHED 4 of 14



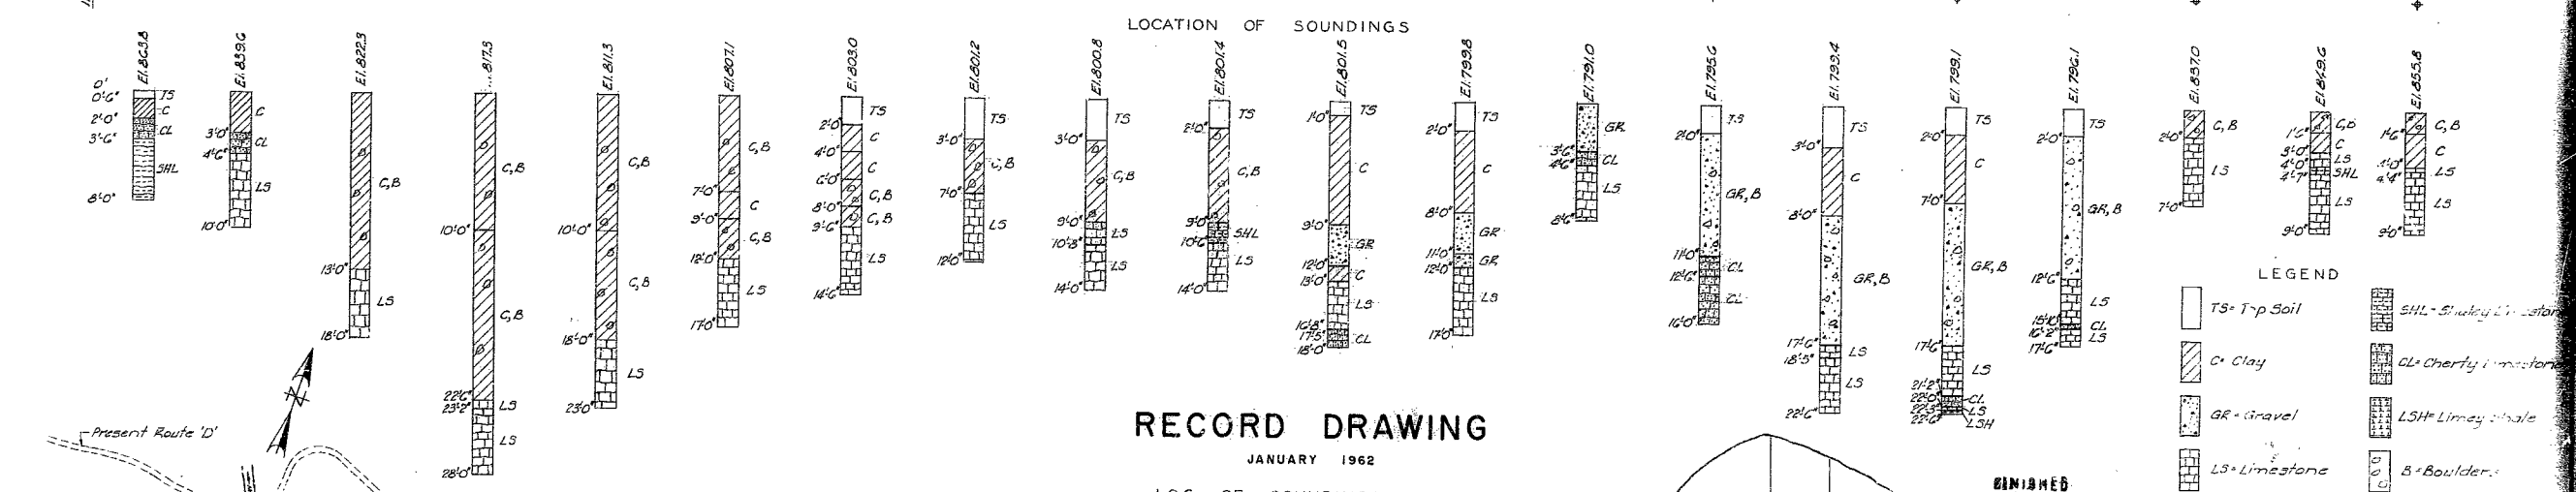
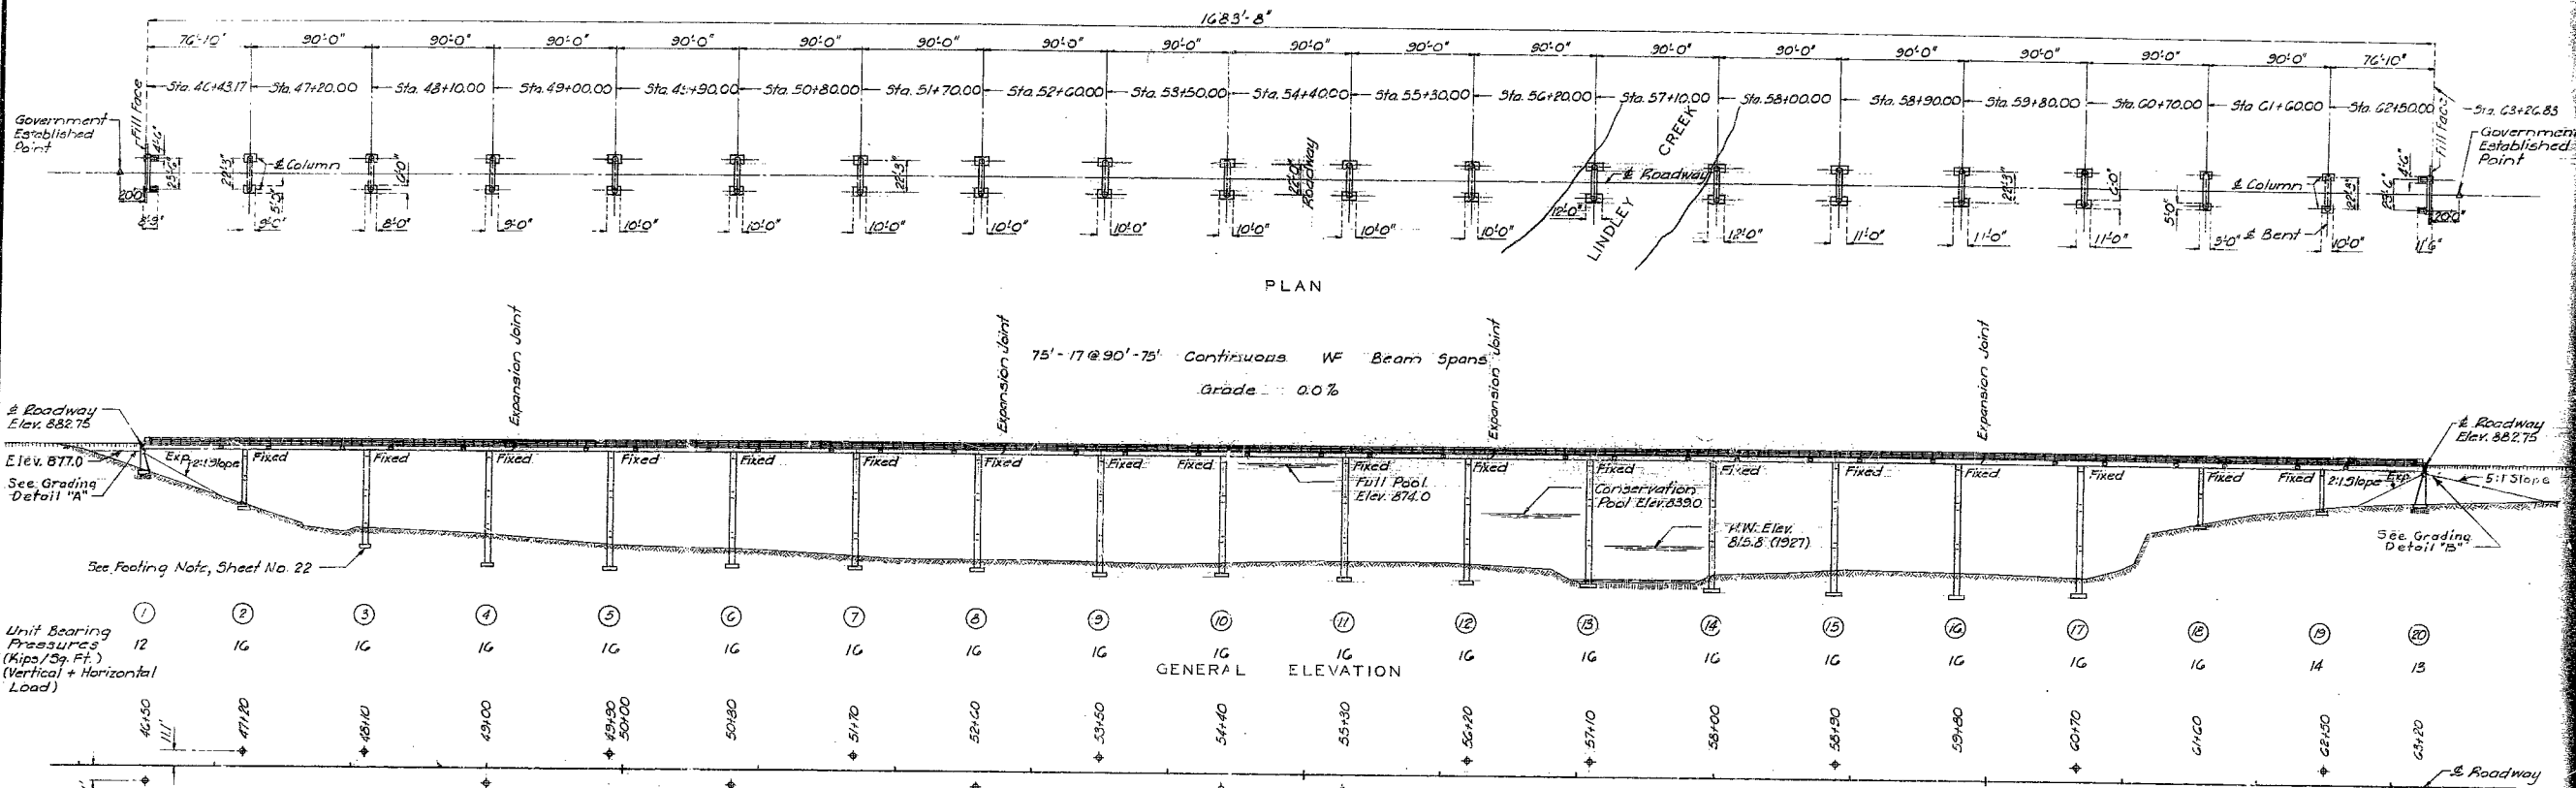


**RECORD DRAWING**  
JANUARY 1962  
LOG OF SOUNDINGS

ESTIMATED QUANTITIES			
Item	Substr.	Superstr.	Total
Class 1 Excavation for Structures	Cu. Yds.	1208.2	1208.2
Class 2 Excavation for Structures	Cu. Yds.	571.1	571.1
Reinforcing Steel	Lbs.	586,428	264,630
Steel Castings	Lbs.	—	2470
Fabricated Structural Steel	Lbs.	—	1,425,840
Concrete	Cu. Yds.	2185.2	3106.2
Portland Cement	Barrels	—	4,128
Painting on Structural Steel	Tons	714	714

Note: Excavation for bridge made above Elev. 793.0 will be paid for as Class 1 Excavation for Structures.  
Excavation for bridge made below Elev. 793.0 will be paid for as Class 2 Excavation for Structures.  
Estimated Excavation Quantities are computed from ground line elevations as shown or from Excavation Datum where Excavation Datum is above the ground line. The Contracting Officer shall determine actual ground elevations at each footing before the Contractor begins excavating. Actual ground elevations shall be used in computing excavation quantities for final payment.

NOTE: THIS DRAWING IS NOT TO SCALE. FOLLOW DIMENSIONS

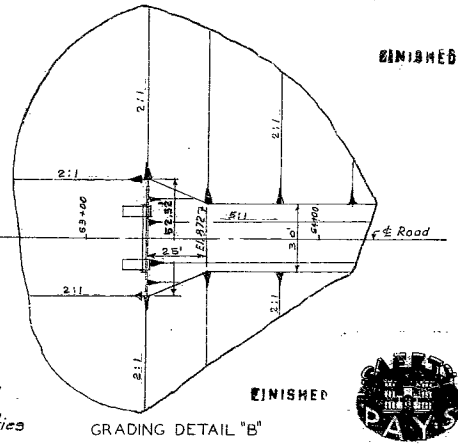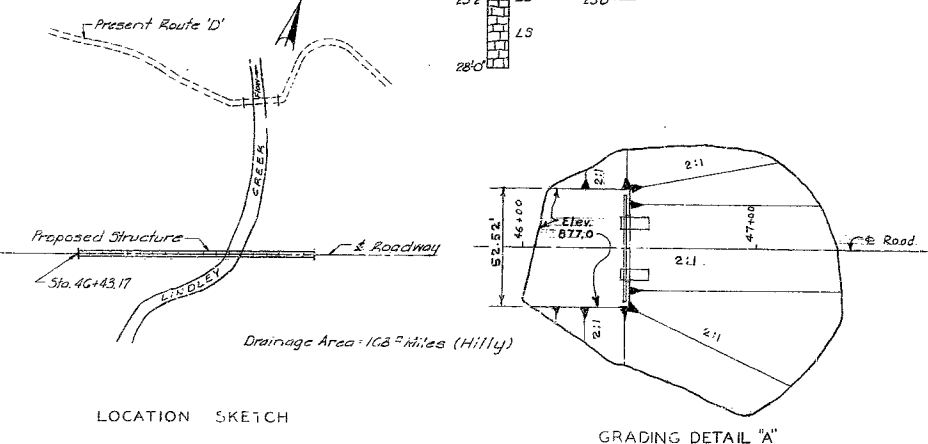

REV.	DESCRIPTION	DATE	APP'D.
1	Revised for as-built conditions	4-5-2	JLB
2	Rev. Substr. Conc. & Reinf. Steel Quantities	7-16-2	


OSAGE RIVER BASIN  
**POMME DE TERRE RESERVOIR**  
POMME DE TERRE RIVER, MISSOURI  
MISSOURI STATE HIGHWAY RELOCATIONS  
BRIDGE OVER LINDLEY CREEK  
PLAN, ELEVATION, AND SOUNDINGS FINISHED

IN 30 SHEETS SHEET NO. 21 SCALE: 1"=30'  
U. S. ARMY ENGINEER DISTRICT KANSAS CITY, MO. MAY 1960  
SUBMITTED BY: [Signature] RECOMMENDED BY: [Signature] APPROVED BY: [Signature]  
CHIEF, PROJECTS DESIGN BRANCH CHIEF, ENGINEERING DIV. COL. C.E. DISTRICT ENG.  
DRAWN BY: REH CHECKED BY: RHK FILE NO. 0-10-611

222

COMPLETE BILL OF REINFORCING STEEL

NO	SIZE	LENGTH	MARK	LOCATION
SUPERSTRUCTURE				
20	#5	4'-0"	C1	End Curb
25	#5	3'-5"	C2	"
4	#5	6'-0"	C3	End Curb
36	#5	26'-3"	C4	Curb 75'-0" Span
234	#6	31'-3"	C5	" 90'-0" Span
24	#6	17'-9"	C6	" 18'-0" Span
48	#6	36'-3"	C7	" 72'-0" Span
24	#4	3'-9"	R1	End Post
20	#5	7'-3"	R2	"
132	#5	24'-3"	S1	Slab
390	#5	29'-0"	S2	"
576	#5	20'-0"	S3	"
40	#5	2'-6"	S4	"
1521	#5	29'-3"	S5	"
468	#5	28'-9"	S6	"
END BENT NO. 1				
20	#6	4'-0"	D1	Footing
8	#6	8'-0"	F1	Col. Haunch
8	#6	8'-0"	F2	"
2	#6	26'-3"	H1	Backwall
2	#4	26'-3"	H2	"
3	#6	30'-0"	H3	Beam
2	#6	28'-0"	H4	"
8	#11	28'-0"	H5	"
2	#4	29'-0"	H6	Backwall
18	#6	10'-0"	H7	Wing
4	#6	19'-0"	H8	"
4	#6	19'-0"	H9	"
4	#6	19'-0"	H10	"
20	#3	15'-9"	P1	Column
4	#6	19'-0"	T1	Wing
29	#5	11'-9"	U1	Beam
10	#4	3'-3"	U2	"
46	#4	6'-0"	V1	Backwall
12	#4	7'-0"	V2	"
7	#4	14'-0"	V3	Wing
12	#6	14'-6"	V4	Column
8	#6	14'-3"	V5	"
8	#4	11'-3"	V6	"
8	#2	19'-9"	W1	A.B. Wall
INTERMEDIATE BENTS NO. 2, 18 & 19				
36	#8	6'-3"	D15	Footing Bt. 2418
56	#8	4'-3"	D16	"
48	#11	8'-3"	D17	"
32	#11	12'-0"	D18	"
18	#8	9'-3"	D19	" 19
16	#6	22'-3"	G1	Cap & Tie Beam
30	#11	28'-9"	G2	Cap
12	#6	16'-6"	G3	"
8	#9	25'-0"	G4	Tie Beam 2418
12	#9	24'-3"	G7	" 2418
16	#11	17'-9"	P22	Column 2418
16	#11	23'-9"	P23	" 2418
16	#11	26'-3"	P24	" 2
16	#11	26'-11"	P25	" 18
8	#11	29'-3"	P26	" 19
8	#11	35'-3"	P27	" 19
202	#5	6'-9"	P28	"
12	#11	15'-9"	P29	"
224	#5	15'-3"	U3	Cap
40	#4	10'-9"	U5	Tie Beam 2418
72	#3	10'-6"	W2	A.B. Spirals

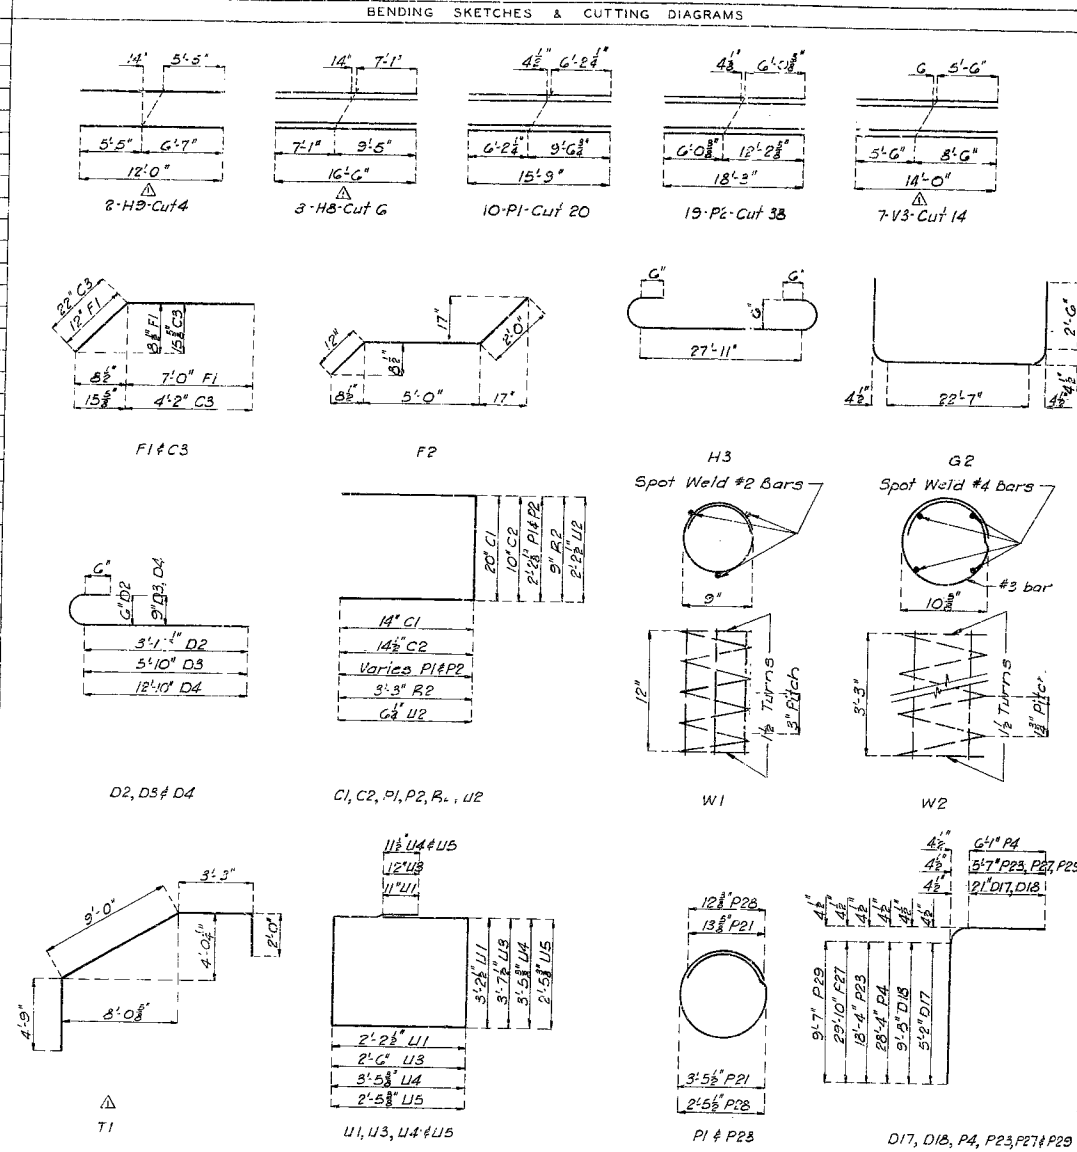

NO.	SIZE	LENGTH	MARK	LOCATION
INTERMEDIATE BENTS NO. 3 THRU 17				
360	#11	8'-9"	D3	Footing
100	#11	14'-6"	D4	"
22	#6	7'-3"	D5	" Bt 3
22	#6	8'-3"	D6	" 4
88	#7	9'-3"	D7	" 5,6,7,8
44	#9	11'-3"	D8	" 13,14
34	#6	5'-3"	D10	" 3,4
80	#7	5'-3"	D11	" 5,6,7,8
144	#8	5'-3"	D12	" 9,10,11,12,13,16,17
88	#8	9'-3"	D13	" 9,10,11,12
44	#8	10'-9"	D14	" 15,16,17
48	#9	5'-3"	D9	" 13,14
90	#6	22'-3"	G1	Cap & Tie Beam
120	#11	28'-9"	G2	Cap
90	#6	16'-6"	G3	"
300	#9	25'-0"	G4	Tie Beam
120	#9	25'-0"	G5	"
180	#11	27'-8"	P3	Column
180	#11	34'-2"	P4	"
312	#11	32'-9"	P5	" 5 thru 17
48	#11	27'-9"	P6	" 3 & 4
24	#11	19'-9"	P7	" 3
24	#11	32'-9"	P8	" 4
24	#11	29'-9"	P9	" 5
24	#11	27'-9"	P10	" 6
24	#11	51'-9"	P11	" 9
24	#11	30'-9"	P12	" 10
24	#11	33'-9"	P13	" 11
24	#11	34'-9"	P14	" 12
24	#11	35'-9"	P15	" 13
24	#11	38'-9"	P16	" 14
24	#11	42'-9"	P17	" 15
24	#11	41'-9"	P18	" 16
24	#11	39'-9"	P19	" 17
48	#11	28'-9"	P20	" 7 & 8
24	#5	12'-0"	P21	"
END BENT NO. 20				
20	#7	5'-3"	D2	Footing
8	#6	8'-0"	F1	Col. Haunch
8	#6	8'-0"	F2	"
2	#6	26'-3"	H1	Backwall
2	#4	26'-3"	H2	"
3	#6	30'-0"	H3	Beam
2	#6	28'-0"	H4	"
8	#11	28'-0"	H5	"
2	#4	29'-0"	H6	Backwall
18	#6	10'-0"	H7	Wing
3	#6	16'-6"	H8	"
2	#6	12'-0"	H9	"
4	#6	19'-0"	H10	Backwall
38	#3	18'-3"	P2	Column
4	#6	19'-0"	T1	Wing
29	#5	11'-9"	U1	Beam
10	#4	3'-3"	U2	"
46	#4	6'-0"	V1	Backwall
12	#4	7'-0"	V2	"
7	#4	14'-0"	V3	Wing
12	#6	14'-6"	V4	Column
8	#6	14'-3"	V5	"
8	#4	11'-3"	V6	"
8	#2	19'-9"	W1	A.B. Wall

GENERAL NOTES:

Design Specifications: A.A.S.H.O. - 1957 (Modified to permit a shape factor in computing wind on round columns) and Criteria for Prestressed Concrete Edg. S.

Loading: H15-512-44

Structural Steel Stress: 18,000 #/sq"

Reinforcing Steel Stress: 20,000 #/sq" Tension

16,000 #/sq" Compression

Prestressing Steel Stress: 116,000 #/sq" Initial

87,000 #/sq" Final

Concrete Stress: 1200 #/sq"

Rivets #4 holes 1/2" except where otherwise noted.

Qualification of welding operators will be required.

Field connections except as noted in handrail details bolted with high tensile bolts. Final pay weight for fabricated structural steel will be based on the use of field rivets except for bolted connections specified for handrail.

Paint: Shop, none; Field, contact surfaces of bolted field connections one coat of red lead. All other exposed surfaces first coat red lead, second coat brown, third coat aluminum. Payment for cleaning and all painting will be made under unit price bid for painting.

All loose, shelly or disintegrated rock shall be removed and the footings placed on or into hard, solid, undisturbed rock. If soft rock or shale is encountered, the footings shall be carried at least 18" into and cast against vertical faces of same.

FINISHED

RECORD DRAWING

JANUARY 1962

SYL	DESCRIPTION	DATE	APPD.
	Revised for as-built conditions	1-2-62	REB
	Changed bars H7, H8, H9, T1 and V3	1-2-62	REB
	REVISION		

OSAGE RIVER BASIN

POMME DE TERRE RESERVOIR

POMME DE TERRE RIVER, MISSOURI

MISSOURI STATE HIGHWAY RELOCATIONS

BRIDGE OVER LINDLEY CREEK

BILL OF REINFORCING STEEL

FINISHED

IN 30 SHEETS SHEET NO. 22 SCALE AS SHOWN

U. S. ARMY ENGINEER DISTRICT KANSAS CITY, MO MAY 1960

SUBMITTED: [Signature] RECOMMENDED: [Signature] APPROVED: [Signature]

CHIEF, PROJECTS DESIGN BRANCH CHIEF, ENGINEERING DIV. COL., U.S. DISTRICT ENG.


DRAWN BY: REH. CHECKED BY: REH. R.H.K. H.C.A.S. 1-2-62 0-10-612

PRICHARD COMPANY, INDEPENDENCE, MISSOURI


522

Note: All dimensions are center to center.

NOTE: THIS DRAWING IS NOT TO SCALE. FOLLOW DIMENSIONS

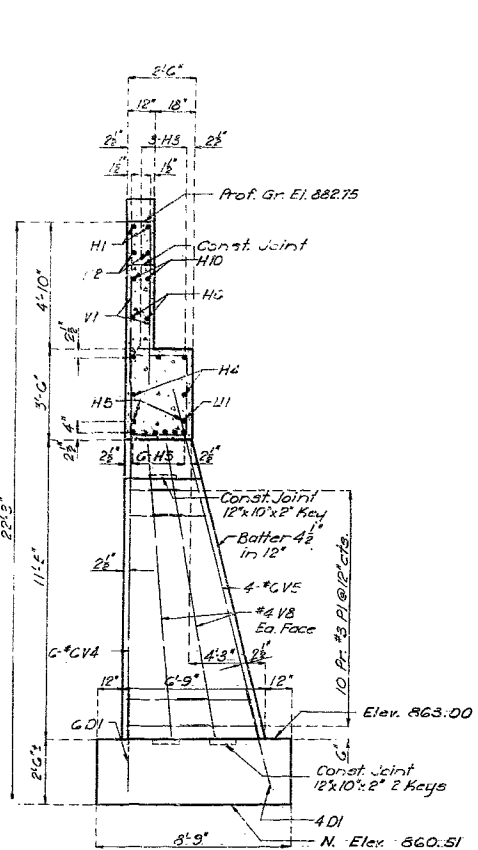


SECTION AT END BENT NO. 1

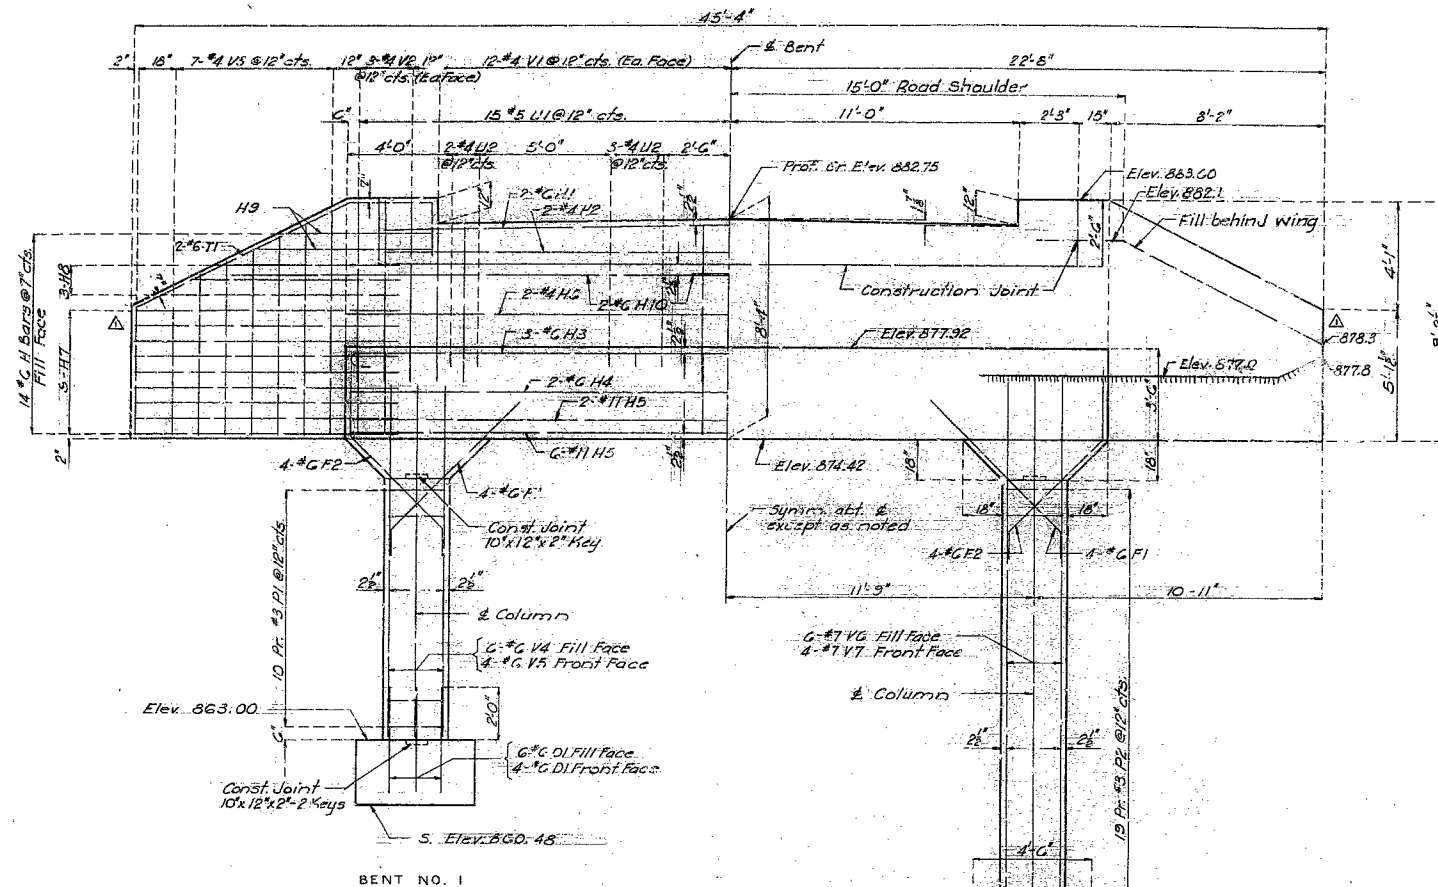

BENT NO. 1


Note: Top of backwall and expansion device shall conform to crown and grade of roadway slab.  
 Backwall above construction joint shall not be poured until the structural steel of the expansion device has been installed and slab has been poured in adjacent span.  
 Fill at the end bents shall not be carried above elevation 877.0 until superstructure span (1-2) and span (18-20) is in place.

ELEVATION

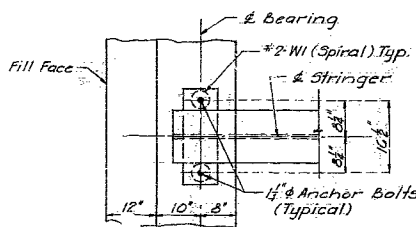


PART ANCHOR BOLT PLAN

1 20

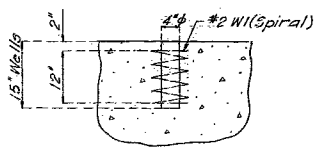

Note: Anchor bolts set in wells as shown. See Specifications for setting Anchor Bolts.

DETAIL OF SPIRAL AROUND ANCHOR BOLTS

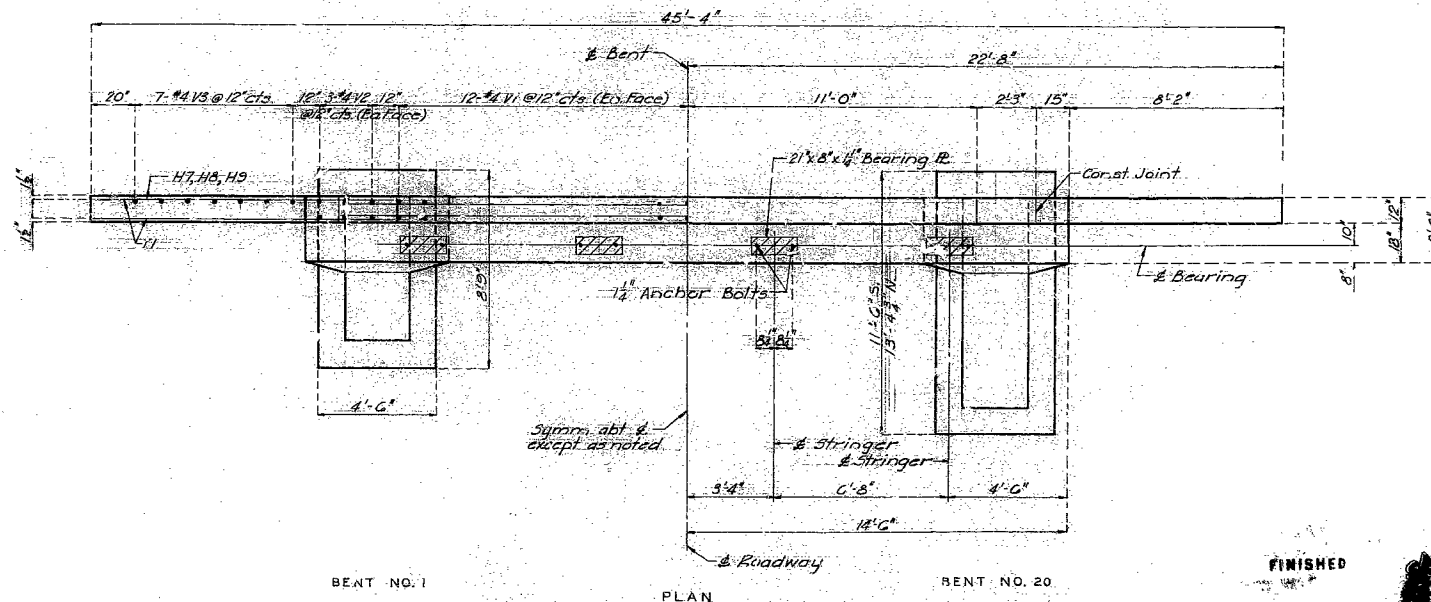


BENT NO. 1

PLAN

BENT NO. 20

DETAILS OF END BENTS NO. 1 & NO. 20

NOTE: THIS DRAWING IS NOT TO SCALE. FOLLOW DIMENSIONS

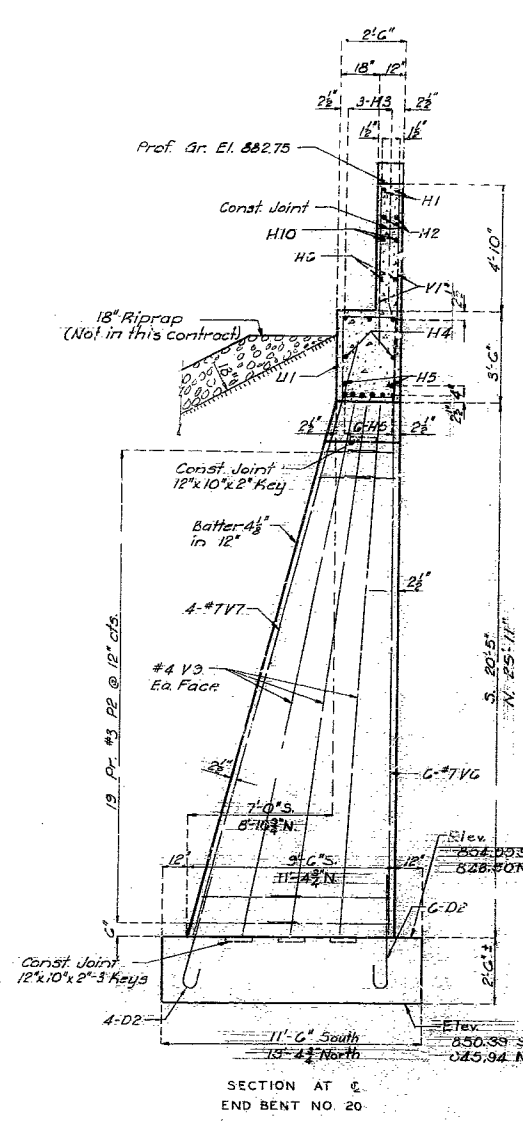

SECTION AT END BENT NO. 20

ESTIMATED QUANTITIES FOR BENTS 1 AND 20

Bent No.	Concrete	Reinf. Steel	Excavation	
			Class 1	Class 2
1	3060 cu yds	3832 lbs.	-	-
20	602 cu yds	4707 lbs.	-	-

FINISHED

**RECORD DRAWING**

JANUARY 1962

SYMBOL	DESCRIPTION	DATE	APP'D.
(A)	Revised for as-built conditions	1-12-62	J.E.B.
(B)	1/2-1 Wing Slope Changed to 2:1 Slope	7-14-60	

OSAGE RIVER BASIN

POMME DE TERRE RESERVOIR  
 POMME DE TERRE RIVER, MISSOURI  
 MISSOURI STATE HIGHWAY RELOCATIONS  
 BRIDGE OVER LINDLEY CREEK  
 DETAILS OF END BENTS 1 AND 20


FINISHED

IN 30 SHEETS SHEET NO. 23 SCALE: NOT KNOWN  
 U. S. ARMY ENGINEER DISTRICT KANSAS CITY, MO. MAY 1960  
 SUBMITTED: H. H. GARDNER, CHIEF, PROJECTS DESIGN BRANCH  
 RECOMMENDED: R. H. HICKORY, CHIEF, ENGINEERING DIV.  
 APPROVED: E. G. LAWRENCE, COL., C.E. DISTRICT ENGINEER  
 DRAWN BY: REH. CHECKED BY: REH. R.H.K. HICKORY




226




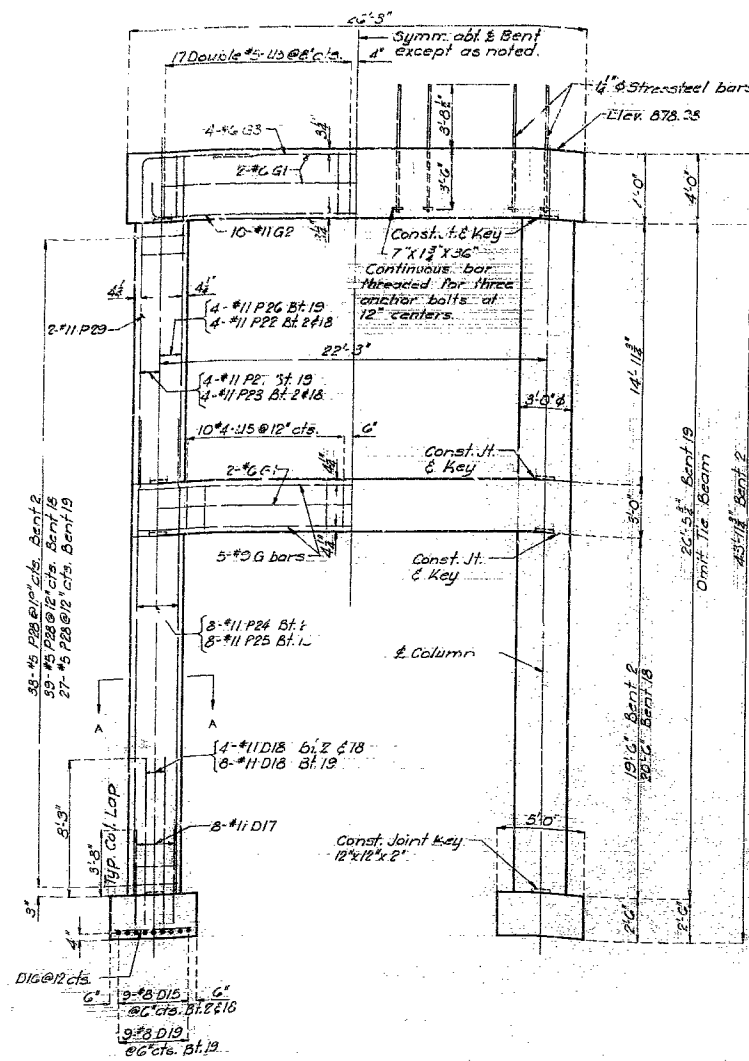

ELEVATION

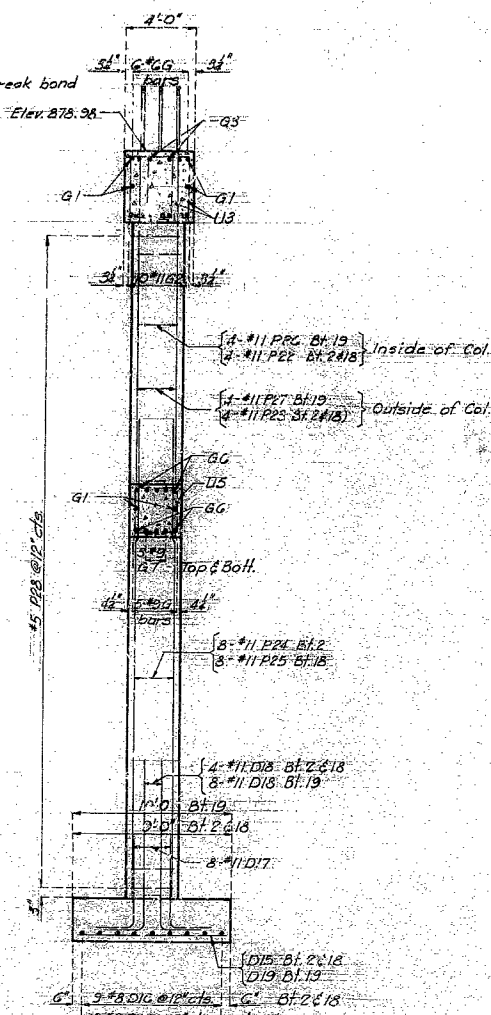


SECTION AT E

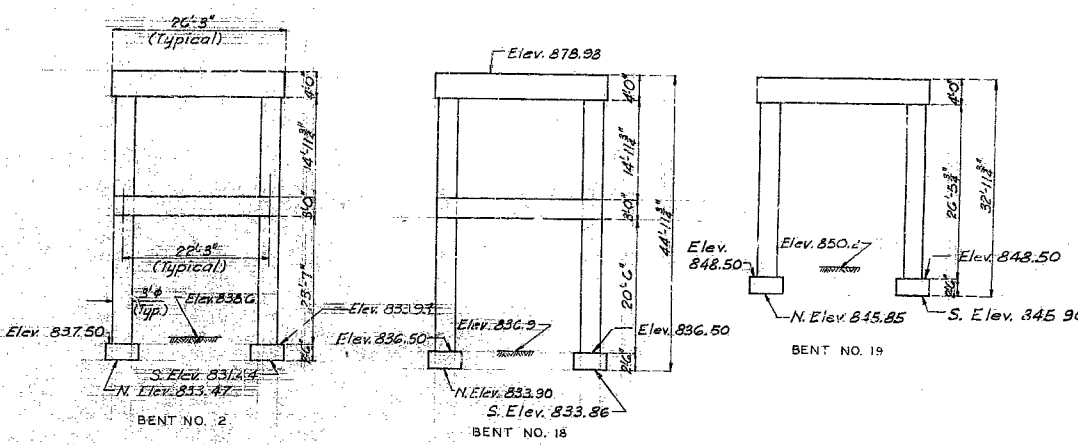


ESTIMATED QUANTITIES FOR BENTS 2, 18 & 19


Bent No.	Concrete	Reinf. Steel	Excavation	
			Class 1	Class 2
2	53.1 Cu Yds	114,225 Lbs.		
18	50.55 "	116,000 "		
19	38.64 "	9507 "		

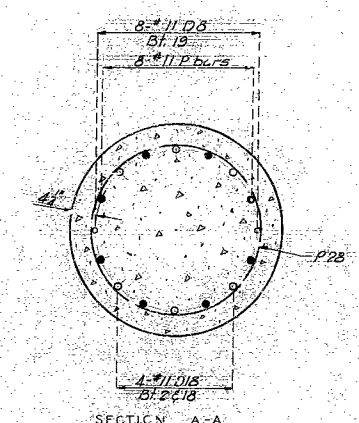

SECTION A-A

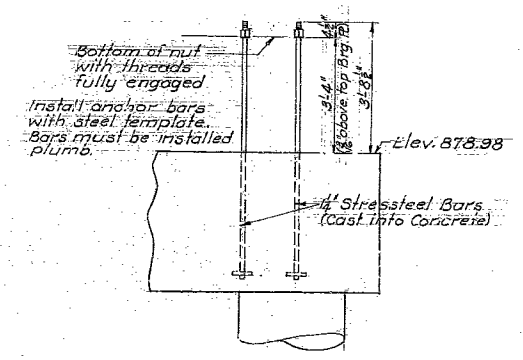

PLACING DETAIL FOR ANCHOR BARS (For all intermediate bents)

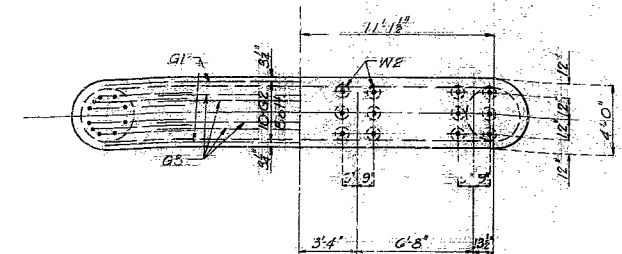

PLAN

DETAILS OF INTERMEDIATE BENTS NO. 2, 18, 19

NOTE: THIS DRAWING IS NOT TO SCALE. FOLLOW DIMENSIONS.

FINISHED  
**RECORD DRAWING**

JANUARY 1962

SYN.	DESCRIPTION	DATE	APP'D.
	Revised for As Built conditions.	1-3-62	71KB

OSAGE RIVER BASIN  
**POMME DE TERRE RESERVOIR**  
 POMME DE TERRE RIVER, MISSOURI  
 MISSOURI STATE HIGHWAY RELOCATIONS  
 BRIDGE OVER LINDLEY CREEK  
 DETAILS OF INTERMEDIATE BENTS 2, 18, 19 FINISHED


IN 30 SHEETS SHEET NO. 24 SCALE NONE  
 U. S. ARMY ENGINEER DISTRICT KANSAS CITY, MO. MAY 1960  
 SUBMITTED: *[Signature]* APPROVED: *[Signature]*  
 CHIEF, PROJECTS DESIGN BRANCH CHIEF, ENGINEERING DIV. COL., C.E. DISTRICT EN.  
 DRAWN BY: *[Signature]* CHECKED BY: *[Signature]*  
 REH REH REK HICKORY 1-2-62 P.E. NO. 0-10-614




PRICHARD COMPANY, INC. INDEPENDENCE, MISSOURI

227


651 79-1

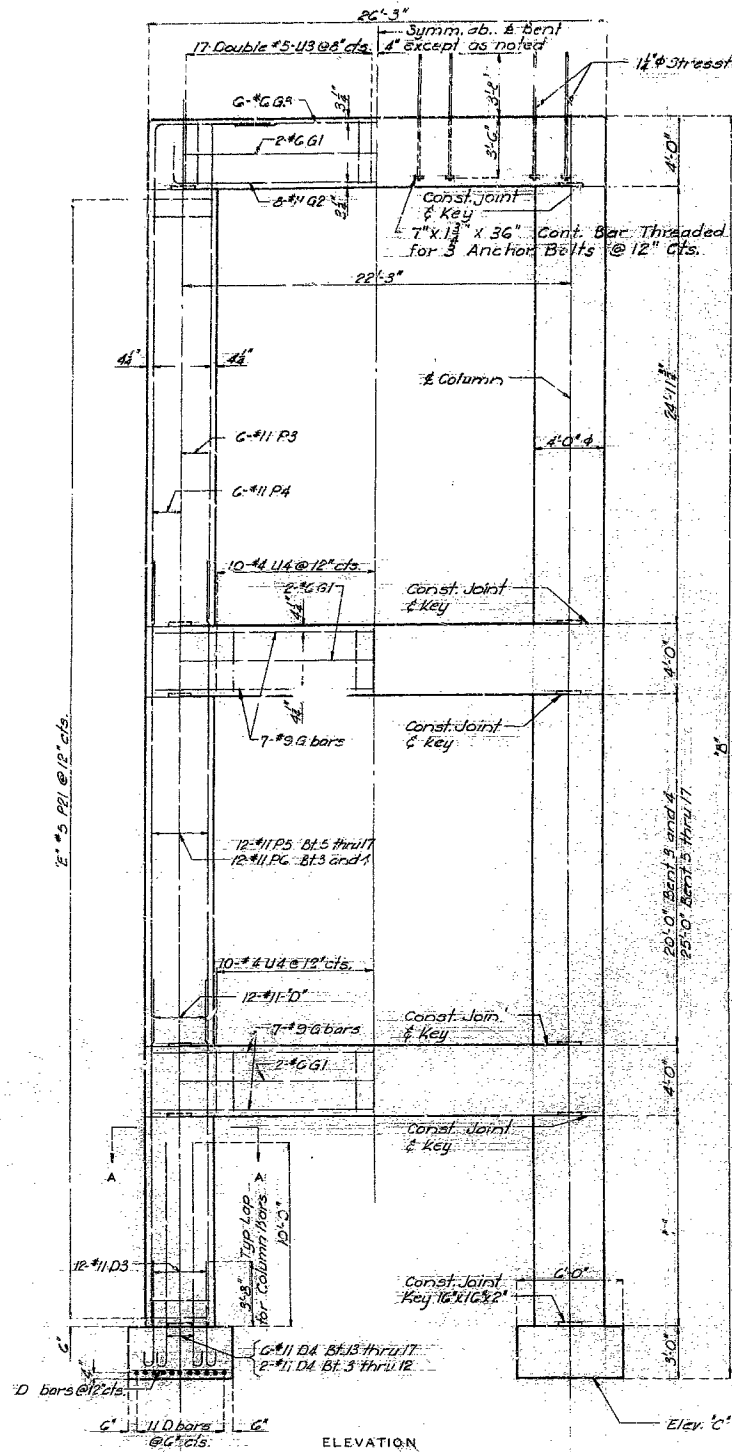


ELEVATION

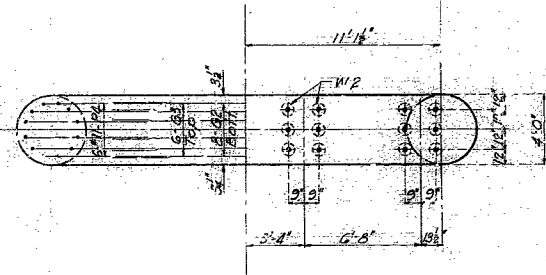


PLAN

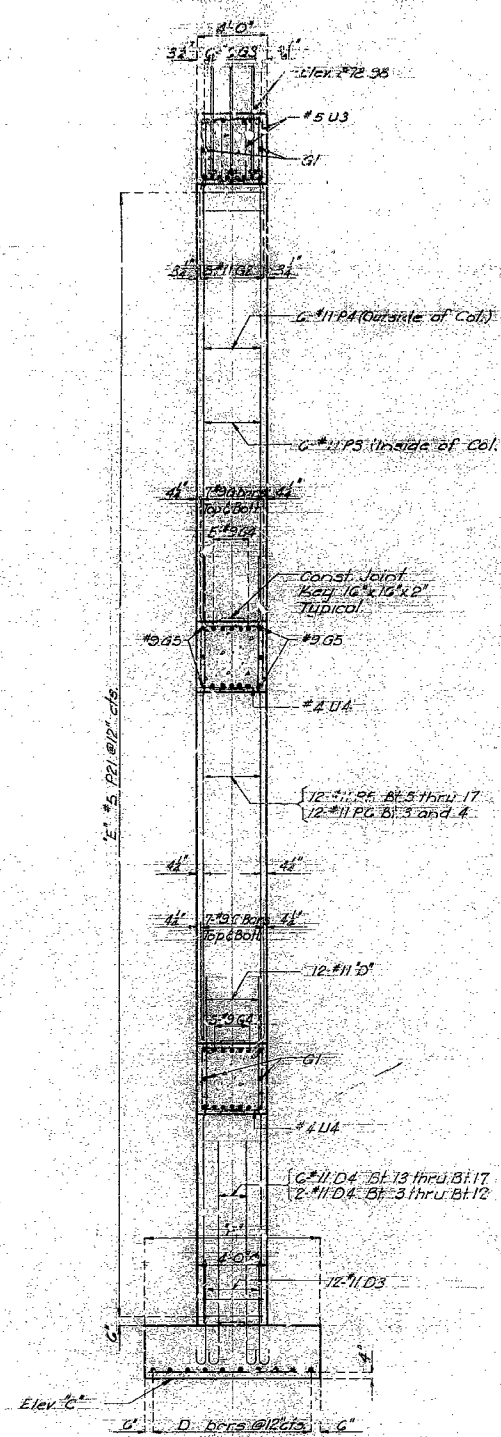

SECTION A-A

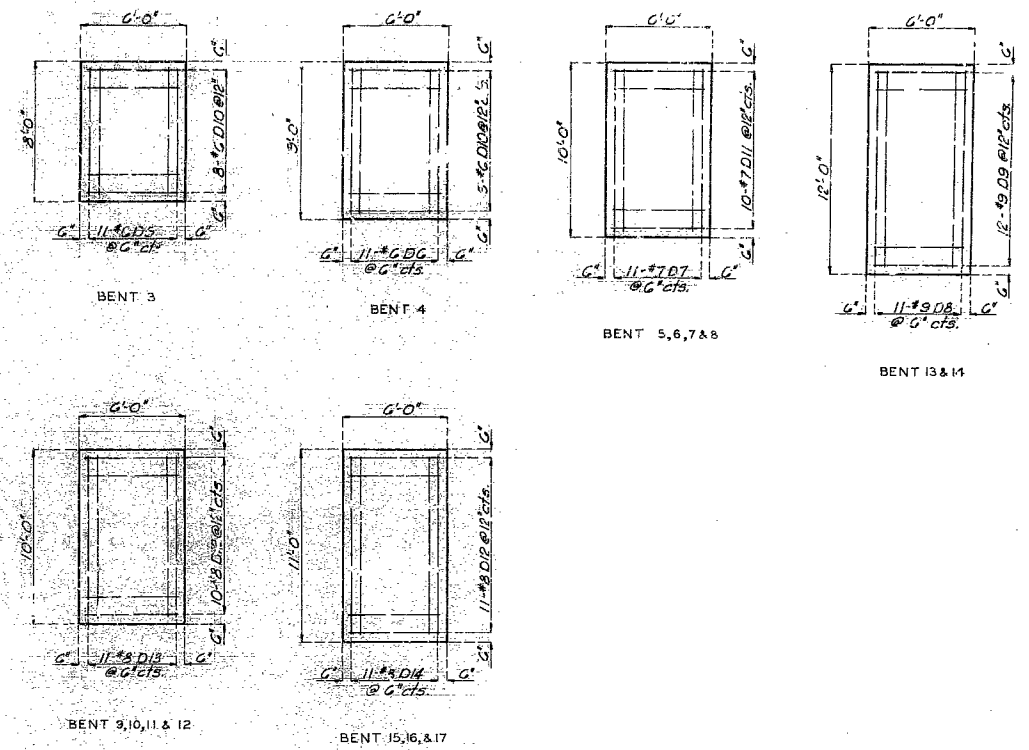

DETAILS OF FOOTINGS

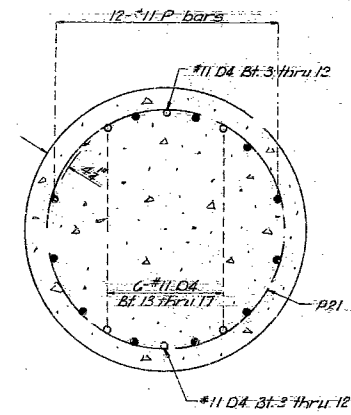

SECTION A-A

DETAILS OF INTERMEDIATE BENTS NO. 3 THRU 17

### RECORD DRAWING

FINISHED

JANUARY 1962

Revised for As Built Conditions

SYL.	DESCRIPTION	DATE	APPD.

OSAGE RIVER BASIN  
**POMME DE TERRE RESERVOIR**  
 POMME DE TERRE RIVER, MISSOURI  
 MISSOURI STATE HIGHWAY RELICATIONS  
 BRIDGE OVER LINDLEY CREEK  
 DETAILS OF INTERMEDIATE BENTS 3 THRU 17



IN 30 SHEETS SHEET NO. 25 SCALE NONE  
 U. S. ARMY ENGINEER DISTRICT KANSAS CITY, MO. JAN 1960  
 KANSAS CITY, MO. JAN 1960  
 SUBMITTED: *H. E. ...* RECOMMENDED: *R. H. ...* APPROVED: *R. E. ...*  
 CHIEF, PROJECTS DESIGN BRANCH CHIEF, ENGINEER, KS DIV. COL., C.E., DISTRICT ENG.  
 DRAWN BY: *REH* CHECKED BY: *R.H.K. HICKORY* 1094 0-10-615  
 TRACED BY: *REH*



PRICHARD COMPANY, INC. INDEPENDENCE, MISSOURI

228

NOTE: THIS DRAWING IS NOT TO SCALE. FOLLOW DIMENSIONS.

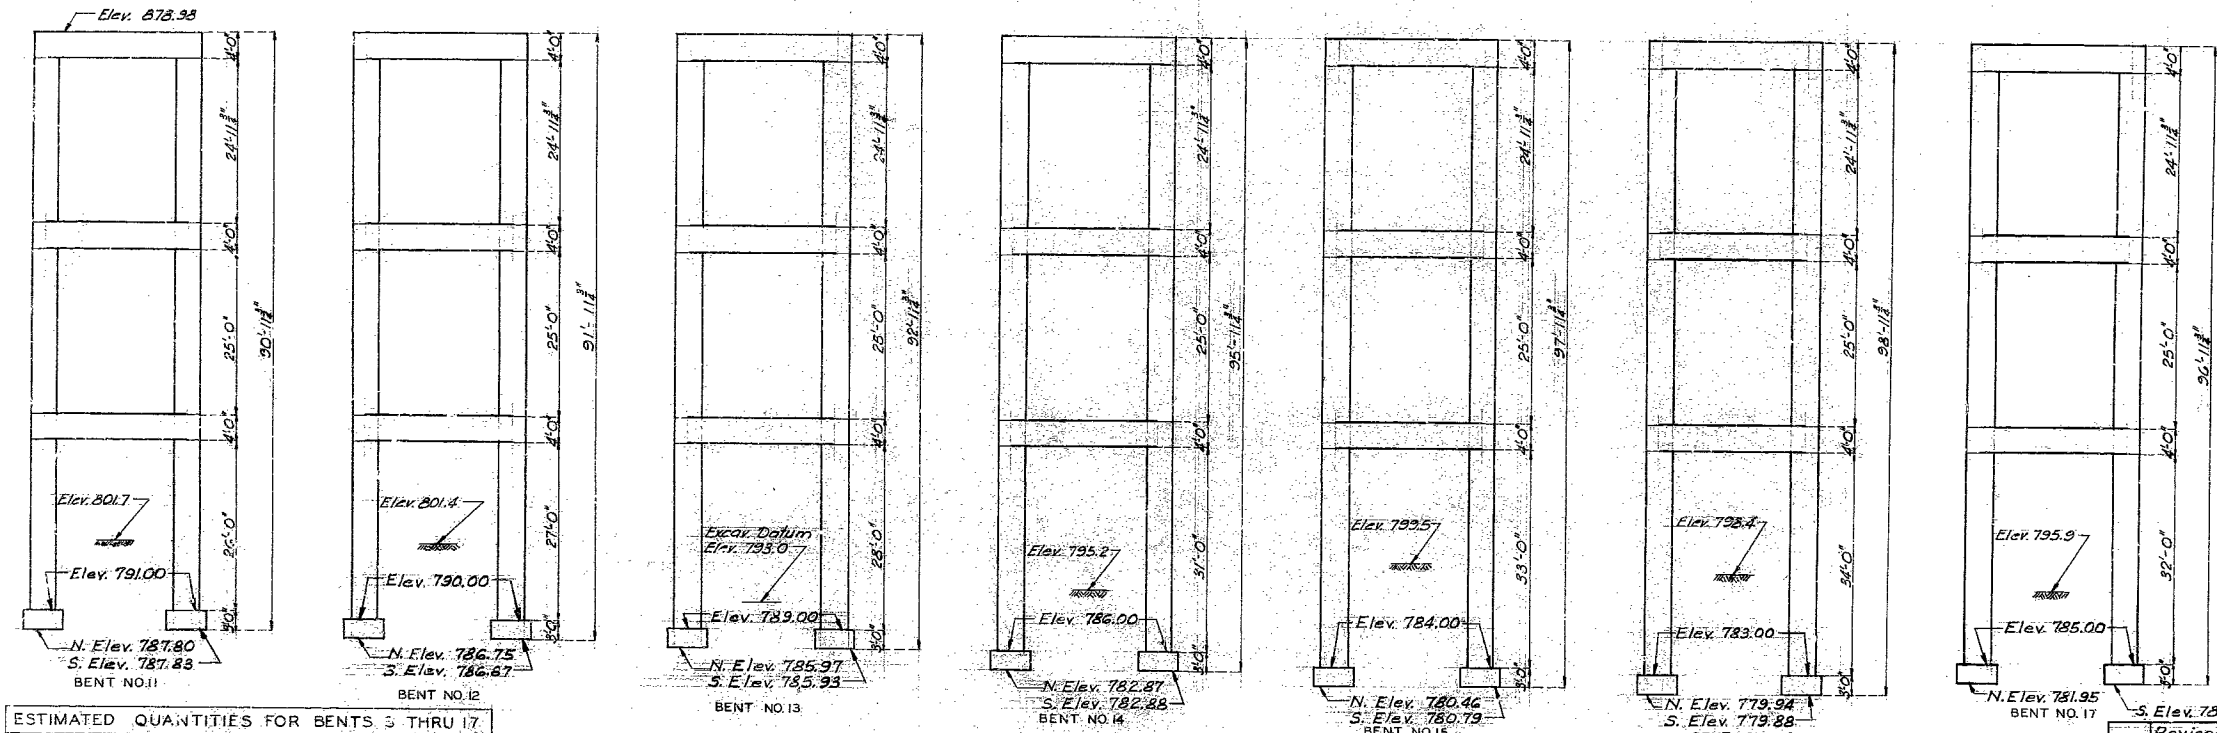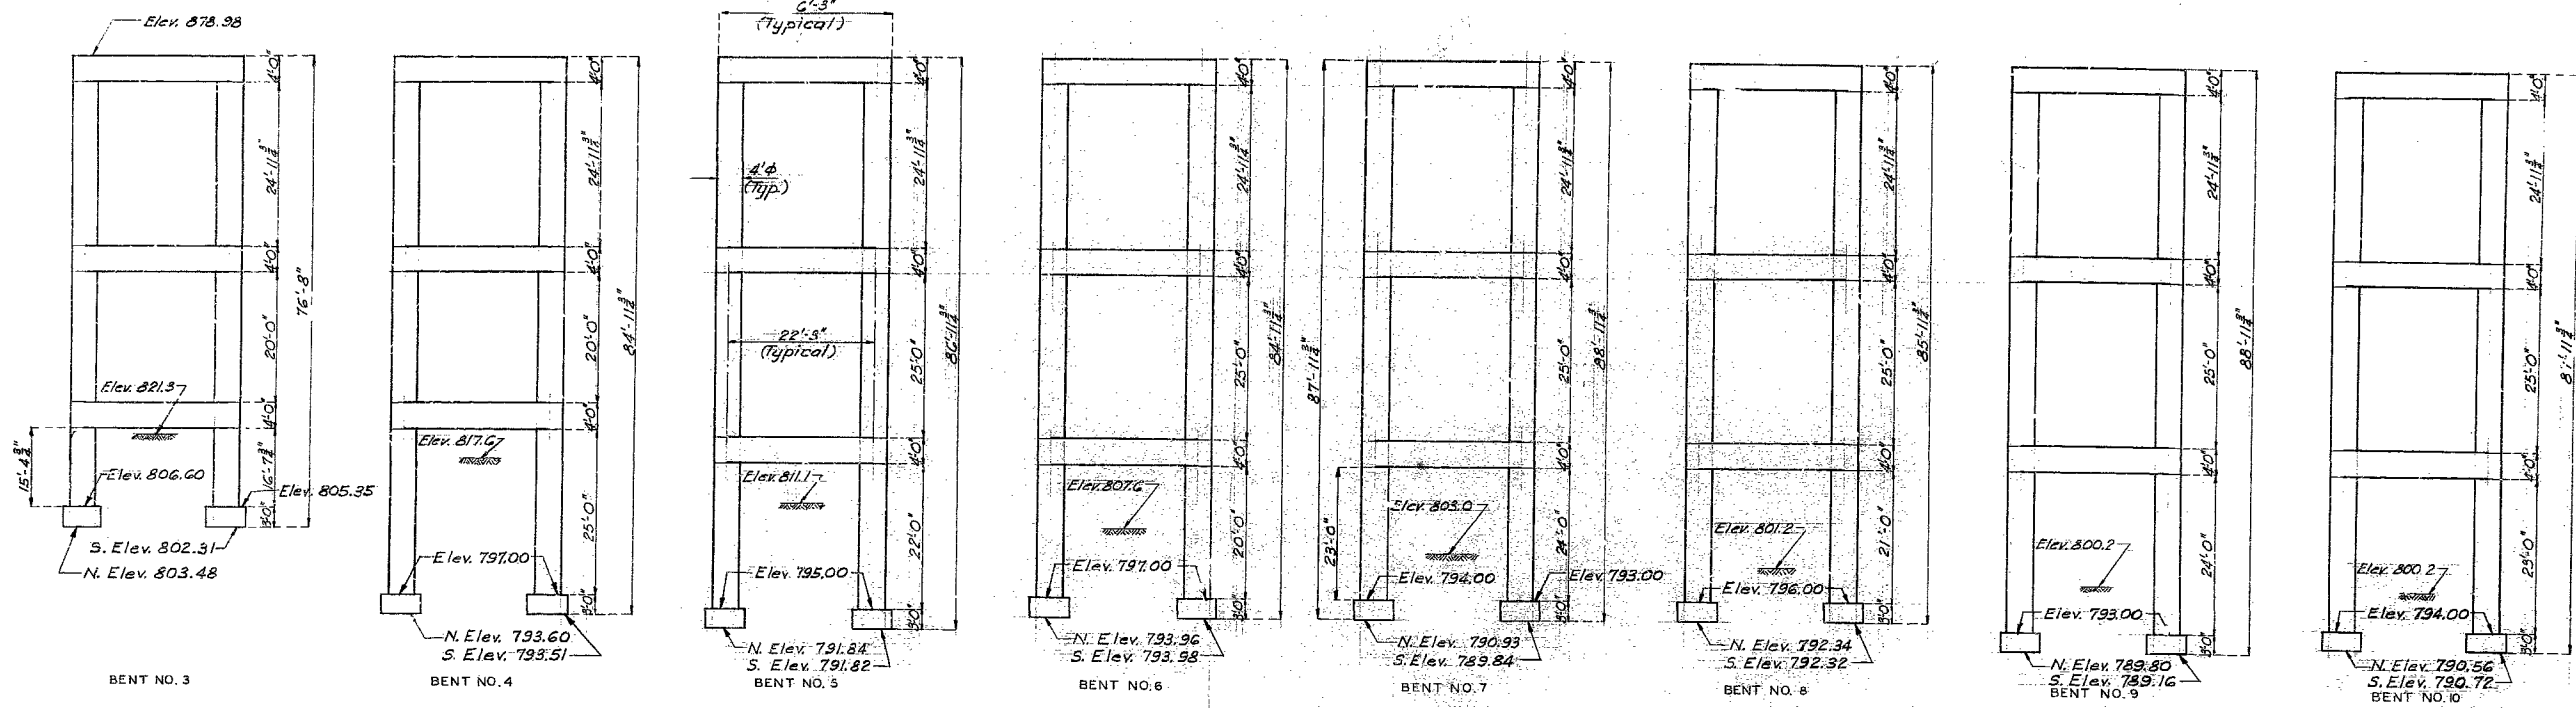

N = North  
S = South

ESTIMATED QUANTITIES FOR BENTS 3 THRU 17

Bent No.	Concrete	Rein. Steel	Excavation	
			Class 1	Class 2
3	112.81 Cu Yds	19462 Lbs		
4	124.08	21493		
5	126.23	22015		
6	123.36	21710		
7	127.45	21862		
8	128.51	21862		
9	129.65	22513		
10	128.00	22361		
11	130.01	22816		
12	130.97	22971		
13	134.00	24186		
14	137.118	24243		
15	138.88	24589		
16	138.42	24741		
17	137.05	24437		

DETAILS OF INTERMEDIATE BENTS NO. 3 THRU 17

FINISHED  
RECORD DRAWING

JANUARY 1962

SYN	DESCRIPTION	DATE	APP'D.
	Revised for As Built conditions	4-13-63	712P
REVISIONS			

OSAGE RIVER BASIN  
POMME DE TERRE RESERVOIR  
POMME DE TERRE RIVER, MISSOURI  
MISSOURI STATE HIGHWAY RELOCATIONS  
BRIDGE OVER LINDLEY CREEK  
DETAILS OF INTERMEDIATE BENTS 3 THRU 17

IN 30 SHEETS SHEET NO. 26 SCALE: 1"=10'

U. S. ARMY ENGINEER DISTRICT KANSAS CITY, MO. MAY 1960

APPROVED: *[Signature]* COL. C. E. DISTRICT ENG.

RECOMMENDED: *[Signature]* CHIEF, ENGINEERING DIV.

CHIEF, PROJECTS DESIGN BRANCH

TRACED BY: *[Signature]* CHECKED BY: *[Signature]*

DESIGNED BY: *[Signature]* DRAWN BY: *[Signature]*

PRICHARD COMPANY, INC. INDEPENDENCE, MISSOURI

229

NOTE: THIS DRAWING IS NOT TO SCALE. FOLLOW DIMENSIONS.

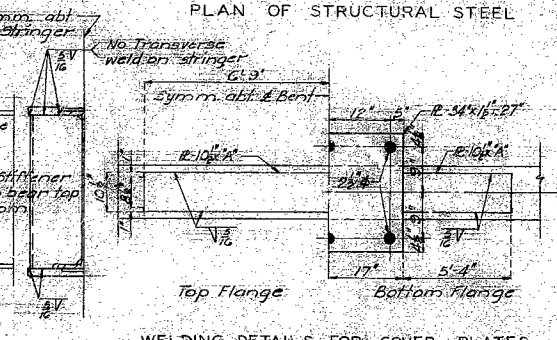
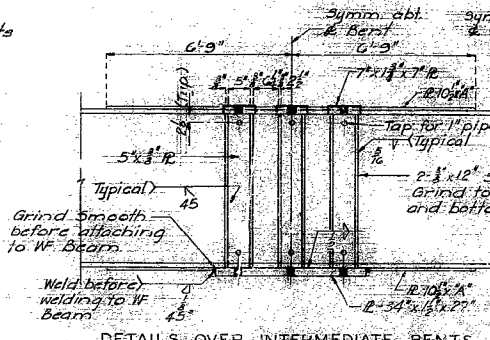
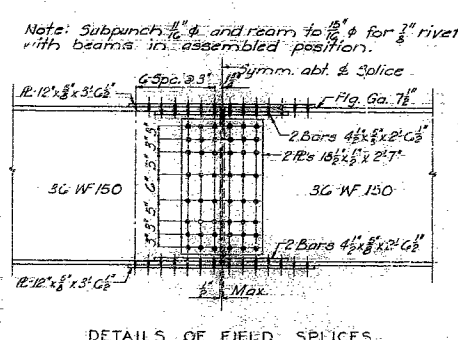
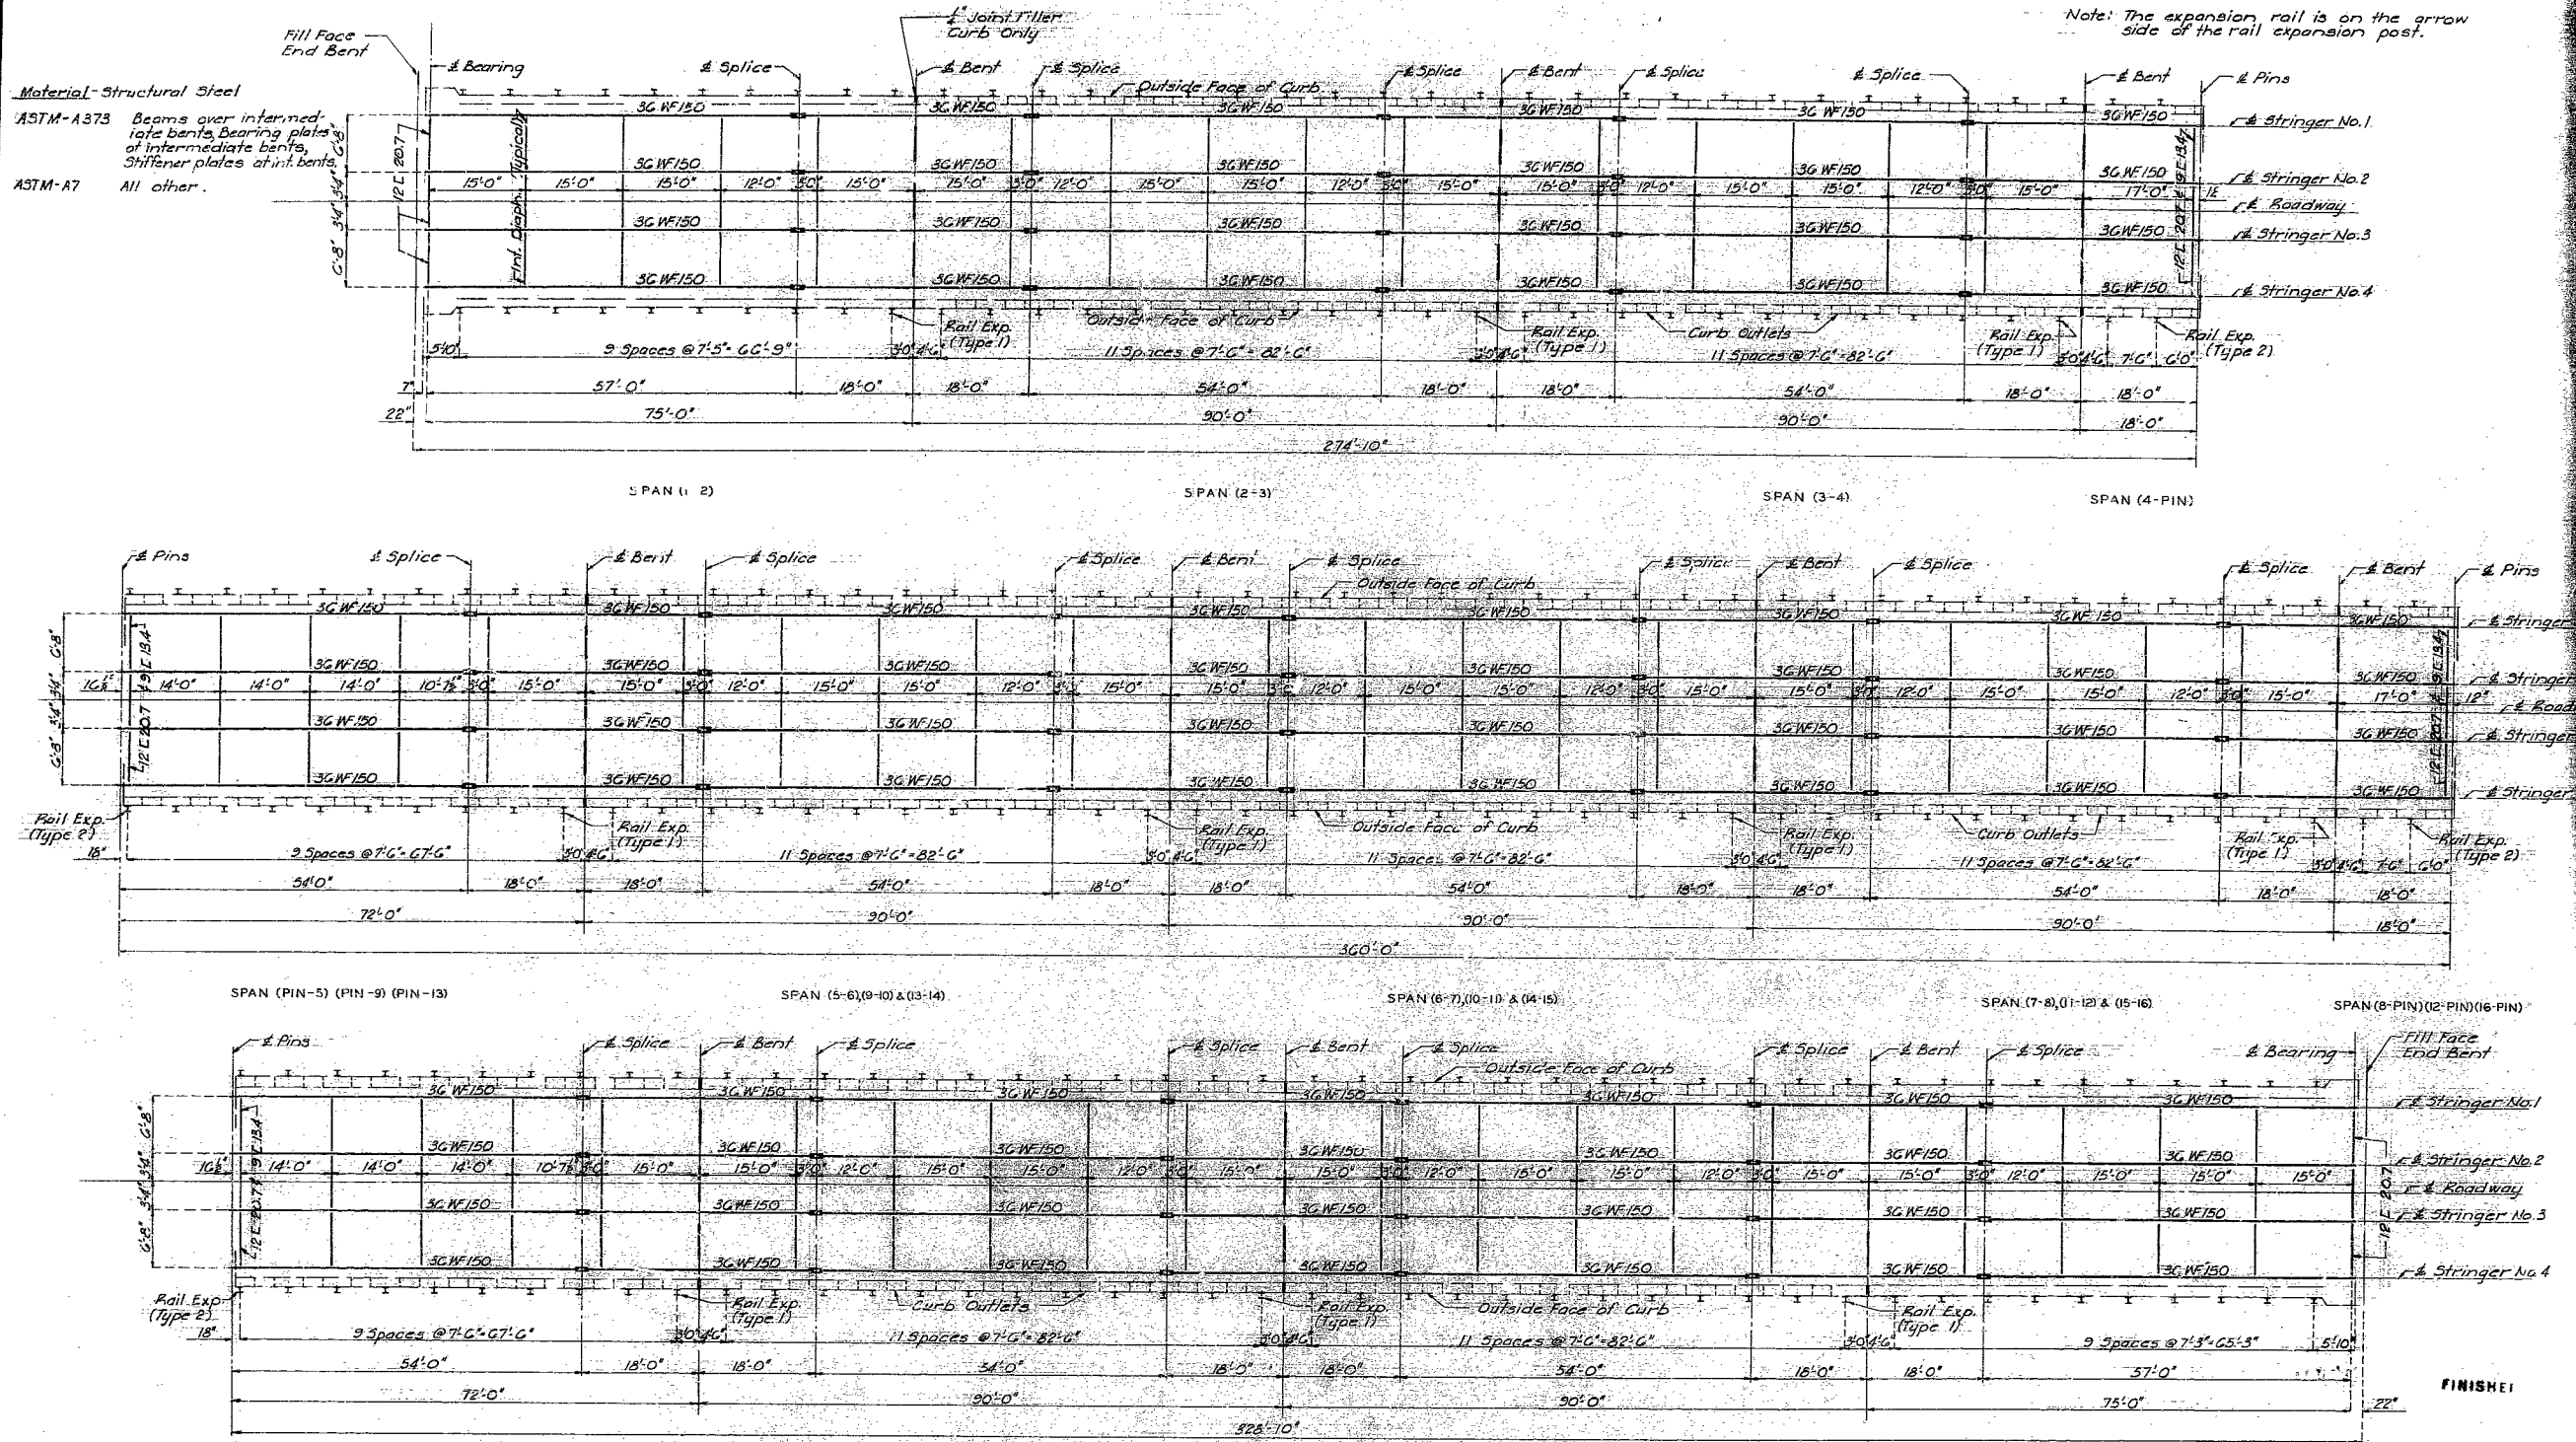


TABLE OF DIMENSIONS

ST. NO.	LOCATION	OUTSIDE STR.	INSIDE STR.
1			
2			
**RECORD DRAWING**

JANUARY 1962

OSAGE RIVER BASIN  
POMME DE TERRE RESERVOIR  
POMME DE TERRE RIVER, MISSOURI  
MISSOURI STATE HIGHWAY RELOCATIONS  
BRIDGE OVER LINDLEY CREEK  
PLAN OF STRUCTURAL STEEL

IN 30 SHEETS SHEET NO. 27 SCALE: 1/4\"

U. S. ARMY ENGINEER DISTRICT KANSAS CITY, MO. MAY 1960

APPROVED: *[Signature]* COL. C. E. DISTRICT ENG.


CHIEF, PROJECTS DESIGN BRANCH CHIEF, ENGINEERING DIV.

TRACED BY: *[Signature]* FILE NO. 0-10-617


FRICHARD COMPANY, INC. INDEPENDENCE, MISSOURI

230


1844

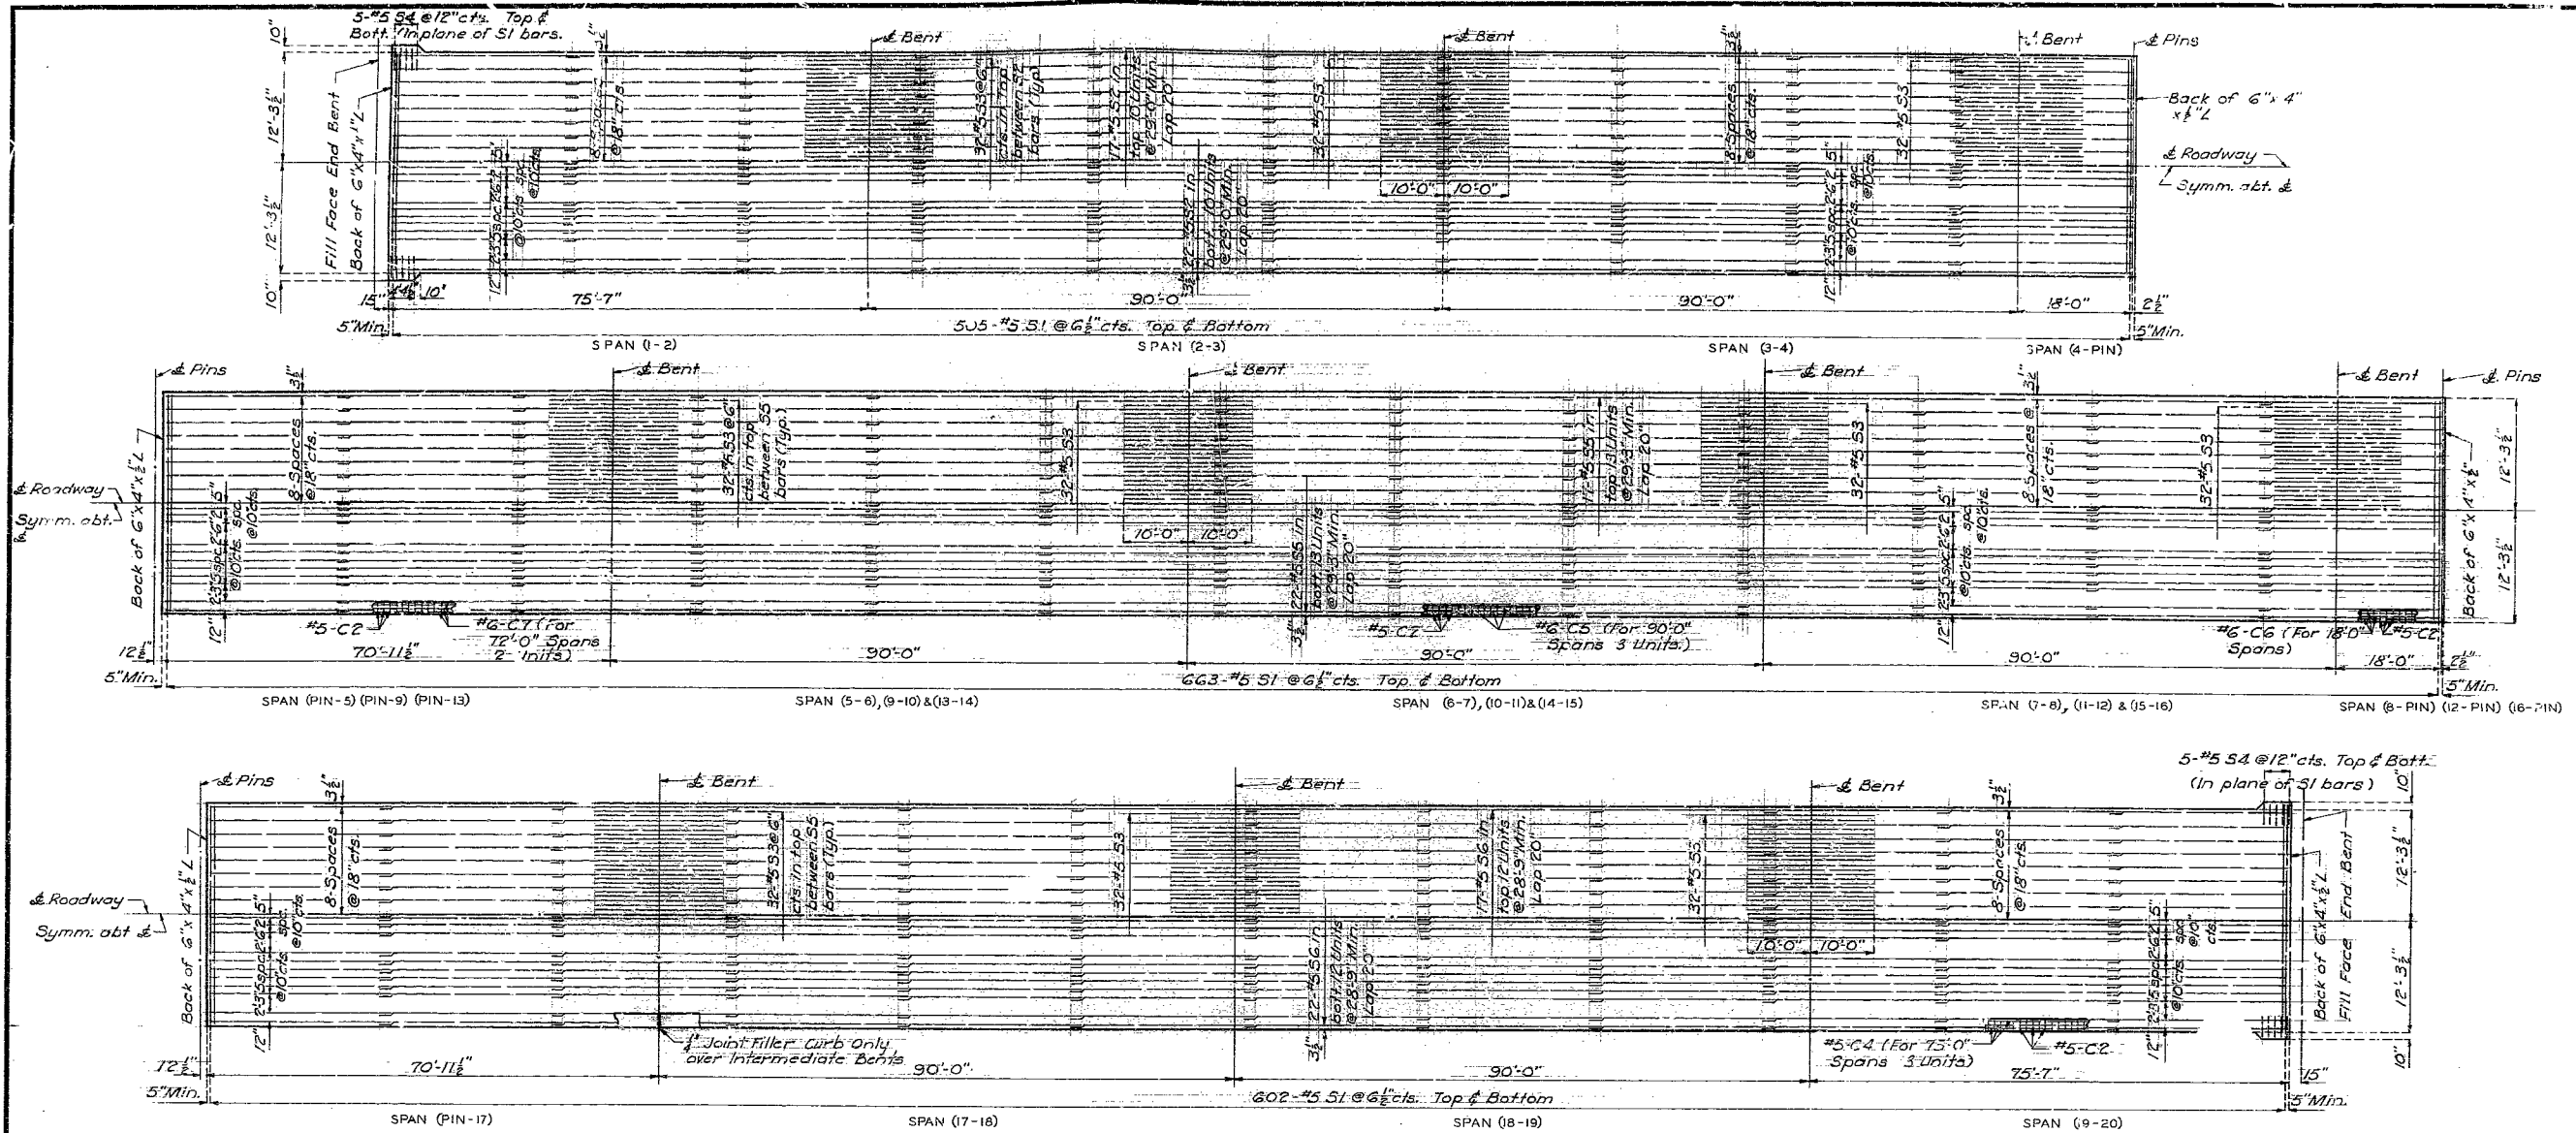


PLAN OF SLAB SHOWING REINFORCING STEEL

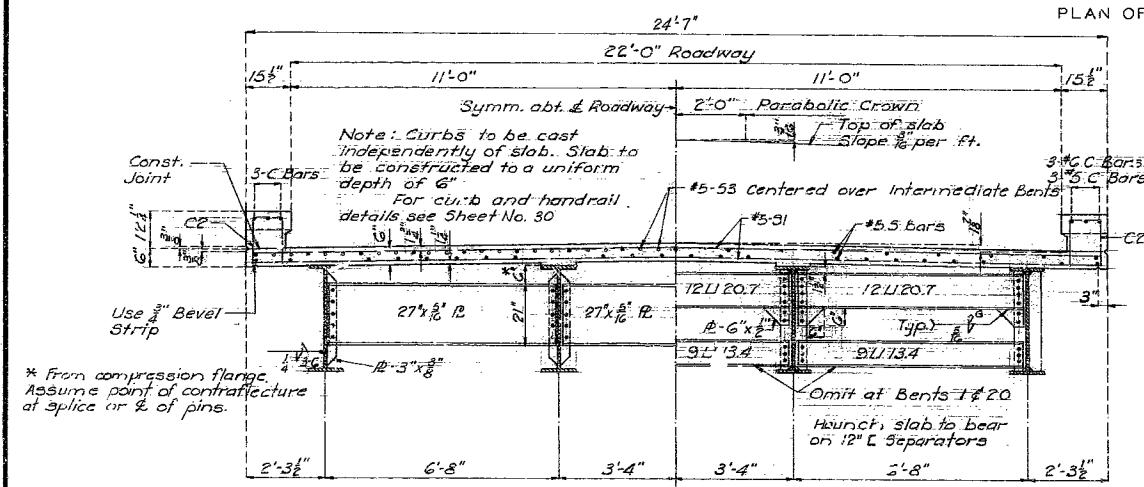

HALF SECTION SHOWING INTERMEDIATE DIAPHRAGMS HALF SECTION SHOWING END CHANNEL SEPARATORS

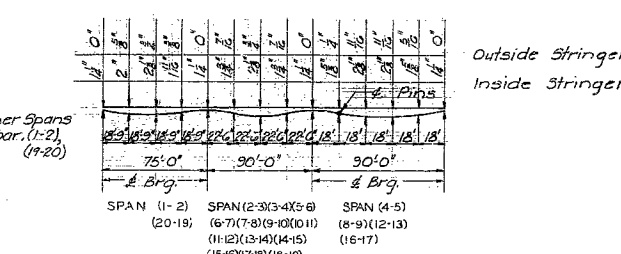

Note: Slab shall be built parallel to grade and to a minimum thickness of 6".  
 Dead load deflection and roadway crown shall be taken care of by haunching to stringers by the amounts shown in above diagram. These haunches are based on top of beam Elev. 82.11 at center line of bearing. These elevations shall be checked and corrections made to haunches for any deviation from theoretical top of beam elevation. The concrete in the slab haunches is included in the Estimated Quantities.

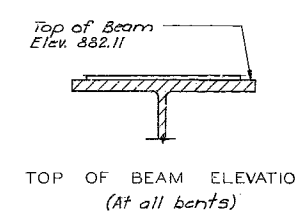

Note: For Slab Pouring Sequence see sheet No. 30.

FINISHED  
**RECORD DRAWING**  
 JANUARY 1962

SYN.	DESCRIPTION	DATE	APPD.
REVISIONS			


OSAGE RIVER BASIN  
**POMME DE TERRE RESERVOIR**  
 POMME DE TERRE RIVER, MISSOURI  
 MISSOURI STATE HIGHWAY RELOCATIONS  
 BRIDGE OVER LINDLEY CREEK FINISHED  
 PLAN OF SLAB REINFORCING STEEL

IN 30 SHEETS SHEET No. 28 SCALE: 1/8" = 1'-0"  
 U. S. ARMY ENGINEER DISTRICT KANSAS CITY, MO.  
 KANSAS CITY MAY 1960  
 SUBMITTED: *H. S. ...* RECOMMENDED: *H. S. ...* APPROVED: *H. S. ...*  
 CHIEF, PROJECTS DESIGN BRANCH CHIEF, ENGINEERING DIV. COL. J. E. DISTRICT  
 DRAWN BY: *EGR* CHECKED BY: *R.H. HICKORY*




PRICHARD COMPANY, INC. INDEPENDENCE, MISSOURI

231

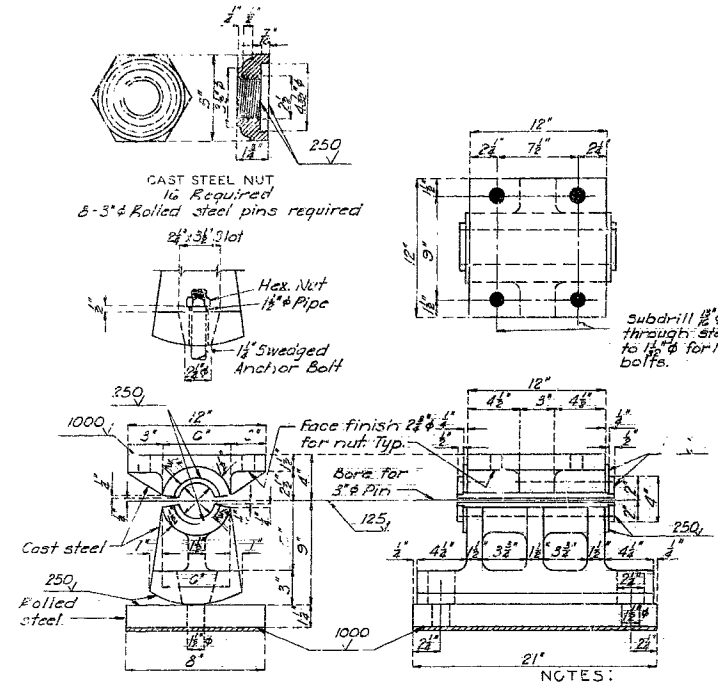


EXPANSION ROCKER  
8 Required  
TYPE 'A'  
DETAILS OF BEARING CASTINGS  
BENTS NO. 1 & 20

NOTES:  
All fillets shall have 1/4" radius.  
Material for castings shall be Cast Steel, except as noted.  
All pins, bolts, nuts, pipe sleeves, and rolled steel shall be paid for as structural steel.  
Anchor bolts shall be 1 1/2" swaged bolts with Hex. nuts and shall extend 12" into concrete.  
Lead plates under bearings shall be approximately 1/2" thickness and weigh 8# per sq. ft. Cost of lead plates shall be included in price bid for other items.

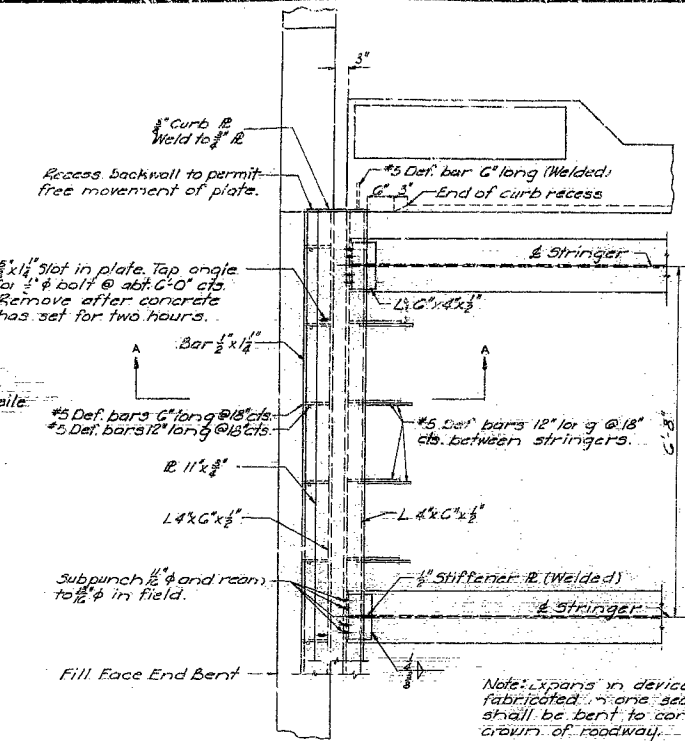


PART PLAN AT END BENT

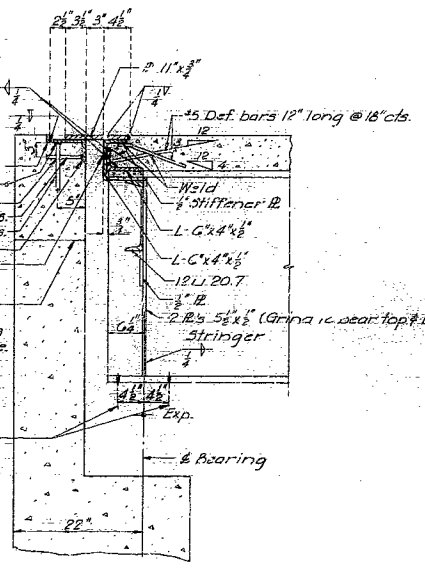


SECTION A-A AT END BENT

Expansion Device shown for Bent No. 1, opposite hand Bent No. 20

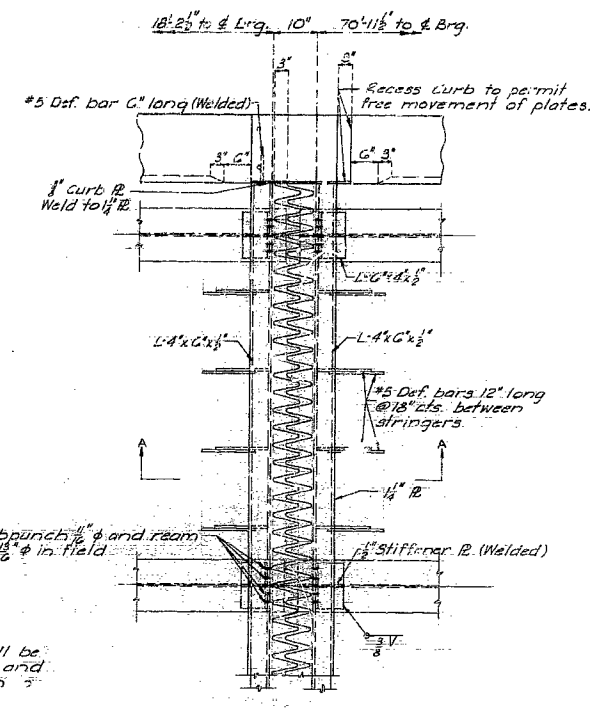


PART PLAN AT PINS

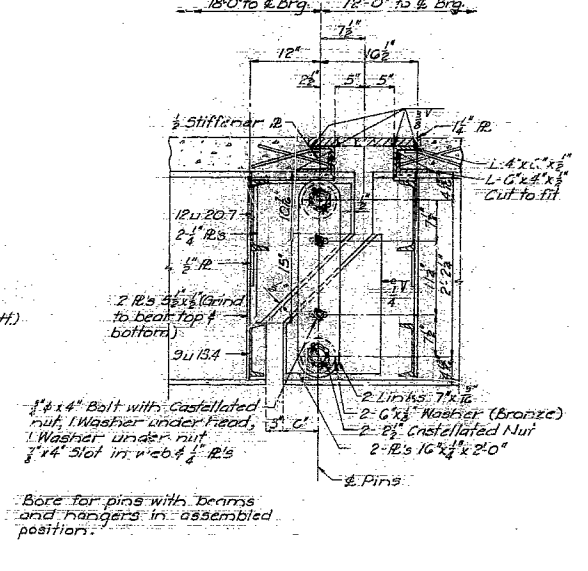


SECTION A-A AT PINS

DETAILS OF EXPANSION DEVICES

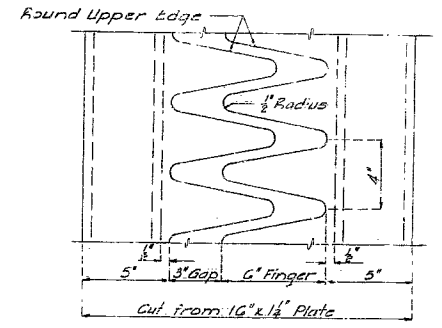


DETAILS OF FINGER PLATE


Note: Finger plate shall be cut with a gas torch from one plate 16" x 1/2". The surface of the cut shall be perpendicular to the surface of plate. The cut shall not exceed 1/2" in width. The centerline of cut shall not deviate more than 1/8" from the position of a cut shown above. No part of expansion device may be spliced. Finger plate expansion device shall be bent to conform to crown of roadway.

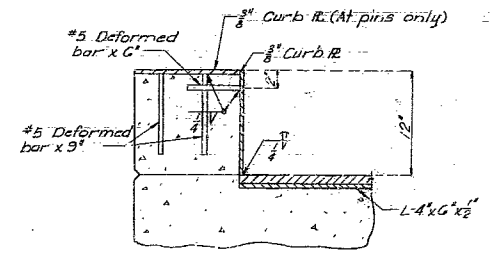


PART SECTION SHOWING CURB PLATE

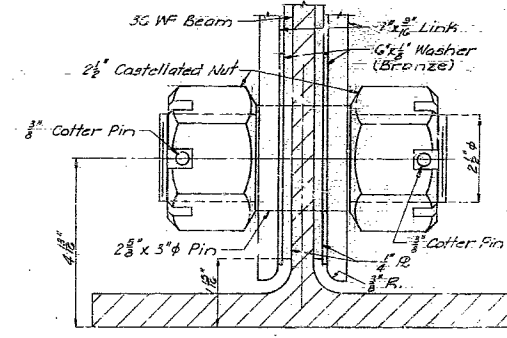

FINISHED PART SECTION SHOWING PIN

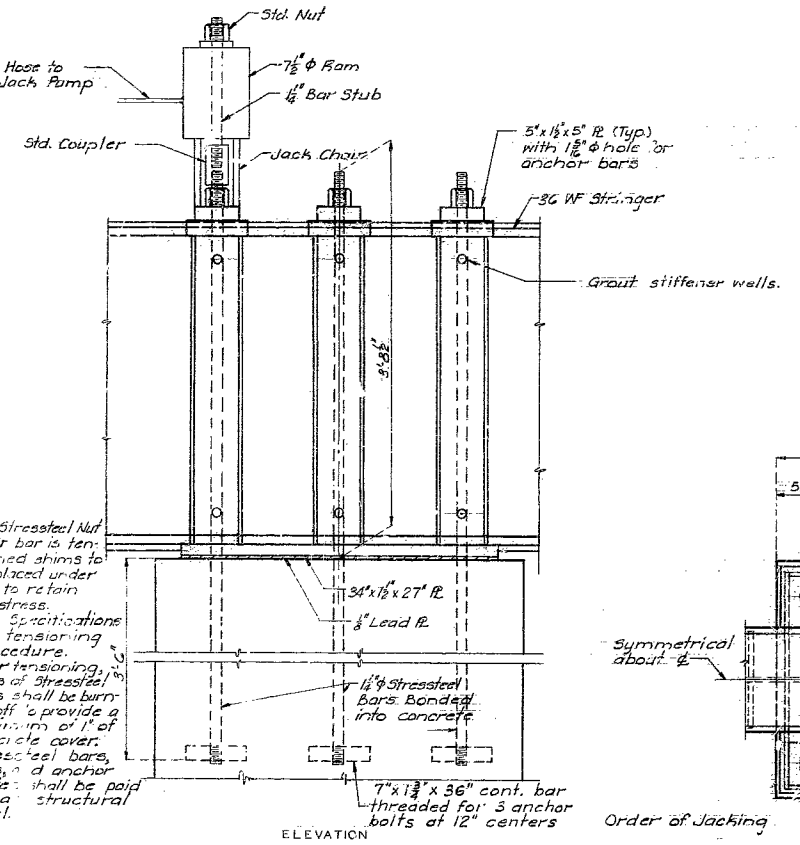

ELEVATION  
DETAILS OF BEARING PLATES  
INTERMEDIATE BENTS NO. 2 THRU 19

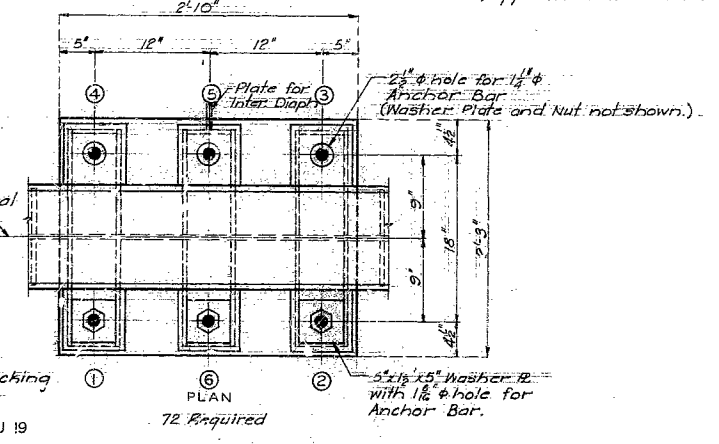

PLAN  
72 Required

NOTE: THIS DRAWING IS NOT TO SCALE. FOLLOW DIMENSIONS


RECORD DRAWING  
JANUARY 1962

Revised for As Built conditions		1-13-62	REH
SYM.	DESCRIPTION	DATE	APP'D.
REVISIONS			

OSAGE RIVER BASIN  
POMME DE TERRE RESERVOIR  
POMME DE TERRE RIVER, MISSOURI  
MISSOURI STATE HIGHWAY RELOCATIONS  
BRIDGE OVER LINDLEY CREEK  
DETAILS OF STRUCTURAL STEEL

IN 30 SHEETS SHEET NO. 29 SCALE: 1/4" = 1'-0"  
U.S. ARMY ENGINEER DISTRICT KANSAS CITY, MO. MAY 1960  
SUBMITTED: [Signature] RECOMMENDED: [Signature] APPROVED: [Signature]  
CHIEF, PROJECTS DESIGN BRANCH CHIEF, ENGINEERING DIV. COL. C.E. DISTRICT ENG.  
DRAWN BY: REH. CHECKED BY: REH. R.H.K. GUNOBY  
PRICHARD COMPANY, INC. INDEPENDENCE, MISSOURI

232

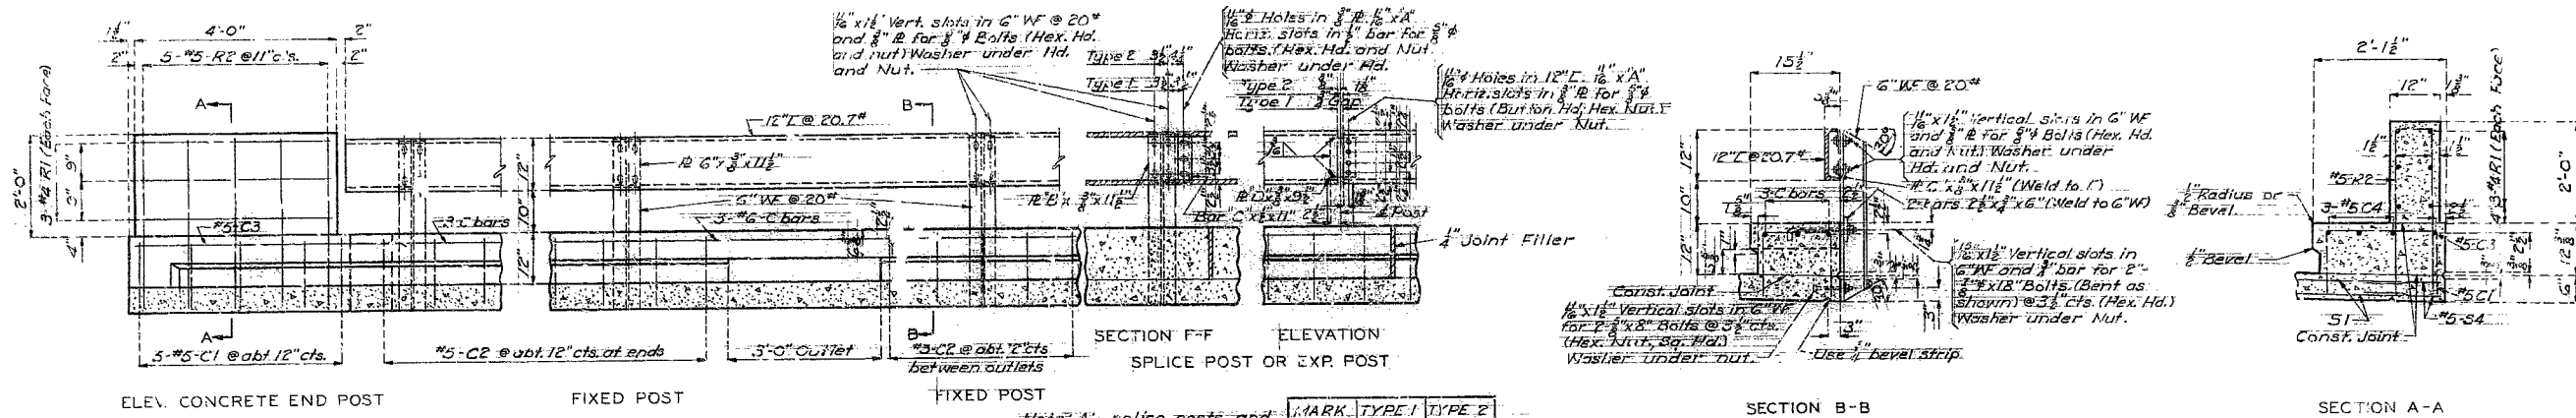



MARK	TYPE 1	TYPE 2
"A"	2"	3 1/2"
"B"	9 1/2"	10 1/2"
"C"	3 1/2"	5"
"D"	6"	7 1/2"

Note: Outlet to be centered in handrail panels as shown on Sheet No. 27.


Note: A: splice posts and expansion posts are Type 1 except posts on each side of pinned expansion joint, which are Type 2. See Sheet No. 27.

Note: Channel rail to be adjusted for horizontal alignment by use of 1/4" size metal shims placed between CWF and connection. B Shims 1/4" and 1/2" thickness to be included in price bid for other items.


GENERAL NOTES:  
All exposed edges of End Post to be beveled 1/4".

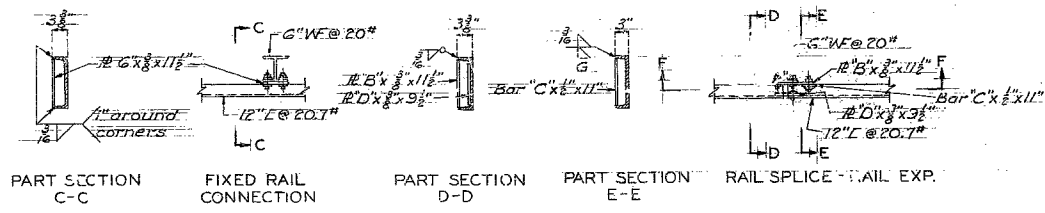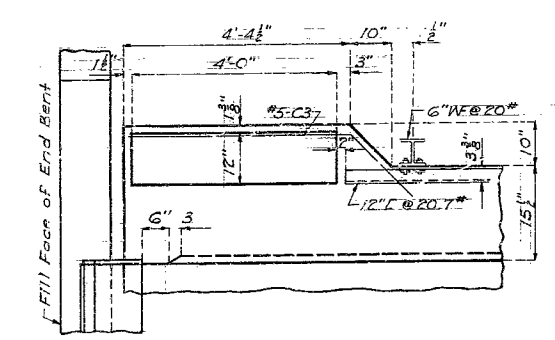

DETAILS OF BEVEL FOR FILLED JOINTS

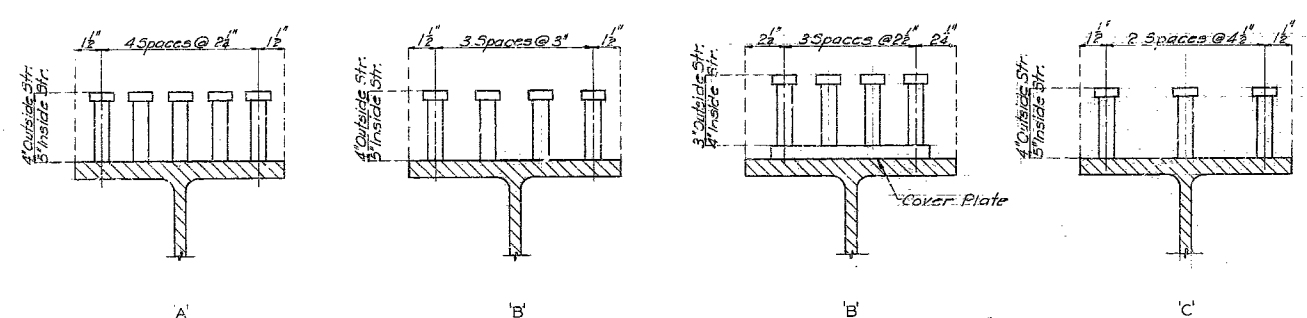

Note: All shear connectors shall be 1/2" studs automatically end welded in the shop.

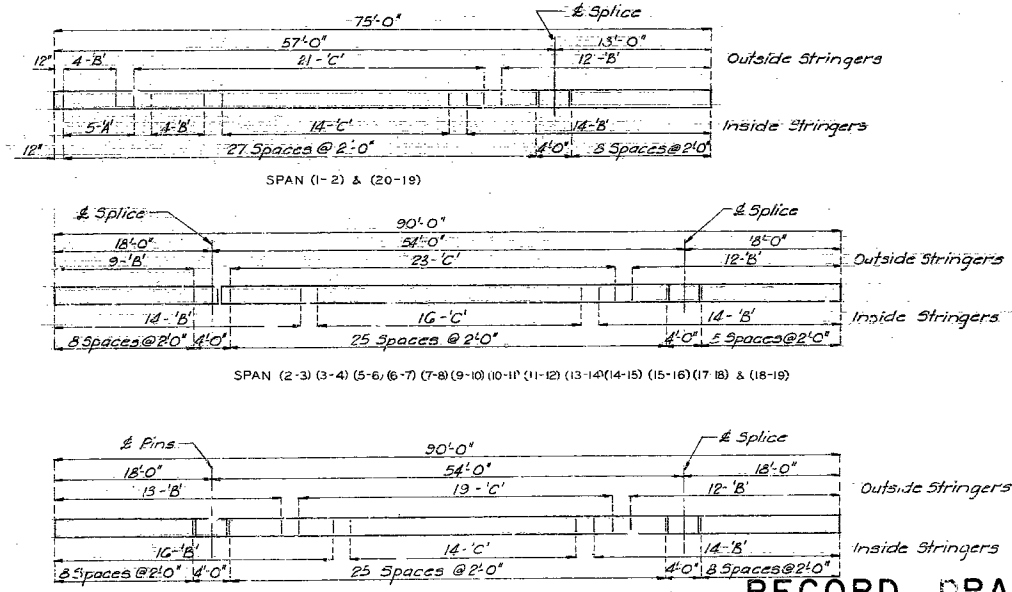


RECORD DRAWING

REVISIONS			
SYMBOL	DESCRIPTION	DATE	APP'D.
	Revised for As Built conditions	1/15/62	J.R.B.

OSAGE RIVER BASIN  
POMME DE TERRE RESERVOIR  
POMME DE TERRE RIVER, MISSOURI  
MISSOURI STATE HIGHWAY RELOCATIONS  
BRIDGE OVER LINDLEY CREEK  
DETAILS OF HANDRAIL

IN 30 SHEETS SHEET NO. 30 SCALE: 1/4" = 1'-0"  
U. S. ARMY ENGINEER DISTRICT, KANSAS CITY, MO. MAY 1960  
SUBMITTED: H. G. R. RECOMMENDED: J. O. Gail APPROVED: J. B. O. ...  
CHIEF, PROJECTS DESIGN BRANCH CHIEF, ENGINEERING DIV. COL. C.E. DIST. T. S.  
DRAWN BY: E. G. R. CHECKED BY: R. H. K. HICKORY  
O-10-620

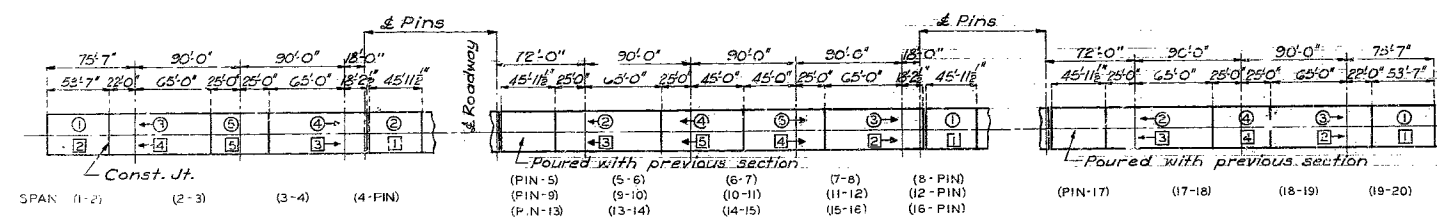

Note: The slab shall be poured in sections of the lengths shown and in the sequence indicated by the numbers (1) through (18) or as alternate by the numbers (1) through (18) in each series of spans. The separate pours shall progress in the direction indicated by the arrows. The pour may be in either direction if no arrow is shown. Longitudinal construction joints will not be perm. ed.

Finish each side of joint with 3/4" radius edging tool. Fill groove with joint seal.

DETAIL OF SLAB CONST. JOINT 14 of 14


NOTE: THIS DRAWING IS NOT TO SCALE. FOLLOW DIMENSIONS

233


MISSOURI HIGHWAY AND TRANSPORTATION COMMISSION

State	Proj. No.	Sheet No.
MO		81
SEC. 17/18/19	TWP. 36N	RGE. 21W


(UIP) (75'-0", 17 @ 90'-0", 75'-0") Continuous Composite Wide Flange Beam Spans  
No Skew

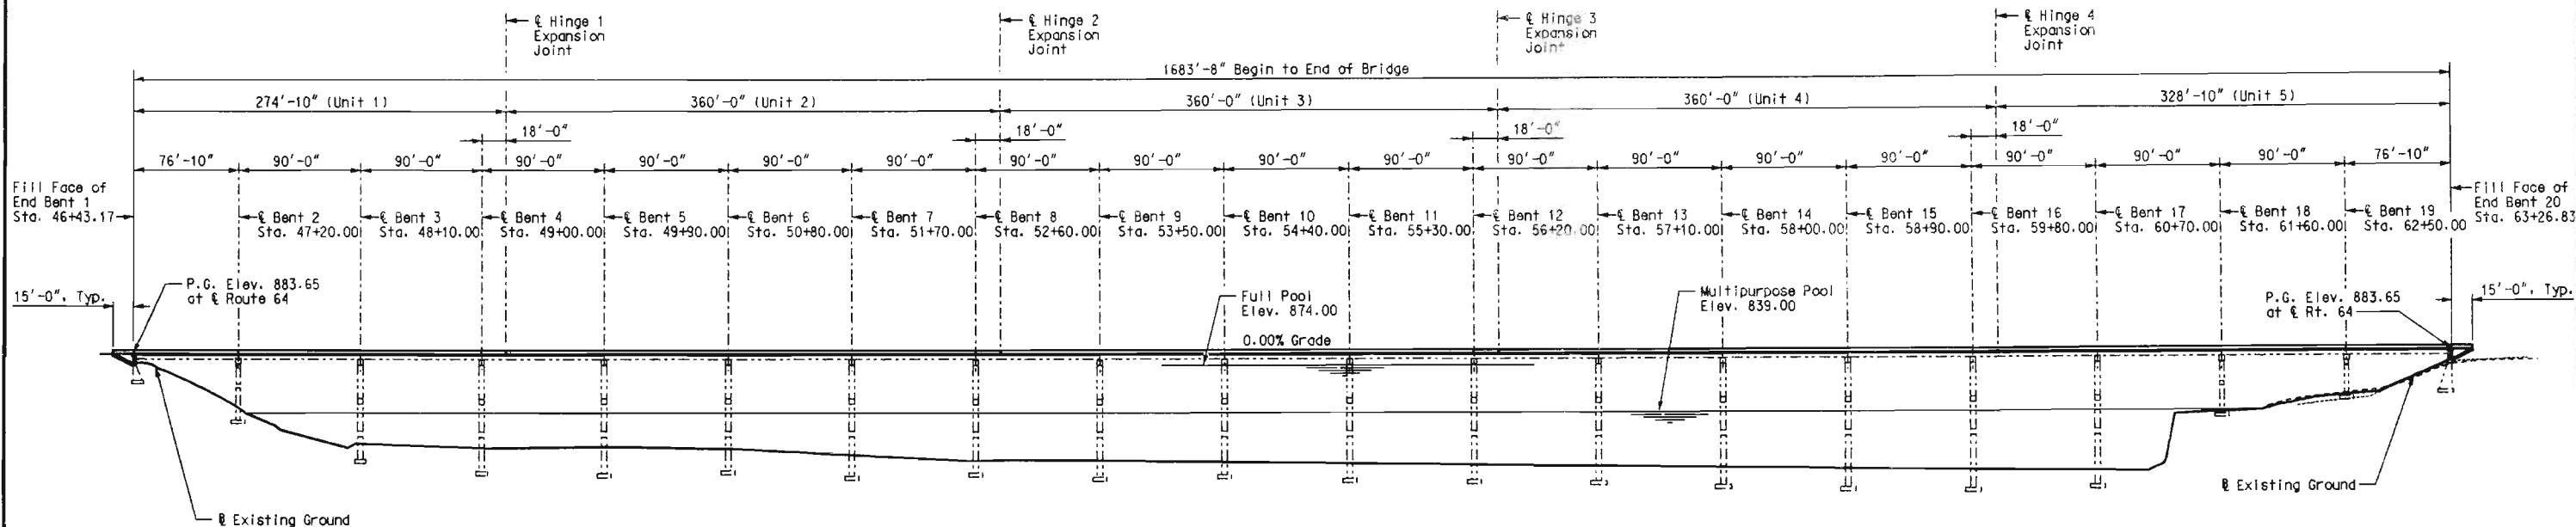

GENERAL ELEVATION

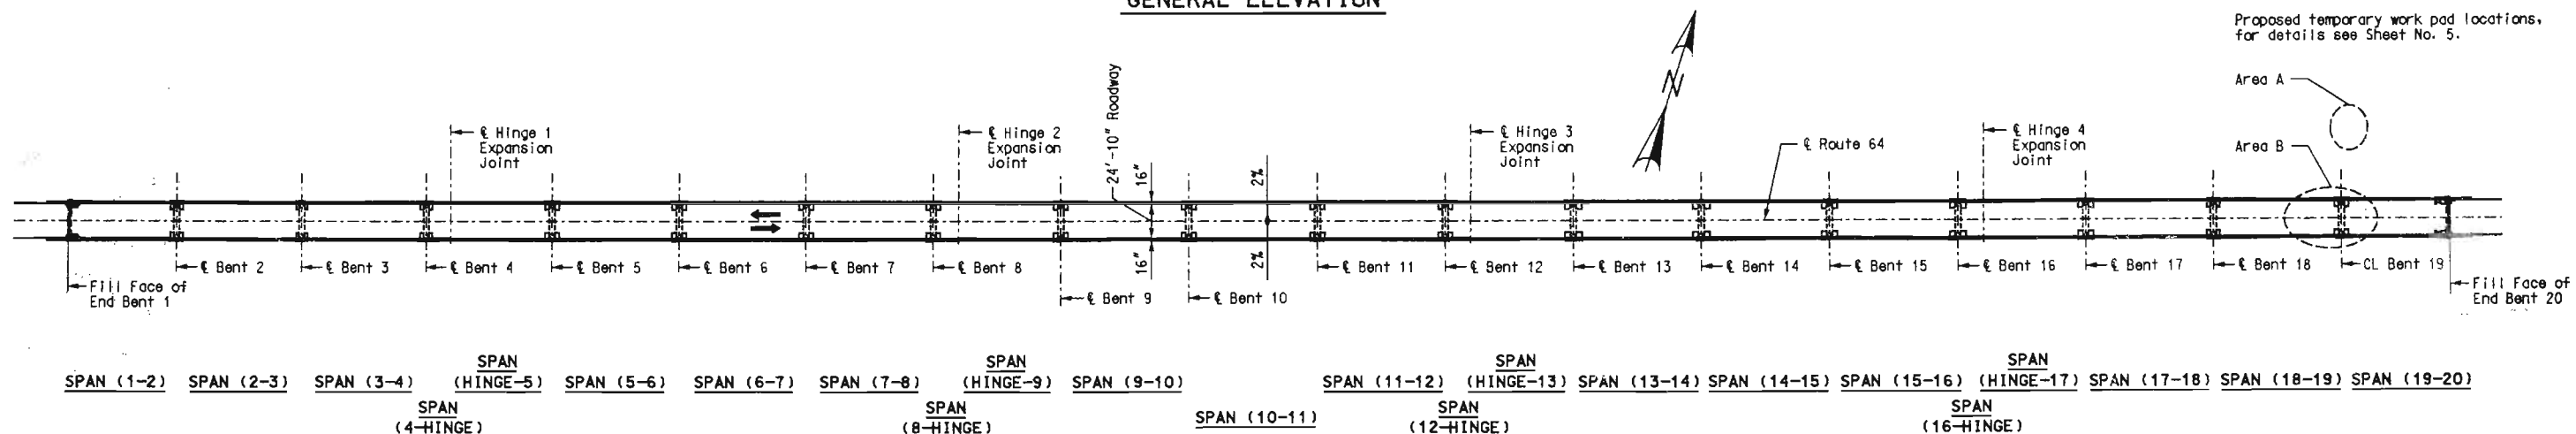

PLAN

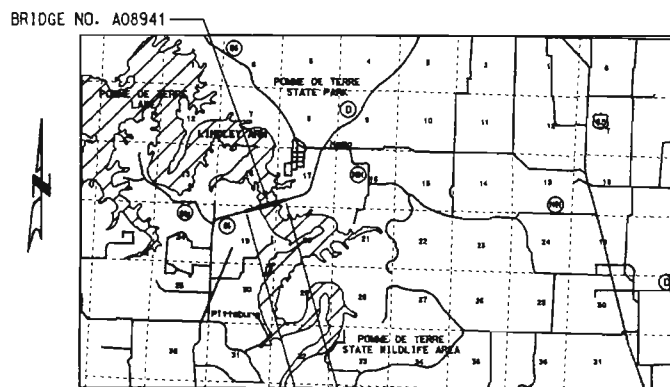


LOCATION MAP

EXISTING PLANS NOTE

Elevations have been adjusted (+ 0.456 feet) from existing bridge "As Built Plans" to match 2001 Survey Datum.  
Plan dimensions and details relative to existing structure have been taken from existing plans and are subject to nominal construction variations. It shall be the Contractor's responsibility to verify such dimensions and details in the field and make necessary approved adjustments prior to construction or ordering of materials. Such variations shall not be cause for additional compensation for a change in the scope of the work, however, the Contractor will be paid for the quantity actually furnished at the unit price bid for the work.

BENCHMARKS

Top NE corner of concrete wingwall (Pavement side) on the East End and South side of the Bridge over Pomme de Terre Lake, Lindley Branch.  
Elev. 884.056  
Top center @ Northerly end of concrete wingwall @ Southwest corner of Bridge (West side of Lake) over Pomme de Terre Lake, Lindley Branch.  
Set cut "t".  
Elev. 884.109

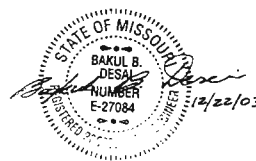

WIDENING OF:  
BRIDGE OVER POMME DE TERRE LAKE  
STATE ROAD FROM RTE. NN S.W. TO RTE. 64B  
1.5 MILES SOUTHWEST OF ROUTE NN  
PROJECT NO. STA. 46+43.17  
JOB NO. J850654 RTE. 64  
HICKORY COUNTY  
DATE 12/30/03

STD. 706.35
STD. 609.00
A08941

USER: jh...  
 PLOTTED: 2/2/03...  
 K:\b.54\84\1-64\_Precast Deck Drawings\p01.dwg

Detailed SEP 2003  
 Checked OCT 2003



Note: This drawing is not to scale. Follow Dimensions.

Sheet No. 1 of 35



**GENERAL NOTES:**

**DESIGN SPECIFICATIONS:**  
2002 AASHTO 17th Edition  
Load Factor Design  
Seismic Performance Category A.

**DESIGN LOADINGS:**  
HS15-44: Stringers and Substructure  
HS20-44: Deck  
Earth 120#/Cu. Ft. Equivalent Fluid Pressure = 45#/Cu. Ft.  
Fatigue Stress Cycles - Case II.  
Superstructure: Continuous composite for live load.

**DESIGN UNIT STRESSES:**  
Class B-1 Concrete (Substructure) f'c = 4,000 psi.  
Class B-1 Concrete (Closure Pour & Barrier Curb) f'c = 4,000 psi.  
Silica Fume concrete f'c = 4,000 psi.  
Precast Slab Panel grout f'c = 2,500 psi (prior to opening to traffic)  
Reinforcing Steel Grade 60 Fy = 60,000 psi.  
Structural Carbon Steel (ASTM A709 Grade 36) Fy = 36,000 psi.  
Post-Tensioning Bars (Grade 150) Fy = 150 ksi.

**FABRICATED STEEL CONNECTIONS:**  
Field connections, high strength bolts 3/4" Dia., holes 15/16" Dia., except as noted.  
High strength bolts, nuts and washers will be sampled for quality assurance as specified in Standard Specification 106 and Field Section (FS-712) from Materials Manual.

**STRUCTURAL STEEL:**  
Fabricated structural carbon steel shall be ASTM A709, Grade 36, except as noted.

**WELDING:**  
For welded connections, use minimum weld sizes as per Missouri Standard Specifications for Highway Construction, unless shown otherwise.

**WIDEN, EXTENSION, AND REPAIR:**  
Outline of old work is indicated by dashed lines. Heavy lines indicate new work.  
Dimensions contained in these plans are based on the "As Built Plans". Contractor shall verify all dimensions in field before ordering new steel.  
Bars bonded in old concrete not removed shall be cleanly stripped and embedded into new concrete where possible. If length is available, old bars shall extend into new concrete at least 40 diameters for smooth bars and 30 diameters for deformed bars, unless otherwise noted.  
The contractor shall use one of the resin anchor systems listed in the general special provisions. These anchor systems shall be installed according to the manufacturer's specifications, except as modified by the general special provisions.  
Cost of furnishing and installing the anchor system complete in place shall be included in the price bid for Class B-1 Concrete (Substr.).  
The resin anchor systems shall have a minimum ultimate pullout strength as specified below, in concrete with f'c = 4,000 psi. See Special Provisions.

DIAMETER	BAR SIZE	EMBEDDED LENGTH (in new concrete)	PULLOUT (lbs.)
3/8"	#4	18"	15,500
1/2"	#6	24"	20,400

**REINFORCING STEEL:**  
Minimum clearance to the reinforcing steel shall be 1 1/2", unless otherwise shown.

**JOINT FILLER:**  
All joint filler shall meet the requirements of Section 1057.2.4 of the Missouri Standard Specifications, except as noted.

**PROTECTIVE COATING:**  
System G by the contractor (See Special Provisions).

**FIELD COAT (EXISTING STEEL):**  
All exposed and accessible surfaces of the existing structural steel shall be cleaned and coated with System G prime coat in accordance with Section 712 and the Special Provisions. Tint of the prime coat for System G shall be similar to the color of the field coat to be used.  
Field Coat: The color of the finish coat shall be Gray (Federal Standard #26373). The cost of the intermediate coat shall be included in the contract unit price per sq. foot of intermediate Field Coat (System G) Gray. The cost of the finish coat shall be included in the contract unit price per sq. foot of Finish Field Coat (System G) Gray. (See Special Provisions.)  
The Contractor is responsible for the containment and disposal of any materials resulting from the surface preparation and recoating of the existing steel stringers (including top flanges), diaphragms, and other miscellaneous appurtenances. See Special Provisions.

**BEARINGS:**  
Bearings at end bents require cleaning, lubricating and coating, see Special Provisions.

**NON-DESTRUCTIVE TESTING:**  
Welds at existing cover plates and existing stringer post-tension anchor plates require non-destructive testing, see Special Provisions.

**PRECAST SLAB PANELS:**  
Concrete for precast slab panels shall be Class A1 with f'c = 5,000 psi, f'ci = 5,000 psi.

All reinforcement shall be epoxy coated.  
The top surface of all panels shall receive a scored finish with a depth of scoring of 1/8" perpendicular to the CL of Route 64 (see Special Provisions).  
Suitable anchorage devices for lifting may be cast in panels, provided they are shown on the shop drawings and approved by the engineer.  
Panels shall be set on joint filler in accordance with Section 1057.2.5 of Mo. Std. Spec. or polystyrene bedding material.

**POST-TENSIONING BARS:**  
All bars shall conform to the requirements of ASTM A722 Grade 150. Anchorage systems and blockout details shall be determined by the post-tensioning system used. The contractor shall adjust dimensions and reinforcing as required.  
Maximum jacking stress = 0.75 f's  
Maximum stress after seating = 0.70 f's  
P.T. . Where noted in plans, denotes Post-Tensioned.

**TEMPORARY BRIDGE:**  
To accommodate openings in deck at closure pour locations and joint between precast slab panels and existing deck, steel plates (or other approved device) shall be used.  
Prior to removal of any portion of the deck or end bent backwalls, shop drawings and calculations indicating size and thickness of plates shall be submitted to the Engineer for approval. See Special Provisions.

**SILICA FUME CONCRETE WEARING SURFACE:**  
In order to maintain grade and a minimum thickness of wearing surface as shown on plans it may be necessary to use additional quantities of wearing surface at various locations throughout the structure. No payment will be allowed for additional labor, materials or equipment for variations in thickness of wearing surface.

**CONSTRUCTION NOTE:**  
"Rivet Replacement at Field Splices" shall be completed prior to beginning bridge deck removal and placing of precast slab panels, see Sheet No. 11.  
Contractor shall remove portions of deck immediately above existing stringer post-tension anchor plates for a visual inspection at least 1 week prior to placement of Precast Slab Panels at bent locations.


**ESTIMATED QUANTITIES**

ITEM	SUBSTR.	SUPERSTR.	TOTAL
Removal of Existing Bridge Deck	Sq. Ft.	41,406	41,406
Partial Removal of Substructure Concrete	Lump Sum	1	1
Class 1 Excavation	Cu. Yds.	70	70
* Temporary Shoring	Lump sum	1	1
Bridge Approach Slab (Bridge)	Sq. Yds.	153	153
* Rock Fill (Special)	Cu. Yds.	855	855
Substructure Repair (Formed)	Sq. Ft.	18	18
Substructure Repair (Unformed)	Sq. Ft.	20	20
Protective Coating - Concrete Bents (Deleterious Agents)	Lump sum	1	1
Class B-1 Concrete (Substr)	Cu. Yds.	25.4	25.4
Class B-1 Concrete (Closure Pour & Barrier Curb)	Cu. Yds.	43.6	43.6
Precast Concrete Slab Panels (with intergal Barrier Curbs)	Sq. Yds.	4,999	4,999
Silica Fume Concrete Wearing Surface	Sq. Yds.	4,614	4,614
Strip Seal Expansion Device	Lin. Ft.	56	56
Post-Tension System	Lump Sum	1	1
Reinforcing Steel (Bridges)	Lbs.	3,180	3,180
Mechanical Bar Splice	Each	528	584
Reinforcing Steel (Epoxy Coated)	Lbs.	2,100	15,080
Expansion Device (Finger Plate)	Lin. Ft.	100	100
Fabricated Structural Carbon Steel (Misc.)	Pound	190	190
Cleaning, Lubricating and Coating Bearing	Each	8	8
Slab Drain	Each	292	292
Surface Preparation for Recoating Structural Steel	Sq. Ft.	65,700	65,700
Field Application of Inorganic Zinc Primer	Sq. Ft.	65,700	65,700
Intermediate Field Coat (System G) Gray	Sq. Ft.	58,900	58,900
Finish Field Coat (System G) Gray	Sq. Ft.	16,500	16,500
Transporting Lead Contaminated Residue to Storage Area	Lump Sum	1	1
Transporting Lead Contaminated Residue to the Smelter	Lump Sum	1	1
Disposal of Lead Contaminated Residue	Lump Sum	1	1
Non-Destructive Testing	Lin. Ft.	420	420
Hanger Retrofit at Hinges	Each	16	16
Rivet Replacement at Field Splices	Each	448	448
Removal of Existing Shear Connectors	Lump Sum	1	1
Installation of Shear Connectors	Each	11,868	11,868

**Notes:**  
The quantities for "Surface Preparation for Recoating Structural Steel" and "Field Application of Inorganic Zinc Primer" include the entire length of all Stringers.  
The intermediate field coat shall be applied to the surfaces of all structural steel except those surfaces to be in contact with concrete shall not receive the intermediate coat. The intermediate coat shall also be applied to the end bent bearings.  
The finish field coat shall include the exterior stringers. The limits of the exterior stringers shall include the bottom of the top exterior flanges, the top of the bottom exterior flanges, the exterior web area, the exterior face of the top and bottom flanges, and the bottom of the bottom flange. Areas of steel to be in contact with concrete shall not receive the finish coat.  
The surfaces of all structural steel located under expansion joints shall be field coated with intermediate and finish coats for a distance of 10 feet from the center line of the joint. Within this limit, the items to be field coated shall include all surfaces of stringers, bearings, diaphragms, stiffeners and miscellaneous structural steel items. Areas of steel to be in contact with concrete shall not receive the field coats.  
The limits of the field coatings shall be masked to provide crisp, straight lines and to prevent overspray on adjacent areas.  
\* The quantities for "Rock Fill (Special)" and "Temporary Shoring" are based on Contractor's work area as shown in the plans. If Contractor does not use workpad as shown in plans, then these items shall be underrun as determined by the Engineer. See Special Provisions.  
The lump sum quantity for "Protective Coating - Concrete Bents (Deleterious Agents)" includes End Bent 1 and End Bent 20, to the limits shown.




USER: jhompson  
 PLOTTED: 29 DEC 2003 10:09  
 I:\334\PROJECT 64\PROJECT Deck.dwg  
 12/22/03 10:09

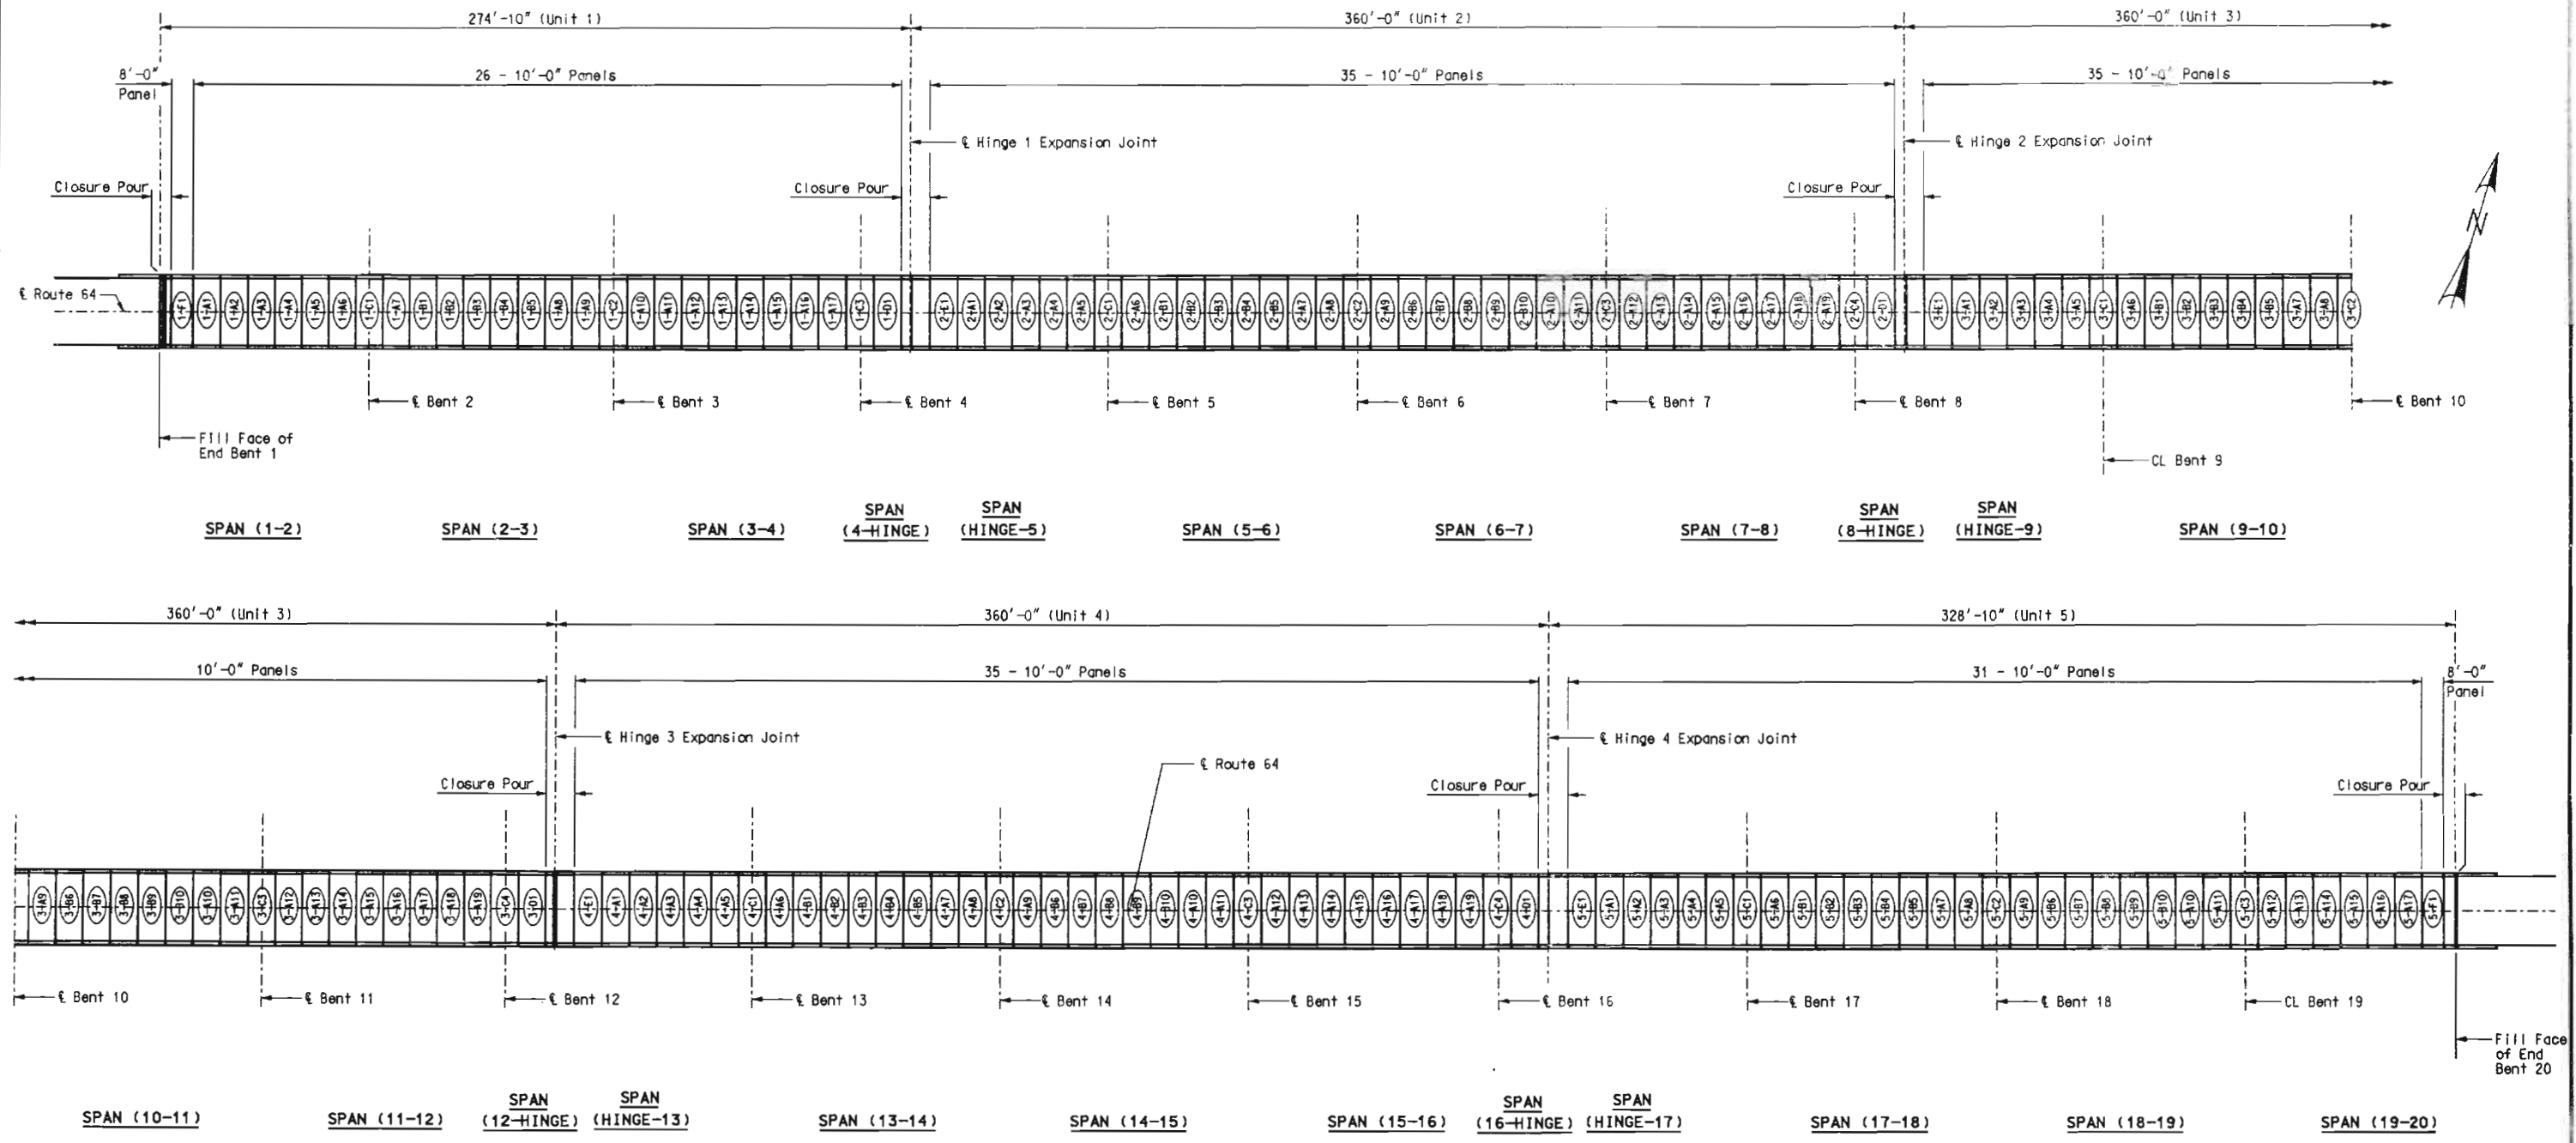

**PLAN OF CONSTRUCTION**

**PROPOSED OVERALL CONSTRUCTION SEQUENCE**

1. Construct End Bent Modifications to backwalls as detailed, using temporary steel plate across backwall and expansion joint. Complete "Rivet Replacement at Field Splices" as detailed, prior to beginning deck replacement. See Special Provisions.
2. Place panels in Span (1-2) (See Plan of Construction).
3. Set strip seal joint at End Bent 1 and cast closure pour.
4. Place panels in Span (2-3).
5. Place panels for Spans (3-4), (4-Hinge), and (Hinge-5).
6. Install hanger retrofit at hinge. Set finger joint in Span (4-5) and cast closure pour.
7. Place panels for Spans (5-6) thru (8-9).
8. Repeat step 6 for Span (8-Hinge) and (Hinge-9).
9. Repeat steps 7 & 8 for Units 3 and 4.
10. Place panels in Span (16-Hinge) and (Hinge-17).
11. Repeat step 6 for Span (16-Hinge) and (Hinge-17).
12. Place panels for Spans (17-18) and (18-19).
13. Place panels for Span (19-20).
14. Set strip seal joint at End Bent 20 and cast closure pour.
15. Place wearing surface on bridge deck.
16. Construct approach slab, wingwalls and barrier at End Bents 1 and 20. Utilize staged construction to coordinate with placement of wearing surface.

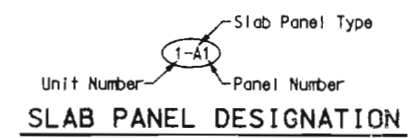

**PROPOSED OVERALL CONSTRUCTION SEQUENCE**

HICKORY COUNTY A08941

USER: jhinc...  
 PLOTTED: 10-DEC-2003 16:07  
 K:\b35418\RT b4 Precast Deck drawings\p03.dgn



Detailed OCT 2003  
 Checked NOV 2003




Note: This drawing is not to scale. Follow Dimensions.

### PROPOSED NIGHTLY CONSTRUCTION SEQUENCE


1. Close entire bridge at 7 p.m.
2. Remove guardrail, curb, and slab (except directly over stringers). (Remove only deck area that will be replaced that night.)

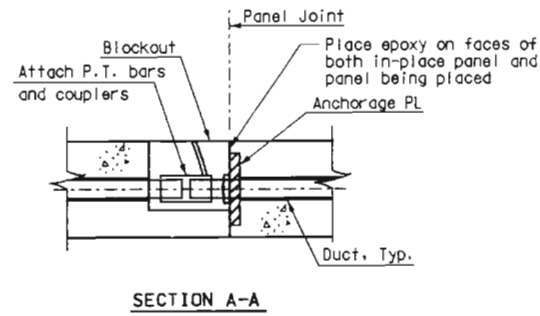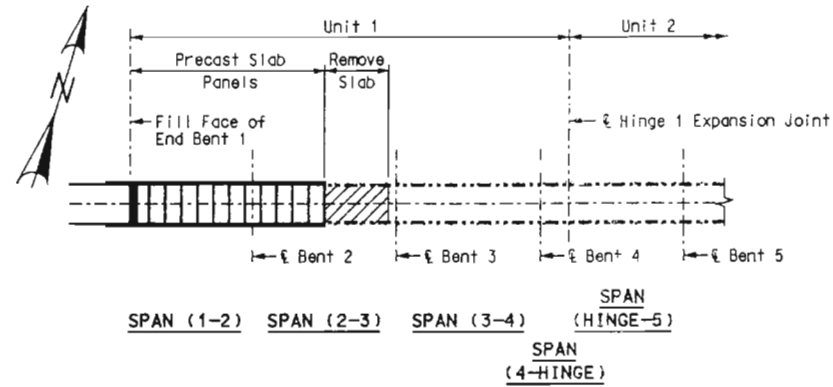


7. Apply epoxy on match cast faces of both in-place panel and panel being placed.
8. Move panel being placed into final position and begin stressing P.T. bars. P.T. bars shall be stressed in pairs symmetric about center line of bridge.
9. Repeat steps 5-8 for each slab panel placed.
10. After all P.T. bars are fully stressed, install new shear connectors to stringer top flanges.

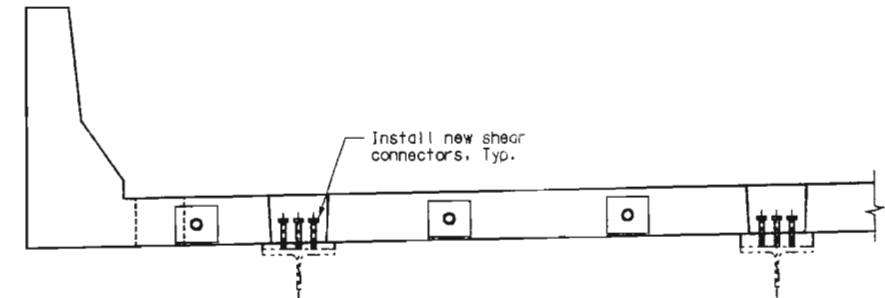


3. Using approved equipment, remove slab directly over top flange of stringers. (See Special Provisions)
4. Remove existing shear connectors and clean and prime coat top flange of stringers.

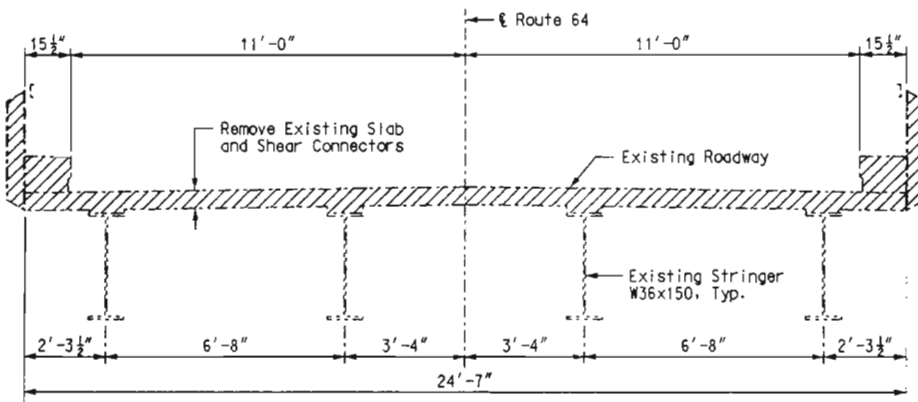



5. Place joint filler material on edges of top flange and then place full-width precast slab panel on stringers. Level and align slab panel as required. (See Special Provisions)
6. Attach P.T. bars and couplers.

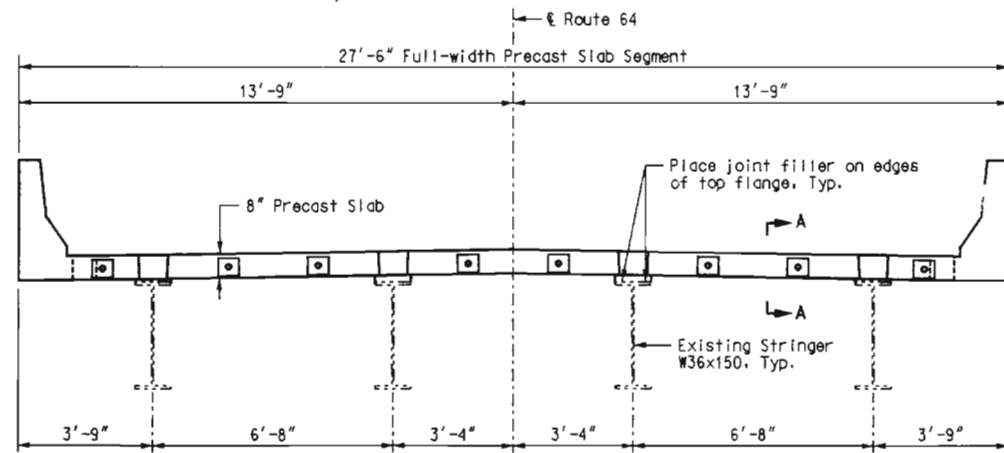

11. Begin pumping high-early strength concrete grout into shear connector and "bearing" pockets. Ensure that concrete grout flows between shear connector pockets thru the "bearing" pocket (between the top flange and bottom of panel). After the "bearing" pocket has been filled, finish placing the concrete grout in shear connector pocket, move to next shear connector pocket, and repeat procedure. Place concrete grout in blockouts for P.T. bar couplers.

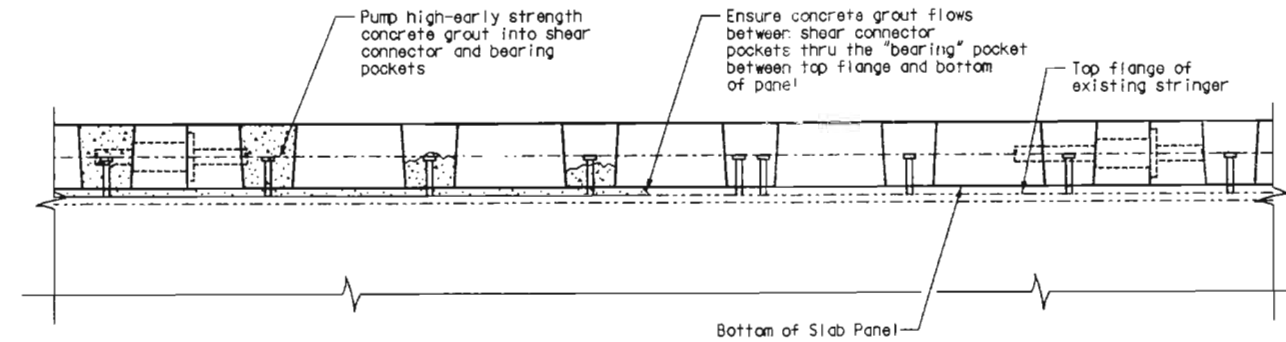

12. Place Temporary Bridge over gap between slab panel and existing bridge deck. Positively attach Temporary Bridge to existing bridge to prevent movement. (See Temporary Bridge Special Provisions)

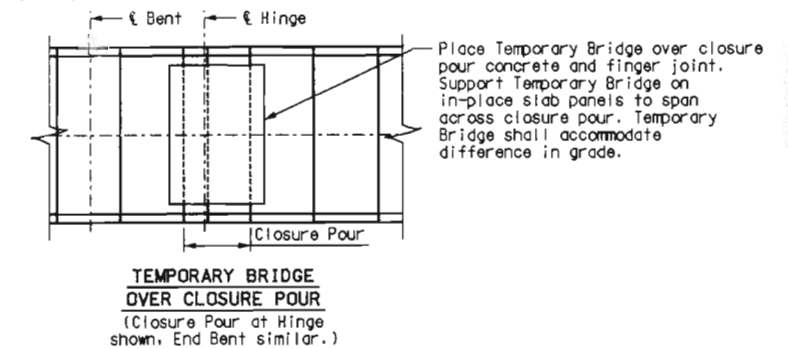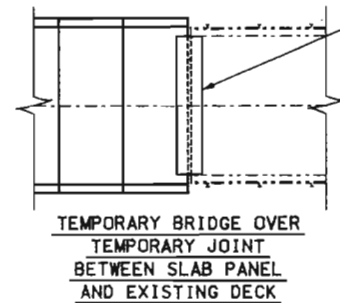


13. Put traffic control devices in place between existing curb and new safety barrier curb.
14. Open entire bridge at 7 a.m.
15. Grout PT Bars upon completion of each span.




PROPOSED NIGHTLY CONSTRUCTION SEQUENCE


HICKORY COUNTY A08941

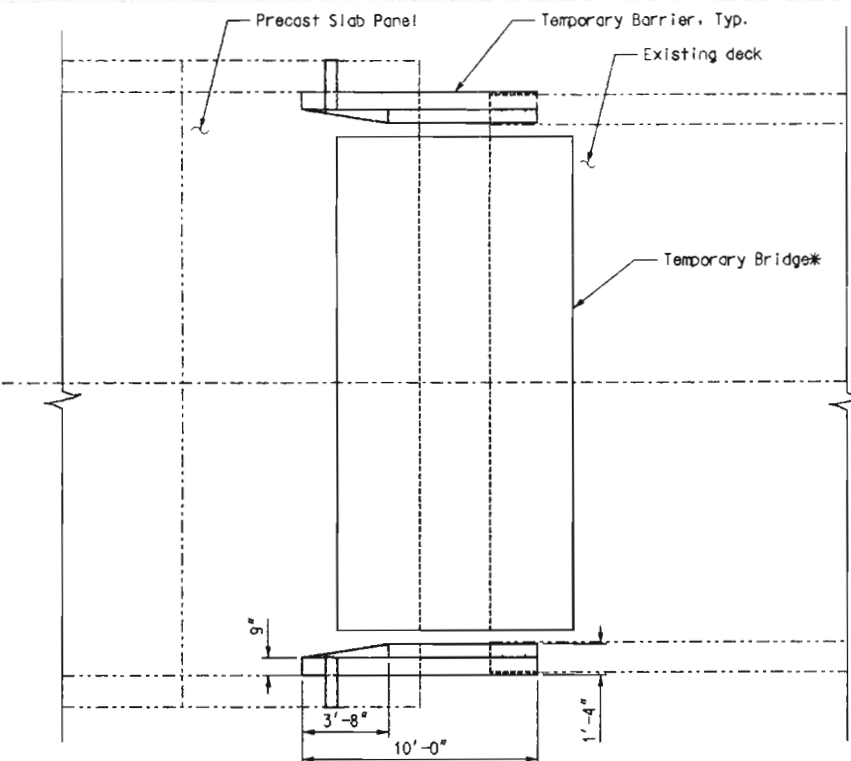

**TEMPORARY BRIDGE OVER TEMPORARY JOINT BETWEEN SLAB PANEL AND EXISTING DECK**

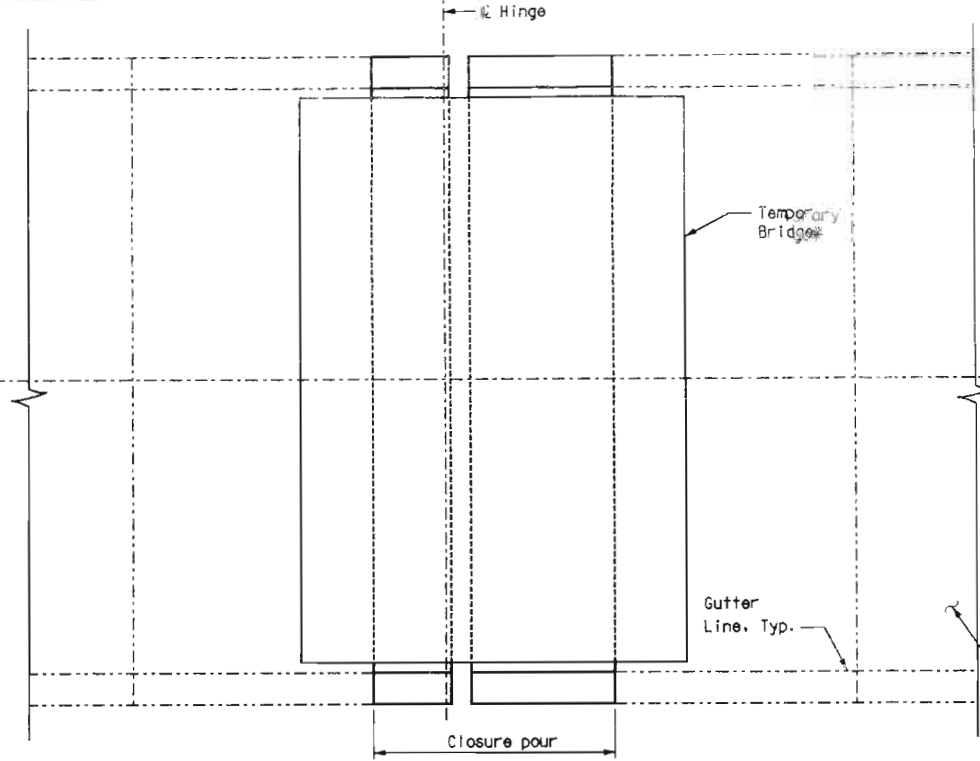

**TEMPORARY BRIDGE OVER CLOSURE POUR**  
(Closure Pour at Hinge shown. End Bent similar.)

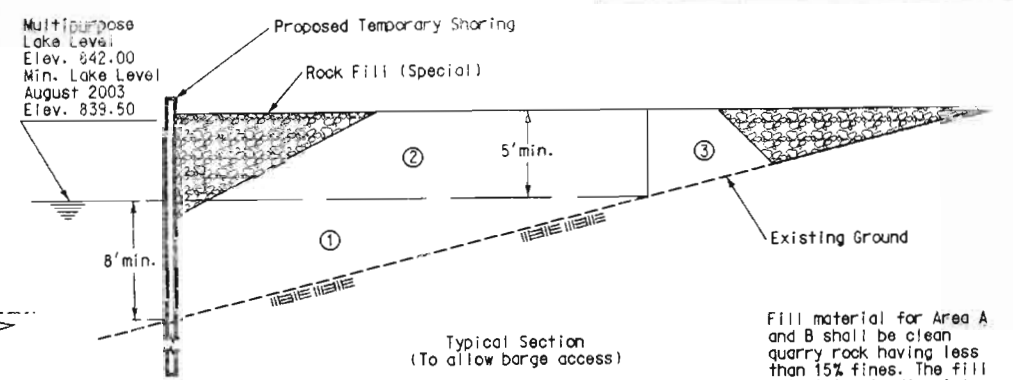


For information only:  
 ① Fill below Multipurpose Lake Level=288 c.y.  
 ② Fill above Multipurpose Lake Level=361 c.y.  
 ③ Fill above Land=115 c.y.

Fill material for Area A and B shall be clean quarry rock having less than 15% fines. The fill material extending into the lake shall be removed after construction, and the foot print of fill material in the lake shall be restored to the original conditions.


**DETAIL OF TEMPORARY WORK PAD (AREA A)**

Notes:  
 Temporary Work Pad dimensions shown are for information only. Contractor shall submit for approval, design calculations and details of temporary shoring and fill. See Temporary Shoring Special Provision. Contractor shall submit for approval, details and procedures of placing and removing fill. Contractor shall submit for approval, to U.S. Army Corps of Engineers, drawings indicating limits of Temporary Work Pad (Area A).

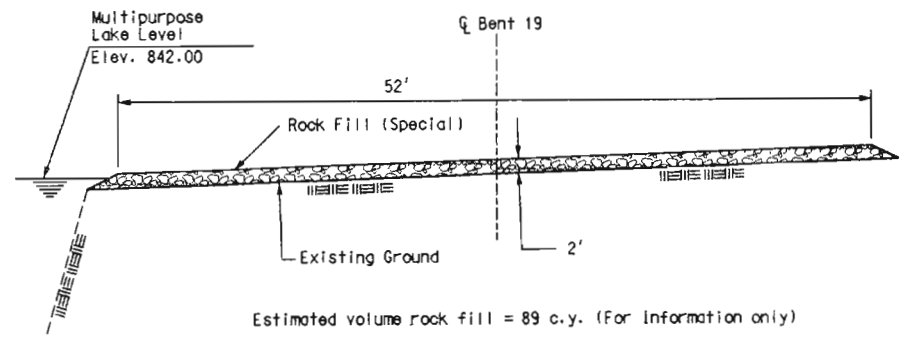


**DETAIL OF TEMPORARY WORK PAD (AREA B)**


Notes:  
 Temporary Work Pad dimensions shown are for information only. Contractor shall submit for approval, details and procedures of placing and removing fill. Contractor shall submit for approval, to U.S. Army Corps of Engineers, drawings indicating limits of Temporary Work Pad (Area B).

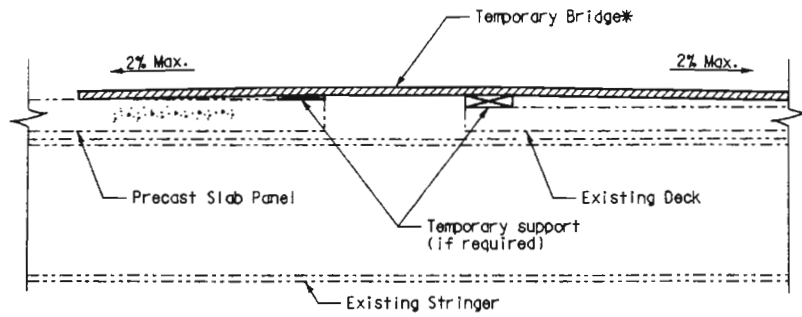

**SECTION OF TEMPORARY BRIDGE AT TEMPORARY JOINT**

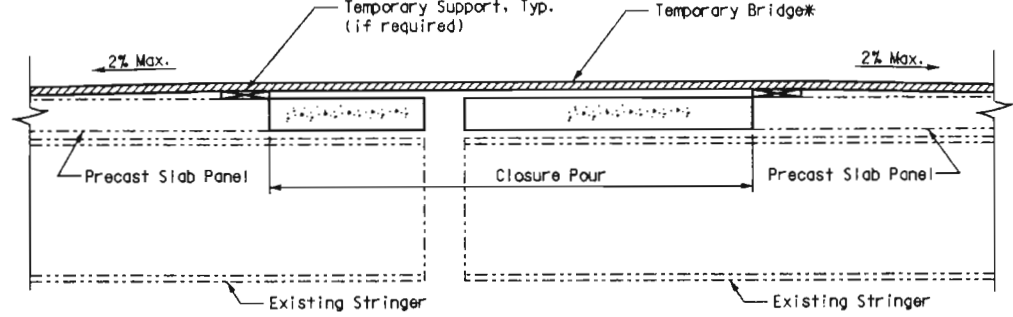


**SECTION OF TEMPORARY BRIDGE AT CLOSURE POUR**  
(Closure Pour at Hinge shown. End Bent similar.)

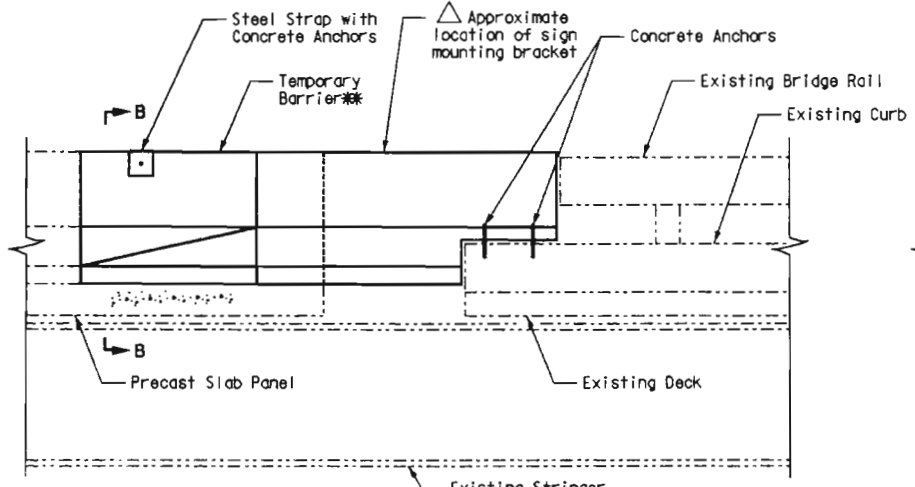


**ELEVATION OF TEMPORARY BARRIER AT TEMPORARY JOINT**

△ Provide mounting bracket for traffic control sign, see roadway plans for sign details.

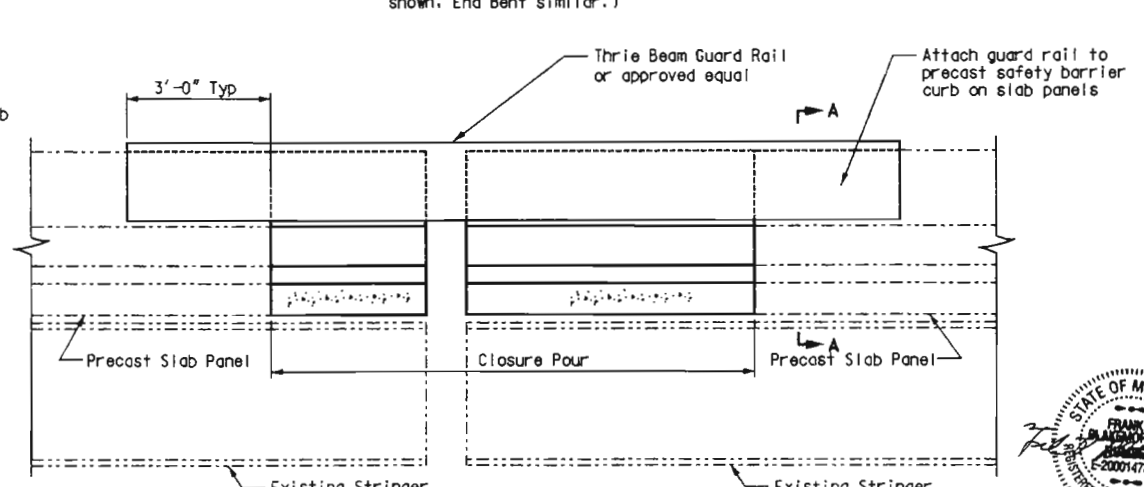

**ELEVATION OF SAFETY BARRIER AT CLOSURE POUR**  
(Closure Pour at Hinge shown. End Bent similar.)

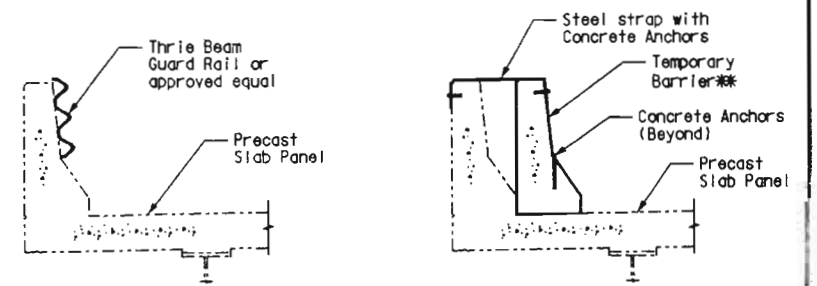

**SECTION A-A**


**SECTION B-B**

Notes:  
 \* Temporary Bridge shown is schematic only. See General Notes and Special Provisions. Payment will be considered subsidiary to other items of work.  
 \*\* Temporary Barrier shown is schematic only. See General Notes and Special Provisions for Temporary Bridge. Payment will be considered subsidiary to other items of work.  
 Thrie beam guardrail (or approved equal) at closure pour shall remain in place until the cast-in-place safety barrier curb has achieved full design strength. Contractor shall submit shop drawings for approval showing attachment of thrie beam guard rail to precast panel barrier curb, payment will be considered subsidiary to other items of work.


**CONSTRUCTION DETAILS**



K:\B33418\RI 64 Precast Deck\Drawings\p05b.dgn  
 22-DEC-2003 09:17  
 HNTB

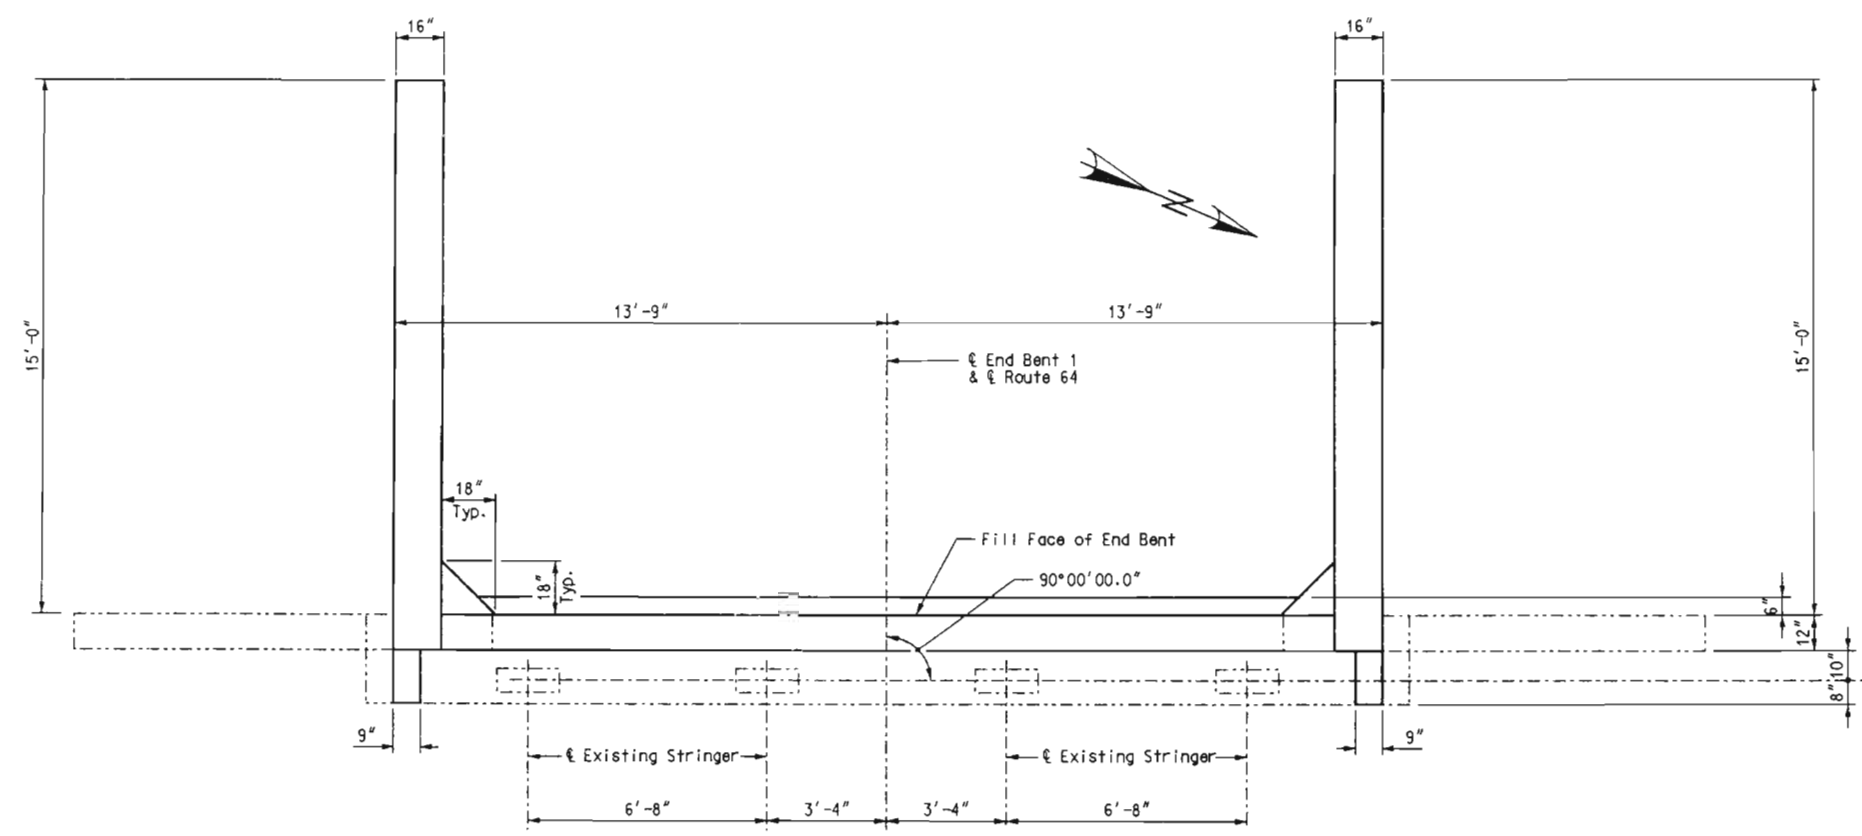


**PLAN**

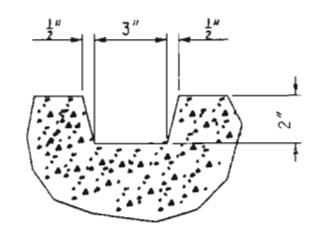


**DETAIL OF UPPER CONST. JOINT**

\* Pour concrete above upper construction joint after expansion device is placed.  
 Δ Lap #4-V101 and #4-V102 with existing #4 reinforcing a minimum of 15" (30 diameters).  
 † Lap #6-H103 with existing reinforcing a minimum of 24".

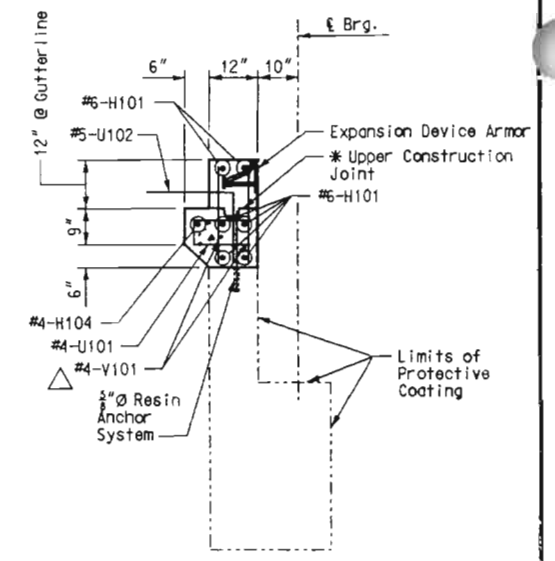


**SECTION A-A**

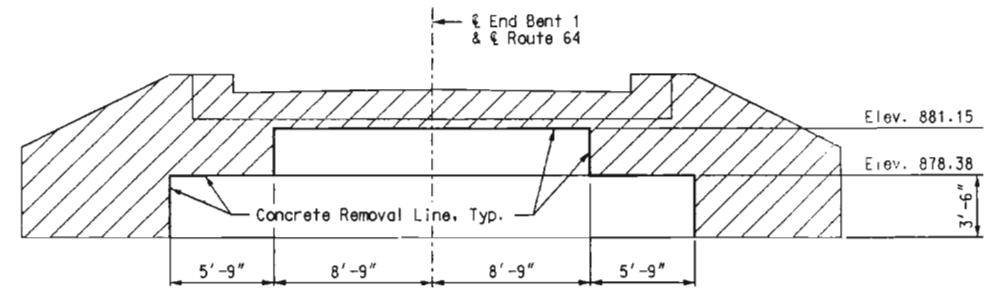


**REMOVAL LIMITS**  
(Looking Backstation)

Area to be removed  
 The area exposed by the removal of concrete and not covered with new concrete shall be coated with an approved bituminous paint

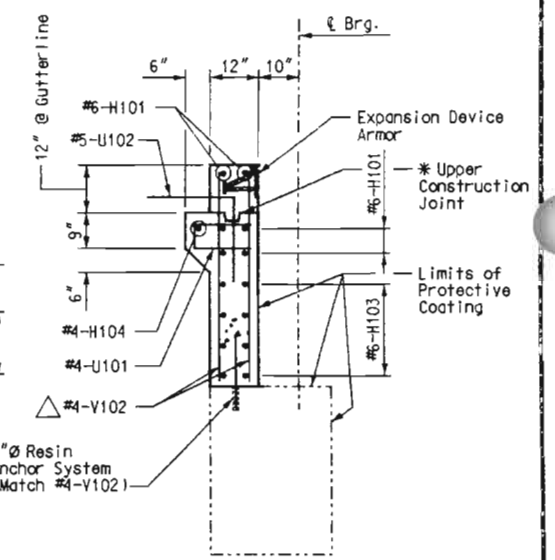

**SECTION B-B**

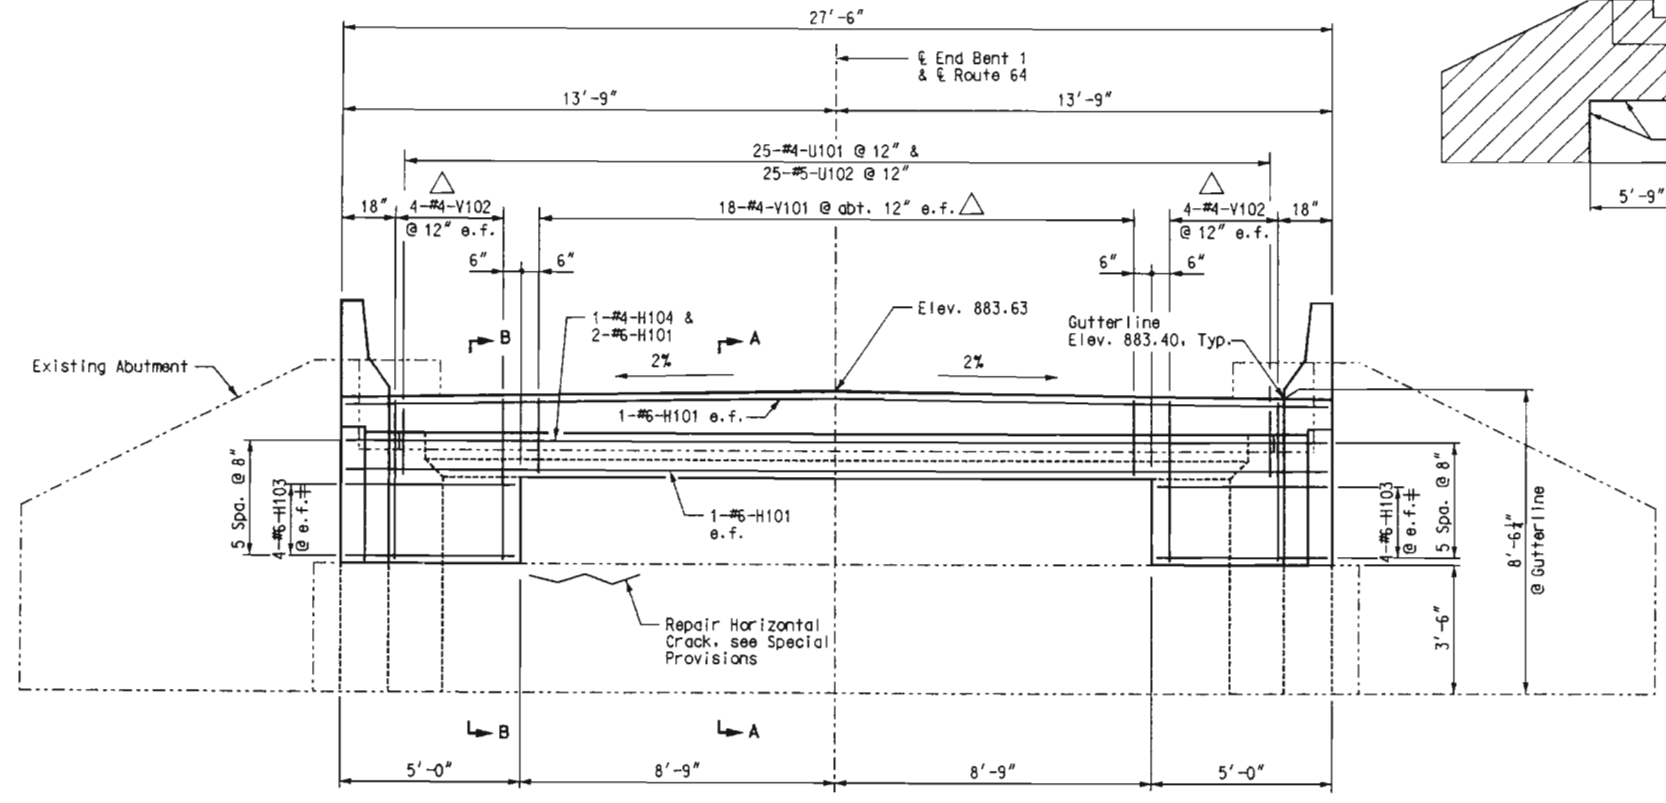

**ELEVATION**  
(Looking Backstation)


ITEM	UNITS	QUANTITY
Class 1 Excavation	Cu. Yds.	35
Substructure Repair (Formed)	Sq. Ft.	4
Class B-1 Concrete (Substr.)	Cu. Yds.	12.7
Reinforced Steel (Bridges)	Lbs.	1,590
Reinforcing Steel (Epoxy Coated)	Lbs.	1,080

Notes:  
 The Substructure Quantities are included in the Estimated Quantities table on Sheet No. 2.  
 Existing bearings to be cleaned, lubricated and coated, see Special Provisions.  
 For Wingwall Details, see Sheet No. 8.  
 For Safety Barrier Curb Details, see Sheet No. 29.  
 Footings are not shown for clarity.  
 Cost for furnishing and installing the resin anchor systems, complete in place, shall be included in the Class B-1 Concrete (Substr.).  
 Place resin anchor systems to clear any existing horizontal or vertical reinforcing; e.f. denotes each face




**END BENT 1 MODIFICATIONS**

USER: jthompson  
 PLOTFILE: 23-DE-2003-09-17  
 I:\NO354\BENT 64 - Precast Deck\Drawings\p14.dwg

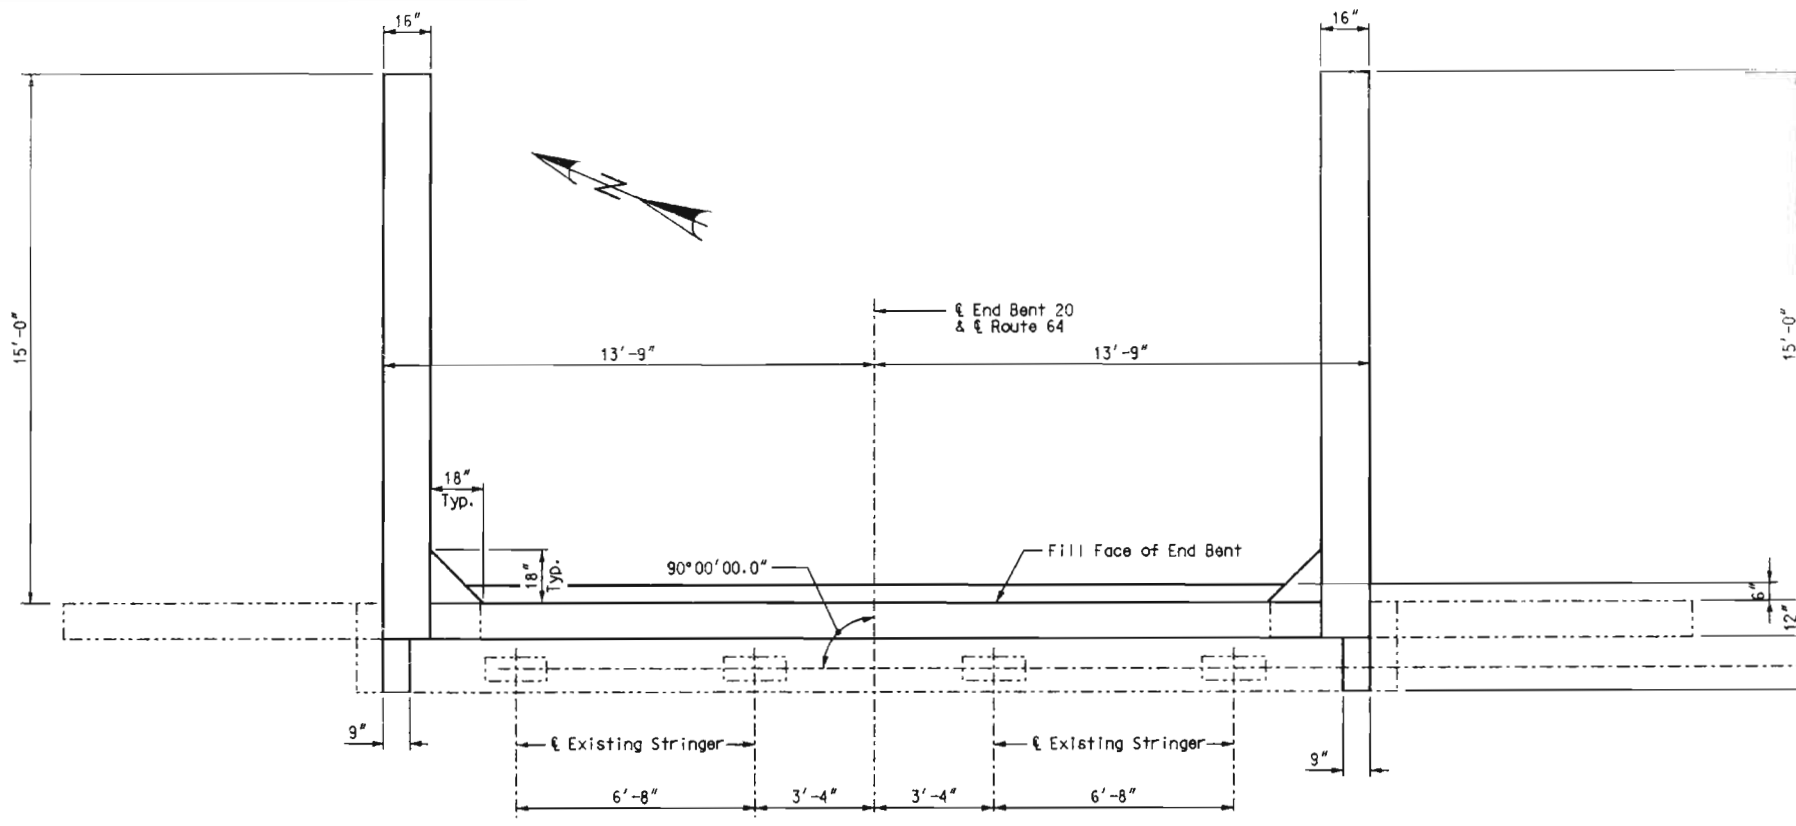


**PLAN**

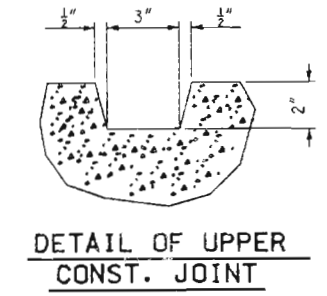


**DETAIL OF UPPER CONST. JOINT**


\* Pour concrete above upper construction joint after expansion device is placed.  
 △ Lap #4-V2001 and #4-V2002 with existing #4 reinforcing a minimum of 15" (30 diameters).  
 † Lap #6-H2003 with existing reinforcing a minimum of 24".

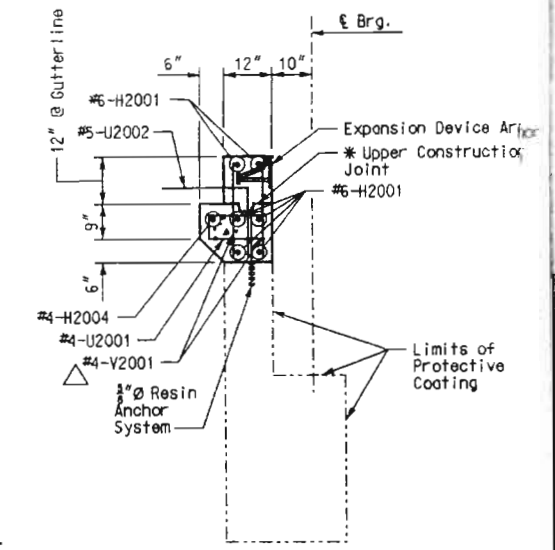

**SECTION A-A**

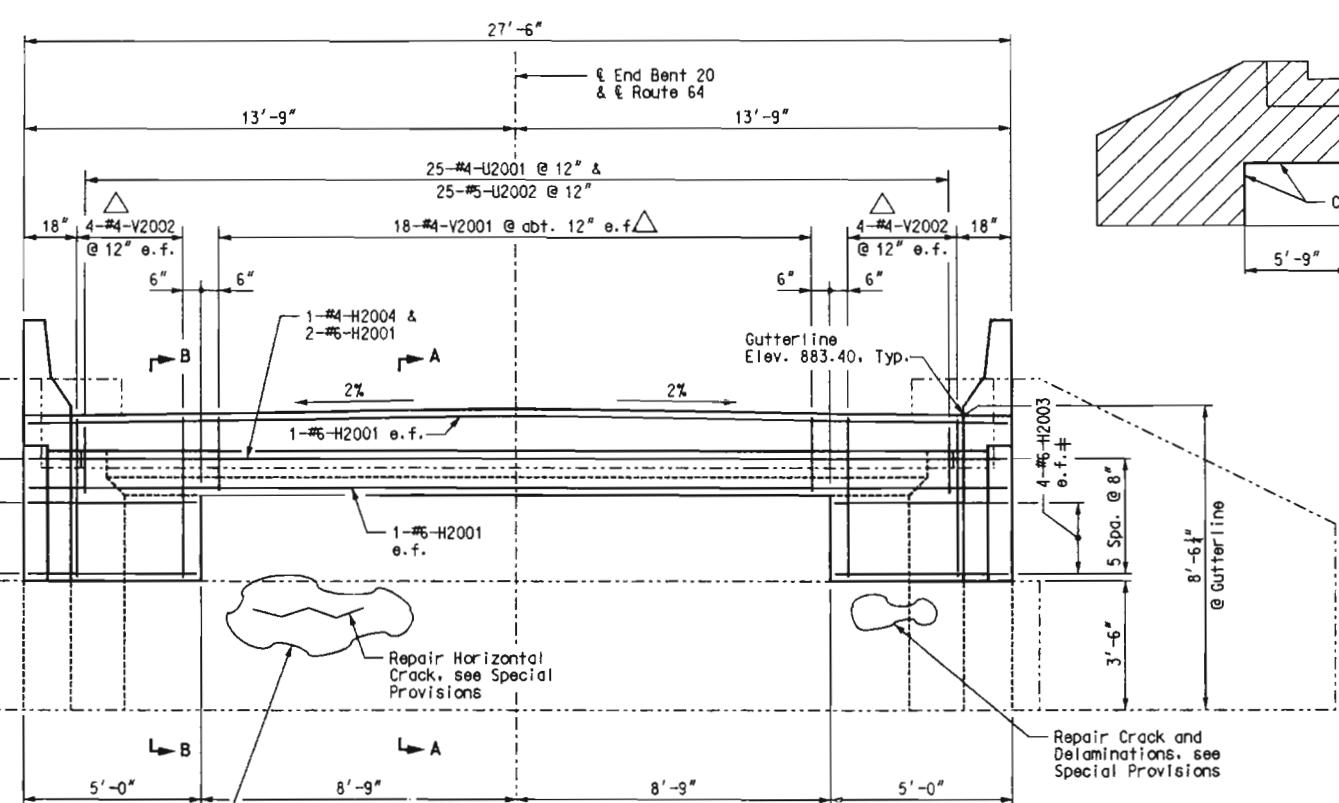


**ELEVATION**

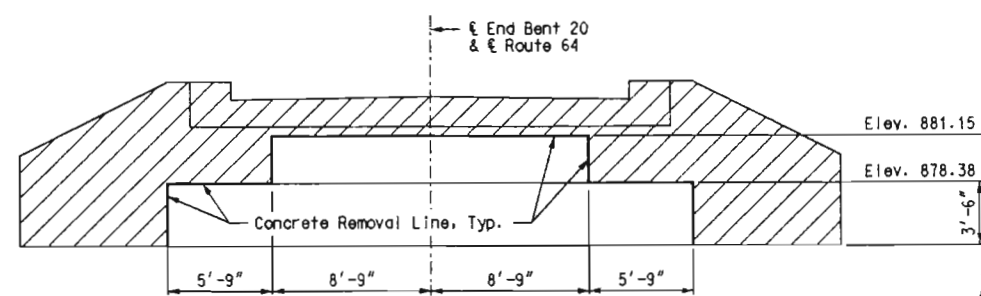

**REMOVAL LIMITS**

Area to be removed  
 The area exposed by the removal of concrete and not covered with new concrete shall be coated with an approved bituminous paint

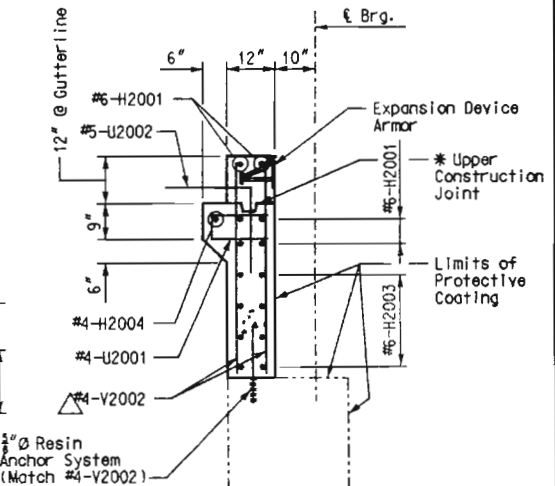

**SECTION B-B**

**SUBSTRUCTURE QUANTITY TABLE FOR END BENT 20**

ITEM	UNITS	QUANTITY
Class 1 Excavation	Cu. Yds.	35
Substructure Repair (Formed)	Sq. Ft.	14
Substructure Repair (Unformed)	Sq. Ft.	20
Class B-1 Concrete (Substr.)	Cu. Yds.	12.7
Reinforced Steel (Bridges)	Lbs.	1,590
Reinforcing Steel (Epoxy Coated)	Lbs.	1,020

Notes:  
 The Substructure Quantities are included in the Estimated Quantities table on Sheet No. 2.  
 Existing bearings to be cleaned, lubricated and coated, see Special Provisions.  
 For Wingwall Details, see Sheet No. 8.  
 For Safety Barrier Curb Details, see Sheet No. 29.  
 Footings are not shown for clarity.  
 Cost for furnishing and installing the resin anchor systems, complete in place, shall be included in the Class B-1 Concrete (Substr.).  
 Place resin anchor systems to clear any existing horizontal or vertical reinforcing. e.f. denotes each face.

**END BENT 20 MODIFICATIONS**


12/20/03  
 22-DEC-2003 09:17  
 W:\334\B\NRI 64 Precast Deck Drawings\p05.dgn

Detailed SEP 2003  
 Checked NOV 2003




Note: This drawing is not to scale. Follow Dimensions.




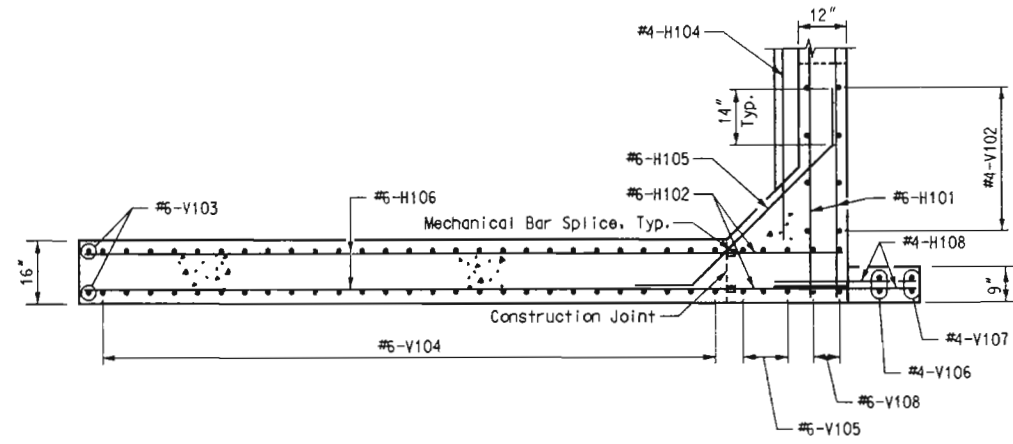

SECTION A-A

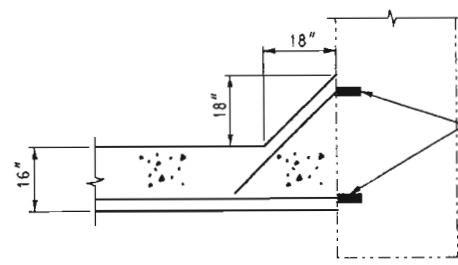


SECTION D-D

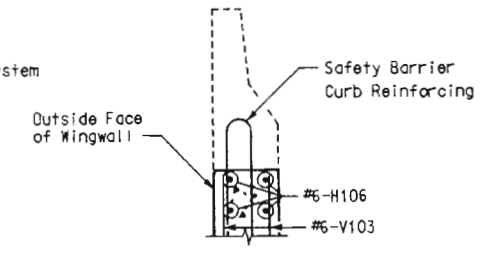


SECTION C-C

Note:  
 \* Pour concrete above upper construction joint after expansion device is placed.  
 \*\* #5-K103 and #5-K104 shall be spaced as shown on Sheet No. 29.

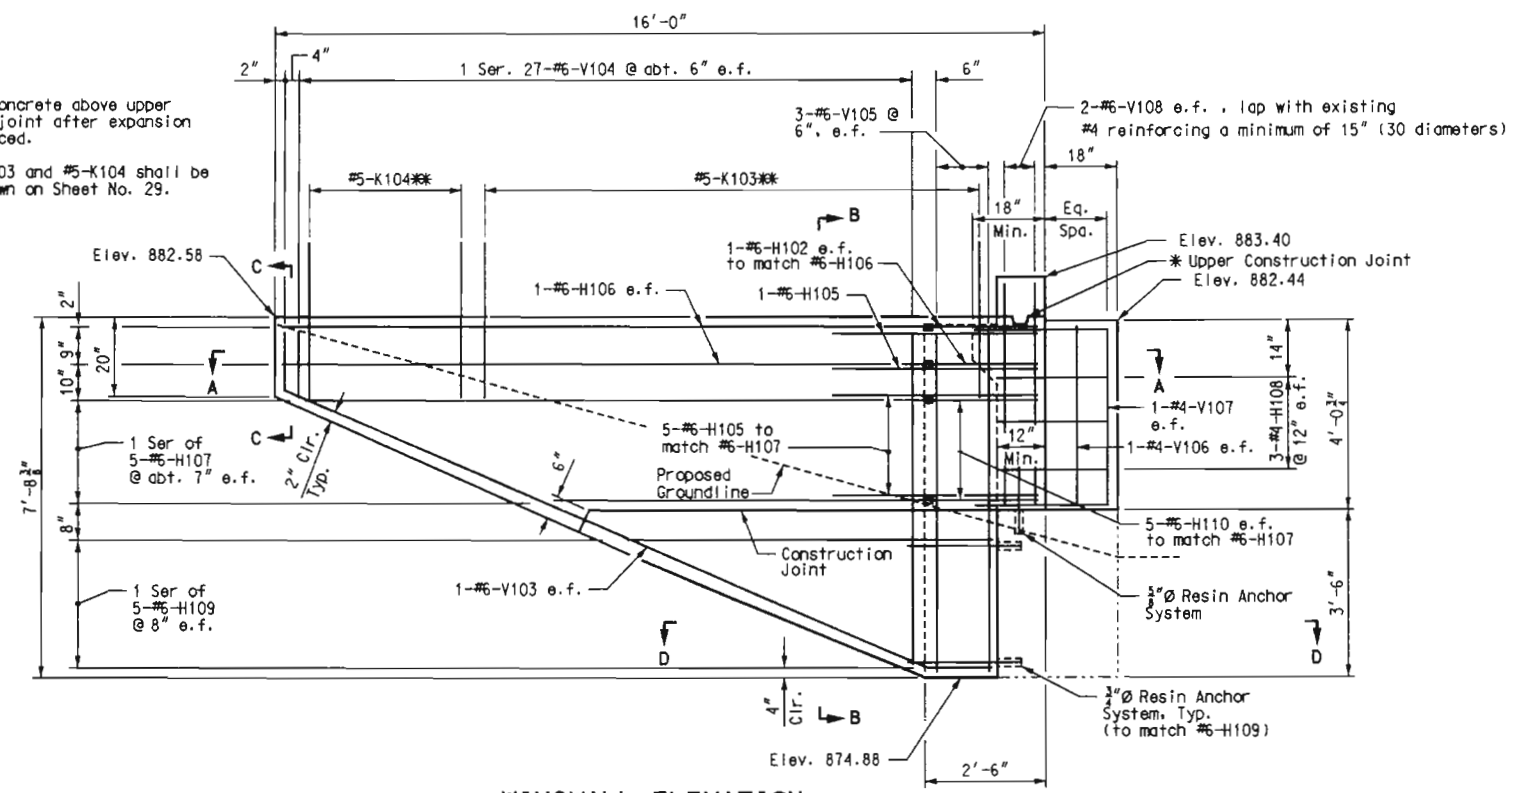

WINGWALL ELEVATION

End Bent 1 Right Side Shown (Left Side Opposite)  
 End Bent 20 Left Side Shown (Right Side Opposite)

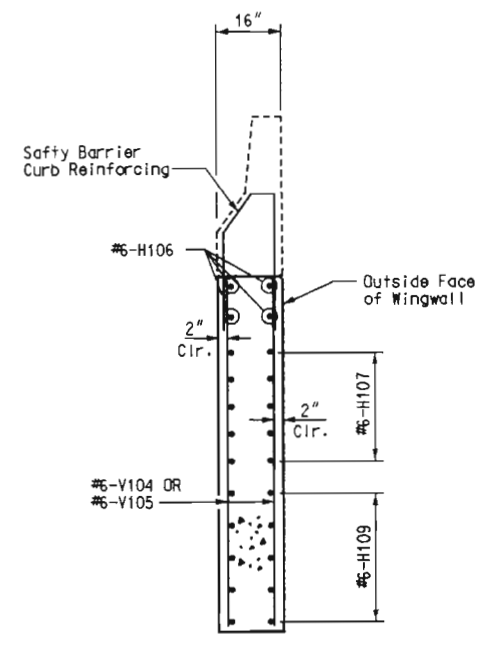


SECTION B-B

Notes:  
 Bar Marks shown are for End Bent 1 using "100" series Bar Marks.  
 End Bent 20 is similar, except use "2000" series Bar Marks.  
 e.f. denotes each face.  
 For Safety Barrier Curb Details, see Sheet No. 29.  
 Cost for furnishing and installing the resin anchor systems, complete in place, shall be included in the Class B-1 Concrete (Substr.).  
 Place resin anchor systems to clear any existing horizontal or vertical reinforcing.


WINGWALL DETAILS  
 END BENTS 1 AND 20




USER: jthom5003  
 PLOTTED: 22-DEC-2003 10:10  
 K:\033418\B1\04\_Precast Deck\Drawings\p06.dgn

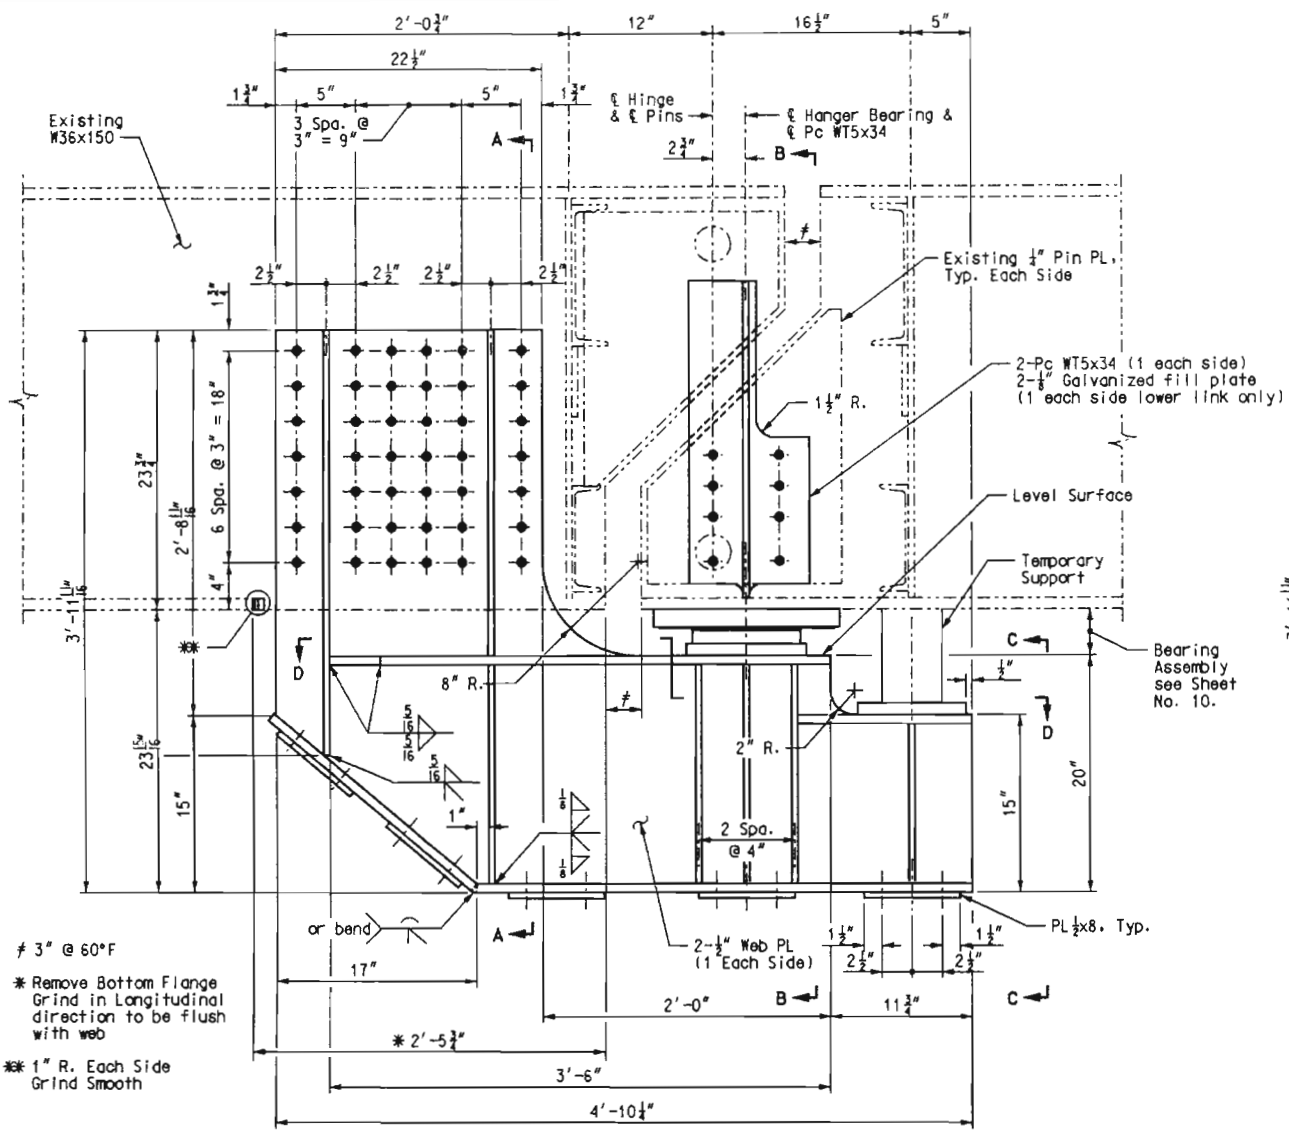


**ELEVATION AT HINGE**

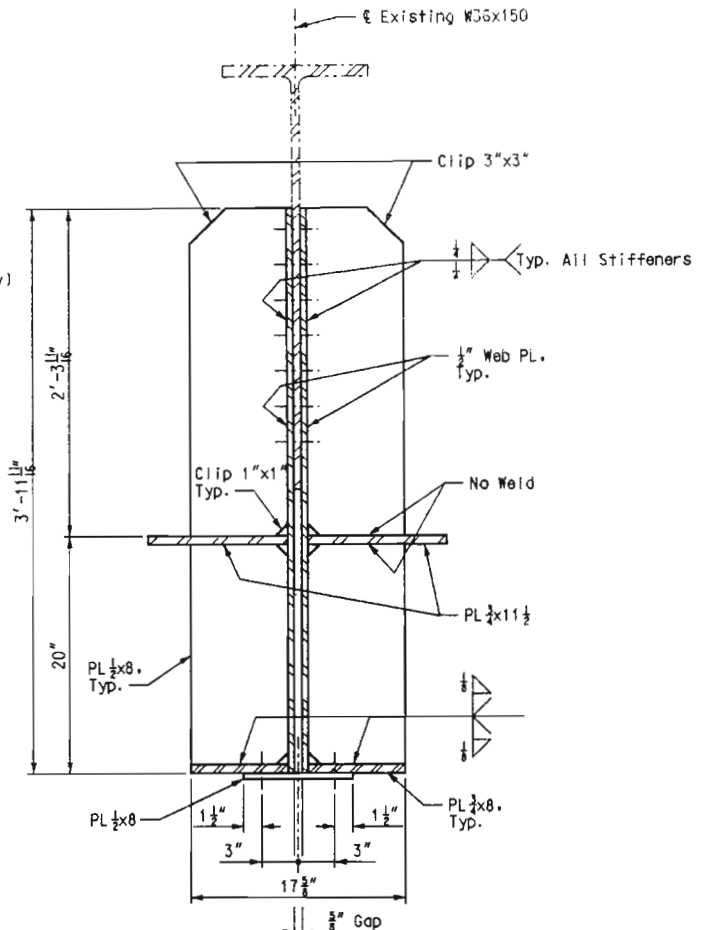


**SECTION A-A**

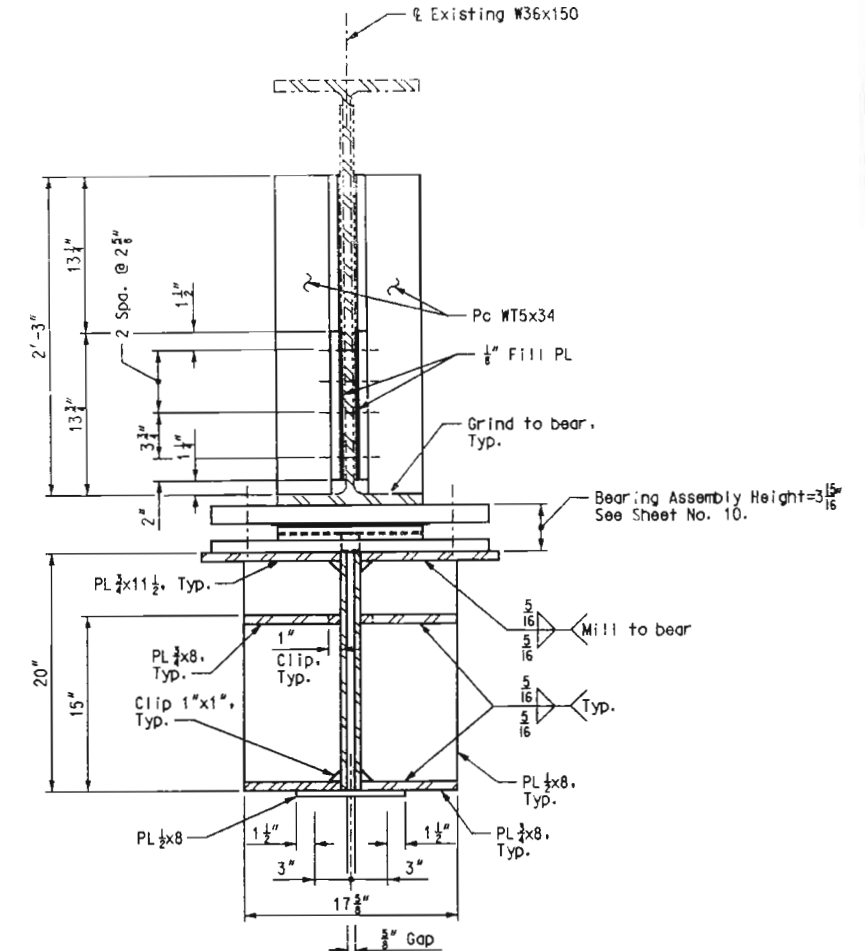

**SECTION B-B**

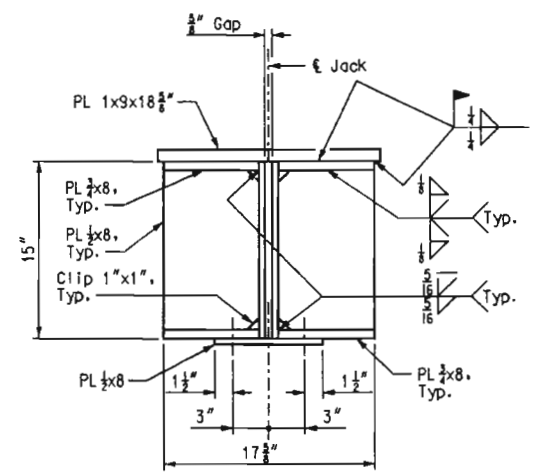

**SECTION C-C**

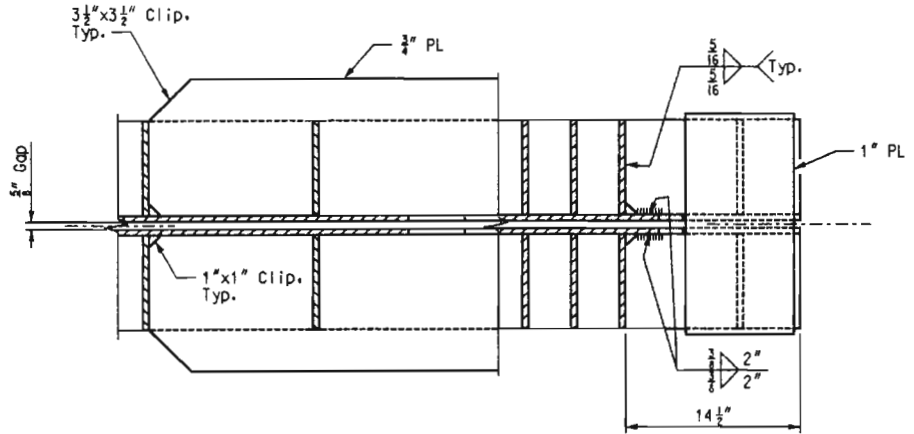

**SECTION D-D**

# 3" @ 60°F  
 \* Remove Bottom Flange Grind in Longitudinal direction to be flush with web  
 \*\* 1" R. Each Side Grind Smooth

Notes:  
 All structural steel shall be ASTM A709, Grade 36.  
 All bolts shall be 1/2" ASTM A325 H.S. bolts, holes 15/16" Ø.  
 Payment for the hanger bearing assembly, bottom flange removal and materials shown on this sheet shall be included in the contract unit price for Hanger Retrofit at Hinges.  
 All hanger retrofit materials shall be coated similar to existing stringers and comply with hanger bearing requirements.  
 No construction equipment shall be located on supported span while span is temporarily supported.

**REPLACEMENT OF HANGER RETROFIT AT HINGES SEQUENCE:**


1. Remove bottom flange of support stringer, grind in longitudinal direction to be flush with web as shown in Elevation at Hinge.
2. Attach hanger bracket.
3. Jack stringers.
4. Remove existing links and pins.
5. Clean and prime coat.
6. Install new bearings, attach Pc WT5x34 and lower stringers onto bearings.




**DETAILS OF HANGER RETROFIT AT HINGES**

10-DLC-2003 16-09 k:\b33418\18\Ft 64 Precast Deck\Drawings\p07.dgn  
 Checked: [Name] Date: [Date]  
 Detailed: [Name] Date: [Date]





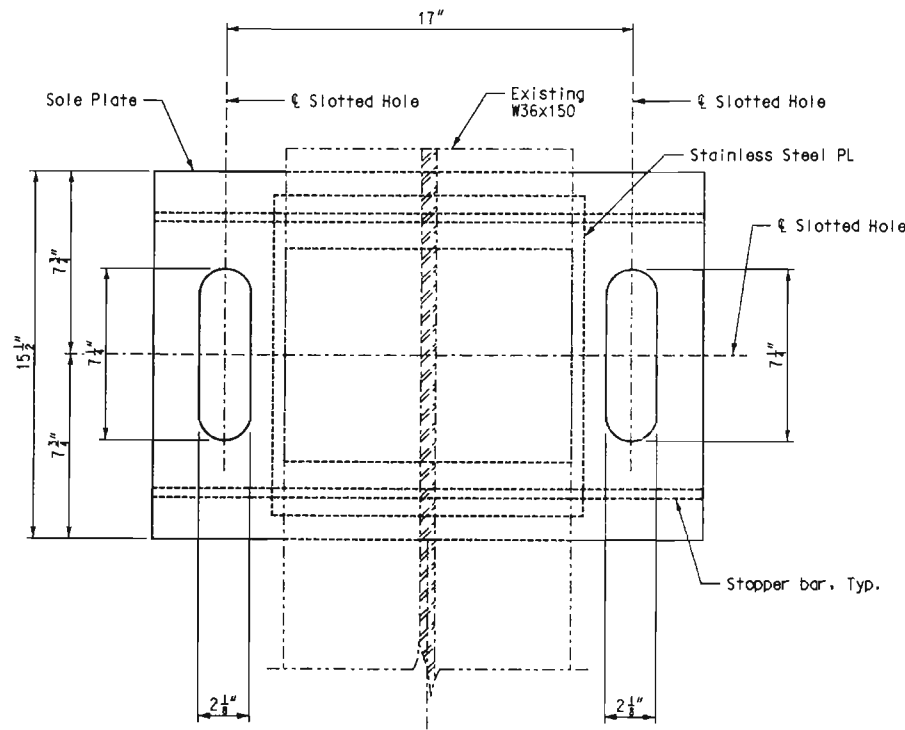


PART PLAN

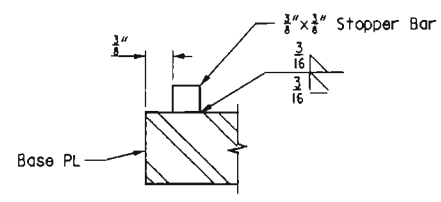


DETAIL A

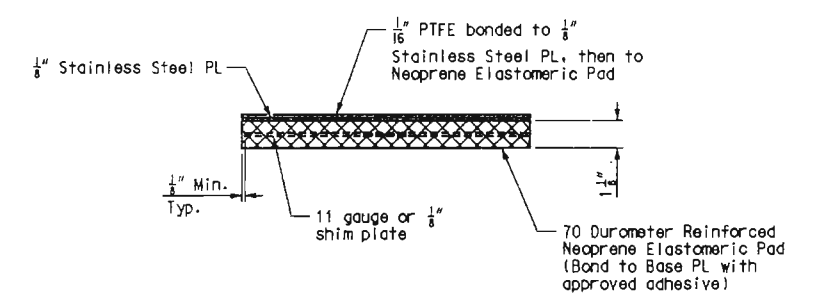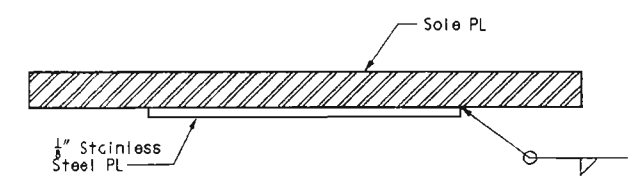

NEOPRENE ELASTOMERIC PAD

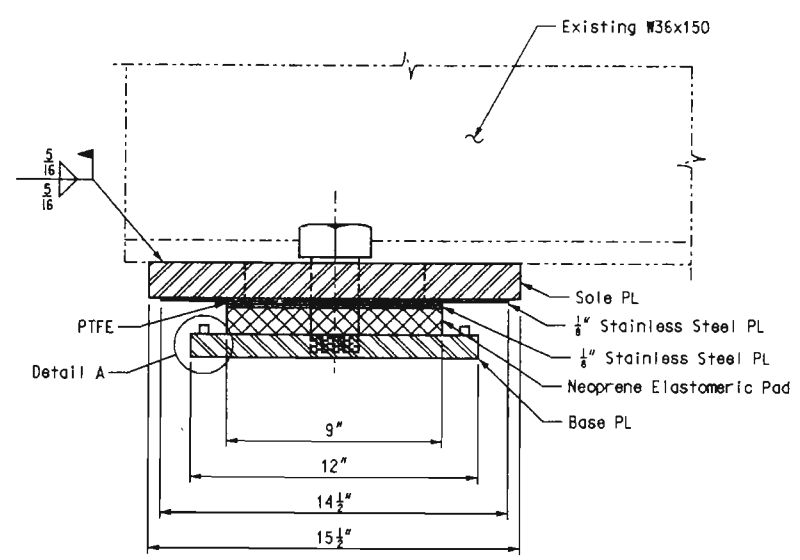

SIDE VIEW

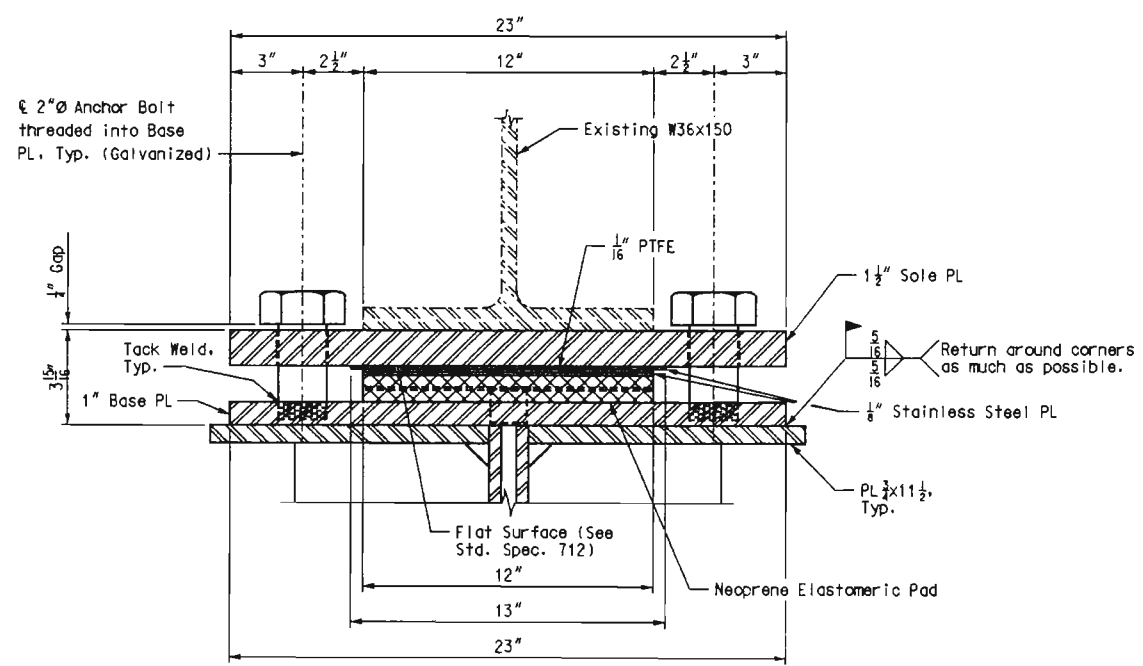

END VIEW


Note: Stopper Bar not shown for clarity.

Notes:


- Provide a  $\frac{3}{8} \times \frac{3}{8}$  stopper bar to prevent the loss of support due to creeping of the PTFE bearings from under stringers at expansion bearings.
- To prevent sliding, the neoprene pad shall be bonded to the base plate as approved by the bearing manufacturer for bonding neoprene to steel.
- The bottom face of the  $\frac{1}{8}$  stainless steel plate that is welded to the sole plate shall be lubricated with a lubricant that is approved by the bearing manufacturer.
- Anchor bolts shall be ASTM A709 Grade 50 steel.
- The sole plate and base plate shall be furnished with the bearing and field welded to the stringers.
- Structural steel for the sole plate and base plate shall be ASTM A709 Grade 36.
- Payment for the sole plate, masonry plate, anchor bolts, stainless steel plates, PTFE and Neoprene elastomeric pad, (bearing assembly), shall be included in the cost of the Hanger Retrofit at Hinges.
- Sole plate and base plate shall be coated similar to existing stringers.



USER: jthompson  
 PLOTTED: 10-DEC-2003 16:09  
 K:\6334\B\VI 64 - Precast Deck Drawings\p07a.dgn

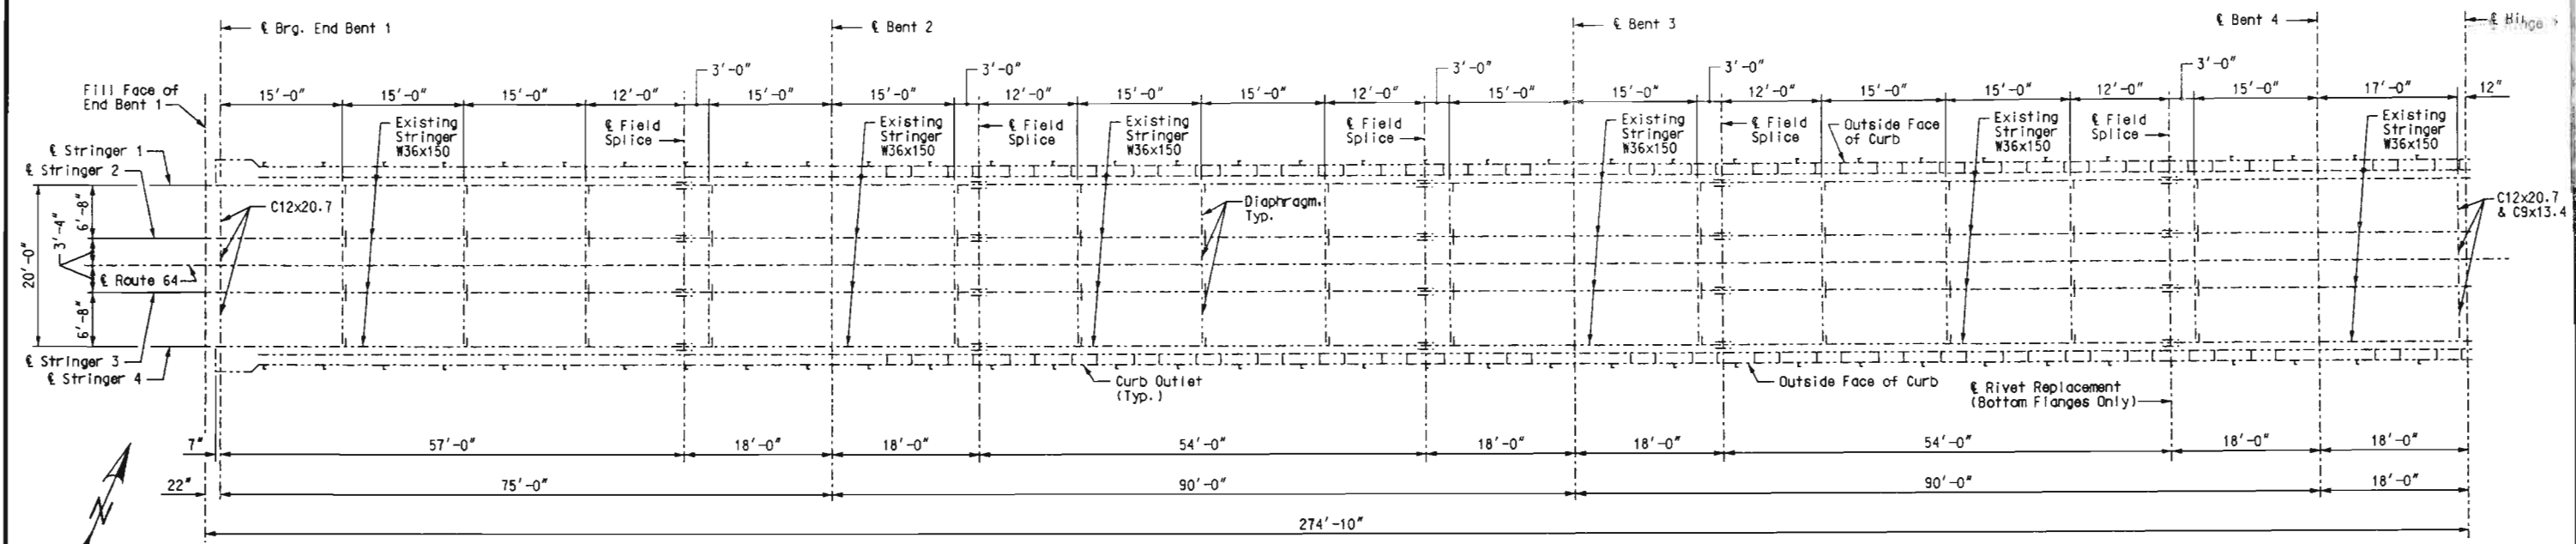

SPAN (1-2) SPAN (2-3) SPAN (3-4) SPAN (4-HINGE)

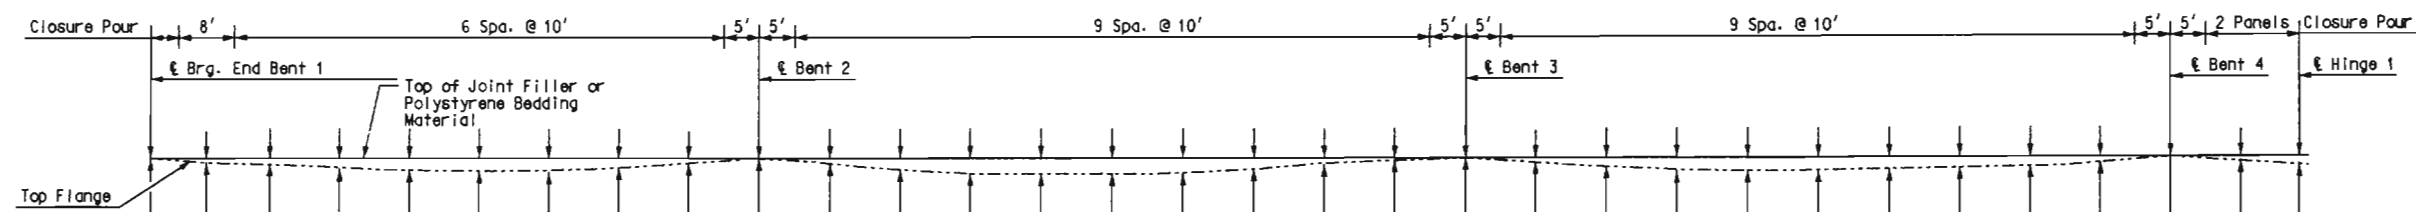


Total	Stringers 1 & 4	1	1 1/16	1 3/8	1 3/8	2	1 3/4	1 5/16	1	1	1 1/2	1 11/16	1 11/16	1 15/16	2 1/4	1 13/16	1 5/16	1	1	1	1 1/2	1 3/4	2 1/16	2	2 9/16	1 15/16	1 1/4	1	1	1	1 1/4	2 1/2	
	Stringers 2 & 3	2 3/8	2 3/8	3 1/8	3 3/8	3 15/16	3 3/8	3 1/4	2 13/16	2 3/8	2 3/8	2 13/16	3 3/8	3 3/4	3 11/16	4 3/16	3 11/16	3 3/4	2 13/16	2 3/8	2 3/8	2 13/16	3 7/16	3 13/16	3 3/4	4 7/16	3 13/16	3 3/16	2 3/8	2 3/8	2 3/8	2 15/16	4 1/4

SPAN (1-2) SPAN (2-3) SPAN (3-4) SPAN (4-HINGE)

ESTIMATED JOINT FILLER THICKNESS


Notes: All values are given in inches and are for information only. Estimated Joint Filler thicknesses shown are based on an erection analysis assuming 30% of existing deck is removed and 30' of Precast Slab Panels are replaced each work period. A 10' gap (one panel width) between the existing deck and Precast Slab Panels is assumed to occur at the end of each work period. Closure pours occur after all Precast Slab Panels in the span are erected. A maximum of 1/4" (at midspan) has been added to stringers 2 & 3 values to evenly distribute the Slab Panel load to the stringers. The Contractor shall perform an erection analysis to determine joint filler thickness and shall submit details and calculations to the Engineer for approval.

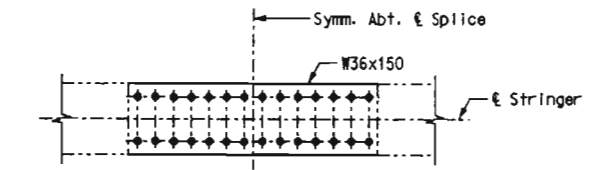

BOTTOM FLANGE RIVET REPLACEMENT PLAN

(16 Locations Required)  
See Framing Plans for locations.

Note: Starting at  $\ell$  of splice remove 2 rivets each side of  $\ell$  of splice and replace with fully torqued 3/4" A325 bolts. Symmetrically continue removal/replacement in groups of two each side of  $\ell$  of splice. Progress to splice plate ends while having no more than 2 open holes each side of  $\ell$  of splice.

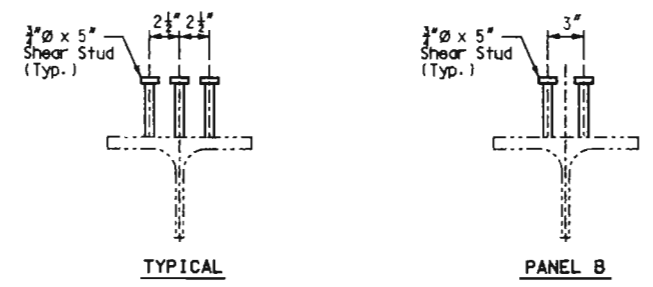



SHEAR CONNECTOR DETAILS

Notes: Existing structural steel stringers over intermediate bents, bearing plates at intermediate bents, and stiffener plates at intermediate bents are ASTM-A373 material. All other structural steel is ASTM-A7 material. Shear connectors shall meet the requirements of Section 1037 of the Missouri Standard Specifications. For location of slab panel drain attachment holes see Slab Panel Drain Details, Sheet No. 24.



FRAMING PLAN AND STRINGER DEFLECTIONS UNIT 1

USER: jth  
 PLOTTED: 22-DEC-2003 09:18  
 k:\b33418\RT 64 Precast Deck\drawings\p08.dgn

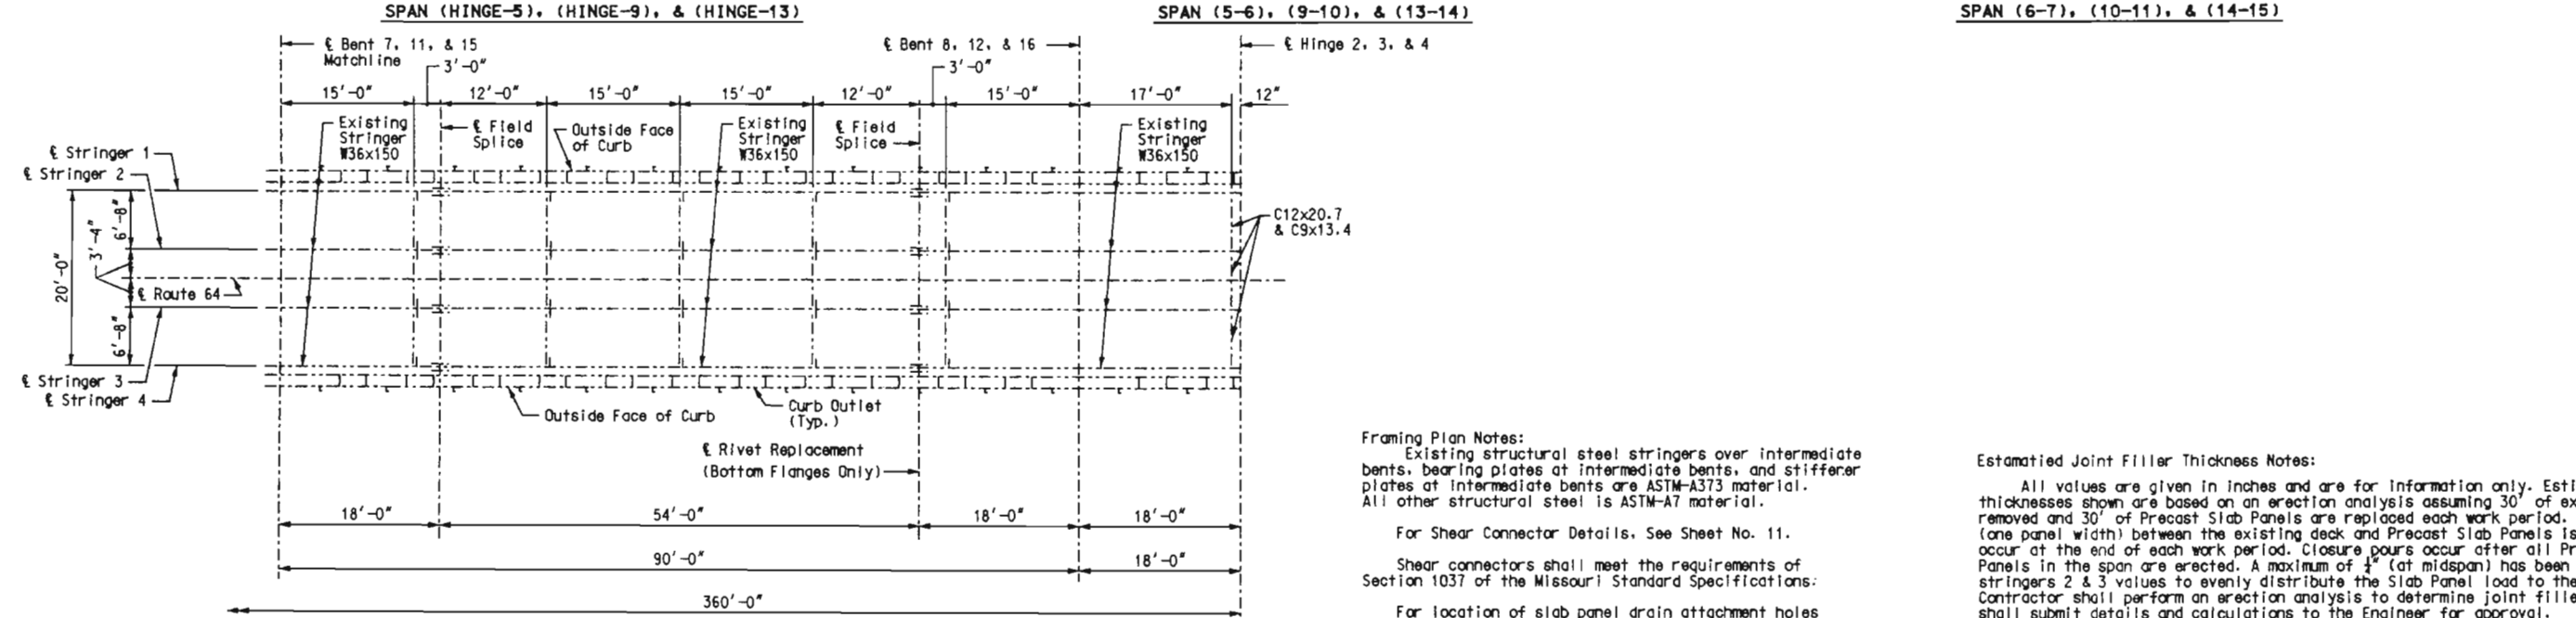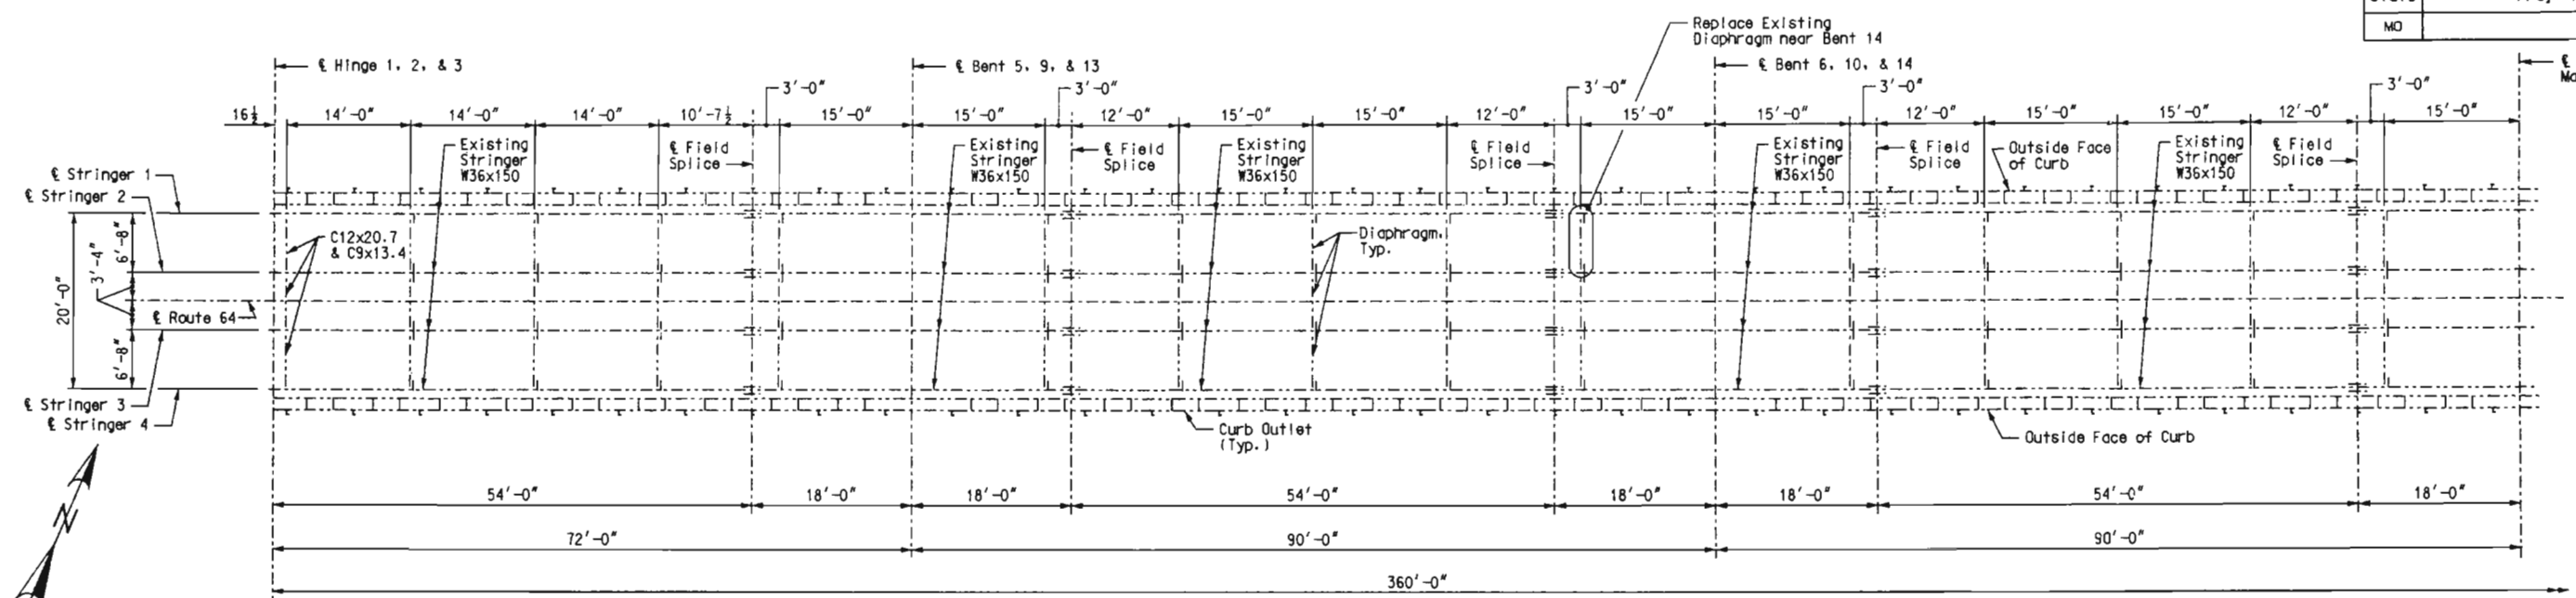

**Framing Plan Notes:**  
 Existing structural steel stringers over intermediate bents, bearing plates at intermediate bents, and stiffener plates at intermediate bents are ASTM-A373 material. All other structural steel is ASTM-A7 material.  
 For Shear Connector Details, See Sheet No. 11.  
 Shear connectors shall meet the requirements of Section 1037 of the Missouri Standard Specifications.  
 For location of slab panel drain attachment holes see Slab Panel Drain Details, Sheet No. 24.

**Estimated Joint Filler Thickness Notes:**  
 All values are given in inches and are for information only. Estimated Joint Filler thicknesses shown are based on an erection analysis assuming 30' of existing deck is removed and 30' of Precast Slab Panels are replaced each work period. A 10' gap (one panel width) between the existing deck and Precast Slab Panels is assumed to occur at the end of each work period. Closure pours occur after all Precast Slab Panels in the span are erected. A maximum of 1/4" (at midspan) has been added to stringers 2 & 3 values to evenly distribute the Slab Panel load to the stringers. The Contractor shall perform an erection analysis to determine joint filler thickness and shall submit details and calculations to the Engineer for approval.

	8'	6 Spa. @ 10'						5'	5'	9 Spa. @ 10'						5'	5'	9 Spa. @ 10'						5'	5'	2 Panels Closure Pour																
	€ Hinge 1, 2 and 3							€ Bent 5, 9 and 13							€ Bent 6, 10 and 14							€ Bent 7, 11 and 15							€ Bent 8, 12 and 16	€ Hinge 2, 3 and 4												
	Top Flange	Top of Joint Filler or Polystyrene Bedding Material																																								
Total	Stringers 1&4	2 1/2	2 7/16	2 1/2	1 15/16	1 1/16	1 1/16	1	1	1 1/8	1 11/16	2	1 15/16	2 1/4	1 13/16	1 3/16	1	1	1	1 1/8	1 11/16	1 15/16	1 15/16	2 1/4	1 13/16	1 3/16	1 3/16	1	1	1	1 1/8	1 13/16	2 1/8	2 1/8	2 11/16	2 1/8	1 1/2	1	1	1	1 3/16	2 1/4
	Stringers 2&3	4 1/4	4 3/16	4 1/8	3 13/16	3 3/4	2 11/16	2 3/8	2 3/4	3 3/8	3 3/4	3 11/16	4 3/16	3 11/16	3 3/16	2 13/16	2 3/8	2 3/8	2 13/16	3 3/8	3 3/4	3 11/16	4 3/16	3 3/8	3 3/16	2 3/4	2 3/8	2 3/8	2 3/8	2 13/16	3 1/2	3 3/8	3 3/8	4 1/8	4	3 3/8	2 1/4	2 3/8	2 3/8	2 3/8	2 3/8	4

SPAN (HINGE-5), (HINGE-9), & (HINGE-13)      SPAN (5-6), (9-10), & (13-14)      SPAN (6-7), (10-11), & (14-15)      SPAN (7-8), (11-12), & (15-16)      SPAN (8-HINGE), (12-HINGE), & (16-HINGE)

**ESTIMATED JOINT FILLER THICKNESS**

**FRAMING PLAN AND STRINGER DEFLECTIONS  
 UNITS 2, 3, AND 4**





USER: jthompson  
 PLOTTED: 22-DEC-2003 09:18  
 k:\33418\rt 64-Precast Deck drawings\p09.dgn

Detailed - SEPT 2003  
 Checked - NOV 2003



Note: This drawing is not to scale. Follow Dimensions.

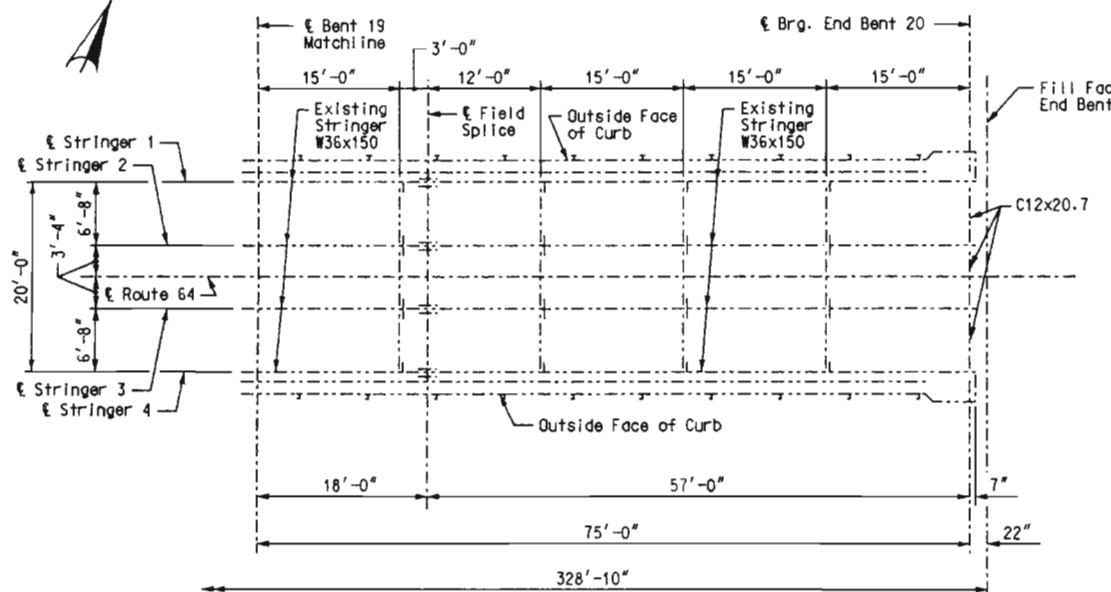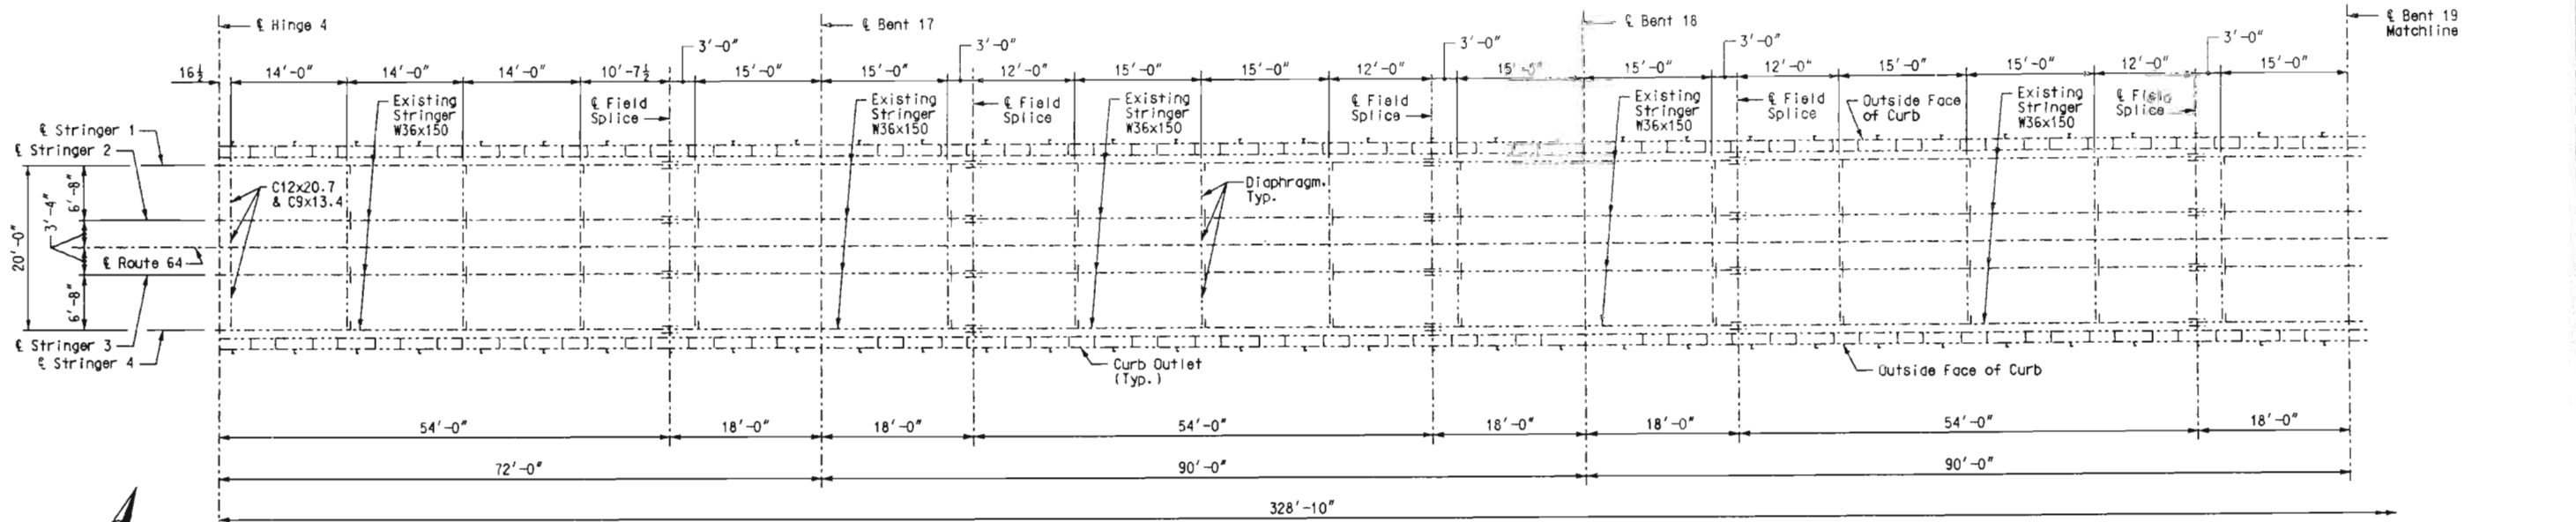

**Framing Plan Notes:**  
 Existing structural steel stringers over intermediate bents, bearing plates at intermediate bents, and stiffener plates at intermediate bents are ASTM-A373 material. All other structural steel is ASTM-A7 material.

For Shear Connector Details, See Sheet No. 11.

Shear Connectors shall meet the requirements of Section 1037 of the Missouri Standard Specifications.

For location of slab panel drain attachment holes see Slab Panel Drain Details, Sheet No. 24.

**Estimated Joint Filler Thickness Notes:**  
 All values are given in inches and are for information only. Estimated Joint Filler thicknesses shown are based on an erection analysis assuming 30' of existing deck is removed and 30' of Precast Slab Panels are replaced each work period. A 10' gap (one panel width) between the existing deck and Precast Slab Panels is assumed to occur at the end of each work period. Closure pours occur after all Precast Slab Panels in the span are erected. A maximum of 1/4" (at midspan) has been added to stringers 2 & 3 values to evenly distribute the Slab Panel load to the stringers. The Contractor shall perform an erection analysis to determine joint filler thickness and shall submit details and calculations to the Engineer for approval.

		8'	6 Spa. @ 10'	5'	5'	8 Spa. @ 10'	5'	5'	8 Spa. @ 10'	5'	5'	6 Spa. @ 10'	8'	Closure Panel
		€ Hinge 4			€ Bent 17			€ Bent 18			€ Bent 19		€ Brg. End Bent 20	
		Top Flange		Top of Joint Filler or Polystyrene Bedding Material										
Total	Stringers 1 & 4	2 1/2	2 1/2	2 9/16	2	1 7/16	1 1/16	1	1	1 1/8	1 1/16	1	1	1
	Stringers 2 & 3	4 1/2	4 1/2	4 7/16	3 1/8	3 5/16	2 13/16	2 1/2	2 1/8	2 1/4	3 7/16	3 1/2	3 11/16	3 1/2

SPAN (HINGE-17)      SPAN (17-18)      SPAN (18-19)      SPAN (19-20)

**ESTIMATED JOINT FILLER THICKNESS**

FRAMING PLAN AND STRINGER DEFLECTIONS  
UNIT 5



USER: hntb on 22-DEC-2003 09:15 k:\b334\B\RT 64 Precast Deck\Drawings\p10.dgn


Detail led SEPT 2003  
 Checked NOV 2003



Note: This drawing is not to scale. Follow Dimensions.

Sheet No. 13 of 35

HICKORY COUNTY A08941

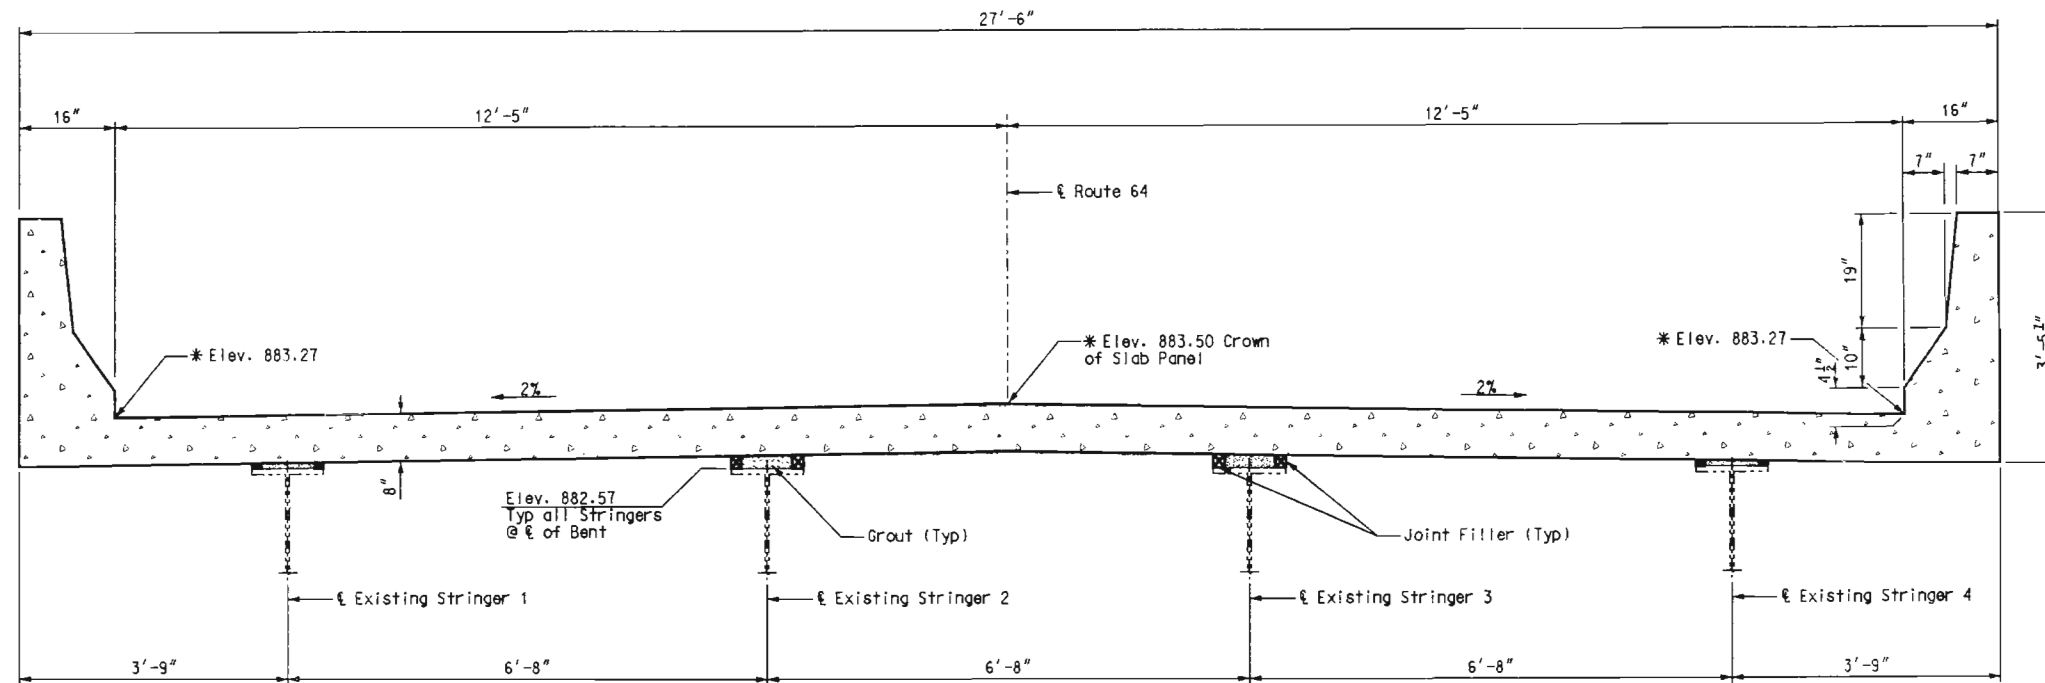


### TYPICAL SECTION SHOWING ELEVATIONS

\* Elevations are at top of slab panels and do not include wearing surface.

### PRECAST SLAB PANELS GENERAL NOTES:

1. The joint filler or polystyrene bedding material shall be cut to the required haunch height above top of flange to maintain top of slab panel elevations as shown. The joint filler or polystyrene bedding material shall be cut so that slab panels bear fully on all existing stringer flanges.
2. The surface of joint filler shall be cut to match bridge cross slope.
3. Joint filler shall be one piece thickness, not acceptable to build thickness up in layers. Minimum joint filler or polystyrene bedding material thickness shall be 1 inch, except over splice plates or cover plates where minimum thickness shall be 1/2 inch.
4. All panel support pads (joint filler or polystyrene bedding material) shall be glued to the stringer. When support thickness exceeds 1 1/2 inches, the pads shall be glued top and bottom. The glue used shall be the type recommended by the panel support pads manufacturer.
5. Joint filler shall be 1 1/2 inch wide for thickness up to 2 inches. width of joint filler over 2 inches thickness shall be thickness minus 1/2 inch.
6. Adjustment in the wearing surface thickness, joint filler or polystyrene bedding material thickness, or grade will be necessary if the stringer deflection after panel placement differs from plan deflection. No payment will be made for additional labor or materials for the adjustment.

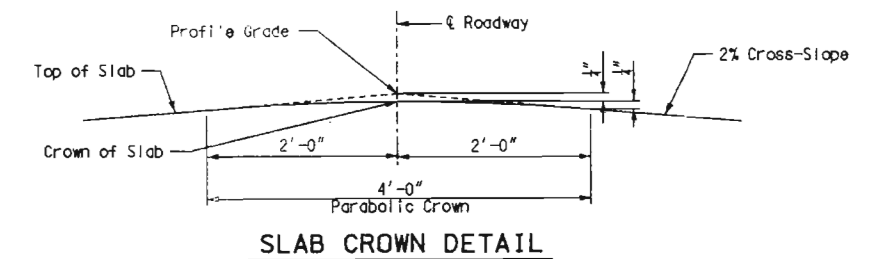

SLAB CROWN DETAIL



TOP OF SLAB PANEL ELEVATIONS

HICKORY COUNTY

A08941


Note: This drawing is not to scale. Follow Dimensions.

Sheet No. 14 of 35


Detailed OCT 2003  
Checked OCT 2003

**HNTB**

USER: jthompson  
 PLOTTED: 11-DEC-2003 10:58  
 k:\b33418\RT 64 Precast Deck Drawings\pl1.dwg

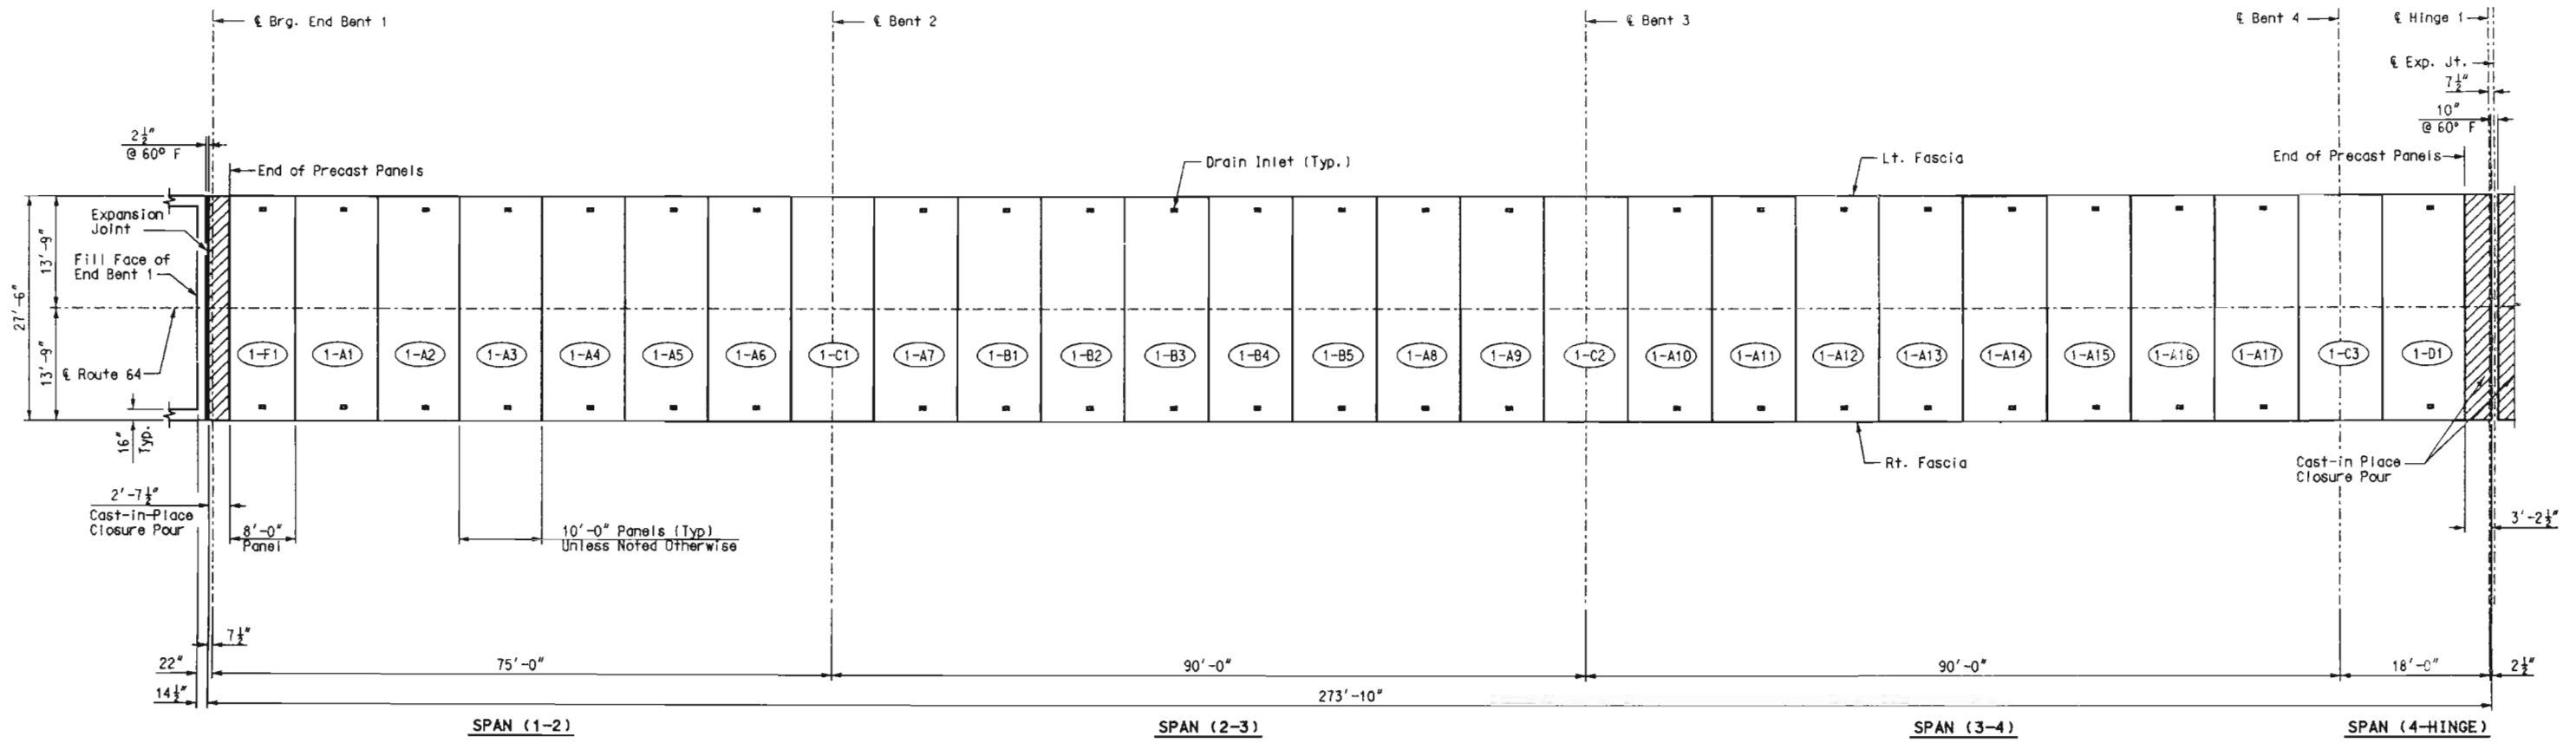

**PLAN**

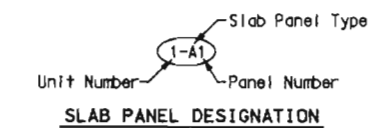


**Notes:**  
 For Typical Section, see Sheet No. 22.  
 For Safety Barrier Curb Details, see Sheet No. 25 and 28.  
 For Slab Drain Details, see Sheet No. 24.  
 For Closure Pour Details, see Sheet No. 26.  
 For Expansion Joint Details, see Sheet No. 30 and 31.  
 Longitudinal dimensions are measured horizontally.




**SLAB PANEL LAYOUT  
UNIT 1**

User: jthompson  
 PLOTTED: 10-DEC-2003 16:10 k:\b.33418\RT 64 Precast Deck.dwg\p12.dgn


State	Proj. No.	Sheet No.
MO		B16

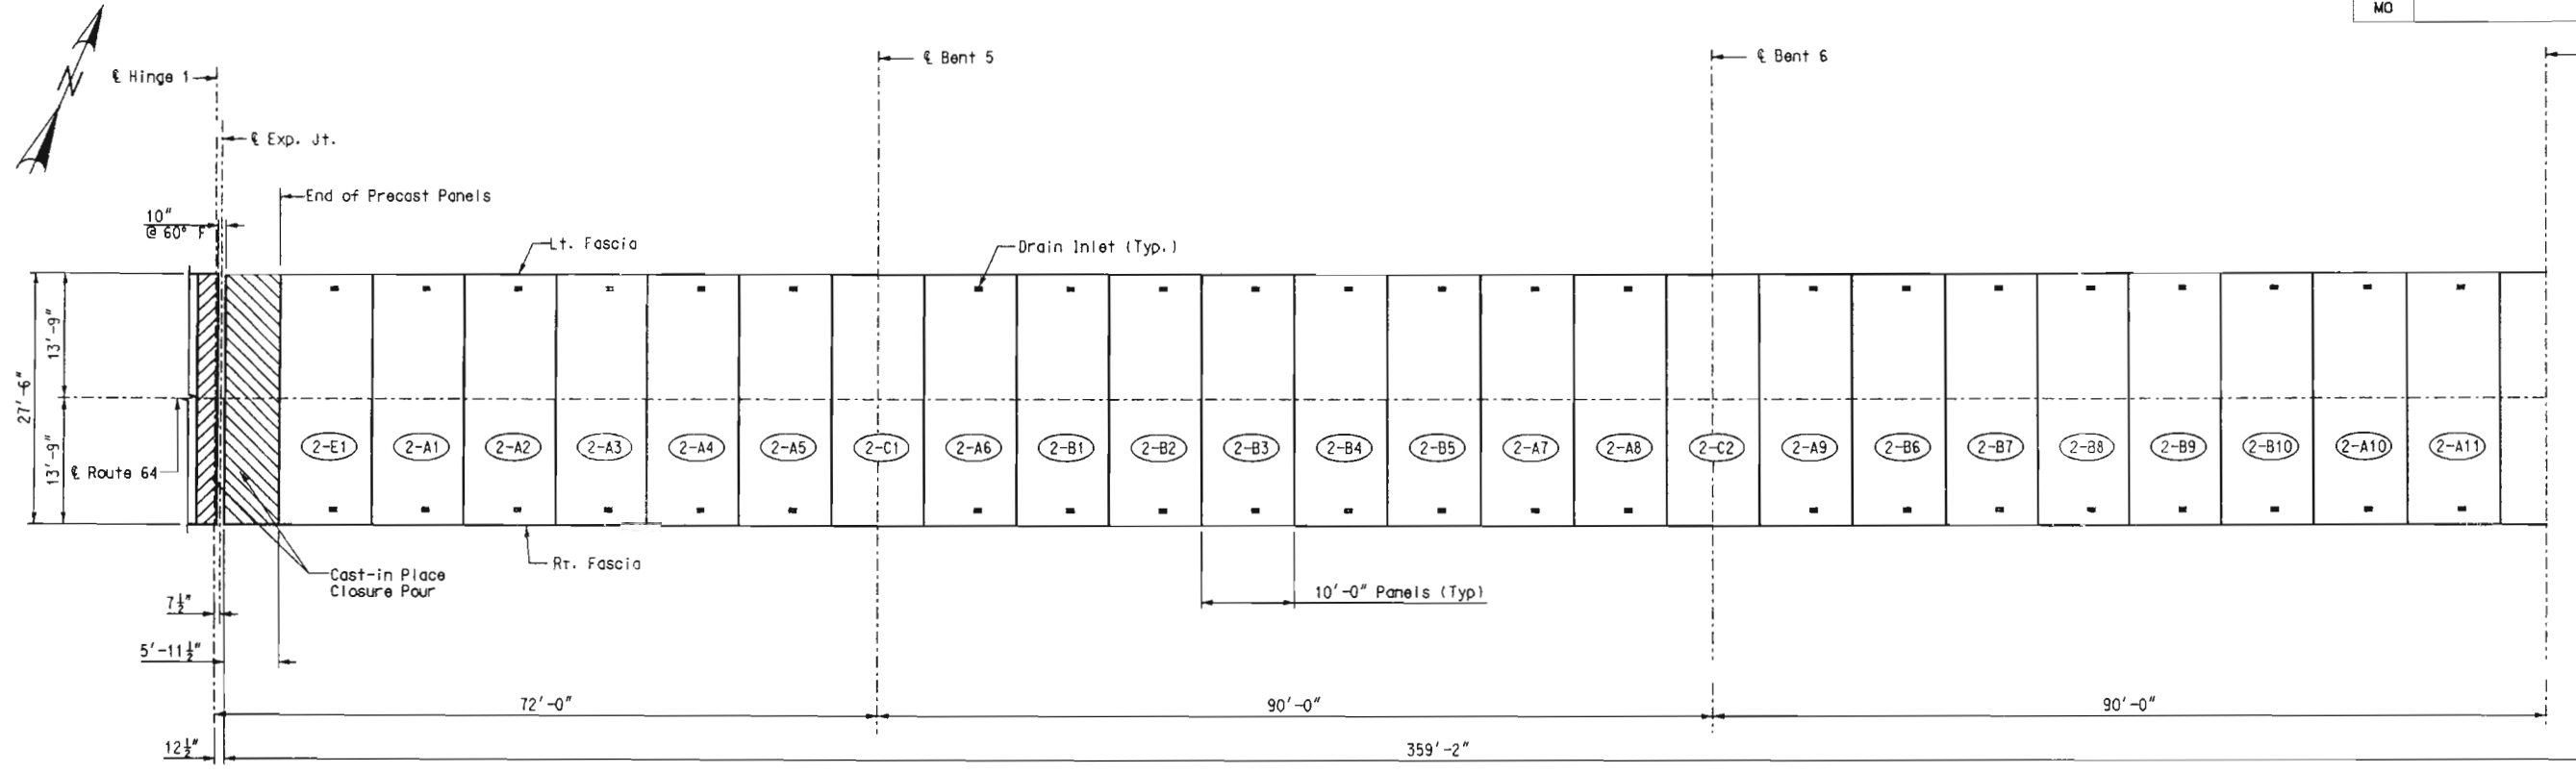

PLAN

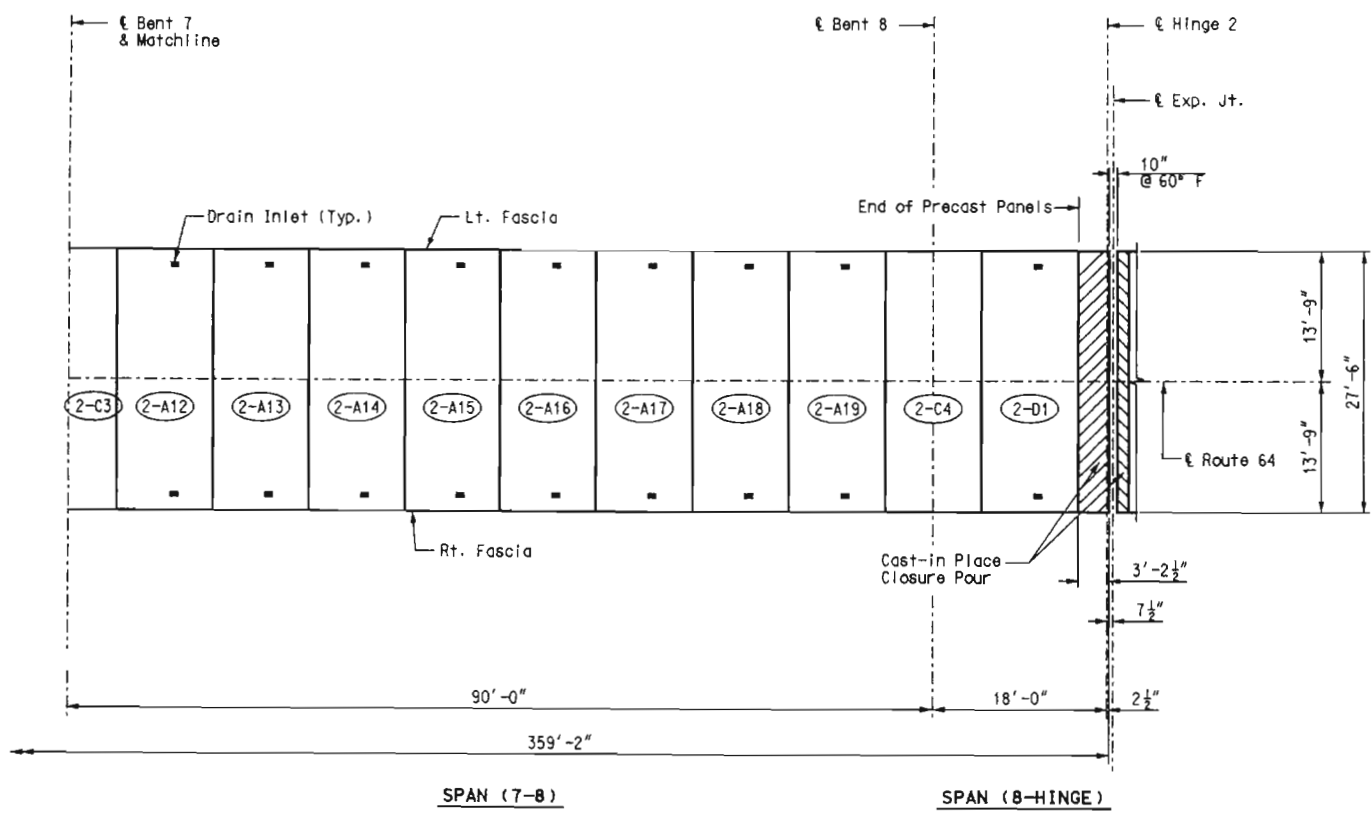

PLAN

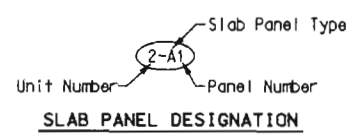

Notes:
 

- For Typical Section, see Sheet No. 22.
- For Safety Barrier Curb Details, see Sheet No. 25 and 28.
- For Slab Drain Details, see Sheet No. 24.
- For Closure Pour Details, see Sheet No. 26.
- For Expansion Joint Details, see Sheet No. 30 and 31.
- Longitudinal dimensions are measured horizontally.



SLAB PANEL LAYOUT  
UNIT 2

USER: jthompson  
 PLOTTED: 10-DEC-2003 16:10  
 k:\b33418\RT 64 Precast Deck drawings\p15.dwg




Detailed OCT 2003  
Checked NOV 2003



Note: This drawing is not to scale. Follow Dimensions.

Sheet No. 16 of 35

HICKORY COUNTY A08941

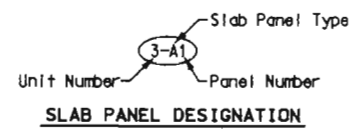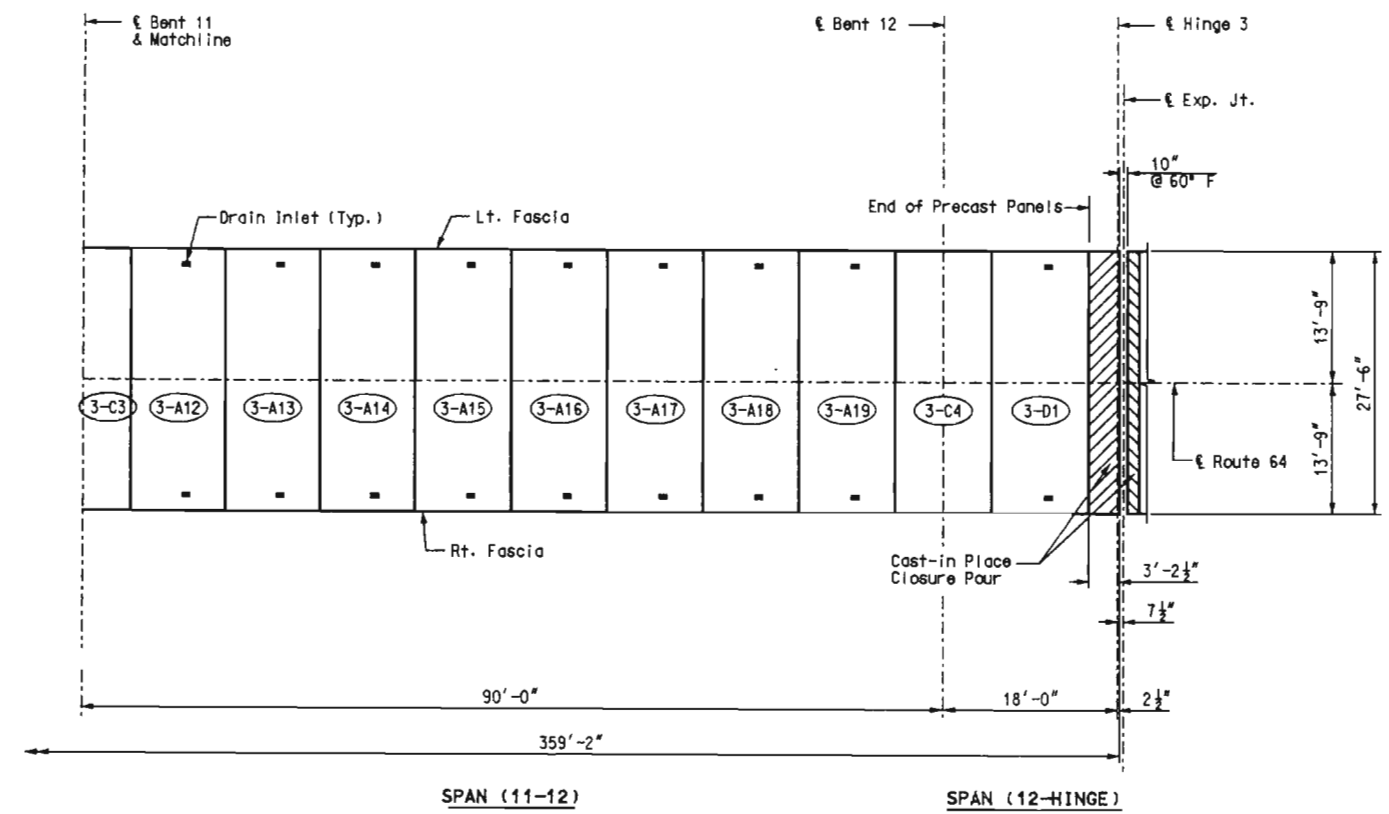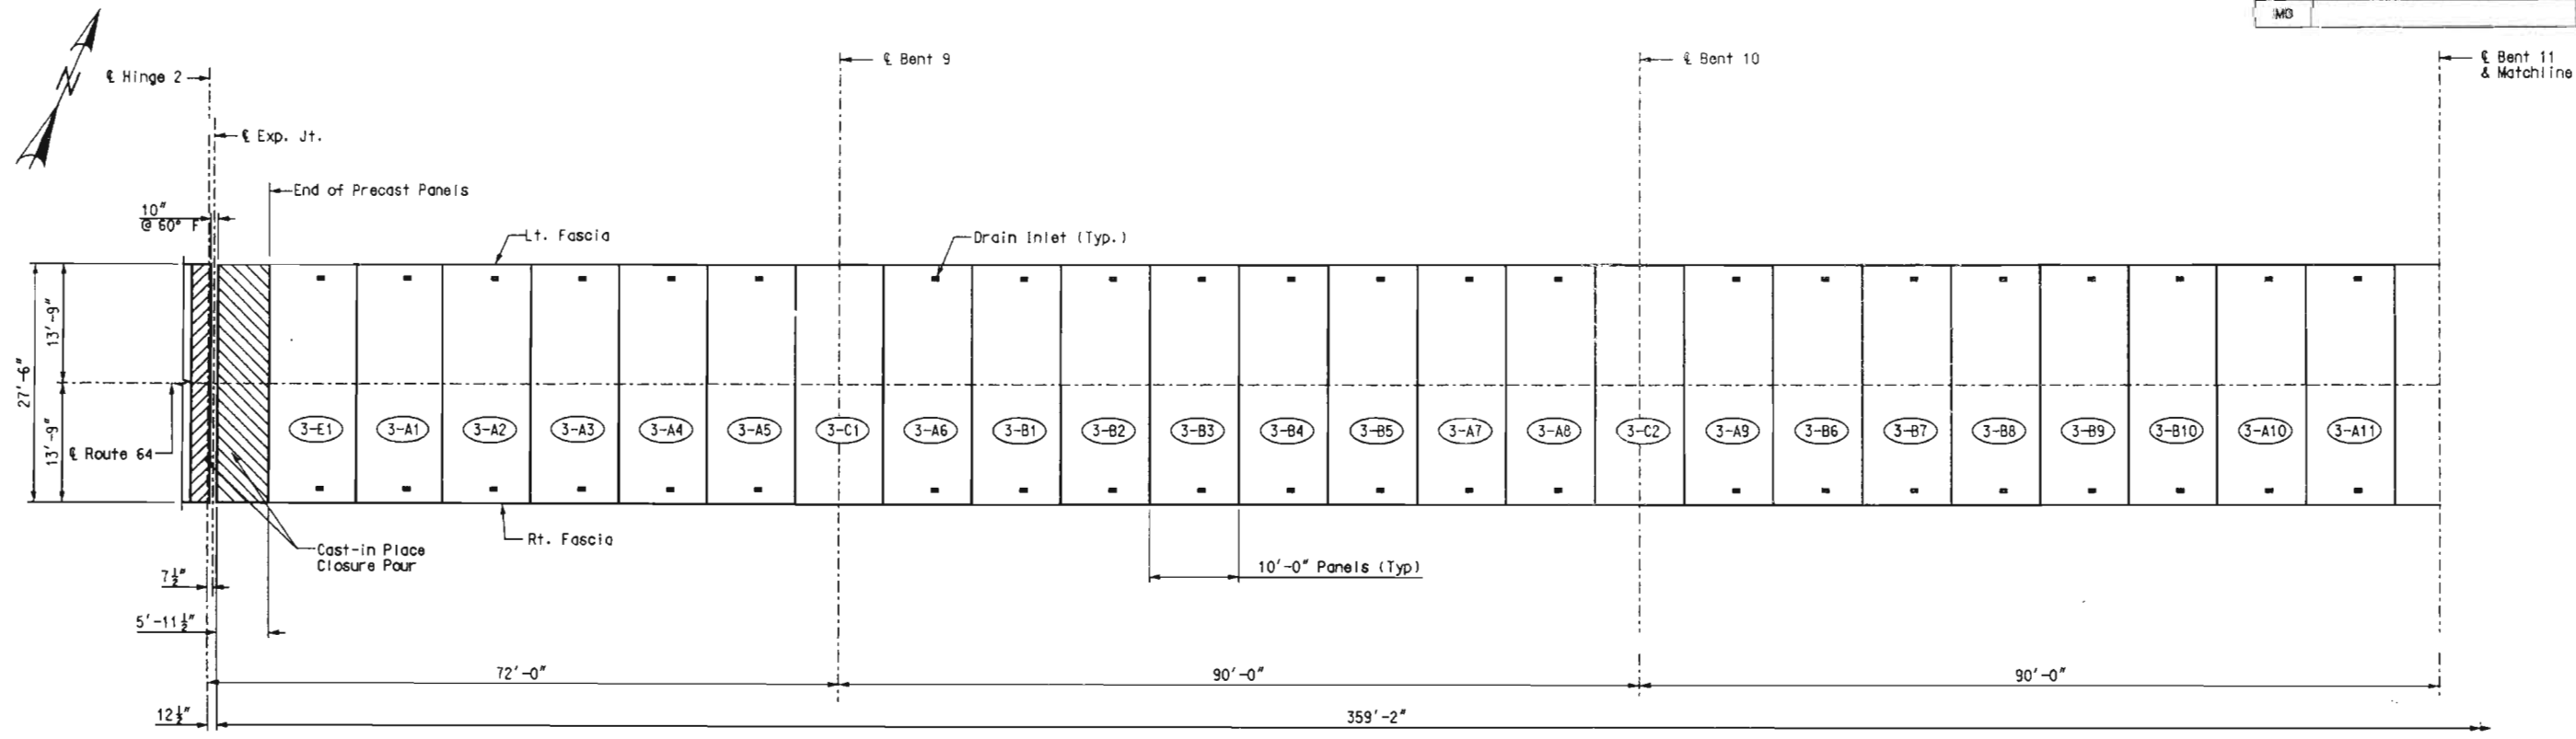

Notes:  
 For Typical Section, see Sheet No. 22.  
 For Safety Barrier Curb Details, see Sheet No. 25 and 28.  
 For Slab Drain Details, see Sheet No. 24.  
 For Closure Pour Details, see Sheet No. 26.  
 For Expansion Joint Details, see Sheet No. 30 and 31.  
 Longitudinal dimensions are measured horizontally.




SLAB PANEL LAYOUT  
UNIT 3

HICKORY COUNTY A08941

USER: jbro PLOTTED: k:\b34\B\rt 64 Precast Deck\drawings\p14.dgn  
 DLG-2003 16:10



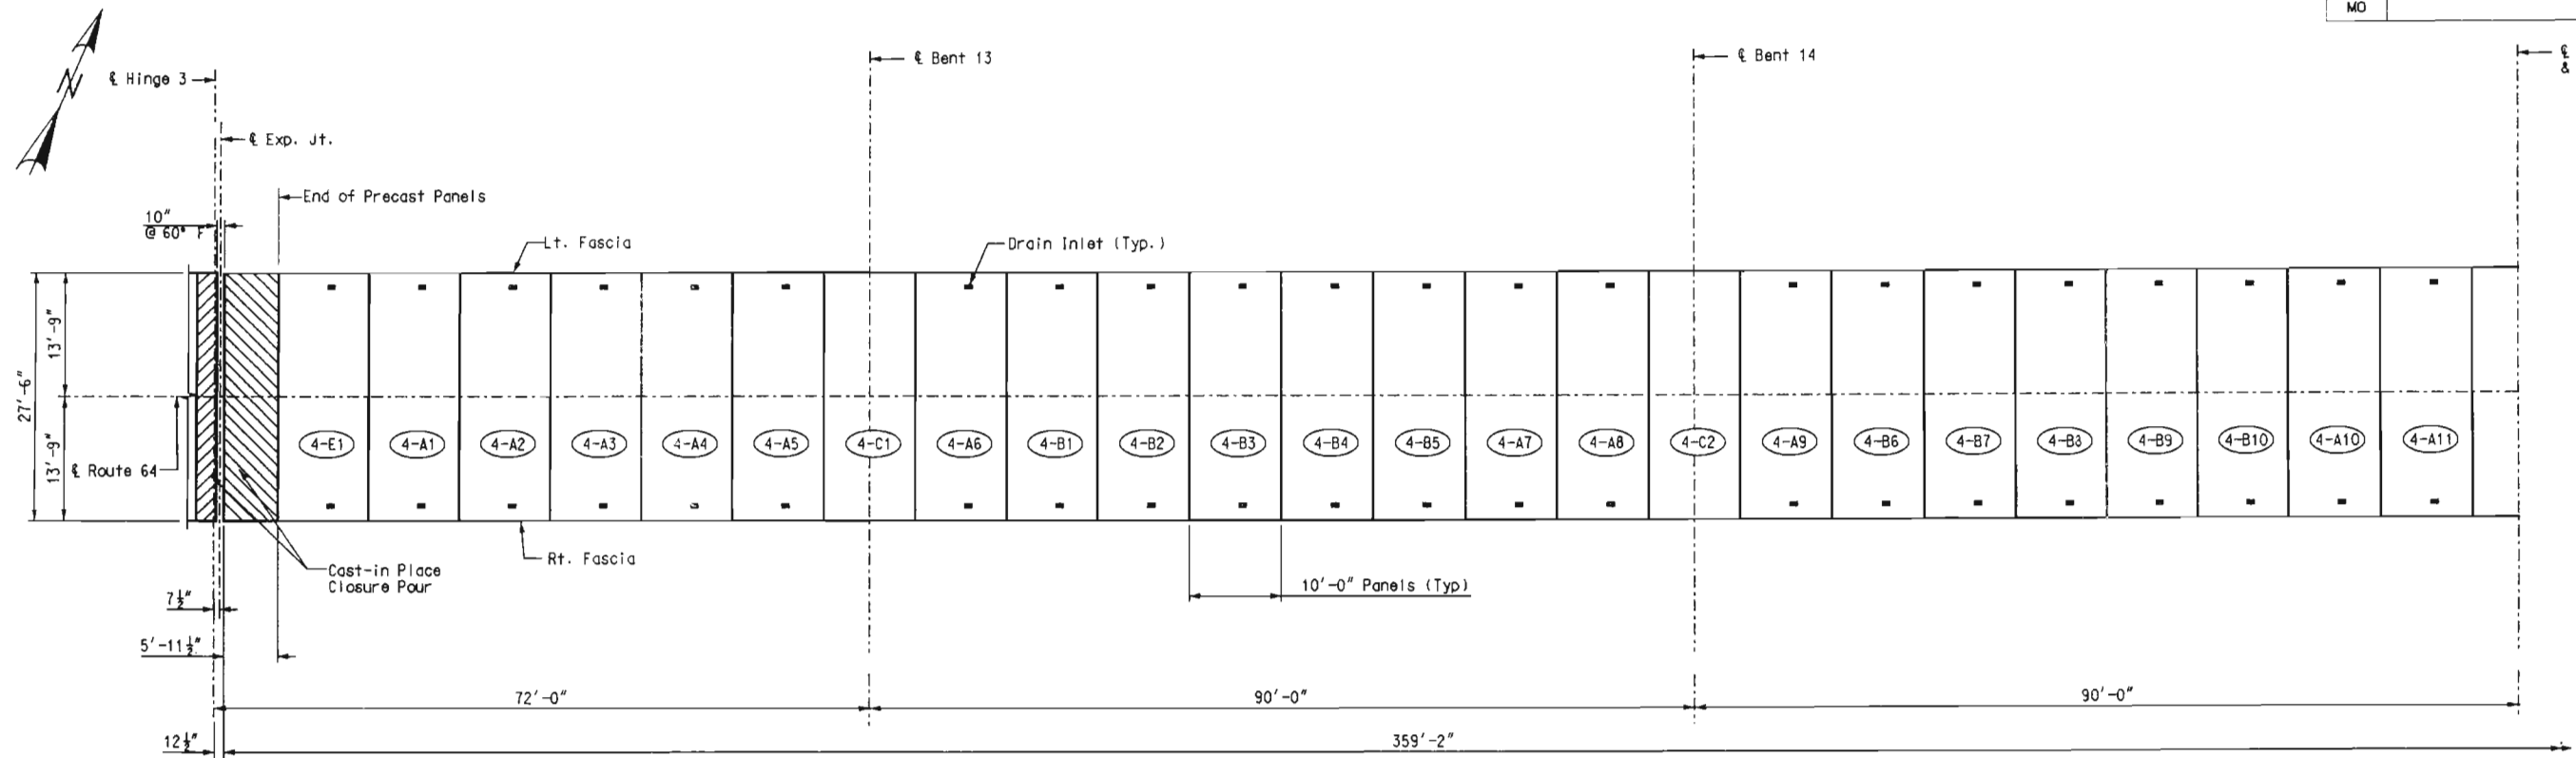


SPAN (HINGE-13)

SPAN (13-14)

SPAN (14-15)


PLAN

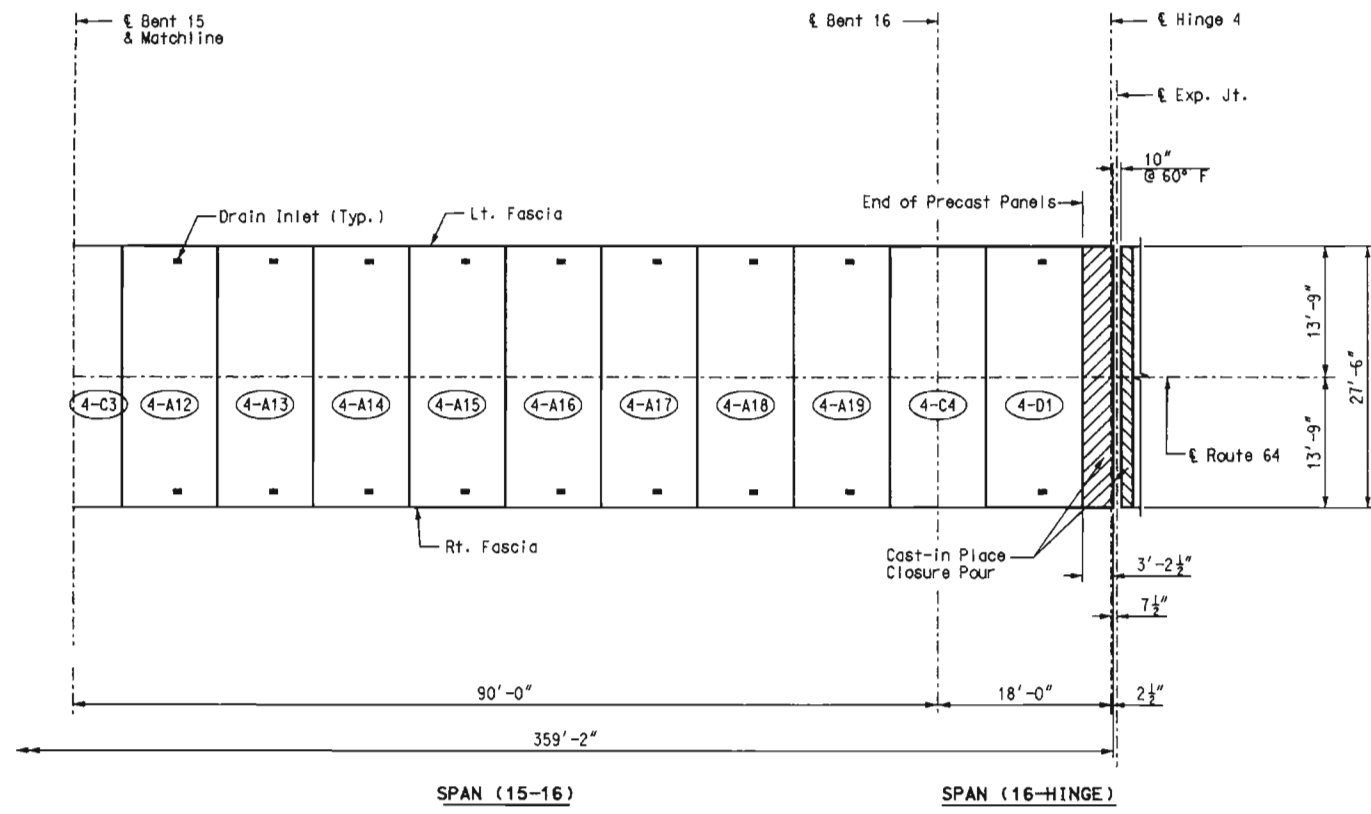

SPAN (15-16)

SPAN (16-HINGE)

PLAN

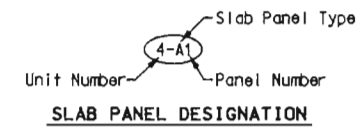

Notes:  
 For Typical Section, see Sheet No. 22.  
 For Safety Barrier Curb Details, see Sheet No. 25 and 28.  
 For Slab Drain Details, see Sheet No. 24.  
 For Closure Pour Details, see Sheet No. 26.  
 For Expansion Joint Details, see Sheet No. 30 and 31.  
 Longitudinal dimensions are measured horizontally.






SLAB PANEL LAYOUT  
 UNIT 4

USER: jhompson  
 PLOTTED: 10-DEC-2003 16:11  
 k:\1534\B\1534-16-11-04-PreCast Deck Drawings\p15.dwg

Detailed OCT 2003  
 Checked NOV 2003



Note: This drawing is not to scale. Follow Dimensions.

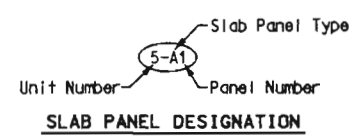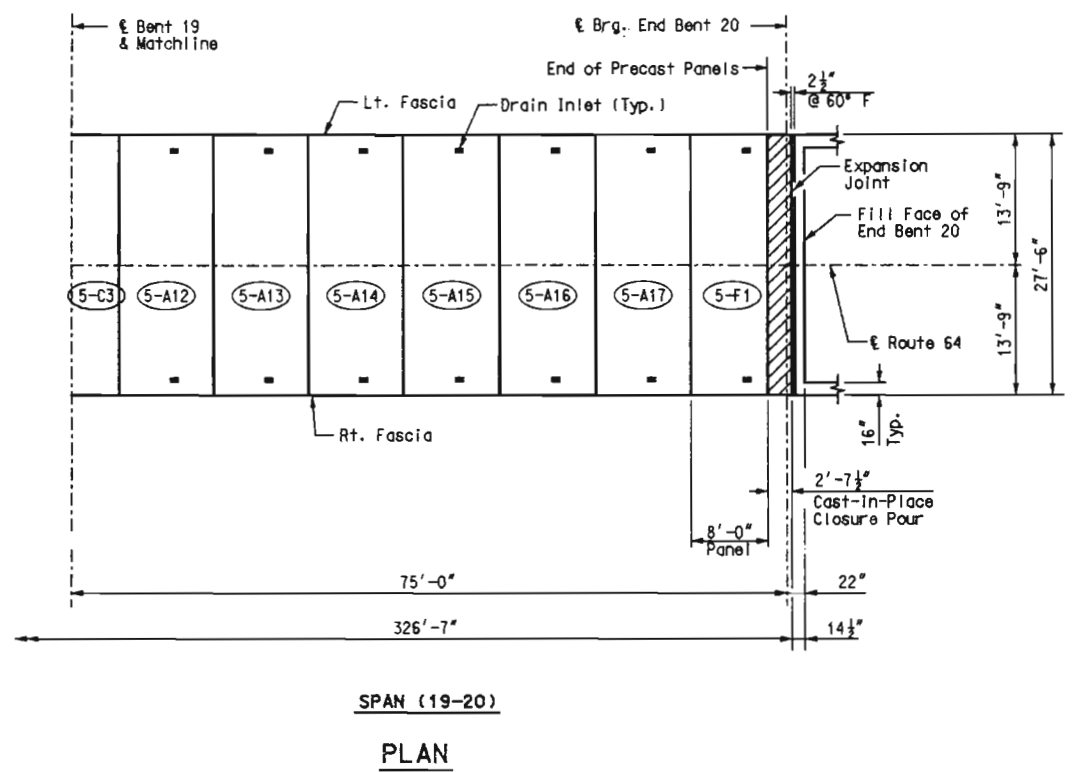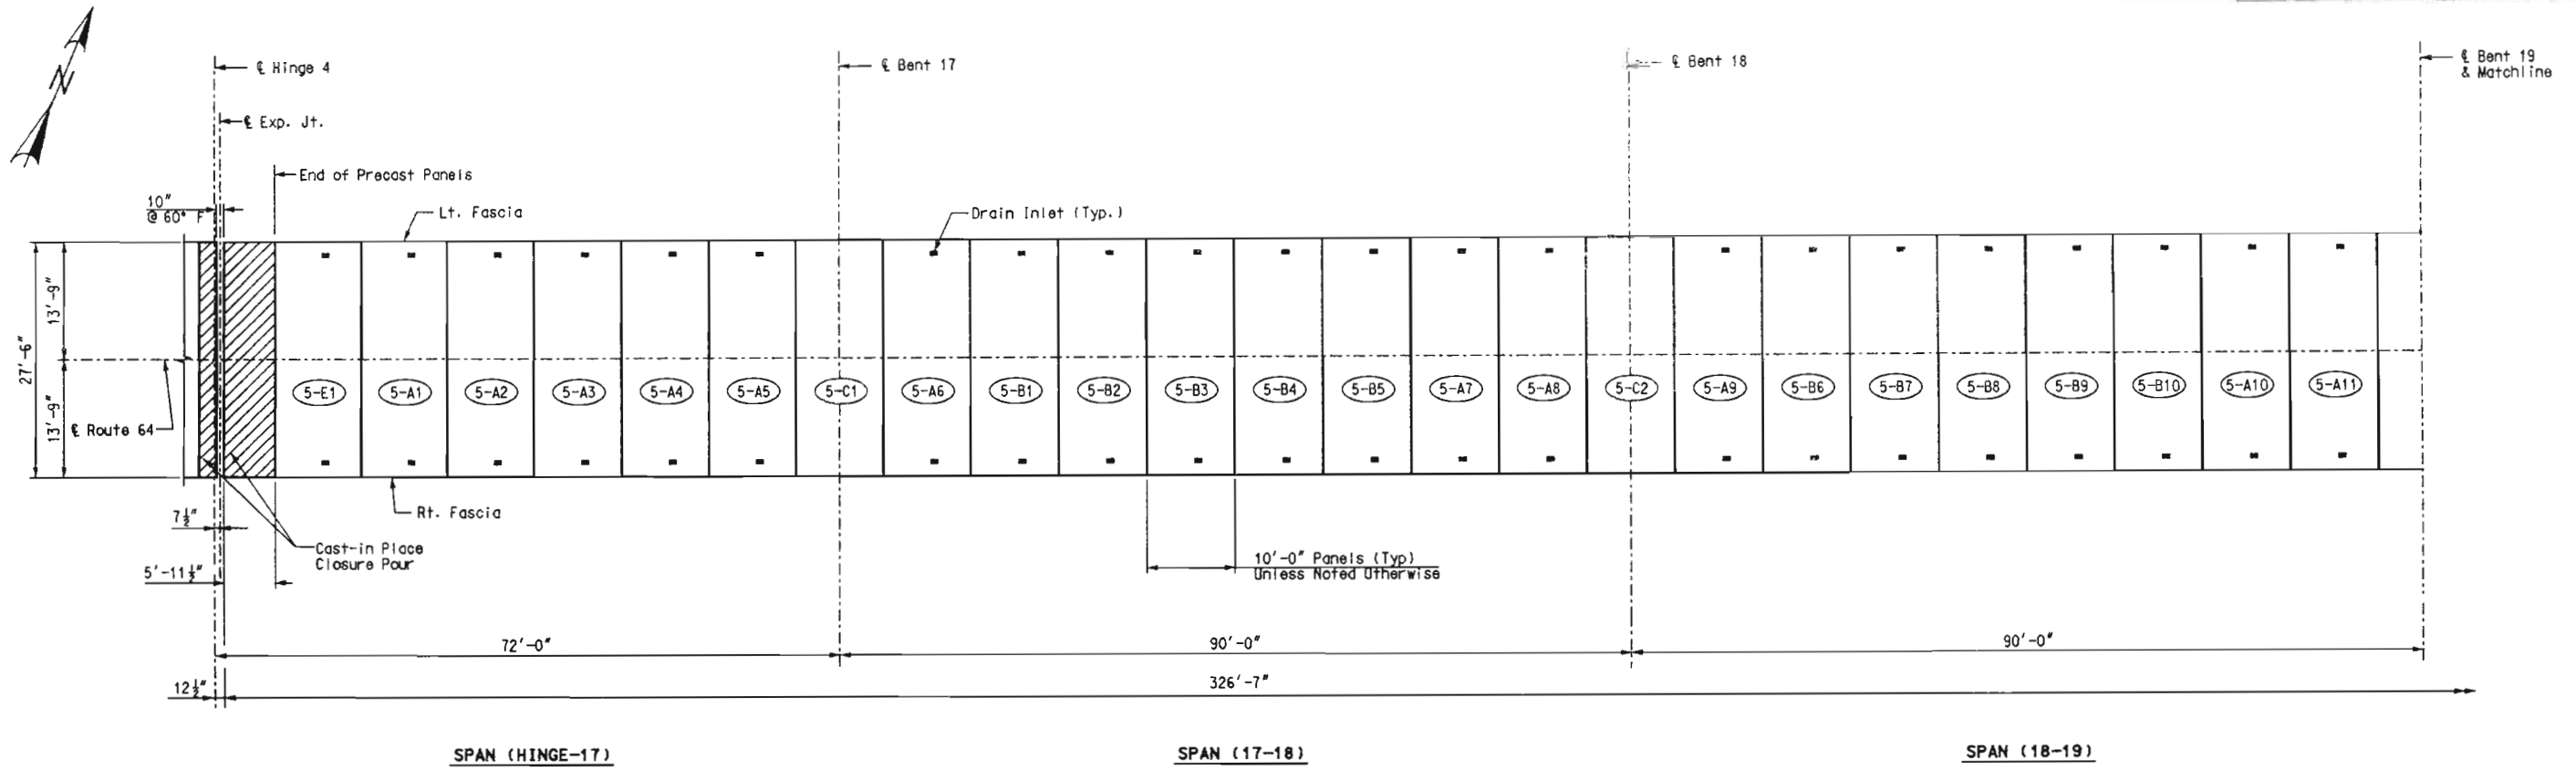

Notes:  
 For Typical Section, see Sheet No. 22.  
 For Safety Barrier Curb Details, see Sheet No. 25 and 28.  
 For Slab Drain Details, see Sheet No. 24.  
 For Closure Pour Details, see Sheet No. 26.  
 For Expansion Joint Details, see Sheet No. 30 and 31.  
 Longitudinal dimensions are measured horizontally.



SLAB PANEL LAYOUT  
UNIT 5

HICKORY COUNTY A08941


USER: jth...  
 PLOT: 11...  
 k:\b33418\RT 64 Precast Deck\Drawings\p16.dwg  
 DEC-2003 16:11

Detailed by OCT 2003  
 Checked by NOV 2003




Note: This drawing is not to scale. Follow Dimensions.


State	Proj. No.	Sheet No.
MO		B20

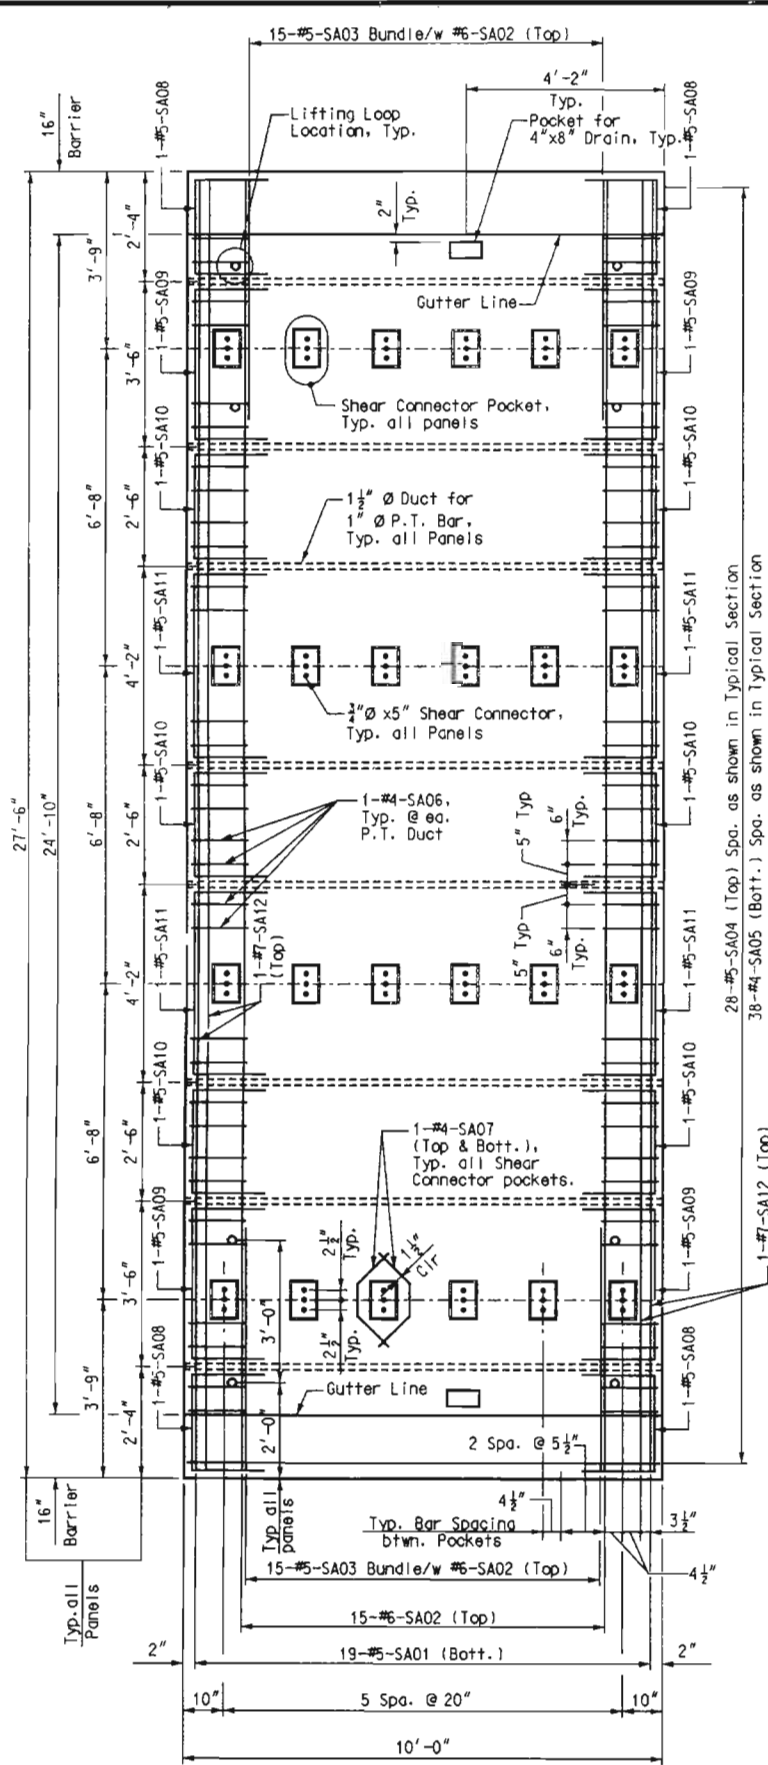

**PANEL TYPE A**  
 Note: Barrier Reinforcing not shown for clarity.

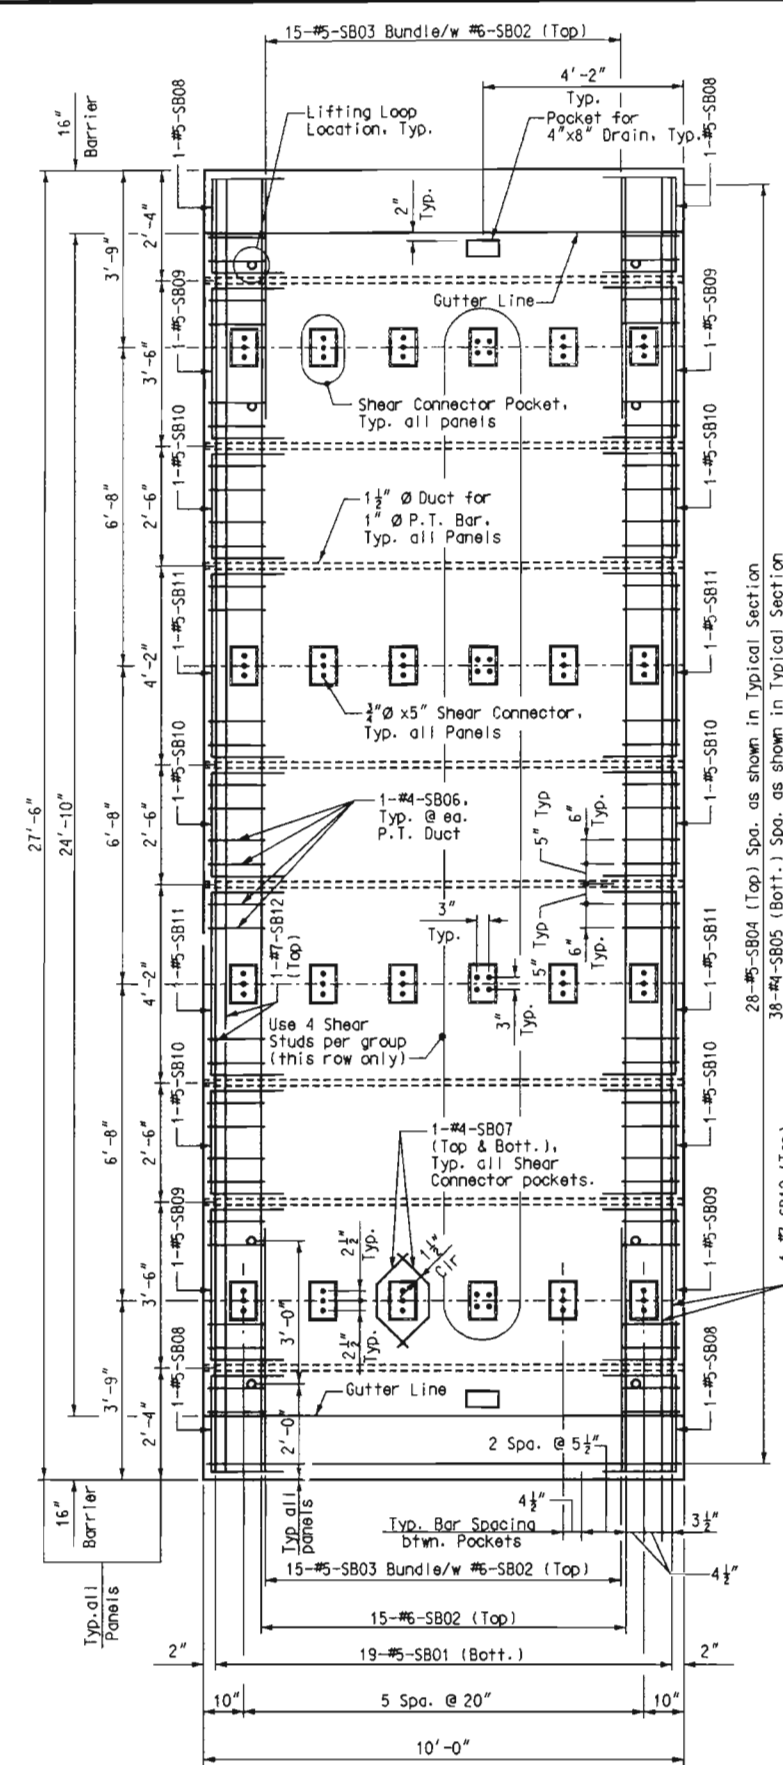


**PANEL TYPE B**  
 Note: Barrier Reinforcing not shown for clarity.

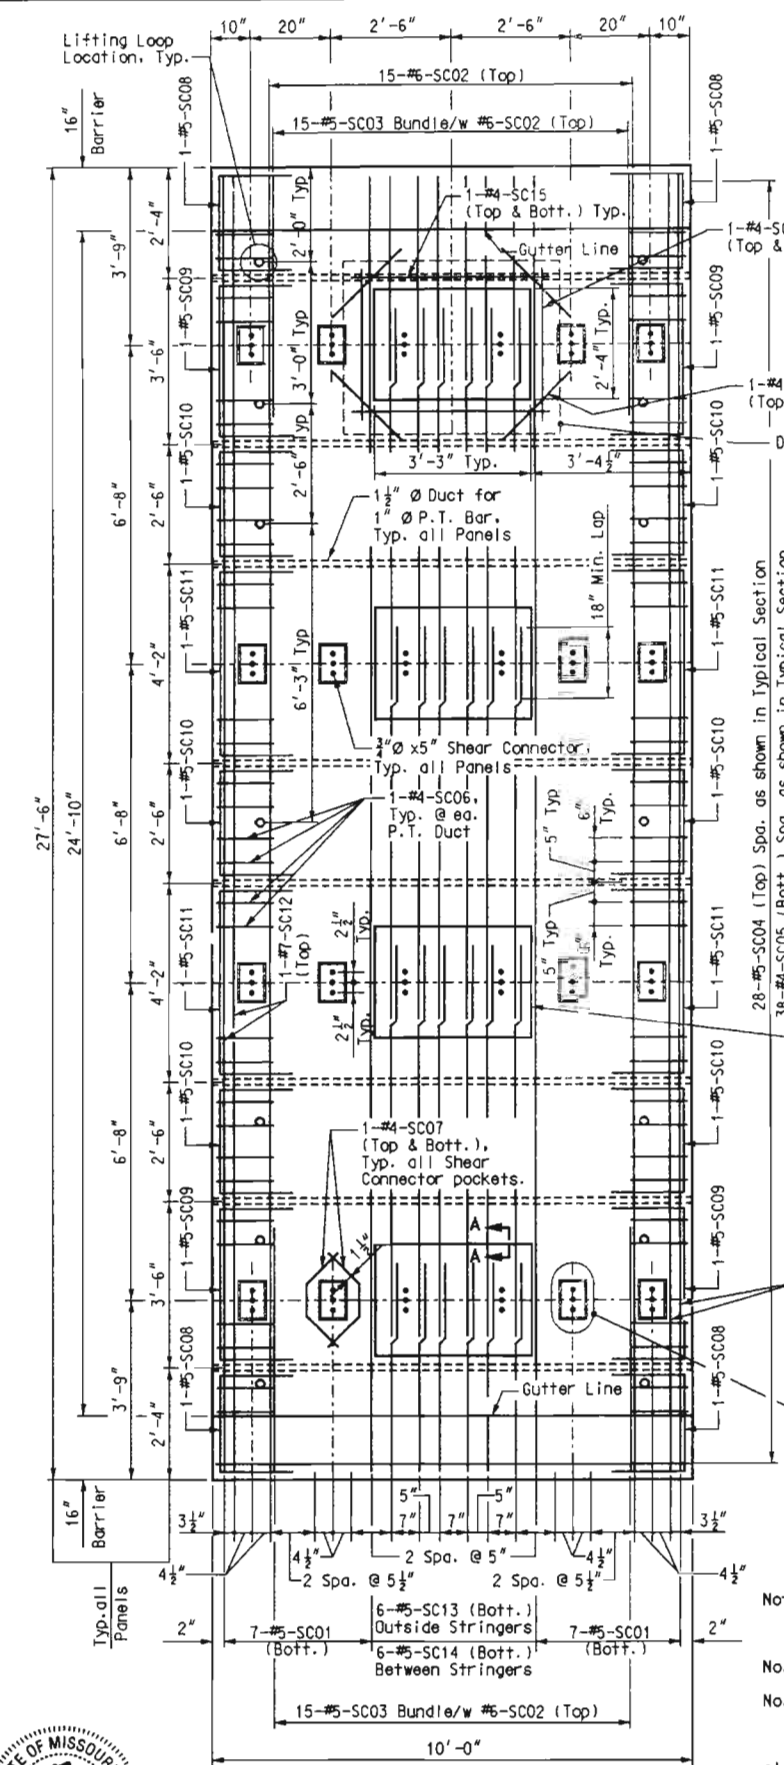

**PANEL TYPE C**  
 Note: Barrier Reinforcing not shown for clarity.

Blockout for existing stringer post-tensioning. Field verify locations and size prior to casting Slab Panels Type C.

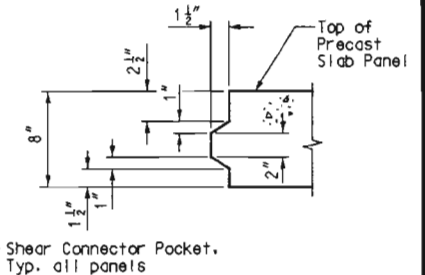


- Notes:
- For Barrier Reinforcing see Sheet No. 25.
  - For Typical Section, see Sheet No. 22.
  - For Shear Connector Details, see Sheet No. 11.
  - For Shear Key Details, see Sheet No. 23.
  - For Drain Details, see Sheet No. 24.
  - P.T. bar and coupler blockouts not shown for clarity.
  - At Contractors option, Panel Type C may be constructed cast-in-place at no additional cost to owner.




SLAB PANEL TYPES A, B, AND C

USER: jhompson  
 PLOT JOB: H DEC-2003 08:54  
 K:\MS34\ENR\Cal\_Plan\_and\_Deck\_Supporting.plt

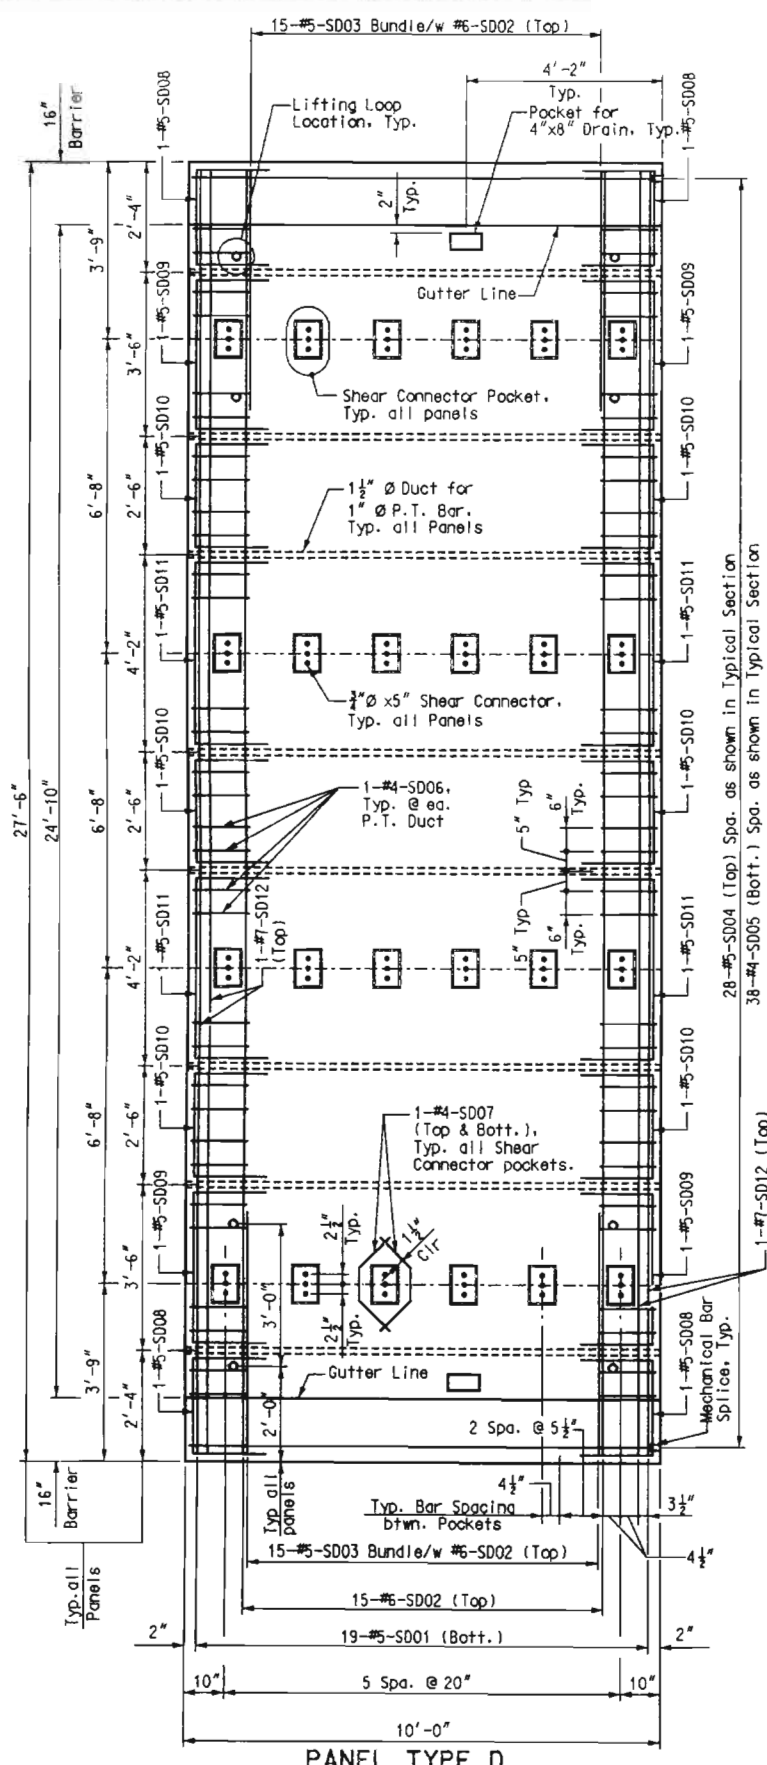


**PANEL TYPE D**

Note: Barrier Reinforcing not shown for clarity.

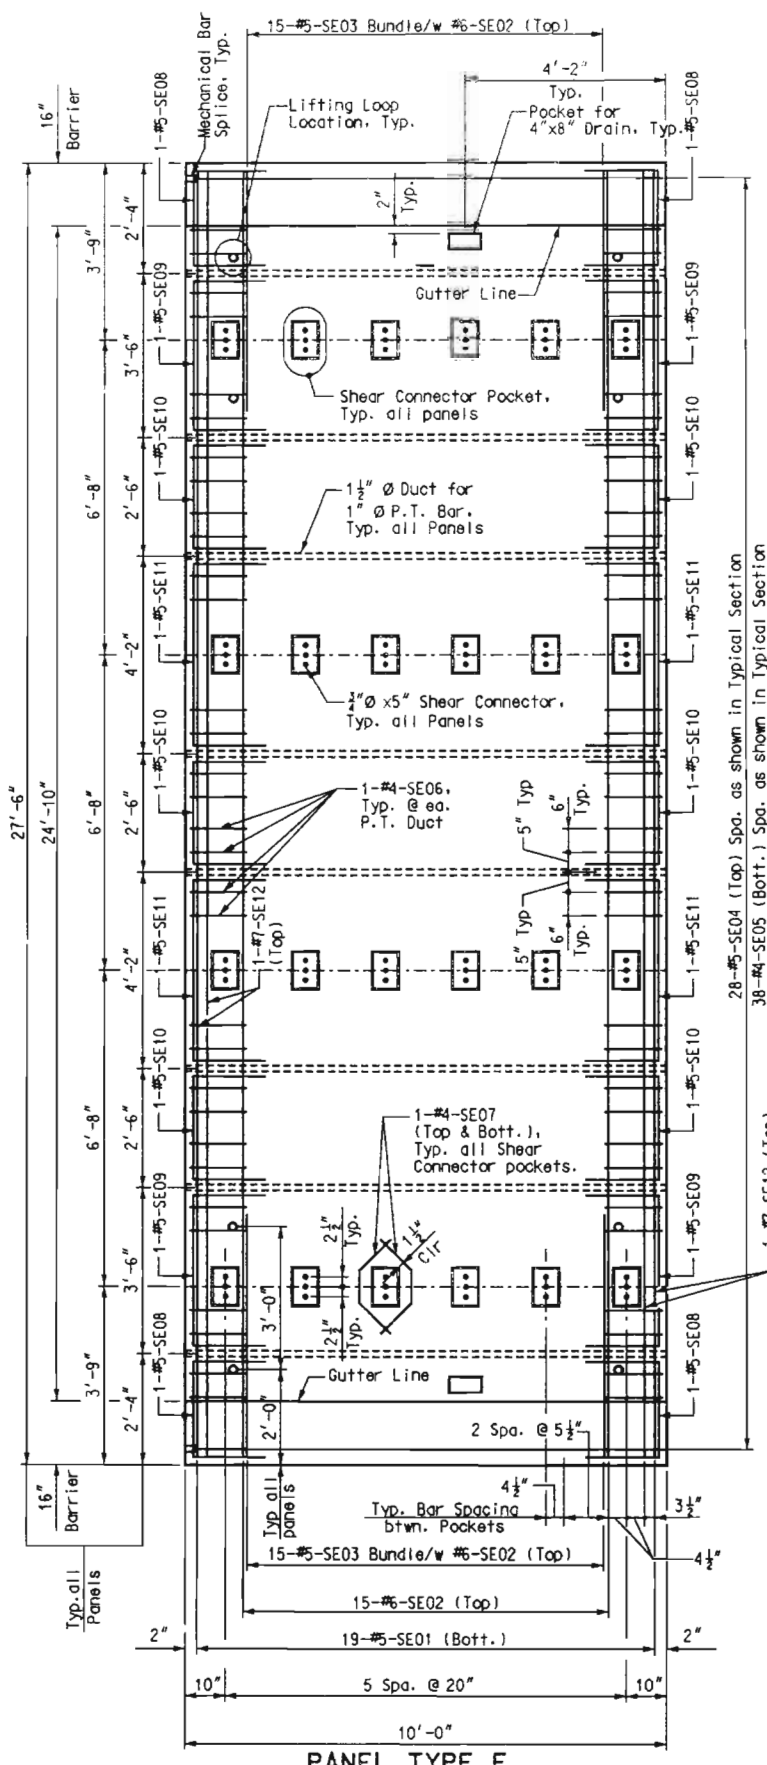

**PANEL TYPE E**

Note: Barrier Reinforcing not shown for clarity. Panel Type E is identical to Panel Type D except for orientation of shear keys and Mechanical Bar Splices.

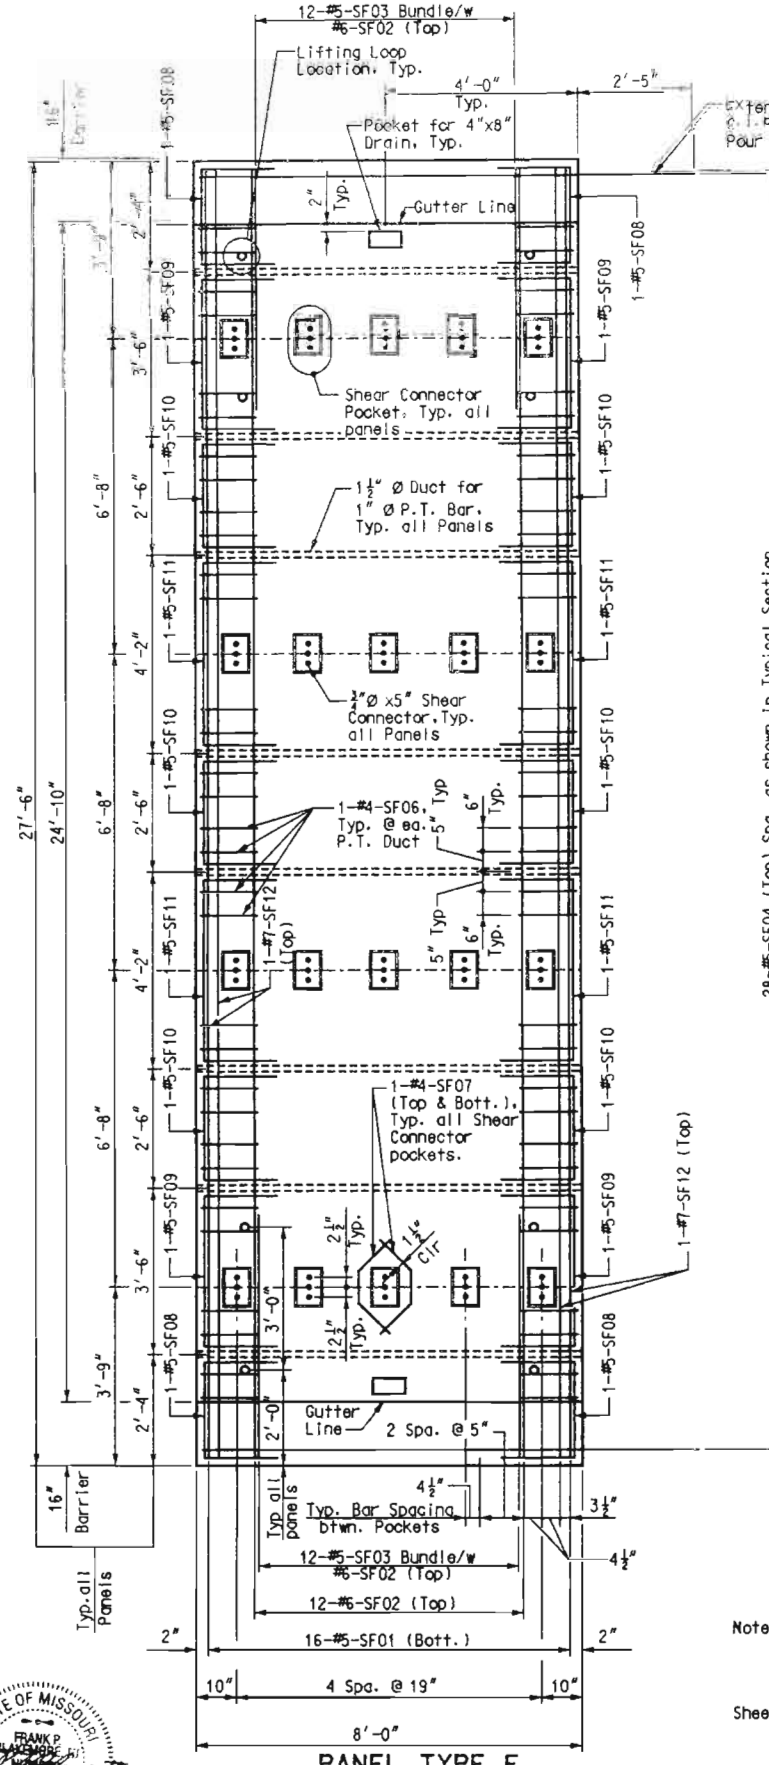

**PANEL TYPE F**



Note: Barrier Reinforcing not shown for clarity.

**SLAB PANEL TYPES D, E AND F**

- Notes:
- For Barrier Reinforcing, see Sheet 25.
  - For Typical Section, see Sheet No. 22.
  - For Shear Key Details, see Sheet No. 23.
  - For Shear Connector Pocket Details, see Sheet No. 22.
  - For Shear Connector Details see Sheet No. 24.
  - For Slab Drain Details, see Sheet No. 24.
  - P.T. bar coupler blockouts not shown for clarity.




USER: 101  
 PROJECT: 2005-09-18  
 k:\b3\4\2\NRT G4 Precast Deck drawings\p17a.dwg  
 12-DEC-2005 09:18

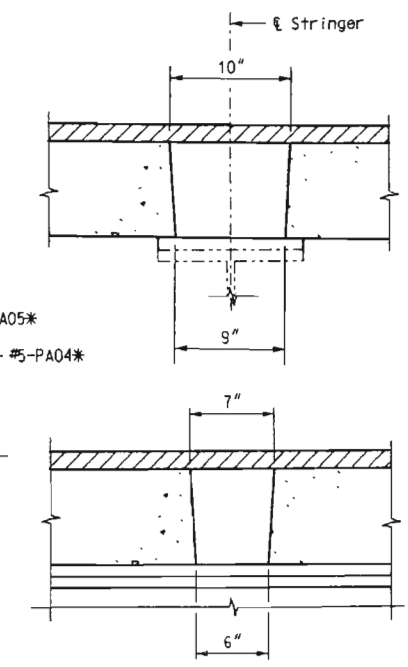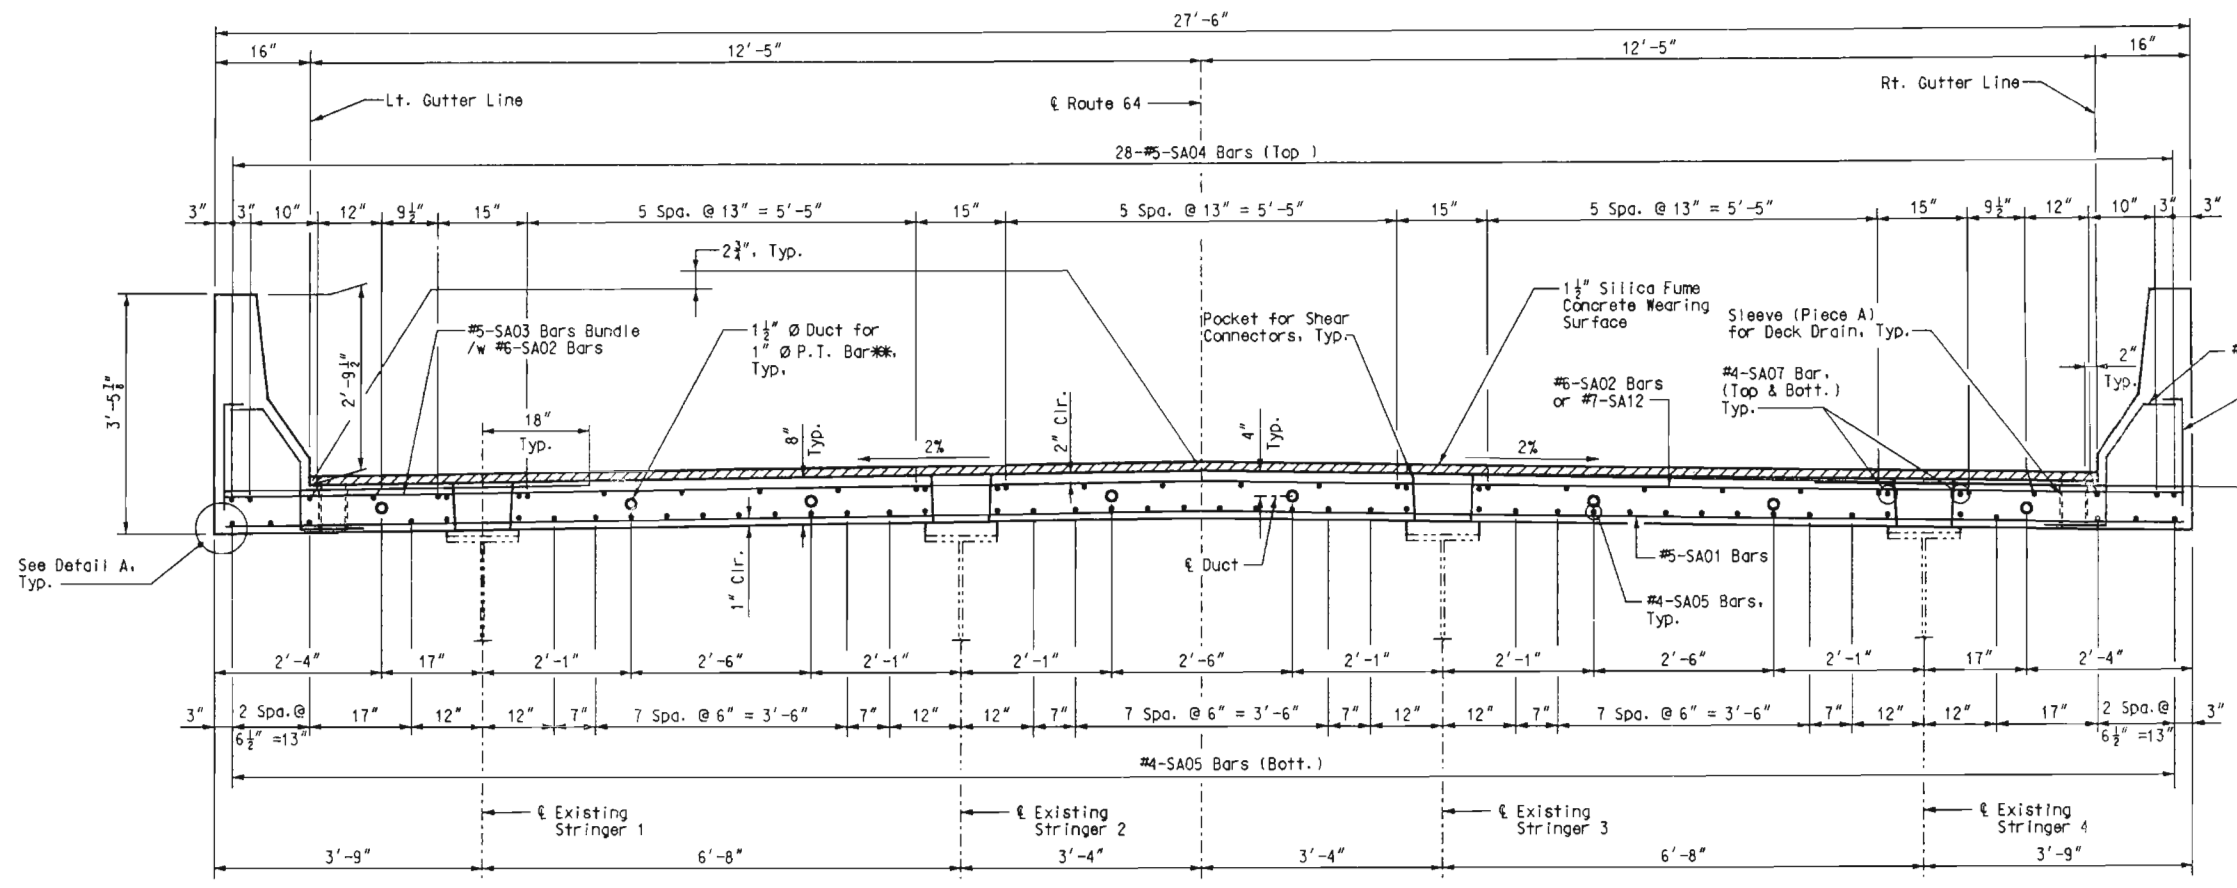


**TYPICAL SECTION**

Bar Marks shown are for Panel A. Panels B thru F are similar, except use "SB" thru "SF" series.

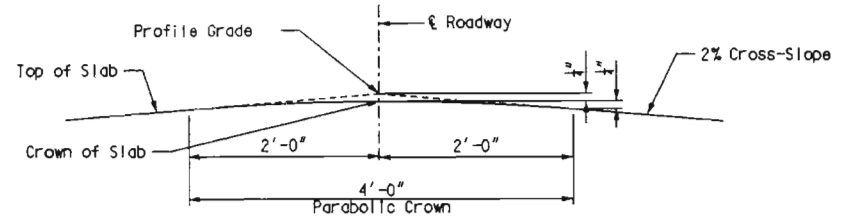


**SLAB CROWN DETAIL**

Notes:  
 For Slab Panel Layouts, see Sheet No. 15 thru 19.  
 For Slab Panel Types, see Sheet No. 20 and 21.  
 For location of Detail B, see Sheet No. 20.  
 \* Post-Tensioned Bars shall be stressed to 0.65 f's.  
 For Shear Key Details, see Sheet No. 23.  
 For Shear Connector Details, see Sheet No. 11.  
 For Safety Barrier Curb Details, see Sheet No. 25.  
 \* For spacing of #5-PA04 and #5-PA05 bars, see Safety Barrier Curb Elevation, Sheet No. 25.

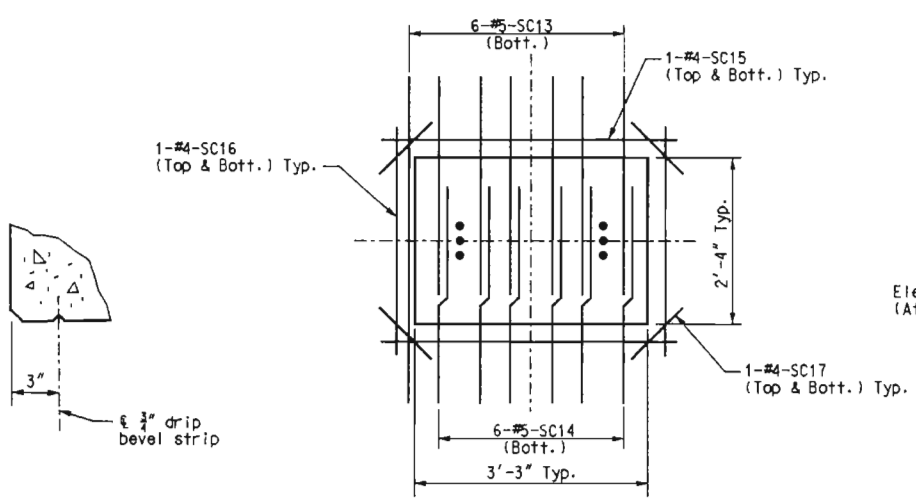

**DETAIL A**

**DETAIL B**

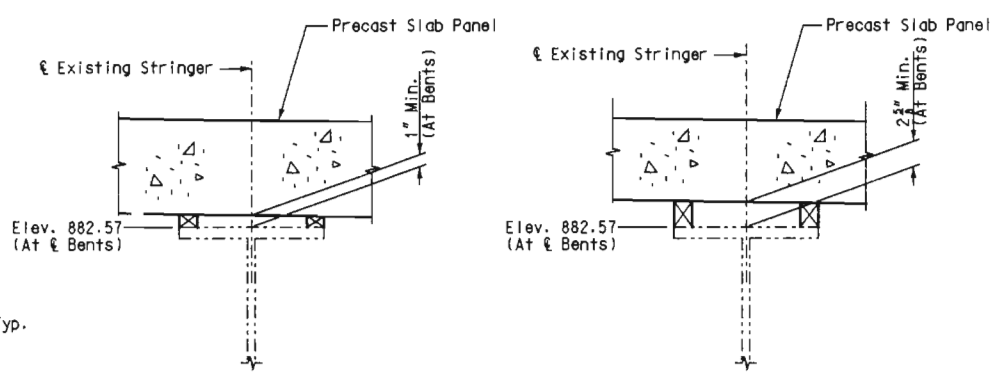

**STRINGER 1 OR 4**

**STRINGER 2 OR 3**


**TYPICAL HAUNCH DETAIL**

Note:  
 If haunch depth exceeds 3", shear connector length shall be increased.  
 Field verify haunch depths prior to placement of precast slab panels.  
 No payment will be made for additional shear connector length, or concrete required for variable haunch.




**SLAB PANEL CROSS SECTION**


U.S. ER. Thompson  
 PLOTTED: 10-DEC-2003 10:11  
 I:\B334\BRI 04 Precast Deck Drawings\p18.dgn

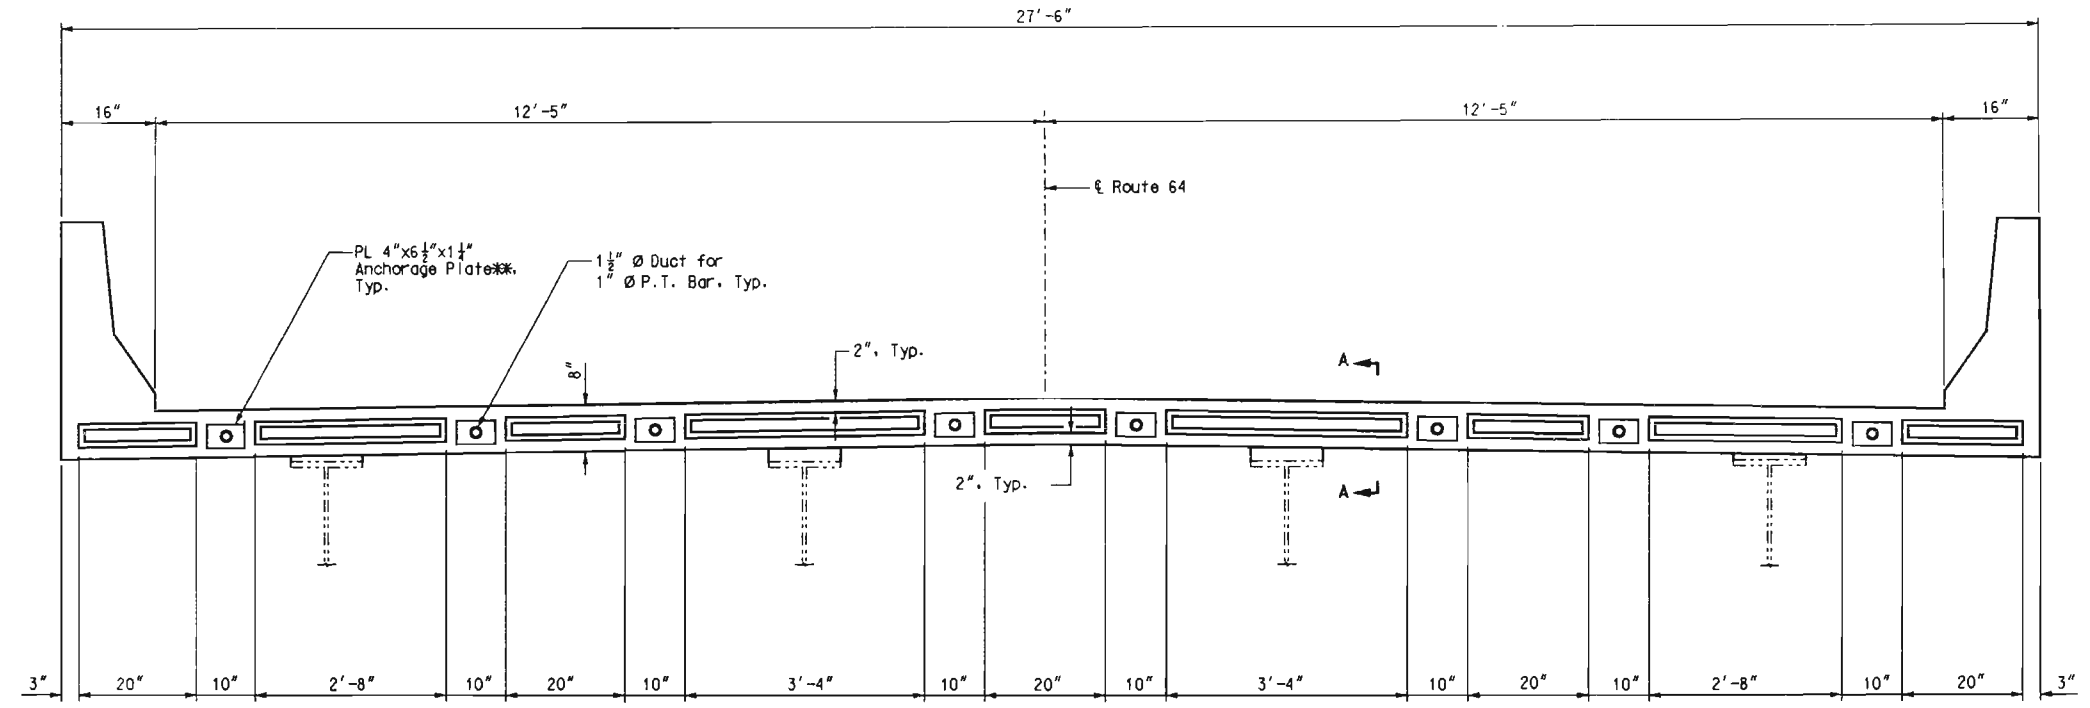

TYPICAL SECTION SHOWING SHEAR KEYS

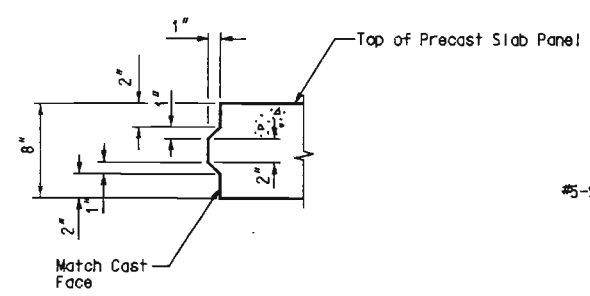


SECTION A-A

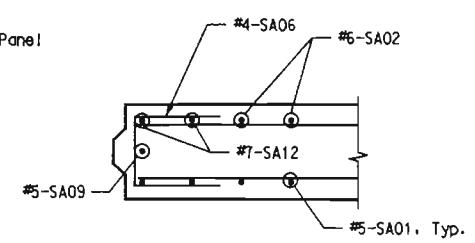


SECTION B-B

Note: Bars Shown for Panel Type A. Other Panels Similar.

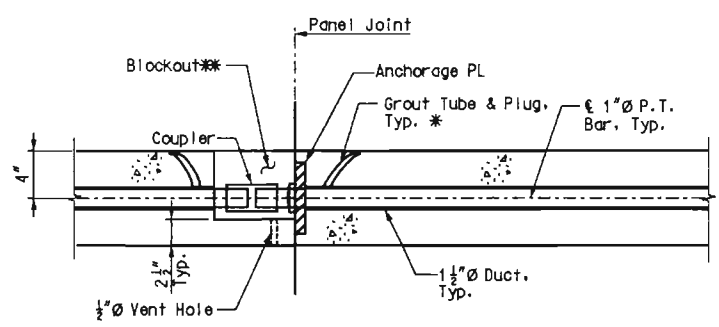

P.T. BARS IN PRECAST SLAB PANELS

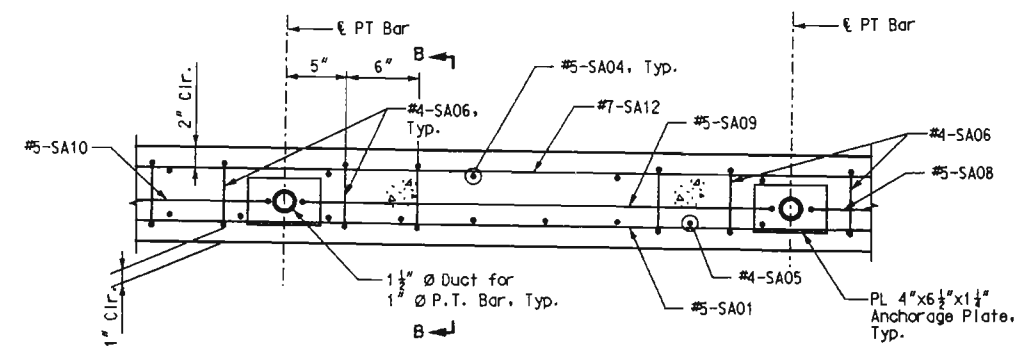

TYPICAL REINFORCING AT END OF PANEL DETAIL

Note: Bars shown for Panel Type A. Other panels similar.

Note:  
 For slab reinforcing, See Sheet Nos. 20, 21 and 22.  
 \* Grout Tube and Plug shall be capable of withstanding traffic loads. See Special Provisions.  
 \*\* Anchorage System and blockout details shall be determined by the post-tensioning system used.

SLAB PANEL SHEAR KEY DETAILS




k:\b33418\RI 64\_Precast Dec\Drawings\p19.dgn  
 10-DEC-2003 16:11  
 HNTB


Detailed OCT 2003  
 Checked NOV 2003




Note: This drawing is not to scale. Follow Dimensions.

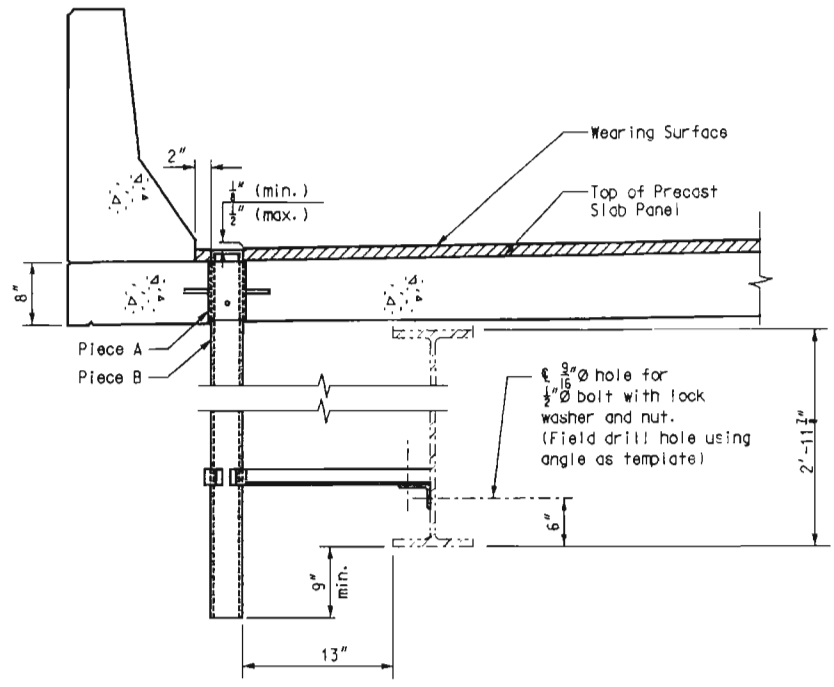


**PART ELEVATION OF SLAB AT DRAIN**

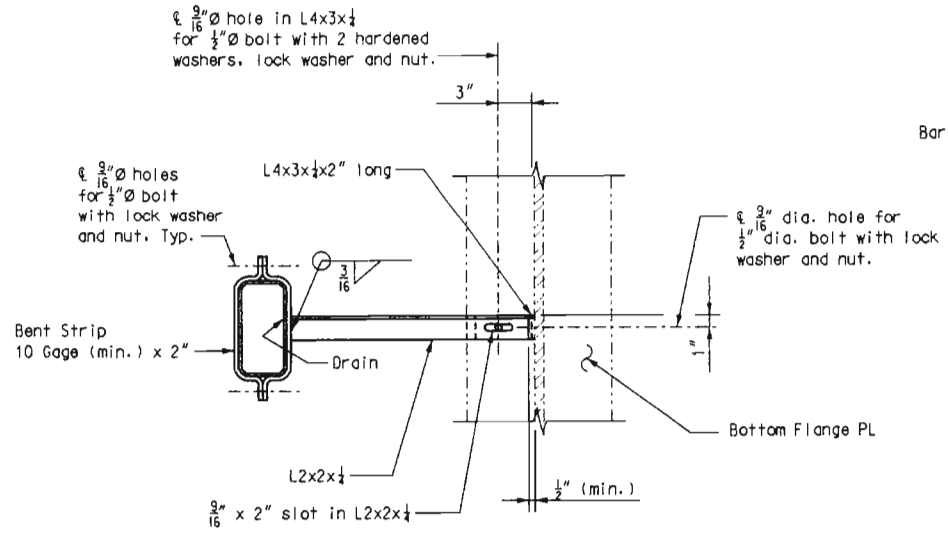


**PART SECTION SHOWING BRACKET ASSEMBLY**

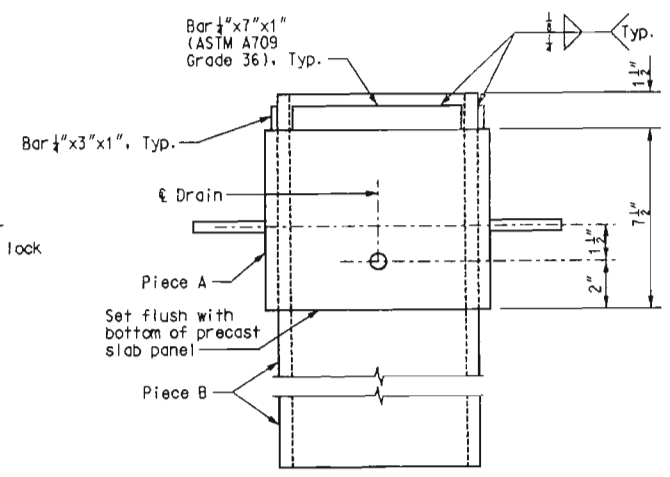

**ELEVATION OF DRAIN**

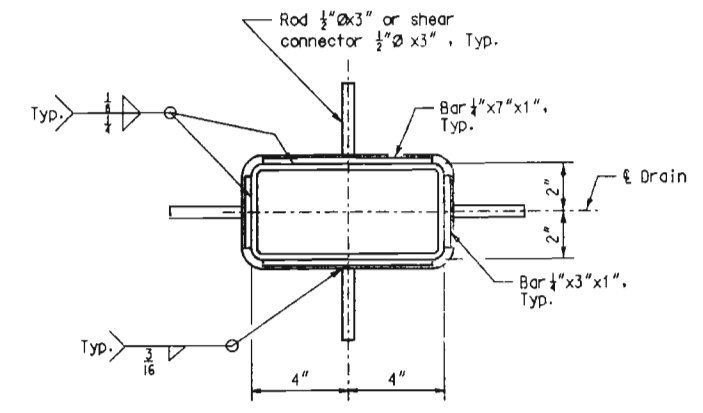

**PLAN OF DRAIN**

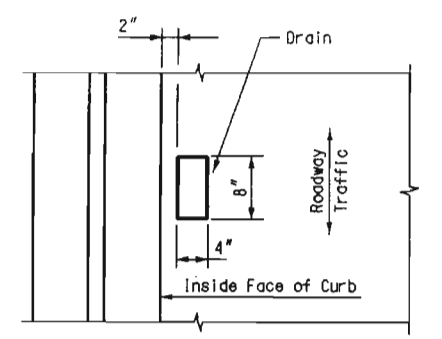


**PART PLAN OF SLAB AT DRAIN**

Notes:  
 For Slab Drain location, see Slab Panel Layouts, Sheet No. 15 thru 19.  
 Slab drains may be fabricated of either 1/4" welded sheets of ASTM A709, Grade 36 steel or from 1/2" structural steel tubing ASTM A500 or A501.  
 Slab drain bracket assembly shall be ASTM A709, Grade 36 steel.  
 Outside dimensions of drains are 8" x 4".  
 Locate drain blockouts in the slab panels by dimensions shown in the Part Plan of Slab at Drain.  
 The slab drains and bracket assembly shall be galvanized in accordance with ASTM A123.  
 All bolts, hardened washers, lock washers and nuts shall be galvanized in accordance with ASTM A153.  
 Shop drawings will not be required for slab drains and the bracket assembly.  
 Install slab drains in panels prior to wearing surface placement.




10-DEC-2003 16:12 k:\033415\161 64 Precast Deck Drawings\p.dwg  
 User: jthompson  
 PLOTTED: 10-DEC-2003 16:12



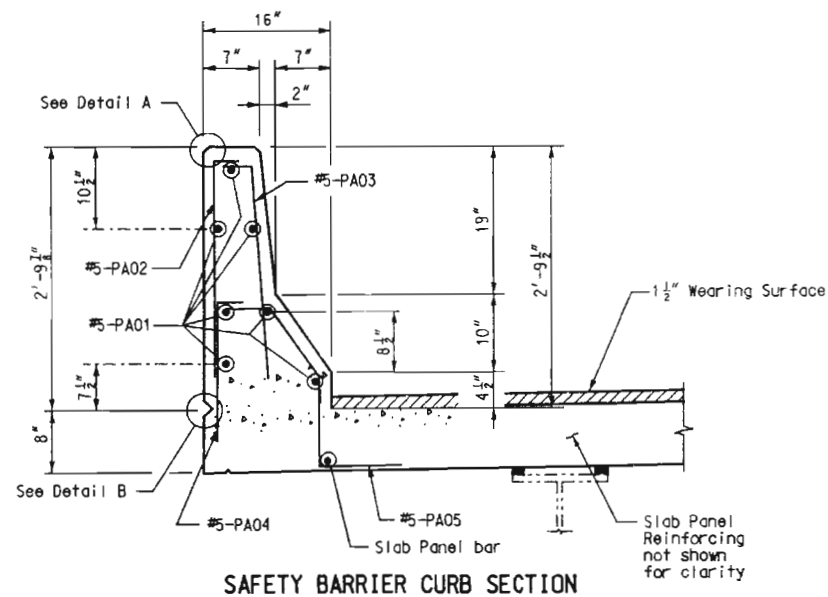


**SAFETY BARRIER CURB SECTION**

Notes:  
 Bar Marks shown are for Panel A. Panels B thru F are similar, except use "B00" thru "F00" series Bar Marks.  
 The cross-sectional area above the slab panel = 2.44 sq. ft.

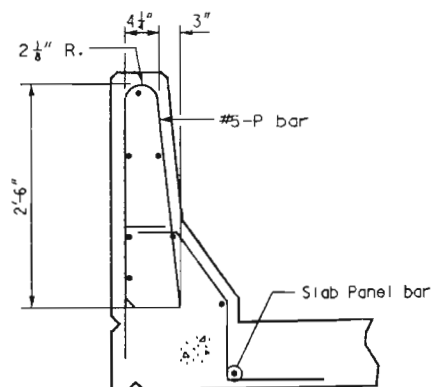


**P-BAR PERMISSIBLE ALTERNATE SHAPE**

The PX02 and PX03 bar combination may be furnished as one bar, as shown, at the contractor's option. (All dimensions are out to out.)  
 X = Panel Type

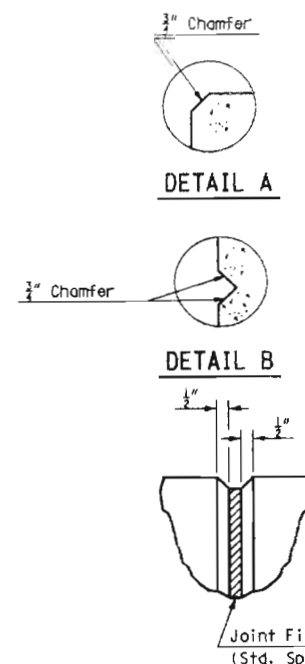


**FILLED JOINT DETAIL**

Note: Fill gaps between barrier on panels after completion of each unit.

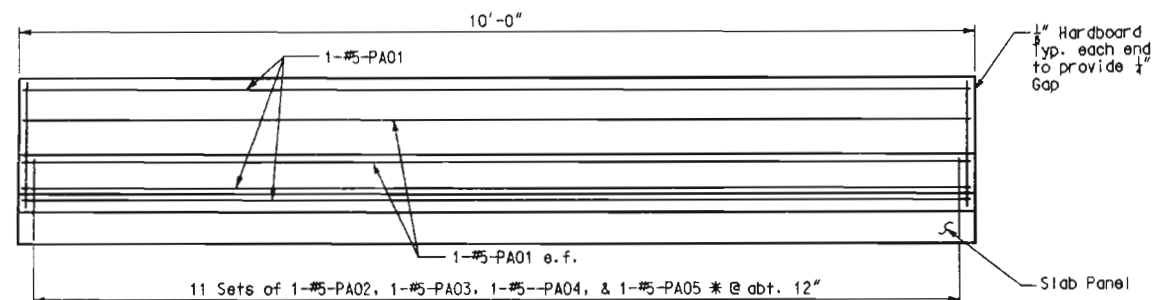

**SAFETY BARRIER ELEVATION AT PANELS A, B, C, D OR E**

Notes:  
 Bar Marks shown are for Panel A. Panels B thru E are similar, except use "B00" thru "E00" series Bar Marks.  
 The cross-sectional area above the slab panel = 2.44 sq. ft.

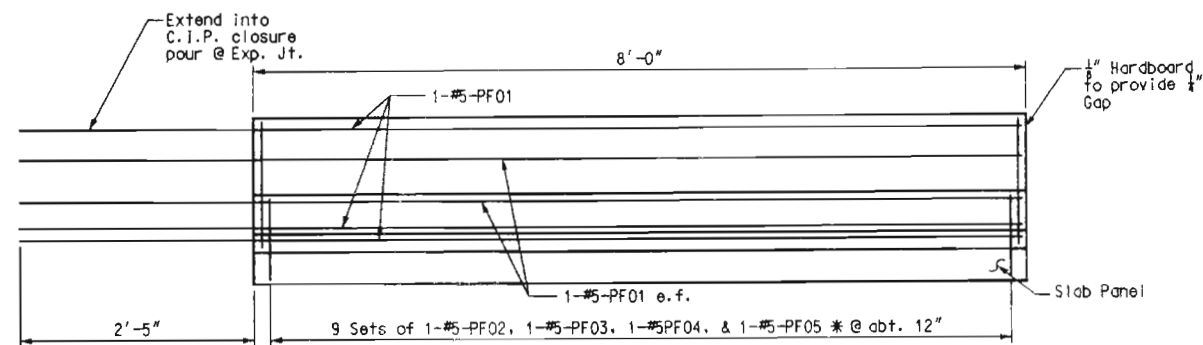

**SAFETY BARRIER ELEVATION AT PANELS F**

(Shown at End Bent 1, End Bent 20 opposite hand.)

Notes:  
 For safety barrier curb details at end bents, see Sheet No. 29.  
 Top of safety barrier curb shall be built parallel to grade with safety barrier curb joints (except at End Bents) normal to grade.  
 All exposed edges of safety barrier curb shall have either a 1/2" radius or a 1/4" bevel, unless otherwise noted.  
 Concrete in the safety barrier curb shall be Class B-1.  
 \* Adjust spacing of Bar PA05 thru PF05 to clear pocket for deck drain in slab panels.  
 e.f. denotes each face.



SLAB PANEL SAFETY BARRIER CURB DETAILS

HICKORY


COUNTY

A08941

USER: FRANK P. [Name] 10/14/03 16:12  
 k:\B33418\VR1 64 1 recast Deck Drawings\p21.dgn




State	Proj. No.	Sheet No.
MO		B26

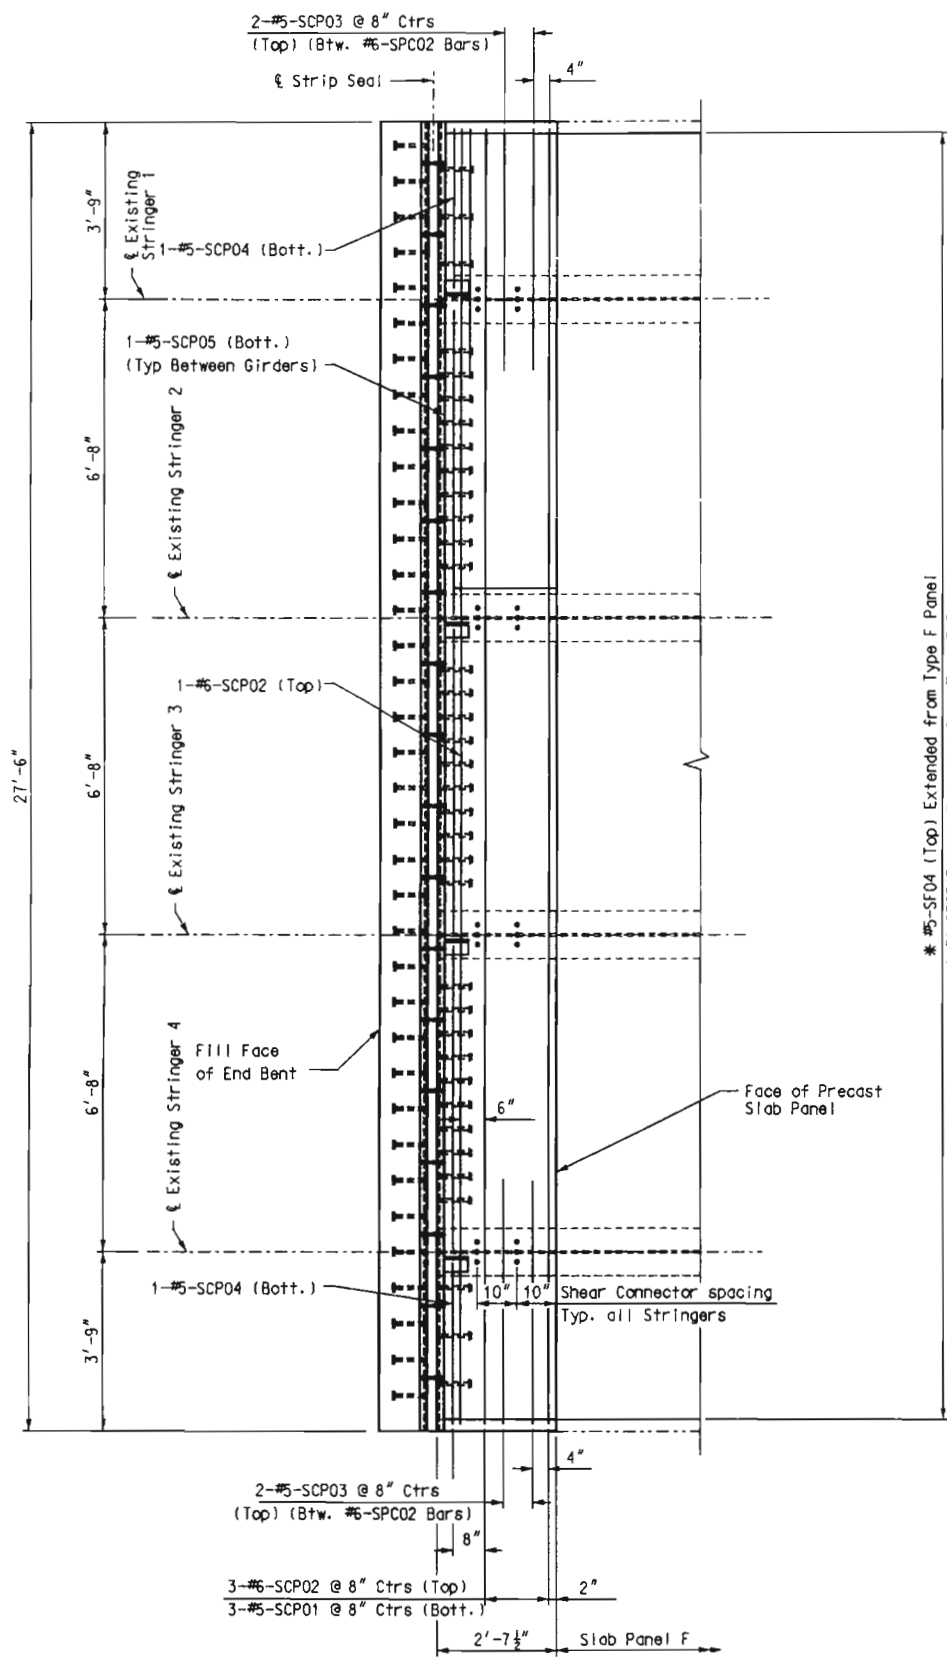

**CLOSURE POUR AT END BENT**

\* Field Bend as Required to Clear Expansion Joint Shear Connectors.

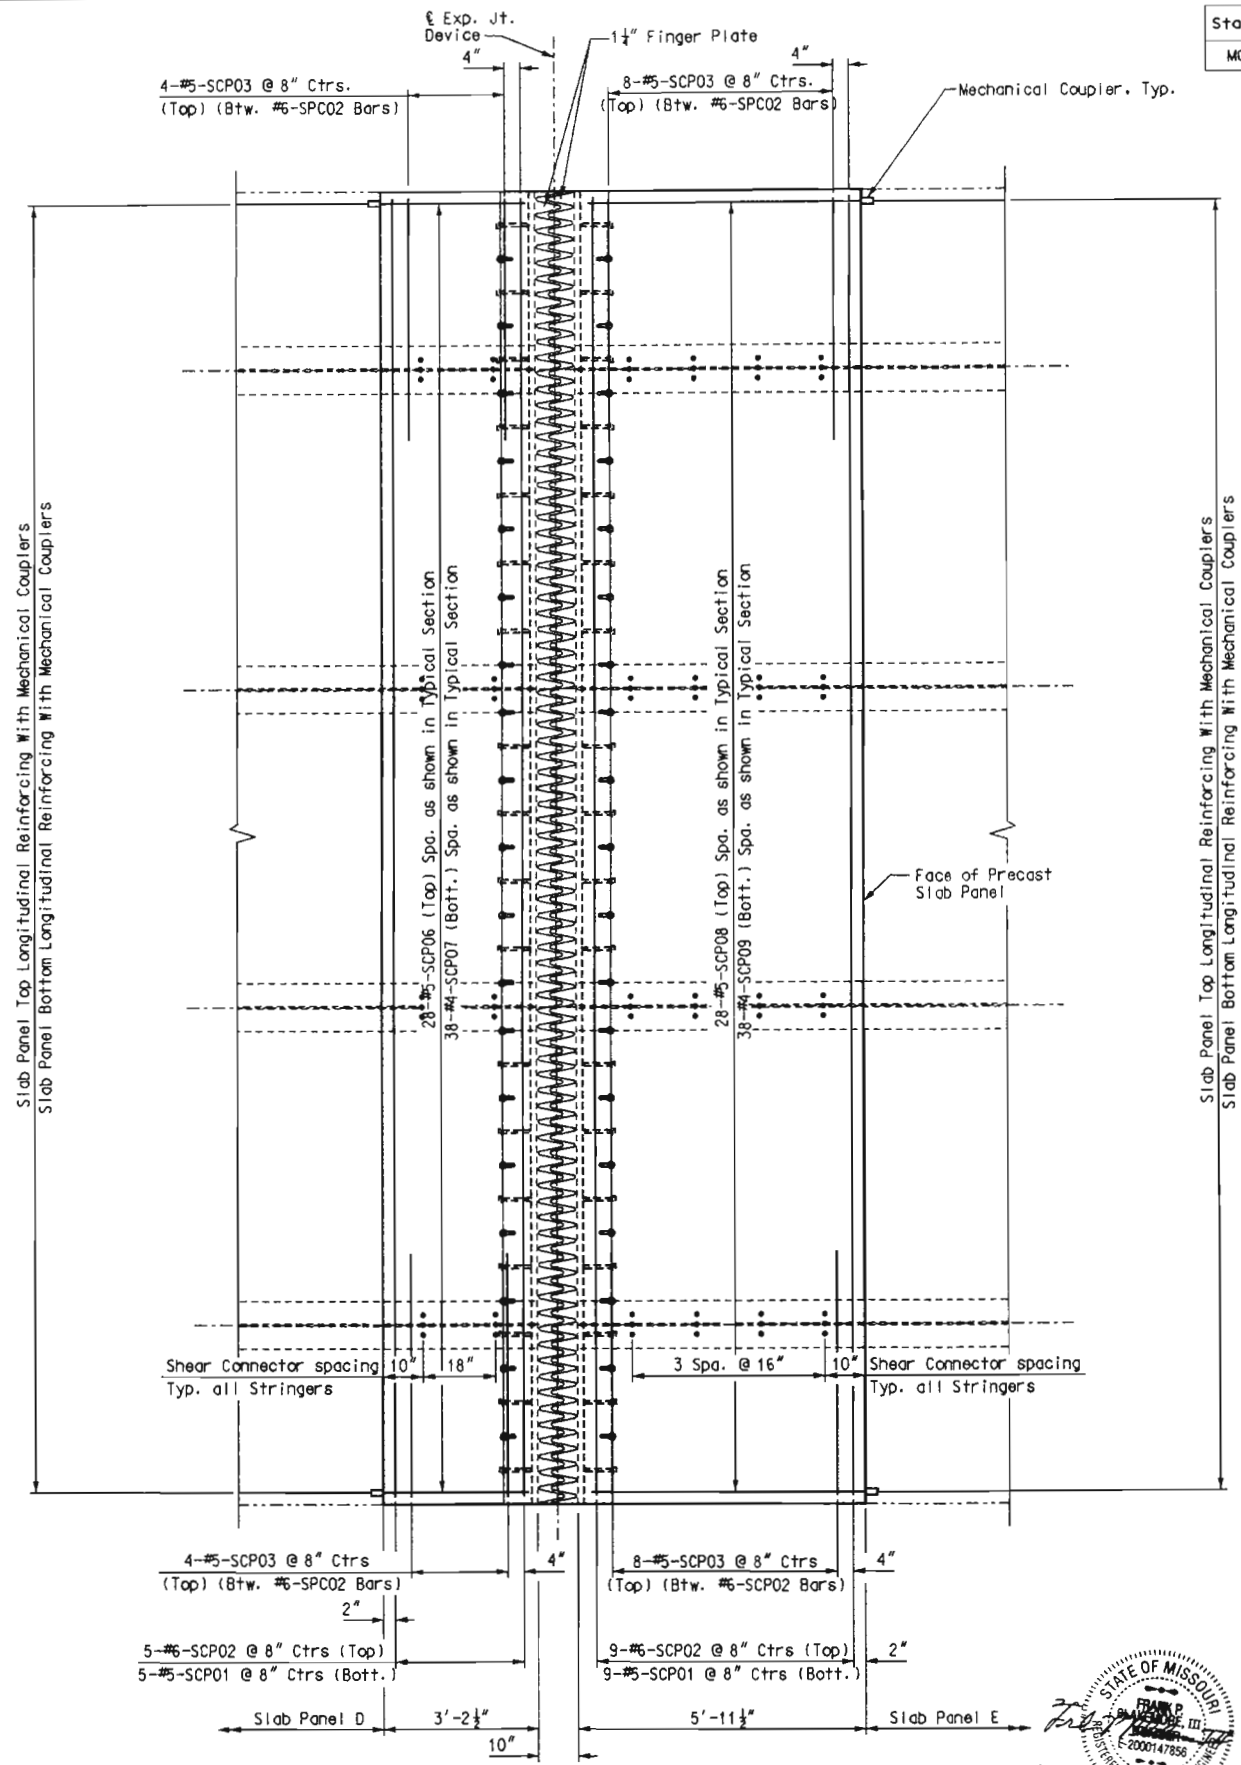

**CLOSURE POUR AT HINGE**

**CLOSURE POUR DETAILS**

Notes:  
 For details of strip seal at end bents. See Sheet No. 31.  
 For details of finger joints. See Sheet No. 30.



USER: jthompson  
 PLOTTED: 10-DEC-2003 16:12  
 I:\B3\3118\RT\64 Precast Deck\Drawings\p2.dwg


Detailed NOV 2003  
 Checked NOV 2003




Note: This drawing is not to scale. Follow Dimensions.

Sheet No. 26 of 35

HICKORY COUNTY A08941

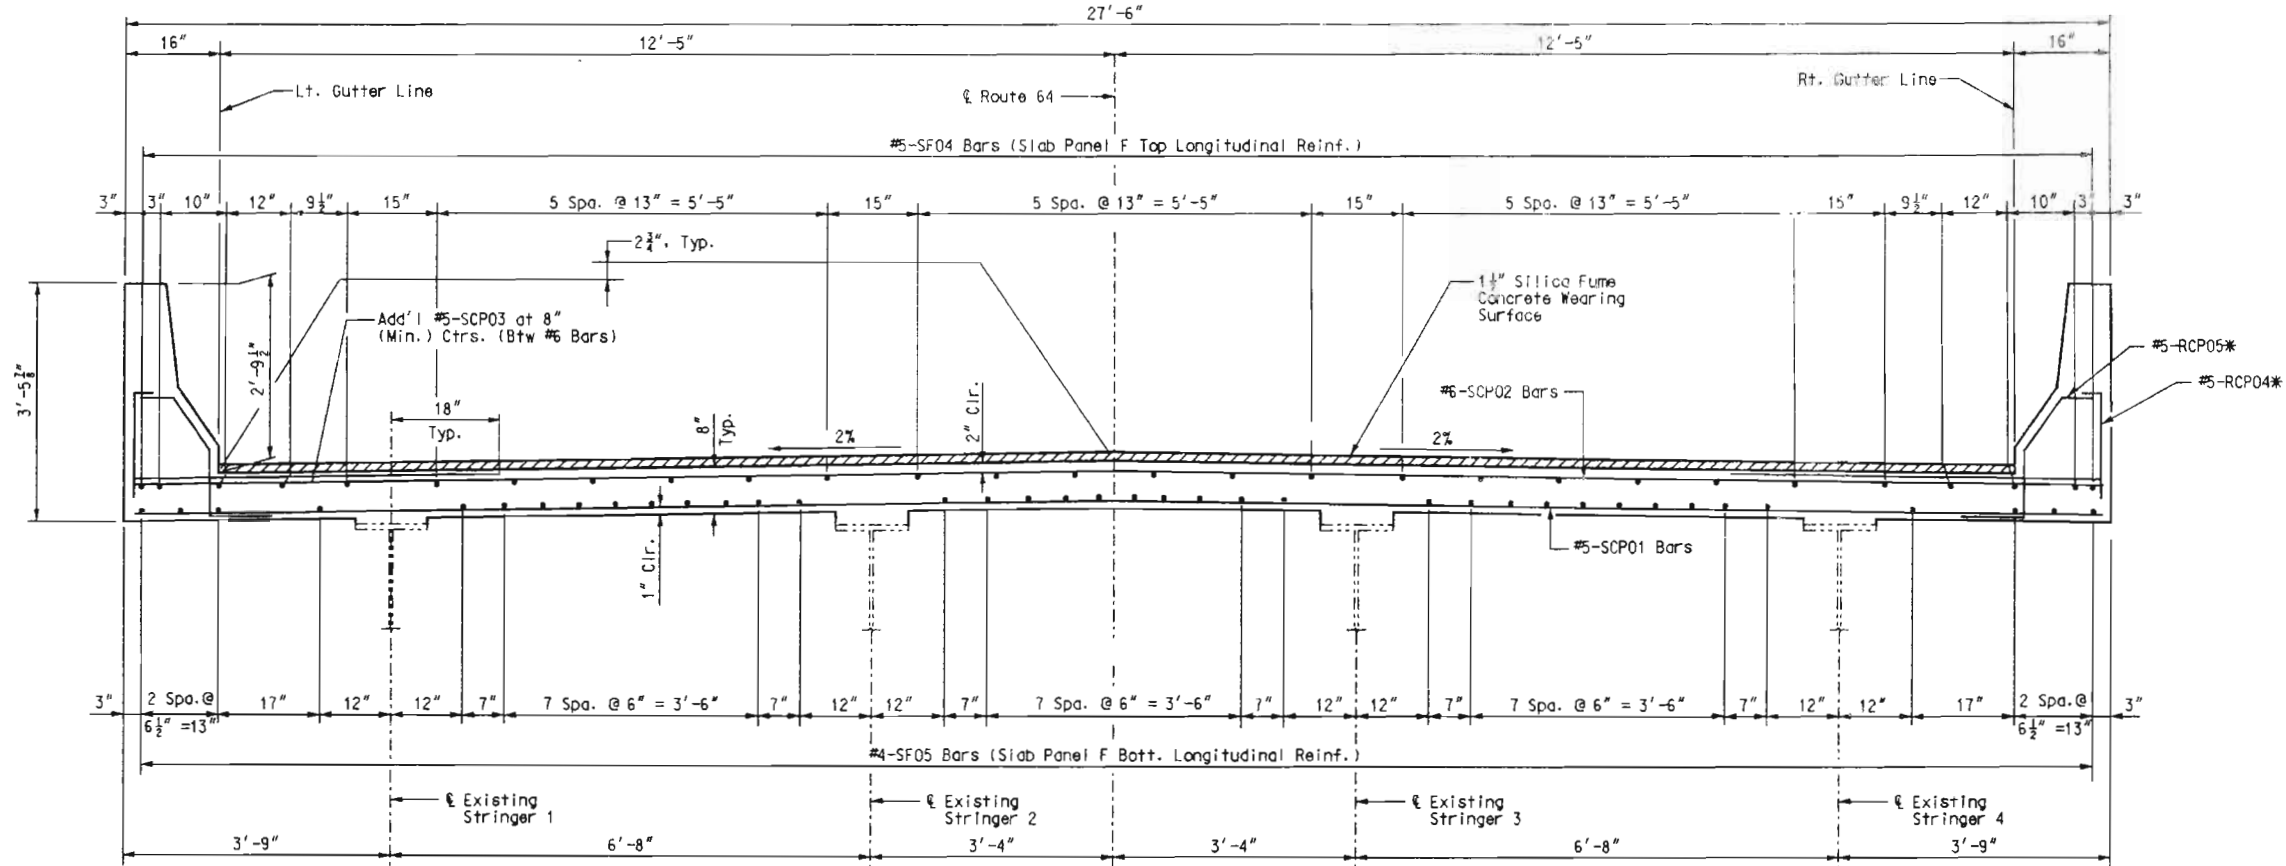


**TYPICAL SECTION**  
(Shown at End Bent)

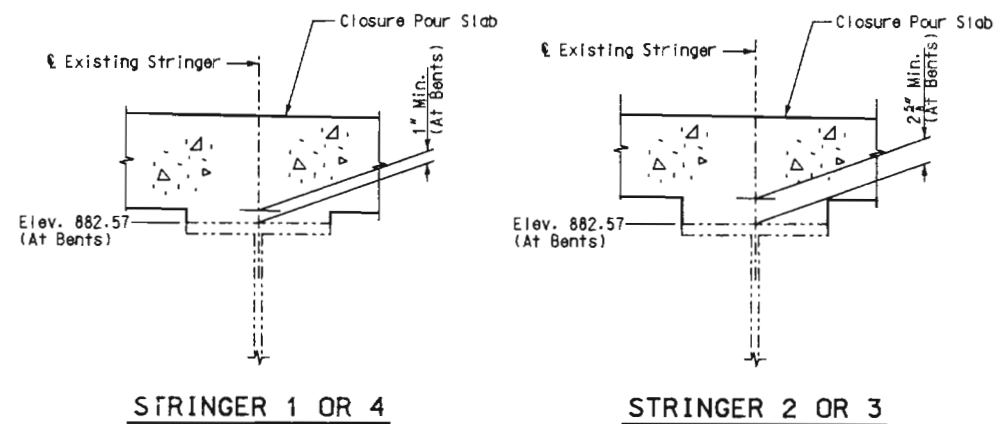

**TYPICAL HAUNCH DETAIL**

Note:  
If haunch depth exceeds 3", shear connector length shall be increased.  
Field verify haunch depths prior to placement of closure pour slab.  
No payment will be made for additional shear connector length, or concrete required for variable haunch.

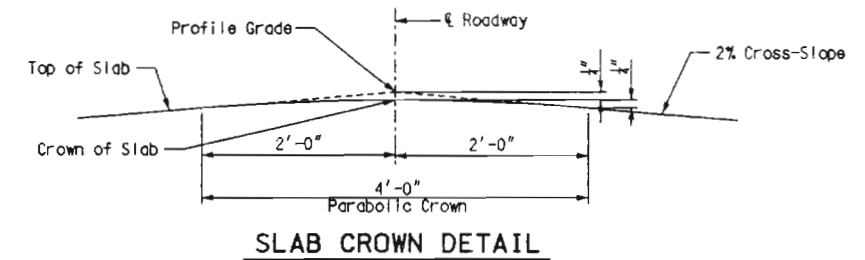

**SLAB CROWN DETAIL**

Notes:  
For Closure Pour Details, see Sheet No. 26.  
For Safety Barrier Curb Details, see Sheet No. 28.  
\* For spacing of #5-RCP04 and #5-RCP05 bars, see Safety Barrier Curb Elevation, Sheet No. 28.  
Bar Marks shown are for Closure Pour at End Bent. Closure Pours at Hinge are similar.


**CLOSURE POUR CROSS SECTION**



HICKORY COUNTY


A08941

C:\p3\3418\RT 64 Proj.asst\lect\drawings\p22a.dgn  
 DEC-2003 16:12

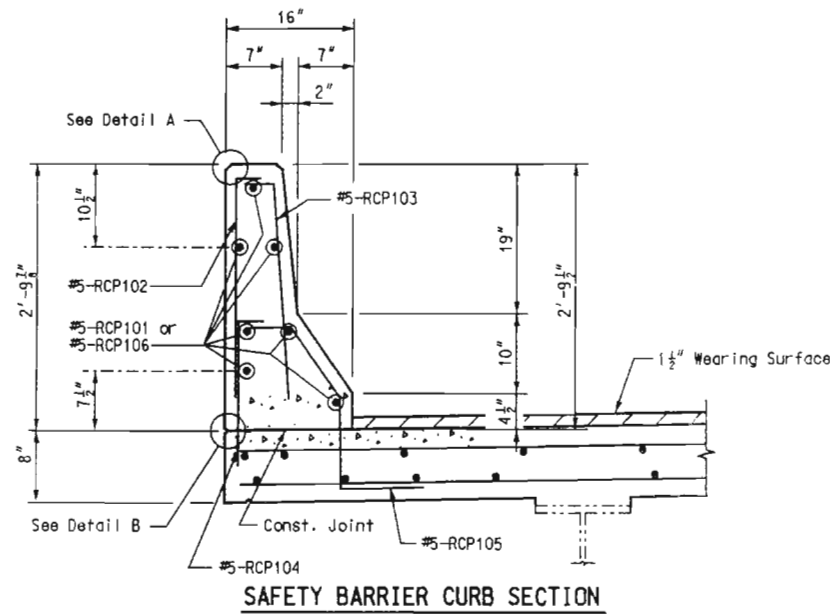


**SAFETY BARRIER CURB SECTION**

Notes:  
The cross-sectional area above the slab = 2.44 sq. ft.

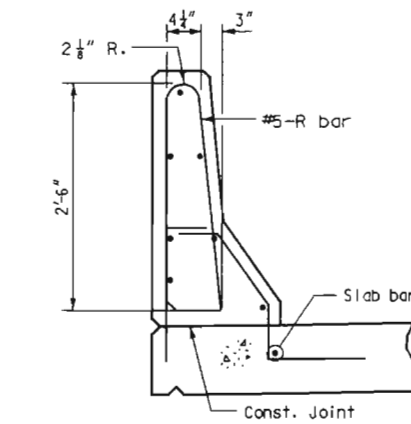


**R-BAR PERMISSIBLE ALTERNATE SHAPE**


The RCP102 and RCP103 bar combination may be furnished as one bar, as shown, at the contractor's option. (All dimensions are out to out.)

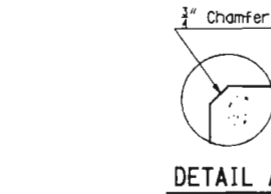


**DETAIL A**

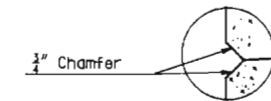

**DETAIL B**

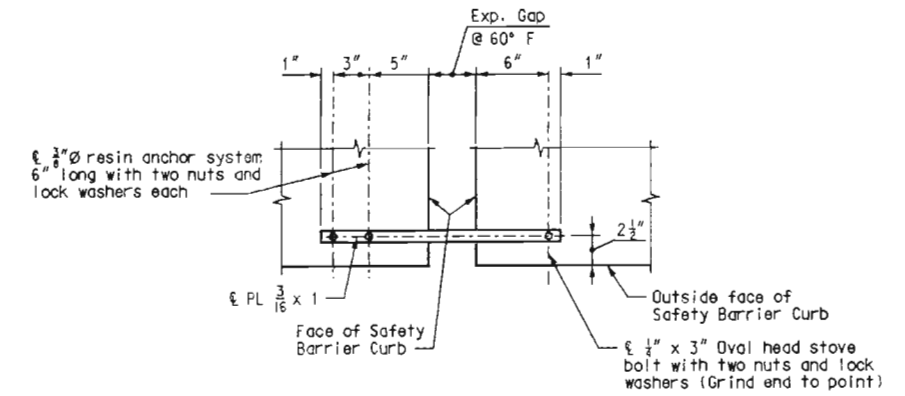


**PART PLAN OF BARRIER CURB SHOWING MOVEMENT GAUGE**

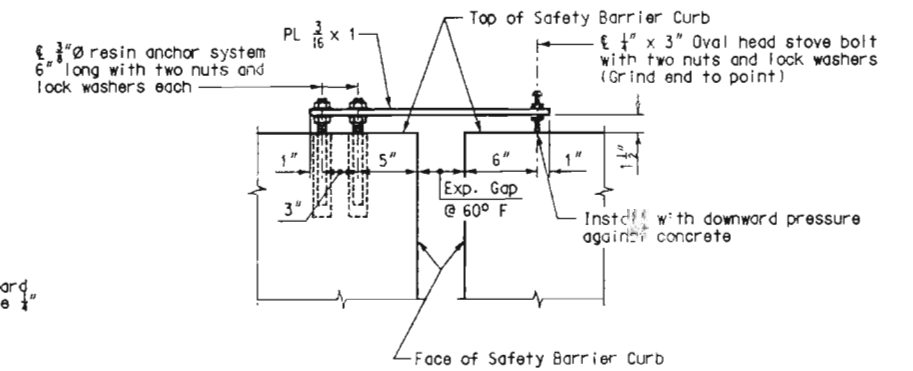


**PART ELEVATION OF BARRIER CURB SHOWING MOVEMENT GAUGE**

Notes:  
A movement gauge shall be provided on right side of bridge at all safety barrier curb expansion joints.  
All steel shall be galvanized in accordance with ASTM A153.  
Cost of movement gauge complete in place shall be included in contract unit price for Class B-1 Concrete (Closure Pour & Barrier Curb).

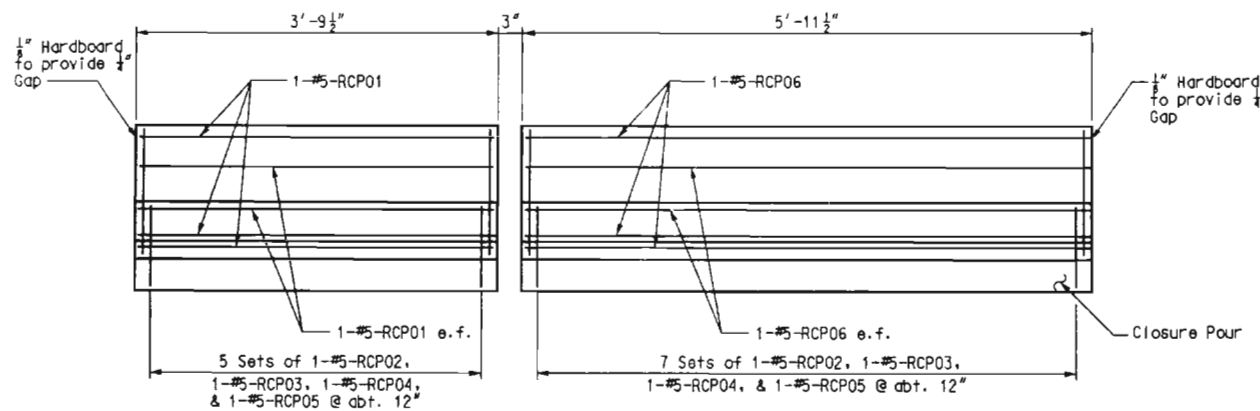


**SAFETY BARRIER ELEVATION AT C.I.P. CLOSURE POURS**

(Hinge 1 shown, Hinges 2, 3, and 4 similar.)

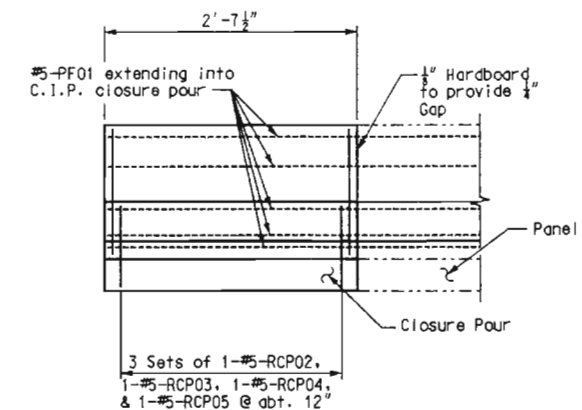

**SAFETY BARRIER ELEVATION AT C.I.P. CLOSURE POURS**

(End Bent 1 shown, End Bent 20 similar.)

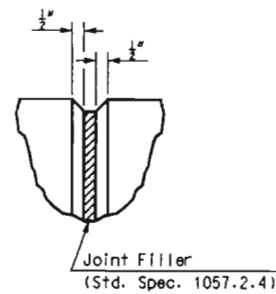

**FILLED JOINT DETAIL**

Note:  
Fill joint between barrier on slab panel and cast-in-place barrier at closure pours.

Notes:  
For safety barrier curb details at end bents, see Sheet No. 29.  
Top of safety barrier curb shall be built parallel to grade.  
All exposed edges of safety barrier curb shall have either a 1/2 inch radius or a 1/4 inch bevel, unless otherwise noted.  
Concrete in the safety barrier curb shall be Class B-1.




**DETAILS OF SAFETY BARRIER CURB AT CLOSURE POURS**

**HICKORY COUNTY**


**A08941**

USER: jthompson  
 FILED: 11-DEC-2013 08:54  
 PROJECT: I-55/48/41/64 - Project Deck Widening - P. 2/3

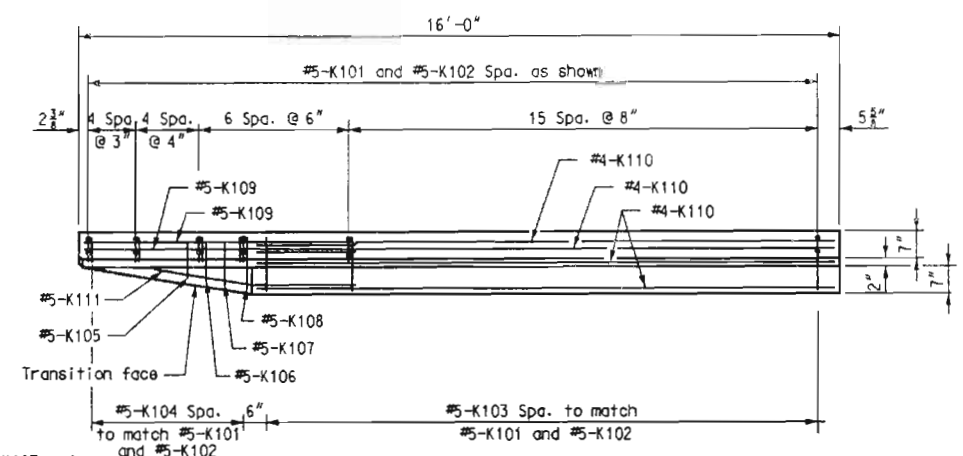


**PLAN**


Notes:  
 #5-K105, #5-K106, #5-K107 and #5-K108 are spaced with #5-K104 bars. Fit #5-K111 bar to follow transition face of curb.

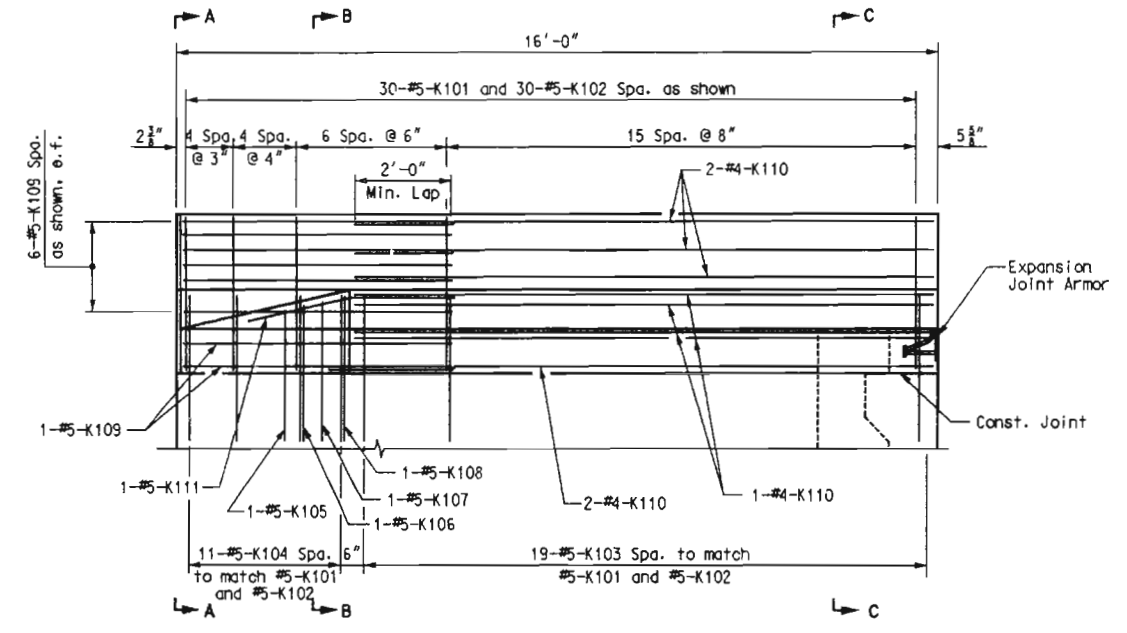


**BARRIER ELEVATION**  
 End Bent 1, Left side shown (Right side opposite)

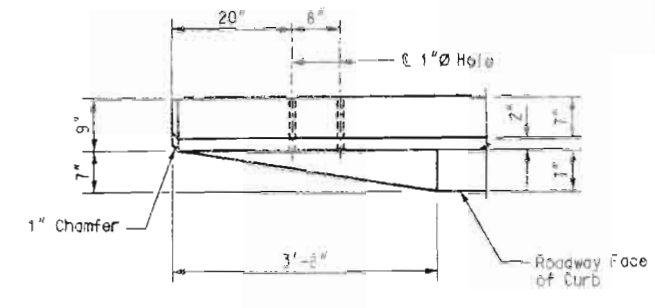


**PART PLAN**

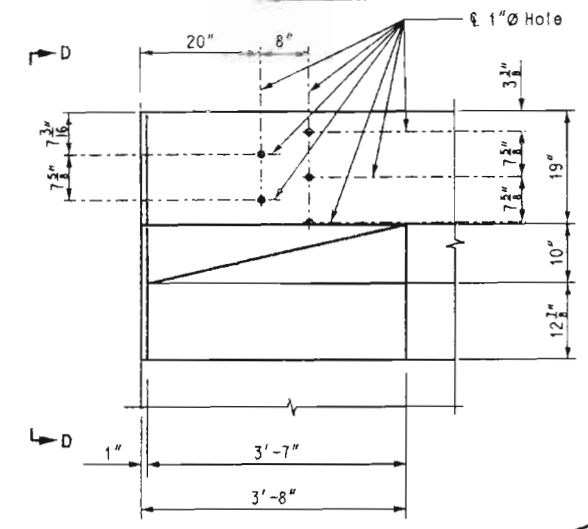

**PART ELEVATION**

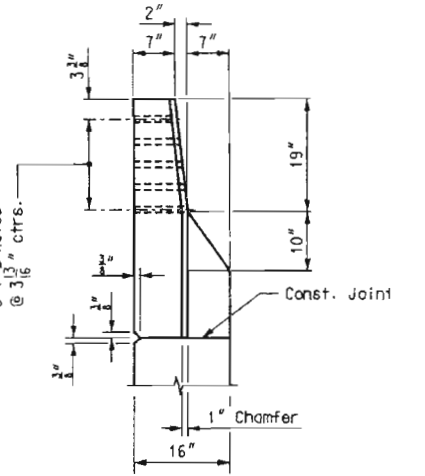


**VIEW D-D**

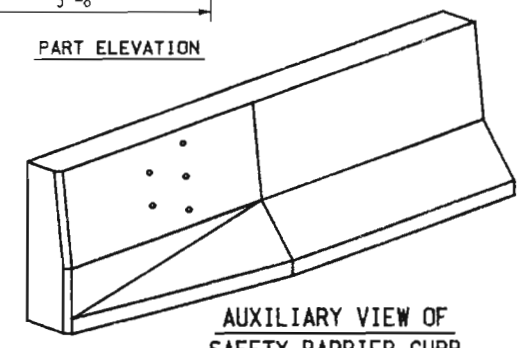


**AUXILIARY VIEW OF SAFETY BARRIER CURB**


**DETAILS OF GUARD RAIL ATTACHMENT**

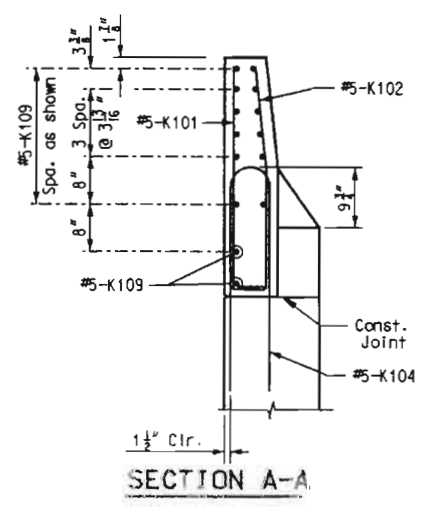

**SECTION A-A**

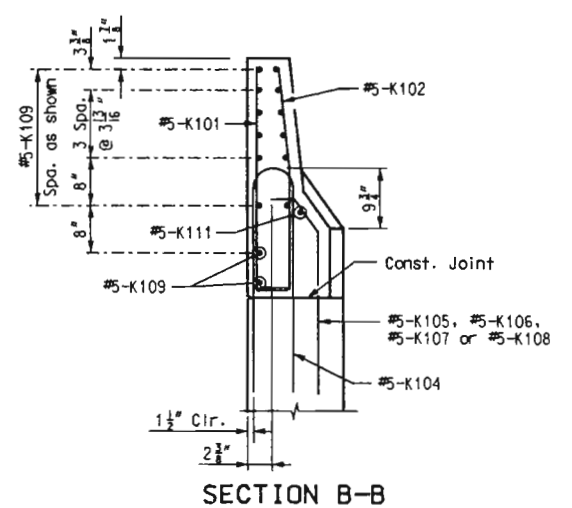

**SECTION B-B**

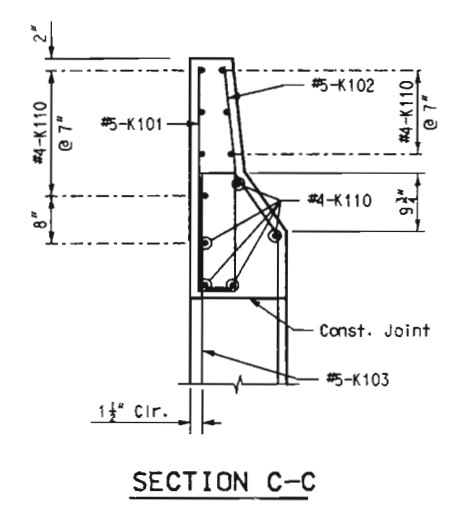

**SECTION C-C**

Notes:  
 For typical barrier curb section, see Sheet No. 28.  
 Top of safety barrier curb shall be built parallel to grade with safety barrier curb joints (except at End Bents) normal to grade.  
 All exposed edges of safety barrier curb shall have either a 1/2" radius or a 1/4" bevel, unless otherwise noted.  
 Concrete in the safety barrier curb shall be Class B-1.  
 Provide Guard Rail Attachment at Left and Right Barriers.  
 For Expansion Joint Details, see Sheet No. 31.  
 Bar Marks shown are for End Bent 1 using "100" series Bar Marks. End Bent 20 is identical, except use "2000" series Bar Marks.




**DETAILS OF SAFETY BARRIER CURB AT END BENTS**


HICKORY COUNTY A08941

USER: pthom  
 DATE: 11/11/03  
 DEC-2003 16:13  
 K:\b33418\ART 64 Precast Deck\Drawings\p29.dgn

State	Proj. No.	Sheet No.
MO		B30

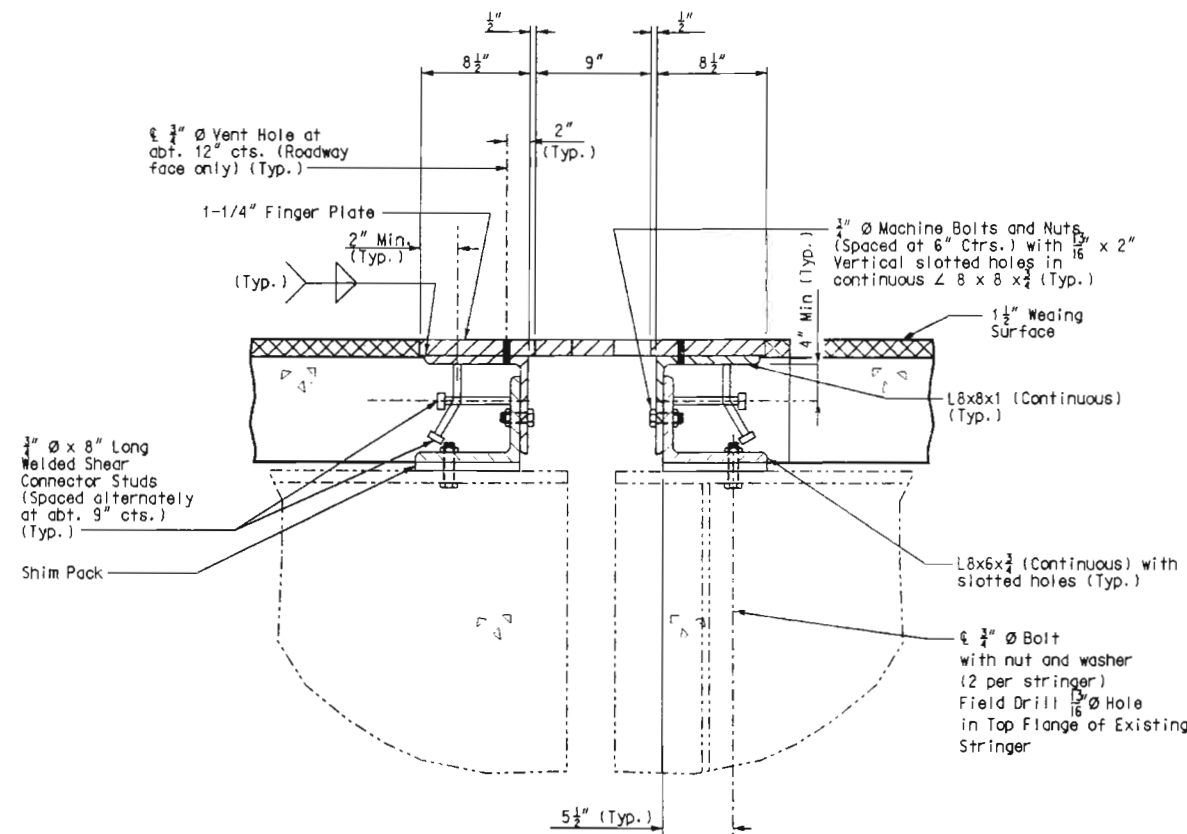

PART SECTION THRU EXPANSION JOINT

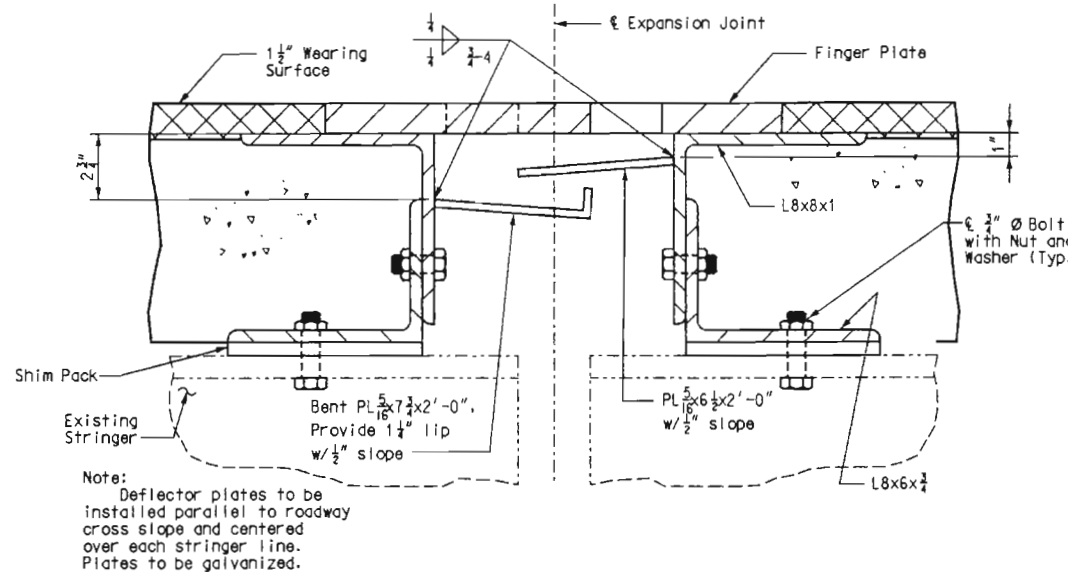

DEFLECTOR PLATES AT EACH STRINGER LINE

**GENERAL NOTES:**

Finger plate shall be cut with a machine guided gas torch from one plate. The plate from which fingers are cut may be spliced before fingers are cut. The surface of cut shall be perpendicular to the surface of the plate. The cut shall not exceed 1/8 inch in width. The centerline of cut shall not deviate more than 1/8 inch from the position of centerline of cut shown. No splicing of finger plate or finger plate assembly will be allowed after fingers are cut.

Plan dimensions are based on installation at 60°F. The expansion gap and other dimensions shall be increased 1/8 inch for each 10°F fall and decreased 1/8 inch for each 10°F rise in temperature at installation.

Structural steel for the expansion device and curb plate shall be coated with a minimum of two coats of inorganic zinc primer (5 mils minimum) or galvanized in accordance with ASTM A123. Anchors need not be protected from overspray.

Payment for furnishing, coating or galvanizing and installing structural steel for the expansion device will be made at the contract unit price for Expansion Device (Finger Plate) per lin. ft.


Concrete shall be forced under and around finger plate supporting hardware, studs, angles and bars. Proper consolidation shall be achieved by localized internal vibration.

1-1/4" Finger Plate and L 8 x 8 x 1/2 shall be bent to conform to crown of roadway.


Longitudinal reinforcing steel shall be placed so that ends shall not be more than 1"± from vertical Leg 8x6x3/4 angle at expansion device.

Material for the expansion device shall be ASTM A709 Grade 36 structural steel. Anchors for the expansion device shall be approved stud welded anchors (C1010 thru C1020).


Provide galvanized shims and beveled shims under L8x6x3/4 at existing stringers.

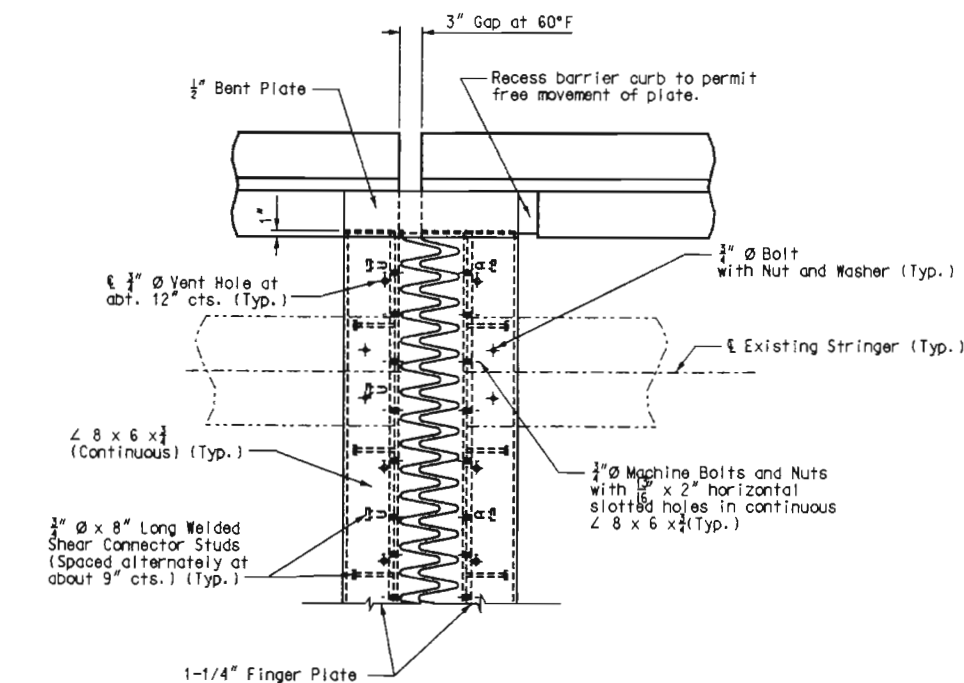


PART PLAN OF EXPANSION DEVICE

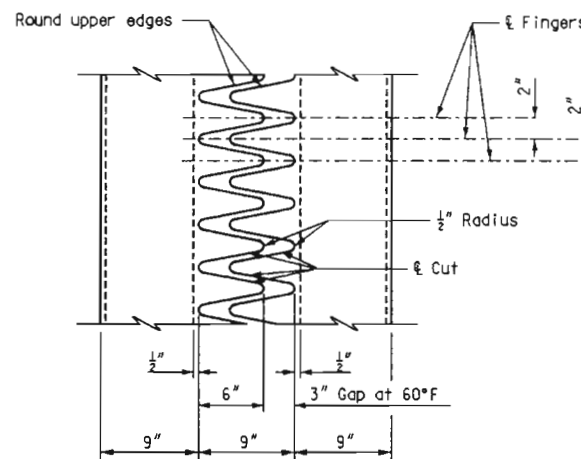

TYPICAL PLAN OF PLATE

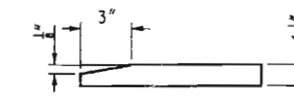


FINGER DETAIL

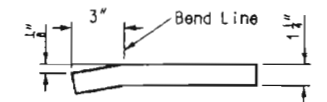


OPTIONAL FINGER DETAIL





PART SECTION B-B

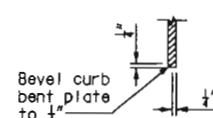


SECTION C-C

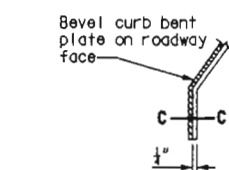

PART ELEVATION AT END OF BEVELED CURB BENT PLATE

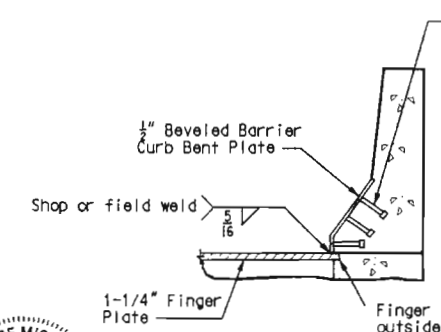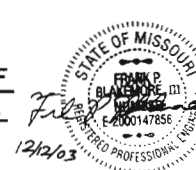

PART SECTION A-A

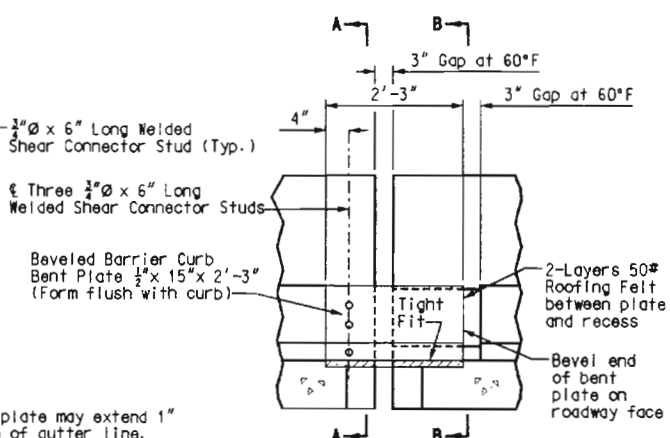

PART ELEVATION OF BARRIER CURB

DETAILS OF FINGER JOINTS AT HINGES

HICKORY COUNTY


A08941

USER: jthompson  
 PLOTTED: 10-DEC-2003 16:13  
 I: J:\5418\481 64 Proj-6-1 Deck\Drawings\Exp. 1.dwg

Detailed OCT 2003  
 Checked NOV 2003  
**HNTB**

Note: This drawing is not to scale. Follow Dimensions.

Sheet No. 30 of 35

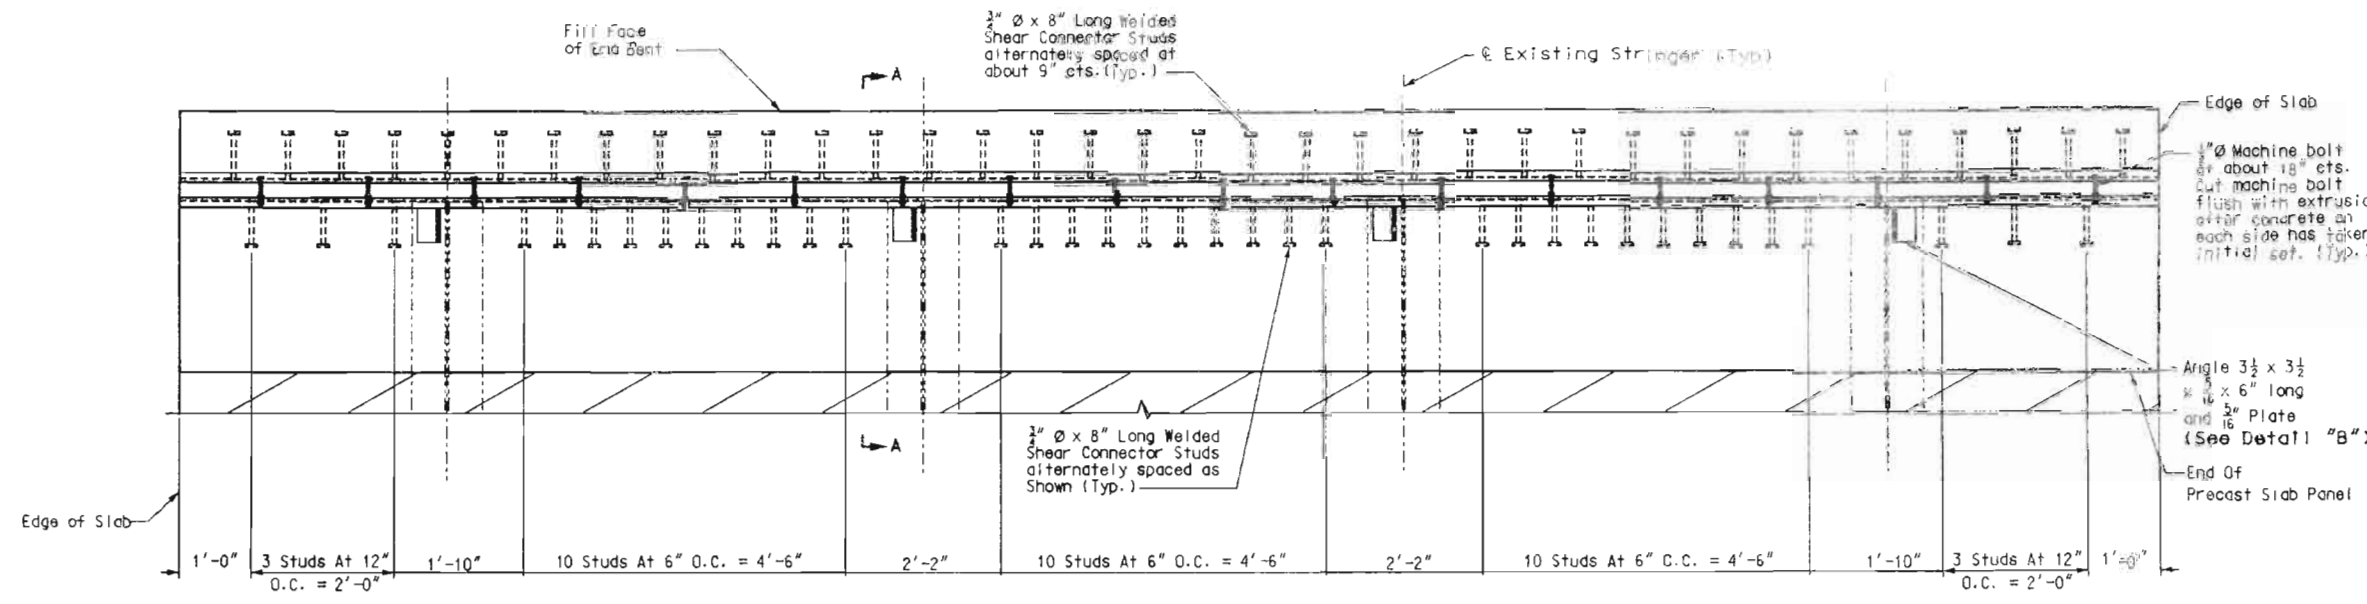

PLAN

**GENERAL NOTES:**

The expansion device shall be fabricated and installed in accordance with the recommendations of the manufacturer, and as set forth in the Special Provisions.

The contractor must verify all dimensions prior to fabrication.

All welds shall conform to Section 712 of the Missouri Standard Specifications.

Splices of steel extrusion shall develop full strength.

All steel shall be ASTM A709 Grade 36, except steel extrusions shall be ASTM A709 Grade 50W or Grade 36.

Neoprene Strip Seal shall meet ASTM D-2628.

Anchors for the extrusions or armor shall be approved welded studs (C1010 thru C1020).

Structural steel for the expansion device and curb plate shall be coated with a minimum of two coats of inorganic zinc primer (5 mils minimum) or galvanized in accordance with ASTM A123. Anchors need not be protected from overspray.

Payment for furnishing, coating or galvanizing and placing steel extrusions, miscellaneous structural steel, barrier curb plates, and neoprene strip seal shall be made under the contract unit price for Strip Seal Expansion Device.


Plan dimensions are based on installation at 60°F. The gap shall be increased  $\frac{1}{8}$ " for each 10° fall in temperature and decreased  $\frac{1}{8}$ " for each 10° rise in temperature from the installation temperature.

Longitudinal reinforcing steel shall be placed so that ends shall not be more than 1" from vertical leg of extrusion at Expansion Device.


Concrete shall be forced under and around strip seal extrusions and studs. Proper consolidation of the concrete shall be achieved by localized internal vibration.

Curb Plate anchors shall be a drilled cone expansion or a cast-in-place wing type threaded insert. The minimum ultimate pullout capacity for these anchors shall be 2700 lbs in f'c = 4000 psi concrete. Lead anchors will not be permitted. Holes for anchors shall not be drilled until the concrete is at least 7 days old.


For Safety Barrier Curb Details, see Sheet No. 29.

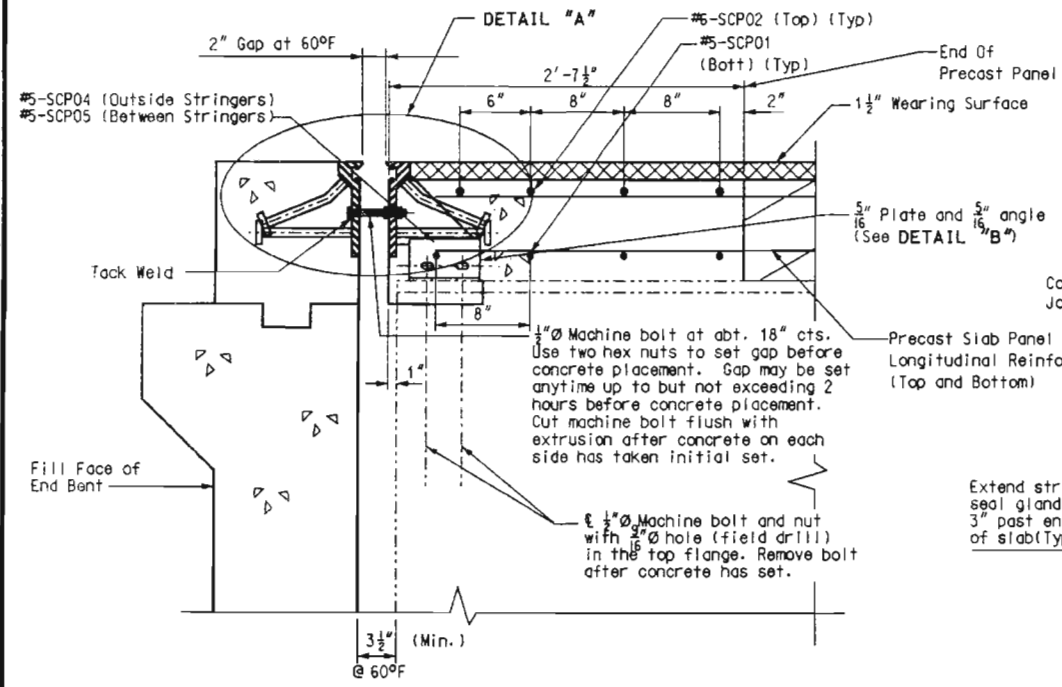


SECTION A-A

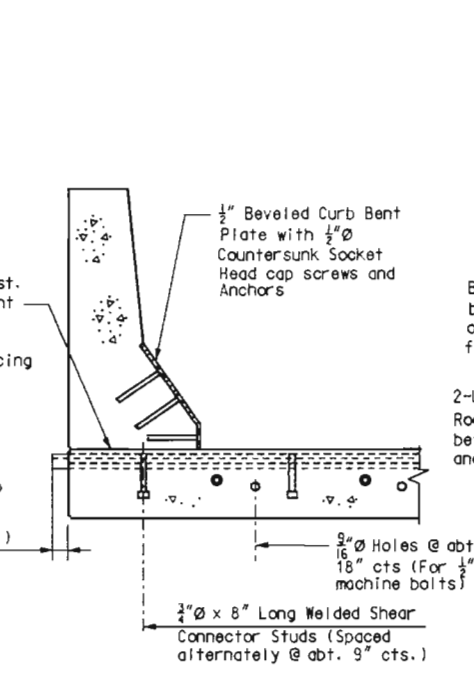


PART SECTION C-C

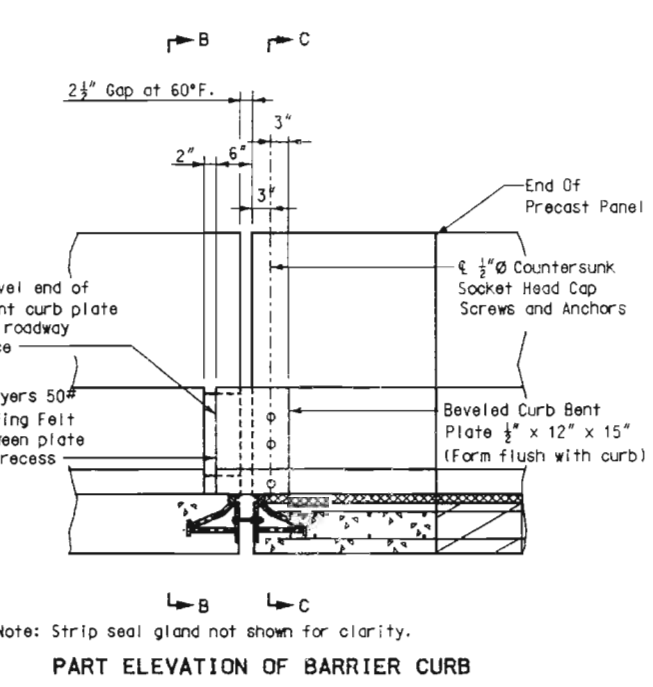


PART ELEVATION OF BARRIER CURB

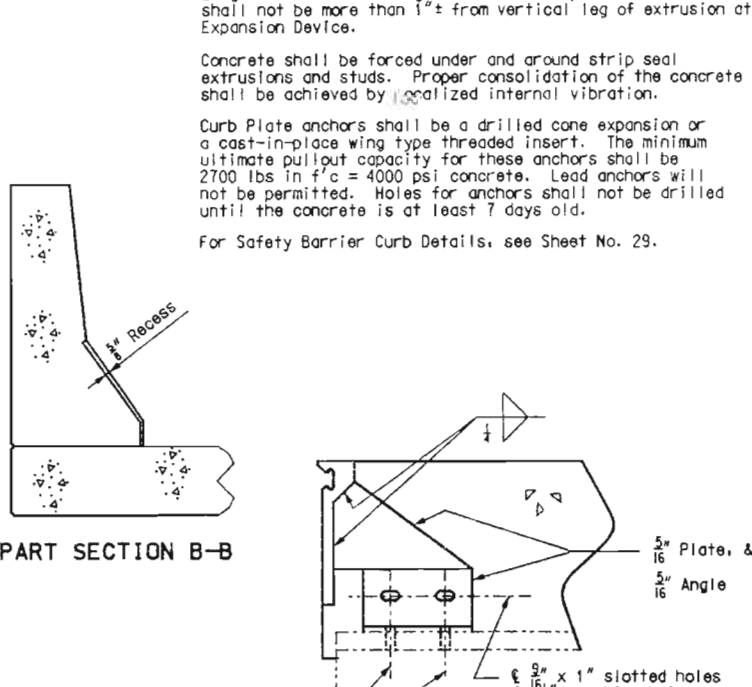


PART SECTION B-B

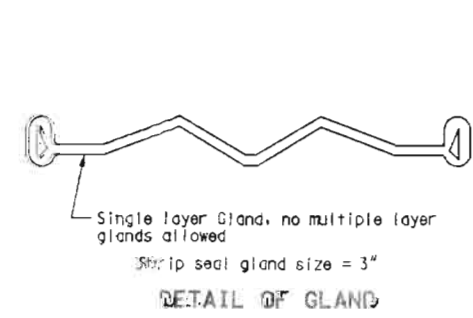


DETAIL OF GLAND

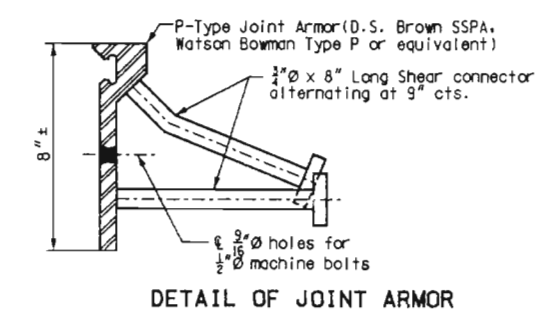


DETAIL OF JOINT ARMOR

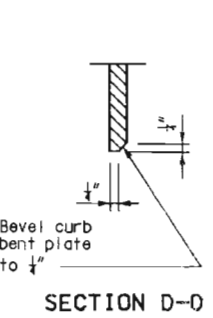


SECTION D-D

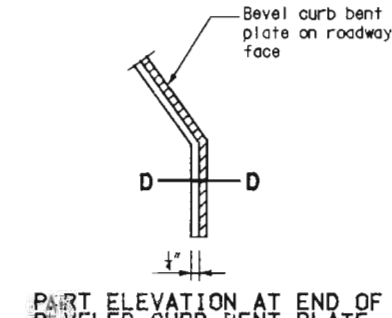

PART ELEVATION AT END OF BEVELED CURB BENT PLATE

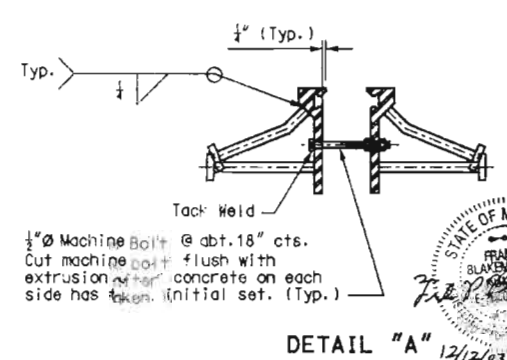

DETAIL "A"

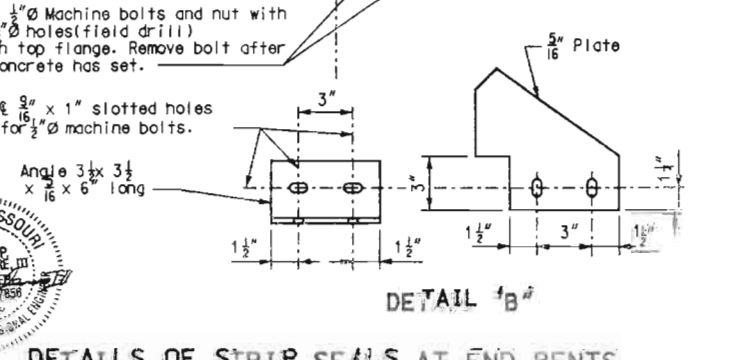

DETAIL "B"

DETAILS OF STRIP SEALS AT END BENTS


USER: jh  
 DATE: 12/11/13  
 PROJECT: 16-13  
 DRAWING: 12/12/13  
 SHEET: B31 OF 35  
 HNTB

Note: This drawing is not to scale. Follow dimensions.


Sheet No. 31 of 35

HICKORY COUNTY A08941


State	Proj. No.	Sheet No.
MO		B32

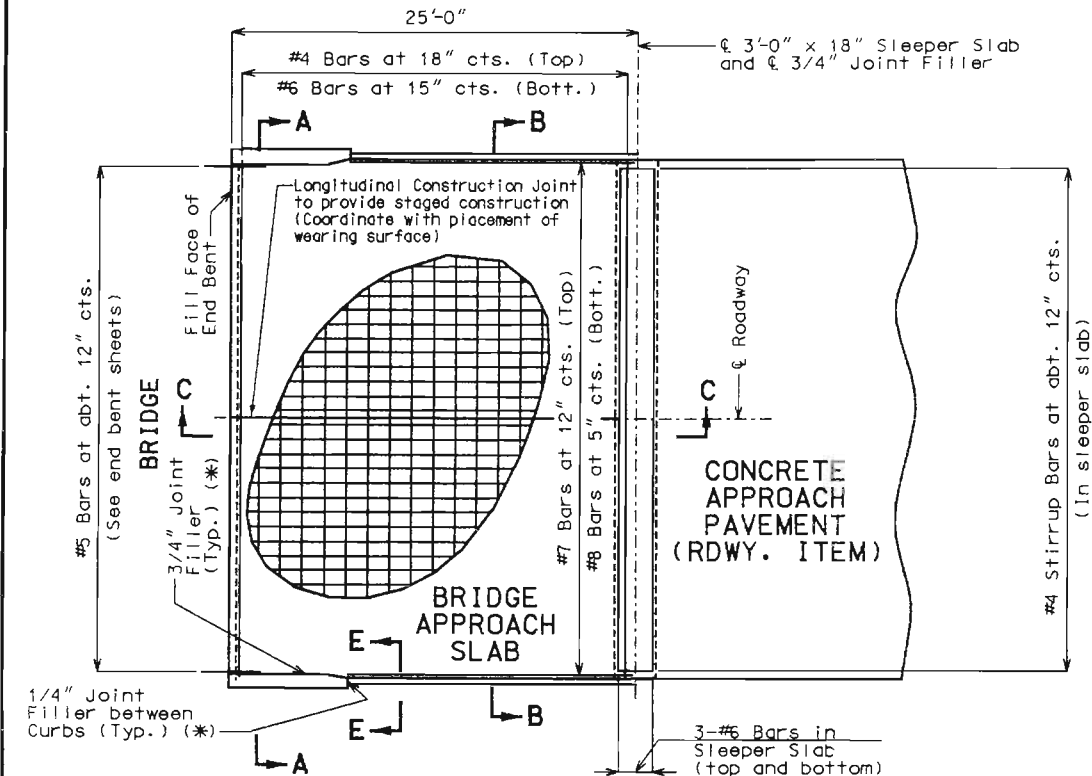


PART PLAN SHOWING REINFORCEMENT

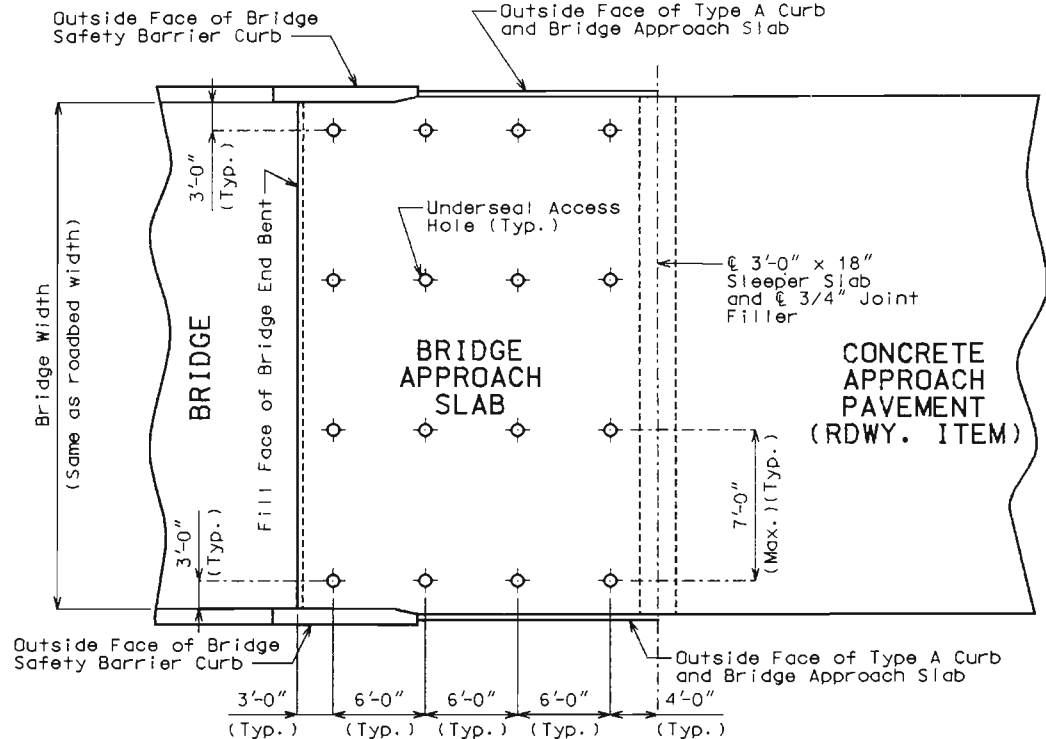

PART PLAN (SHOWING TYPICAL UNDERSEAL ACCESS HOLE LOCATIONS)

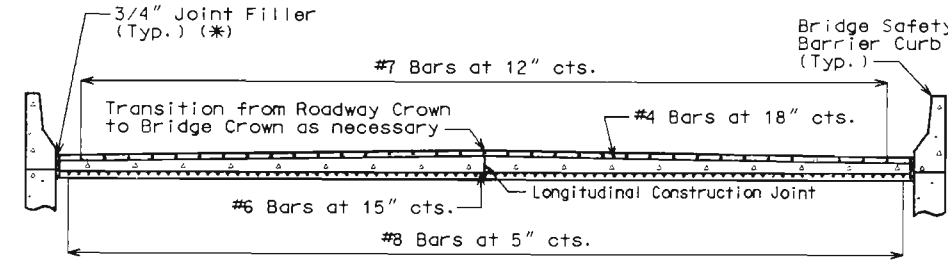


SECTION A-A

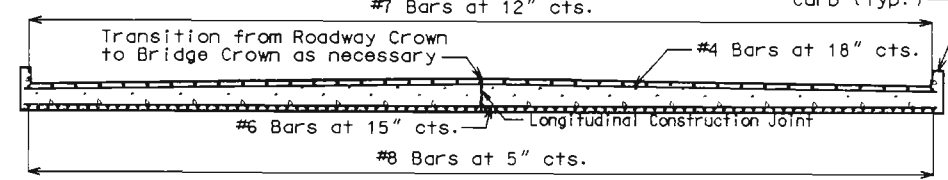


SECTION B-B

Note: With the approval of the Engineer, the contractor may crown the bottom of the approach slab to match the crown of the roadway surface.

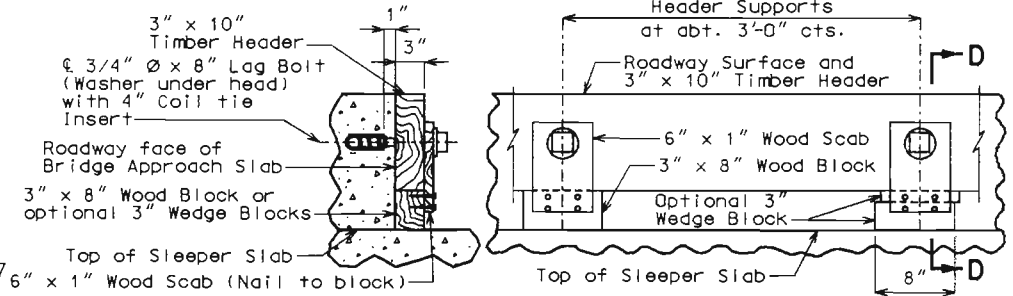


SECTION D-D PART ELEVATION DETAILS OF TIMBER HEADER

Note: Remove timber header when concrete pavement is placed.  
 (\*) Use 3/4" Joint Filler between vertical face of Approach Slab and roadway face of Safety Barrier Curb/Wing, except at the end of Safety Barrier Curb/Wing face use 1/4" Joint Filler. Seal joint with joint sealant. See Special Provisions.

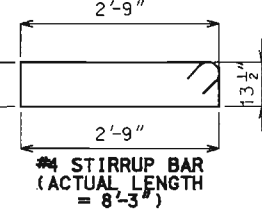


TYPICAL 135° STIRRUP BAR HOOK DIMENSIONS BENDING DIAGRAM

Note: Nominal lengths are based on out to out dimensions shown in bending diagram and are listed for fabricators use (nearest inch).

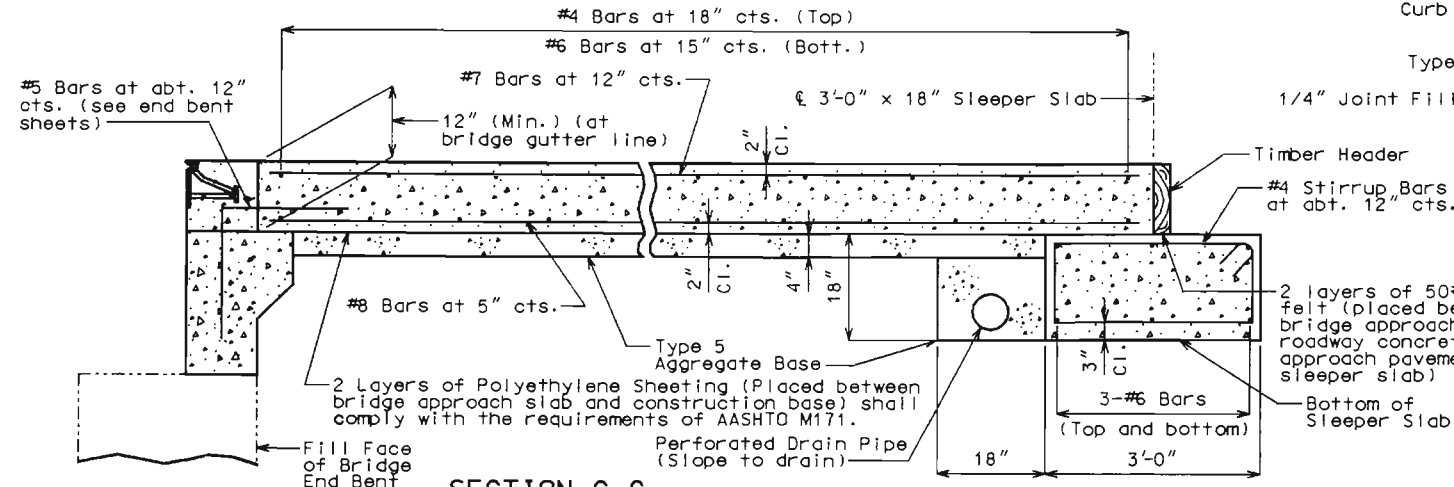


SECTION C-C

SECTION E-E (BETWEEN CURBS)

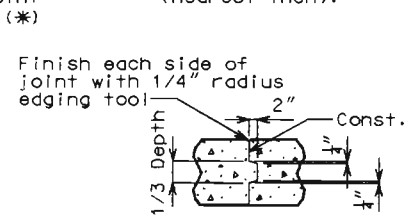

CONST. JOINT DETAIL (IF REQUIRED)

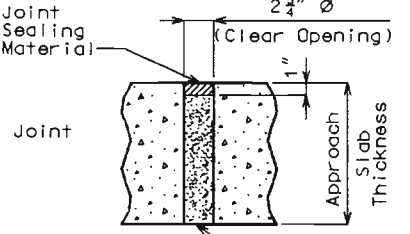

TYPICAL UNDERSEAL ACCESS HOLE DETAIL

BRIDGE APPROACH SLAB DETAILS



USER: jthompson  
 PLOTTED: 10-DEC-2003 10:10  
 I:\1534\PROJECT 64 - Project Deck\dwg\10-11-03



**BILL OF REINFORCING STEEL**

NO. REQ'D.	MARK NO.	LOCATION	EPOXY (E)	SHAPE NO.	STIRRUP (S)	SUBSTR. (X)	VARIES (V)	NO. EACH	DIMENSIONS								NOMINAL LENGTH	ACTUAL LENGTH	WEIGHT
									B	C	D	E	F	H	K				
<b>END BENT 1</b>																			
6	6H101	Backwall		E 20	X				27'-2"							27'-2"	245		
8	6H102	Backwall		E 20	X				2'-3"							2'-3"	27		
16	6H103	Backwall		E 19	X				6'-4"	18"						7'-10"	186		
1	4H104	Backwall		E 20	X				24'-6"							24'-6"	16		
14	6H105	Wingwall		E 15	X				14"	4'-4"	14"	9 3/8"	9 3/8"	9 3/8"	9 3/8"	6'-8"	140		
10	6H106	Wingwall		E 20	X				13'-5"						13'-5"	202			
20	6H107	Wingwall		E 20	X	V	4		7'-10"						7'-10"	313			
		Increment = 15 1/2"							13'-0"						13'-0"				
12	4H108	Wingwall		E 20	X				2'-4"						2'-4"	19			
20	6H109	Wingwall		E 20	X	V	4		3'-4"						3'-4"	189			
		Increment = 17 3/4"							9'-3"						9'-3"				
20	6H110	Backwall		E 20	X				2'-3"						2'-3"	68			
25	4U101	Backwall		E 5	X				6"	14"	14"				2'-10"	45			
25	5U102	Backwall		E 19	X				2'-0"	2'-0"					4'-0"	102			
36	4V101	Backwall		E 20	X				2'-1"						2'-1"	50			
18	4V102	Backwall		E 20	X				4'-10"						4'-10"	58			
4	6V103	Wingwall		E 15	X	V	4		14"	14'-3"	19"	7 3/8"	17 3/8"	12 3/8"	5 3/8"	17'-0"	102		
108	6V104	Wingwall		E 20	X				16"						16"	676			
		Increment = 2 3/4"							7'-0"						7'-0"				
12	6V105	Wingwall		E 20	X				7'-2"						7'-2"	129			
4	4V106	Wingwall		E 20	X				3'-8"						3'-8"	10			
4	4V107	Wingwall		E 5	X				3'-10"	2'-10"	2'-10"				9'-4"	25			
8	6V108	Wingwall		E 20	X				4'-10"						4'-10"	58			
<b>END BENT 20</b>																			
6	6H2001	Backwall		E 20	X				27'-2"						27'-2"	245			
8	6H2002	Backwall		E 20	X				2'-3"						2'-3"	27			
16	6H2003	Backwall		E 19	X				6'-4"	18"					7'-10"	186			
1	4H2004	Backwall		E 20	X				24'-6"						24'-6"	16			
14	6H2005	Wingwall		E 15	X				14"	4'-4"	14"	9 3/8"	9 3/8"	9 3/8"	9 3/8"	6'-8"	140		
8	6H2006	Wingwall		E 20	X				13'-5"						13'-5"	161			
20	6H2007	Wingwall		E 20	X	V	4		7'-10"						7'-10"	313			
		Increment = 15 1/2"							13'-0"						13'-0"				
12	4H2008	Wingwall		E 20	X				2'-4"						2'-4"	19			
20	6H2009	Wingwall		E 20	X	V	4		3'-4"						3'-4"	189			
		Increment = 17 3/4"							9'-3"						9'-3"				
20	6H2010	Backwall		E 20	X				2'-3"						2'-3"	68			
25	4U2001	Backwall		E 5	X				6"	14"	14"				2'-10"	45			
25	5U2002	Backwall		E 19	X				2'-0"	2'-0"					4'-0"	102			
36	4V2001	Backwall		E 20	X				2'-1"						2'-1"	50			
16	4V2002	Backwall		E 20	X				4'-10"						4'-10"	52			
4	6V2003	Wingwall		E 15	X	V	4		14"	14'-3"	19"	7 3/8"	17 3/8"	12 3/8"	5 3/8"	17'-0"	102		
108	6V2004	Wingwall		E 20	X				16"						16"	676			
		Increment = 2 3/4"							7'-0"						7'-0"				
12	6V2005	Wingwall		E 20	X				7'-2"						7'-2"	129			
4	4V2006	Wingwall		E 20	X				3'-8"						3'-8"	10			
4	4V2007	Wingwall		E 5	X				3'-10"	2'-10"	2'-10"				9'-4"	25			
8	6V2008	Wingwall		E 20	X				4'-10"						4'-10"	58			

\* Two additional #4-V102 and #6-H106 are included in the bar list for testing.

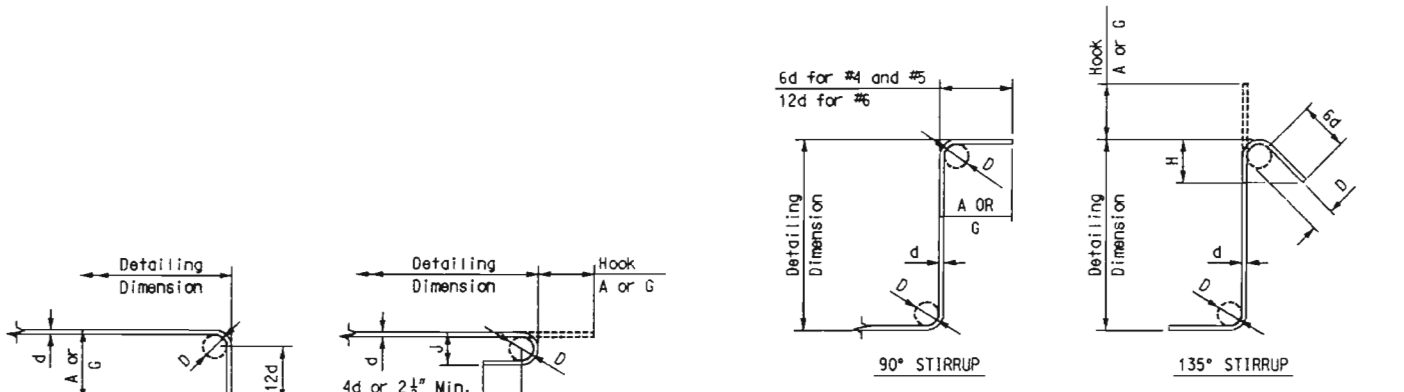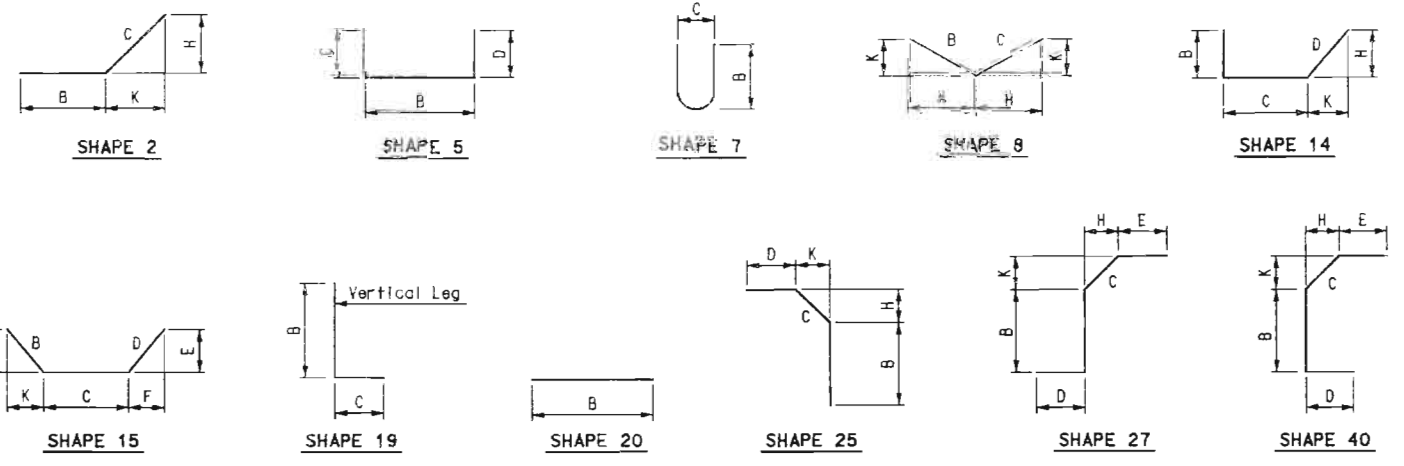

END HOOK DIMENSIONS				
BAR SIZE	D (IN.)	ALL GRADES		
		180° HOOKS		90° HOOKS
		HOOK A OR G	J	HOOK A OR G
#3	2 1/4"	5"	3"	6"
#4	3"	6"	4"	8"
#5	3 3/4"	7"	5"	10"
#6	4 1/2"	8"	6"	12"
#7	5 1/4"	10"	7"	14"
#8	6"	11"	8"	16"
#9	9 3/8"	15"	11 3/8"	19"
#10	10 3/4"	17"	13 3/4"	22"
#11	12"	19"	14 3/4"	2'-0"
#14	18 1/4"	2'-3"	21 3/4"	2'-7"

STIRRUP HOOK DIMENSIONS			
GRADES 40 - 50 - 60 KSI			
BAR SIZE	D (IN.)	90° HOOK	135° HOOK
		HOOK A OR G	HOOK A OR G APPROX. H
#4	2"	4 1/2"	3"
#5	2 1/2"	6"	3 3/4"
#6	4 1/2"	12"	4 1/2"

Note: Unless otherwise noted, diameter "D" is the same for all bends and hooks on a bar.

Notes:  
 All standard hooks and bends other than 180 degree are to be bent with the same procedure as for 90 degree standard hooks.  
 Hooks and bends shall be in accordance with the procedures as shown on this sheet.  
 E = Epoxy coated reinforcement.  
 S = Stirrup.  
 X = Bar is included in substructure quantities.  
 V = Bar dimensions vary in equal increments between dimensions shown on this line and the following line.  
 No. = Number of bars of each length.  
 Nominal lengths are based on out to out dimensions shown in bending diagrams and are listed for fabricators use. (Nearest inch)  
 Actual lengths are measured along centerline bar to the nearest inch.  
 Payweights are based on actual lengths.  
 Reinforcing Steel (Grade 60) fy = 60,000 psi.












# MISSOURI HIGHWAY AND TRANSPORTATION COMMISSION

(UIP) (75'-0", 17 @ 90'-0", 75'-0") Continuous Composite Wide Flange Beam Spans  
No Skew

State	Proj. No.	Sheet No.
MD	FAS-5935(2) ✓	B1
SEC. 17/18/19	TWP. 36N	RGE. 21W

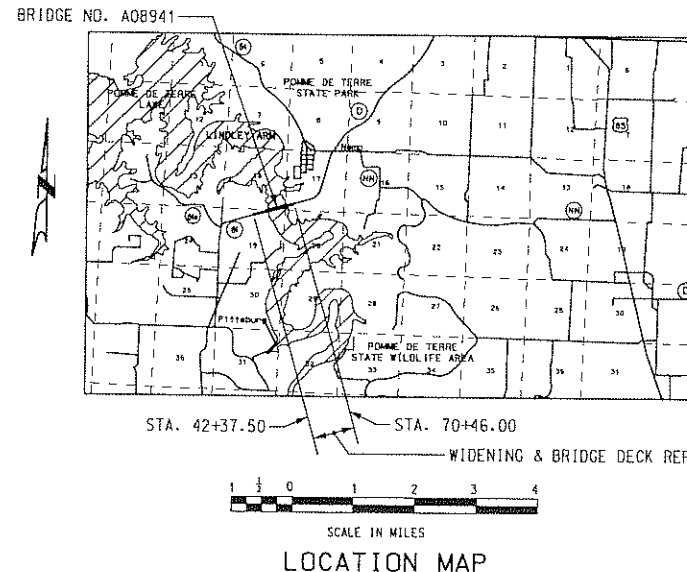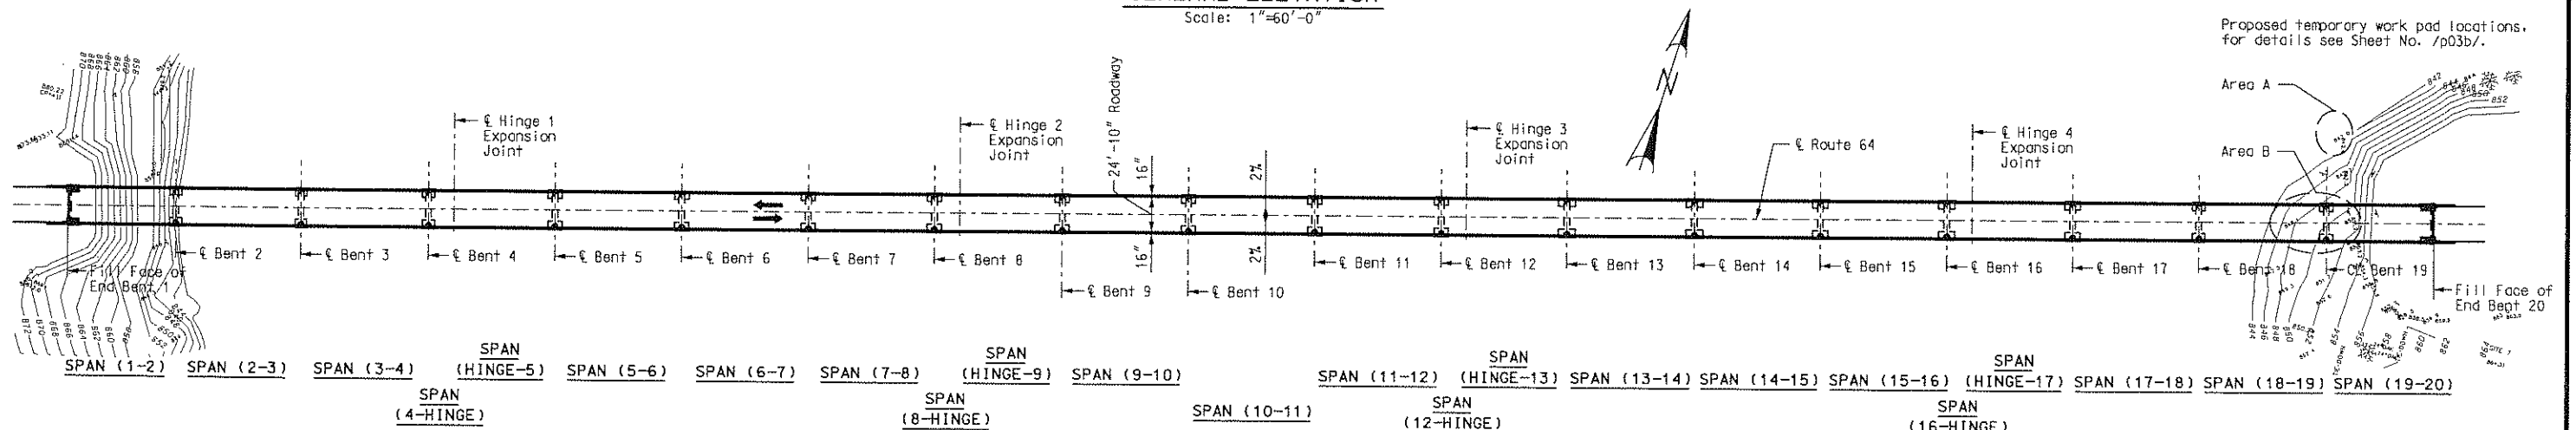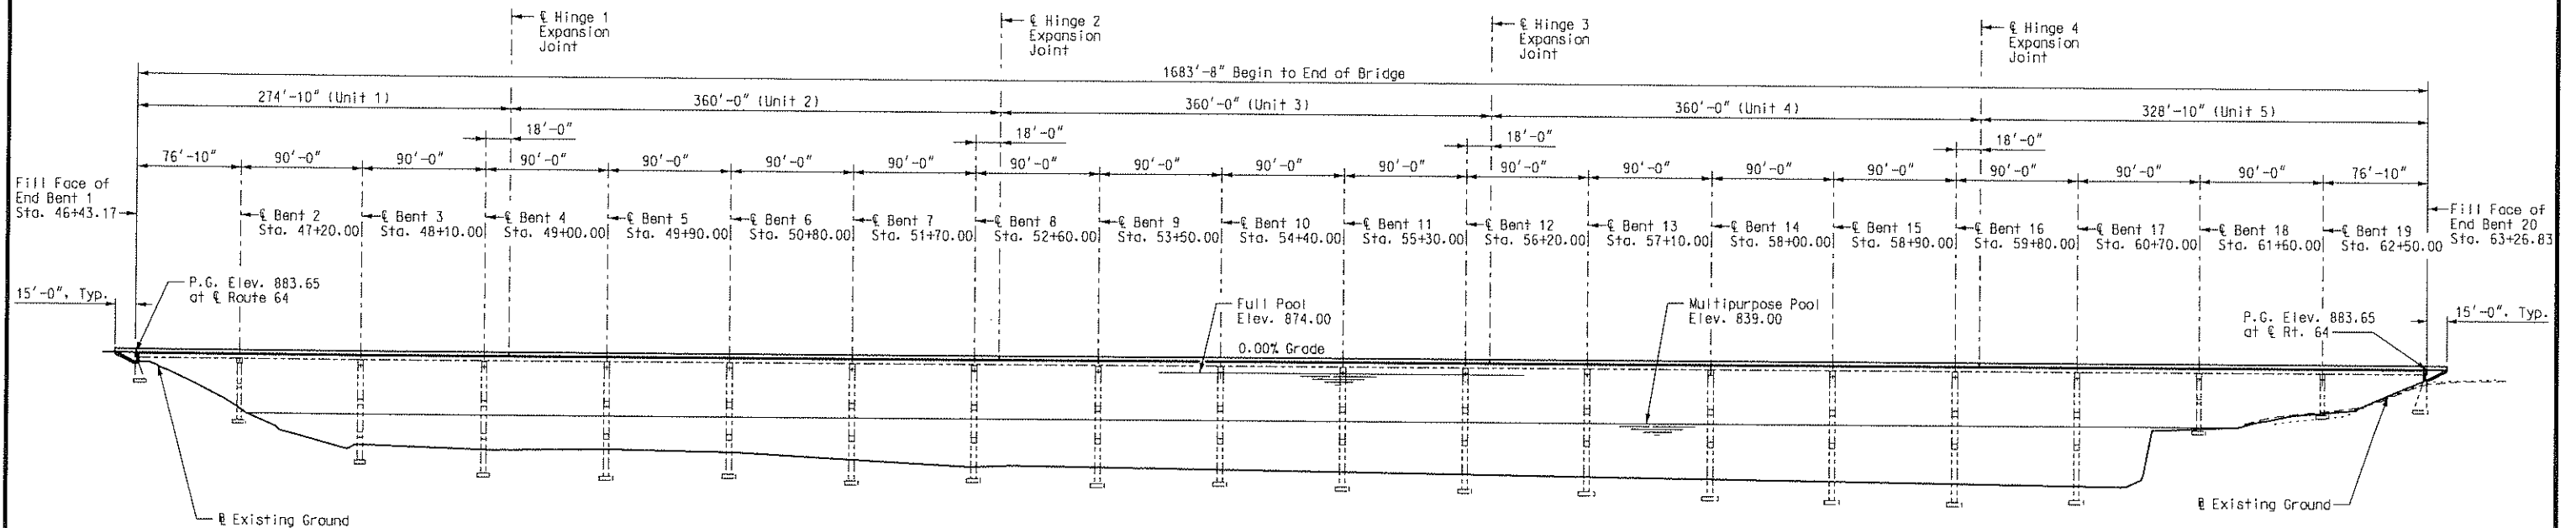

**BENCHMARKS**

Set in concrete barrier wall on the East End and North Side of the Bridge over Pomme de Terre Lake, Lindley Branch.  
Elev. 886.230

Set in concrete barrier wall West End and South side of the Bridge over Pomme de Terre Lake, Lindley Branch.  
Elev. 886.200

**FINAL PLANS**

I CERTIFY THAT THIS PLAN SHEET ACCURATELY DEPICTS THE CONFIGURATION AND LOCATION OF THE ROADWAY AND ALL ITS APPURTENANT FEATURES, TO THE BEST OF MY KNOWLEDGE, AS I AND MY STAFF HAVE OBSERVED THE CONTRACTOR'S CONSTRUCTION OF THIS PROJECT. I SPECIFICALLY DISCLAIM ANY RESPONSIBILITY FOR THE DESIGN OF THIS PROJECT, EXCEPT AS I AND MY STAFF MAY HAVE MODIFIED OR AUTHORIZED THE MODIFICATION OF THE PROJECT'S DESIGN DURING ITS CONSTRUCTION; AND I DISCLAIM RESPONSIBILITY FOR THE CONTRACTOR'S ACTUAL CONSTRUCTION OF THE PROJECT, EXCEPT AS I AND MY STAFF MAY HAVE DIRECTED OR ORDERED THAT THE PROJECT BE CONSTRUCTED.

**WIDENING OF:**  
**BRIDGE OVER POMME DE TERRE LAKE**  
 STATE ROAD FROM RTE. NN S.W. TO RTE. 64B  
 1.5 MILES SOUTHWEST OF ROUTE NN  
 PROJECT NO. STA. 46+43.17  
 JOB NO. J8S0654 RTE. 64  
**HICKORY COUNTY**

STD. 706.35
STD. 609.00
<b>A08941</b>

Compiled by Regis Belisle  
Checked by Dallas Russell

Note: This drawing is not to scale. Follow Dimensions.

SIGNATURE \_\_\_\_\_ DATE \_\_\_\_\_  
Sheet No. 1 of 35

**GENERAL NOTES:**

**DESIGN SPECIFICATIONS:**  
 2002 AASHTO 17th Edition  
 Load Factor Design  
 Seismic Performance Category A.

**DESIGN LOADINGS:**  
 HS15-44: Stringers and Substructure  
 HS20-44: Deck  
 Earth 120#/Cu. Ft. Equivalent Fluid Pressure = 45#/Cu. Ft.  
 Fatigue Stress Cycles - Case II.  
 Superstructure: Continuous composite for live load.

**DESIGN UNIT STRESSES:**  
 Class B-1 Concrete (Substructure) f'c = 4,000 psi.  
 Class B-1 Concrete (Closure Pour & Barrier Curb) f'c = 4,000 psi.  
 Silica Fume concrete f'c = 4,000 psi.  
 Precast Slab Panel grout f'c = 2,500 psi (prior to opening to traffic)  
 Reinforcing Steel Grade 60 Fy = 60,000 psi.  
 Structural Carbon Steel (ASTM A709 Grade 36) Fy = 36,000 psi.  
 Post-Tensioning Bars (Grade 150) Fy = 150 ksi.

**FABRICATED STEEL CONNECTIONS:**  
 Field connections, high strength bolts 7/8" Dia., holes 1 1/8" Dia., except as noted.  
 High strength bolts, nuts and washers will be sampled for quality assurance as specified in Standard Specification 106 and Field Section (FS-712) from Materials Manual.

**STRUCTURAL STEEL:**  
 Fabricated structural carbon steel shall be ASTM A709, Grade 36, except as noted.

**WELDING:**  
 For welded connections, use minimum weld sizes as per Missouri Standard Specifications for Highway Construction, unless shown otherwise.

**WIDEN, EXTENSION, AND REPAIR:**  
 Outline of old work is indicated by dashed lines. Heavy lines indicate new work.  
 Dimensions contained in these plans are based on the "As Built Plans". Contractor shall verify all dimensions in field before ordering new steel.  
 Bars bonded in old concrete not removed shall be cleanly stripped and embedded into new concrete where possible. If length is available, old bars shall extend into new concrete at least 40 diameters for smooth bars and 30 diameters for deformed bars, unless otherwise noted.  
 The contractor shall use one of the resin anchor systems listed in the general special provisions. These anchor systems shall be installed according to the manufacturer's specifications, except as modified by the general special provisions.  
 Cost of furnishing and installing the anchor system complete in place shall be included in the price bid for Class B-1 Concrete (Substr).

The resin anchor systems shall have a minimum ultimate pullout strength as specified below, in concrete with f'c = 4,000 psi. See Special Provisions.

DIAMETER	BAR SIZE	EMBEDDED LENGTH (in new concrete)	PULLOUT (lbs.)
5/8"	#4, #5	18"	15,500
3/4"	#6	24"	20,400

**REINFORCING STEEL:**  
 Minimum clearance to the reinforcing steel shall be 1 1/2", unless otherwise shown.

**JOINT FILLER:**  
 All joint filler shall meet the requirements of Section 1057.2.4 of the Missouri Standard Specifications, except as noted.

**PROTECTIVE COATING:**  
 System G by the contractor (See Special Provisions).

**FIELD COAT (EXISTING STEEL):**  
 All exposed and accessible surfaces of the existing structural steel shall be cleaned and coated with System G prime coat in accordance with Section 712 and the Special Provisions. Tint of the prime coat for System G shall be similar to the color of the field coat to be used.  
 Field Coat: The color of the finish coat shall be Gray (Federal Standard #26373). The cost of the intermediate coat shall be included in the contract unit price per sq. foot of intermediate Field Coat (System G) Gray. The cost of the finish coat shall be included in the contract unit price per sq. foot of Finish Field Coat (System G) Gray. (See Special Provisions.)  
 The Contractor is responsible for the containment and disposal of any materials resulting from the surface preparation and recoating of the existing steel stringers (including top flanges), diaphragms, and other miscellaneous appurtenances. See Special Provisions.

**BEARINGS:**  
 Bearings at end bents require cleaning, lubricating and coating, see Special Provisions.

**NON-DESTRUCTIVE TESTING:**  
 Welds at existing cover plates and existing stringer post-tension anchor plates require non-destructive testing, see Special Provisions.

**PRECAST SLAB PANELS:**  
 Concrete for precast slab panels shall be Class B1 with f'c = 5,000 psi, f'ci = 5,000 psi.

All reinforcement shall be epoxy coated.  
 The top surface of all panels shall receive a scored finish with a depth of scoring of 1/8" perpendicular to the CL of Route 64 (see Special Provisions).  
 Suitable anchorage devices for lifting may be cast in panels, provided they are shown on the shop drawings and approved by the engineer.  
 Panels shall be set on joint filler in accordance with Section 1057.2.5 of Mo. Std. Spec. or polystyrene bedding material.

**POST-TENSIONING BARS:**  
 All bars shall conform to the requirements of ASTM A722 Grade 150. Anchorage systems and blockout details shall be determined by the post-tensioning system used. The contractor shall adjust dimensions and reinforcing as required.  
 Maximum jacking stress = 0.75 f's  
 Maximum stress after seating = 0.70 f's  
 P.T., where noted in plans, denotes Post-Tensioned.

**TEMPORARY BRIDGE:**  
 To accommodate openings in deck at closure pour locations and joint between precast slab panels and existing deck, steel plates (or other approved device) shall be used.  
 Prior to removal of any portion of the deck or end bent backwalls, shop drawings and calculations indicating size and thickness of plates shall be submitted to the Engineer for approval. See Special Provisions.

**SILICA FUME CONCRETE WEARING SURFACE:**  
 In order to maintain grade and a minimum thickness of wearing surface as shown on plans it may be necessary to use additional quantities of wearing surface at various locations throughout the structure. No payment will be allowed for additional labor, materials or equipment for variations in thickness of wearing surface.

**FINAL QUANTITIES**

ITEM	SUBSTR.	SUPERSTR.	TOTAL
Removal of Existing Bridge Deck	Sq. Ft.	-	41,406
Partial Removal of Substructure Concrete	Lump Sum	1	1
Class 1 Excavation	Cu. Yds.	70	70
* Temporary Shoring	Lump sum	-	1
Bridge Approach Slab (Bridge)	Sq. Yds.	-	153
* Rock Fill (Special)	Cu. Yds.	-	279
Substructure Repair (Formed)	Sq. Ft.	0	0
Substructure Repair (Unformed)	Sq. Ft.	19	19
Protective Coating - Concrete Bents (Deleterious Agents)	Lump sum	1	1
Class B-1 Concrete (Substr)	Cu. Yds.	25.4	25.4
Class B-1 Concrete (Closure Pour & Barrier Curb)	Cu. Yds.	-	43.6
Precast Concrete Slab Panels (with intergal Barrier Curbs)	Sq. Yds.	-	4,999
Silica Fume Concrete Wearing Surface	Sq. Yds.	-	4,614
Strip Seal Expansion Device	Lin. Ft.	-	56
Post-Tension System	Lump Sum	-	1
Reinforcing Steel (Bridges)	Lbs.	3,180	3,180
Mechanical Bar Splice	Each	56	584
Reinforcing Steel (Epoxy Coated)	Lbs.	2,100	12,980
Expansion Device (Finger Plate)	Lin. Ft.	-	100
Fabricated Structural Carbon Steel (Misc.)	Pound	-	190
Cleaning, Lubricating and Coating Bearing	Each	-	8
Slab Drain	Each	-	292
Surface Preparation for Recoating Structural Steel	Sq. Ft.	-	75,000
Field Application of Inorganic Zinc Primer	Sq. Ft.	-	75,000
Intermediate Field Coat (System G) Gray	Sq. Ft.	-	68,300
Finish Field Coat (System G) Gray	Sq. Ft.	-	19,400
Transporting Lead Contaminated Residue to Storage Area	Lump Sum	-	1
Transporting Lead Contaminated Residue to the Smelter	Lump Sum	-	1
Disposal of Lead Contaminated Residue	Lump Sum	-	1
Non-Destructive Testing	Lin. Ft.	-	420
Hanger Retrofit at Hinges	Each	-	16
Rivet Replacement at Field Splices	Each	-	0
Removal of Existing Shear Connectors	Lump Sum	-	1
Installation of Shear Connectors	Each	-	11,868

**Notes:**  
 The quantities for "Surface Preparation for Recoating Structural Steel" and "Field Application of Inorganic Zinc Primer" include the entire length of all Stringers.  
 The intermediate field coat shall be applied to the surfaces of all structural steel except those surfaces to be in contact with concrete shall not receive the intermediate coat. The intermediate coat shall also be applied to the end bent bearings.  
 The finish field coat shall include the exterior stringers. The limits of the exterior stringers shall include the bottom of the top exterior flanges, the top of the bottom exterior flanges, the exterior web area, the exterior face of the top and bottom flanges, and the bottom of the bottom flange. Areas of steel to be in contact with concrete shall not receive the finish coat.  
 The surfaces of all structural steel located under expansion joints shall be field coated with intermediate and finish coats for a distance of 10 feet from the center line of the joint. Within this limit, the items to be field coated shall include all surfaces of stringers, bearings, diaphragms, stiffeners and miscellaneous structural steel items. Areas of steel to be in contact with concrete shall not receive the field coats.  
 The limits of the field coatings shall be masked to provide crisp, straight lines and to prevent overspray on adjacent areas.  
 \* The quantities for "Rock Fill (Special)" and "Temporary Shoring" are based on Contractors work area as shown in the plans. If Contractor does not use workpad as shown in plans, then these items shall be underrun as determined by the Engineer. See Special Provisions.  
 The lump sum quantity for "Protective Coating - Concrete Bents (Deleterious Agents)" includes End Bent 1 and End Bent 20, to the limits shown.

**FINAL PLANS**

I CERTIFY THAT THIS PLAN SHEET ACCURATELY DEPICTS THE CONFIGURATION AND LOCATION OF THE ROADWAY AND ALL ITS APPURTENANT FEATURES, TO THE BEST OF MY KNOWLEDGE, AS I AND MY STAFF HAVE OBSERVED THE CONTRACTOR'S CONSTRUCTION OF THIS PROJECT. I SPECIFICALLY DISCLAIM ANY RESPONSIBILITY FOR THE DESIGN OF THIS PROJECT, EXCEPT AS I AND MY STAFF MAY HAVE MODIFIED OR AUTHORIZED THE MODIFICATION OF THE PROJECT DESIGN DURING ITS CONSTRUCTION; AND I DISCLAIM RESPONSIBILITY FOR THE CONTRACTOR'S ACTUAL CONSTRUCTION OF THE PROJECT, EXCEPT AS I AND MY STAFF MAY HAVE DIRECTED OR ORDERED THAT THE PROJECT BE CONSTRUCTED.


SIGNATURE \_\_\_\_\_ DATE \_\_\_\_\_

GENERAL NOTES AND FINAL QUANTITIES

HICKORY

COUNTY

A08941

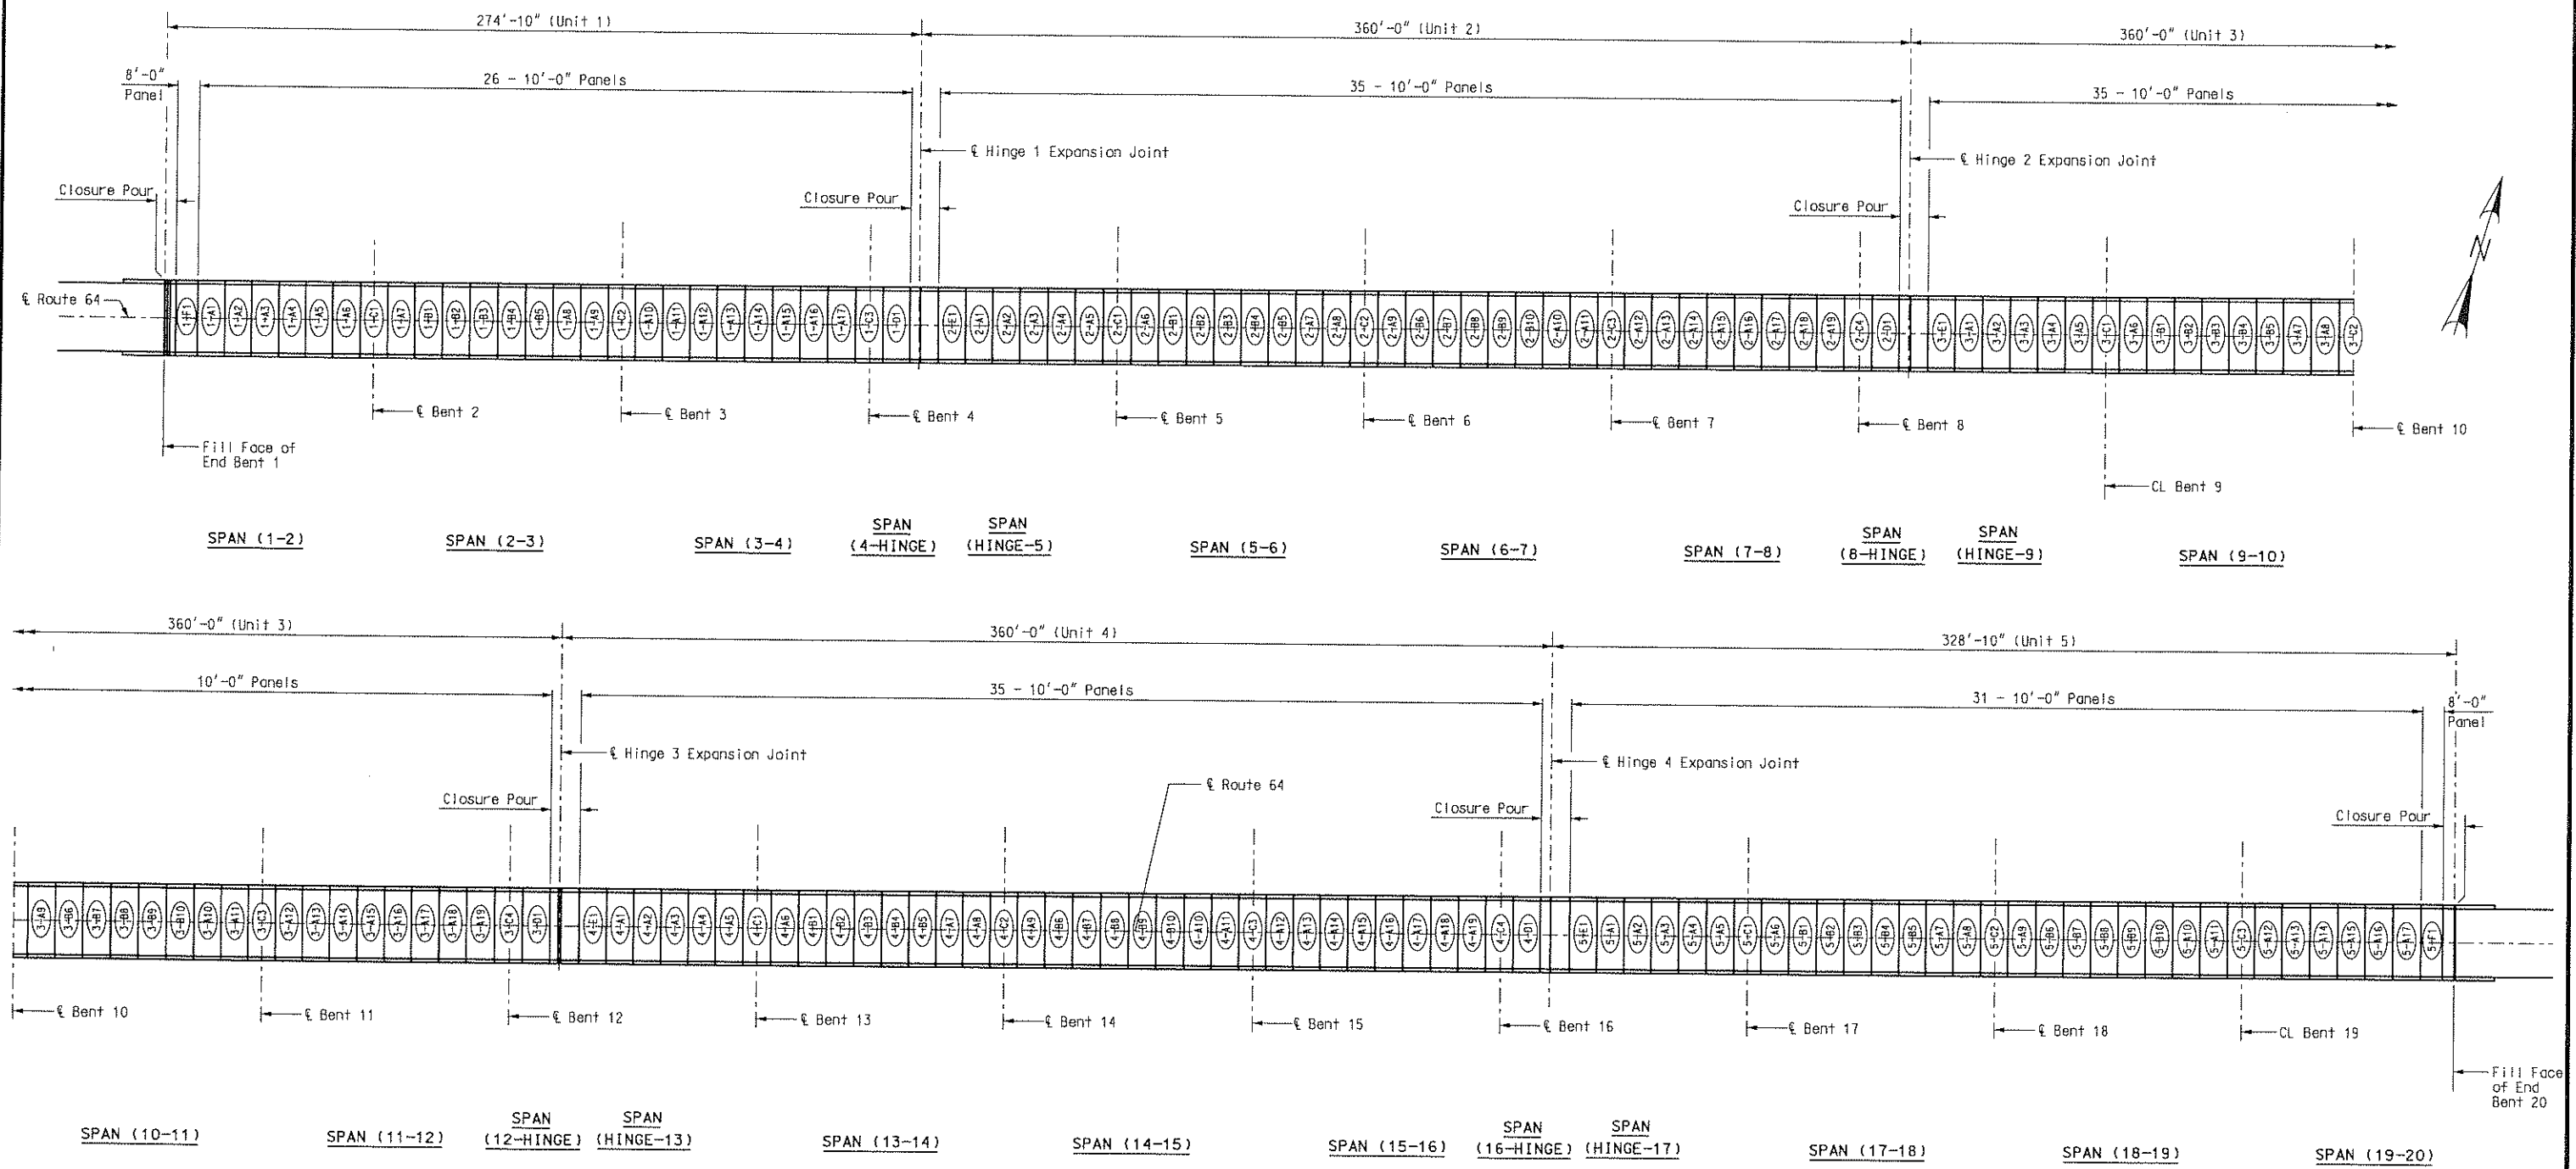


**PLAN OF CONSTRUCTION**

Scale: 1"=30'-0"

**PROPOSED OVERALL CONSTRUCTION SEQUENCE**

1. Construct End Bent Modifications to backwalls as detailed, using temporary steel plate across backwall and expansion joint.
2. Place panels in Span (1-2) (See Plan of Construction).
3. Set strip seal joint at End Bent 1 and cast closure pour.
4. Place panels in Span (2-3).
5. Place panels for Spans (3-4), (4-Hinge), and (Hinge-5).
6. Install hanger retrofit at hinge. Set finger joint in Span (4-5) and cast closure pour.
7. Place panels for Spans (5-6) thru (8-9).
8. Repeat step 6 for Span (8-Hinge) and (Hinge-9).
9. Repeat steps 7 & 8 for Units 3 and 4.
10. Place panels in Span (16-Hinge) and (Hinge-17).
11. Repeat step 6 for Span (16-Hinge) and (Hinge-17).
12. Place panels for Spans (17-18) and (18-19).
13. Place panels for Span (19-20).
14. Set strip seal joint at End Bent 20 and cast closure pour.
15. Place wearing surface on bridge deck.
16. Construct approach slab, wingwalls and barrier at End Bents 1 and 20. Utilize staged construction to coordinate with placement of wearing surface.

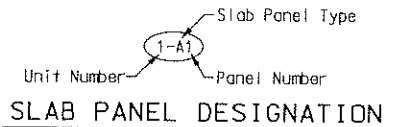

**FINAL PLANS**

I CERTIFY THAT THIS PLAN SHEET ACCURATELY DEPICTS THE CONFIGURATION AND LOCATION OF THE ROADWAY AND ALL ITS APPURTENANT FEATURES, TO THE BEST OF MY KNOWLEDGE, AS I AND MY STAFF HAVE OBSERVED THE CONTRACTOR'S CONSTRUCTION OF THIS PROJECT. I SPECIFICALLY DISCLAIM ANY RESPONSIBILITY FOR THE DESIGN OF THIS PROJECT, EXCEPT AS I AND MY STAFF MAY HAVE MODIFIED OR AUTHORIZED THE MODIFICATION OF THE PROJECT DESIGN DURING ITS CONSTRUCTION; AND I DISCLAIM RESPONSIBILITY FOR THE CONTRACTOR'S ACTUAL CONSTRUCTION OF THE PROJECT, EXCEPT AS I AND MY STAFF MAY HAVE DIRECTED OR ORDERED THAT THE PROJECT BE CONSTRUCTED.



SIGNATURE \_\_\_\_\_ DATE \_\_\_\_\_

**PROPOSED OVERALL CONSTRUCTION SEQUENCE**


HICKORY COUNTY A08941

**PROPOSED NIGHTLY CONSTRUCTION SEQUENCE**


1. Close entire bridge at 7 p.m.
2. Remove guardrail, curb, and slab (except directly over stringers). (Remove only deck area that will be replaced that night.)

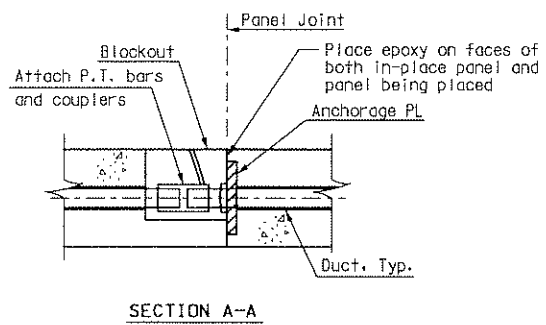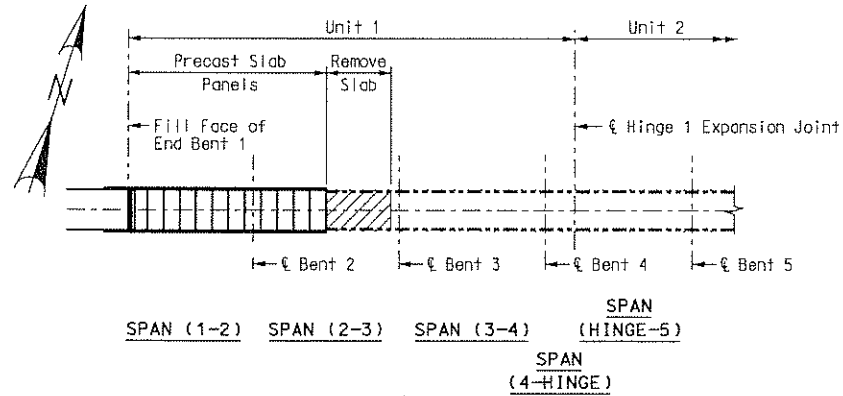


7. Apply epoxy on match cast faces of both in-place panel and panel being placed.
8. Move panel being placed into final position and begin stressing P.T. bars. P.T. bars shall be stressed in pairs symmetric about center line of bridge.
9. Repeat steps 5-8 for each slab panel placed.
10. After all P.T. bars are fully stressed, install new shear connectors to stringer top flanges.

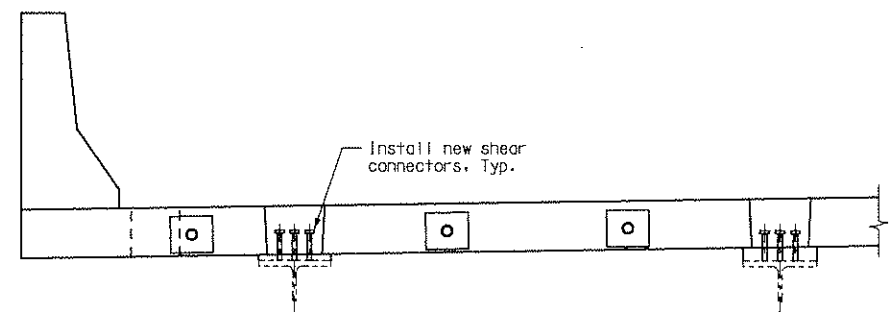


3. Using approved equipment, remove slab directly over top flange of stringers. (See Special Provisions)
4. Remove existing shear connectors and clean and prime coat top flange of stringers.

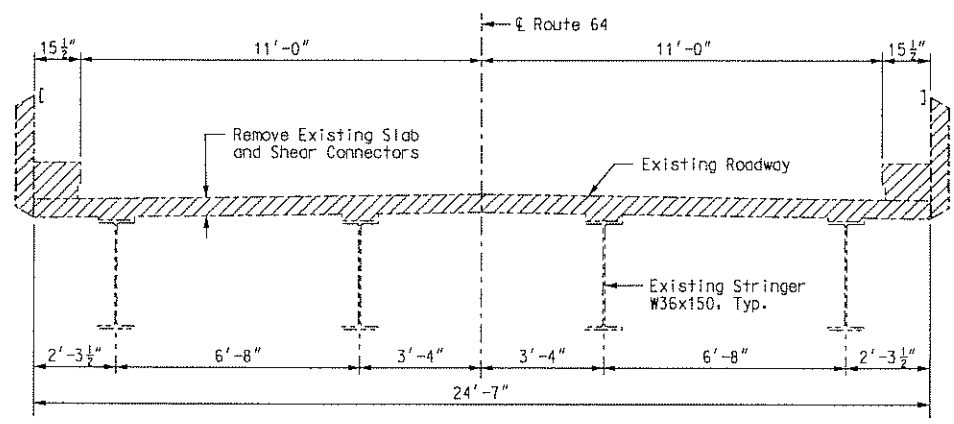


11. Begin pumping high-early strength concrete grout into shear connector and "bearing" pockets. Ensure that concrete grout flows between shear connector pockets thru the "bearing" pocket (between the top flange and bottom of panel). After the "bearing" pocket has been filled, finish placing the concrete grout in shear connector pocket, move to next shear connector pocket, and repeat procedure. Place concrete grout in blockouts for P.T. bar couplers.

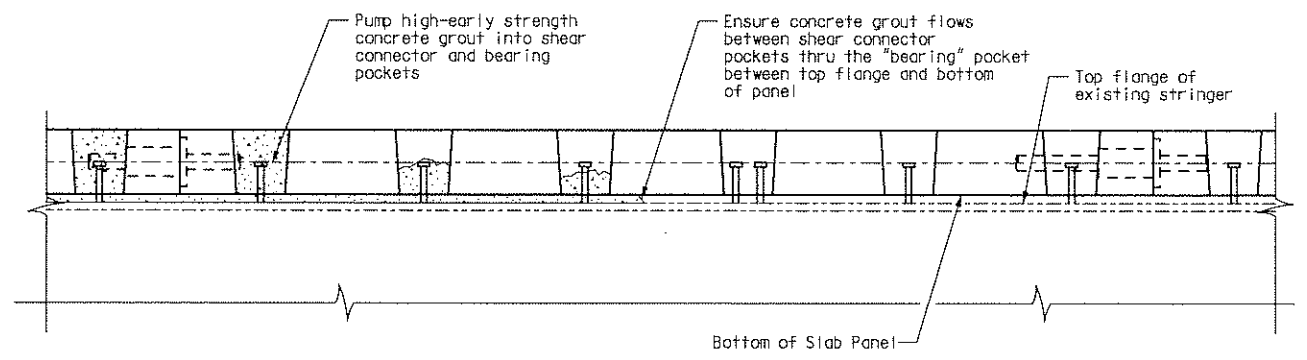

5. Place joint filler material on edges of top flange and then place full-width precast slab panel on stringers. Level and align slab panel as required. (See Special Provisions)
6. Attach P.T. bars and couplers.

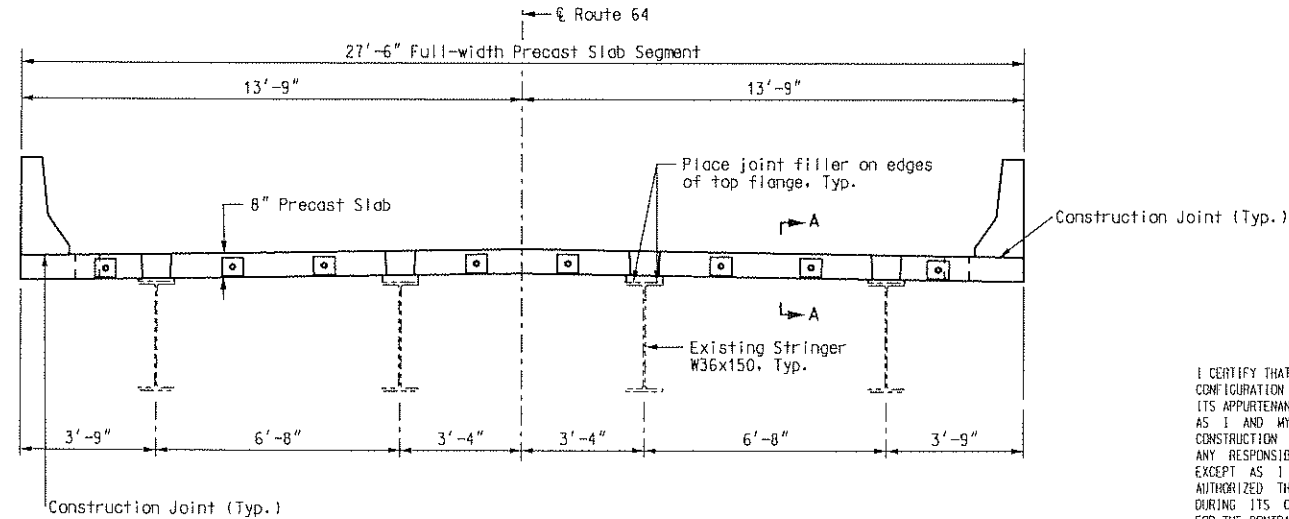

12. Place Temporary Bridge over gap between slab panel and existing bridge deck. Positively attach Temporary Bridge to existing bridge to prevent movement. (See Temporary Bridge Special Provisions)

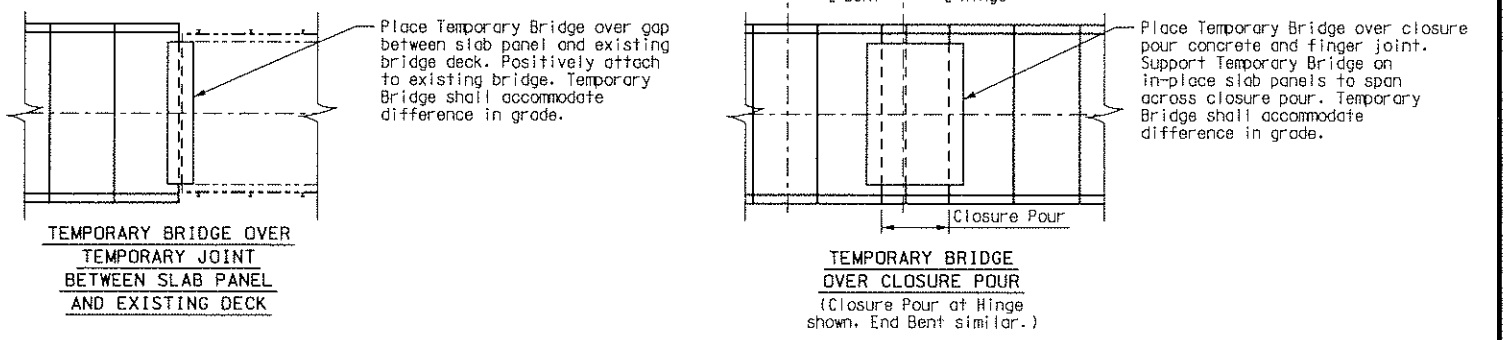


13. Put traffic control devices in place between existing curb and new safety barrier curb.
14. Open entire bridge at 7 a.m.
15. Grout PT Bars upon completion of each span.


**FINAL PLANS**  
 I CERTIFY THAT THIS PLAN SHEET ACCURATELY DEPICTS THE CONFIGURATION AND LOCATION OF THE ROADWAY AND ALL ITS APPURTENANT FEATURES, TO THE BEST OF MY KNOWLEDGE, AS I AND MY STAFF HAVE OBSERVED THE CONTRACTOR'S CONSTRUCTION OF THIS PROJECT. I SPECIFICALLY DISCLAIM ANY RESPONSIBILITY FOR THE DESIGN OF THIS PROJECT, EXCEPT AS I AND MY STAFF MAY HAVE MODIFIED OR AUTHORIZED THE MODIFICATION OF THE PROJECT DESIGN DURING ITS CONSTRUCTION; AND I DISCLAIM RESPONSIBILITY FOR THE CONTRACTOR'S ACTUAL CONSTRUCTION OF THE PROJECT, EXCEPT AS I AND MY STAFF MAY HAVE DIRECTED OR ORDERED THAT THE PROJECT BE CONSTRUCTED.

SIGNATURE \_\_\_\_\_ DATE \_\_\_\_\_


State	Proj. No.	Sheet No.
MO	FAS-9935(2)	B5

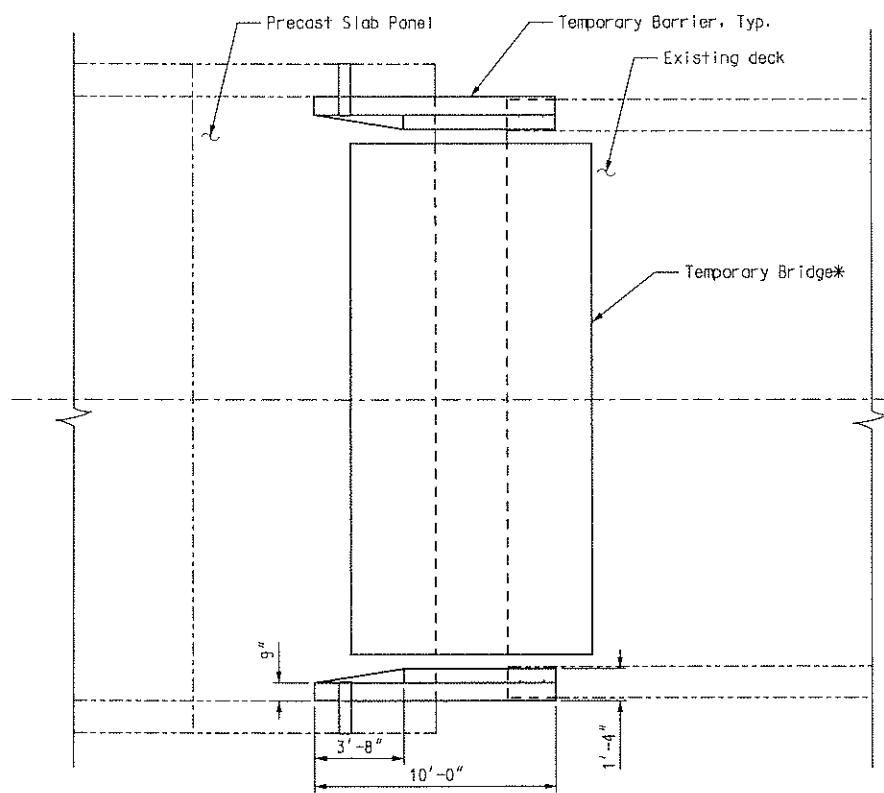

TEMPORARY BRIDGE OVER TEMPORARY JOINT BETWEEN SLAB PANEL AND EXISTING DECK

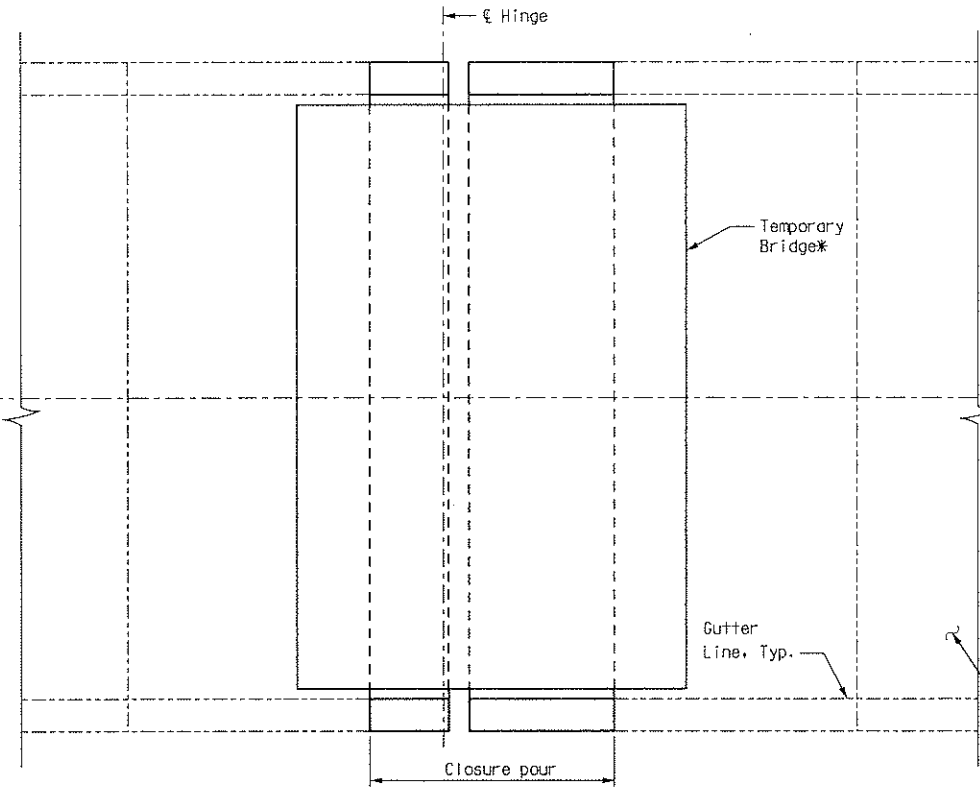

TEMPORARY BRIDGE OVER CLOSURE POUR (Closure Pour at Hinge shown, End Bent similar.)

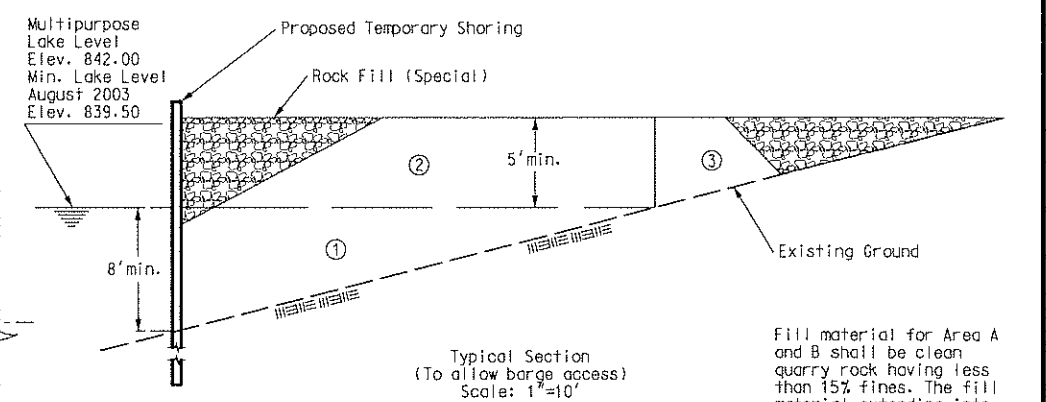

For information only:


- ① Fill below Multipurpose Lake Level=288 c.y.
- ② Fill above Multipurpose Lake Level=361 c.y.
- ③ Fill above Land=115 c.y.

Fill material for Area A and B shall be clean quarry rock having less than 15% fines. The fill material extending into the lake shall be removed after construction, and the foot print of fill material in the lake shall be restored to the original conditions.


DETAIL OF TEMPORARY WORK PAD (AREA A)

Notes:  
 Temporary Work Pad dimensions shown are for information only. Contractor shall submit for approval, design calculations and details of temporary shoring and fill. See Temporary Shoring Special Provision. Contractor shall submit for approval, details and procedures of placing and removing fill. Contractor shall submit for approval, to U.S. Army Corps of Engineers, drawings indicating limits of Temporary Work Pad (Area A).


FINAL PLANS  
 I CERTIFY THAT THIS PLAN SHEET ACCURATELY DEPICTS THE CONFIGURATION AND LOCATION OF THE ROADWAY AND ALL ITS APPURTENANT FEATURES, TO THE BEST OF MY KNOWLEDGE, AS I AND MY STAFF HAVE OBSERVED THE CONTRACTOR'S CONSTRUCTION OF THIS PROJECT. I SPECIFICALLY DISCLAIM ANY RESPONSIBILITY FOR THE DESIGN OF THIS PROJECT, EXCEPT AS I AND MY STAFF MAY HAVE MODIFIED OR AUTHORIZED THE MODIFICATION OF THE PROJECT DESIGN DURING ITS CONSTRUCTION; AND I DISCLAIM RESPONSIBILITY FOR THE CONTRACTOR'S ACTUAL CONSTRUCTION OF THE PROJECT, EXCEPT AS I AND MY STAFF MAY HAVE DIRECTED OR ORDERED THAT THE PROJECT BE CONSTRUCTED.

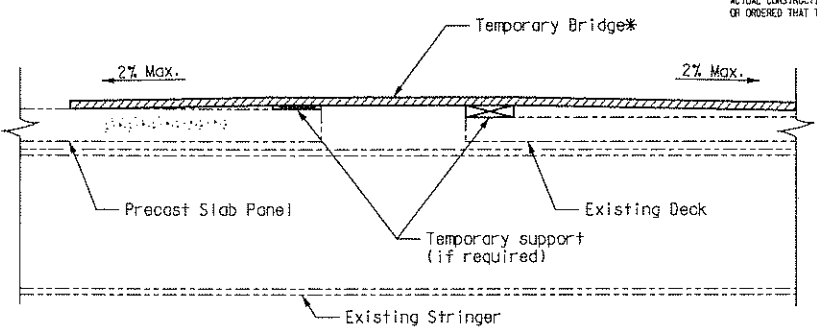

SECTION OF TEMPORARY BRIDGE AT TEMPORARY JOINT

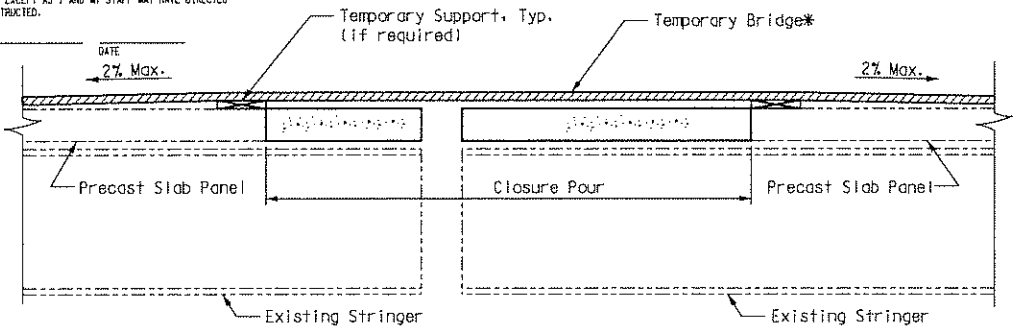


SECTION OF TEMPORARY BRIDGE AT CLOSURE POUR (Closure Pour at Hinge shown, End Bent similar.)

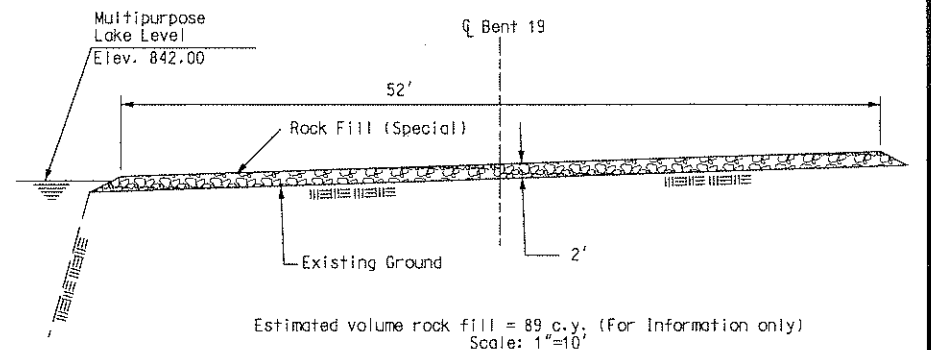

Estimated volume rock fill = 89 c.y. (For Information only)  
 Scale: 1"=10'


DETAIL OF TEMPORARY WORK PAD (AREA B)

Notes:  
 Temporary Work Pad dimensions shown are for information only. Contractor shall submit for approval, details and procedures of placing and removing fill. Contractor shall submit for approval, to U.S. Army Corps of Engineers, drawings indicating limits of Temporary Work Pad (Area B)

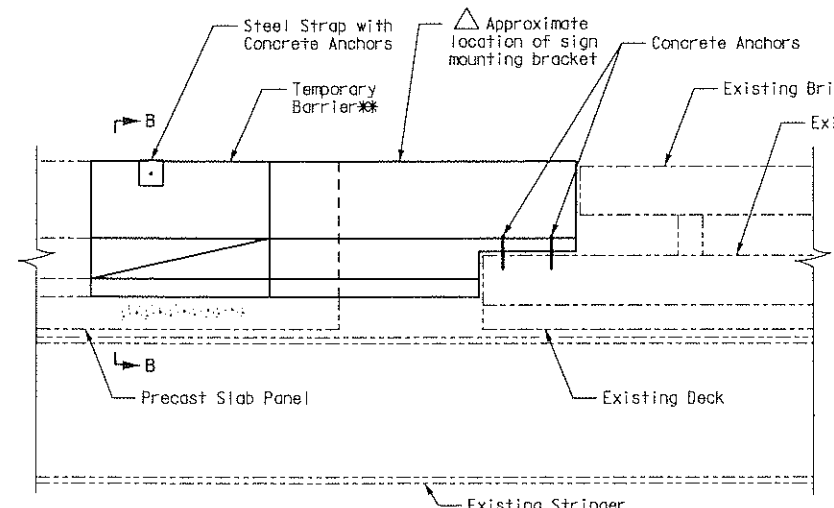


ELEVATION OF TEMPORARY BARRIER AT TEMPORARY JOINT

△ Provide mounting bracket for traffic control sign, see roadway plans for sign details.

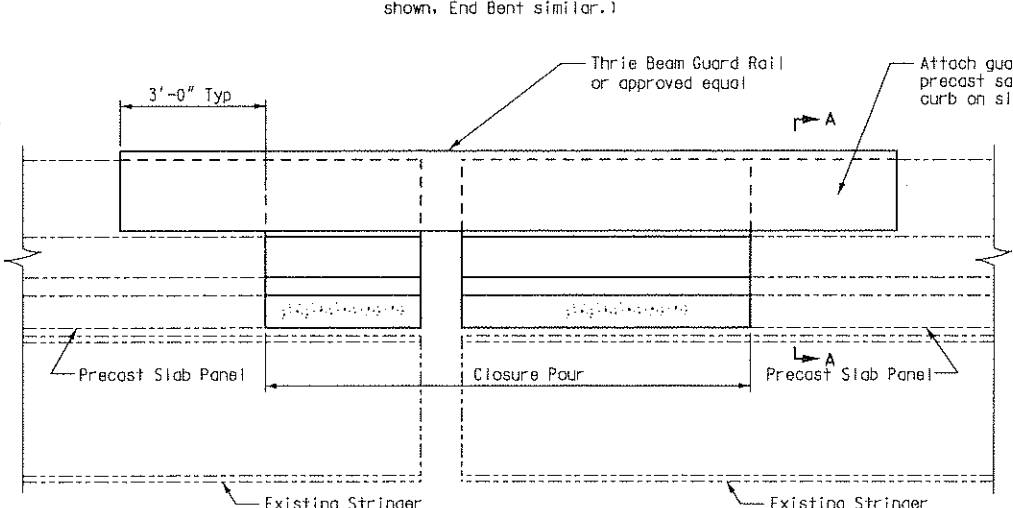

ELEVATION OF SAFETY BARRIER AT CLOSURE POUR (Closure Pour at Hinge shown, End Bent similar.)

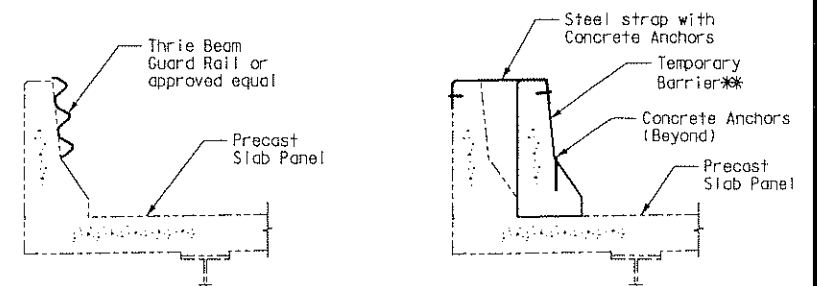


SECTION A-A


SECTION B-B

Notes:  
 \* Temporary Bridge shown is schematic only. See General Notes and Special Provisions. Payment will be considered subsidiary to other items of work.  
 \*\* Temporary Barrier shown is schematic only. See General Notes and Special Provisions for Temporary Bridge. Payment will be considered subsidiary to other items of work.  
 Thrie beam guardrail (or approved equal) at closure pour shall remain in place until the cast-in-place safety barrier curb has achieved full design strength. Contractor shall submit shop drawings for approval showing attachment of thrie beam guard rail to precast panel barrier curb, payment will be considered subsidiary to other items of work.


CONSTRUCTION DETAILS

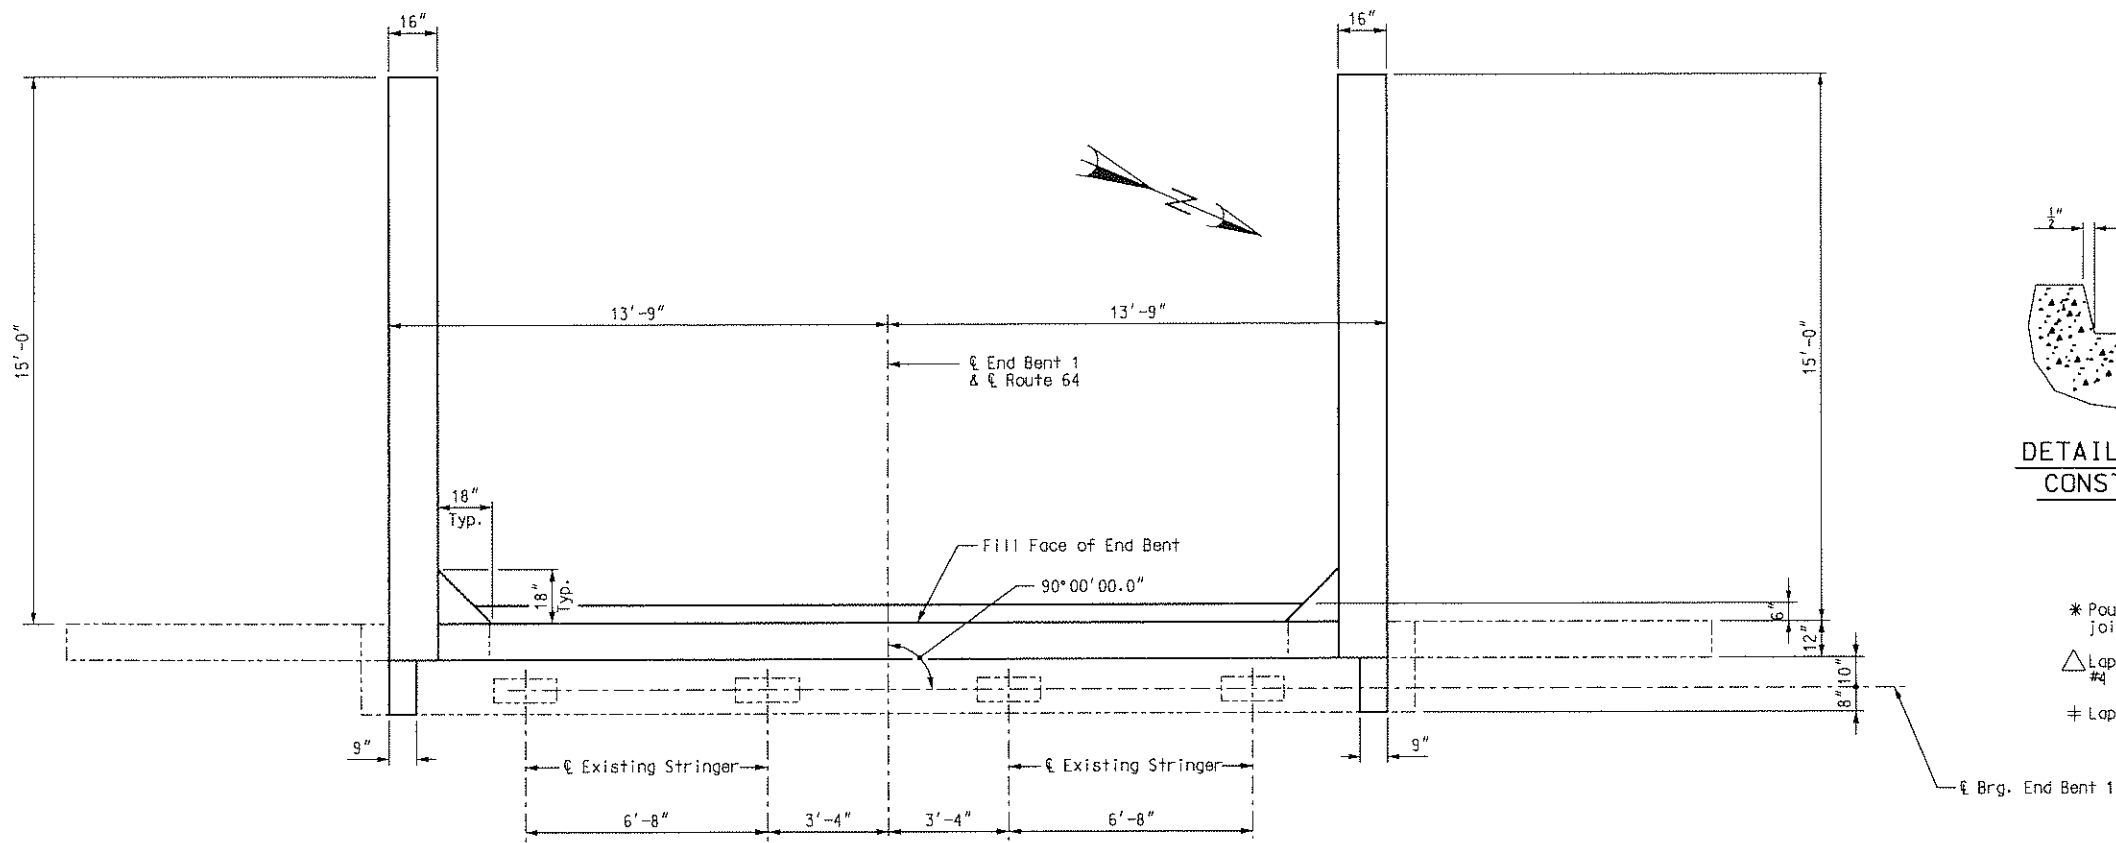

**PLAN**  
Scale: 1/8" = 1'-0"

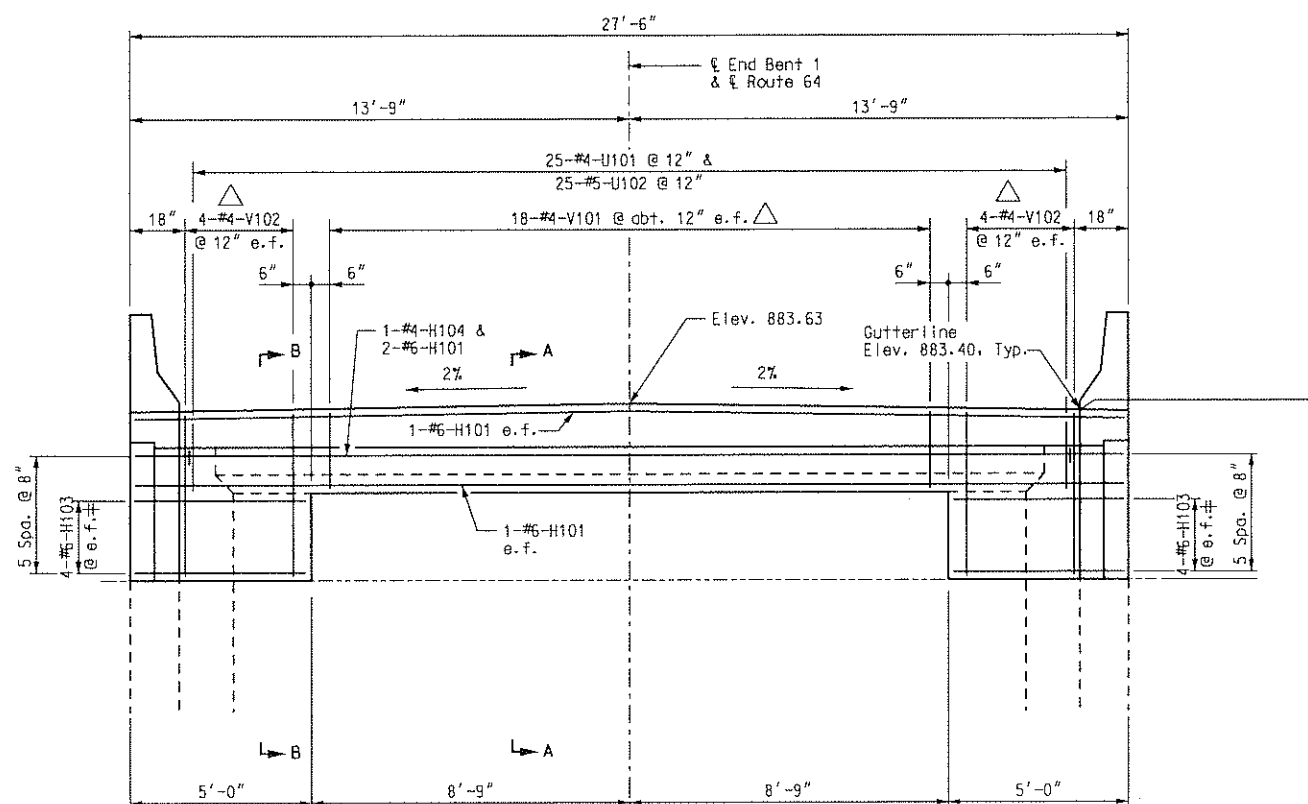


**ELEVATION**  
(Looking Backstation)  
Scale: 1/8" = 1'-0"

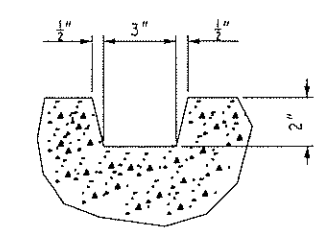


**DETAIL OF UPPER CONST. JOINT**

\* Pour concrete above upper construction joint after expansion device is placed.  
 △ Lap #4-V101 and #4-V102 with existing #4 reinforcing a minimum of 15" (30 diameters).  
 † Lap #6-H103 with existing reinforcing a minimum of 24".

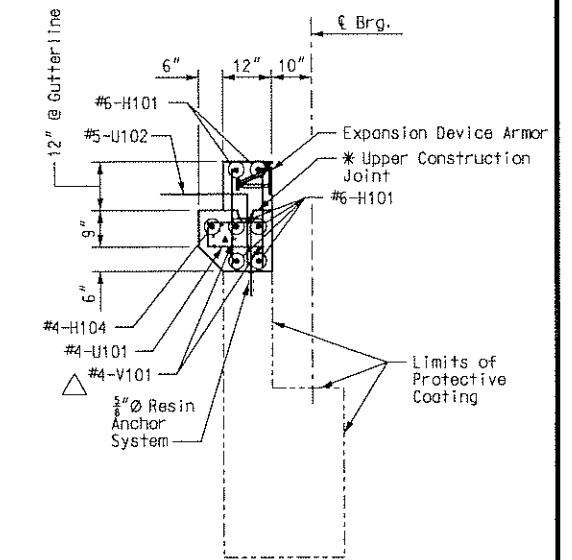

**SECTION A-A**  
Scale: 1/2" = 1'-0"

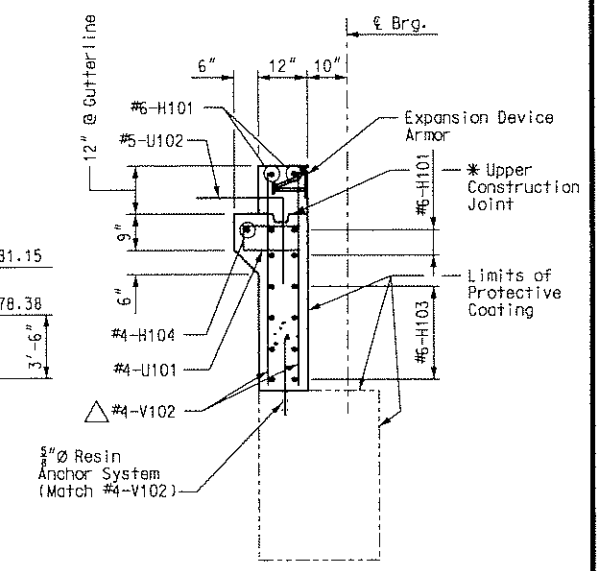

**SECTION B-B**  
Scale: 1/2" = 1'-0"

**SUBSTRUCTURE QUANTITY TABLE FOR END BENT 1**

ITEM	UNITS	QUANTITY
Class 1 Excavation	Cu. Yds.	35 ✓
Substructure Repair (Formed)	Sq. Ft.	0 ✓
Substructure Repair (Unformed)	Sq. Ft.	7 ✓
Class B-1 Concrete (Substr.)	Cu. Yds.	12.7 ✓
Reinforced Steel (Bridges)	Lbs.	1,590 ✓
Reinforcing Steel (Epoxy Coated)	Lbs.	1,080 ✓


**Notes:**  
 The Substructure Quantities are included in the Estimated Quantities table on Sheet No. /p02/.  
 Existing bearings to be cleaned, lubricated and coated, see Special Provisions.  
 For Wingwall Details, see Sheet No. /p06/.  
 For Safety Barrier Curb Details, see Sheet No. /p25/.  
 Footings are not shown for clarity.  
 Cost for furnishing and installing the resin anchor systems, complete in place, shall be included in the Class B-1 Concrete (Substr.).  
 Place resin anchor systems to clear any existing horizontal or vertical reinforcing, e.f. denotes each face.

**FINAL PLANS**  
 I CERTIFY THAT THIS PLAN SHEET ACCURATELY DEPICTS THE CONFIGURATION AND LOCATION OF THE ROADWAY AND ALL ITS APPURTENANT FEATURES, TO THE BEST OF MY KNOWLEDGE, AS I AND MY STAFF HAVE OBSERVED THE CONTRACTOR'S CONSTRUCTION OF THIS PROJECT. I SPECIFICALLY DISCLAIM ANY RESPONSIBILITY FOR THE DESIGN OF THIS PROJECT, EXCEPT AS I AND MY STAFF MAY HAVE MODIFIED OR AUTHORIZED THE MODIFICATION OF THE PROJECT DESIGN DURING ITS CONSTRUCTION; AND I DISCLAIM RESPONSIBILITY FOR THE CONTRACTOR'S ACTUAL CONSTRUCTION OF THE PROJECT, EXCEPT AS I AND MY STAFF MAY HAVE DIRECTED OR ORDERED THAT THE PROJECT BE CONSTRUCTED.


SIGNATURE \_\_\_\_\_ DATE \_\_\_\_\_

**END BENT 1 MODIFICATIONS**




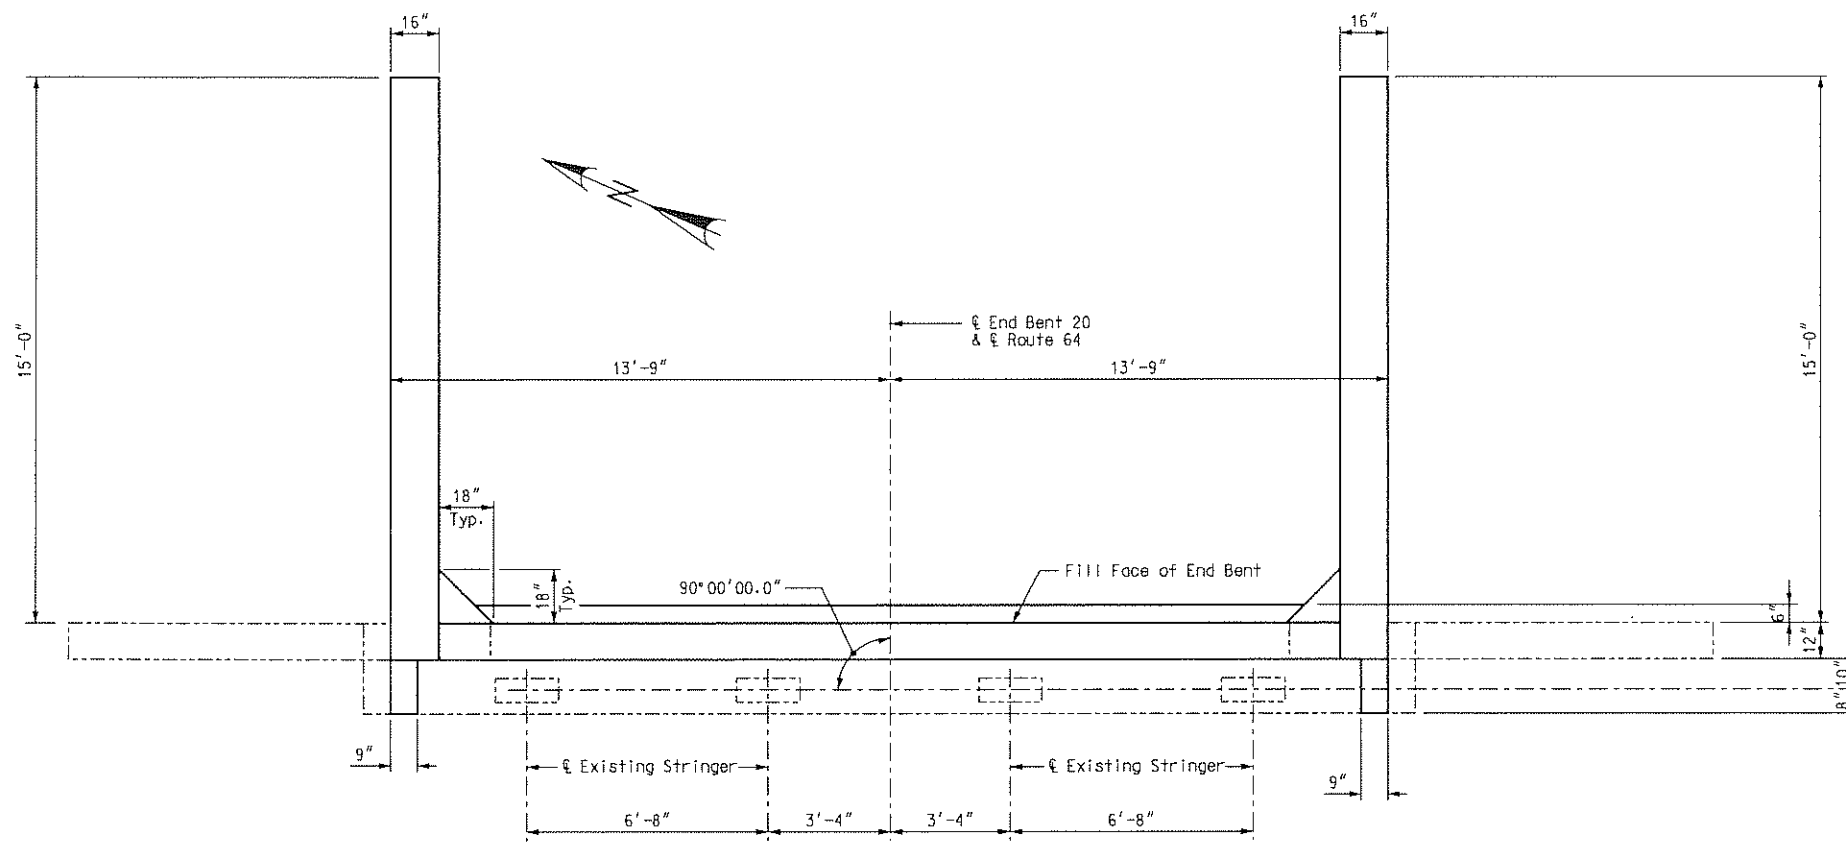

**PLAN**  
Scale: 3/8"=1'-0"

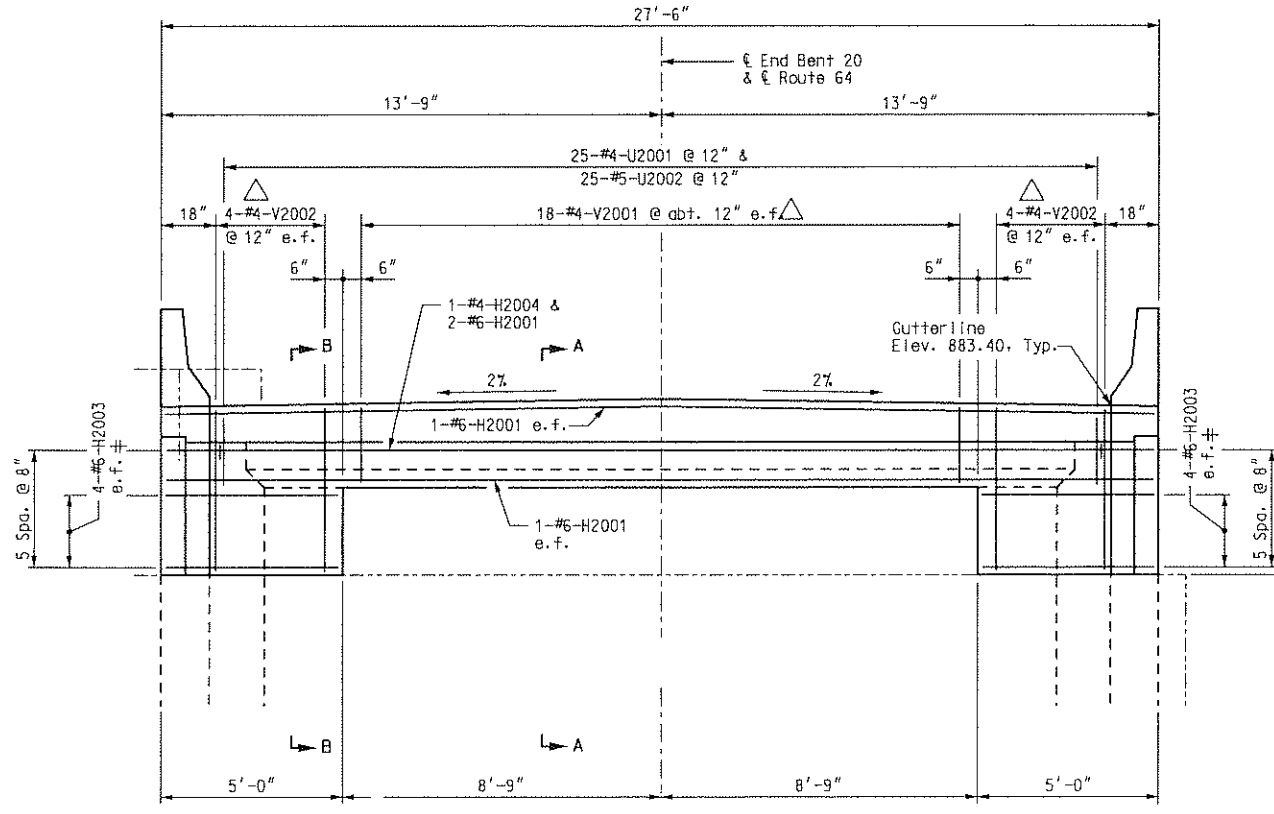


**ELEVATION**  
Scale: 3/8"=1'-0"

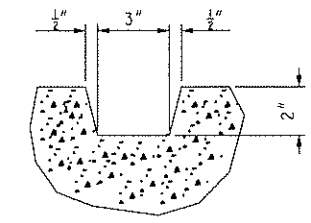


**DETAIL OF UPPER CONST. JOINT**

\* Pour concrete above upper construction joint after expansion device is placed.  
 Δ Lap #4-V2001 and #4-V2002 with existing #4 reinforcing a minimum of 15" (30 diameters).  
 ⊕ Lap #6-H2003 with existing reinforcing a minimum of 24".

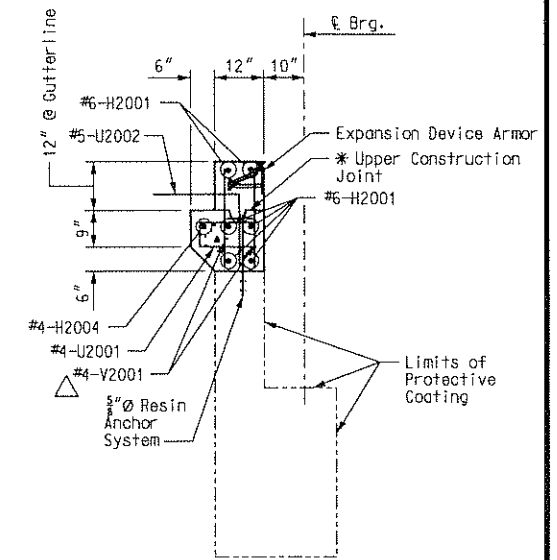

**SECTION A-A**  
Scale: 1/2"=1'-0"

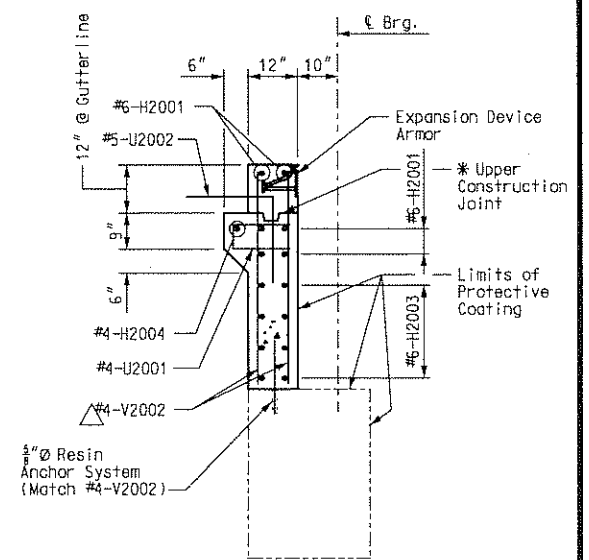

**SECTION B-B**  
Scale: 1/2"=1'-0"

**FINAL PLANS**  
 I CERTIFY THAT THIS PLAN SHEET ACCURATELY DEPICTS THE CONFIGURATION AND LOCATION OF THE ROADWAY AND ALL ITS APPURTENANT FEATURES, TO THE BEST OF MY KNOWLEDGE, AS I AND MY STAFF HAVE OBSERVED THE CONTRACTOR'S CONSTRUCTION OF THIS PROJECT. I SPECIFICALLY DISCLAIM ANY RESPONSIBILITY FOR THE DESIGN OF THIS PROJECT, EXCEPT AS I AND MY STAFF MAY HAVE MODIFIED OR AUTHORIZED THE MODIFICATION OF THE PROJECT DESIGN DURING ITS CONSTRUCTION; AND I DISCLAIM RESPONSIBILITY FOR THE CONTRACTOR'S ACTUAL CONSTRUCTION OF THE PROJECT, EXCEPT AS I AND MY STAFF MAY HAVE DIRECTED OR ORDERED THAT THE PROJECT BE CONSTRUCTED.




SIGNATURE \_\_\_\_\_ DATE \_\_\_\_\_

**SUBSTRUCTURE QUANTITY TABLE FOR END BENT 20**



ITEM	UNITS	QUANTITY
Class 1 Excavation	Cu. Yds.	35 ✓
Substructure Repair (Formed)	Sq. Ft.	0 ✓
Substructure Repair (Unformed)	Sq. Ft.	12 ✓
Class B-1 Concrete (Substr.)	Cu. Yds.	12.7 ✓
Reinforced Steel (Bridges)	Lbs.	1,590 ✓
Reinforcing Steel (Epoxy Coated)	Lbs.	1,020 ✓

Notes:  
 The Substructure Quantities are included in the Estimated Quantities table on Sheet No. /p02/.  
 Existing bearings to be cleaned, lubricated and coated, see Special Provisions.  
 For Wingwall Details, see Sheet No. /p06/.  
 For Safety Barrier Curb Details, see Sheet No. /p25/.  
 Footings are not shown for clarity.  
 Cost for furnishing and installing the resin anchor systems, complete in place, shall be included in the Class B-1 Concrete (Substr.).  
 Place resin anchor systems to clear any existing horizontal or vertical reinforcing. e.f. denotes each face.

**END BENT 20 MODIFICATIONS**

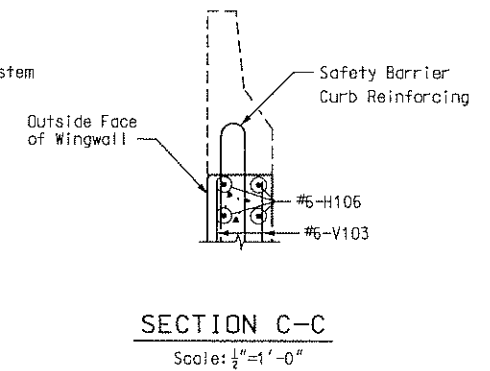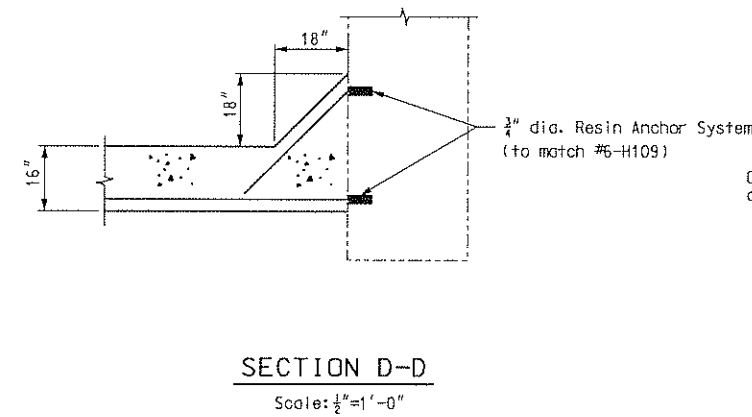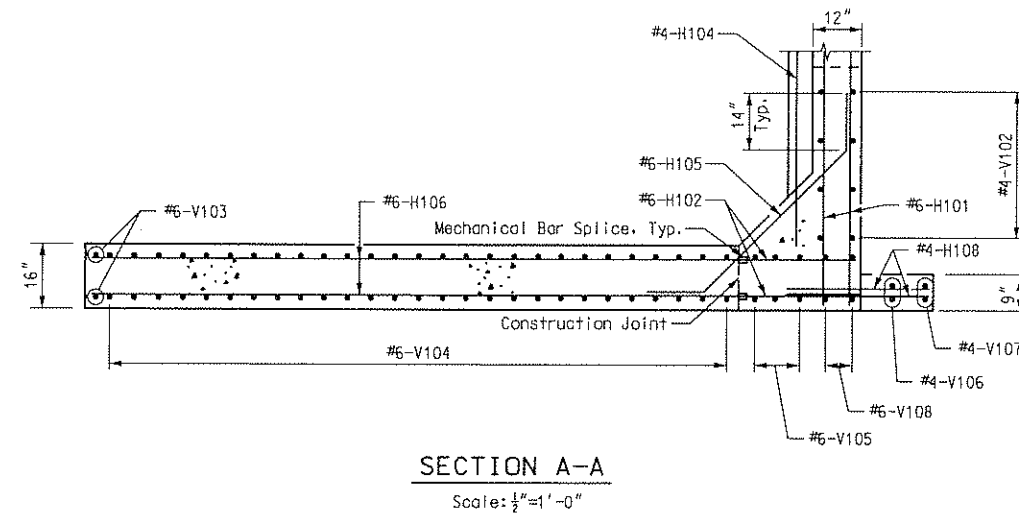

Note:  
 \* Pour concrete above upper construction joint after expansion device is placed.  
 \*\* #5-K103 and #5-K104 shall be spaced as shown on Sheet No. /p25/.

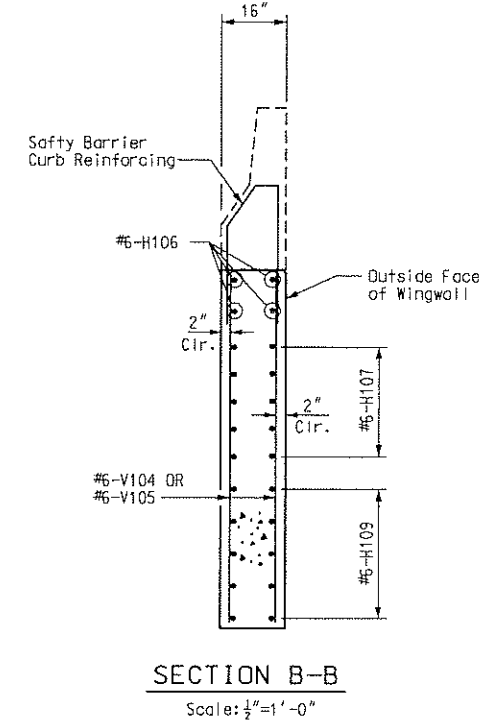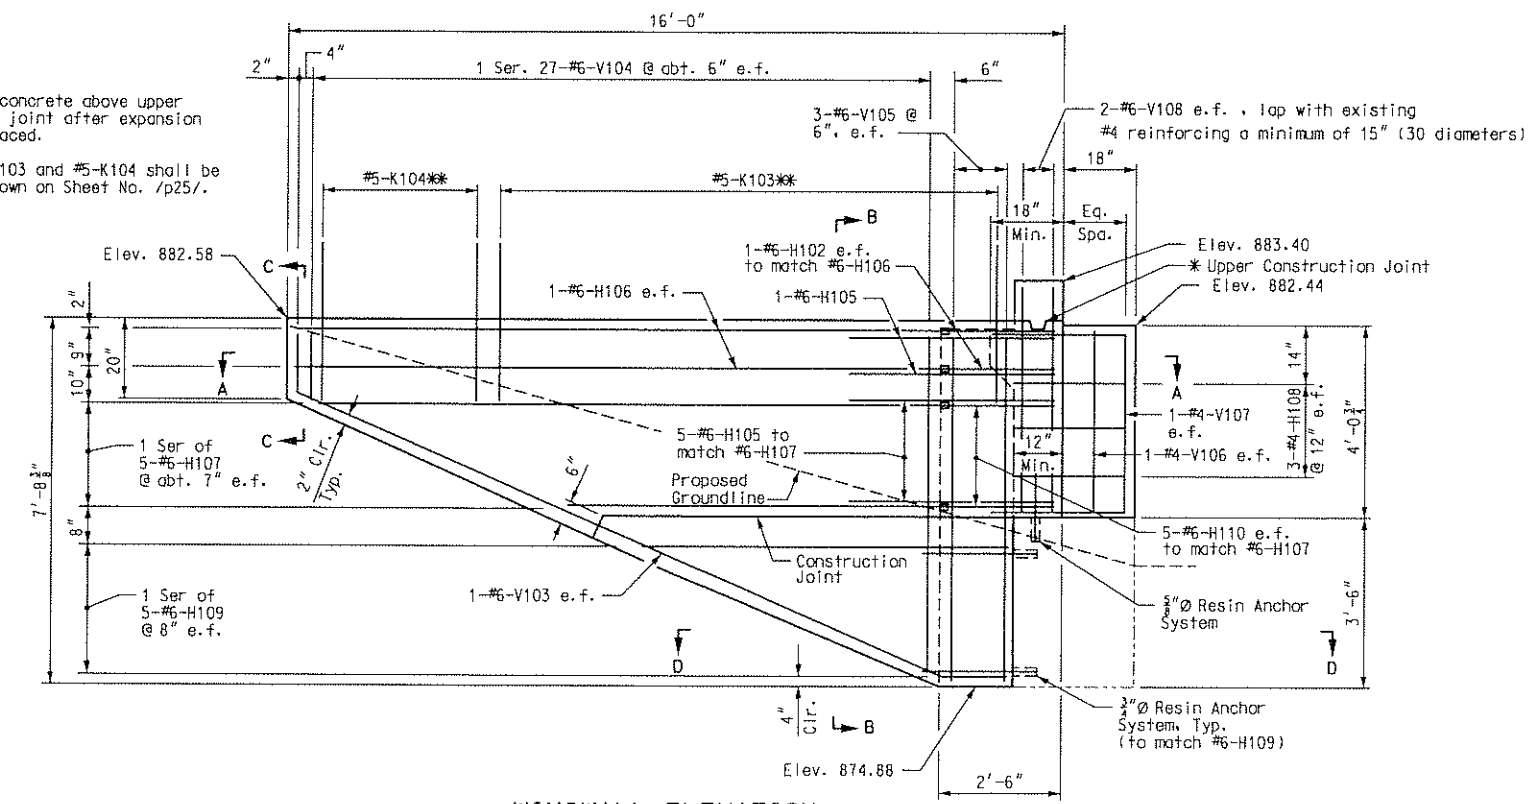


**WINGWALL ELEVATION**  
 End Bent 1 Right Side Shown (Left Side Opposite)  
 End Bent 20 Left Side Shown (Right Side Opposite)  
 Scale: 1/2"=1'-0"


**FINAL PLANS**  
 I CERTIFY THAT THIS PLAN SHEET ACCURATELY DEPICTS THE CONFIGURATION AND LOCATION OF THE ROADWAY AND ALL ITS APPURTENANT FEATURES, TO THE BEST OF MY KNOWLEDGE, AS I AND MY STAFF HAVE OBSERVED THE CONTRACTOR'S CONSTRUCTION OF THIS PROJECT. I SPECIFICALLY DISCLAIM ANY RESPONSIBILITY FOR THE DESIGN OF THIS PROJECT, EXCEPT AS I AND MY STAFF MAY HAVE MODIFIED OR AUTHORIZED THE MODIFICATION OF THE PROJECT DESIGN DURING ITS CONSTRUCTION; AND I DISCLAIM RESPONSIBILITY FOR THE CONTRACTOR'S ACTUAL CONSTRUCTION OF THE PROJECT, EXCEPT AS I AND MY STAFF MAY HAVE DIRECTED OR ORDERED THAT THE PROJECT BE CONSTRUCTED.

Notes:  
 Bar Marks shown are for End Bent 1 using "100" series Bar Marks. End Bent 20 is similar, except use "2000" series Bar Marks. e.f. denotes each face. For Safety Barrier Curb Details, see Sheet No. /p25/. Cost for furnishing and installing the resin anchor systems, complete in place, shall be included in the Class B-1 Concrete (Substr.). Place resin anchor systems to clear any existing horizontal or vertical reinforcing.


**WINGWALL DETAILS  
 END BENTS 1 AND 20**

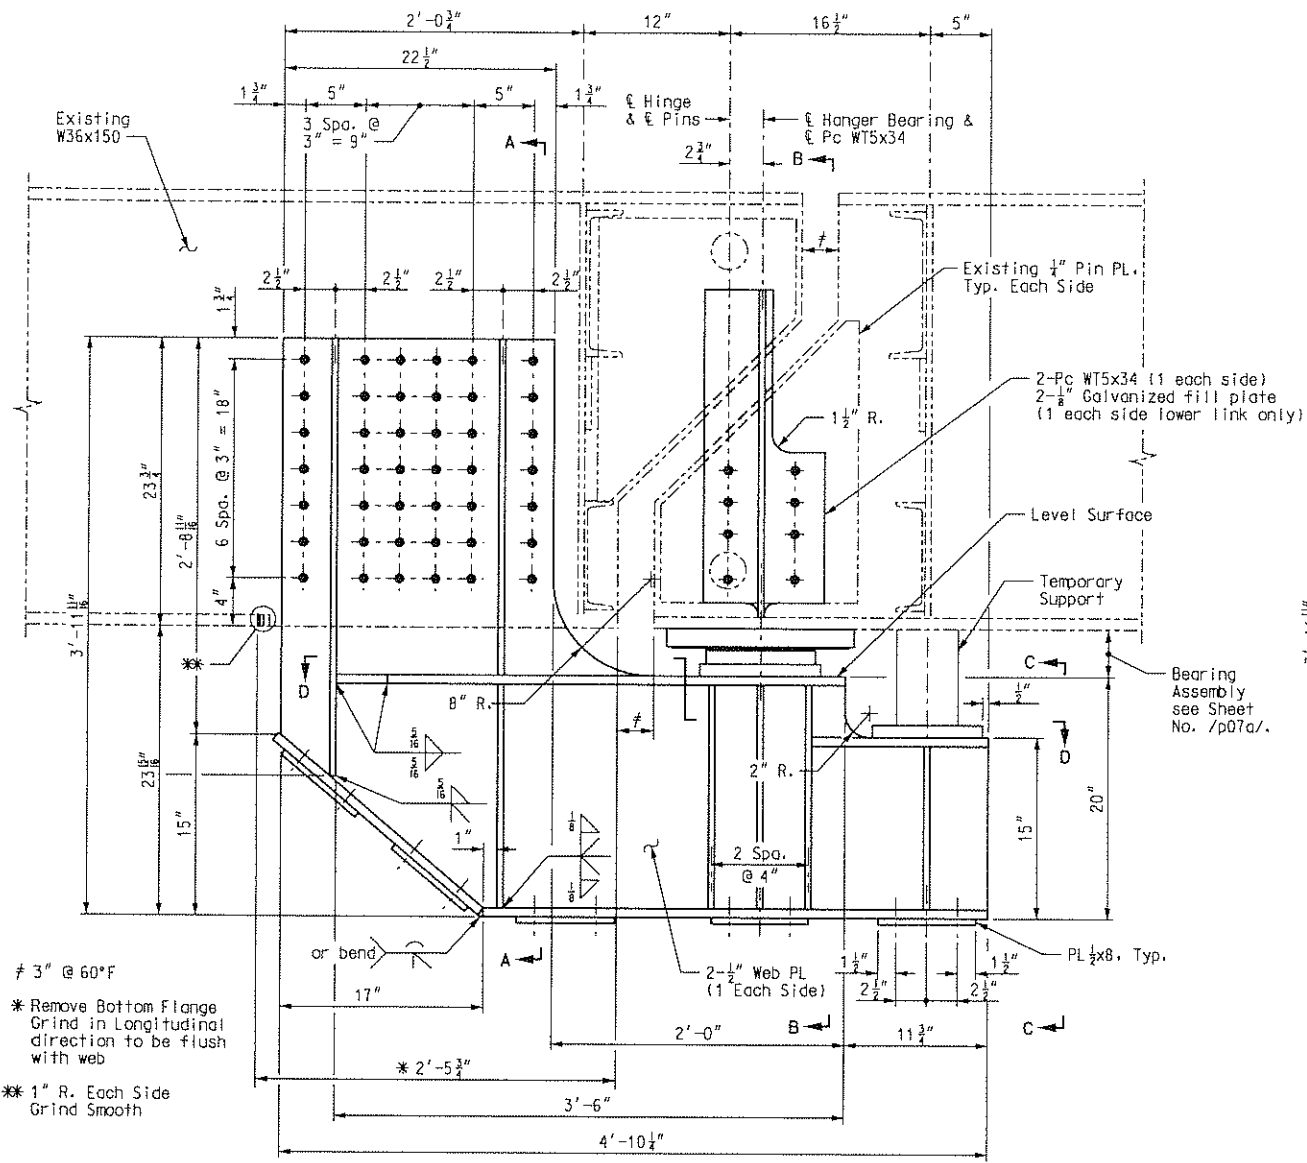

ELEVATION AT HINGE

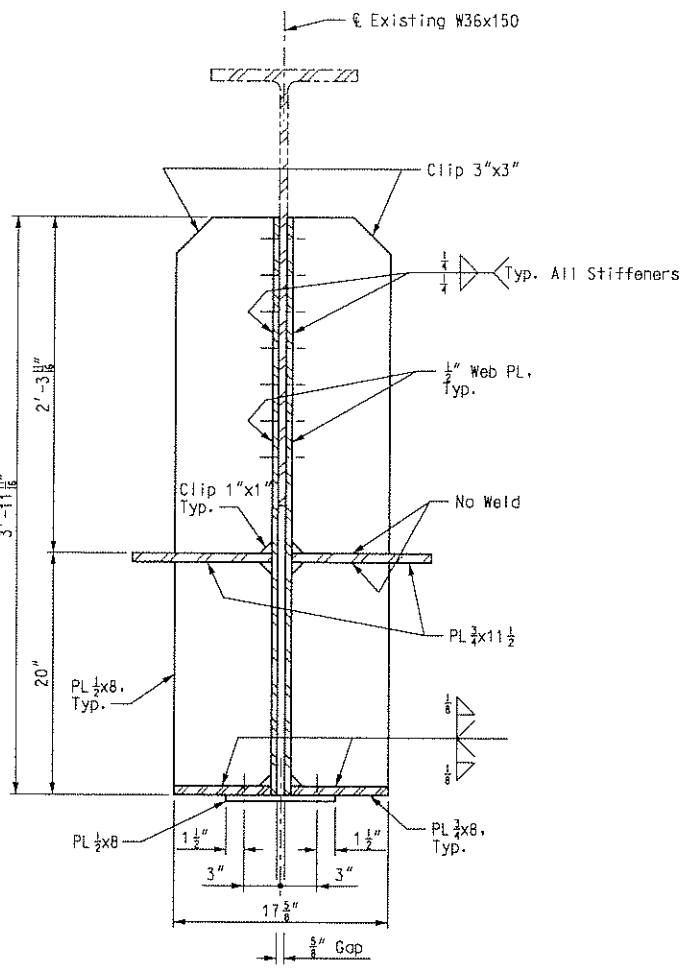


SECTION A-A

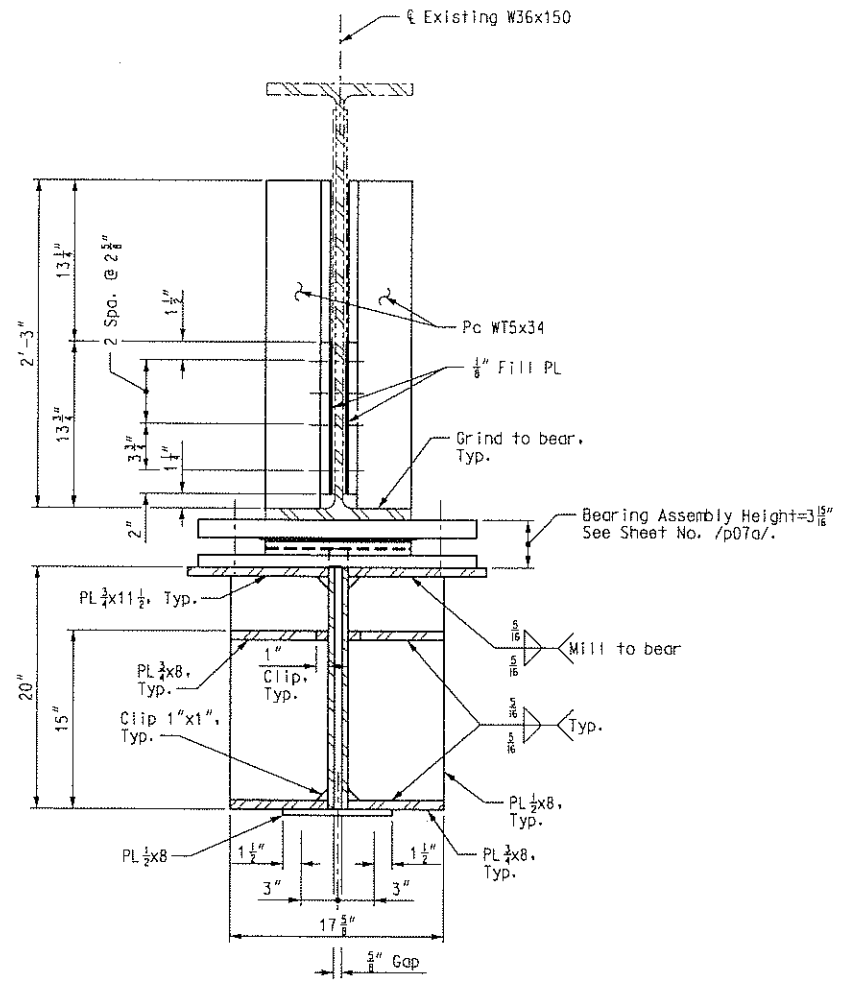


SECTION B-B

# 3" @ 60°F  
 \* Remove Bottom Flange Grind in Longitudinal direction to be flush with web  
 \*\* 1" R. Each Side Grind Smooth

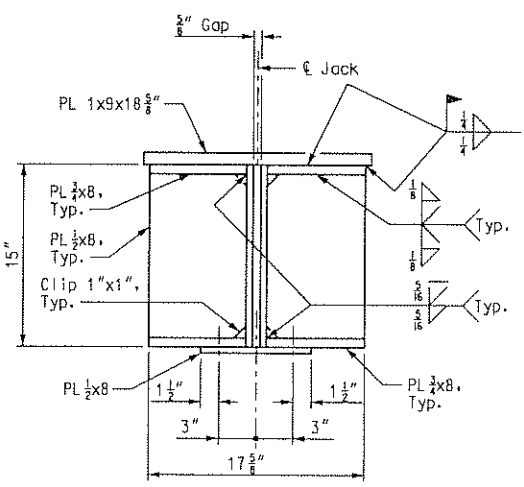

SECTION C-C

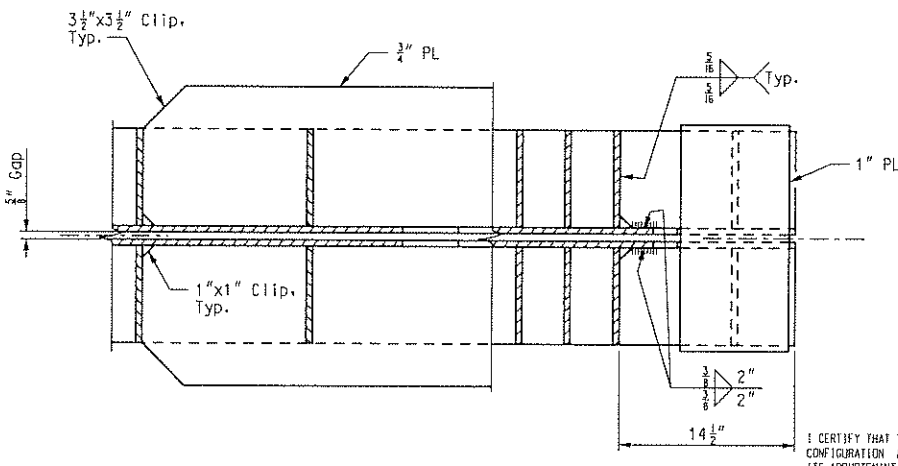

SECTION D-D


Notes:  
 All structural steel shall be ASTM A709, Grade 36.  
 All bolts shall be 1/2" Ø ASTM A325 H.S. bolts, holes 5/16" Ø.  
 Payment for the hanger bearing assembly, bottom flange removal and materials shown on this sheet shall be included in the contract unit price for Hanger Retrofit at Hinges.  
 All hanger retrofit materials shall be coated similar to existing stringers and comply with hanger bearing requirements.  
 No construction equipment shall be located on supported span while span is temporarily supported.

REPLACEMENT OF HANGER RETROFIT AT HINGES SEQUENCE:


1. Remove bottom flange of support stringer, grind in longitudinal direction to be flush with web as shown in Elevation at Hinge.
2. Attach hanger bracket.
3. Jack stringers.
4. Remove existing links and pins.
5. Clean and prime coat.
6. Install new bearings, attach Pc WT5x34 and lower stringers onto bearings.

FINAL PLANS  
 I CERTIFY THAT THIS PLAN SHEET ACCURATELY DEPICTS THE CONFIGURATION AND LOCATION OF THE ROADWAY AND ALL ITS APPURTENANT FEATURES, TO THE BEST OF MY KNOWLEDGE, AS I AND MY STAFF HAVE OBSERVED THE CONTRACTOR'S CONSTRUCTION OF THIS PROJECT. I SPECIFICALLY DISCLAIM ANY RESPONSIBILITY FOR THE DESIGN OF THIS PROJECT, EXCEPT AS I AND MY STAFF MAY HAVE MODIFIED OR AUTHORIZED THE MODIFICATION OF THE PROJECT DESIGN DURING ITS CONSTRUCTION; AND I DISCLAIM RESPONSIBILITY FOR THE CONTRACTOR'S ACTUAL CONSTRUCTION OF THE PROJECT, EXCEPT AS I AND MY STAFF MAY HAVE DIRECTED OR ORDERED THAT THE PROJECT BE CONSTRUCTED.


DETAILS OF HANGER RETROFIT AT HINGES

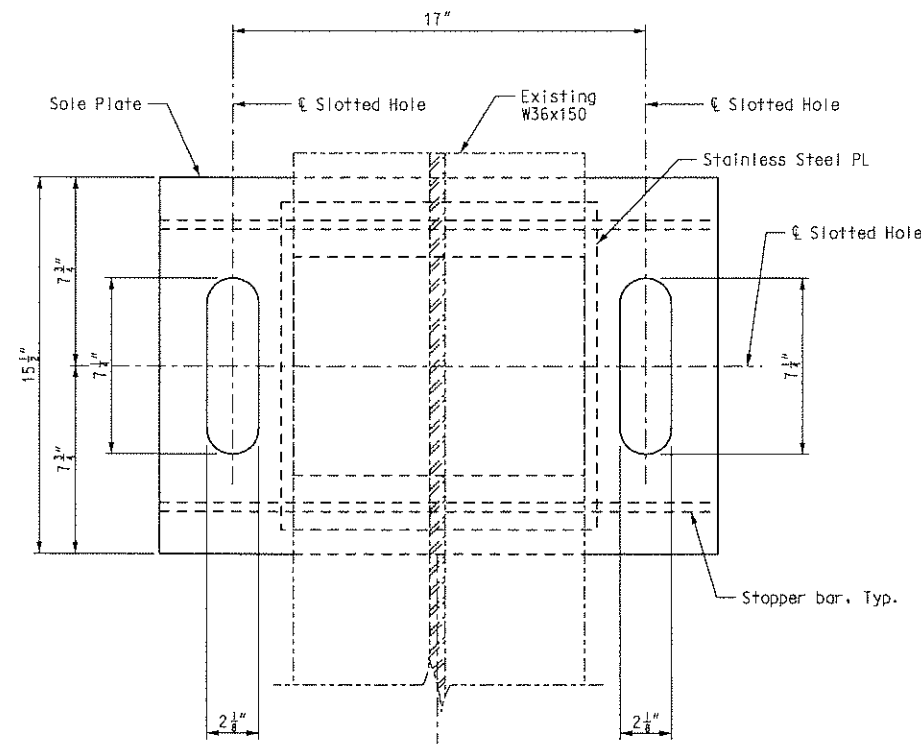


PART PLAN

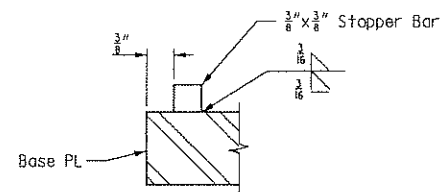


DETAIL A

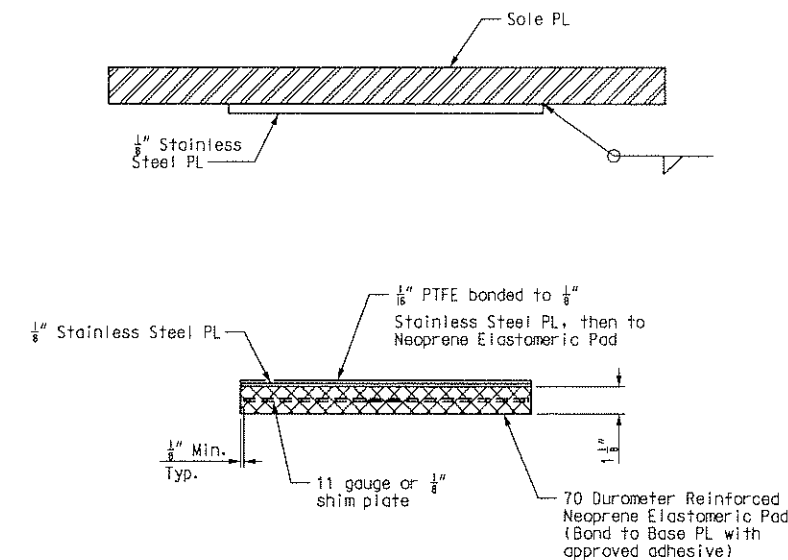

NEOPRENE ELASTOMERIC PAD

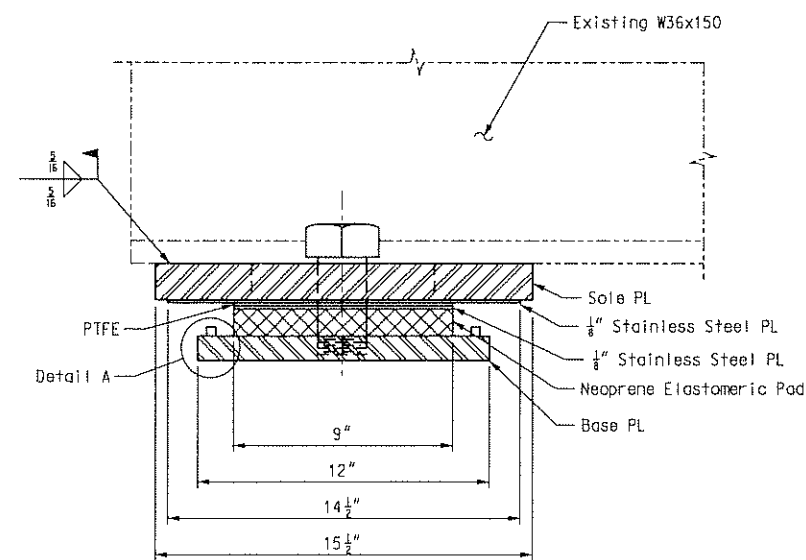

SIDE VIEW

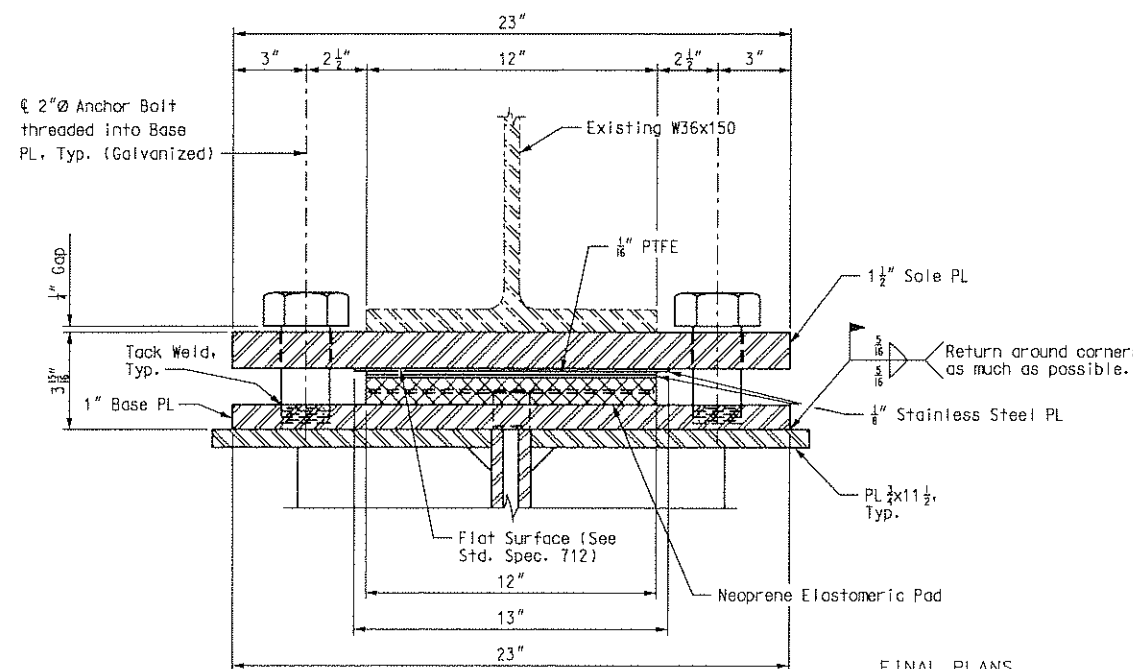

END VIEW

Note: Stopper Bar not shown for clarity.

FINAL PLANS  
I CERTIFY THAT THIS PLAN SHEET ACCURATELY DEPICTS THE CONFIGURATION AND LOCATION OF THE ROADWAY AND ALL ITS APPURTENANT FEATURES, TO THE BEST OF MY KNOWLEDGE, AS I AND MY STAFF HAVE OBSERVED THE CONTRACTOR'S CONSTRUCTION OF THIS PROJECT. I SPECIFICALLY DISCLAIM ANY RESPONSIBILITY FOR THE DESIGN OF THIS PROJECT, EXCEPT AS I AND MY STAFF MAY HAVE MODIFIED OR AUTHORIZED THE MODIFICATION OF THE PROJECT DESIGN DURING ITS CONSTRUCTION; AND I DISCLAIM RESPONSIBILITY FOR THE CONTRACTOR'S ACTUAL CONSTRUCTION OF THE PROJECT, EXCEPT AS I AND MY STAFF MAY HAVE DIRECTED OR ORDERED THAT THE PROJECT BE CONSTRUCTED.

Notes:  
Provide a 3/8" x 3/8" stopper bar to prevent the loss of support due to creeping of the PTFE bearings from under stringers at expansion bearings.

To prevent sliding, the neoprene pad shall be bonded to the base plate as approved by the bearing manufacturer for bonding neoprene to steel.

The bottom face of the 1/8" stainless steel plate that is welded to the sole plate shall be lubricated with a lubricant that is approved by the bearing manufacturer.


Anchor bolts shall be ASTM A709 Grade 50 steel.

The sole plate and base plate shall be furnished with the bearing and field welded to the stringers.

Structural steel for the sole plate and base plate shall be ASTM A709 Grade 36.

Payment for the sole plate, masonry plate, anchor bolts, stainless steel plates, PTFE and Neoprene elastomeric pad, (bearing assembly), shall be included in the cost of the Hanger Retrofit at Hinges.

Sole plate and base plate shall be coated similar to existing stringers.

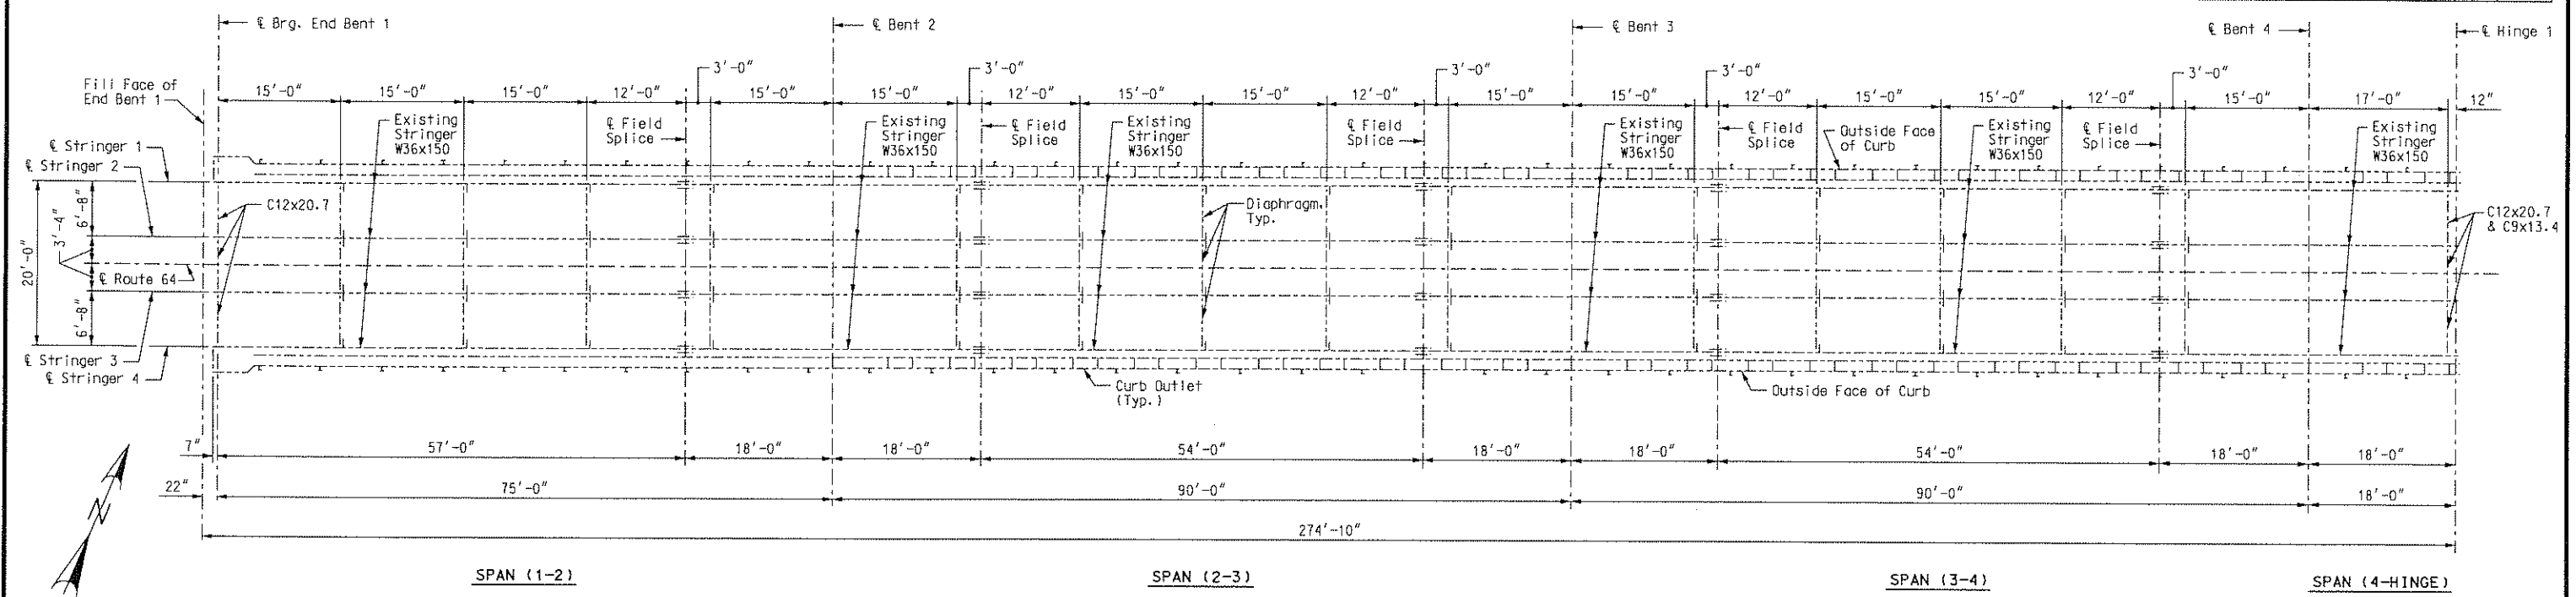


Closure Pour      8'      6 Spa. @ 10'      5' 5'      9 Spa. @ 10'      5' 5'      9 Spa. @ 10'      5' 5'      2 Panels      Closure Pour

Total	Stringers 1 & 4	1	1 1/16	1 3/16	1 5/16	2	1 3/4	1 5/8	1	1	1	1 1/8	1 11/16	1 13/16	1 15/16	2 1/4	1 13/16	1 5/8	1	1	1	1 1/8	1 3/4	2 1/16	2	2 2/16	1 11/16	1 1/4	1	1	1	1 1/4	2 3/8
	Stringers 2 & 3	2 5/8	2 2/4	3 1/8	3 3/8	3 5/8	3 3/8	3 1/4	2 11/16	2 5/8	2 5/8	2 11/16	3 3/8	3 3/4	3 11/16	4 3/16	3 11/16	3 3/8	2 11/16	2 5/8	2 5/8	2 11/16	3 7/16	3 11/16	3 3/4	4 7/16	3 11/16	3 3/8	2 5/8	2 5/8	2 5/8	2 11/16	4 1/8

SPAN (1-2)      SPAN (2-3)      SPAN (3-4)      SPAN (4-HINGE)

**ESTIMATED JOINT FILLER THICKNESS**

Notes: All values are given in inches and are for information only. Estimated Joint Filler thicknesses shown are based on an erection analysis assuming 30' of existing deck is removed and 30' of Precast Slab Panels are replaced each work period. A 10' gap (one panel width) between the existing deck and Precast Slab Panels is assumed to occur at the end of each work period. Closure pours occur after all Precast Slab Panels in the span are erected. A maximum of 1/4" (at midspan) has been added to stringers 2 & 3 values to evenly distribute the Slab Panel load to the stringers. The Contractor shall perform an erection analysis to determine joint filler thickness and shall submit details and calculations to the Engineer for approval.

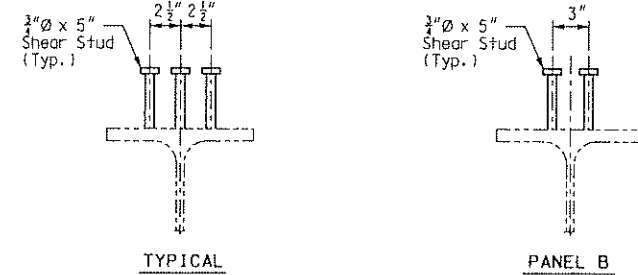

**SHEAR CONNECTOR DETAILS**

**FINAL PLANS**  
 I CERTIFY THAT THIS PLAN SHEET ACCURATELY DEPICTS THE CONFIGURATION AND LOCATION OF THE ROADWAY AND ALL ITS APPURTENANT FEATURES, TO THE BEST OF MY KNOWLEDGE, AS I AND MY STAFF HAVE OBSERVED THE CONTRACTOR'S CONSTRUCTION OF THIS PROJECT. I SPECIFICALLY DISCLAIM ANY RESPONSIBILITY FOR THE DESIGN OF THIS PROJECT, EXCEPT AS I AND MY STAFF MAY HAVE MODIFIED OR AUTHORIZED THE MODIFICATION OF THE PROJECT DESIGN DURING ITS CONSTRUCTION; AND I DISCLAIM RESPONSIBILITY FOR THE CONTRACTOR'S ACTUAL CONSTRUCTION OF THE PROJECT, EXCEPT AS I AND MY STAFF MAY HAVE DIRECTED OR ORDERED THAT THE PROJECT BE CONSTRUCTED.



SIGNATURE \_\_\_\_\_ DATE \_\_\_\_\_

Notes: Existing structural steel stringers over intermediate bents, bearing plates at intermediate bents, and stiffener plates at intermediate bents are ASTM-A373 material. All other structural steel is ASTM-A7 material.

Shear connectors shall meet the requirements of Section 1037 of the Missouri Standard Specifications.

For location of slab panel drain attachment holes see Slab Panel Drain Details, Sheet No. /p20/.

**FRAMING PLAN AND STRINGER DEFLECTIONS UNIT 1**

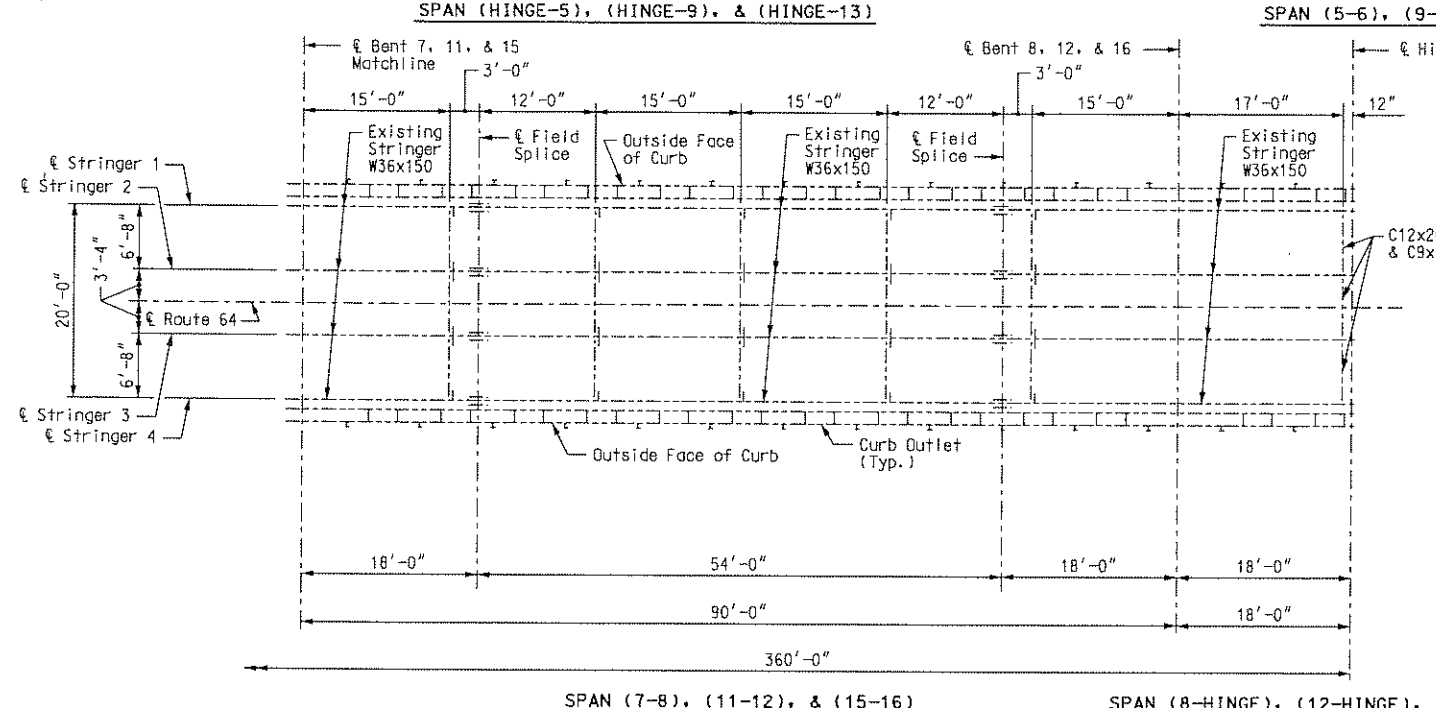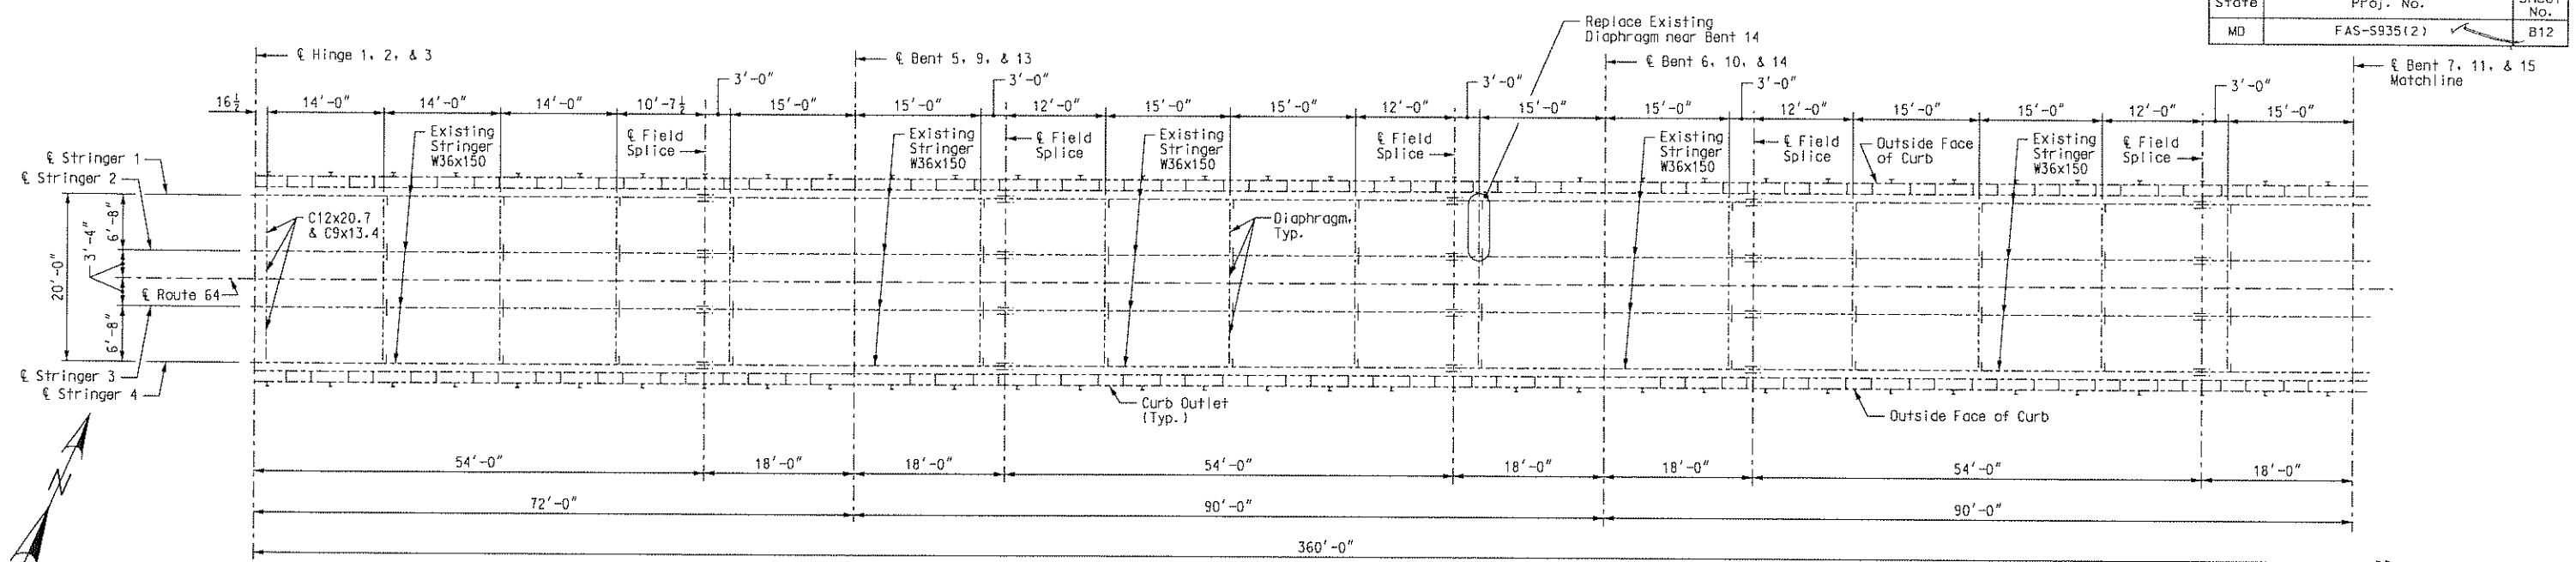

**Framing Plan Notes:**  
 Existing structural steel stringers over intermediate bents, bearing plates at intermediate bents, and stiffener plates at intermediate bents are ASTM-A373 material. All other structural steel is ASTM-A7 material.  
 For Shear Connector Details, See Sheet No. /p08/.  
 Shear connectors shall meet the requirements of Section 1037 of the Missouri Standard Specifications.  
 For location of slab panel drain attachment holes see Slab Panel Drain Details, Sheet No. /p20/.

**Estimated Joint Filler Thickness Notes:**  
 All values are given in inches and are for information only. Estimated Joint Filler thicknesses shown are based on an erection analysis assuming 30' of existing deck is removed and 30' of Precast Slab Panels are replaced each work period. A 10' gap (one panel width) between the existing deck and Precast Slab Panels is assumed to occur at the end of each work period. Closure pours occur after all Precast Slab Panels in the span are erected. A maximum of 1/2" (at midspan) has been added to stringers 2 & 3 values to evenly distribute the Slab Panel load to the stringers. The Contractor shall perform an erection analysis to determine joint filler thickness and shall submit details and calculations to the Engineer for approval.



**FINAL PLANS**  
 I CERTIFY THAT THIS PLAN SHEET ACCURATELY DEPICTS THE CONFIGURATION AND LOCATION OF THE ROADWAY AND ALL ITS APPURTENANT FEATURES, TO THE BEST OF MY KNOWLEDGE, AS I AND MY STAFF HAVE OBSERVED THE CONTRACTOR'S CONSTRUCTION OF THIS PROJECT. I SPECIFICALLY DISCLAIM ANY RESPONSIBILITY FOR THE DESIGN OF THIS PROJECT, EXCEPT AS I AND MY STAFF MAY HAVE MODIFIED OR AUTHORIZED THE MODIFICATION OF THE PROJECT DESIGN DURING ITS CONSTRUCTION; AND I DISCLAIM RESPONSIBILITY FOR THE CONTRACTOR'S ACTUAL CONSTRUCTION OF THE PROJECT, EXCEPT AS I AND MY STAFF MAY HAVE DIRECTED OR ORDERED THAT THE PROJECT BE CONSTRUCTED.

SIGNATURE \_\_\_\_\_ DATE \_\_\_\_\_

		6 Spa. @ 10'						5' 5'		9 Spa. @ 10'						5' 5'		9 Spa. @ 10'						5' 5'		9 Spa. @ 10'		5' 5'		2 Panels Closure Pour											
		€ Hinge 1, 2 and 3		€ Bent 5, 9 and 13						€ Bent 6, 10 and 14		€ Bent 7, 11 and 15						€ Bent 8, 12 and 16		€ Hinge 2, 3 and 4																					
		Top Flange		Top of Joint Filler or Polystyrene Bedding Material																																					
Total	Stringers 1&4	2 1/2	2 1/8	2 1/2	1 13/16	1 7/8	1 1/8	1	1	1 1/8	1 11/16	2	1 11/16	2 1/4	1 11/16	1 1/8	1	1	1	1 1/8	1 11/16	1 11/16	1 11/16	2 1/4	1 11/16	1 1/8	1	1	1	1 1/8	1 11/16	2 1/8	2 1/8	2 11/16	2 1/8	1 1/2	1	1	1	1 3/16	2 1/4
	Stringers 2&3	4 1/4	4 3/8	4 1/8	3 13/16	3 1/4	2 7/8	2 11/16	2 5/8	2 1/4	3 3/8	3 3/4	3 11/16	4 1/8	3 11/16	3 3/8	2 11/16	2 5/8	2 5/8	2 11/16	3 3/8	3 3/4	3 11/16	4 3/8	3 5/8	3 3/8	2 1/4	2 5/8	2 5/8	2 11/16	3 1/2	3 7/8	3 7/8	4 5/8	4	3 3/8	2 3/4	2 5/8	2 5/8	2 7/8	4

SPAN (HINGE-5), (HINGE-9), & (HINGE-13)      SPAN (5-6), (9-10), & (13-14)      SPAN (6-7), (10-11), & (14-15)      SPAN (7-8), (11-12), & (15-16)      SPAN (8-HINGE), (12-HINGE), & (16-HINGE)

**ESTIMATED JOINT FILLER THICKNESS**  
**FRAMING PLAN AND STRINGER DEFLECTIONS**  
**UNITS 2, 3, AND 4**

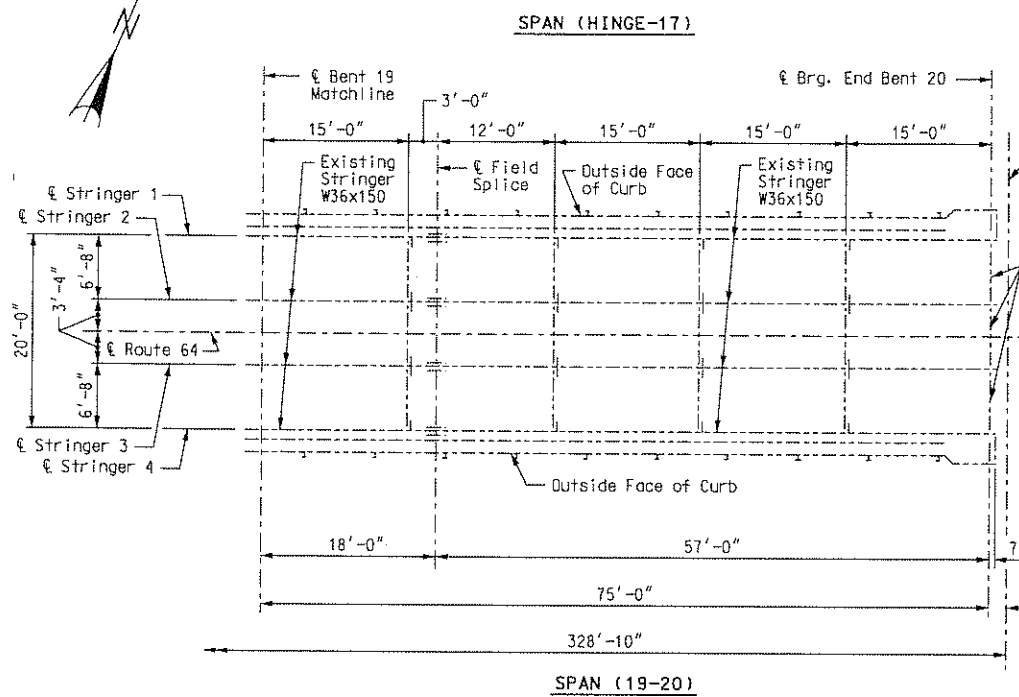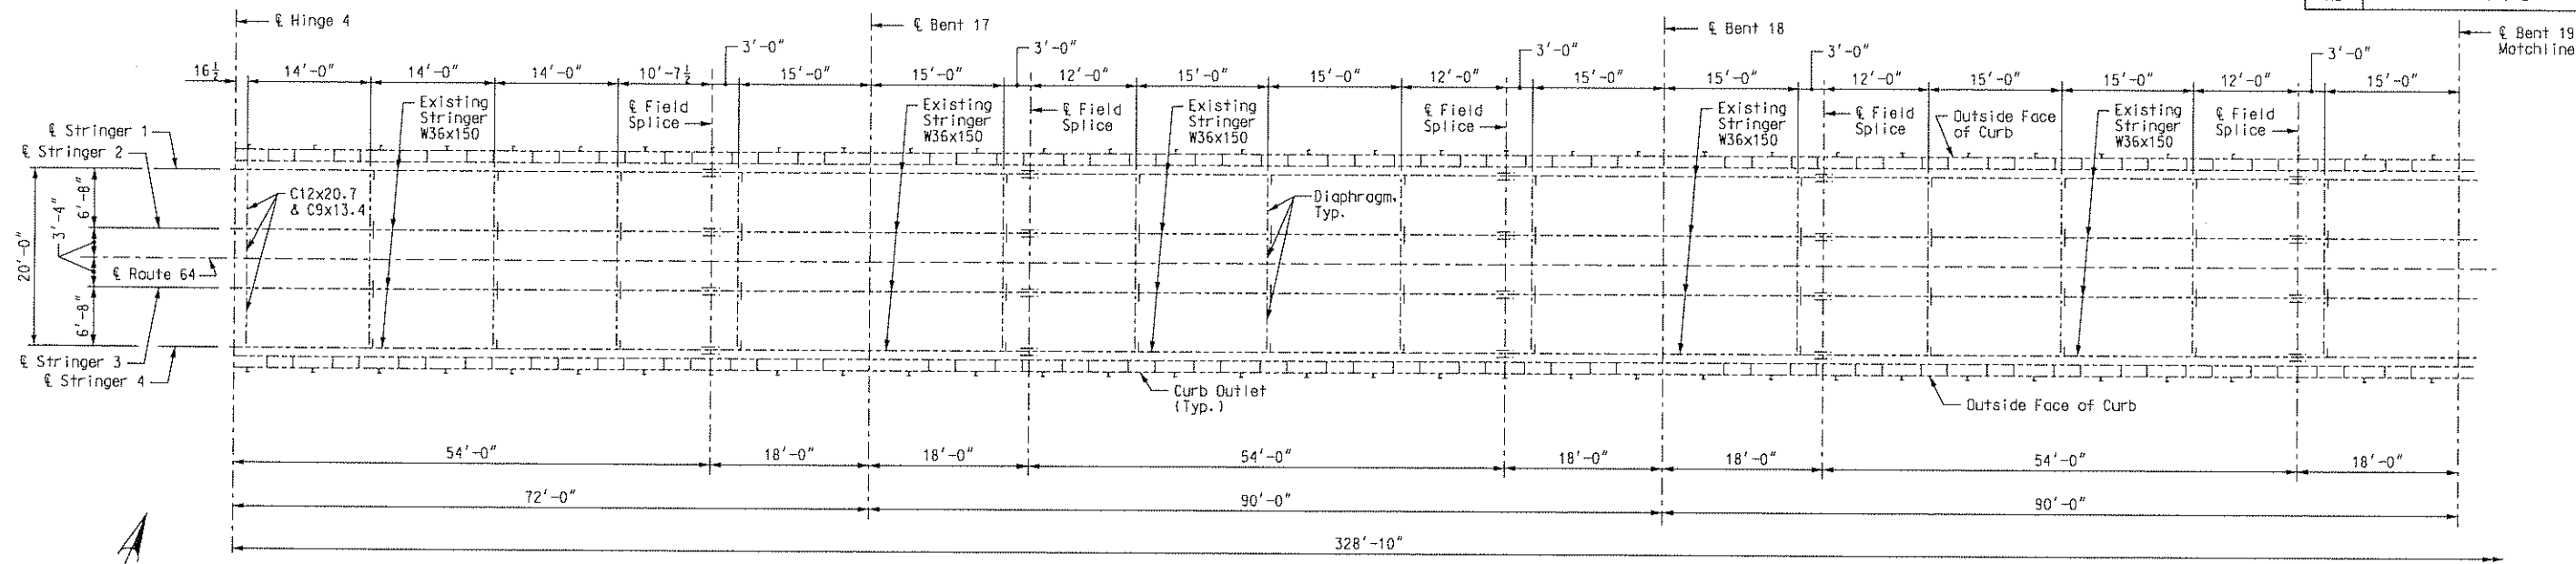

**Framing Plan Notes:**  
 Existing structural steel stringers over intermediate bents, bearing plates at intermediate bents, and stiffener plates at intermediate bents are ASTM-A373 material. All other structural steel is ASTM-A7 material.  
 For Shear Connector Details, See Sheet No. /p08/.  
 Shear Connectors shall meet the requirements of Section 1037 of the Missouri Standard Specifications.  
 For location of slab panel drain attachment holes see Slab Panel Drain Details, Sheet No. /p20/.

**FINAL PLANS**  
 I CERTIFY THAT THIS PLAN SHEET ACCURATELY DEPICTS THE CONFIGURATION AND LOCATION OF THE ROADWAY AND ALL ITS APPURTENANT FEATURES, TO THE BEST OF MY KNOWLEDGE, AS I AND MY STAFF HAVE OBSERVED THE CONTRACTOR'S CONSTRUCTION OF THIS PROJECT. I SPECIFICALLY DISCLAIM ANY RESPONSIBILITY FOR THE DESIGN OF THIS PROJECT, EXCEPT AS I AND MY STAFF MAY HAVE MODIFIED OR AUTHORIZED THE MODIFICATION OF THE PROJECT DESIGN DURING ITS CONSTRUCTION; AND I DISCLAIM RESPONSIBILITY FOR THE CONTRACTOR'S ACTUAL CONSTRUCTION OF THE PROJECT, EXCEPT AS I AND MY STAFF MAY HAVE DIRECTED OR ORDERED THAT THE PROJECT BE CONSTRUCTED.

SIGNATURE \_\_\_\_\_ DATE \_\_\_\_\_


**Estimated Joint Filler Thickness Notes:**  
 All values are given in inches and are for information only. Estimated Joint Filler thicknesses shown are based on an erection analysis assuming 30' of existing deck is removed and 30' of Precast Slab Panels are replaced each work period. A 10' gap (one panel width) between the existing deck and Precast Slab Panels is assumed to occur at the end of each work period. Closure pours occur after all Precast Slab Panels in the span are erected. A maximum of 1/4" (at midspan) has been added to stringers 2 & 3 values to evenly distribute the Slab Panel load to the stringers. The Contractor shall perform an erection analysis to determine joint filler thickness and shall submit details and calculations to the Engineer for approval.

		6 Spa. @ 10'				8 Spa. @ 10'				8 Spa. @ 10'				6 Spa. @ 10'											
		HINGE-17				17-18				18-19				19-20				Closure Panel							
		1	2	3	4	5	6	7	8	9	10	11	12	13	14	15	16	17	18	19	20	21	22	23	24
Total	Stringers 1 & 4	2 3/8	2 3/8	2 3/8	2	1 7/16	1 1/8	1	1	1 1/8	1 11/16	2	1 15/16	2 1/4	1 13/16	1 5/8	1	1	1 1/8	1 11/16	1 15/16	2 1/4	1 13/16	1 5/8	1
	Stringers 2 & 3	4 1/8	4 1/8	4 7/16	3 7/8	3 5/16	2 11/16	2 5/8	2 5/8	2 3/4	3 1/16	3 1/4	3 11/16	4 3/16	3 11/16	3 3/16	2 11/16	2 5/8	2 5/8	2 11/16	3 3/8	2 1/4	2 5/8	2 11/16	2 5/8

**ESTIMATED JOINT FILLER THICKNESS**

**FRAMING PLAN AND STRINGER DEFLECTIONS**

**UNIT 5**

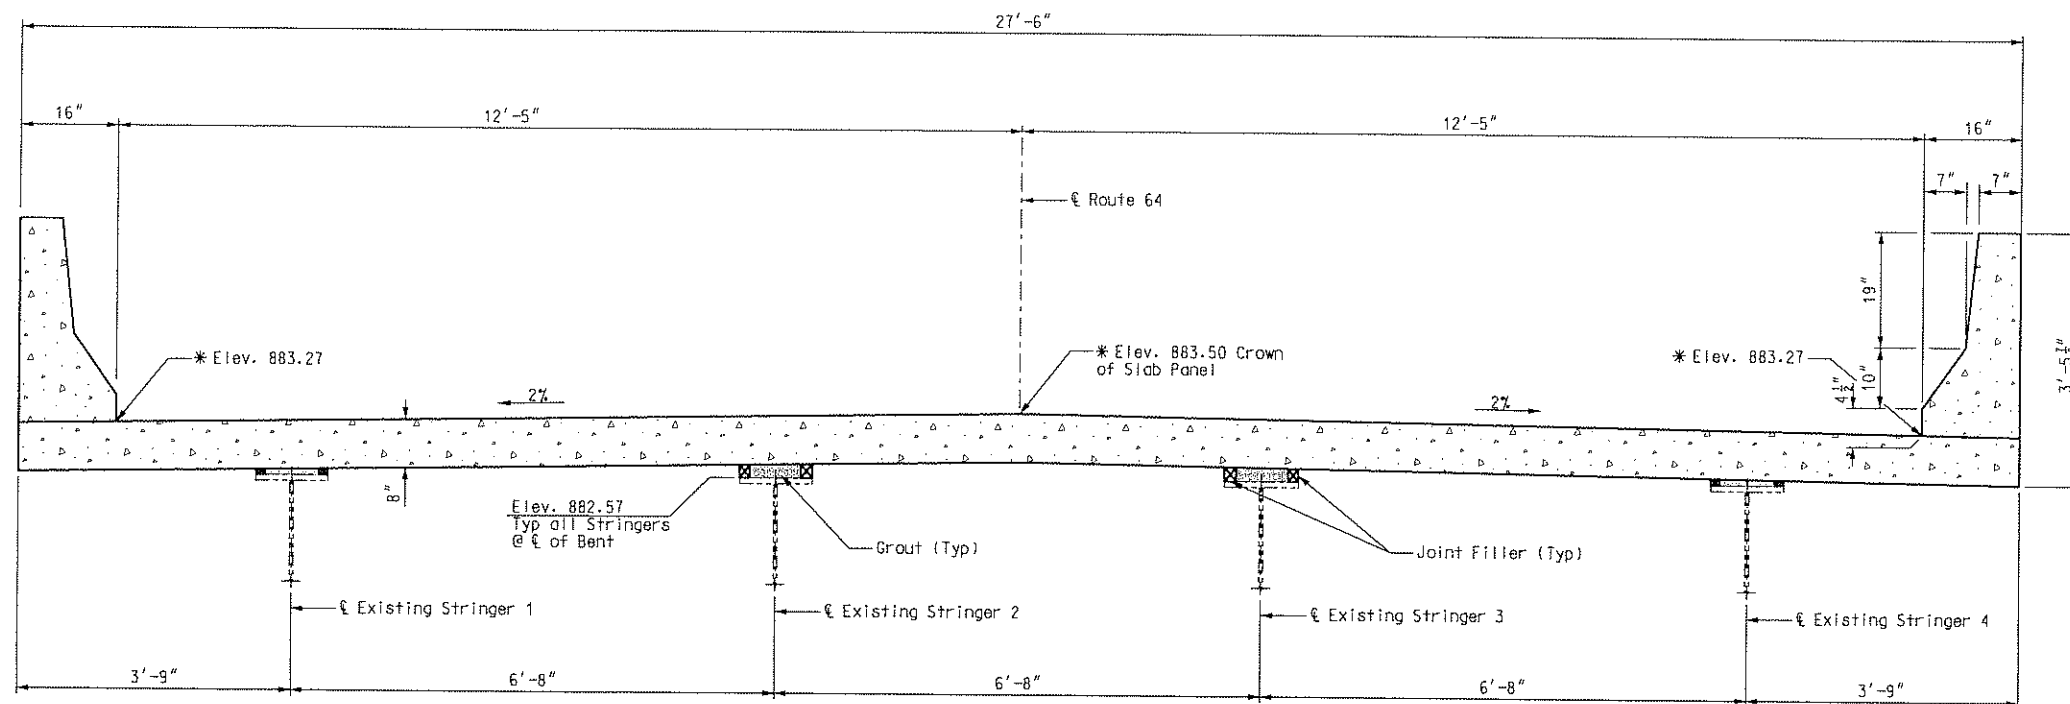


### TYPICAL SECTION SHOWING ELEVATIONS

Scale:  $\frac{1}{4}'' = 1'$

\*Elevations are at top of slab panels and do not include wearing surface.

### PRECAST SLAB PANELS GENERAL NOTES:

1. The joint filler or polystyrene bedding material shall be cut to the required haunch height above top of flange to maintain top of slab panel elevations as shown. The joint filler or polystyrene bedding material shall be cut so that slab panels bear fully on all existing stringer flanges.
2. The surface of joint filler shall be cut to match bridge cross slope.
3. Joint filler shall be one piece thickness, not acceptable to build thickness up in layers. Minimum joint filler or polystyrene bedding material thickness shall be 1 inch, except over splice plates or cover plates where minimum thickness shall be  $\frac{3}{4}$  inch.
4. All panel support pads (joint filler or polystyrene bedding material) shall be glued to the stringer. When support thickness exceeds  $1\frac{1}{2}$  inches, the pads shall be glued top and bottom. The glue used shall be the type recommended by the panel support pads manufacturer.
5. Joint filler shall be  $1\frac{1}{2}$  inch wide for thickness up to 2 inches. width of joint filler over 2 inches thickness shall be thickness minus  $\frac{1}{2}$  inch.
6. Adjustment in the wearing surface thickness, joint filler or polystyrene bedding material thickness, or grade will be necessary if the stringer deflection after panel placement differs from plan deflection. No payment will be made for additional labor or materials for the adjustment.
7. At contractor's option, dry pack grout may be used in place of joint filler at no additional cost to owner.

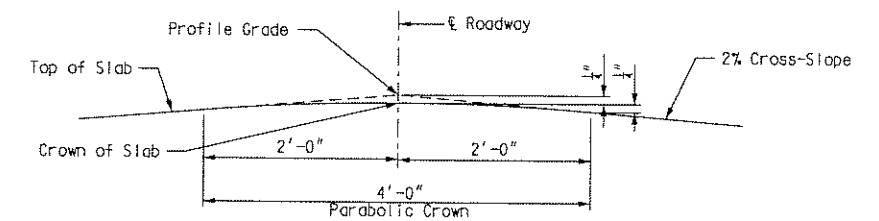

SLAB CROWN DETAIL


### FINAL PLANS

I CERTIFY THAT THIS PLAN SHEET ACCURATELY DEPICTS THE CONFIGURATION AND LOCATION OF THE ROADWAY AND ALL ITS APPURTENANT FEATURES, TO THE BEST OF MY KNOWLEDGE. AS I AND MY STAFF HAVE OBSERVED THE CONTRACTOR'S CONSTRUCTION OF THIS PROJECT, I SPECIFICALLY DISCLAIM ANY RESPONSIBILITY FOR THE DESIGN OF THIS PROJECT, EXCEPT AS I AND MY STAFF MAY HAVE MODIFIED OR AUTHORIZED THE MODIFICATION OF THE PROJECT DESIGN DURING ITS CONSTRUCTION; AND I DISCLAIM RESPONSIBILITY FOR THE CONTRACTOR'S ACTUAL CONSTRUCTION OF THE PROJECT, EXCEPT AS I AND MY STAFF MAY HAVE DIRECTED OR ORDERED THAT THE PROJECT BE CONSTRUCTED.

SIGNATURE \_\_\_\_\_ DATE \_\_\_\_\_



State	Proj. No.	Sheet No.
MO	FAS-5935(2)	B15

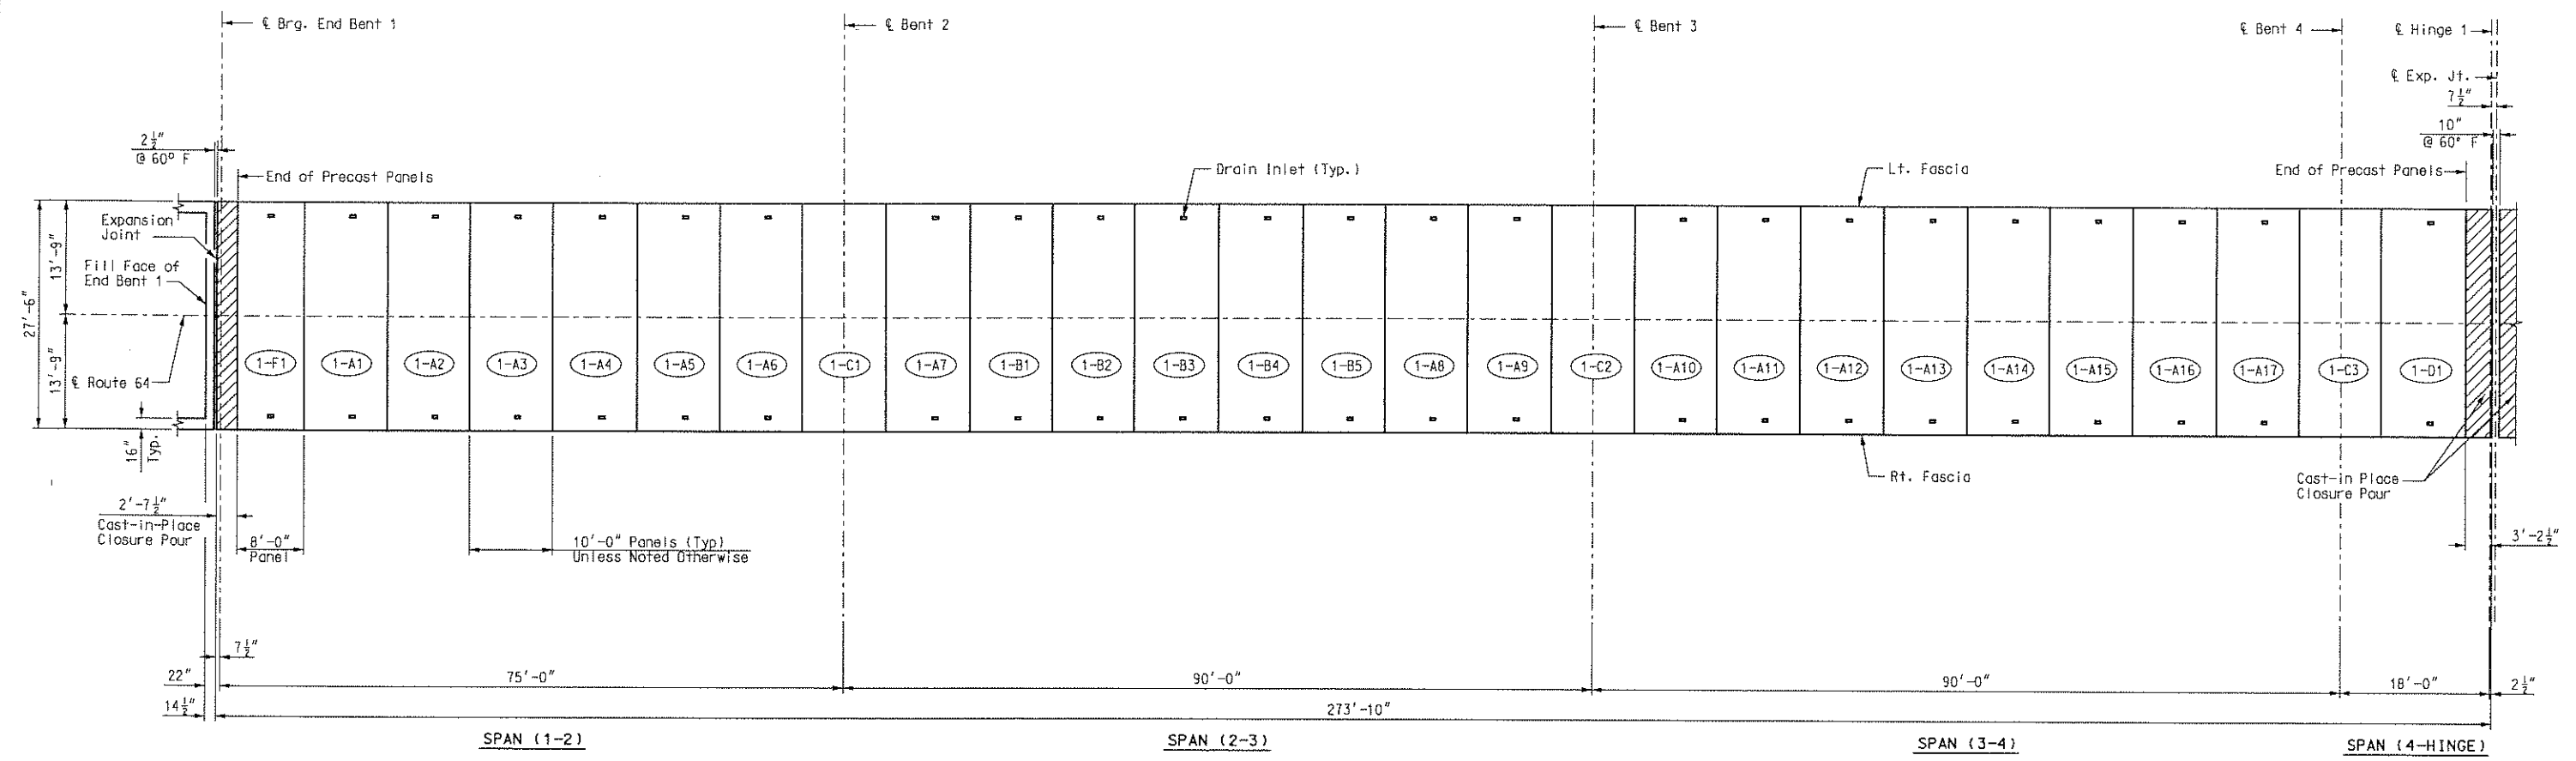


**PLAN**  
Scale: 1"=10'-0"

**FINAL PLANS**


I CERTIFY THAT THIS PLAN SHEET ACCURATELY DEPICTS THE CONFIGURATION AND LOCATION OF THE ROADWAY AND ALL ITS APPURTENANT FEATURES, TO THE BEST OF MY KNOWLEDGE, AS I AND MY STAFF HAVE OBSERVED THE CONTRACTOR'S CONSTRUCTION OF THIS PROJECT. I SPECIFICALLY DISCLAIM ANY RESPONSIBILITY FOR THE DESIGN OF THIS PROJECT, EXCEPT AS I AND MY STAFF MAY HAVE MODIFIED OR AUTHORIZED THE MODIFICATION OF THE PROJECT DESIGN DURING ITS CONSTRUCTION; AND I DISCLAIM RESPONSIBILITY FOR THE CONTRACTOR'S ACTUAL CONSTRUCTION OF THE PROJECT, EXCEPT AS I AND MY STAFF MAY HAVE DIRECTED OR ORDERED THAT THE PROJECT BE CONSTRUCTED.

\_\_\_\_\_  
SIGNATURE                      DATE

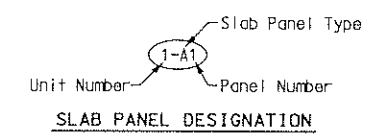


**Notes:**  
For Typical Section, see Sheet No. /p18/.  
For Safety Barrier Curb Details, see Sheet No. /p21/ and /p23/.  
For Slab Drain Details, see Sheet No. /p20/.  
For Closure Pour Details, See Sheet No. /p22/.  
For Expansion Joint Details, see Sheet No. /p24/ and /p26/.  
Longitudinal dimensions are measured horizontally.

SLAB PANEL LAYOUT  
UNIT 1

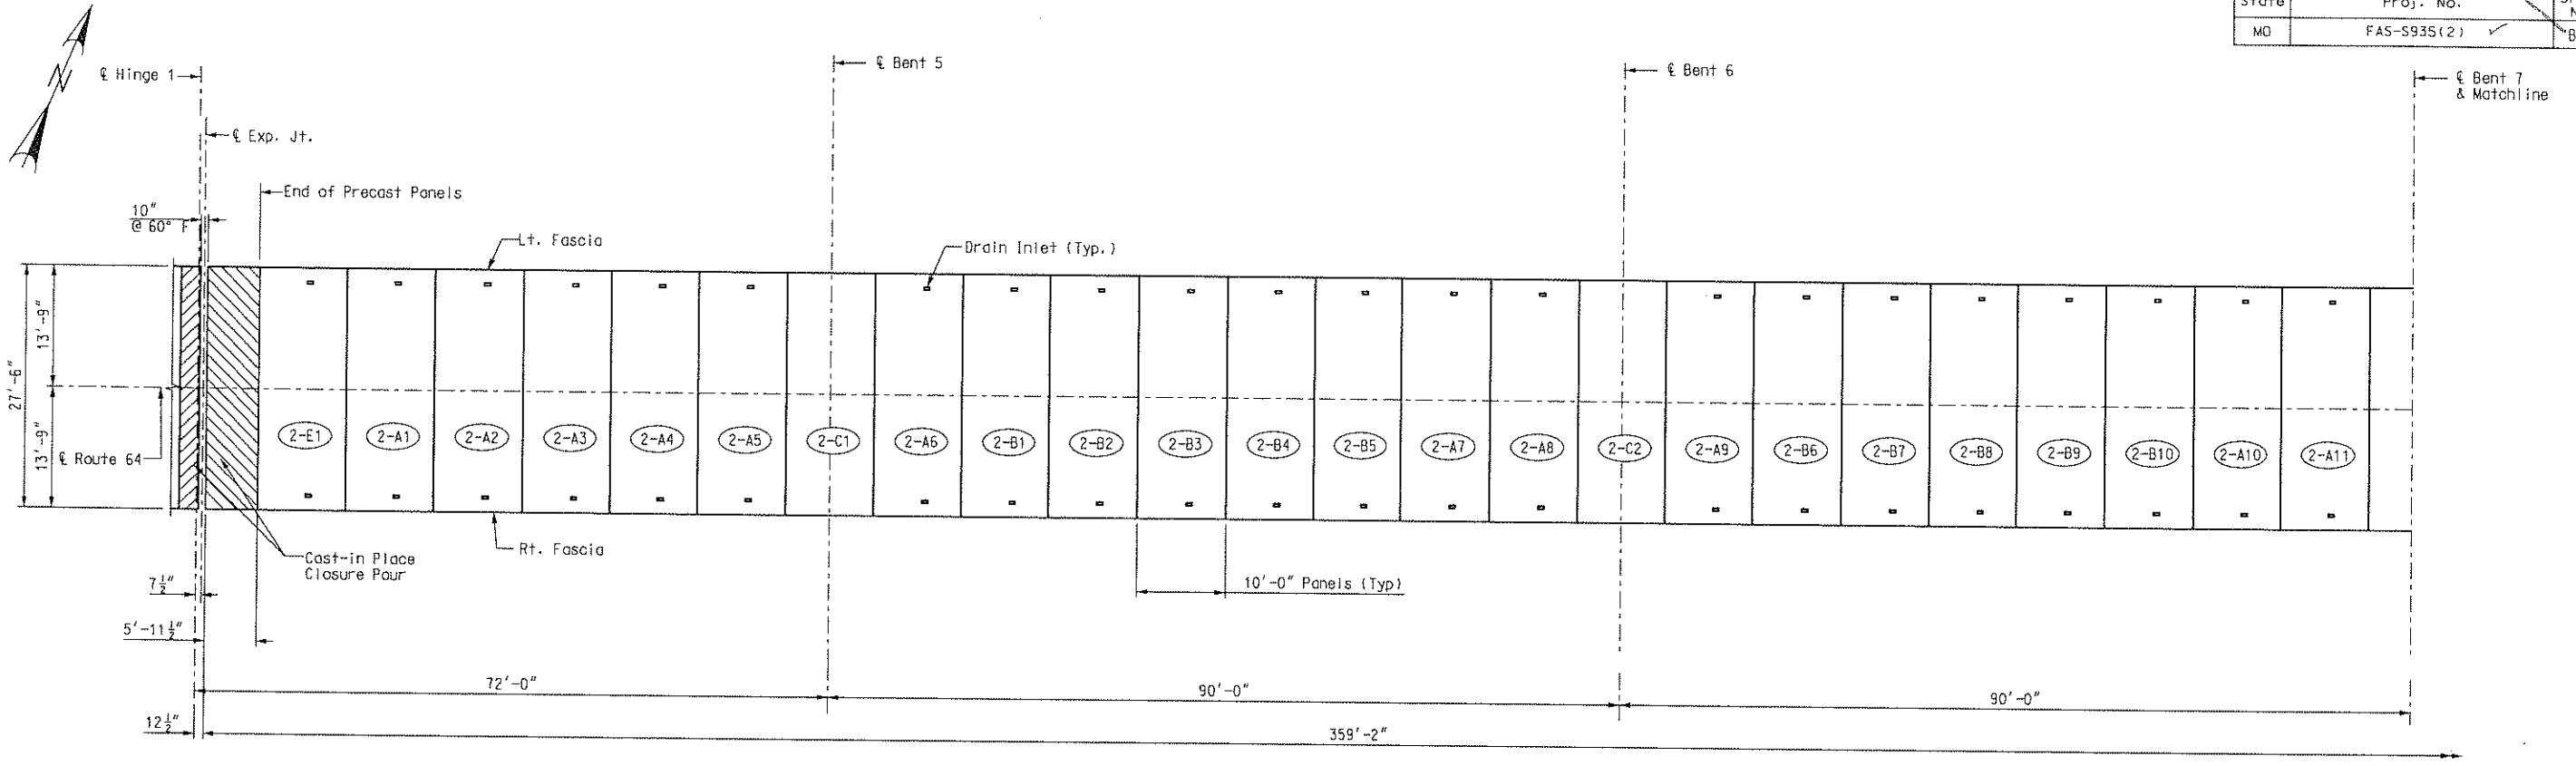

**PLAN**  
Scale: 1"=10'-0"

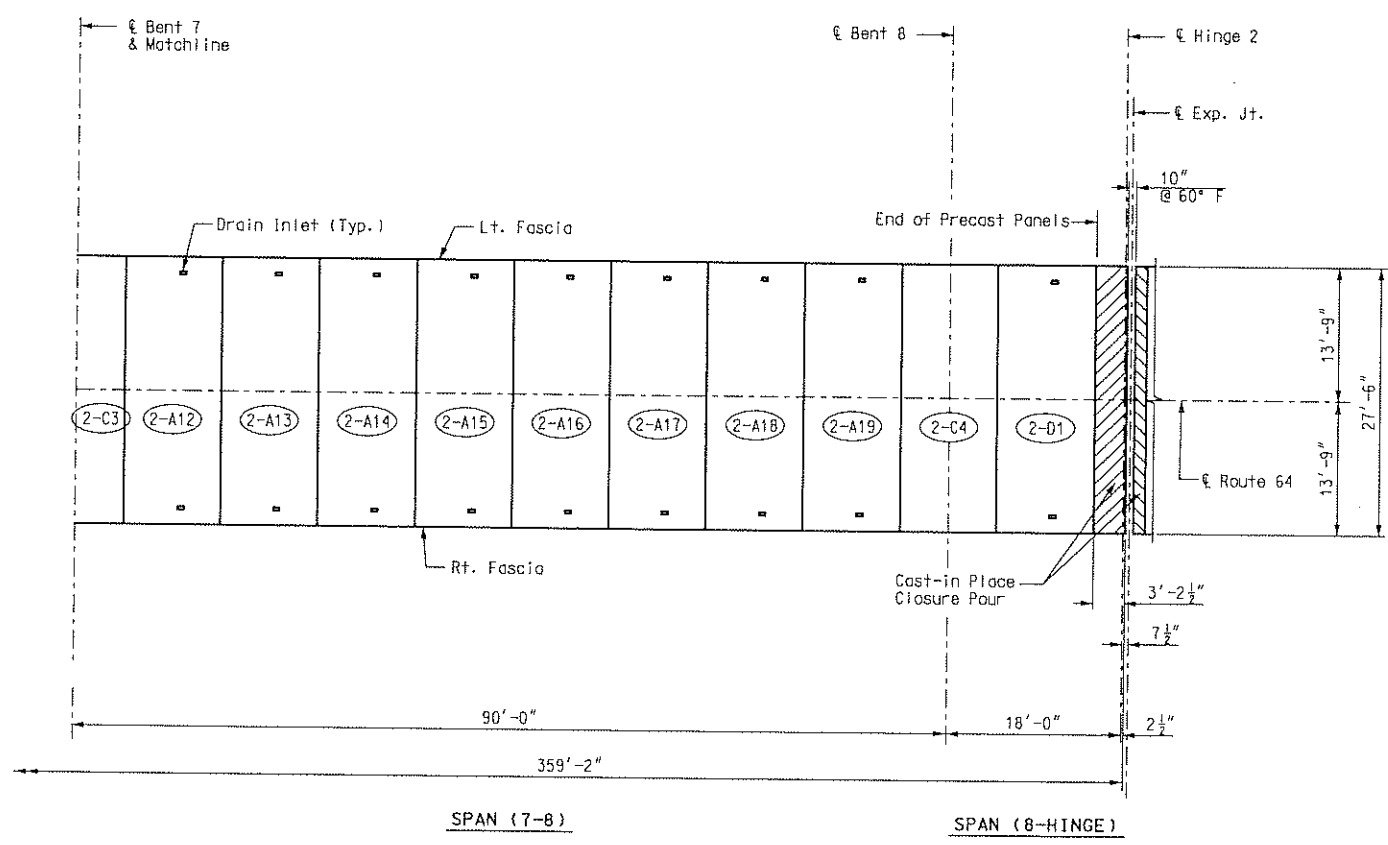


**PLAN**  
Scale: 1"=10'-0"

Note: This drawing is not to scale. Follow Dimensions.

**FINAL PLANS**

I CERTIFY THAT THIS PLAN SHEET ACCURATELY DEPICTS THE CONFIGURATION AND LOCATION OF THE ROADWAY AND ALL ITS APPURTENANT FEATURES, TO THE BEST OF MY KNOWLEDGE, AS I AND MY STAFF HAVE OBSERVED THE CONTRACTOR'S CONSTRUCTION OF THIS PROJECT. I SPECIFICALLY DISCLAIM ANY RESPONSIBILITY FOR THE DESIGN OF THIS PROJECT, EXCEPT AS I AND MY STAFF MAY HAVE MODIFIED OR AUTHORIZED THE MODIFICATION OF THE PROJECT DESIGN DURING ITS CONSTRUCTION; AND I DISCLAIM RESPONSIBILITY FOR THE CONTRACTOR'S ACTUAL CONSTRUCTION OF THE PROJECT, EXCEPT AS I AND MY STAFF MAY HAVE DIRECTED OR ORDERED THAT THE PROJECT BE CONSTRUCTED.




SIGNATURE \_\_\_\_\_ DATE \_\_\_\_\_

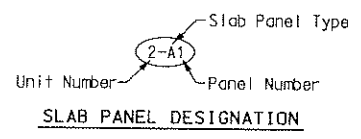

Notes:  
 For Typical Section, see Sheet No. /p18/.  
 For Safety Barrier Curb Details, see Sheet No. /p21/ and /p23/.  
 For Slab Drain Details, see Sheet No. /p20/.  
 For Closure Pour Details, see Sheet No. /p22/.  
 For Expansion Joint Details, see Sheet No. /p24/ and /p26/.  
 Longitudinal dimensions are measured horizontally.

SLAB PANEL LAYOUT  
UNIT 2

State	Proj. No.	Sheet No.
MD	FAS-S935(2)	B17

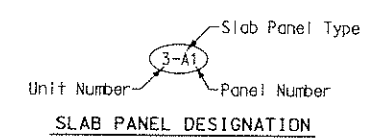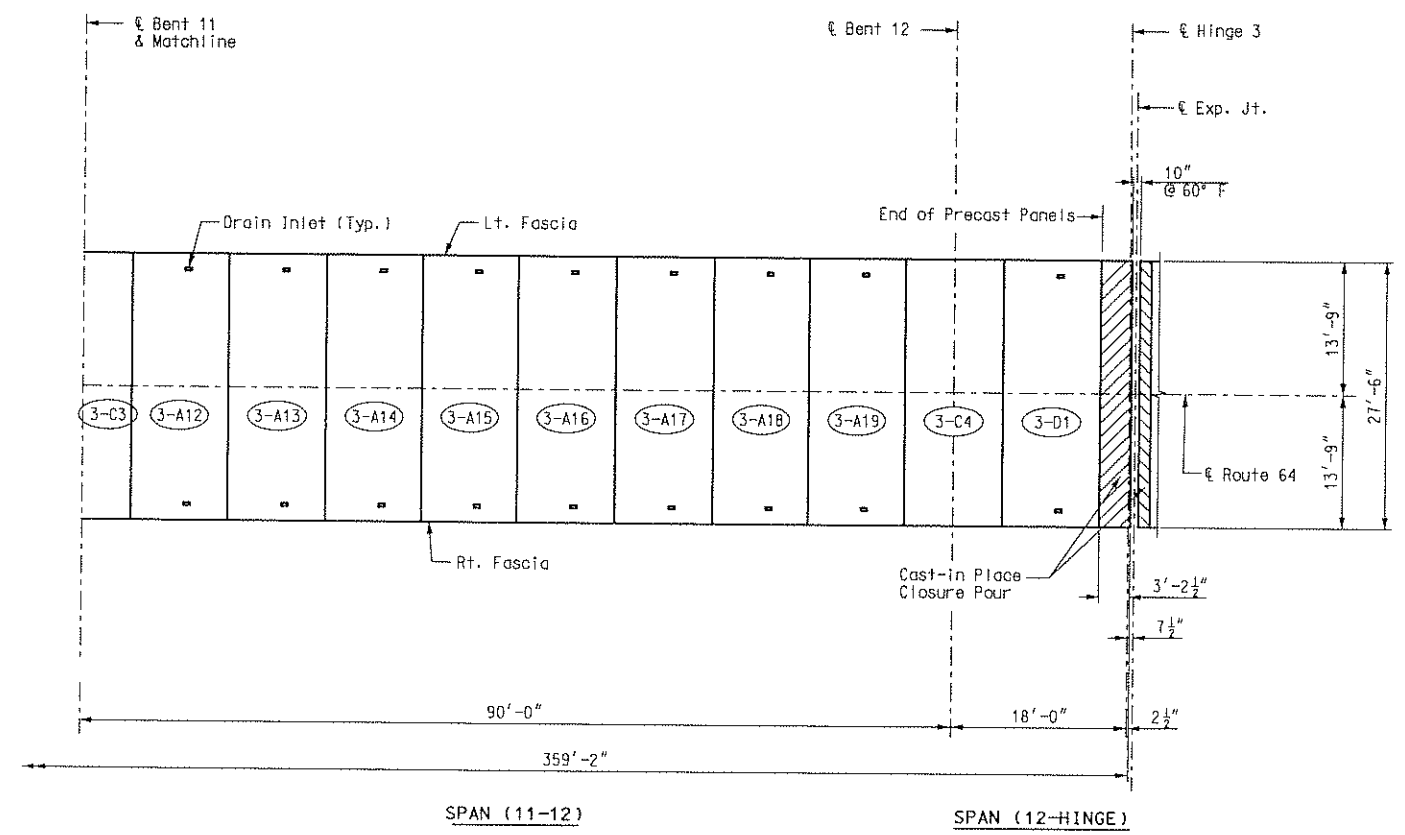
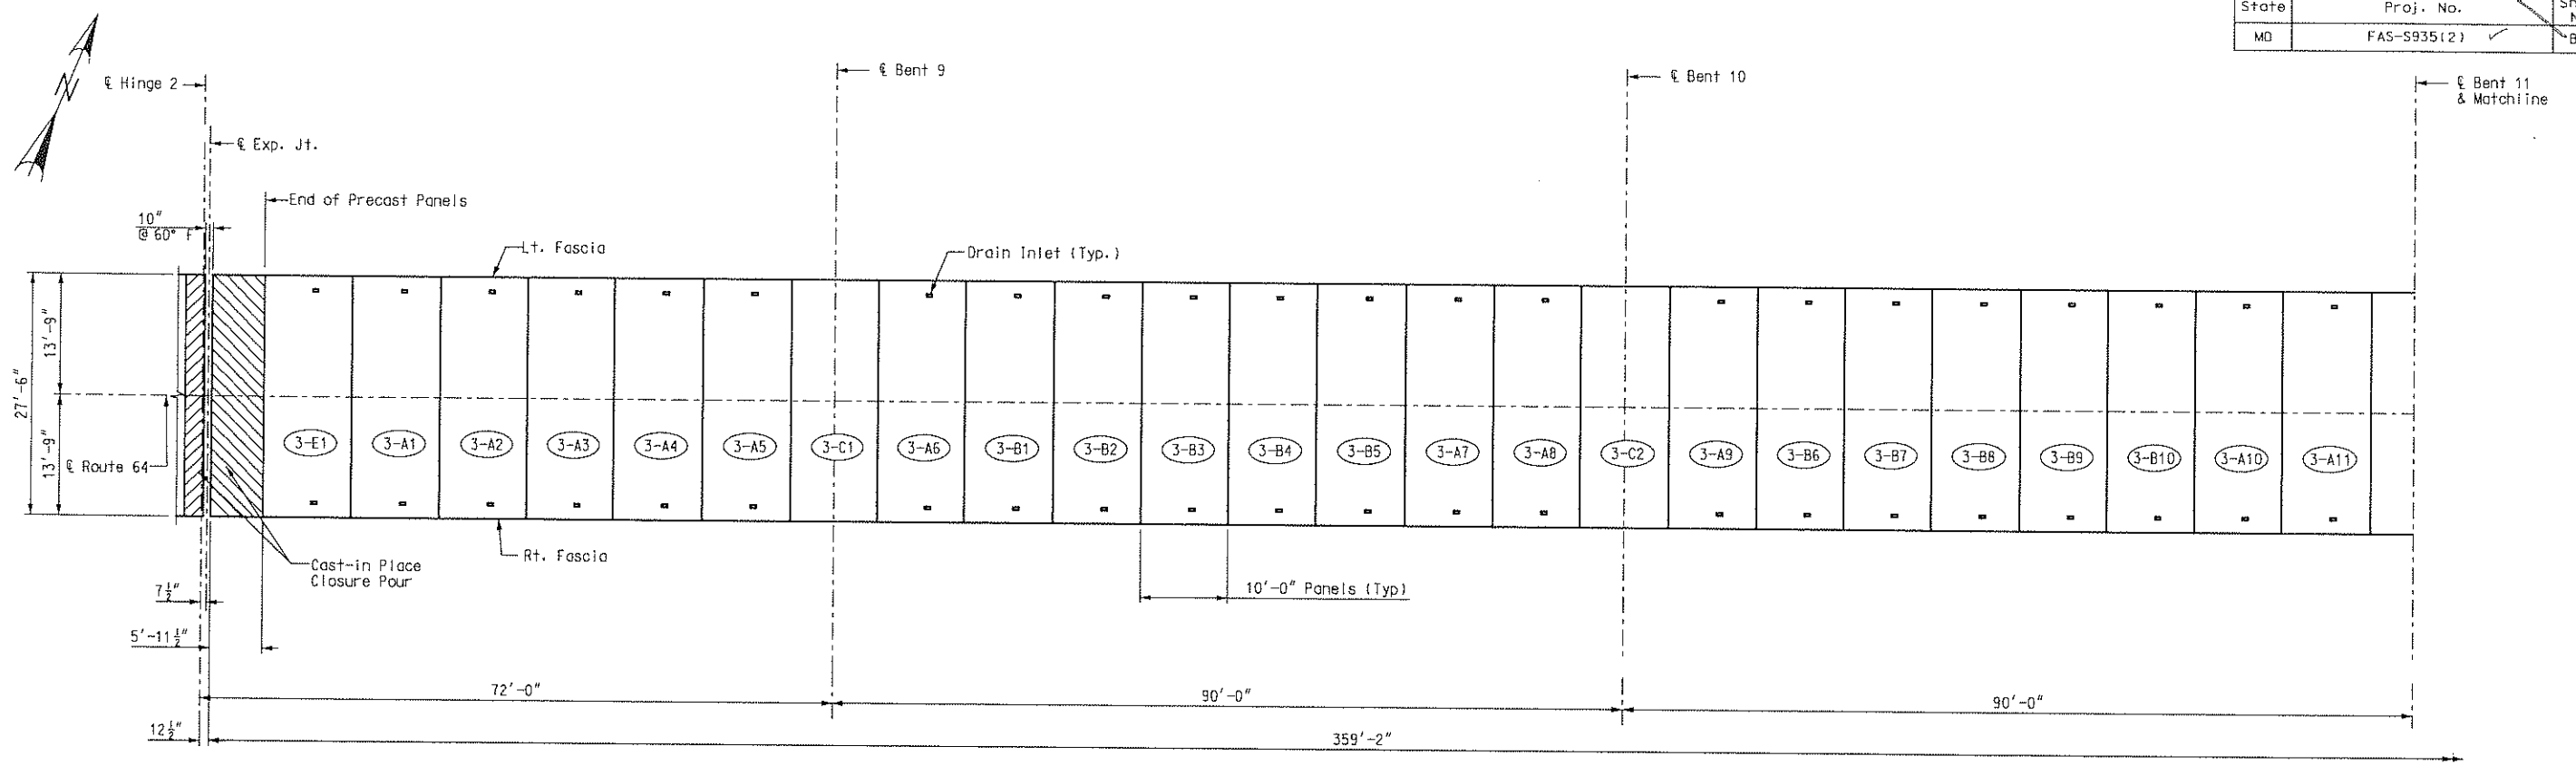


**FINAL PLANS**

I CERTIFY THAT THIS PLAN SHEET ACCURATELY DEPICTS THE CONFIGURATION AND LOCATION OF THE ROADWAY AND ALL ITS APPURTENANT FEATURES, TO THE BEST OF MY KNOWLEDGE, AS I AND MY STAFF HAVE OBSERVED THE CONTRACTOR'S CONSTRUCTION OF THIS PROJECT. I SPECIFICALLY DISCLAIM ANY RESPONSIBILITY FOR THE DESIGN OF THIS PROJECT, EXCEPT AS I AND MY STAFF MAY HAVE MODIFIED OR AUTHORIZED THE MODIFICATION OF THE PROJECT DESIGN DURING ITS CONSTRUCTION; AND I DISCLAIM RESPONSIBILITY FOR THE CONTRACTOR'S ACTUAL CONSTRUCTION OF THE PROJECT, EXCEPT AS I AND MY STAFF MAY HAVE DIRECTED OR ORDERED THAT THE PROJECT BE CONSTRUCTED.

SIGNATURE \_\_\_\_\_ DATE \_\_\_\_\_


SLAB PANEL LAYOUT  
UNIT 3

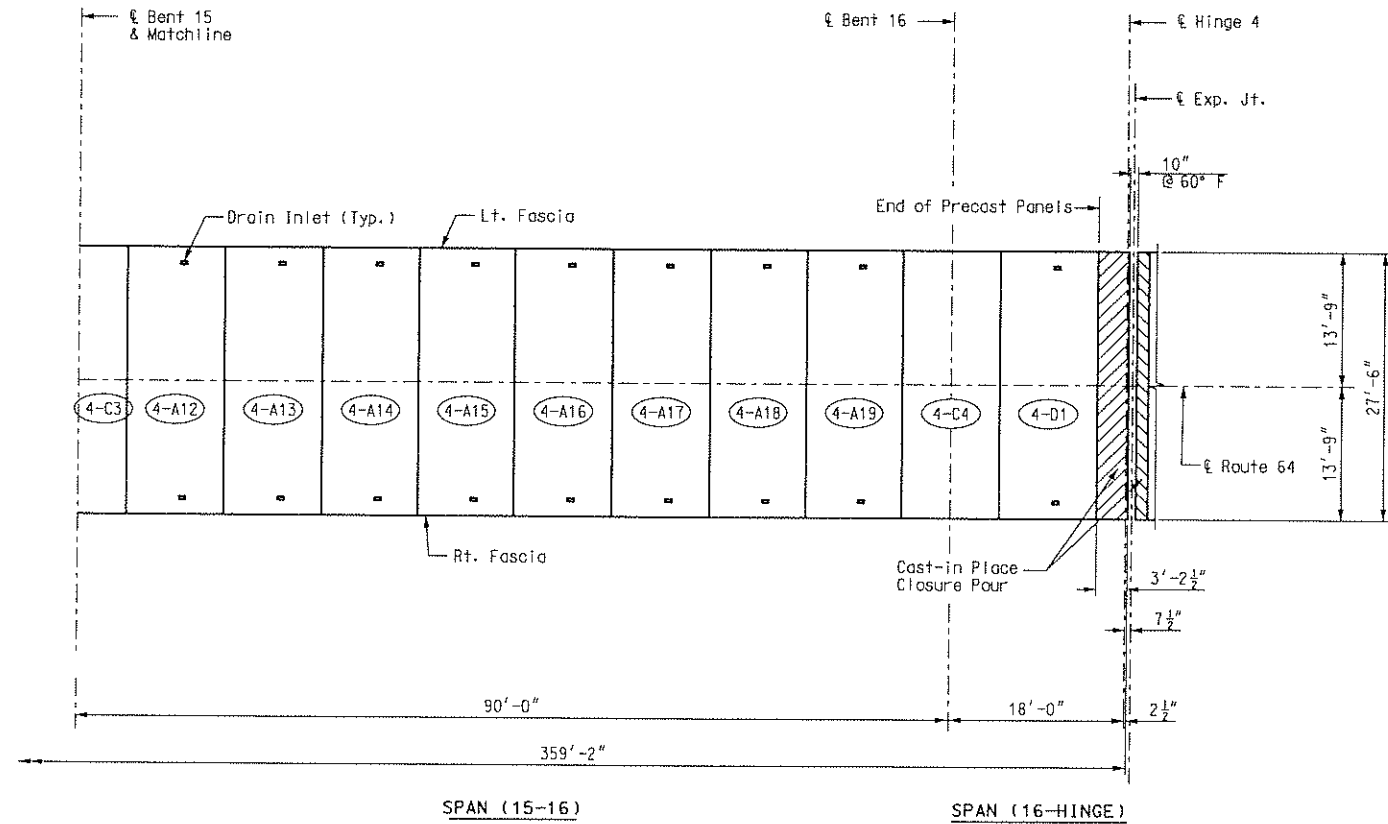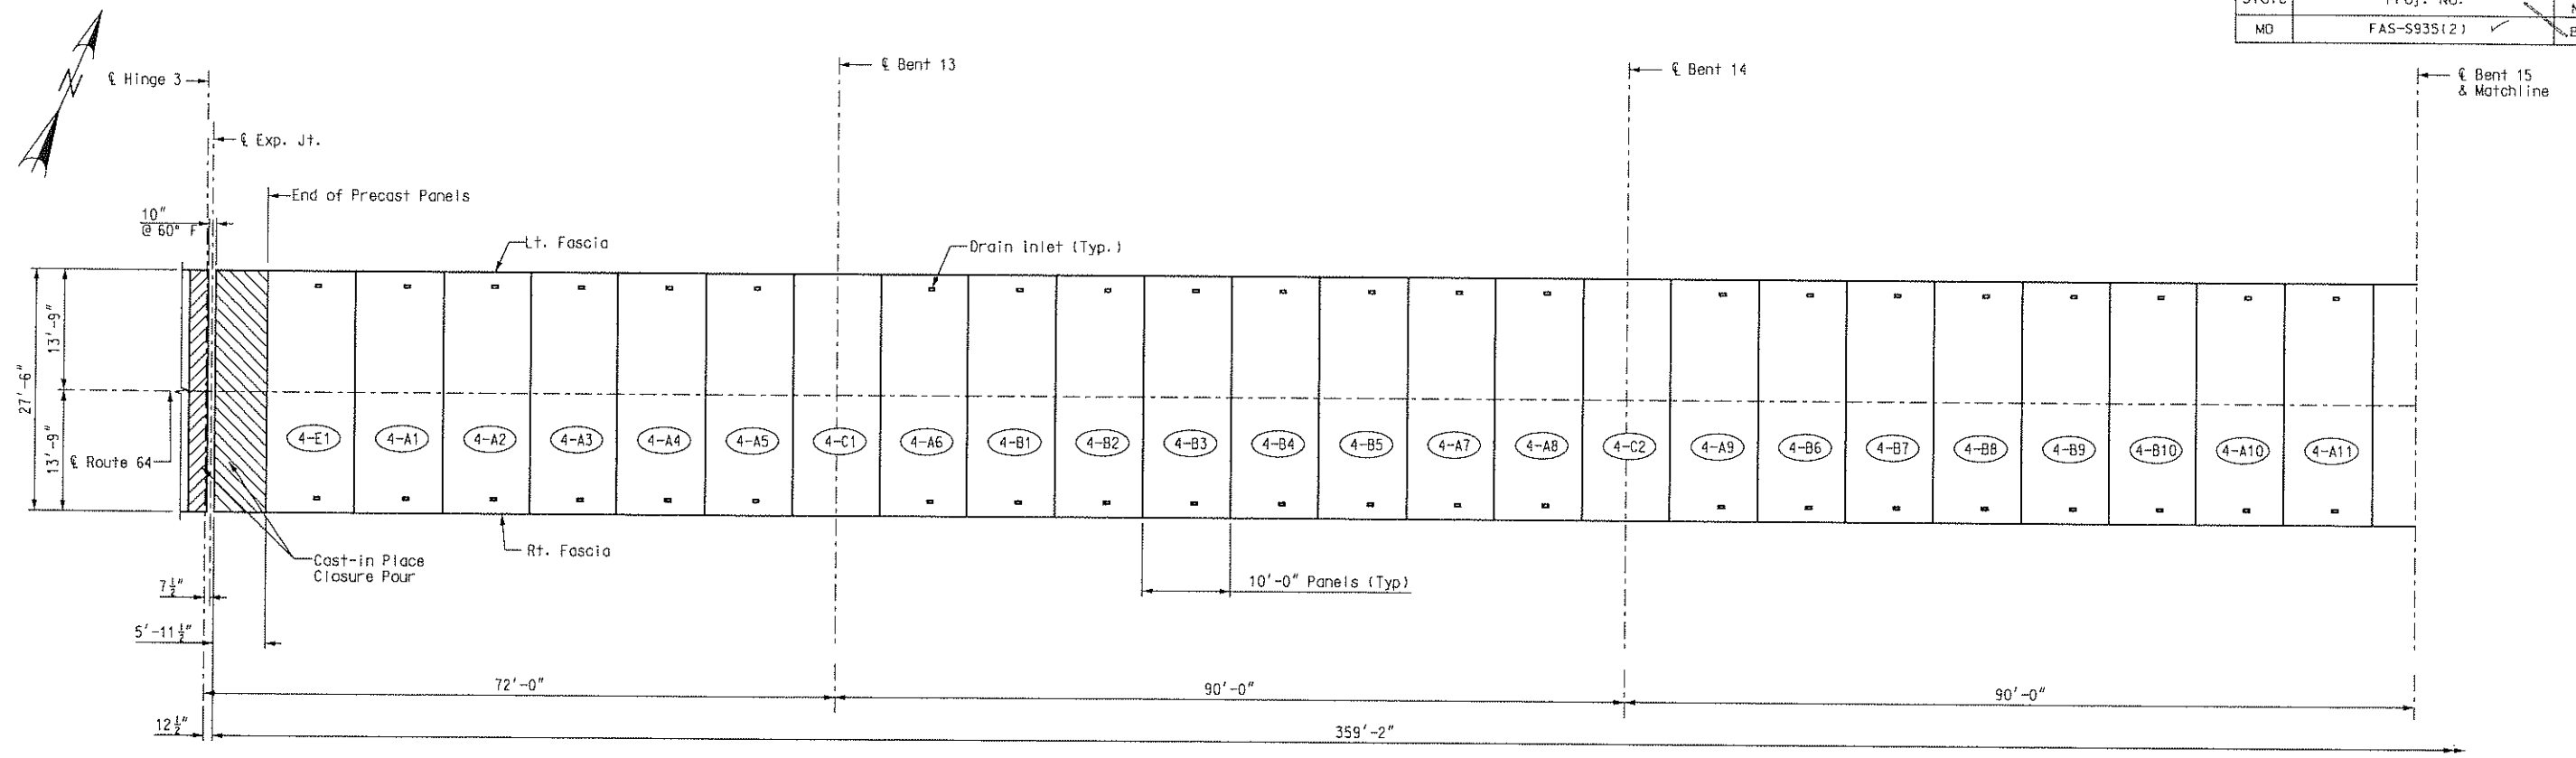


**FINAL PLANS**

I CERTIFY THAT THIS PLAN SHEET ACCURATELY DEPICTS THE CONFIGURATION AND LOCATION OF THE ROADWAY AND ALL ITS APPURTENANT FEATURES, TO THE BEST OF MY KNOWLEDGE, AS I AND MY STAFF HAVE OBSERVED THE CONTRACTOR'S CONSTRUCTION OF THIS PROJECT. I SPECIFICALLY DISCLAIM ANY RESPONSIBILITY FOR THE DESIGN OF THIS PROJECT, EXCEPT AS I AND MY STAFF MAY HAVE MODIFIED OR AUTHORIZED THE MODIFICATION OF THE PROJECT DESIGN DURING ITS CONSTRUCTION; AND I DISCLAIM RESPONSIBILITY FOR THE CONTRACTOR'S ACTUAL CONSTRUCTION OF THE PROJECT, EXCEPT AS I AND MY STAFF MAY HAVE DIRECTED OR ORDERED THAT THE PROJECT BE CONSTRUCTED.

SIGNATURE \_\_\_\_\_ DATE \_\_\_\_\_

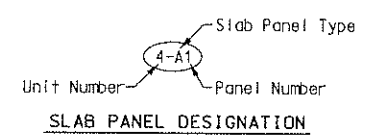

Notes:  
For Typical Section, see Sheet No. /p18/.  
For Safety Barrier Curb Details, see Sheet No. /p21/ and /p23/.  
For Slab Drain Details, see Sheet No. /p20/.  
For Closure Pour Details, see Sheet No. /p22/.  
For Expansion Joint Details, see Sheet No. /p24/ and /p26/.  
Longitudinal dimensions are measured horizontally.

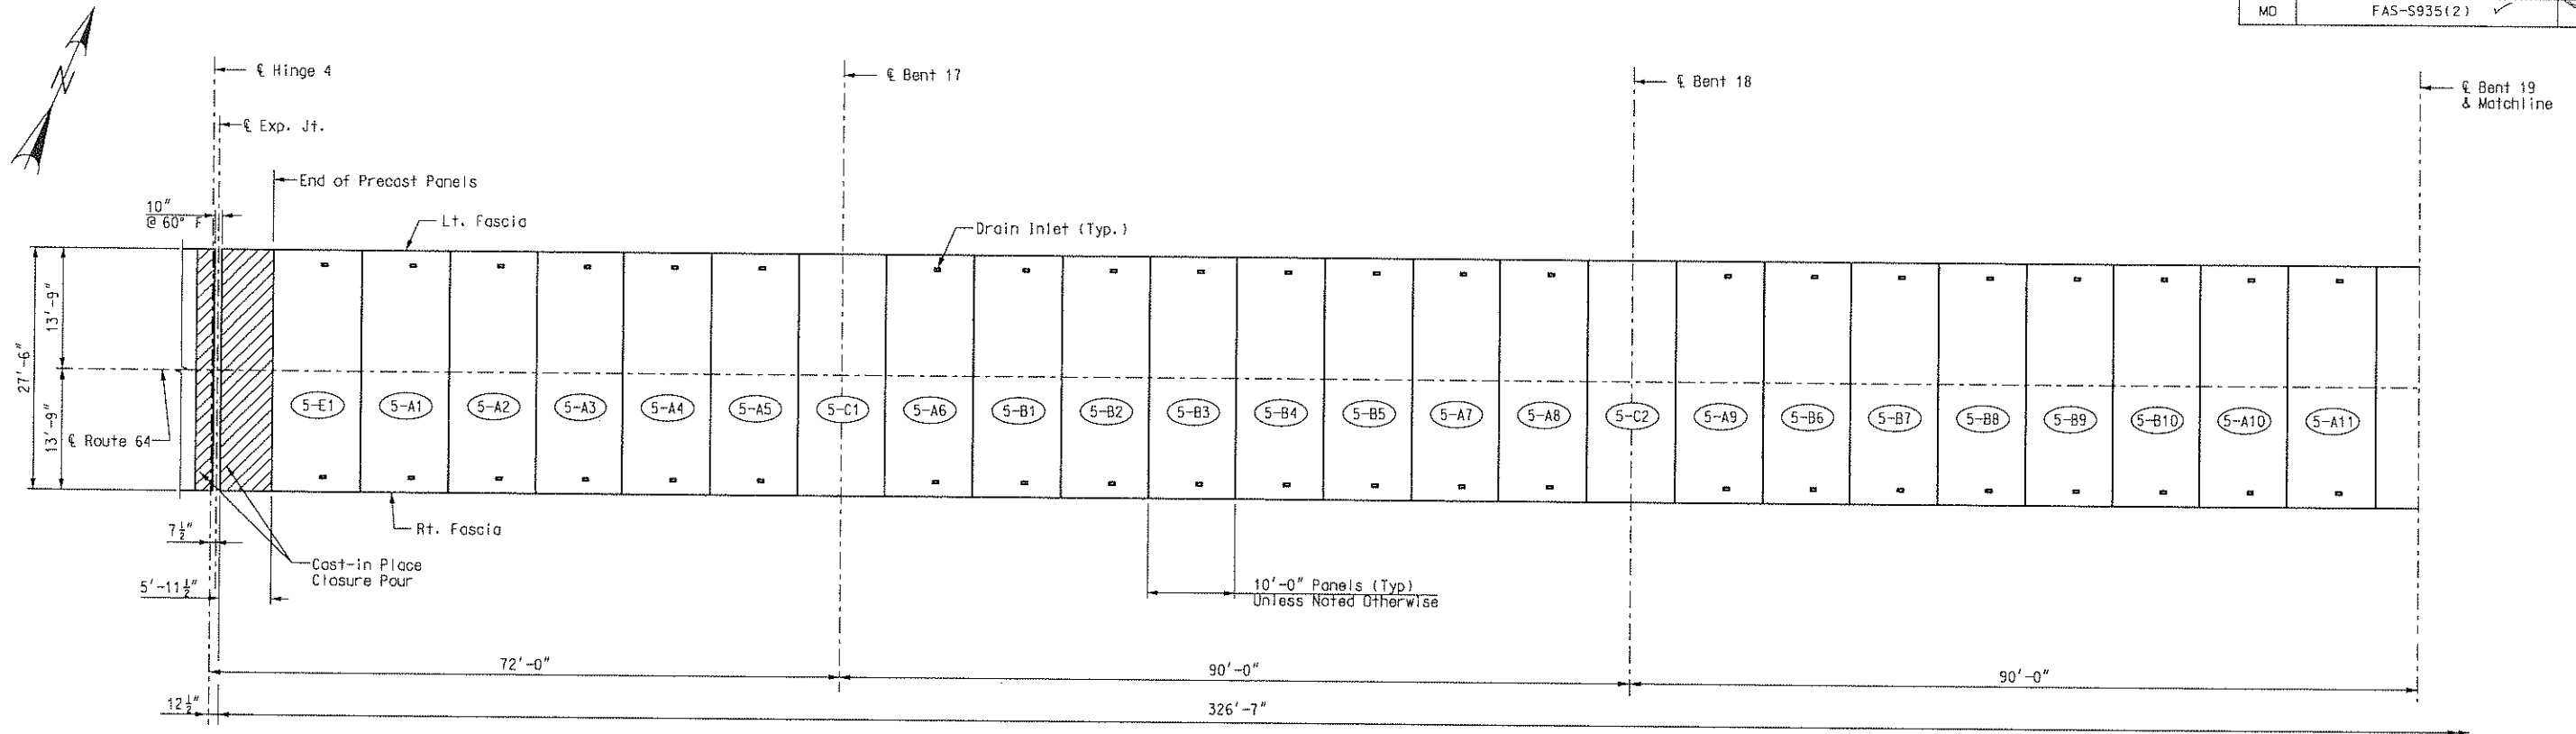

SPAN (HINGE-17)

SPAN (17-18)

SPAN (18-19)


PLAN

Scale: 1"=10'-0"

FINAL PLANS

I CERTIFY THAT THIS PLAN SHEET ACCURATELY DEPICTS THE CONFIGURATION AND LOCATION OF THE ROADWAY AND ALL ITS APPURTENANT FEATURES, TO THE BEST OF MY KNOWLEDGE, AS I AND MY STAFF HAVE OBSERVED THE CONTRACTOR'S CONSTRUCTION OF THIS PROJECT. I SPECIFICALLY DISCLAIM ANY RESPONSIBILITY FOR THE DESIGN OF THIS PROJECT, EXCEPT AS I AND MY STAFF MAY HAVE MODIFIED OR AUTHORIZED THE MODIFICATION OF THE PROJECT DESIGN DURING ITS CONSTRUCTION; AND I DISCLAIM RESPONSIBILITY FOR THE CONTRACTOR'S ACTUAL CONSTRUCTION OF THE PROJECT, EXCEPT AS I AND MY STAFF MAY HAVE DIRECTED OR ORDERED THAT THE PROJECT BE CONSTRUCTED.


SIGNATURE \_\_\_\_\_ DATE \_\_\_\_\_

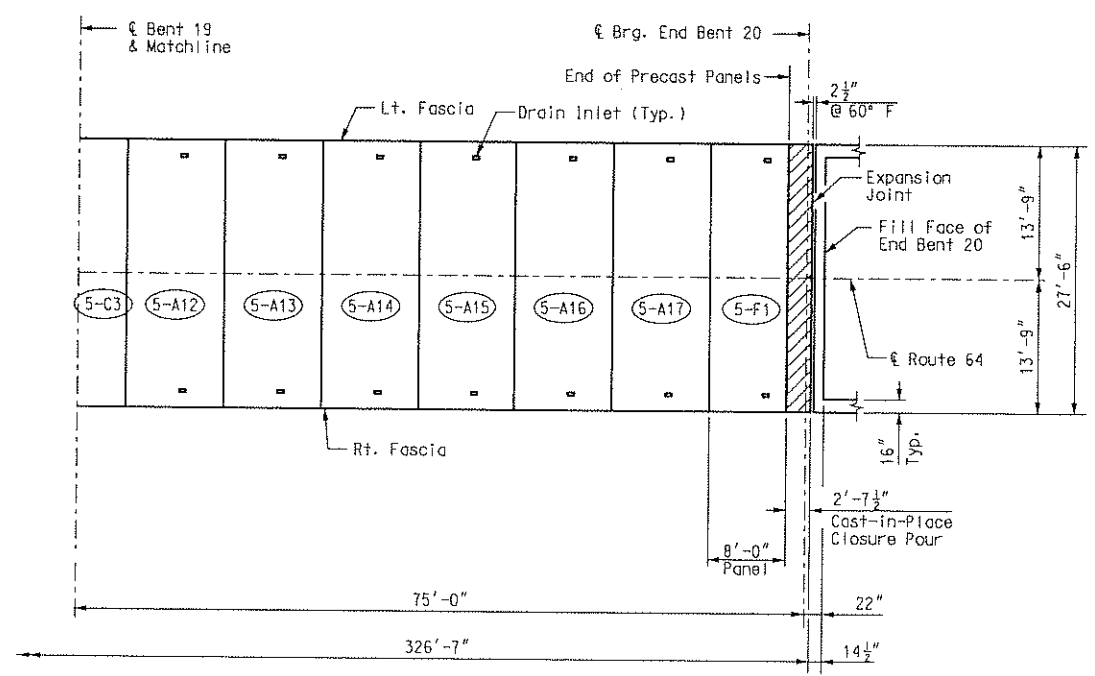

SPAN (19-20)

PLAN


Scale: 1"=10'-0"

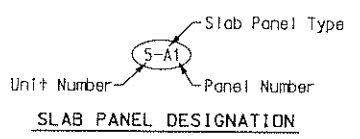

Notes:  
 For Typical Section, see Sheet No. /p18/.  
 For Safety Barrier Curb Details, see Sheet No. /p21/ and /p23/.  
 For Slab Drain Details, see Sheet No. /p20/.  
 For Closure Pour Details, see Sheet No. /p22/.  
 For Expansion Joint Details, see Sheet No. /p24/ and /p26/.  
 Longitudinal dimensions are measured horizontally.


SLAB PANEL LAYOUT  
 UNIT 5

State	Proj. No.	Sheet No.
MD	FAS-S935(2)	B20

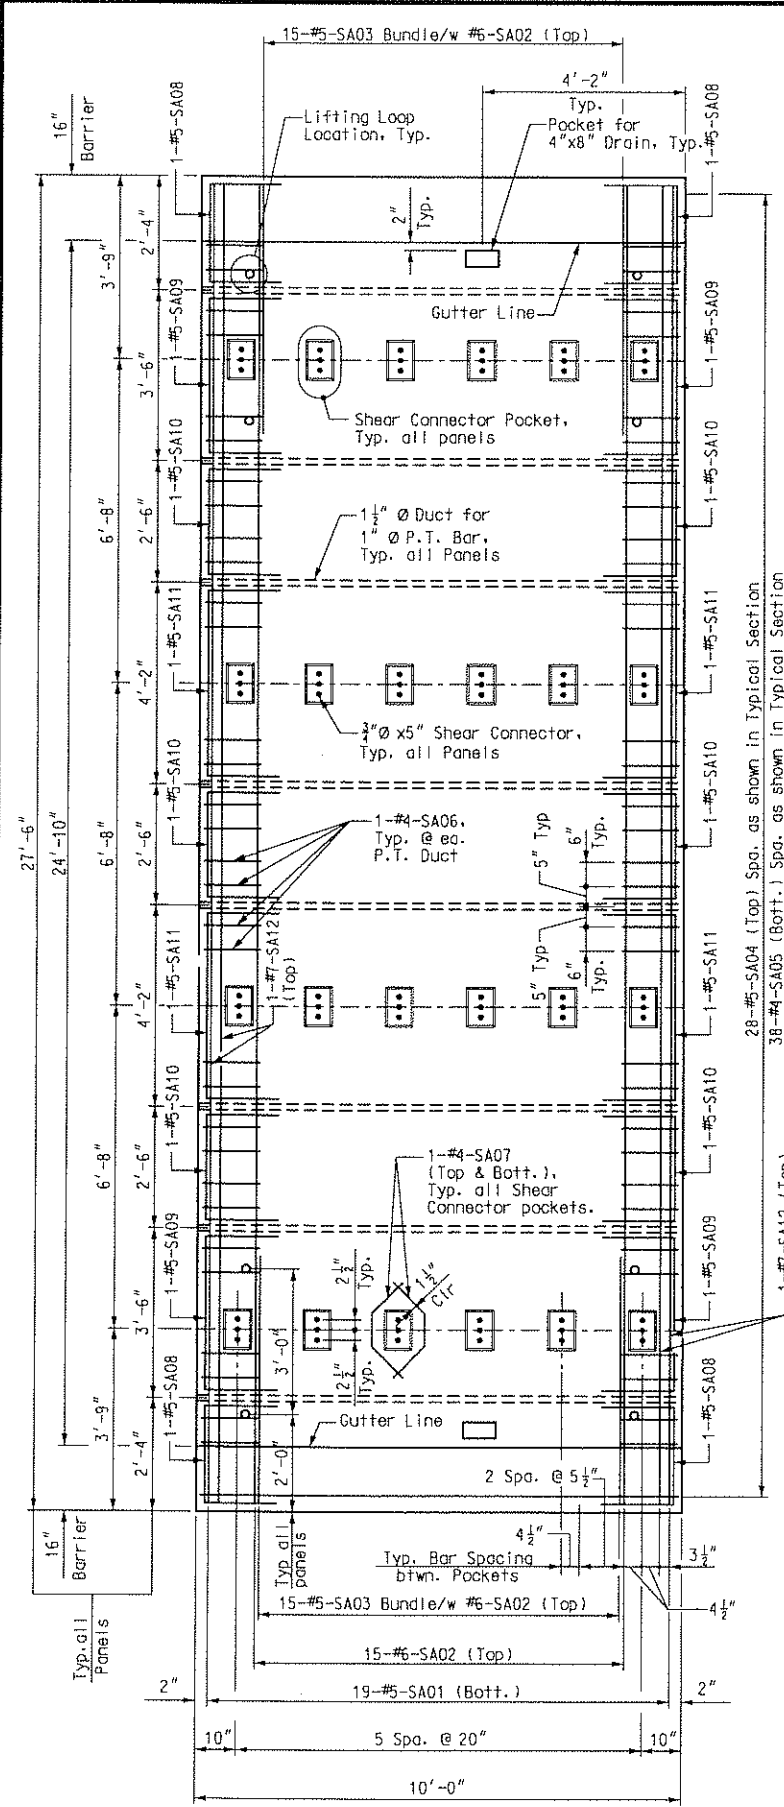

**PANEL TYPE A**


Note: Barrier Reinforcing not shown for clarity.

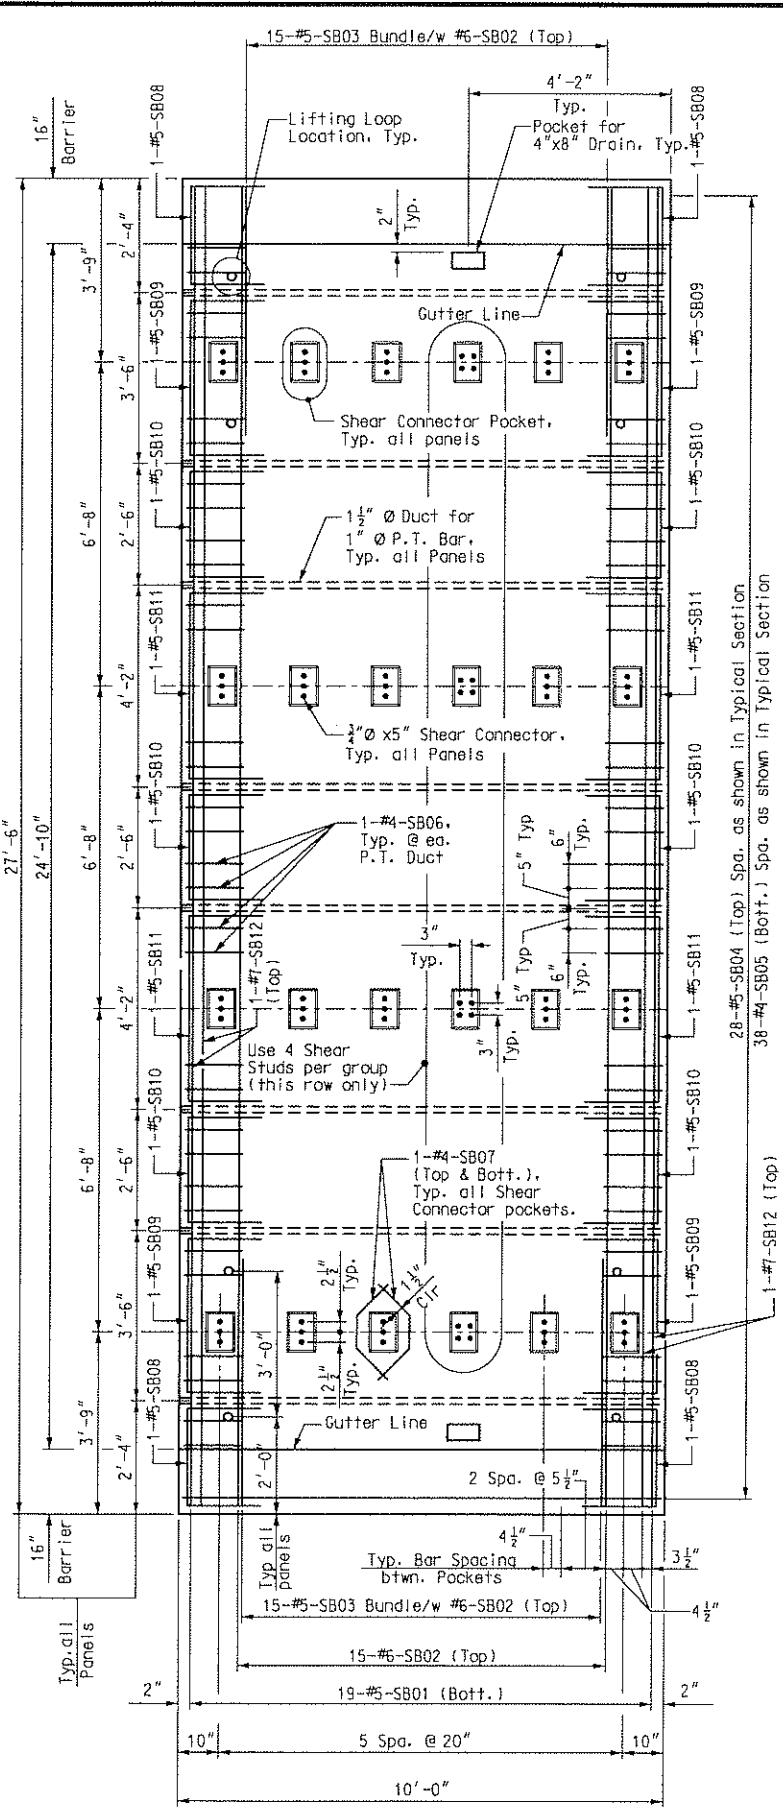

**PANEL TYPE B**

Note: Barrier Reinforcing not shown for clarity.

Scale: 1/2"=1'-0"

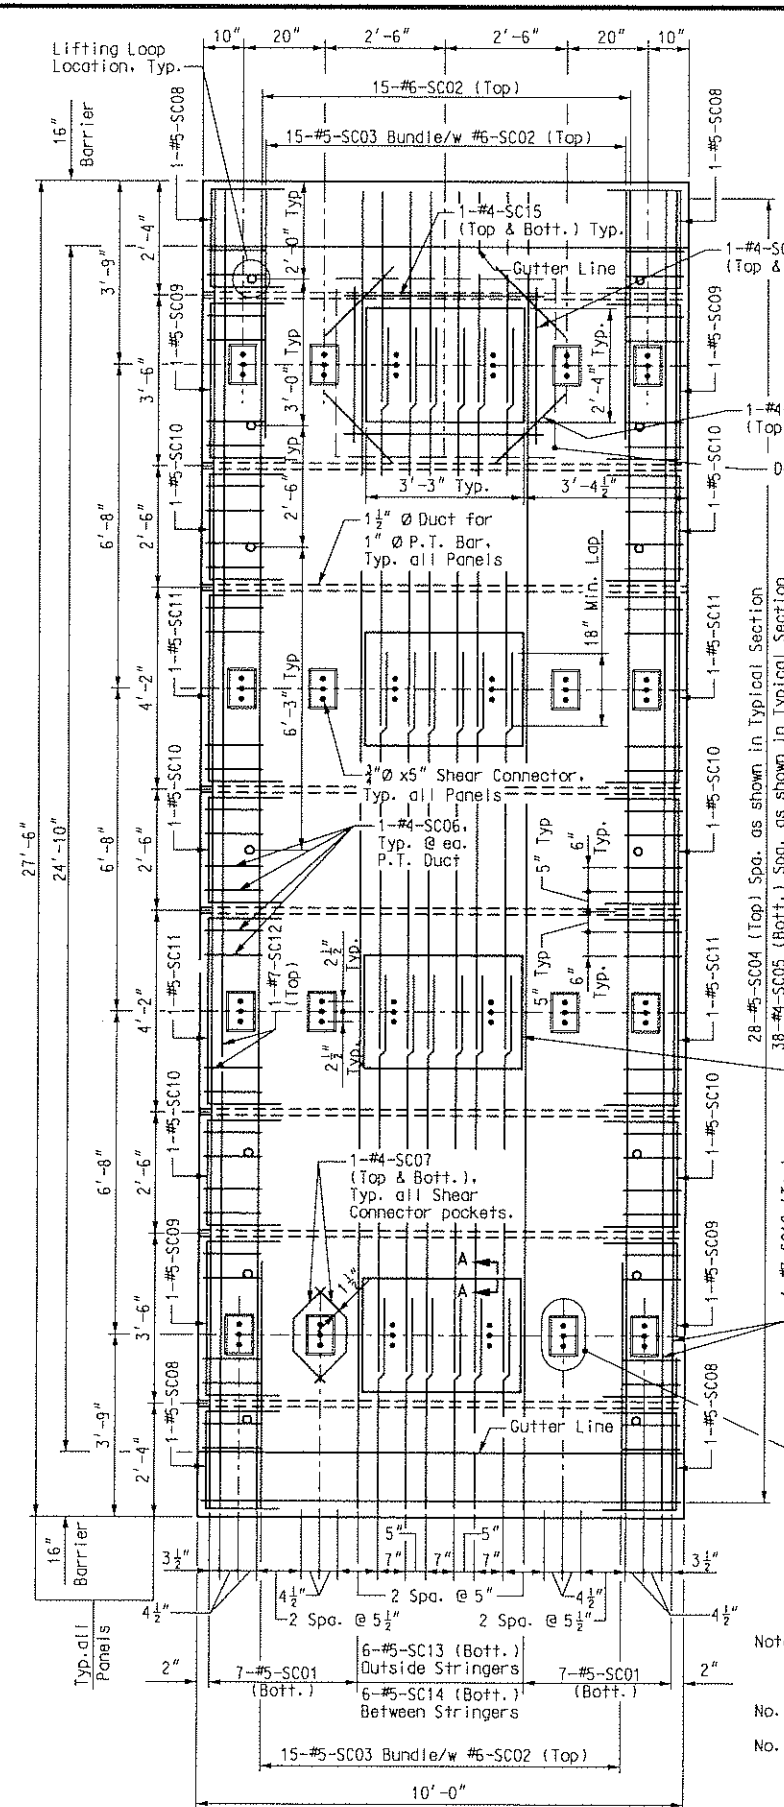

**PANEL TYPE C**

Note: Barrier Reinforcing not shown for clarity.


Scale: 1/2"=1'-0"

**SLAB PANEL TYPES A, B, AND C**

**FINAL PLANS**  
 I CERTIFY THAT THIS PLAN SHEET ACCURATELY DEPICTS THE CONFIGURATION AND LOCATION OF THE ROADWAY AND ALL ITS APPURTENANT FEATURES, TO THE BEST OF MY KNOWLEDGE, AS I AND MY STAFF HAVE OBSERVED THE CONTRACTOR'S CONSTRUCTION OF THIS PROJECT. I SPECIFICALLY DISCLAIM ANY RESPONSIBILITY FOR THE DESIGN OF THIS PROJECT, EXCEPT AS I AND MY STAFF MAY HAVE MODIFIED OR AUTHORIZED THE MODIFICATION OF THE PROJECT DESIGN DURING ITS CONSTRUCTION; AND I DISCLAIM RESPONSIBILITY FOR THE CONTRACTOR'S ACTUAL CONSTRUCTION OF THE PROJECT, EXCEPT AS I AND MY STAFF MAY HAVE DIRECTED OR ORDERED THAT THE PROJECT BE CONSTRUCTED.


SIGNATURE \_\_\_\_\_ DATE \_\_\_\_\_

Blockout for existing stringer post-tensioning. Field verify locations and size prior to casting Slab Panels Type C.

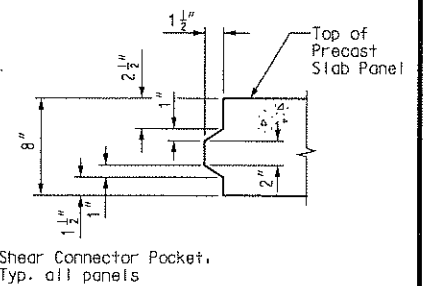


**SECTION A-A**  
 Scale: 1 1/2" = 1'


- Notes:
- For Barrier Reinforcing see Sheet No. /p21/.
  - For Typical Section, see Sheet No. /p18/.
  - For Shear Connector Details, see Sheet No. /p08/.
  - For Shear Connector Pocket Details, see Sheet No. /p18/.
  - For Shear Key Details, see Sheet No. /p19/.
  - For Drain Details, see Sheet No. /p20/.
  - P.T. bar and coupler blockouts not shown for clarity.
  - At Contractors option, Panel Type C may be constructed cast-in-place at no additional cost to owner.

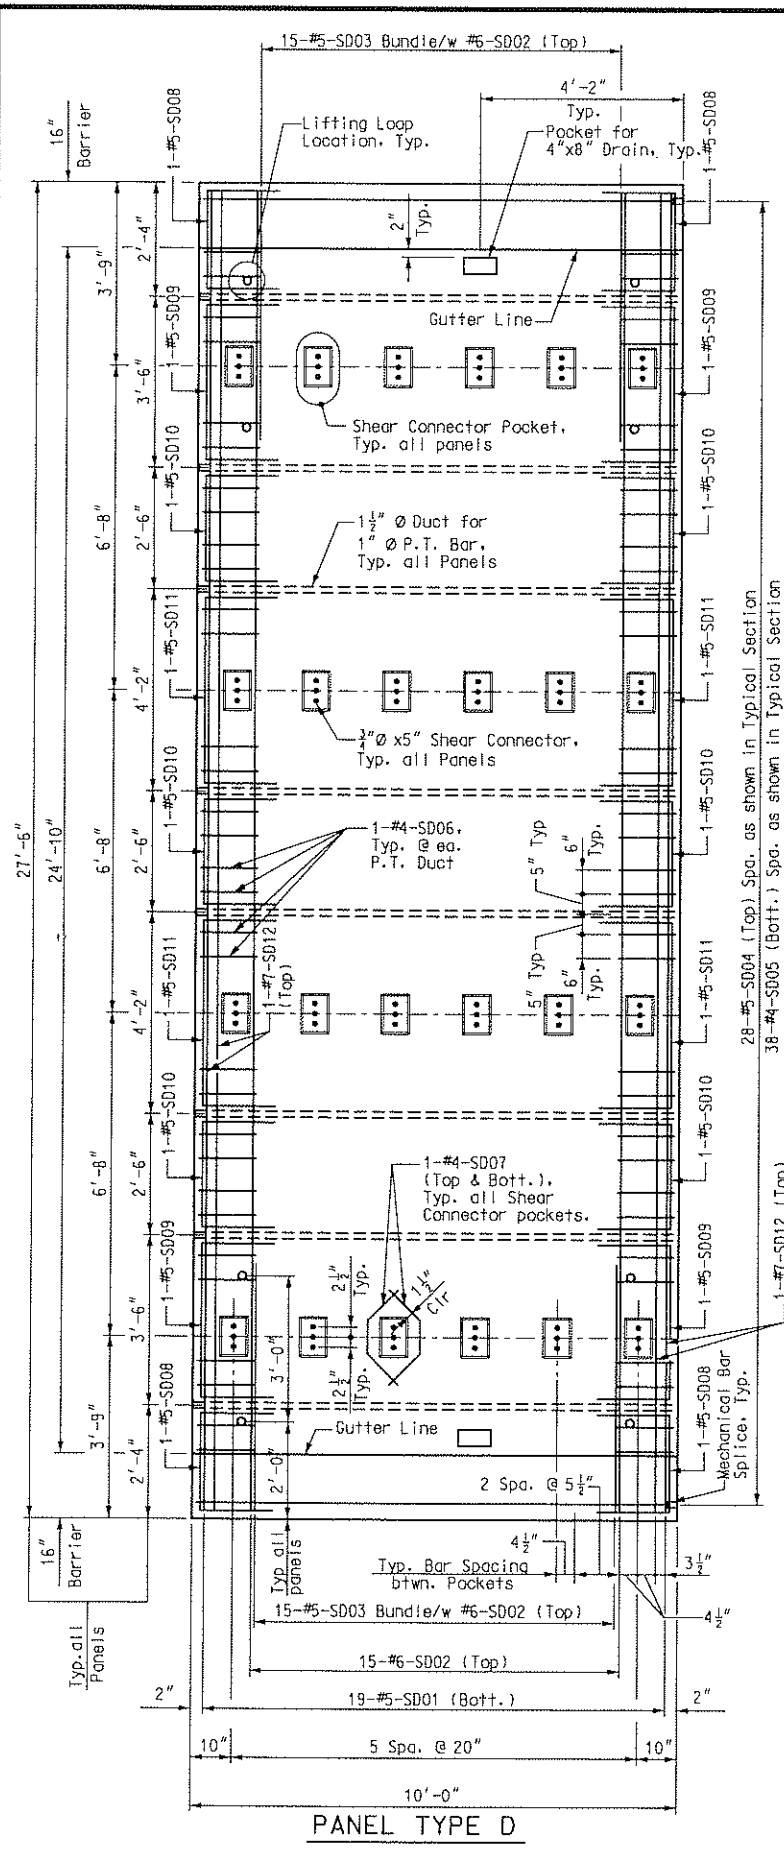

**PANEL TYPE D**  
 Scale: 1/2"=1'-0"  
 Note: Barrier Reinforcing not shown for clarity.

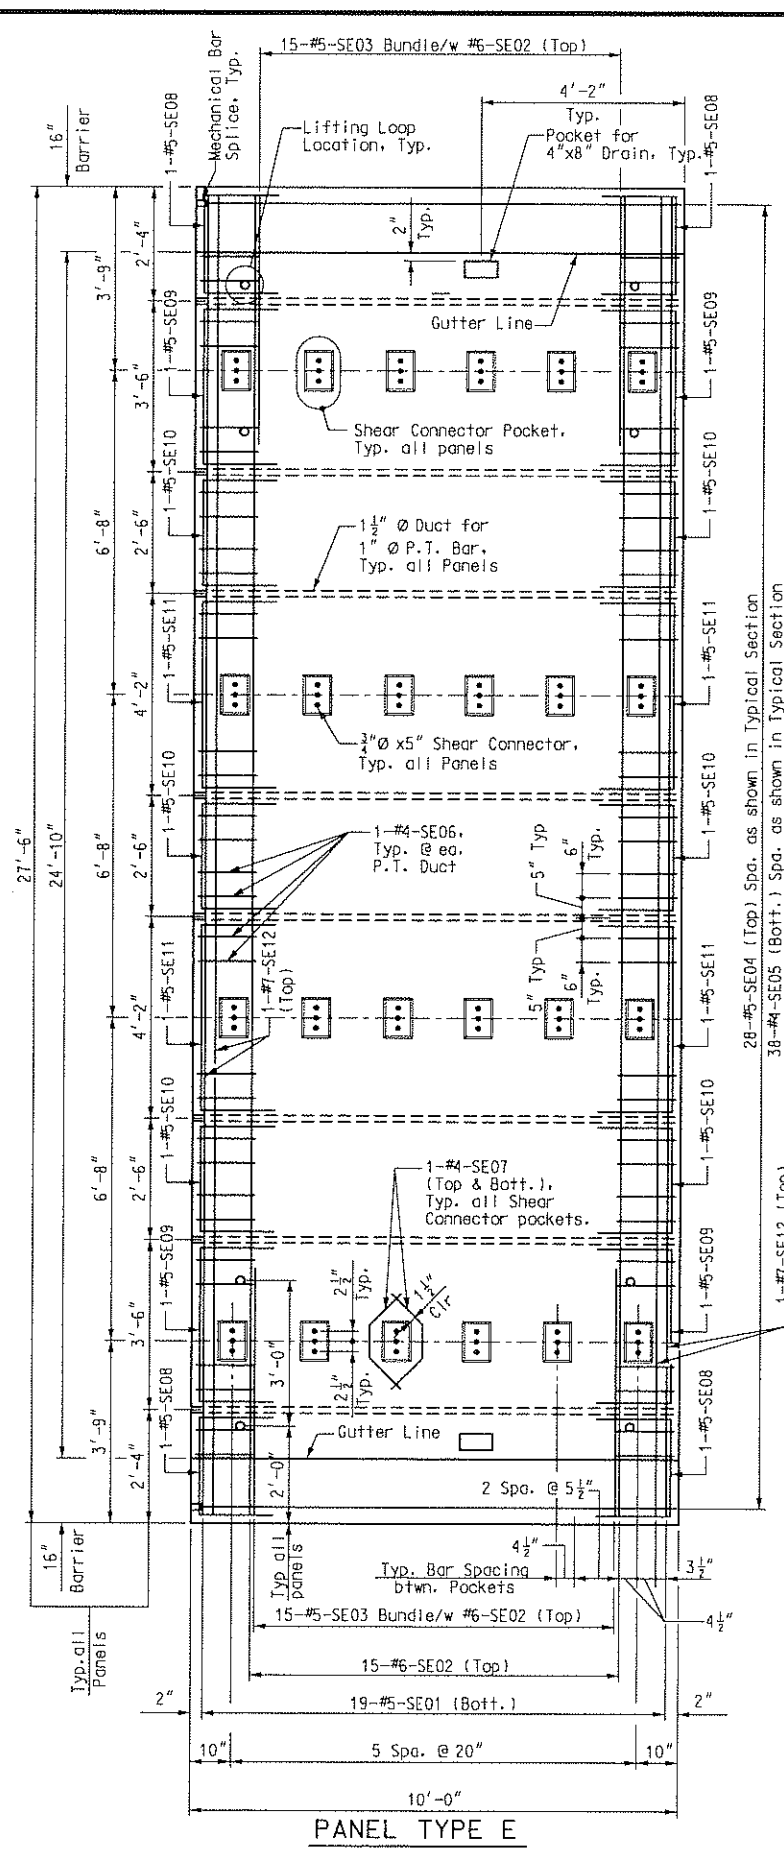

**PANEL TYPE E**  
 Note: Barrier Reinforcing not shown for clarity. Panel Type E is identical to Panel Type D except for orientation of shear keys and Mechanical Bar Splices.

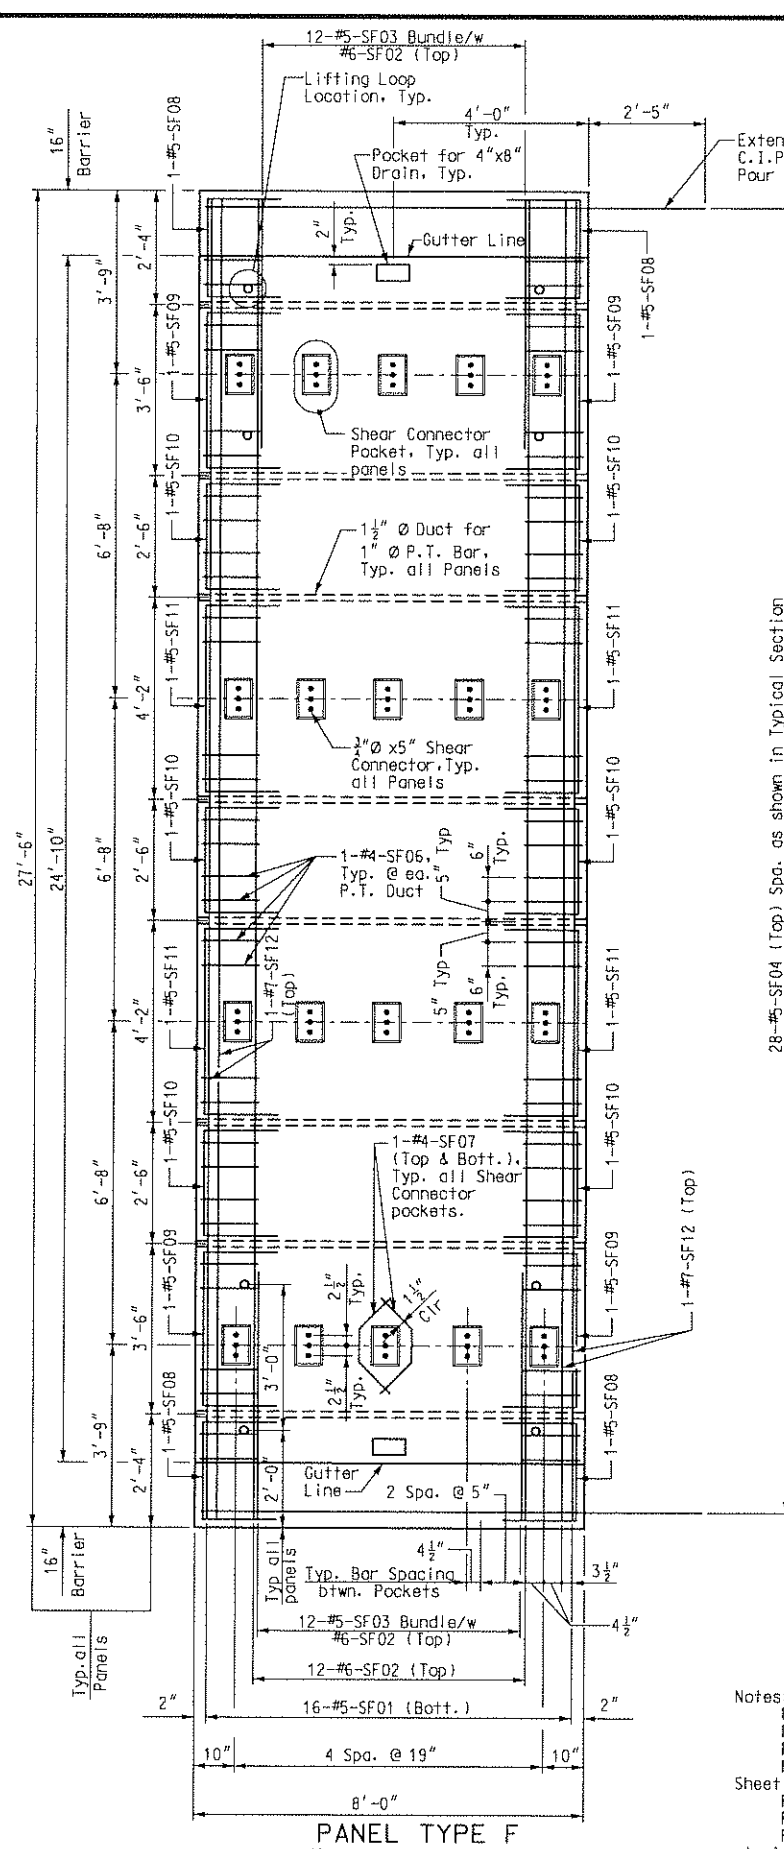

**PANEL TYPE F**  
 Scale: 1/2"=1'-0"  
 Note: Barrier Reinforcing not shown for clarity.



28-#5-SD04 (Top) Spa. as shown in Typical Section  
 38-#4-SD05 (Bott.) Spa. as shown in Typical Section

**FINAL PLANS**  
 I CERTIFY THAT THIS PLAN SHEET ACCURATELY DEPICTS THE CONFIGURATION AND LOCATION OF THE ROADWAY AND ALL ITS APPURTENANT FEATURES, TO THE BEST OF MY KNOWLEDGE, AS I AND MY STAFF HAVE DERIVED THE CONTRACTOR'S CONSTRUCTION OF THIS PROJECT. I SPECIFICALLY DISCLAIM ANY RESPONSIBILITY FOR THE DESIGN OF THIS PROJECT, EXCEPT AS I AND MY STAFF MAY HAVE MODIFIED OR AUTHORIZED THE MODIFICATION OF THE PROJECT DESIGN DURING ITS CONSTRUCTION; AND I DISCLAIM RESPONSIBILITY FOR THE CONTRACTOR'S ACTUAL CONSTRUCTION OF THE PROJECT, EXCEPT AS I AND MY STAFF MAY HAVE DIRECTED OR ORDERED THAT THE PROJECT BE CONSTRUCTED.

SIGNATURE \_\_\_\_\_ DATE \_\_\_\_\_


Notes:  
 For Barrier Reinforcing, see Sheet /p21/.  
 For Typical Section, see Sheet No. /p18/.  
 For Shear Key Details, see Sheet No. /p19/.  
 For Shear Connector Pocket Details, see Sheet No. /p18/.  
 For Shear Connector Details see Sheet /p08/.  
 For Slab Drain Details, see Sheet No. /p20/.  
 P.T. bar coupler blockouts not shown for clarity.

**SLAB PANEL TYPES D, E AND F**

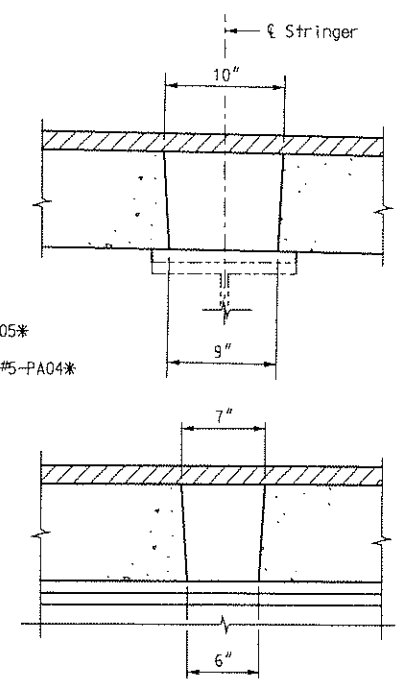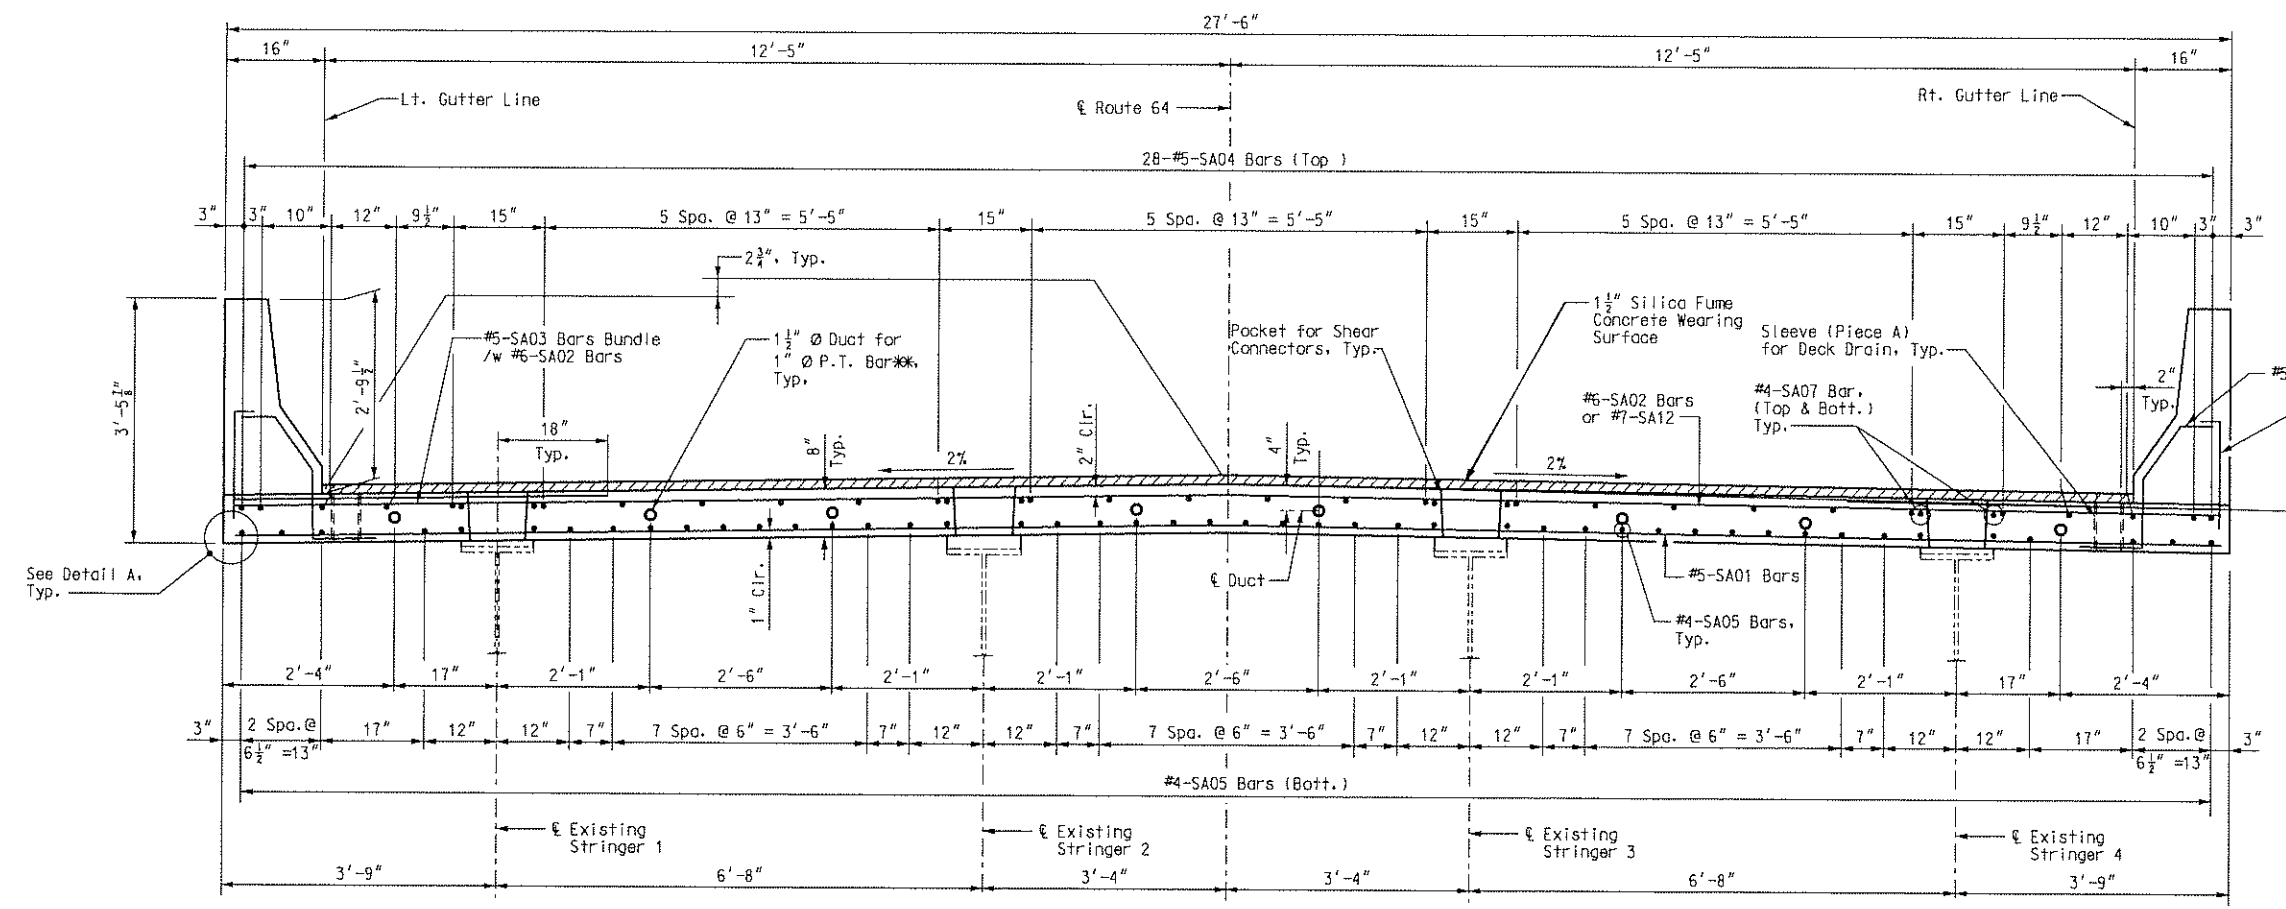


**TYPICAL SECTION**

Scale: 3/4" = 1'  
 Bar Marks shown are for Panel A. Panels B thru F are similar, except use "SB" thru "SF" series.

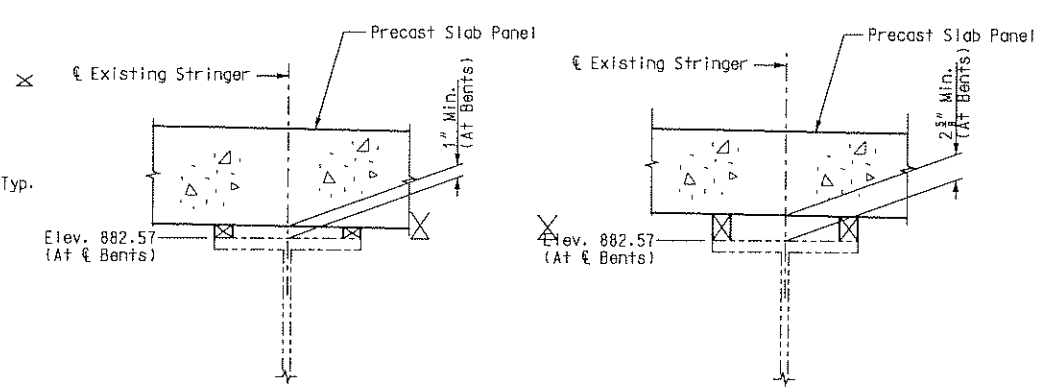

**TYPICAL HAUNCH DETAIL**


Note:  
 If haunch depth exceeds 3", shear connector length shall be increased.  
 Field verify haunch depths prior to placement of precast slab panels.  
 No payment will be made for additional shear connector length, or concrete required for variable haunch.

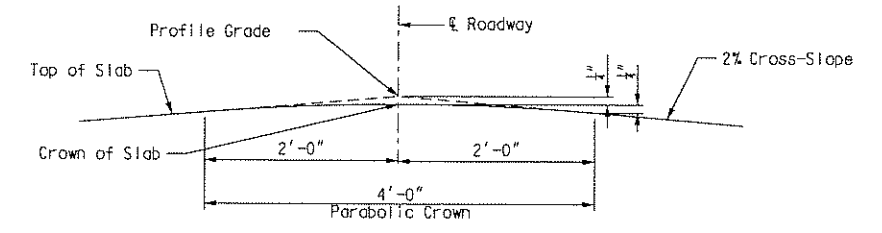

**SLAB CROWN DETAIL**

Notes:  
 For Slab Panel Layouts, see Sheet No. /p12/ thru /p16/.  
 For Slab Panel Types, see Sheet No. /p17/ and /p17a/.  
 For location of Detail B, see Sheet No. /p17/.  
 \* Post-Tensioned Bars shall be stressed to 0.65 f's.  
 For Shear Key Details, see Sheet No. /p19/.  
 For Shear Connector Details, see Sheet No. /p08/.  
 For Safety Barrier Curb Details, see Sheet No. /p21/.  
 \* For spacing of #5-PA04 and #5-PA05 bars, see Safety Barrier Curb Elevation, Sheet No. /p21/.

**SLAB PANEL CROSS SECTION**

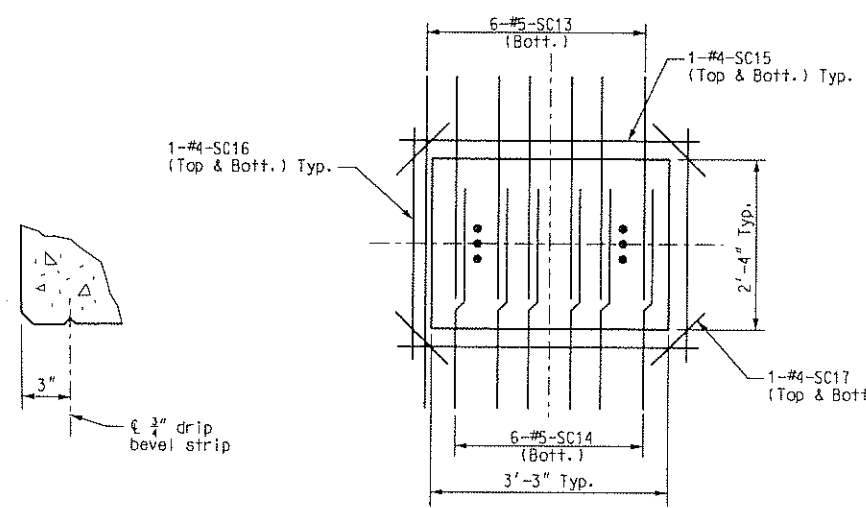


**FINAL PLANS**

I CERTIFY THAT THIS PLAN SHEET ACCURATELY DEPICTS THE CONFIGURATION AND LOCATION OF THE ROADWAY AND ALL ITS APPURTENANT FEATURES, TO THE BEST OF MY KNOWLEDGE, AS I AND MY STAFF HAVE OBSERVED THE CONTRACTOR'S CONSTRUCTION OF THIS PROJECT. I SPECIFICALLY DISCLAIM ANY RESPONSIBILITY FOR THE DESIGN OF THIS PROJECT, EXCEPT AS I AND MY STAFF MAY HAVE MODIFIED OR AUTHORIZED THE MODIFICATION OF THE PROJECT DESIGN DURING ITS CONSTRUCTION; AND I DISCLAIM RESPONSIBILITY FOR THE CONTRACTOR'S ACTUAL CONSTRUCTION OF THE PROJECT, EXCEPT AS I AND MY STAFF MAY HAVE DIRECTED OR ORDERED THAT THE PROJECT BE CONSTRUCTED.

SIGNATURE \_\_\_\_\_ DATE \_\_\_\_\_



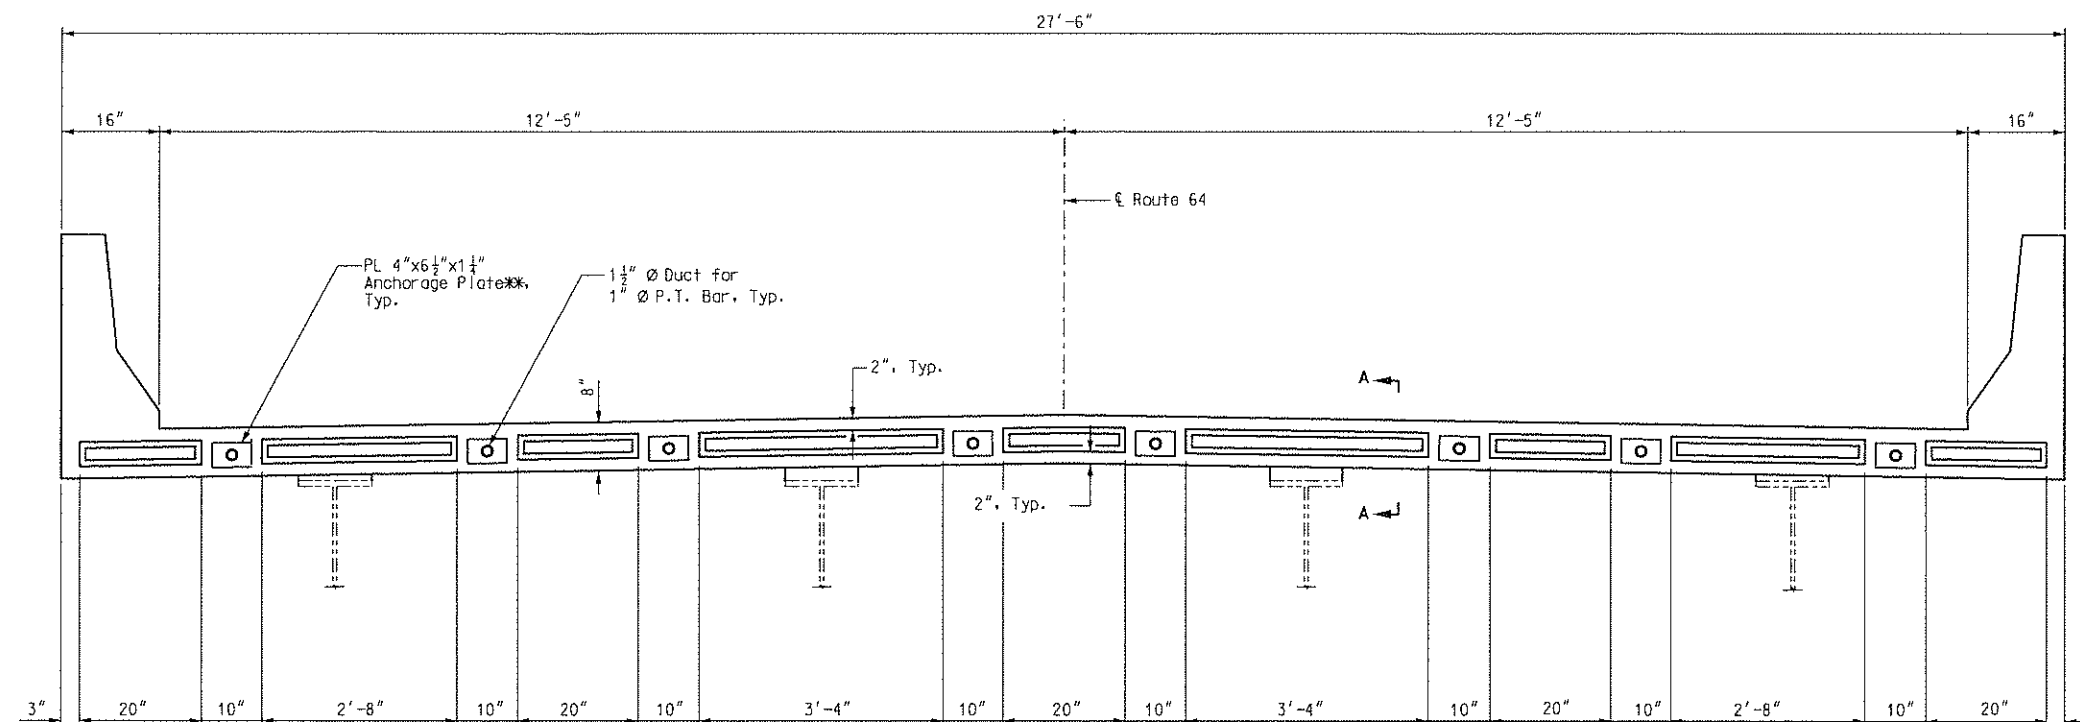


**FINAL PLANS**

I CERTIFY THAT THIS PLAN SHEET ACCURATELY DEPICTS THE CONFIGURATION AND LOCATION OF THE ROADWAY AND ALL ITS APPURTENANT FEATURES, TO THE BEST OF MY KNOWLEDGE, AS I AND MY STAFF HAVE OBSERVED THE CONTRACTOR'S CONSTRUCTION OF THIS PROJECT. I SPECIFICALLY DISCLAIM ANY RESPONSIBILITY FOR THE DESIGN OF THIS PROJECT, EXCEPT AS I AND MY STAFF MAY HAVE MODIFIED OR AUTHORIZED THE MODIFICATION OF THE PROJECT DESIGN DURING ITS CONSTRUCTION; AND I DISCLAIM RESPONSIBILITY FOR THE CONTRACTOR'S ACTUAL CONSTRUCTION OF THE PROJECT, EXCEPT AS I AND MY STAFF MAY HAVE DIRECTED OR ORDERED THAT THE PROJECT BE CONSTRUCTED.


SIGNATURE \_\_\_\_\_ DATE \_\_\_\_\_

**TYPICAL SECTION SHOWING SHEAR KEYS**

Scale: 3/4" = 1'

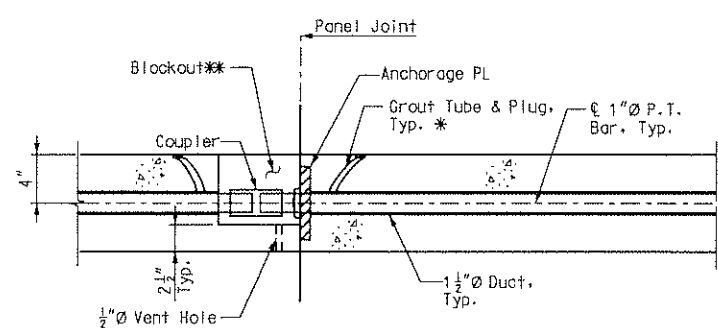

**P.T. BARS IN PRECAST SLAB PANELS**

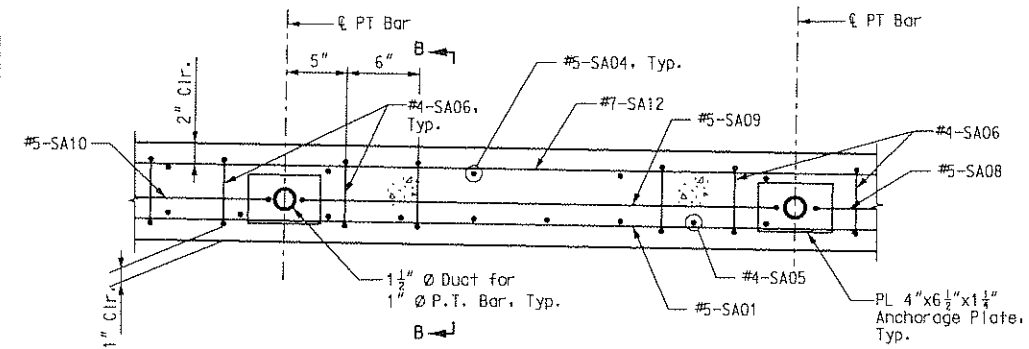


**TYPICAL REINFORCING AT END OF PANEL DETAIL**

Scale: 1 1/2" = 1'

Note: Bars shown for Panel Type A. Other panels similar.


Note:  
 For slab reinforcing, See Sheet Nos. /p17/, /p17a/ and /p18/.  
 \* Grout Tube and Plug shall be capable of withstanding traffic loads. See Special Provisions.  
 \*\* Anchorage System and blockout details shall be determined by the post-tensioning system used.

**SLAB PANEL SHEAR KEY DETAILS**

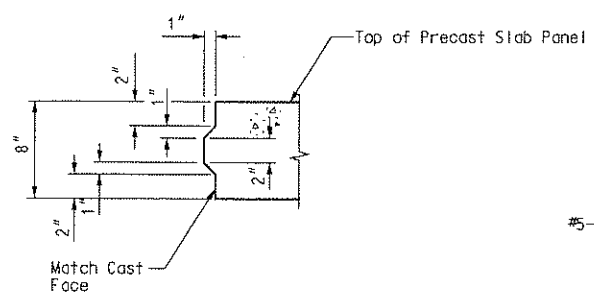


**SECTION A-A**

Scale: 1 1/2" = 1'

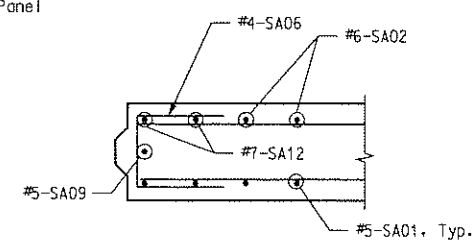


**SECTION B-B**

Note: Bars Shown for Panel Type A. Other Panels Similar.

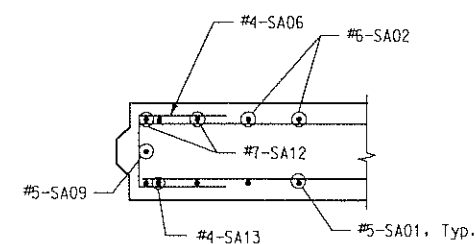

**SECTION C-C AT ANCHORAGE**


Note: Bars Shown for Panel Type A. Other Panels Similar. Anchor Plate Not Shown for Clarity.

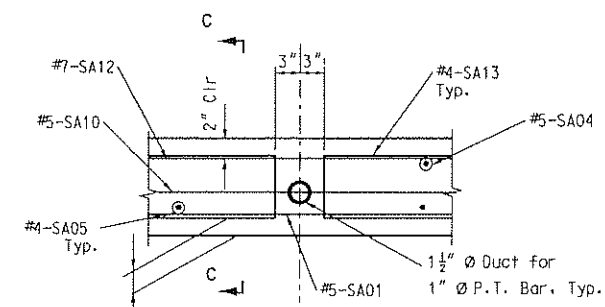


**SECTION AT P.T. DUCT**

Note: Anchor Plate Not Shown for Clarity.


Note: This drawing is not to scale. Follow Dimensions.

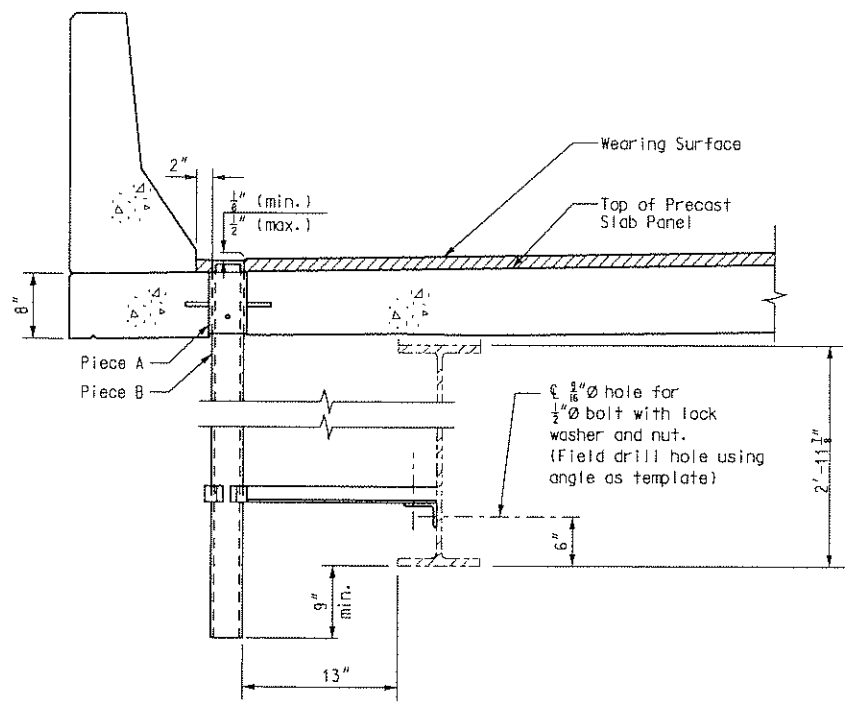


**PART ELEVATION OF SLAB AT DRAIN**  
Scale: 1"=1'-0"

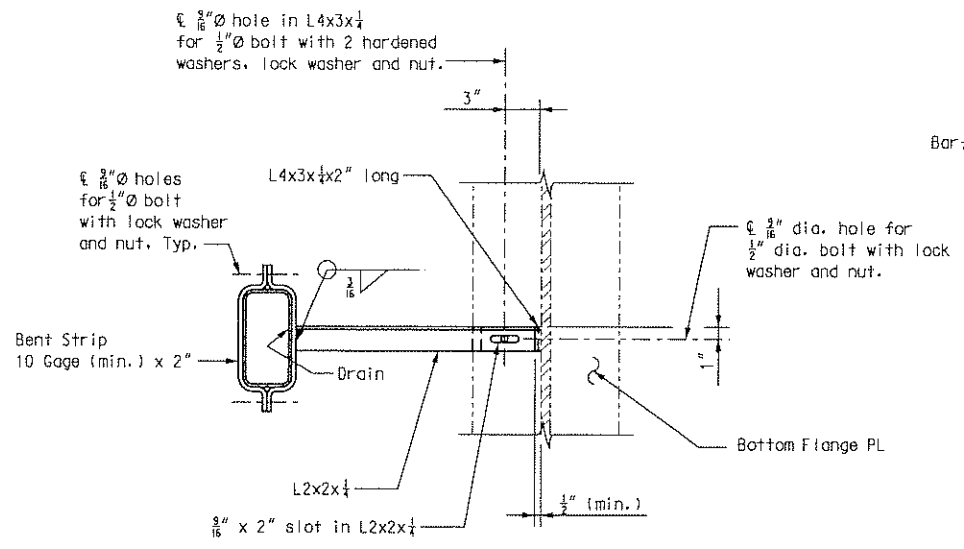


**PART SECTION SHOWING BRACKET ASSEMBLY**  
Scale: 1"=1'-0"

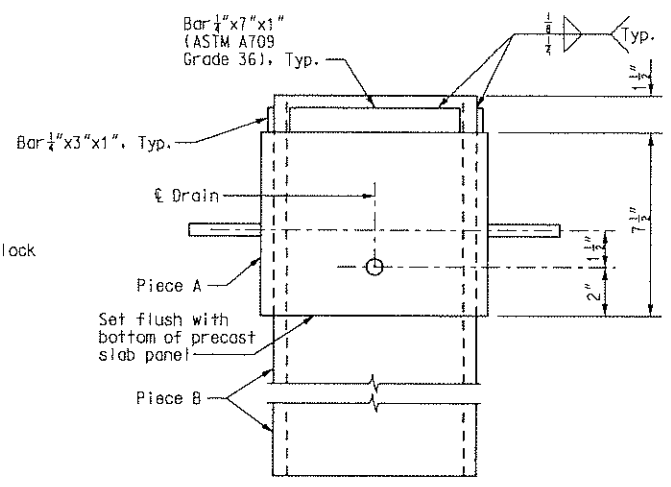

**ELEVATION OF DRAIN**  
Scale: 3"=1'-0"

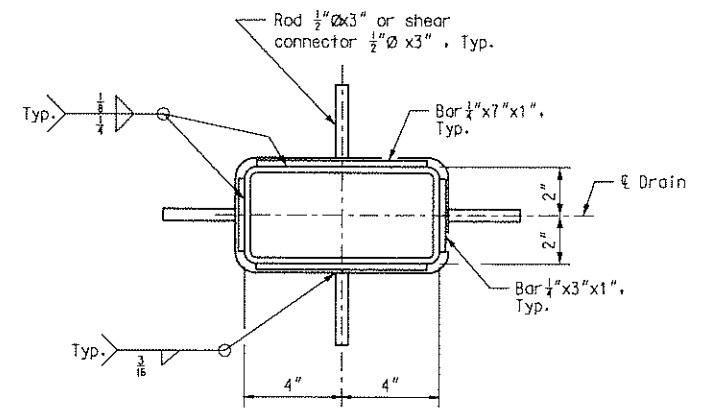

**PLAN OF DRAIN**  
Scale: 3"=1'-0"

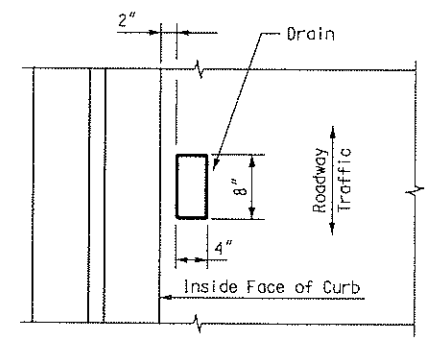

**PART PLAN OF SLAB AT DRAIN**  
Scale: 1"=1'-0"


**FINAL PLANS**

I CERTIFY THAT THIS PLAN SHEET ACCURATELY DEPICTS THE CONFIGURATION AND LOCATION OF THE ROADWAY AND ALL ITS APPURTENANT FEATURES, TO THE BEST OF MY KNOWLEDGE, AS I AND MY STAFF HAVE OBSERVED THE CONTRACTOR'S CONSTRUCTION OF THIS PROJECT. I SPECIFICALLY DISCLAIM ANY RESPONSIBILITY FOR THE DESIGN OF THIS PROJECT, EXCEPT AS I AND MY STAFF MAY HAVE MODIFIED OR AUTHORIZED THE MODIFICATION OF THE PROJECT DESIGN DURING ITS CONSTRUCTION; AND I DISCLAIM RESPONSIBILITY FOR THE CONTRACTOR'S ACTUAL CONSTRUCTION OF THE PROJECT, EXCEPT AS I AND MY STAFF MAY HAVE DIRECTED OR ORDERED THAT THE PROJECT BE CONSTRUCTED.

SIGNATURE \_\_\_\_\_ DATE \_\_\_\_\_


Notes:  
 For Slab Drain location, see Slab Panel Layouts, Sheet No. /p12/ thru /p16/.  
 Slab drains may be fabricated of either 1/4" welded sheets of ASTM A709, Grade 36 steel or from 1/4" structural steel tubing ASTM A500 or A501.  
 Slab drain bracket assembly shall be ASTM A709, Grade 36 steel.  
 Outside dimensions of drains are 8" x 4".  
 Locate drain blockouts in the slab panels by dimensions shown in the Part Plan of Slab at Drain.  
 The slab drains and bracket assembly shall be galvanized in accordance with ASTM A123.  
 All bolts, hardened washers, lock washers and nuts shall be galvanized in accordance with ASTM A153.  
 Shop drawings will not be required for slab drains and the bracket assembly.  
 Install slab drains in panels prior to wearing surface placement.

State	Proj. No.	Sheet No.
MD	FAS-5935(2)	B25

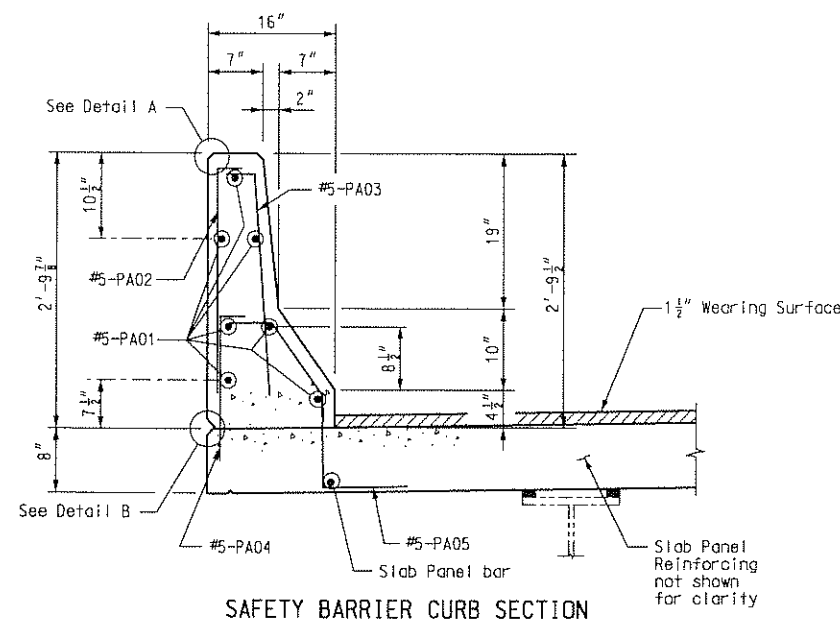


**SAFETY BARRIER CURB SECTION**

Notes:  
 Bar Marks shown are for Panel A. Panels B thru F are similar, except use "B00" thru "F00" series Bar Marks.  
 The cross-sectional area above the slab panel = 2.44 sq. ft.

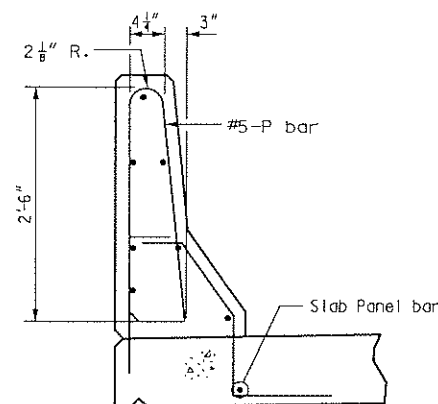


**P-BAR PERMISSIBLE ALTERNATE SHAPE**

The PX02 and PX03 bar combination may be furnished as one bar, as shown, at the contractor's option. (All dimensions are out to out.)  
 X = Panel Type

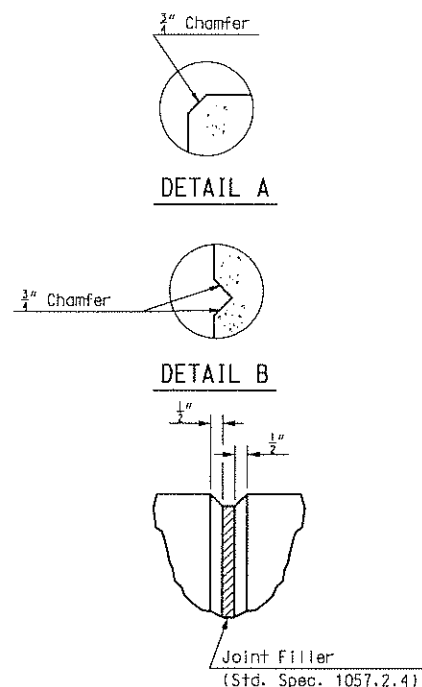


**FILLED JOINT DETAIL**

Note:  
 Fill gaps between barrier on panels after completion of each unit.

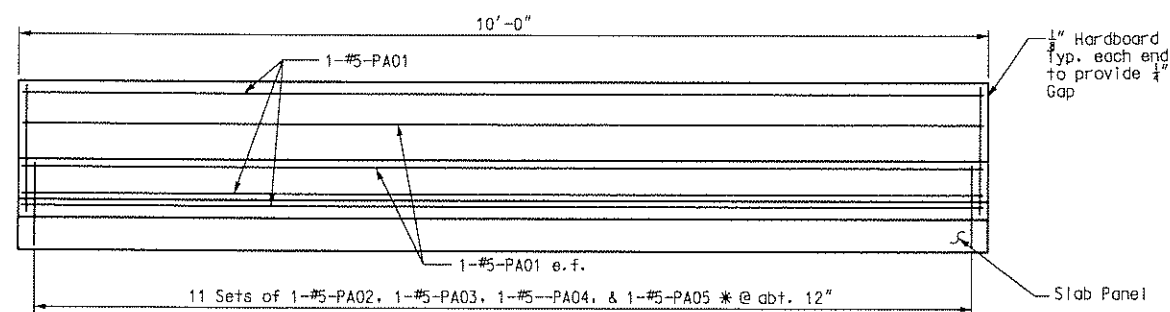

**SAFETY BARRIER ELEVATION AT PANELS A, B, C, D OR E**

Notes:  
 Bar Marks shown are for Panel A. Panels B thru E are similar, except use "B00" thru "E00" series Bar Marks.  
 The cross-sectional area above the slab panel = 2.44 sq. ft.

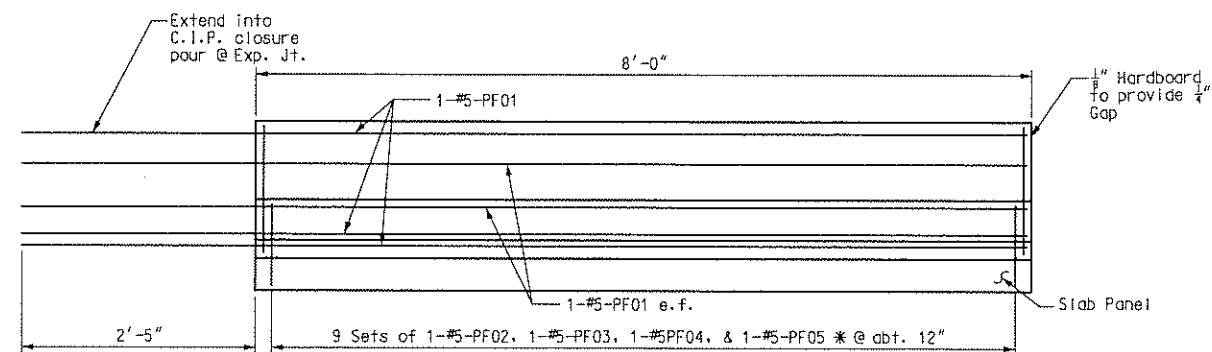

**SAFETY BARRIER ELEVATION AT PANELS F**

(Shown at End Bent 1, End Bent 20 opposite hand.)

**FINAL PLANS**

I CERTIFY THAT THIS PLAN SHEET ACCURATELY DEPICTS THE CONFIGURATION AND LOCATION OF THE ROADWAY AND ALL ITS APPURTENANT FEATURES, TO THE BEST OF MY KNOWLEDGE, AS I AND MY STAFF HAVE OBSERVED THE CONTRACTOR'S CONSTRUCTION OF THIS PROJECT. I SPECIFICALLY DISCLAIM ANY RESPONSIBILITY FOR THE DESIGN OF THIS PROJECT, EXCEPT AS I AND MY STAFF MAY HAVE MODIFIED OR AUTHORIZED THE MODIFICATION OF THE PROJECT DESIGN DURING ITS CONSTRUCTION; AND I DISCLAIM RESPONSIBILITY FOR THE CONTRACTOR'S ACTUAL CONSTRUCTION OF THE PROJECT, EXCEPT AS I AND MY STAFF MAY HAVE DIRECTED OR ORDERED THAT THE PROJECT BE CONSTRUCTED.


SIGNATURE \_\_\_\_\_ DATE \_\_\_\_\_

Notes:  
 For safety barrier curb details at end bents, see Sheet No. /p25/.  
 Top of safety barrier curb shall be built parallel to grade with safety barrier curb joints (except at End Bents) normal to grade.  
 All exposed edges of safety barrier curb shall have either a 1/2 inch radius or a 3/8 inch bevel, unless otherwise noted.  
 Concrete in the safety barrier curb shall be Class B-1.  
 \* Adjust spacing of Bar PA05 thru PF05 to clear pocket for deck drain in slab panels.  
 e.f. denotes each face.

SLAB PANEL SAFETY BARRIER CURB DETAILS


HICKORY COUNTY A08941

State	Proj. No.	Sheet No.
MD	FAS-5935(2)	B26

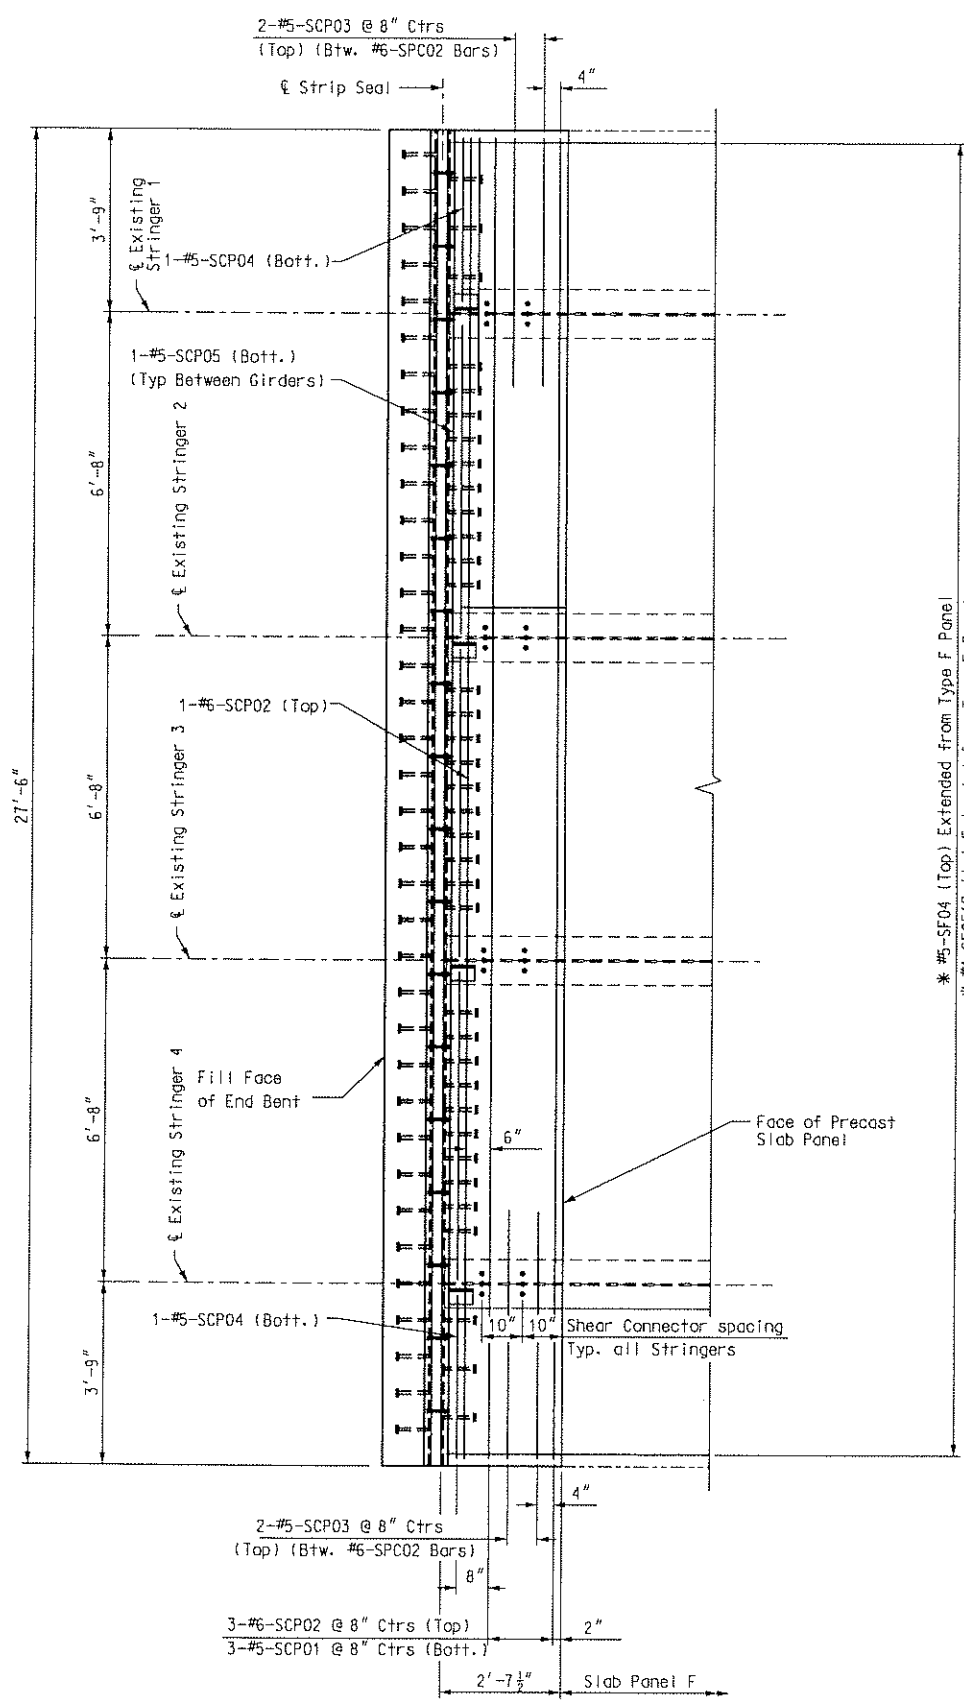

**CLOSURE POUR AT END BENT**  
Scale: 1/2"=1'-0"

\* Field Bend as Required to Clear Expansion Joint Shear Connectors.

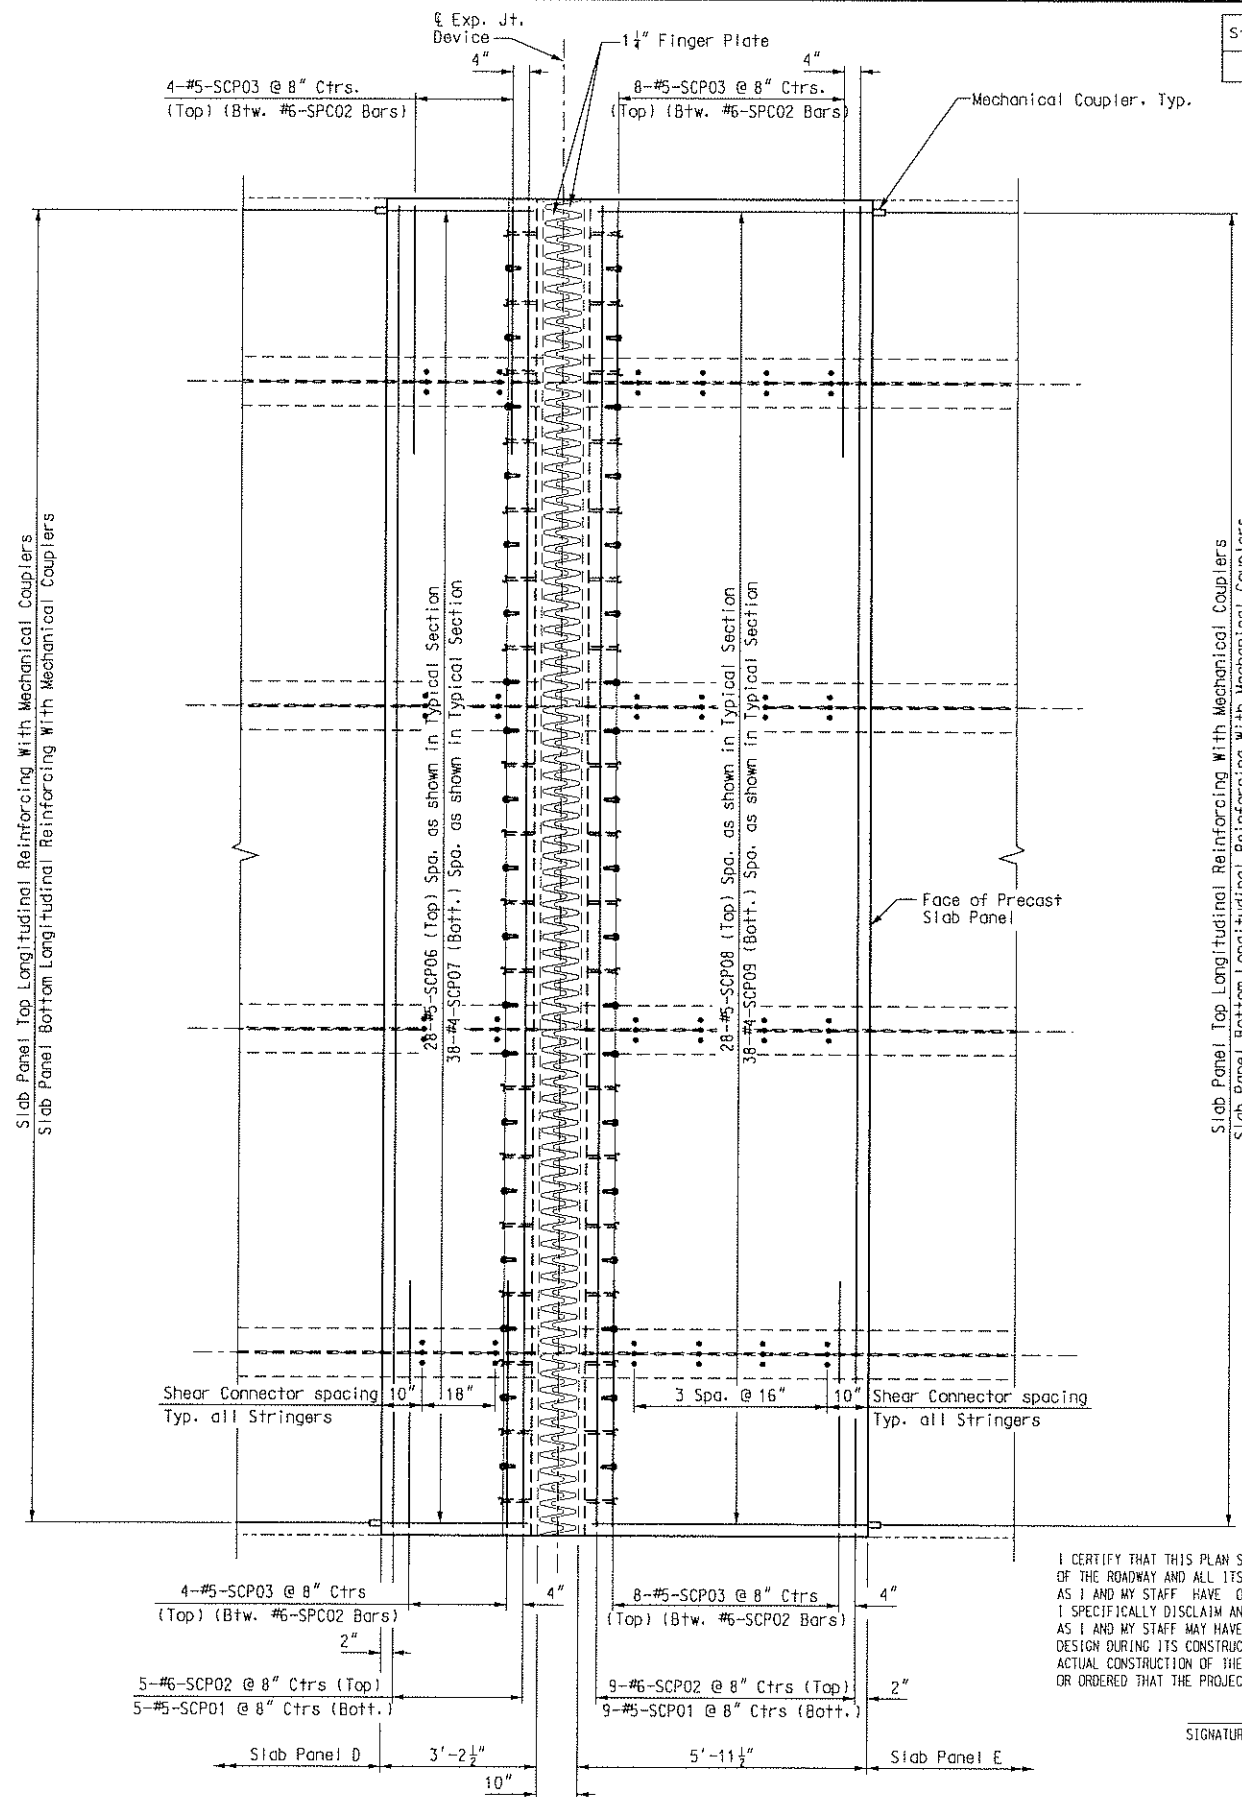

**CLOSURE POUR AT HINGE**  
Scale: 1/2"=1'-0"

**CLOSURE POUR DETAILS**


**FINAL PLANS**  
I CERTIFY THAT THIS PLAN SHEET ACCURATELY DEPICTS THE CONFIGURATION AND LOCATION OF THE ROADWAY AND ALL ITS APPURTENANT FEATURES, TO THE BEST OF MY KNOWLEDGE, AS I AND MY STAFF HAVE OBSERVED THE CONTRACTOR'S CONSTRUCTION OF THIS PROJECT. I SPECIFICALLY DISCLAIM ANY RESPONSIBILITY FOR THE DESIGN OF THIS PROJECT, EXCEPT AS I AND MY STAFF MAY HAVE MODIFIED OR AUTHORIZED THE MODIFICATION OF THE PROJECT DESIGN DURING ITS CONSTRUCTION; AND I DISCLAIM RESPONSIBILITY FOR THE CONTRACTOR'S ACTUAL CONSTRUCTION OF THE PROJECT, EXCEPT AS I AND MY STAFF MAY HAVE DIRECTED OR ORDERED THAT THE PROJECT BE CONSTRUCTED.

SIGNATURE \_\_\_\_\_ DATE \_\_\_\_\_


Notes:  
For details of strip seal at end bents, See Sheet No. /p26/.  
For details of finger joints, See Sheet No. /p24/.




State	Proj. No.	Sheet No.
MD	FAS-S935(2) ✓	B27

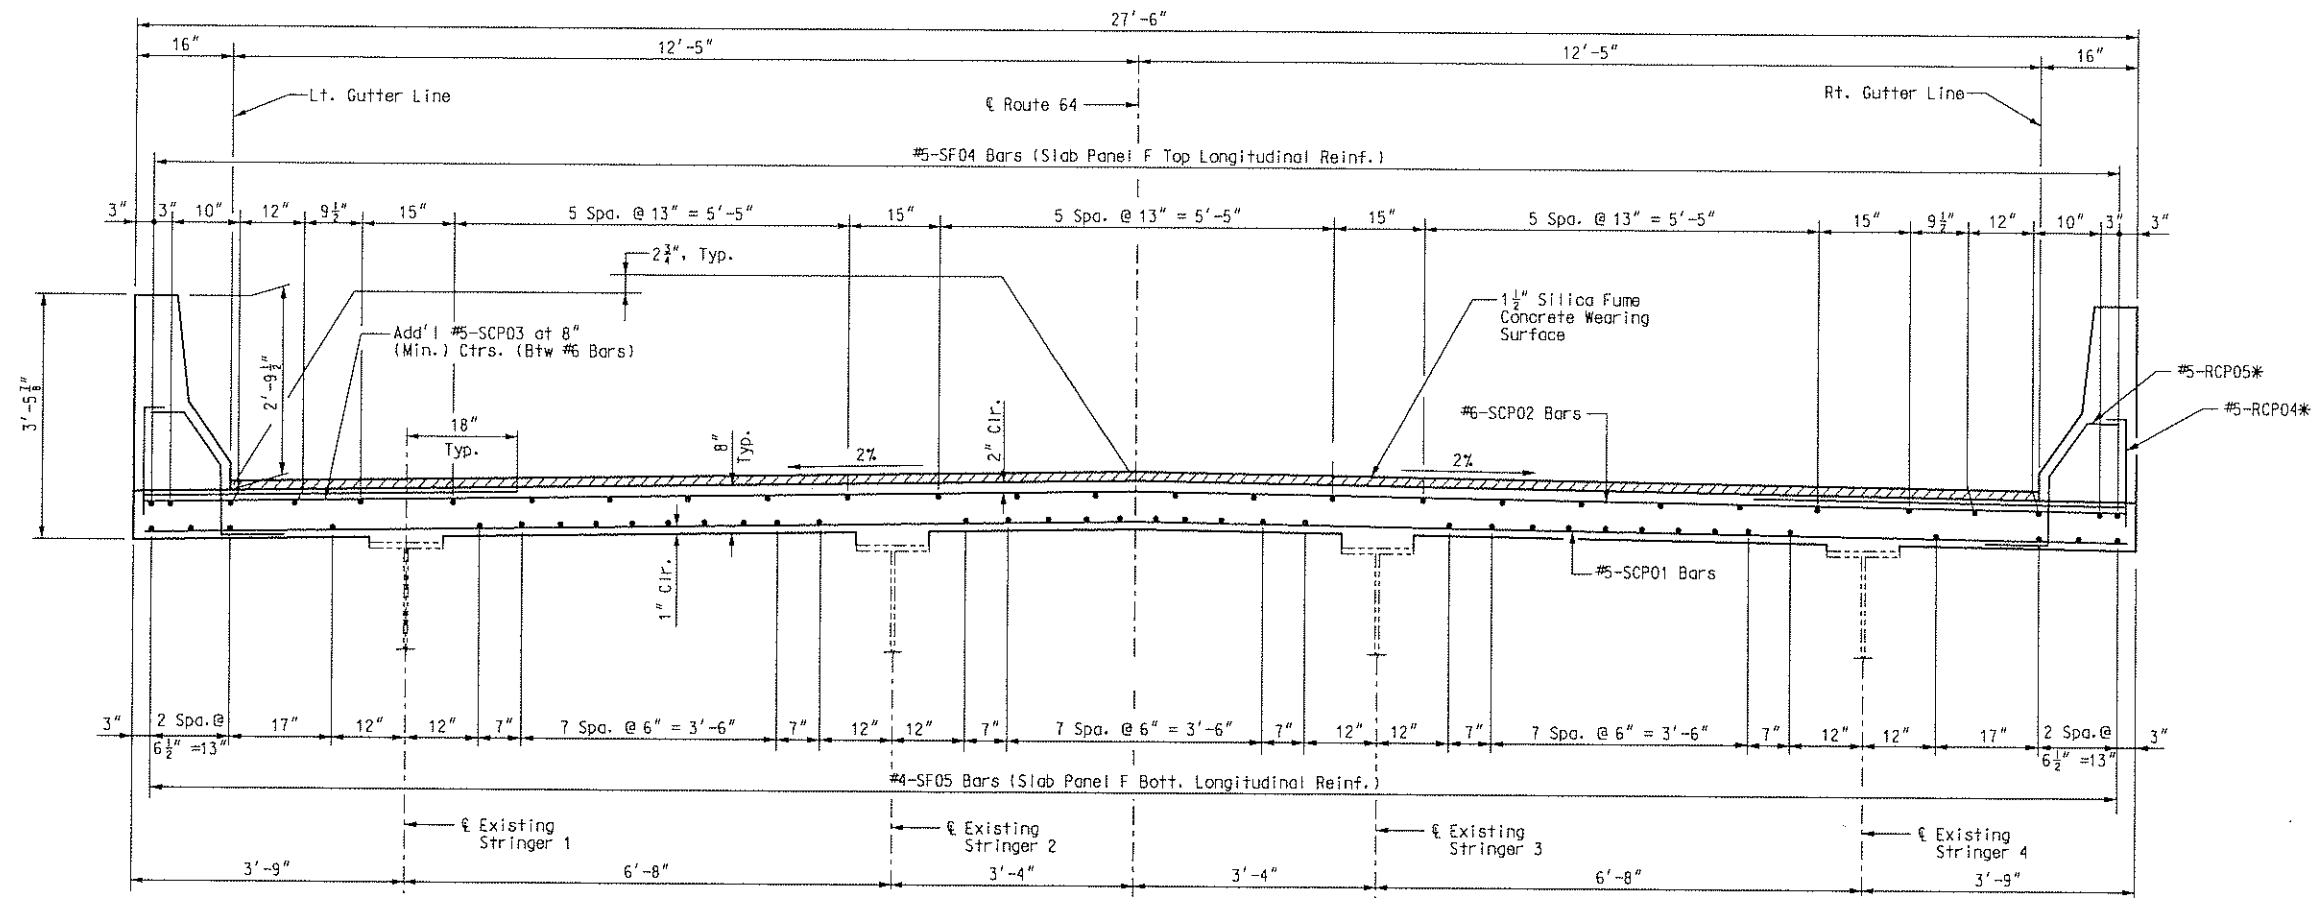

TYPICAL SECTION  
(Showing End Bent)

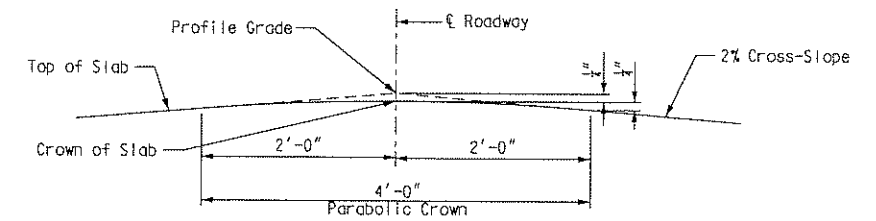

SLAB CROWN DETAIL

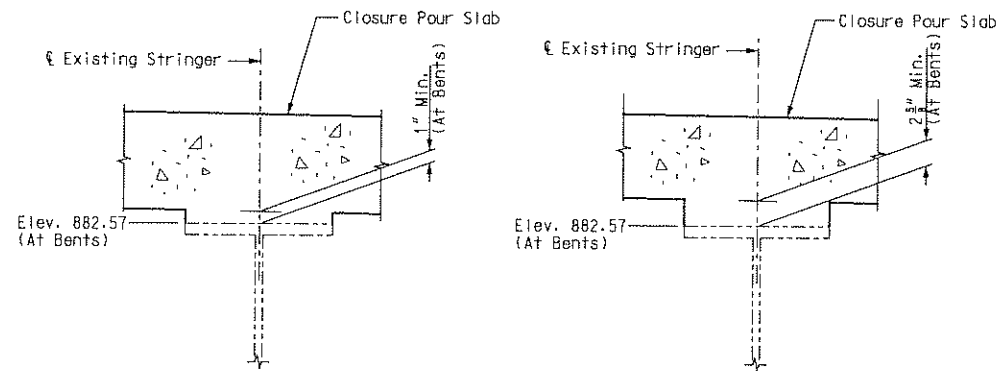

STRINGER 1 OR 4

STRINGER 2 OR 3

TYPICAL HAUNCH DETAIL

Note:  
If haunch depth exceeds 3", shear connector length shall be increased.  
Field verify haunch depths prior to placement of closure pour slab.  
No payment will be made for additional shear connector length, or concrete required for variable haunch.

Notes:  
For Closure Pour Details, see Sheet No. /p22/  
For Safety Barrier Curb Details, see Sheet No. /p23/.  
\* For spacing of #5-RCP04 and #5-RCP05 bars, see Safety Barrier Curb Elevation, Sheet No. /p23/.  
Bar Marks shown are for Closure Pour at End Bent. Closure Pours at Hinge are similar.

FINAL PLANS

I CERTIFY THAT THIS PLAN SHEET ACCURATELY DEPICTS THE CONFIGURATION AND LOCATION OF THE ROADWAY AND ALL ITS APPURTENANT FEATURES, TO THE BEST OF MY KNOWLEDGE, AS I AND MY STAFF HAVE OBSERVED THE CONTRACTOR'S CONSTRUCTION OF THIS PROJECT. I SPECIFICALLY DISCLAIM ANY RESPONSIBILITY FOR THE DESIGN OF THIS PROJECT, EXCEPT AS I AND MY STAFF MAY HAVE MODIFIED OR AUTHORIZED THE MODIFICATION OF THE PROJECT DESIGN DURING ITS CONSTRUCTION; AND I DISCLAIM RESPONSIBILITY FOR THE CONTRACTOR'S ACTUAL CONSTRUCTION OF THE PROJECT, EXCEPT AS I AND MY STAFF MAY HAVE DIRECTED OR ORDERED THAT THE PROJECT BE CONSTRUCTED.

SIGNATURE \_\_\_\_\_


DATE \_\_\_\_\_

CLOSURE POUR CROSS SECTION

HICKORY


COUNTY

A08941

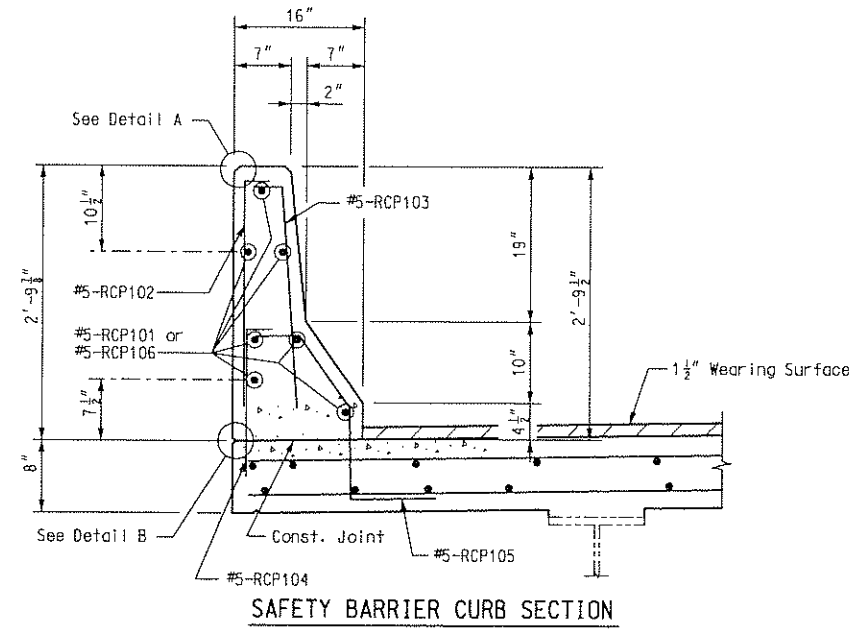


**SAFETY BARRIER CURB SECTION**

Notes:  
The cross-sectional area above the slab = 2.44 sq. ft.

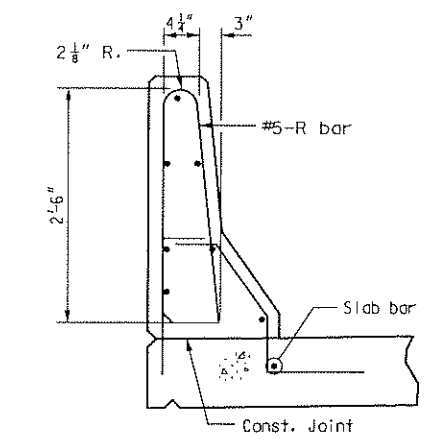


**R-BAR PERMISSIBLE ALTERNATE SHAPE**


The RCP102 and RCP103 bar combination may be furnished as one bar, as shown, at the contractor's option. (All dimensions are out to out.)

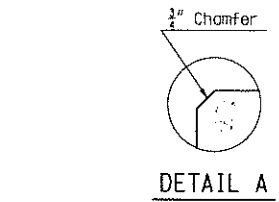


**DETAIL A**

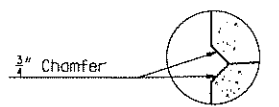

**DETAIL B**

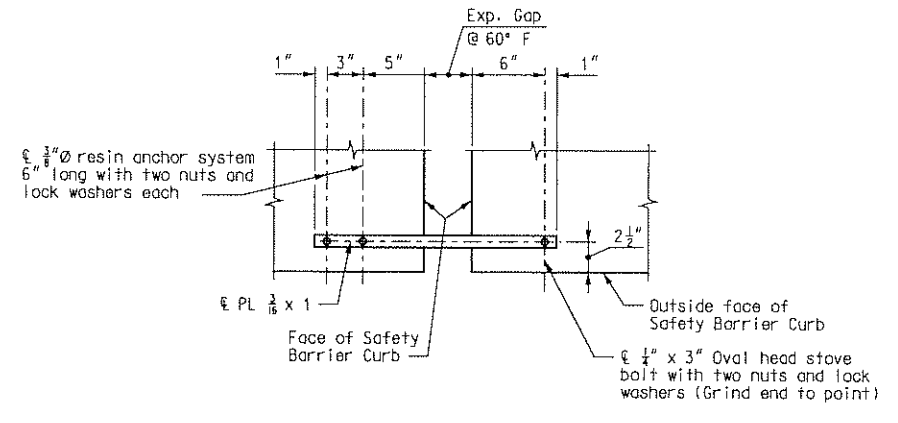


**PART PLAN OF BARRIER CURB SHOWING MOVEMENT GAUGE**

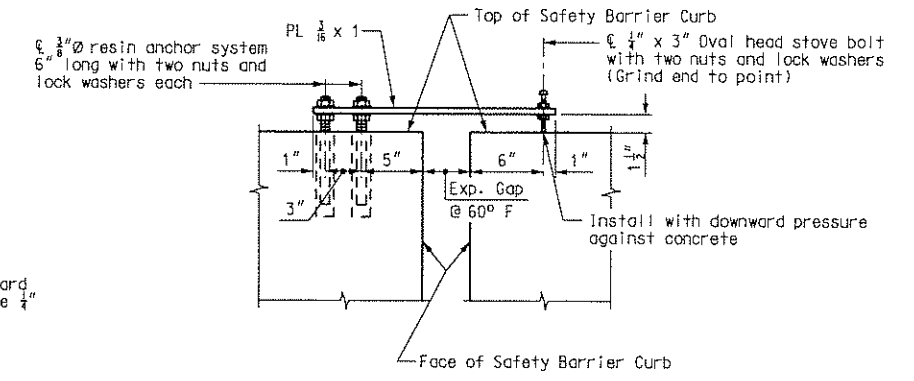


**PART ELEVATION OF BARRIER CURB SHOWING MOVEMENT GAUGE**


Notes:  
A movement gauge shall be provided on right side of bridge at all safety barrier curb expansion joints.  
All steel shall be galvanized in accordance with ASTM A153.  
Cost of movement gauge complete in place shall be included in contract unit price for Class B-1 Concrete (Closure Pour & Barrier Curb).

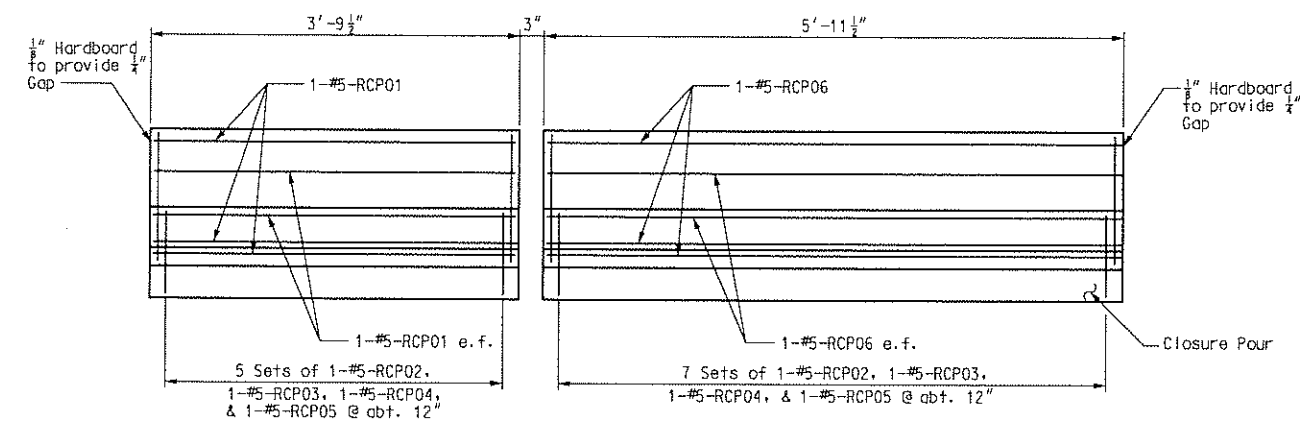

**SAFETY BARRIER ELEVATION AT C.I.P. CLOSURE POURS**  
(Hinge 1 shown, Hinges 2, 3, and 4 similar.)

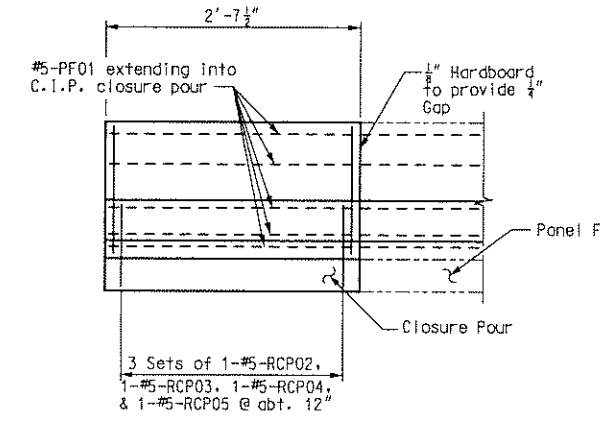

**SAFETY BARRIER ELEVATION AT C.I.P. CLOSURE POURS**  
(End Bent 1 shown, End Bent 20 similar.)

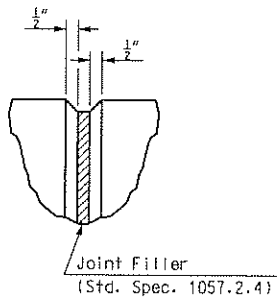

**FILLED JOINT DETAIL**

Note:  
Fill joint between barrier on slab panel and cast-in-place barrier at closure pours.

**FINAL PLANS**


I CERTIFY THAT THIS PLAN SHEET ACCURATELY DEPICTS THE CONFIGURATION AND LOCATION OF THE ROADWAY AND ALL ITS APPURTENANT FEATURES, TO THE BEST OF MY KNOWLEDGE, AS I AND MY STAFF HAVE OBSERVED THE CONTRACTOR'S CONSTRUCTION OF THIS PROJECT. I SPECIFICALLY DISCLAIM ANY RESPONSIBILITY FOR THE DESIGN OF THIS PROJECT, EXCEPT AS I AND MY STAFF MAY HAVE MODIFIED OR AUTHORIZED THE MODIFICATION OF THE PROJECT DESIGN DURING ITS CONSTRUCTION; AND I DISCLAIM RESPONSIBILITY FOR THE CONTRACTOR'S ACTUAL CONSTRUCTION OF THE PROJECT, EXCEPT AS I AND MY STAFF MAY HAVE DIRECTED OR ORDERED THAT THE PROJECT BE CONSTRUCTED.

SIGNATURE \_\_\_\_\_ DATE \_\_\_\_\_

Notes:  
For safety barrier curb details at end bents, see Sheet No. /p25/.  
Top of safety barrier curb shall be built parallel to grade.  
All exposed edges of safety barrier curb shall have either a 1/2 inch radius or a 3/8 inch bevel, unless otherwise noted.  
Concrete in the safety barrier curb shall be Class B-1.


DETAILS OF SAFETY BARRIER CURB AT CLOSURE POURS

State	Proj. No.	Sheet No.
MO	FAS-S935(2)	B29

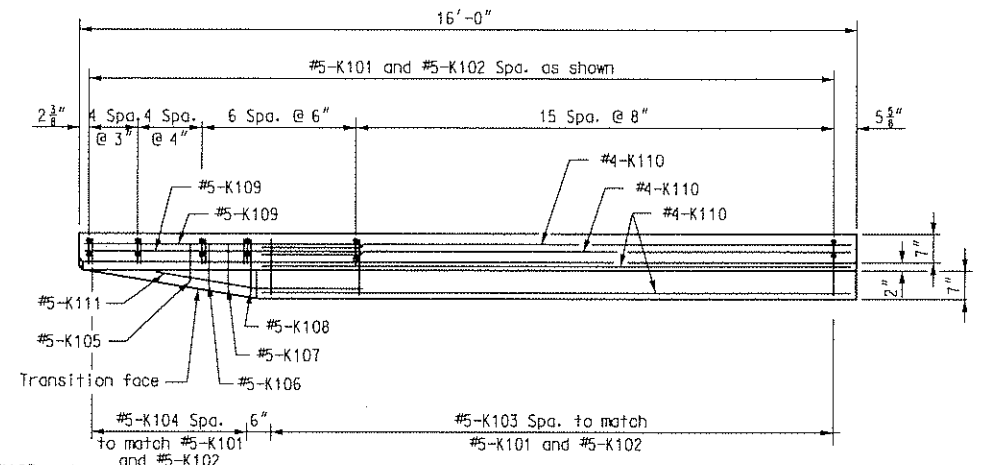

PLAN

Notes:  
 #5-K105, #5-K106, #5-K107 and #5-K108 are spaced with #5-K104 bars. Fit #5-K111 bar to follow transition face of curb.

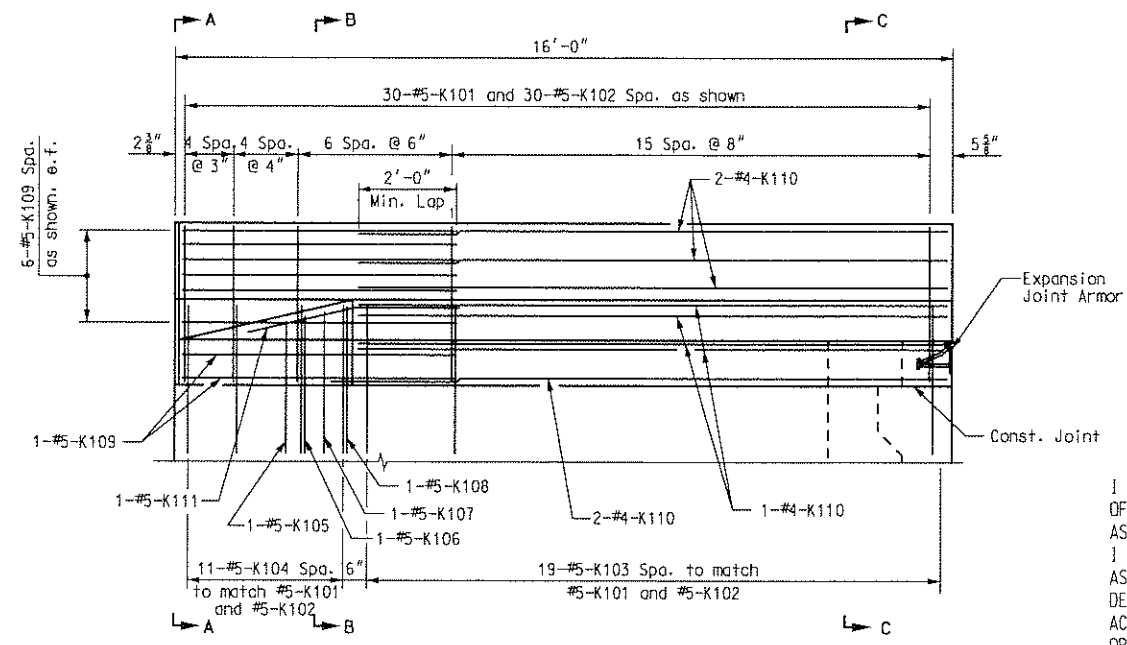


BARRIER ELEVATION


End Bent 1, Left side shown (Right side opposite)  
 Scale: 1/2"=1'-0"

FINAL PLANS  
 I CERTIFY THAT THIS PLAN SHEET ACCURATELY DEPICTS THE CONFIGURATION AND LOCATION OF THE ROADWAY AND ALL ITS APPURTENANT FEATURES, TO THE BEST OF MY KNOWLEDGE, AS I AND MY STAFF HAVE OBSERVED THE CONTRACTOR'S CONSTRUCTION OF THIS PROJECT. I SPECIFICALLY DISCLAIM ANY RESPONSIBILITY FOR THE DESIGN OF THIS PROJECT, EXCEPT AS I AND MY STAFF MAY HAVE MODIFIED OR AUTHORIZED THE MODIFICATION OF THE PROJECT DESIGN DURING ITS CONSTRUCTION; AND I DISCLAIM RESPONSIBILITY FOR THE CONTRACTOR'S ACTUAL CONSTRUCTION OF THE PROJECT, EXCEPT AS I AND MY STAFF MAY HAVE DIRECTED OR ORDERED THAT THE PROJECT BE CONSTRUCTED.


SIGNATURE \_\_\_\_\_ DATE \_\_\_\_\_

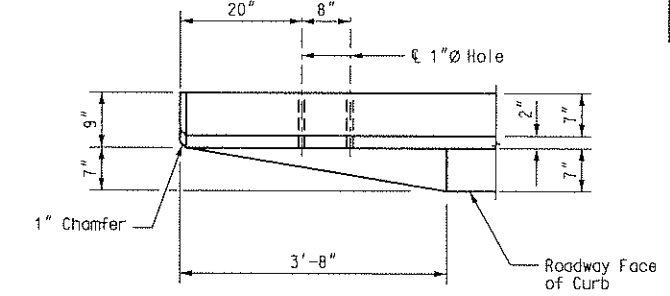


PART PLAN

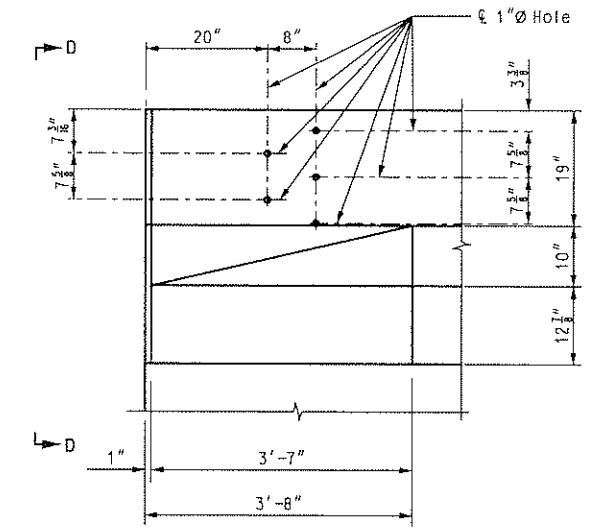

PART ELEVATION

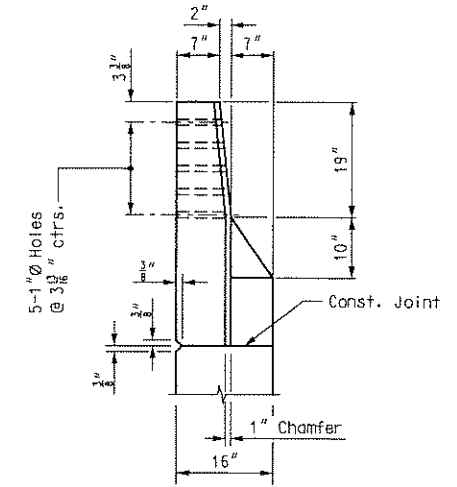


VIEW D-D

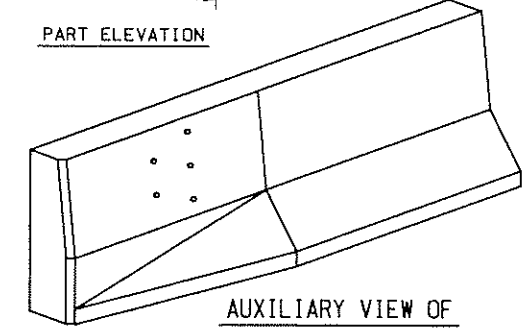


AUXILIARY VIEW OF SAFETY BARRIER CURB


DETAILS OF GUARD RAIL ATTACHMENT

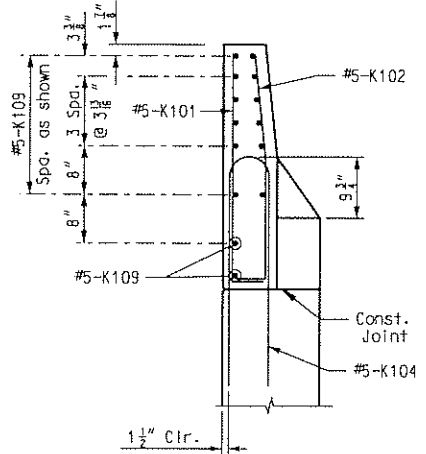

SECTION A-A  
 Scale: 3/4"=1'-0"

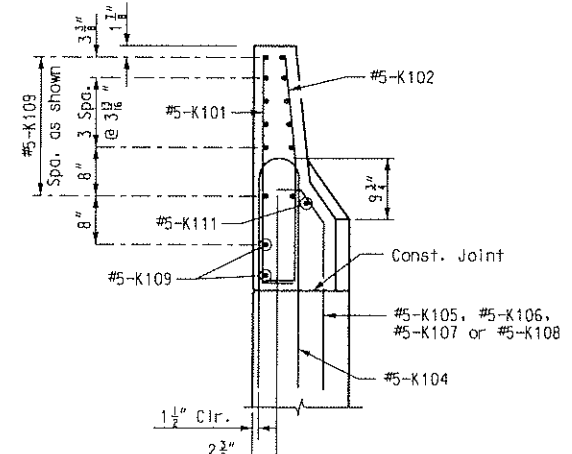

SECTION B-B  
 Scale: 3/4"=1'-0"

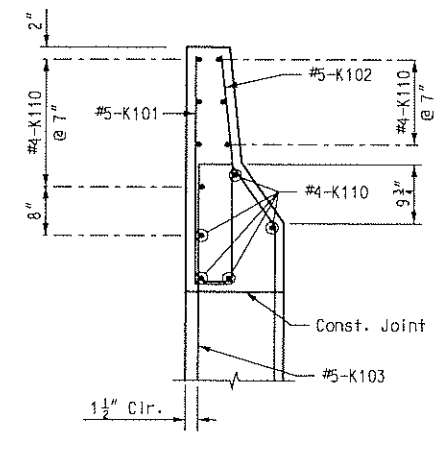


SECTION C-C  
 Scale: 3/4"=1'-0"


Notes:  
 For typical barrier curb section, see Sheet No. /p23/.  
 Top of safety barrier curb shall be built parallel to grade with safety barrier curb joints (except at End Bents) normal to grade.  
 All exposed edges of safety barrier curb shall have either a 1/2" radius or a 3/8" bevel, unless otherwise noted.  
 Concrete in the safety barrier curb shall be Class B-1.  
 Provide Guard Rail Attachment at Left and Right Barriers.  
 For Expansion Joint Details, see Sheet No. /p26/.  
 Bar Marks shown are for End Bent 1 using "100" series Bar Marks. End Bent 20 is identical, except use "200" series Bar Marks.

DETAILS OF SAFETY BARRIER CURB AT END BENTS

State	Proj. No.	Sheet No.
MD	FAS-S93S(2)	B30

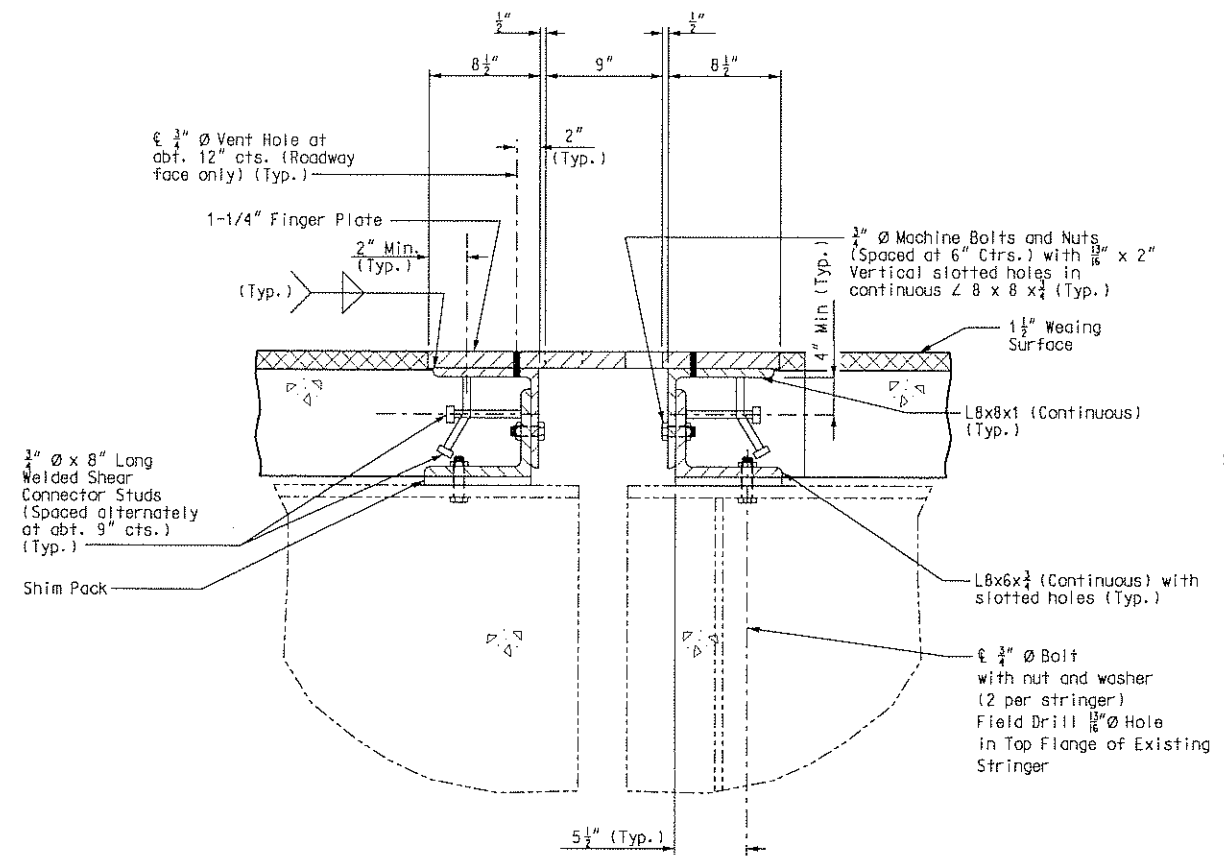

**PART SECTION THRU EXPANSION JOINT**  
Scale: 1 1/2"=1'-0"

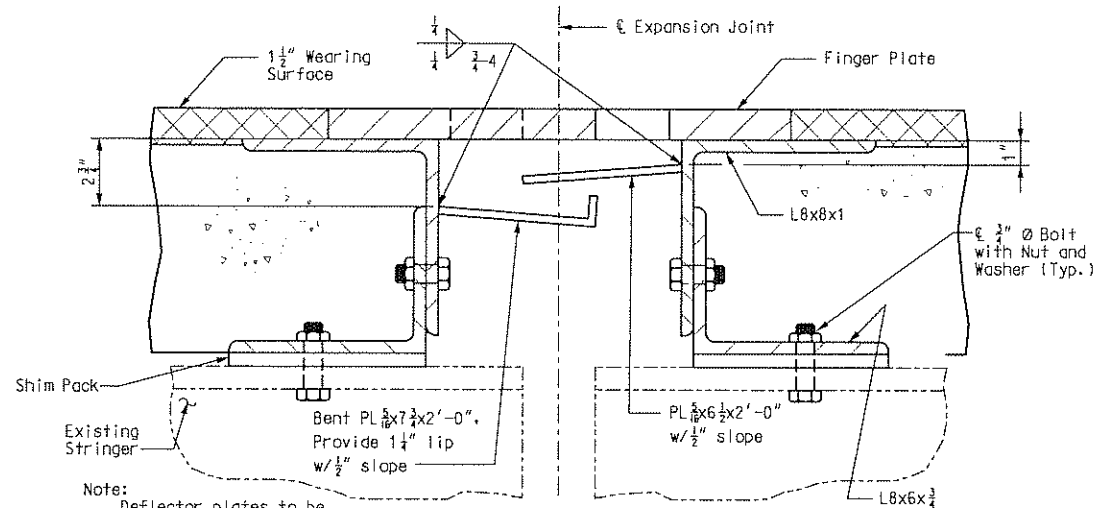

**DEFLECTOR PLATES AT EACH STRINGER LINE**  
Scale: 3"=1'-0"

**GENERAL NOTES:**  
Finger plate shall be cut with a machine guided gas torch from one plate. The plate from which fingers are cut may be spliced before fingers are cut. The surface of cut shall be perpendicular to the surface of the plate. The cut shall not exceed 1/8 inch in width. The centerline of cut shall not deviate more than 1/16 inch from the position of centerline of cut shown. No splicing of finger plate or finger plate assembly will be allowed after fingers are cut.

Plan dimensions are based on installation at 60°F. The expansion gap and other dimensions shall be increased 1/4 inch for each 10°F fall and decreased 1/4 inch for each 10°F rise in temperature at installation.

Structural steel for the expansion device and curb plate shall be coated with a minimum of two coats of inorganic zinc primer (5 mils minimum) or galvanized in accordance with ASTM A123. Anchors need not be protected from overspray.

Payment for furnishing, coating or galvanizing and installing structural steel for the expansion device will be made at the contract unit price for Expansion Device (Finger Plate) per lin. ft.


Concrete shall be forced under and around finger plate supporting hardware, studs, angles and bars. Proper consolidation shall be achieved by localized internal vibration.

1-1/4" Finger Plate and L 8 x 8 x 1/2 shall be bent to conform to crown of roadway.


Longitudinal reinforcing steel shall be placed so that ends shall not be more than 1"± from vertical Leg 8x6x3/4 angle at expansion device.

Material for the expansion device shall be ASTM A709 Grade 36 structural steel. Anchors for the expansion device shall be approved stud welded anchors (C1010 thru C1020).


Provide galvanized shims and beveled shims under L8x6x3/4 at existing stringers.

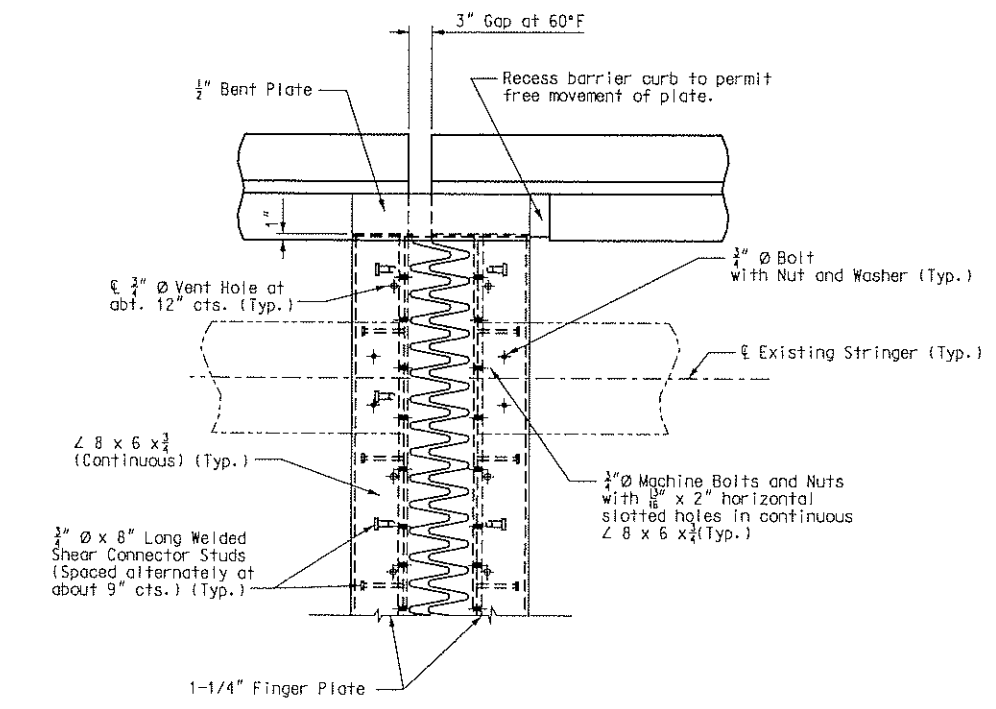


**PART PLAN OF EXPANSION DEVICE**  
Scale: 3/4"=1'-0"

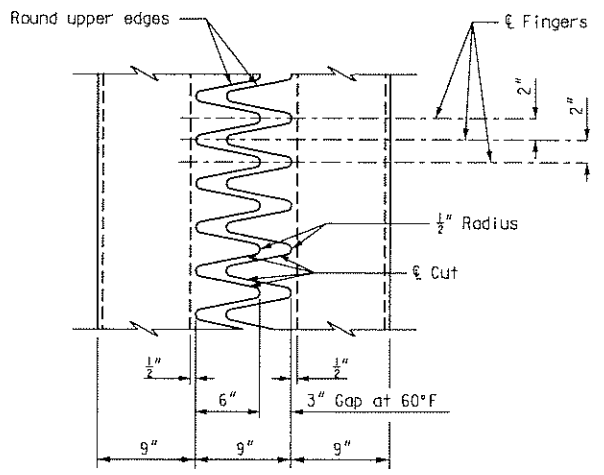


**TYPICAL PLAN OF PLATE**

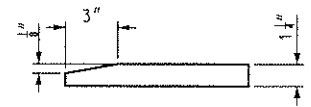


**FINGER DETAIL**

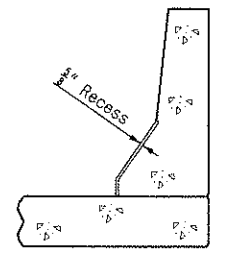


**PART SECTION B-B**

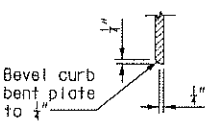

**SECTION C-C**

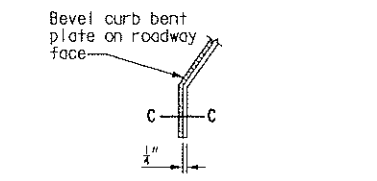


**PART ELEVATION AT END OF BEVELED CURB BENT PLATE**

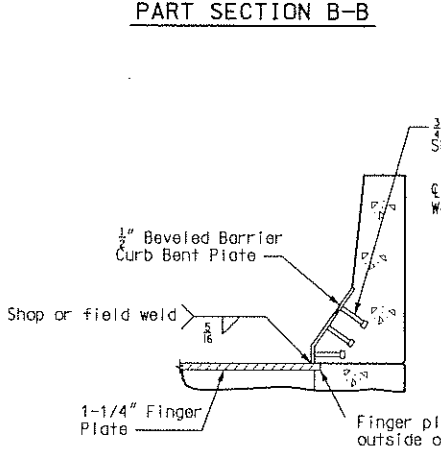

**PART SECTION A-A**

SIGNATURE \_\_\_\_\_ DATE \_\_\_\_\_

**FINAL PLANS**  
I CERTIFY THAT THIS PLAN SHEET ACCURATELY DEPICTS THE CONFIGURATION AND LOCATION OF THE ROADWAY AND ALL ITS APPURTENANT FEATURES, TO THE BEST OF MY KNOWLEDGE, AS I AND MY STAFF HAVE OBSERVED THE CONTRACTOR'S CONSTRUCTION OF THIS PROJECT. I SPECIFICALLY DISCLAIM ANY RESPONSIBILITY FOR THE DESIGN OF THIS PROJECT, EXCEPT AS I AND MY STAFF MAY HAVE MODIFIED OR AUTHORIZED THE MODIFICATION OF THE PROJECT DESIGN DURING ITS CONSTRUCTION; AND I DISCLAIM RESPONSIBILITY FOR THE CONTRACTOR'S ACTUAL CONSTRUCTION OF THE PROJECT, EXCEPT AS I AND MY STAFF MAY HAVE DIRECTED OR ORDERED THAT THE PROJECT BE CONSTRUCTED.

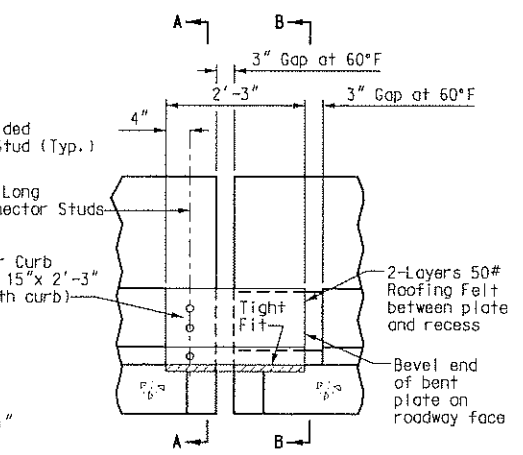


**PART ELEVATION OF BARRIER CURB**

DETAILS OF FINGER JOINTS AT HINGES



State	Proj. No.	Sheet No.
MO	FAS-S935(2)	B31

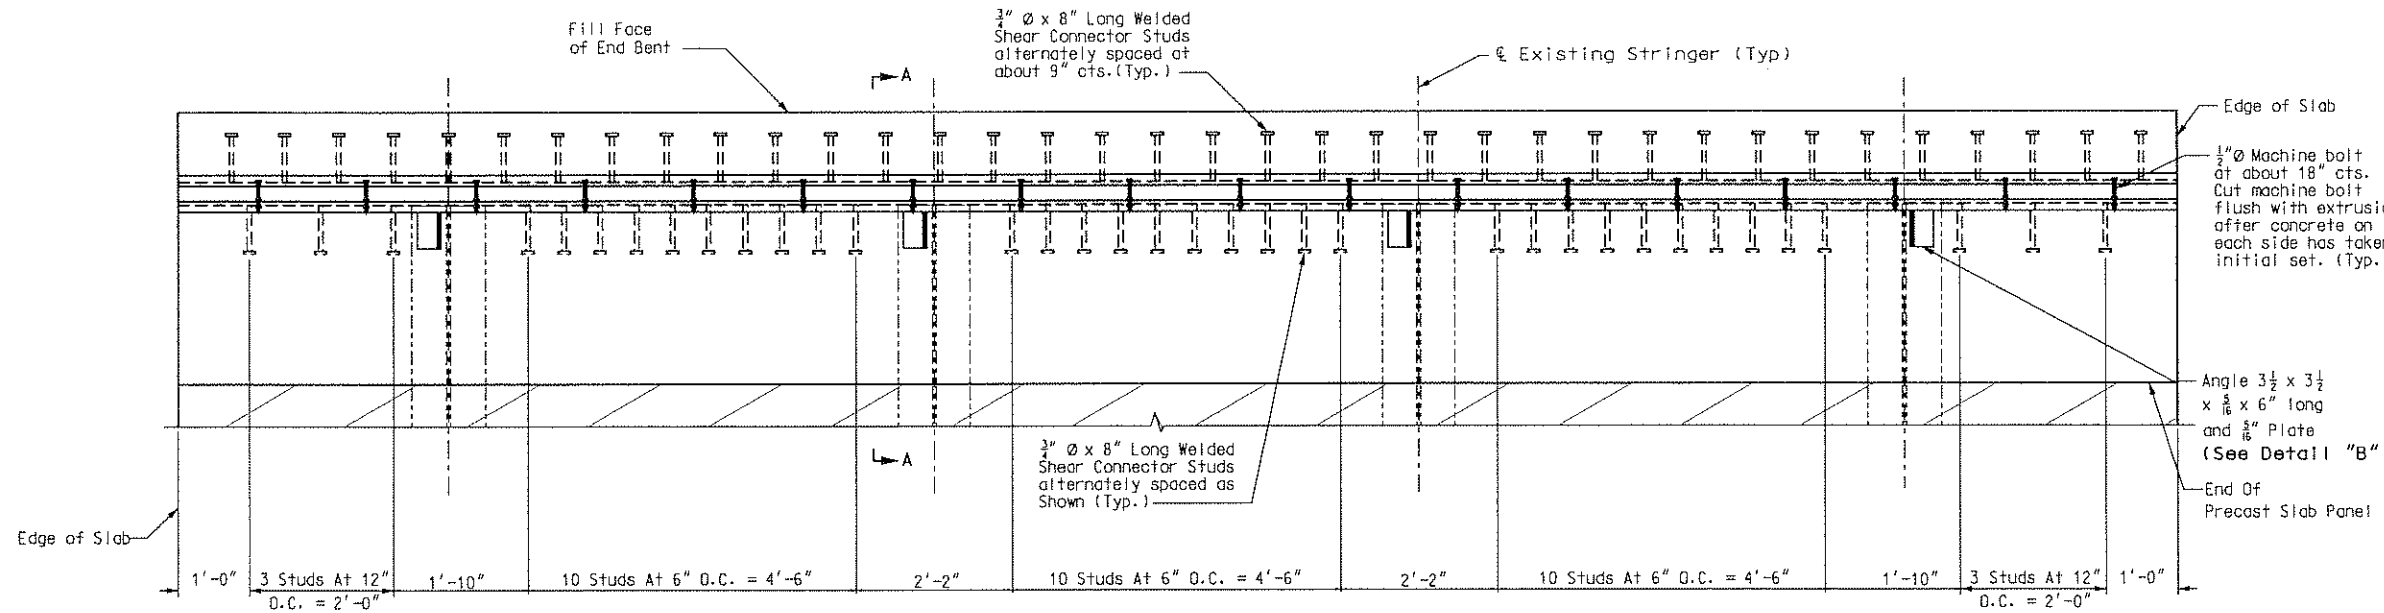

PLAN

**FINAL PLANS**  
 I CERTIFY THAT THIS PLAN SHEET ACCURATELY DEPICTS THE CONFIGURATION AND LOCATION OF THE ROADWAY AND ALL ITS APPURTENANT FEATURES, TO THE BEST OF MY KNOWLEDGE, AS I AND MY STAFF HAVE OBSERVED THE CONTRACTOR'S CONSTRUCTION OF THIS PROJECT. I SPECIFICALLY DISCLAIM ANY RESPONSIBILITY FOR THE DESIGN OF THIS PROJECT, EXCEPT AS I AND MY STAFF MAY HAVE MODIFIED OR AUTHORIZED THE MODIFICATION OF THE PROJECT DESIGN DURING ITS CONSTRUCTION; AND I DISCLAIM RESPONSIBILITY FOR THE CONTRACTOR'S ACTUAL CONSTRUCTION OF THE PROJECT, EXCEPT AS I AND MY STAFF MAY HAVE DIRECTED OR ORDERED THAT THE PROJECT BE CONSTRUCTED.

**GENERAL NOTES:**  
 The expansion device shall be fabricated and installed in accordance with the recommendations of the manufacturer, and as set forth in the Special Provisions.  
 The contractor must verify all dimensions prior to fabrication.  
 All welds shall conform to Section 712 of the Missouri Standard Specifications.  
 Splices of steel extrusion shall develop full strength.  
 All steel shall be ASTM A709 Grade 36, except steel extrusions shall be ASTM A709 Grade 50W or Grade 36.  
 Neoprene Strip Seal shall meet ASTM D-2628.  
 Anchors for the extrusions or armor shall be approved welded studs (C1010 thru C1020).  
 Structural steel for the expansion device and curb plate shall be coated with a minimum of two coats of inorganic zinc primer (5 mils minimum) or galvanized in accordance with ASTM A123. Anchors need not be protected from overspray.  
 Payment for furnishing, coating or galvanizing and placing steel extrusions, miscellaneous structural steel, barrier curb plates, and neoprene strip seal shall be made under the contract unit price for Strip Seal Expansion Device.


Plan dimensions are based on installation at 60°F. The gap shall be increased  $\frac{1}{8}$ " for each 10° fall in temperature and decreased  $\frac{1}{8}$ " for each 10° rise in temperature from the installation temperature.

Longitudinal reinforcing steel shall be placed so that ends shall not be more than 1" from vertical leg of extrusion of Expansion Device.


Concrete shall be forced under and around strip seal extrusions and studs. Proper consolidation of the concrete shall be achieved by localized internal vibration.

Curb Plate anchors shall be a drilled cone expansion or a cast-in-place wing type threaded insert. The minimum ultimate pullout capacity for these anchors shall be 2700 lbs in f'c = 4000 psi concrete. Lead anchors will not be permitted. Holes for anchors shall not be drilled until the concrete is at least 7 days old.


For Safety Barrier Curb Details, see Sheet No. /p25/.

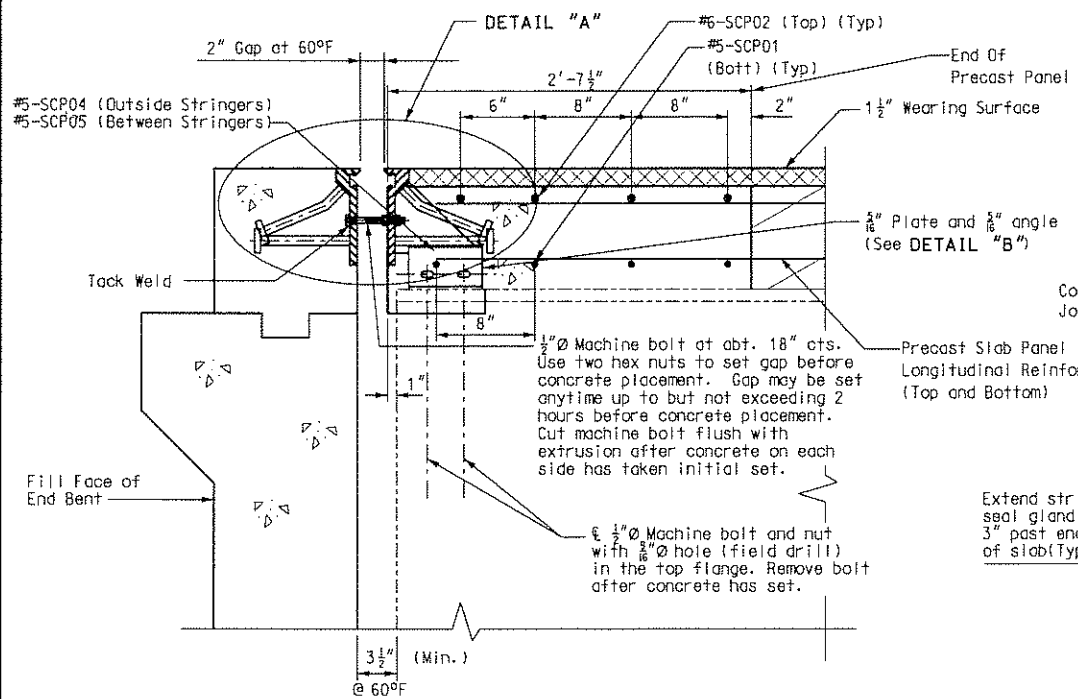


SECTION A-A

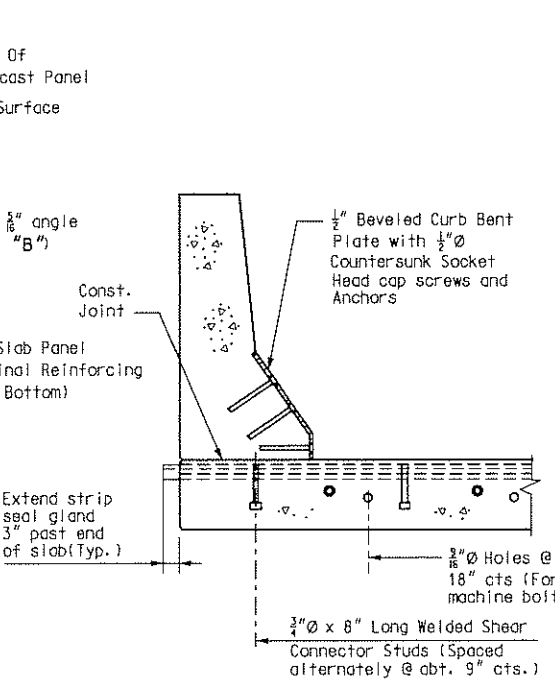



PART SECTION C-C

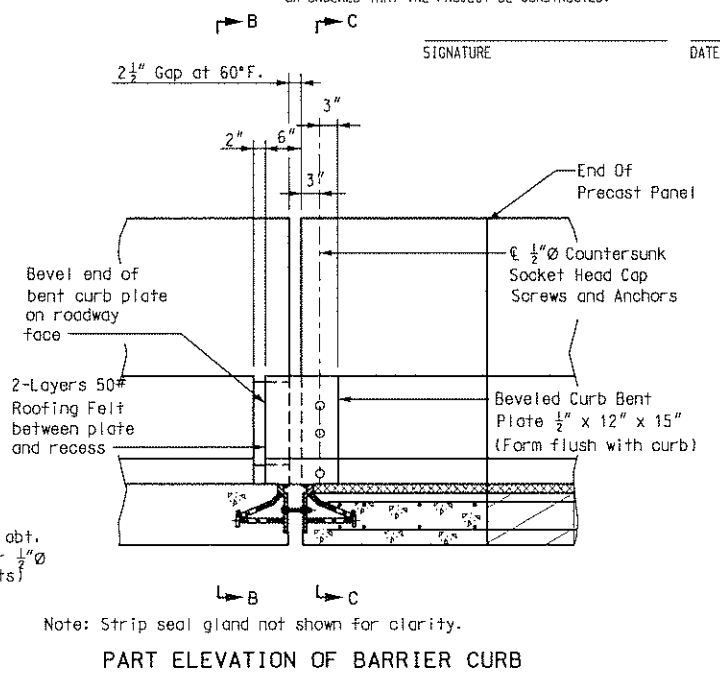


PART ELEVATION OF BARRIER CURB

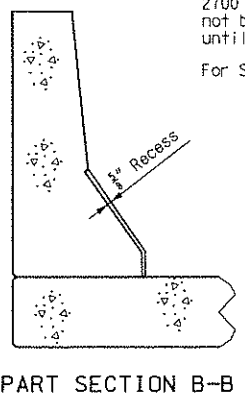


PART SECTION B-B

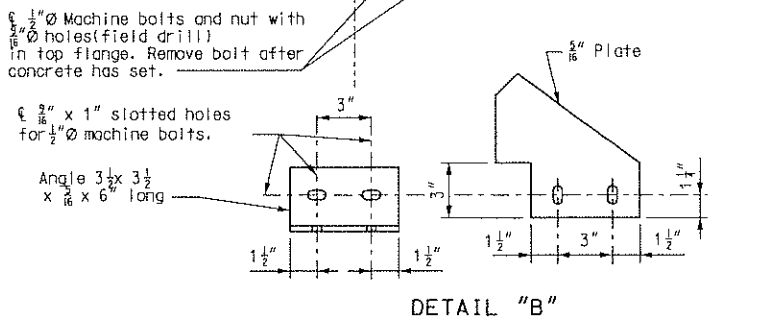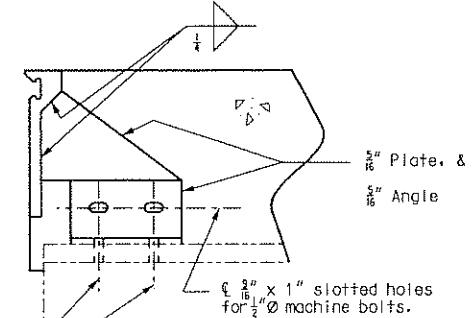


DETAIL "B"

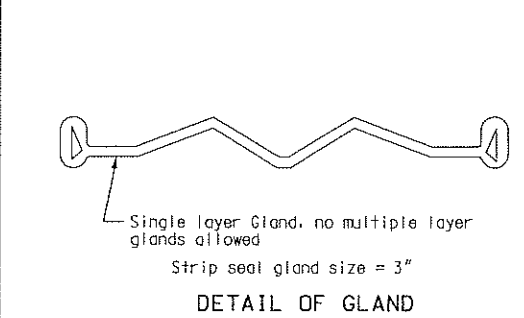


DETAIL OF GLAND

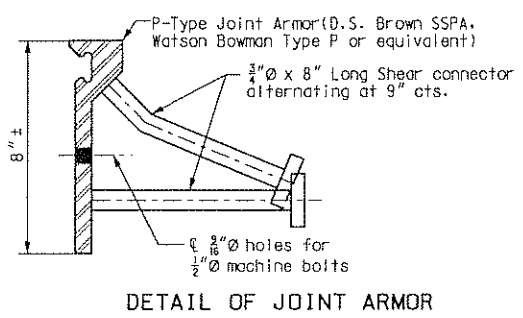


DETAIL OF JOINT ARMOR

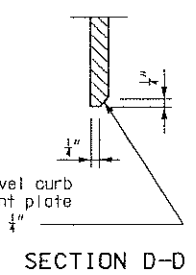

SECTION D-D

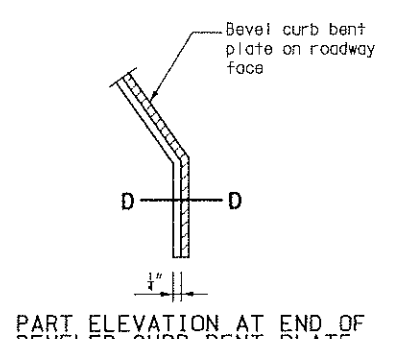


PART ELEVATION AT END OF BEVELED CURB BENT PLATE

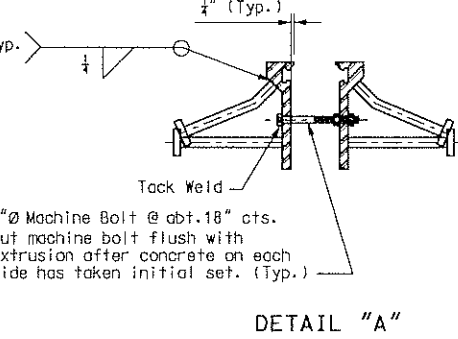


DETAIL "A"


State	Proj. No.	Sheet No.
MO	FAS-S935(2)	B32

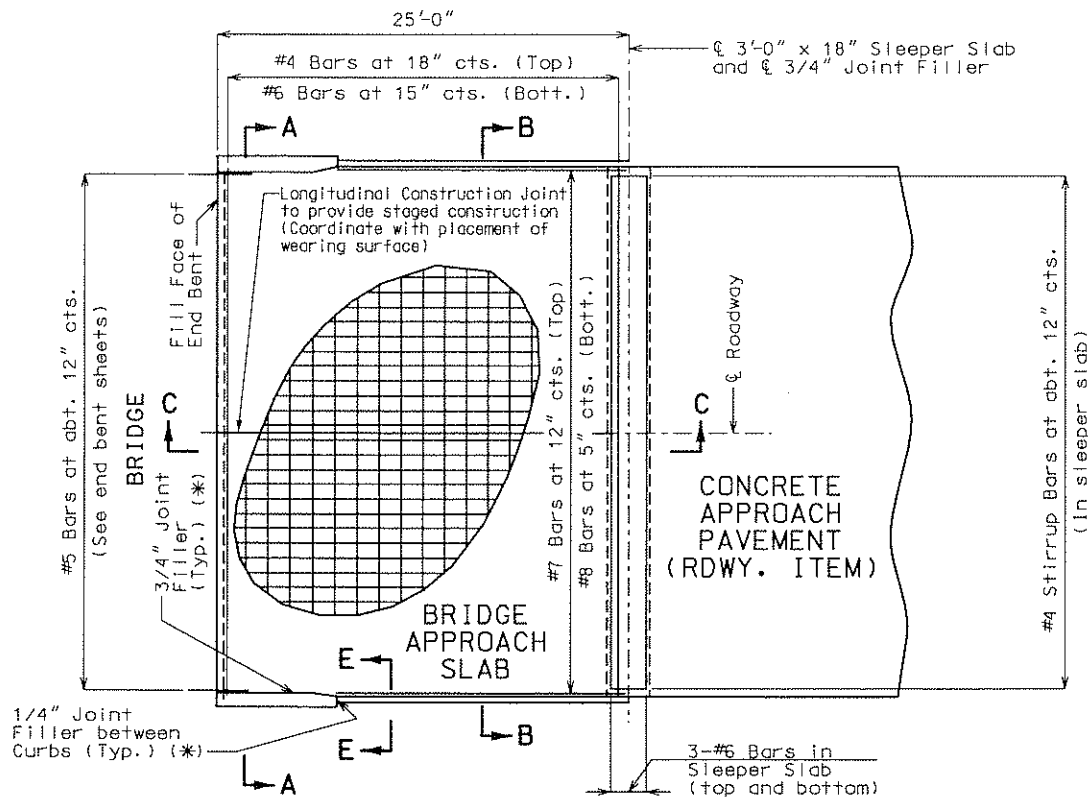


PART PLAN SHOWING REINFORCEMENT

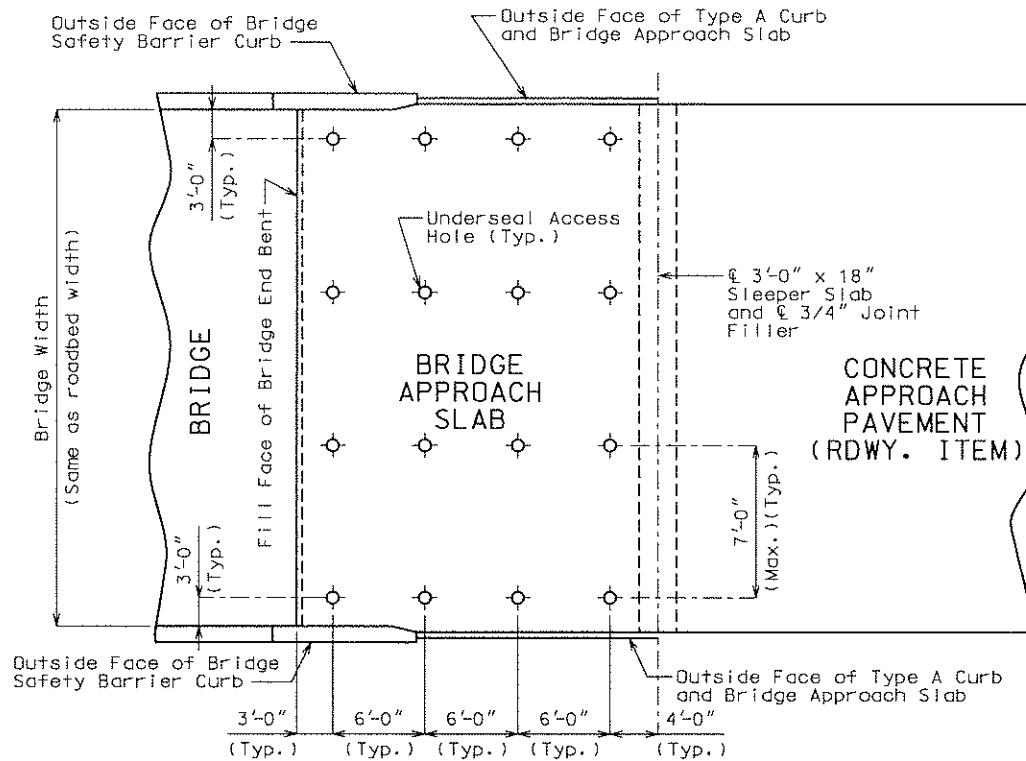

PART PLAN (SHOWING TYPICAL UNDERSEAL ACCESS HOLE LOCATIONS)

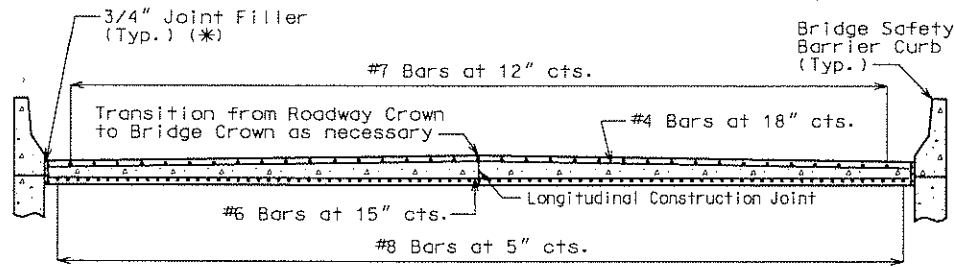


SECTION A-A

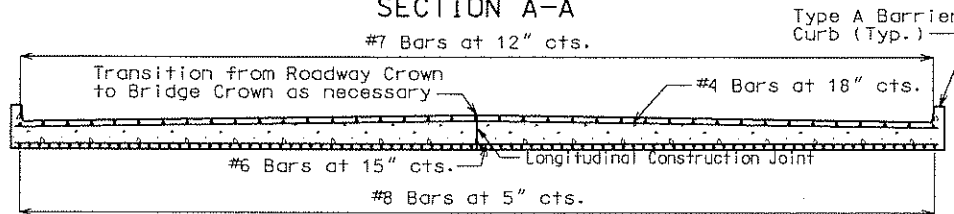

SECTION B-B


Note: With the approval of the Engineer, the contractor may crown the bottom of the approach slab to match the crown of the roadway surface.

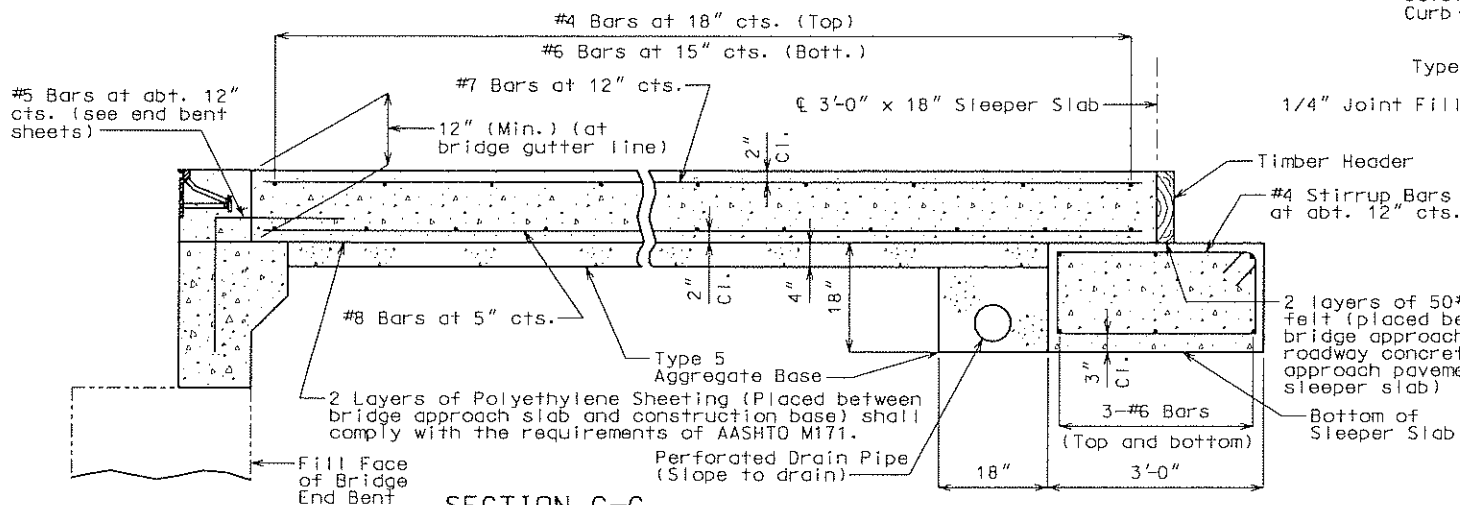

SECTION C-C

Compiled by Regin Belisle  
Checked by Dallas Russett


Note: This drawing is not to scale. Follow Dimensions.

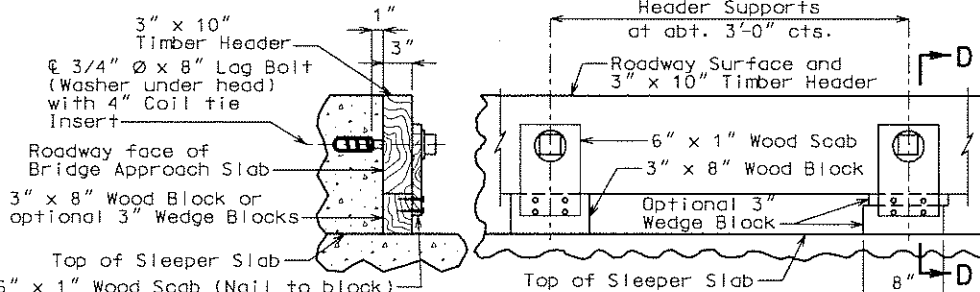

SECTION D-D  
PART ELEVATION (Min.)  
DETAILS OF TIMBER HEADER

Note: Remove timber header when concrete pavement is placed.


(\*) Use 3/4" Joint Filler between vertical face of Approach Slab and roadway face of Safety Barrier Curb/Wing, except at the end of Safety Barrier Curb/Wing face use 1/4" Joint Filler. Seal joint with joint sealant. See Special Provisions.

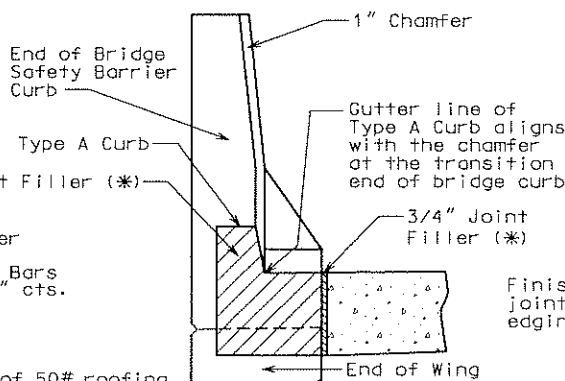

SECTION E-E  
(BETWEEN CURBS)


I CERTIFY THAT THIS PLAN SHEET ACCURATELY REPRESENTS THE CONFIGURATION AND LOCATION OF THE ROADWAY AND ALL ITS APPURTENANCES, TO THE BEST OF MY KNOWLEDGE, AS I AND MY STAFF HAVE OBSERVED THE CONTRACTOR'S CONSTRUCTION OF THIS PROJECT. I SPECIFICALLY DISCLAIM ANY RESPONSIBILITY FOR THE DESIGN OF THIS PROJECT, EXCEPT AS I AND MY STAFF MAY HAVE MODIFIED OR AUTHORIZED THE MODIFICATION OF THE PROJECT DESIGN DURING ITS CONSTRUCTION, AND I ACCEPT FULL RESPONSIBILITY FOR THE CONTRACTOR'S ACTUAL CONSTRUCTION OF THE PROJECT, EXCEPT AS I AND MY STAFF MAY HAVE DIRECTED OR ORDERED THAT THE PROJECT BE CONSTRUCTED.

SIGNATURE \_\_\_\_\_ DATE Sheet No. 32 of 35

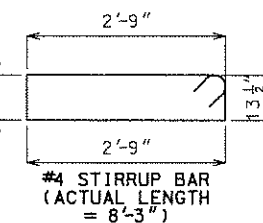


TYPICAL 135° STIRRUP BAR HOOK DIMENSIONS BENDING DIAGRAM

Note: Nominal lengths are based on out to out dimensions shown in bending diagram and are listed for fabricators use (nearest inch).

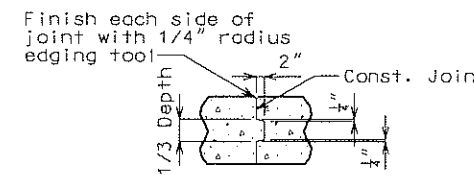

CONST. JOINT DETAIL (IF REQUIRED)

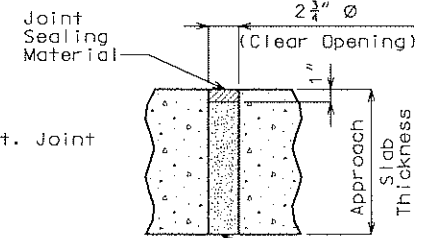

TYPICAL UNDERSEAL ACCESS HOLE DETAIL

BRIDGE APPROACH SLAB DETAILS

GENERAL NOTES:

All concrete for the bridge approach slab and sleeper slab shall be in accordance with Section 503 (f'c = 4,000 psi) of the Missouri Standard Specifications.

All joint filler shall meet the requirements of Section 1057.2.5 of the Missouri Standard Specifications, except as noted.

The reinforcing steel in the bridge approach slab and the sleeper slab shall be epoxy coated Grade 60 with Fy = 60,000 psi.

Minimum clearance to reinforcing steel shall be 1-1/2", unless otherwise shown.

The reinforcing steel in the bridge approach slab and the sleeper slab shall be continuous. The transverse reinforcing steel may be made continuous by lap splicing the #4 & #6 bars 18" and 26" respectively.

Mechanical bar splices will be permitted and shall develop at least 125 percent of the specified yield strength of the reinforcing bars being spliced. The contractor shall furnish the Engineer the manufacturer's certification that this requirement is met and is required to follow the manufacturer's recommendation for installation.

Mechanical bar splices shall be epoxy coated in accordance with Section 710 of the Missouri Standard Specifications.

Hooks and bends shall be in accordance with the CRSI Manual of Standard Practice for Detailing Reinforced Concrete Structures, Stirrup and Tie Dimensions.

The contractor shall pour and satisfactorily finish the bridge slab before pouring the bridge approach slabs.

Longitudinal construction joints in approach slab and sleeper slab shall be aligned with longitudinal construction joints in bridge slab.

Longitudinal construction joints in approach slab and sleeper slab shall be aligned with center line Route 64.

Payment for furnishing all materials, labor and excavation necessary to construct the approach slab, including the timber header, sleeper slab, underdrain, Type A Curb, Type 5 aggregate base, joint filler and all other appurtenances and incidental work as shown on this sheet, complete in place, shall be considered as completely covered under the contract unit price for Bridge Approach Slab (Bridge), per square yard.

For Concrete Approach Pavement details, see roadway plans.

See Missouri Standard Plans Drawing 609.00 for details of Type A Curb.

When a lap splice is required for the use of a mechanical bar splice, the minimum lap length shall be 40" for transverse approach slab bar splices.




At the contractor's option, Grade 40 reinforcement may be substituted for the Grade 60 #5 dowel bars connecting the bridge approach slab to the bridge abutment. No additional payment will be made for this substitution.

When Grade 40 reinforcement is substituted for the Grade 60 #5 dowel bars connecting the bridge approach slab to the bridge abutment, the reinforcement may be bent up to 90 degrees with a 2" minimum radius near the abutment to allow compaction of the backfill material near the abutment. Damage to epoxy coating shall be repaired according to Section 710.3.3 of the Missouri Standard Specifications.

Drain pipe may be either 6" diameter corrugated metallic-coated pipe underdrain, 4" diameter corrugated polyvinyl chloride (PVC) drain pipe, or 4" diameter corrugated polyethylene (PE) drain pipe.

**BILL OF REINFORCING STEEL**

NO.	REQ. D.	MARK NO.	LOCATION	EPOXY (E)	SHAPE NO.	STIRRUP (S)	SUBSTR. (X)	VARIES (V)	NO. EACH	DIMENSIONS										NOMINAL LENGTH	ACTUAL LENGTH	WEIGHT				
										B	C	D	E	F	H	K	FT.	IN.	FT.				IN.			
<b>END BENT 1</b>																										
6	6H101		Backwall	E	20	X											27'-2"	27'-2"	245							
8	6H102		Backwall	E	20	X											2'-3"	2'-3"	27							
16	6H103		Backwall	E	19	X											6'-4"	18"	186							
1	4H104		Backwall	E	20	X											24'-6"	24'-6"	16							
14	6H105		Wingwall	E	15	X											14"	4'-4"	14"	9 7/8"	9 7/8"	9 7/8"	9 7/8"	6'-8"	6'-8"	140
10	6H106		Wingwall	E	20	X											13'-5"	13'-5"	202							
20	6H107		Wingwall		20	X	V	4									7'-10"	7'-10"	313							
			Increment = 15 1/2"														13'-0"	13'-0"								
12	4H108		Wingwall		20	X											2'-4"	2'-4"	19							
20	6H109		Wingwall		20	X	V	4									3'-4"	3'-4"	189							
			Increment = 17 3/4"														9'-3"	9'-3"								
20	6H110		Backwall		20	X											2'-3"	2'-3"	68							
25	4U101		Backwall	E	5	X											6"	14"	14"					2'-10"	2'-8"	45
25	5U102		Backwall	E	19	X											2'-0"	2'-0"	102							
36	4V101		Backwall	E	20	X											2'-1"	2'-1"	50							
18	4V102		Backwall	E	20	X											4'-10"	4'-10"	58							
4	6V103		Wingwall		15	X	V	4									14"	14'-3"	19"	7 3/4"	17 3/8"	12 3/4"	5 1/4"	17'-0"	17'-0"	102
108	6V104		Wingwall		20	X											16"	16"	676							
			Increment = 2 5/8"														7'-0"	7'-0"								
12	6V105		Wingwall		20	X											7'-2"	7'-2"	129							
4	4V106		Wingwall		20	X											3'-8"	3'-8"	10							
4	4V107		Wingwall		5	X											3'-10"	2'-10"	25							
8	6V108		Wingwall		20	X											4'-10"	4'-10"	58							
<b>END BENT 20</b>																										
6	6H2001		Backwall	E	20	X											27'-2"	27'-2"	245							
8	6H2002		Backwall	E	20	X											2'-3"	2'-3"	27							
16	6H2003		Backwall	E	19	X											6'-4"	18"	186							
1	4H2004		Backwall	E	20	X											24'-6"	24'-6"	16							
14	6H2005		Wingwall	E	15	X											14"	4'-4"	14"	9 7/8"	9 7/8"	9 7/8"	9 7/8"	6'-8"	6'-8"	140
8	6H2006		Wingwall	E	20	X											13'-5"	13'-5"	161							
20	6H2007		Wingwall		20	X	V	4									7'-10"	7'-10"	313							
			Increment = 15 1/2"														13'-0"	13'-0"								
12	4H2008		Wingwall		20	X											2'-4"	2'-4"	19							
20	6H2009		Wingwall		20	X	V	4									3'-4"	3'-4"	189							
			Increment = 17 3/4"														9'-3"	9'-3"								
20	6H2010		Backwall		20	X											2'-3"	2'-3"	68							
25	4U2001		Backwall	E	5	X											6"	14"	14"					2'-10"	2'-8"	45
25	5U2002		Backwall	E	19	X											2'-0"	2'-0"	102							
36	4V2001		Backwall	E	20	X											2'-1"	2'-1"	50							
16	4V2002		Backwall	E	20	X											4'-10"	4'-10"	52							
4	6V2003		Wingwall		15	X	V	4									14"	14'-3"	19"	7 3/4"	17 3/8"	12 3/4"	5 1/4"	17'-0"	17'-0"	102
108	6V2004		Wingwall		20	X											16"	16"	676							
			Increment = 2 5/8"														7'-0"	7'-0"								
12	6V2005		Wingwall		20	X											7'-2"	7'-2"	129							
4	4V2006		Wingwall		20	X											3'-8"	3'-8"	10							
4	4V2007		Wingwall		5	X											3'-10"	2'-10"	25							
8	6V2008		Wingwall		20	X											4'-10"	4'-10"	58							

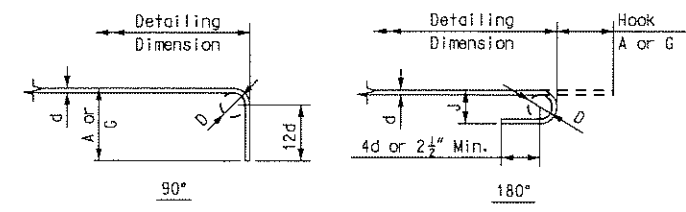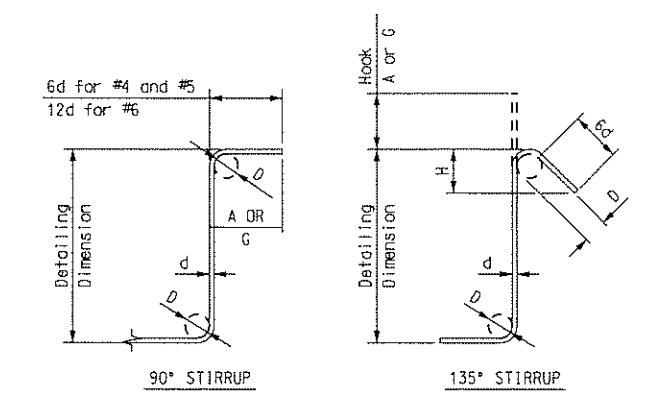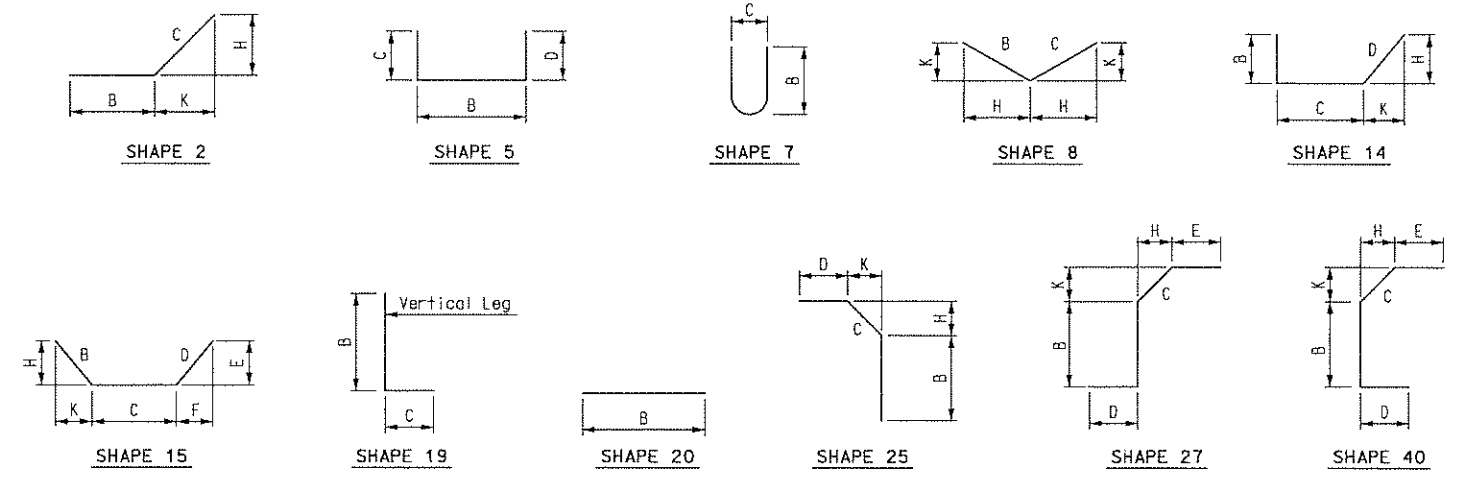

END HOOK DIMENSIONS				
BAR SIZE	D (IN.)	ALL GRADES		
		180° HOOKS		90° HOOKS
		HOOK A OR G	J	HOOK A OR G
#3	2 1/4"	5"	3"	6"
#4	3"	6"	4"	8"
#5	3 3/4"	7"	5"	10"
#6	4 1/2"	8"	6"	12"
#7	5 1/4"	10"	7"	14"
#8	6"	11"	8"	16"
#9	9 1/4"	15"	11 1/4"	19"
#10	10 3/4"	17"	13 1/4"	22"
#11	12"	19"	14 3/4"	2'-0"
#14	18 1/4"	2'-3"	21 3/4"	2'-7"

STIRRUP HOOK DIMENSIONS				
GRADES 40 - 50 - 60 KSI				
BAR SIZE	D (IN.)	90° HOOK HOOK A OR G	135° HOOK HOOK A OR G	APPROX. H
#4	2"	4 1/2"	4 1/2"	3"
#5	2 1/2"	6"	5 1/2"	3 3/4"
#6	4 1/2"	12"	8"	4 1/2"

Note: Unless otherwise noted, diameter "D" is the same for all bends and hooks on a bar.

Notes:  
 All standard hooks and bends other than 180 degree are to be bent with the same procedure as for 90 degree standard hooks.  
 Hooks and bends shall be in accordance with the procedures as shown on this sheet.  
 E = Epoxy coated reinforcement.  
 S = Stirrup.  
 X = Bar is included in substructure quantities.  
 V = Bar dimensions vary in equal increments between dimensions shown on this line and the following line.  
 No. = Number of bars of each length.  
 Nominal lengths are based on out to out dimensions shown in bending diagrams and are listed for fabricators use. (Nearest inch)  
 Actual lengths are measured along centerline bar to the nearest inch.  
 Payweights are based on actual lengths.  
 Reinforcing Steel (Grade 60) fy = 60,000 psi.

**FINAL PLANS**

I CERTIFY THAT THIS PLAN SHEET ACCURATELY DEPICTS THE CONFIGURATION AND LOCATION OF THE ROADWAY AND ALL ITS APPURTENANT FEATURES, TO THE BEST OF MY KNOWLEDGE, AS I AND MY STAFF HAVE OBSERVED THE CONTRACTOR'S CONSTRUCTION OF THIS PROJECT. I SPECIFICALLY DISCLAIM ANY RESPONSIBILITY FOR THE DESIGN OF THIS PROJECT, EXCEPT AS I AND MY STAFF MAY HAVE MODIFIED OR AUTHORIZED THE MODIFICATION OF THE PROJECT DESIGN DURING ITS CONSTRUCTION; AND I DISCLAIM RESPONSIBILITY FOR THE CONTRACTOR'S ACTUAL CONSTRUCTION OF THE PROJECT, EXCEPT AS I AND MY STAFF MAY HAVE DIRECTED OR ORDERED THAT THE PROJECT BE CONSTRUCTED.

SIGNATURE \_\_\_\_\_ DATE \_\_\_\_\_

\* Two additional #4-V102 and #6-H106 are included in the bar list for testing.



